


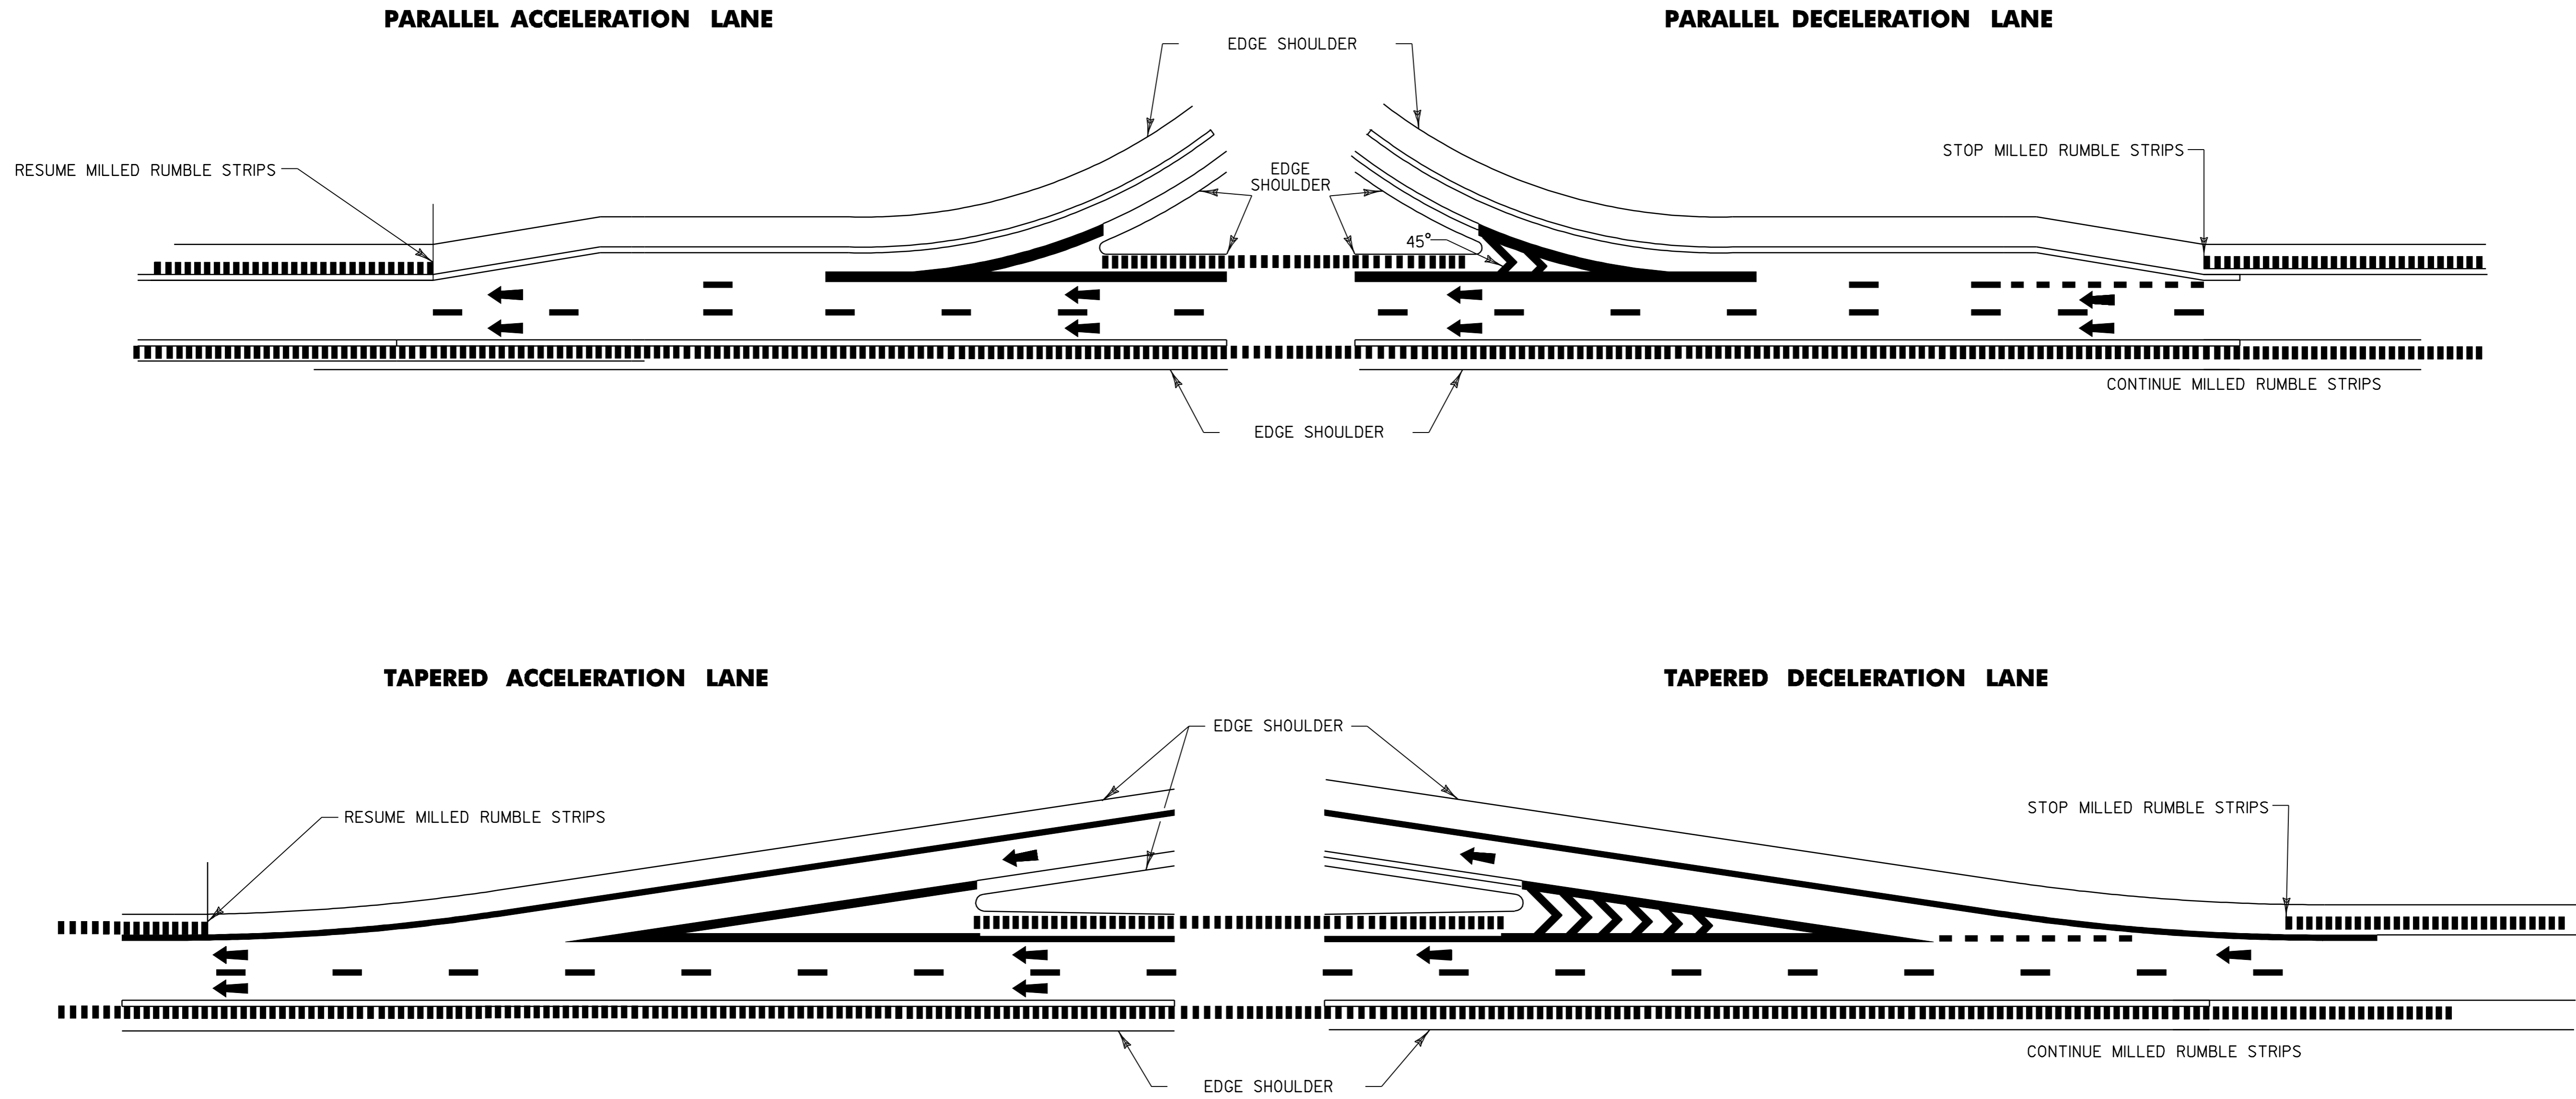

**TYPICAL MILLED RUMBLE STRIPS AT INTERCHANGES & REST AREAS**



**LEGEND**

-  DIRECTION OF TRAFFIC FLOW
-  MILLED RUMBLE STRIPS
- NOT TO SCALE

**NOTES:**

1) THIS TYPICAL MAYBE MODIFIED AT THE RESIDENT ENGINEER DISCRETION IF THE ACTUAL FIELD CONDITIONS NECESSITATE SUCH ACTIONS.

<b>MILLED RUMBLE STRIPS DETAIL #2</b>	PROJECT NAME: MONTPELIER - WATERBURY	PLOT DATE: 11-APR-2005 10:19
	PROJECT NUMBER: IM 089-2(34)	DRAWN BY: _____
	FILE NAME: /pave/03a026/p03a026.dgn	CHECKED BY: _____
	DESIGNED BY: _____	SHEET 21 OF 23