

TEMPORARY AND DURABLE 6'' YELLOW LINE
 STA 5174+40 ~ 5438+40 LT--SOLID

TEMPORARY AND DURABLE 6'' WHITE LINE
 STA 5174+40 ~ 5438+40 RT--SOLID
 STA 5174+40 ~ 5438+40 RT--DASHED

ITEM 621.505 FLEET 350
 MANUFACTURED TERMINAL SECTION (FLARED)
 SB STA 5179+48 ~ 5179+85 RT INST. 8/5/05
 STA 5193+30 ~ 5193+67 RT ✓
 STA 5192+96 ~ 5193+33 LT ✓
 STA 5231+18 ~ 5231+55 RT ✓
 STA 5336+57 ~ 5336+94 RT ✓

ITEM 616.35
 TREATED TIMBER CURB
 STA 5233+50 ~ 5255+50 RT
 STA 5337+35 ~ 5342+32 RT

ITEM 616.47
 BITUMINOUS CONCRETE GUTTERS
 AND TRAFFIC ISLANDS

ITEM 621.52
 M. T. S. (TRAILING END TERMINAL)
 STA 5256+43 RT
 STA 5342+70 RT

ITEM 621.81
 REMOVAL & DISP. OF GUARDRAIL
 STA 5193+30 ~ 5196+19 RT ✓
 STA 5195+12 ~ 5196+33 LT ✓
 STA 5231+18 ~ 5256+55 RT ✓
 STA 5336+57 ~ 5342+82 RT ✓
 SB STA 5175+73 ~ 5176+98 LT ✓ 8/4/05


ITEM 621.20
 STEEL BEAM GUARDRAIL
 SB STA 5175+73 ~ 5179+48 RT ✓ 8/4/05
 STA 5193+67 ~ 5196+19 RT ✓
 STA 5193+33 ~ 5196+33 LT ✓
 STA 5231+55 ~ 5256+43 RT ✓
 STA 5336+94 ~ 5342+70 RT ✓

CHANGING ELEV. OF DI, CB, MH
 REHABILITATION OF DI CB OR MH CLASS I

STA 5175+05 RT 9/01
 STA 5236+84 RT 9/01
 STA 5238+62 RT 9/06
 STA 5240+92 RT 9/06
 STA 5243+88 RT 9/06
 STA 5246+90 RT 9/06
 STA 5249+36 RT 9/08
 STA 5340+35 RT 9/09
 STA 5342+32 RT 9/09

STA. 5174+40
 (MM 98.00)

STA. 5438+40
 (MM 103.00)

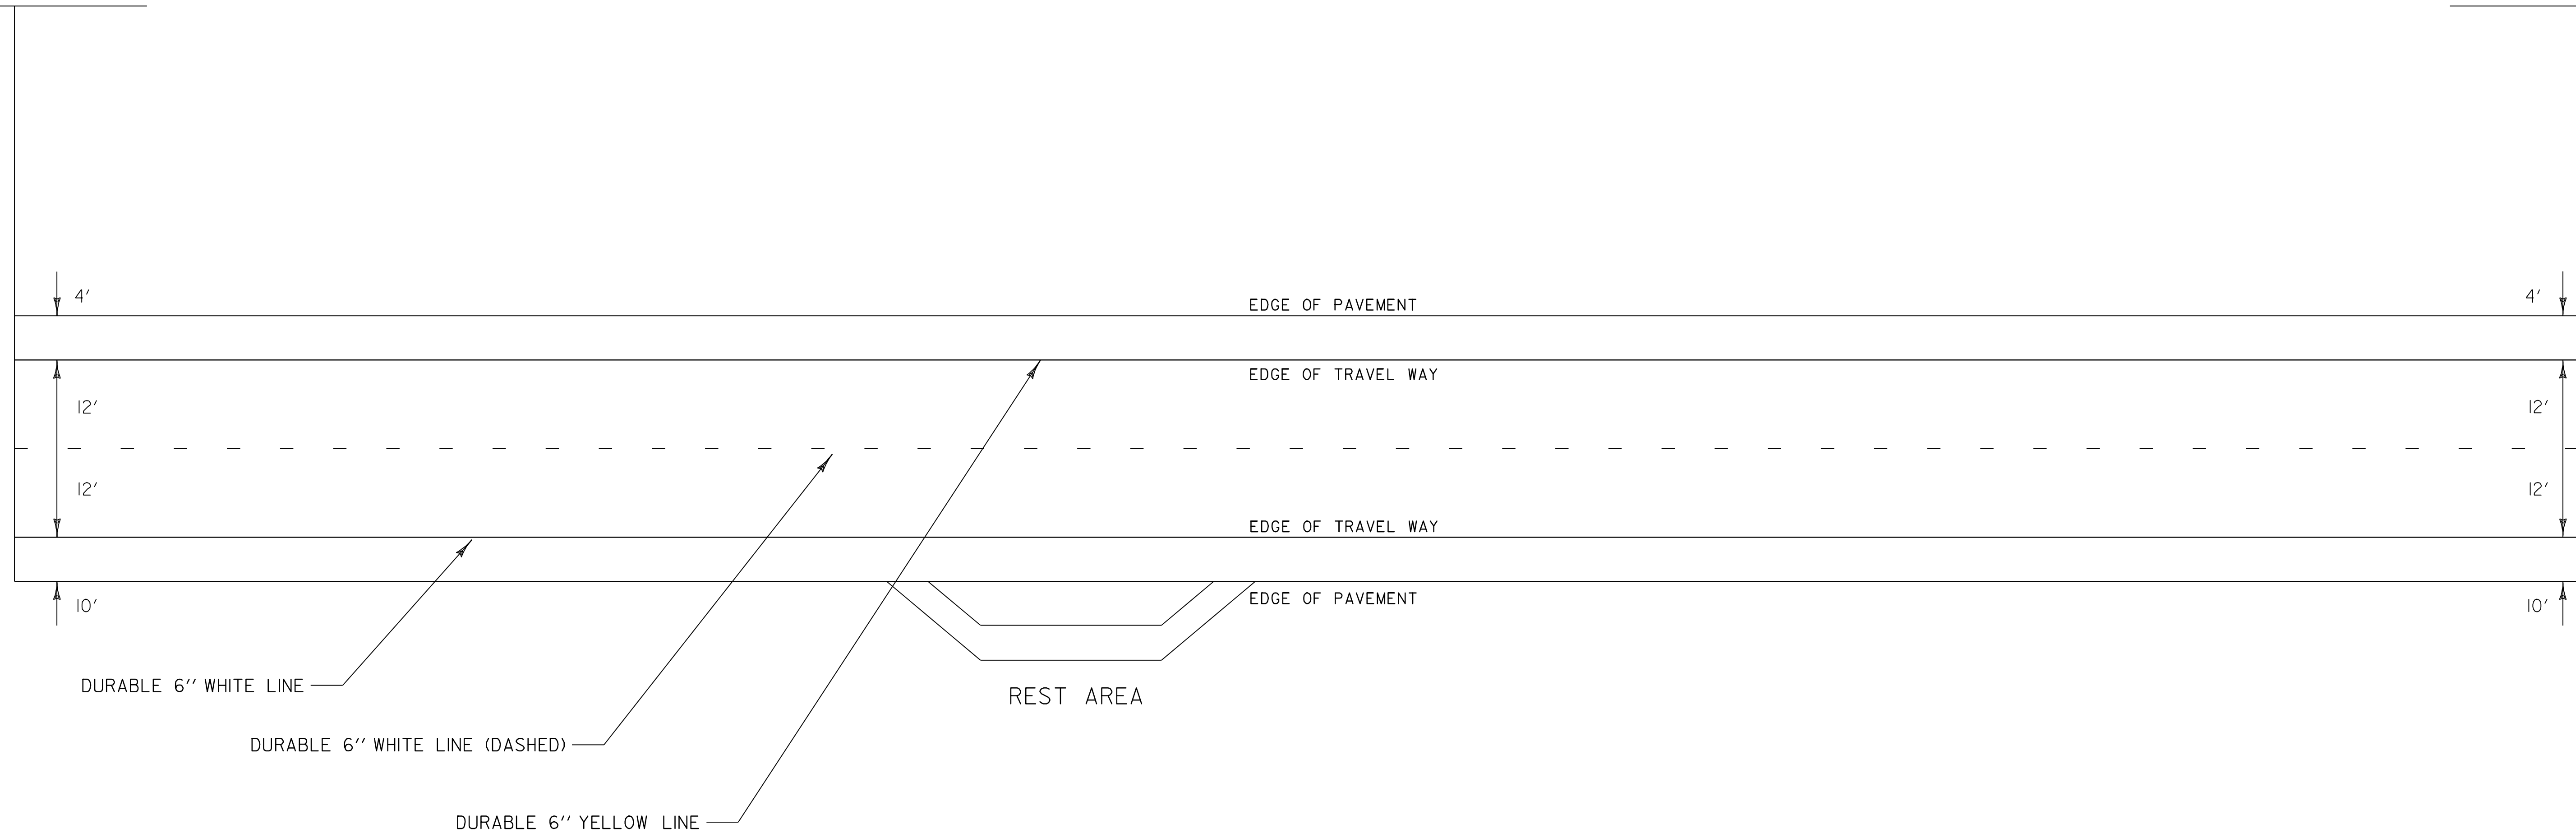

NOTE: ALL DIMENSIONS IN FEET EXCEPT AS INDICATED

NOT TO SCALE

**PAVING
 PROJECT
 LAYOUT #2**

PROJECT NAME: FAIRLEE-NEWBURY
 PROJECT NUMBER: AC IM 091-2(39)

FILE NAME: /pave/03a028/pa028.dgn PLOT DATE: 12-MAR-2007 11:18
 PROJECT LEADER: WOOLAVER DRAWN BY: JLR
 DESIGNED BY: JLR CHECKED BY: JLR
 pa028i02.i SHEET 12 OF 25

DATUM
 VERTICAL _____
 HORIZONTAL _____