

TEMPORARY AND DURABLE 6" YELLOW LINE  
 STA 5438+40 ~ 5545+58.4 LT--SOLID

ITEM 621.505 FLEET 350  
 MANUFACTURED TERMINAL SECTION (FLARED)  
 STA 5452+88 ~ 5453+25 RT ✓  
 STA 5457+19 ~ 5457+26 LT ✓

ITEM 621.81  
 REMOVAL & DISP. OF GUARDRAIL  
 STA 5452+88 ~ 5464+63 RT ✓  
 STA 5457+19 ~ 5464+94 LT ✓


ITEM 621.20  
 STEEL BEAM GUARDRAIL  
 STA 5453+25 ~ 5464+63 RT ✓  
 STA 5457+26 ~ 5464+94 LT ✓

CHANGING ELEV. OF DI, CB, MH  
 REHABILITATION OF DICB OR MH CLASS I

STA 5457+02 RT  
 9/07 STA 5460+63 Lt & Rt 9/08  
 9/12 STA 5463+61 Lt & Rt 9/08

TEMPORARY AND DURABLE 6" WHITE LINE  
 STA 5438+40 ~ 5545+58.4 RT--SOLID  
 STA 5438+40 ~ 5545+58.4 RT--DASHED

ITEM 616.35  
 TREATED TIMBER CURB  
 STA 5455+46 ~ 5464+63 RT ✓  
 STA 5459+65 ~ 5465+12 LT ✓

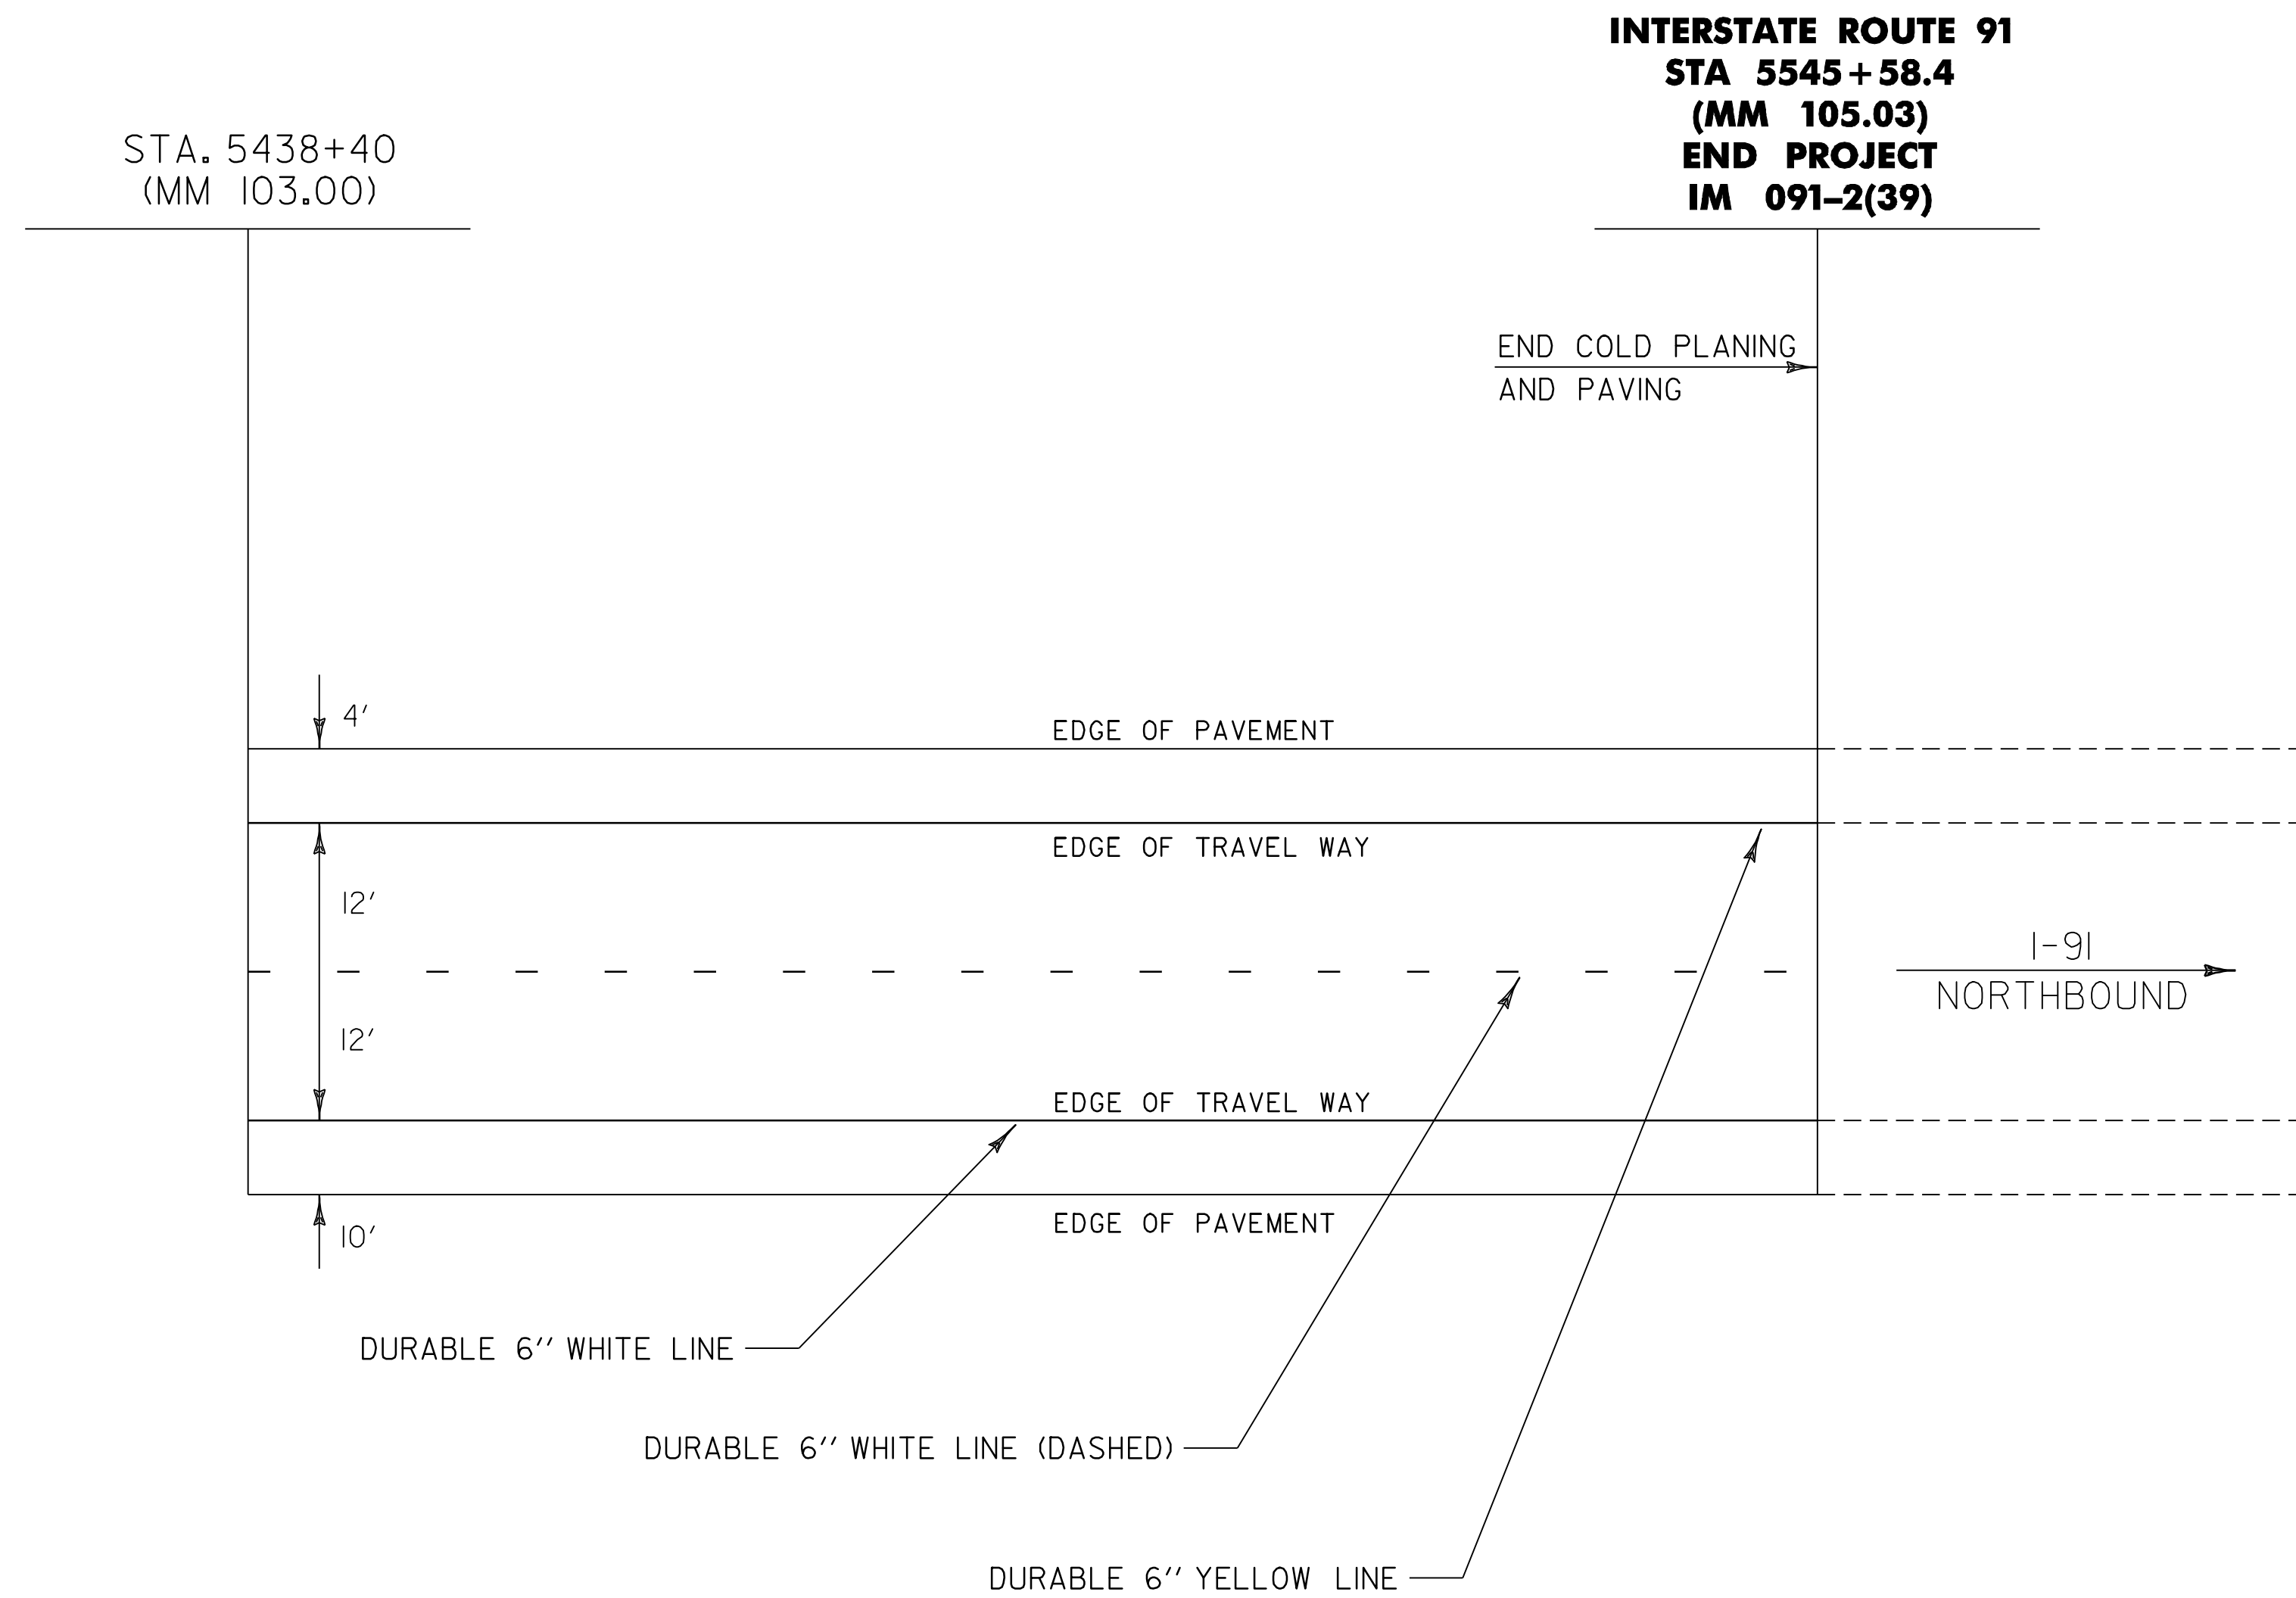

**INTERSTATE ROUTE 91**  
**STA 5545+58.4**  
**(MM 105.03)**  
**END PROJECT**  
**IM 091-2(39)**

END COLD PLANING  
 AND PAVING

I-91  
 NORTHBOUND

NOTE: ALL DIMENSIONS IN FEET EXCEPT AS INDICATED

DATUM  
 VERTICAL \_\_\_\_\_  
 HORIZONTAL \_\_\_\_\_

NOT TO SCALE

**PAVING  
 PROJECT  
 LAYOUT #3**

PROJECT NAME: FAIRLEE-NEWBURY  
 PROJECT NUMBER: AC IM 091-2(39)

FILE NAME: /pave/03a028/pa028.dgn PLOT DATE: 12-MAR-2007 11:18  
 PROJECT LEADER: WOOLLAVER DRAWN BY: JLR  
 DESIGNED BY: JLR CHECKED BY: JLR  
 pa028i03.i SHEET 13 OF 25