

TEMPORARY & DURABLE 24" STOP BAR  
RAMP A STA 19+03



TEMPORARY & DURABLE LETTER OR SYMBOL  
RAMP AA STA 0+00 (▼ 8 EA)  
RAMP AA STA 0+09 (YIELD)(5 EA)  
RAMP A STA 16+50 (ARROW)(1 EA)  
RAMP A STA 18+99 (STOP)(4 EA)  
RAMP A STA 10+61 (STOP)(4 EA)  
RAMP A STA 10+93 (AHEAD)(5 EA)

DURABLE 12" WHITE LINE  
RAMP A STA 17+75 ~ 17+95 RT  
RAMP AA STA 0+75 ~ 0+95 LT

TEMPORARY & DURABLE 6" WHITE LINE  
RAMP A STA 4+00 ~ RAMP AA STA 0+09 RT EDGE LINE--SOLID  
RAMPS A STA 17+95 ~ 19+03 RT EDGE LINE--SOLID

TEMPORARY & DURABLE 6" YELLOW LINE  
RAMP A STA 4+00 ~ 19+03 LT EDGE LINE--SOLID  
RAMPS AA STA 0+00 ~ 0+75 RT EDGE LINE--SOLID

REMOVING SIGNS  
AS SHOWN--10

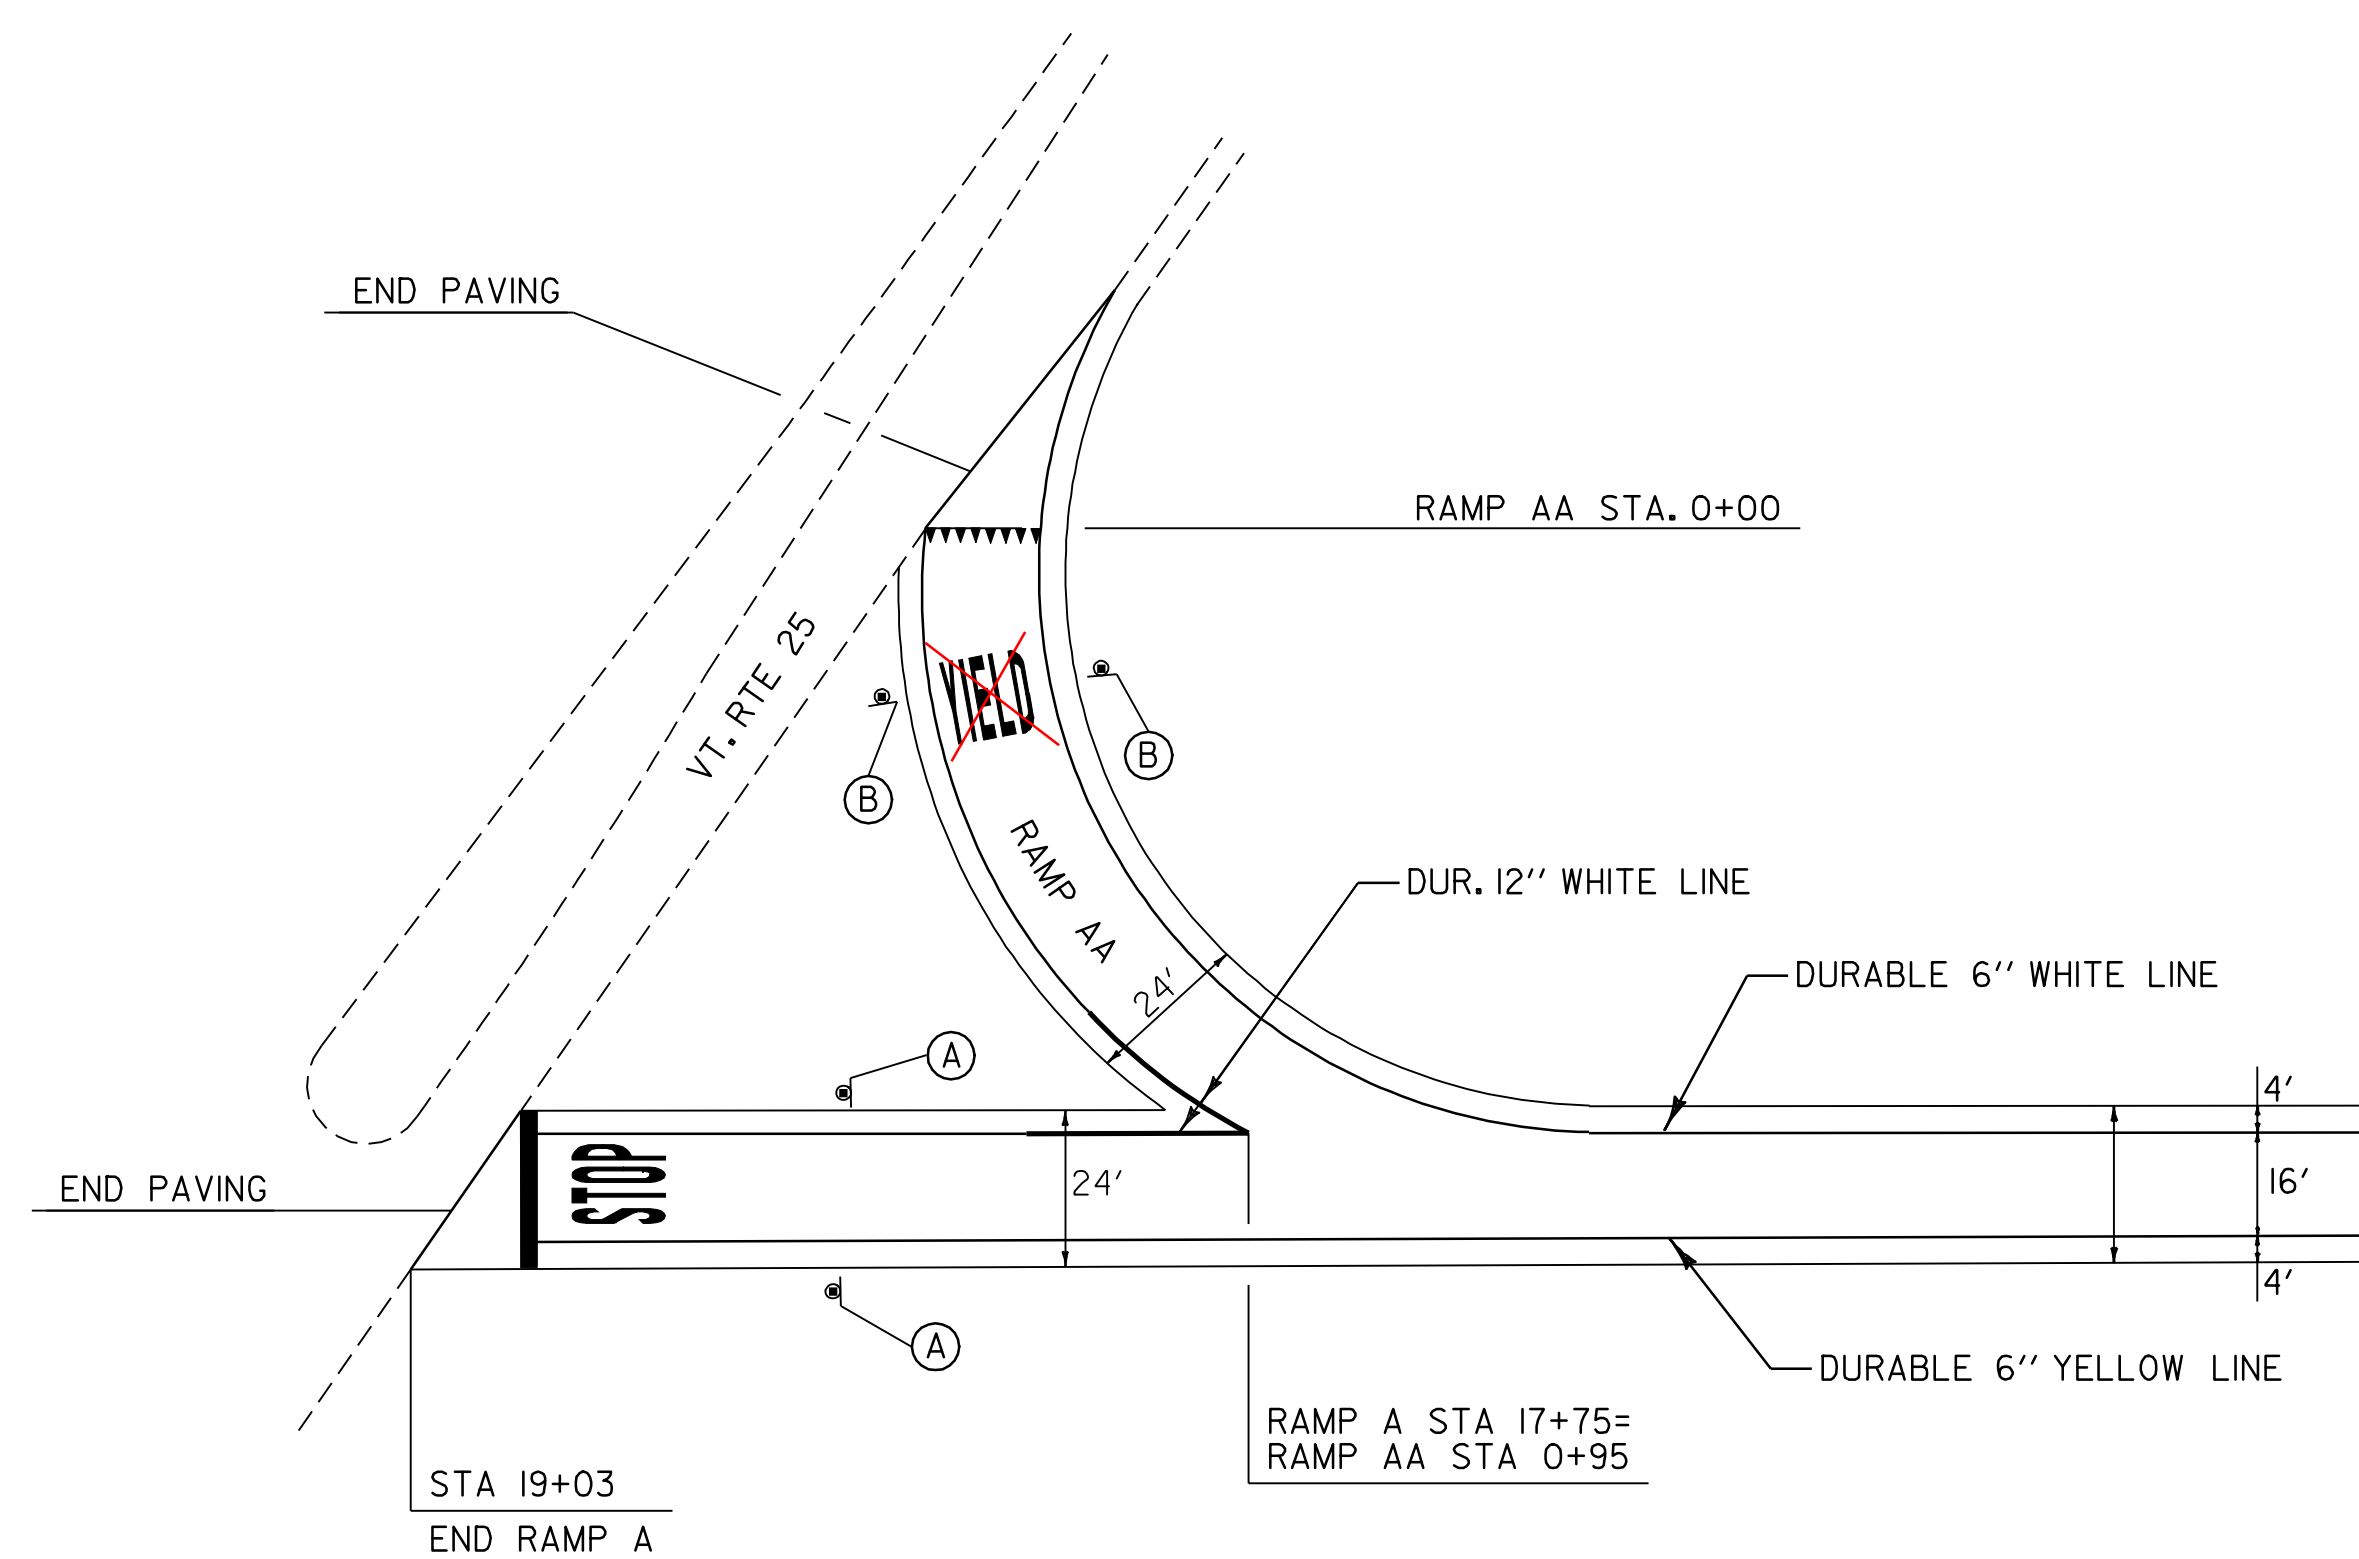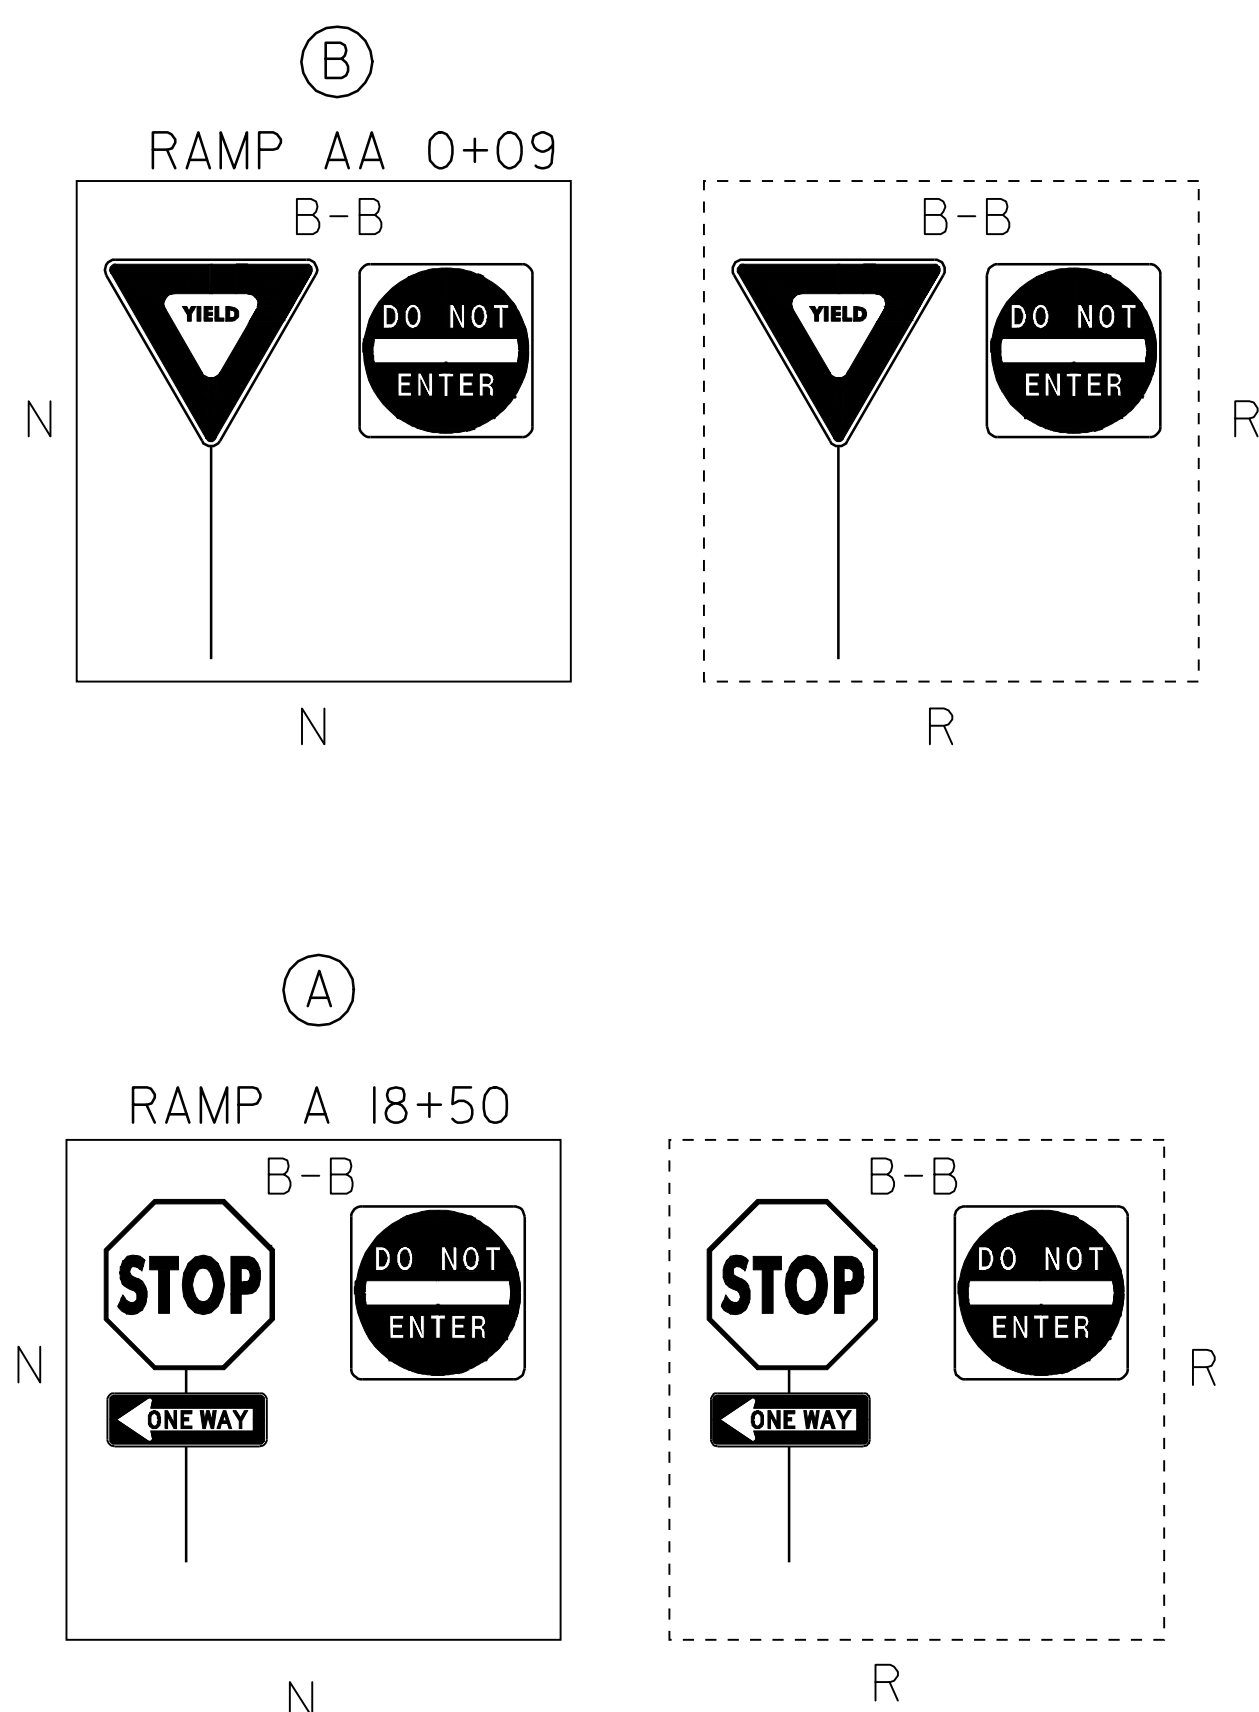

NOTE: REFER TO SHEETS 22, 23 & 24 FOR PAVEMENT MARKING DETAILS.

<b>EXIT 16 RAMPS A &amp; AA SIGN &amp; STRIPING SHEET</b>	PROJECT NAME: FAIRLEE-NEWBURY	PLOT DATE: 12-MAR-2007 11:19
	PROJECT NUMBER: AC IM 091-2(39)	DRAWN BY: JLR
	FILE NAME: /pave/03a028/pa028.dgn	CHECKED BY: JLR
	DESIGNED BY: JLR	SHEET 15 OF 25