

BRADFORD-NEWBURY

POWER & TEL. CABLE

DURABLE LETTER OR SYMBOL  
 STA 10+77 RT (PARKING SYMBOL)  
 STA 11+01 RT (PARKING SYMBOL)  
 LONG WAY ARROW @ ENTRANCE


TEMPORARY & DURABLE 12" WHITE LINE  
 STA 4+90 ~ 6+30 LT  
 STA 16+10 ~ 18+05 LT

TEMPORARY & DURABLE XWALK  
 W/ DIAGONAL LINES  
 STA 10+38 RT  
 STA 11+16 RT

TEMPORARY & DURABLE 6" WHITE LINE

TEMPORARY & DURABLE 6" YELLOW LINE  
 STA 6+30 ~ 9+43 LT EDGE LINE--SOLID  
 STA 12+00 ~ 16+10 LT EDGE LINE--SOLID

TEMPORARY & DURABLE 4" WHITE LINE  
 STA 9+43 ~ 12+00 LT--EDGE LINE--SOLID  
 STA 9+43 ~ 12+22 RT--PARKING STALLS

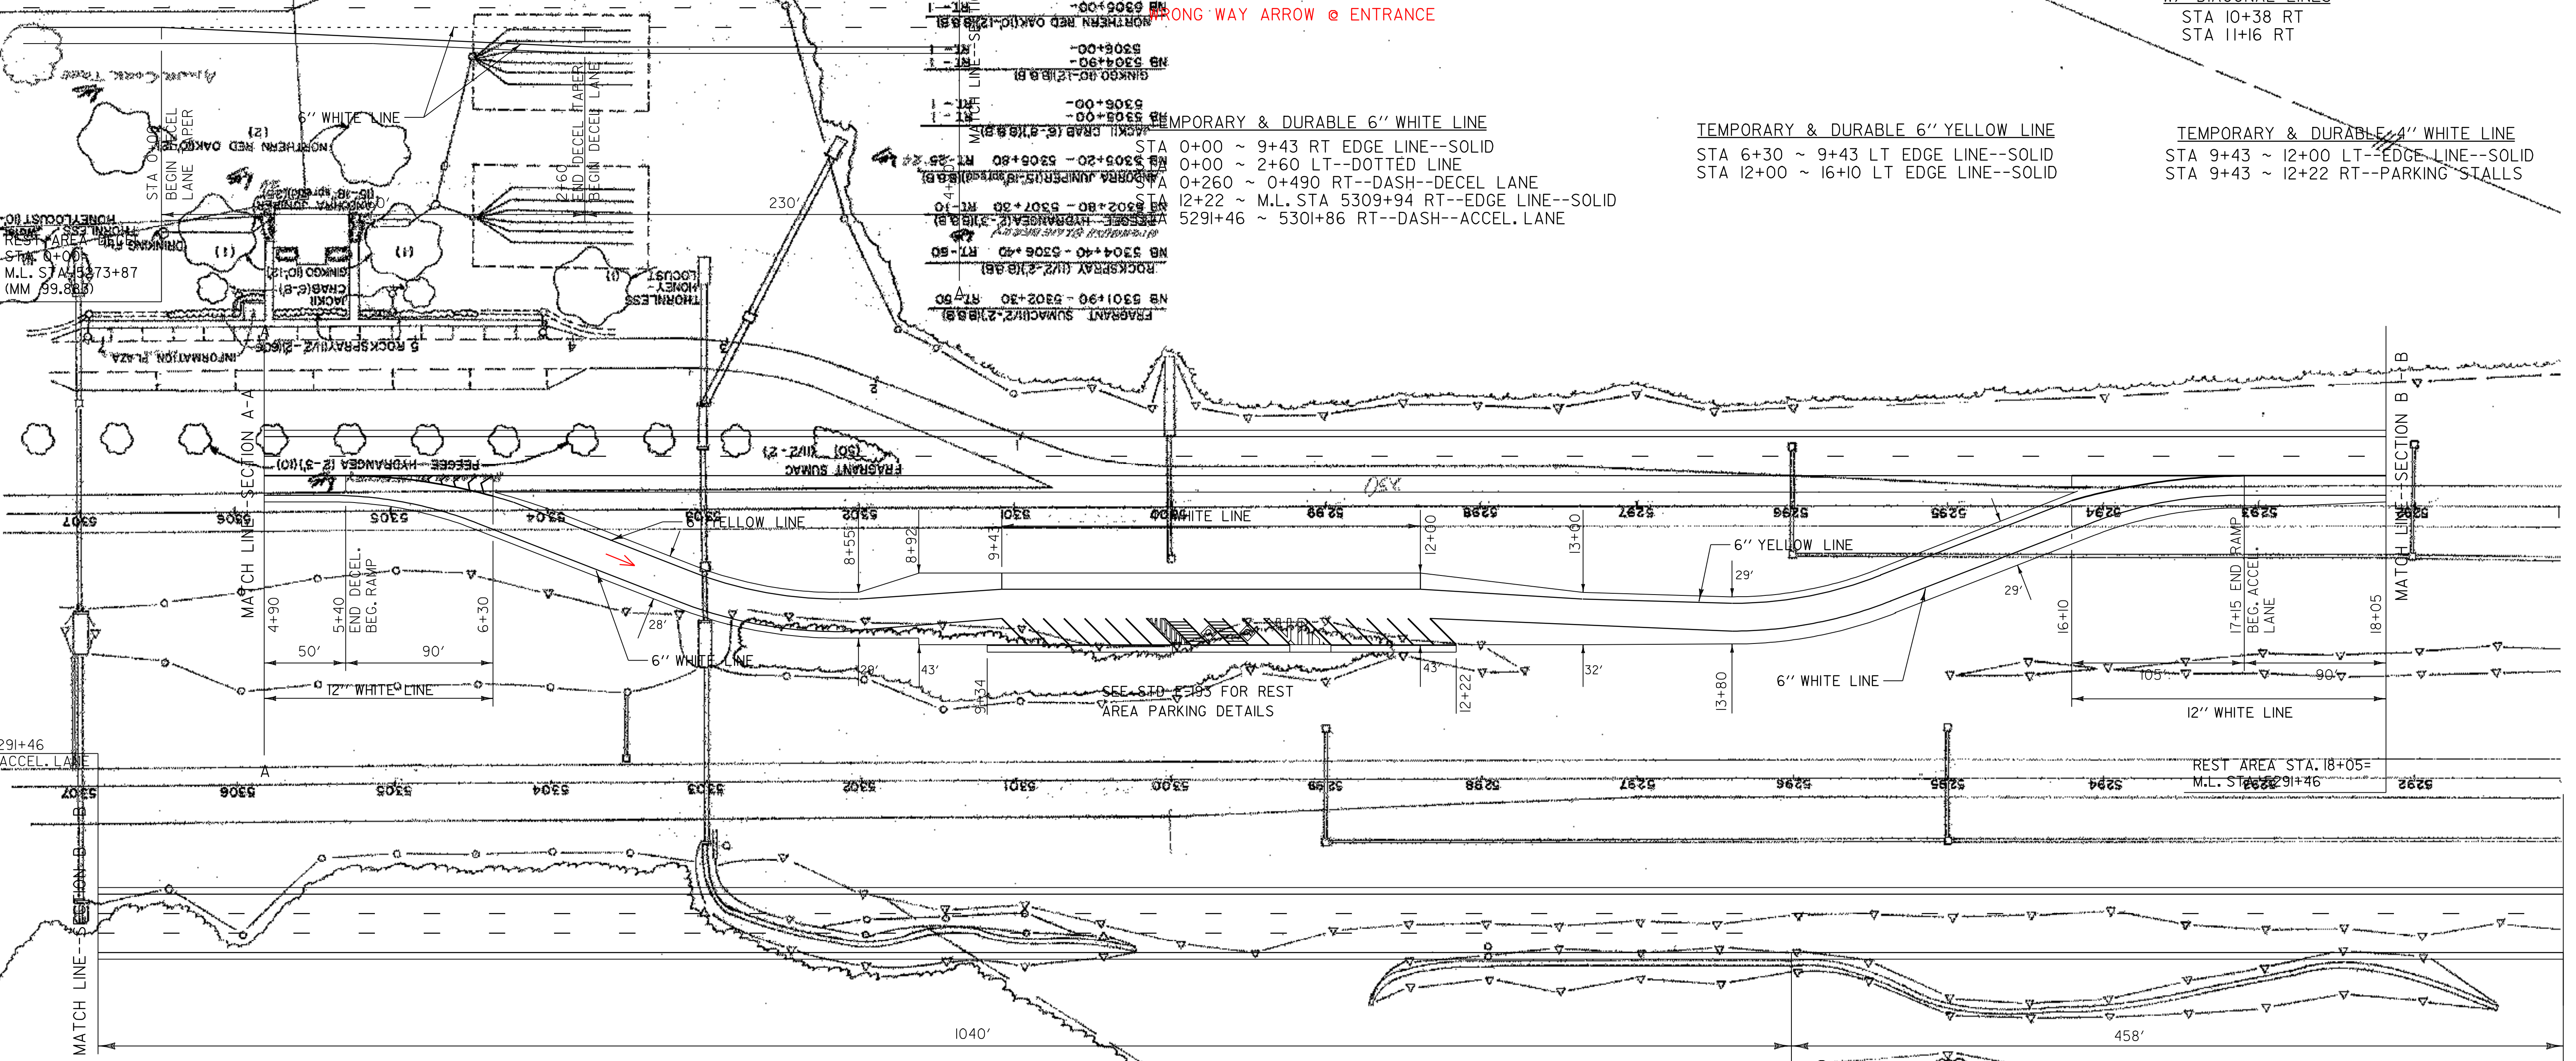


STA 5291+46  
 BEGIN ACCEL. LANE

REST AREA STA. 18+50  
 M.L. STA. 17+16

MATCH LINE--SECTION C - C

BLUE BACKGROUND  
 48" X 48" FOR STANDARD

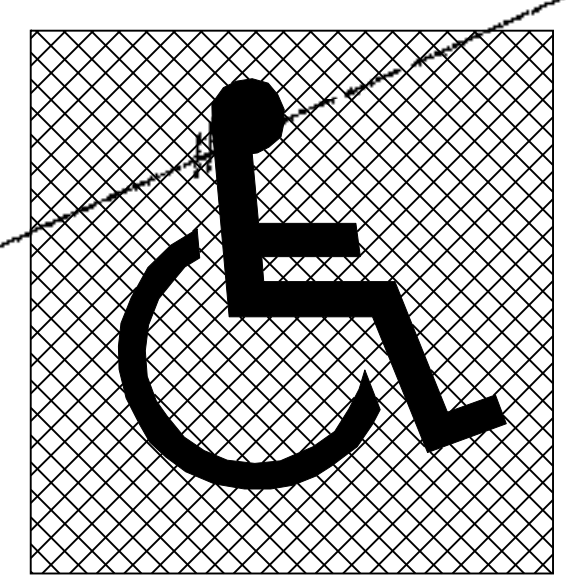

HEIGHT OF SYMBOL  
 STANDARD 41"

WIDTH OF SYMBOL  
 STANDARD 36"

HANDICAP PARKING SYMBOL  
 PAID UNDER ITEM 646.50,  
 DURABLE LETTER OR SYMBOL  
 @ 2 EACH PER LOCATION.

MATCH LINE--SECTION C - C

STA 5306+44  
 BEGIN ACCEL.  
 LANE TAPER

END ACCEL.  
 LANE TAPER  
 STA 5309+94

**I-91 NORTHBOUND  
 REST AREA  
 DETAIL**

NOTE: REFER TO SHEETS 22, 23 & 24 FOR PAVEMENT MARKING DETAILS.

PROJECT NAME: FAIRLEE-NEWBURY  
 PROJECT NUMBER: AC IM 091-2(39)

FILE NAME: /pave/03a028/pa028.dgn  
 PROJECT LEADER: M. WOOLAVER  
 DESIGNED BY: JLR  
 pa028d04.1

PLOT DATE: 12-MAR-2007 11:19  
 DRAWN BY: JLR  
 CHECKED BY: JLR  
 SHEET 17 OF 25