

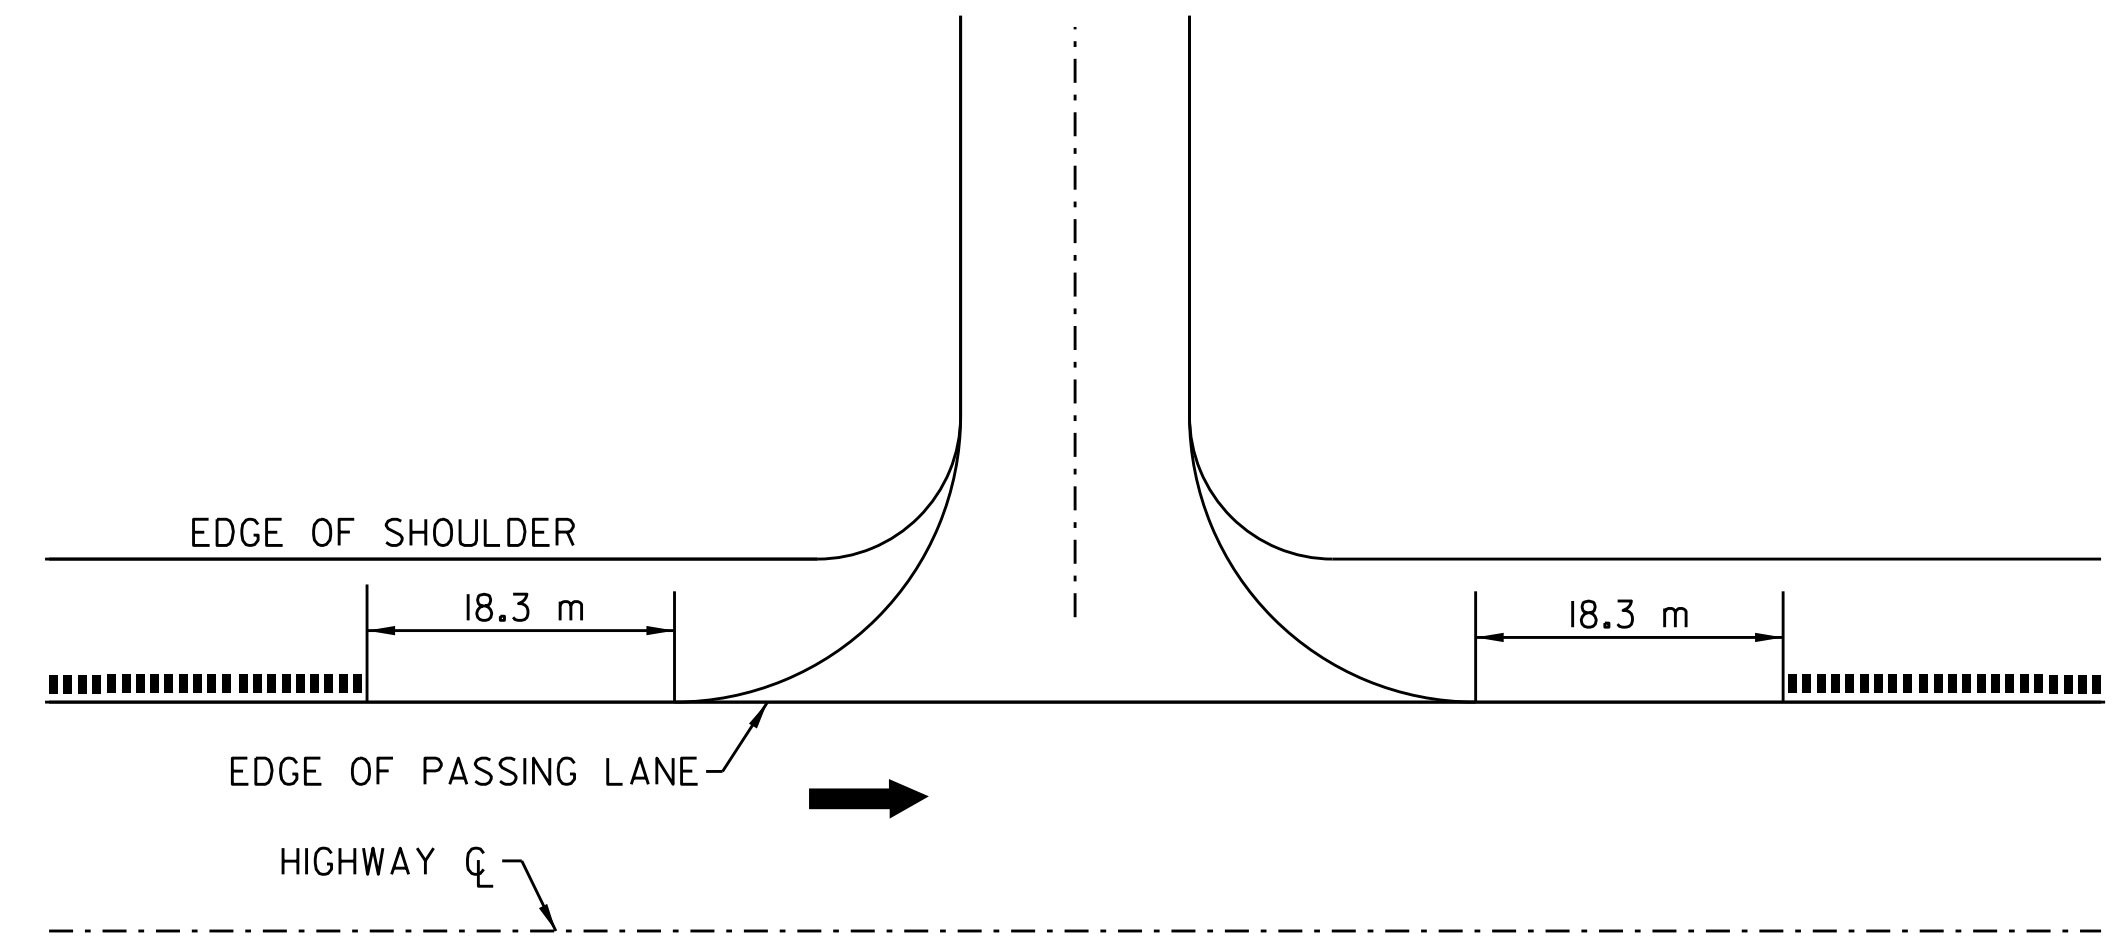


TYPICAL MILLING DETAIL

U-TURN DETAIL

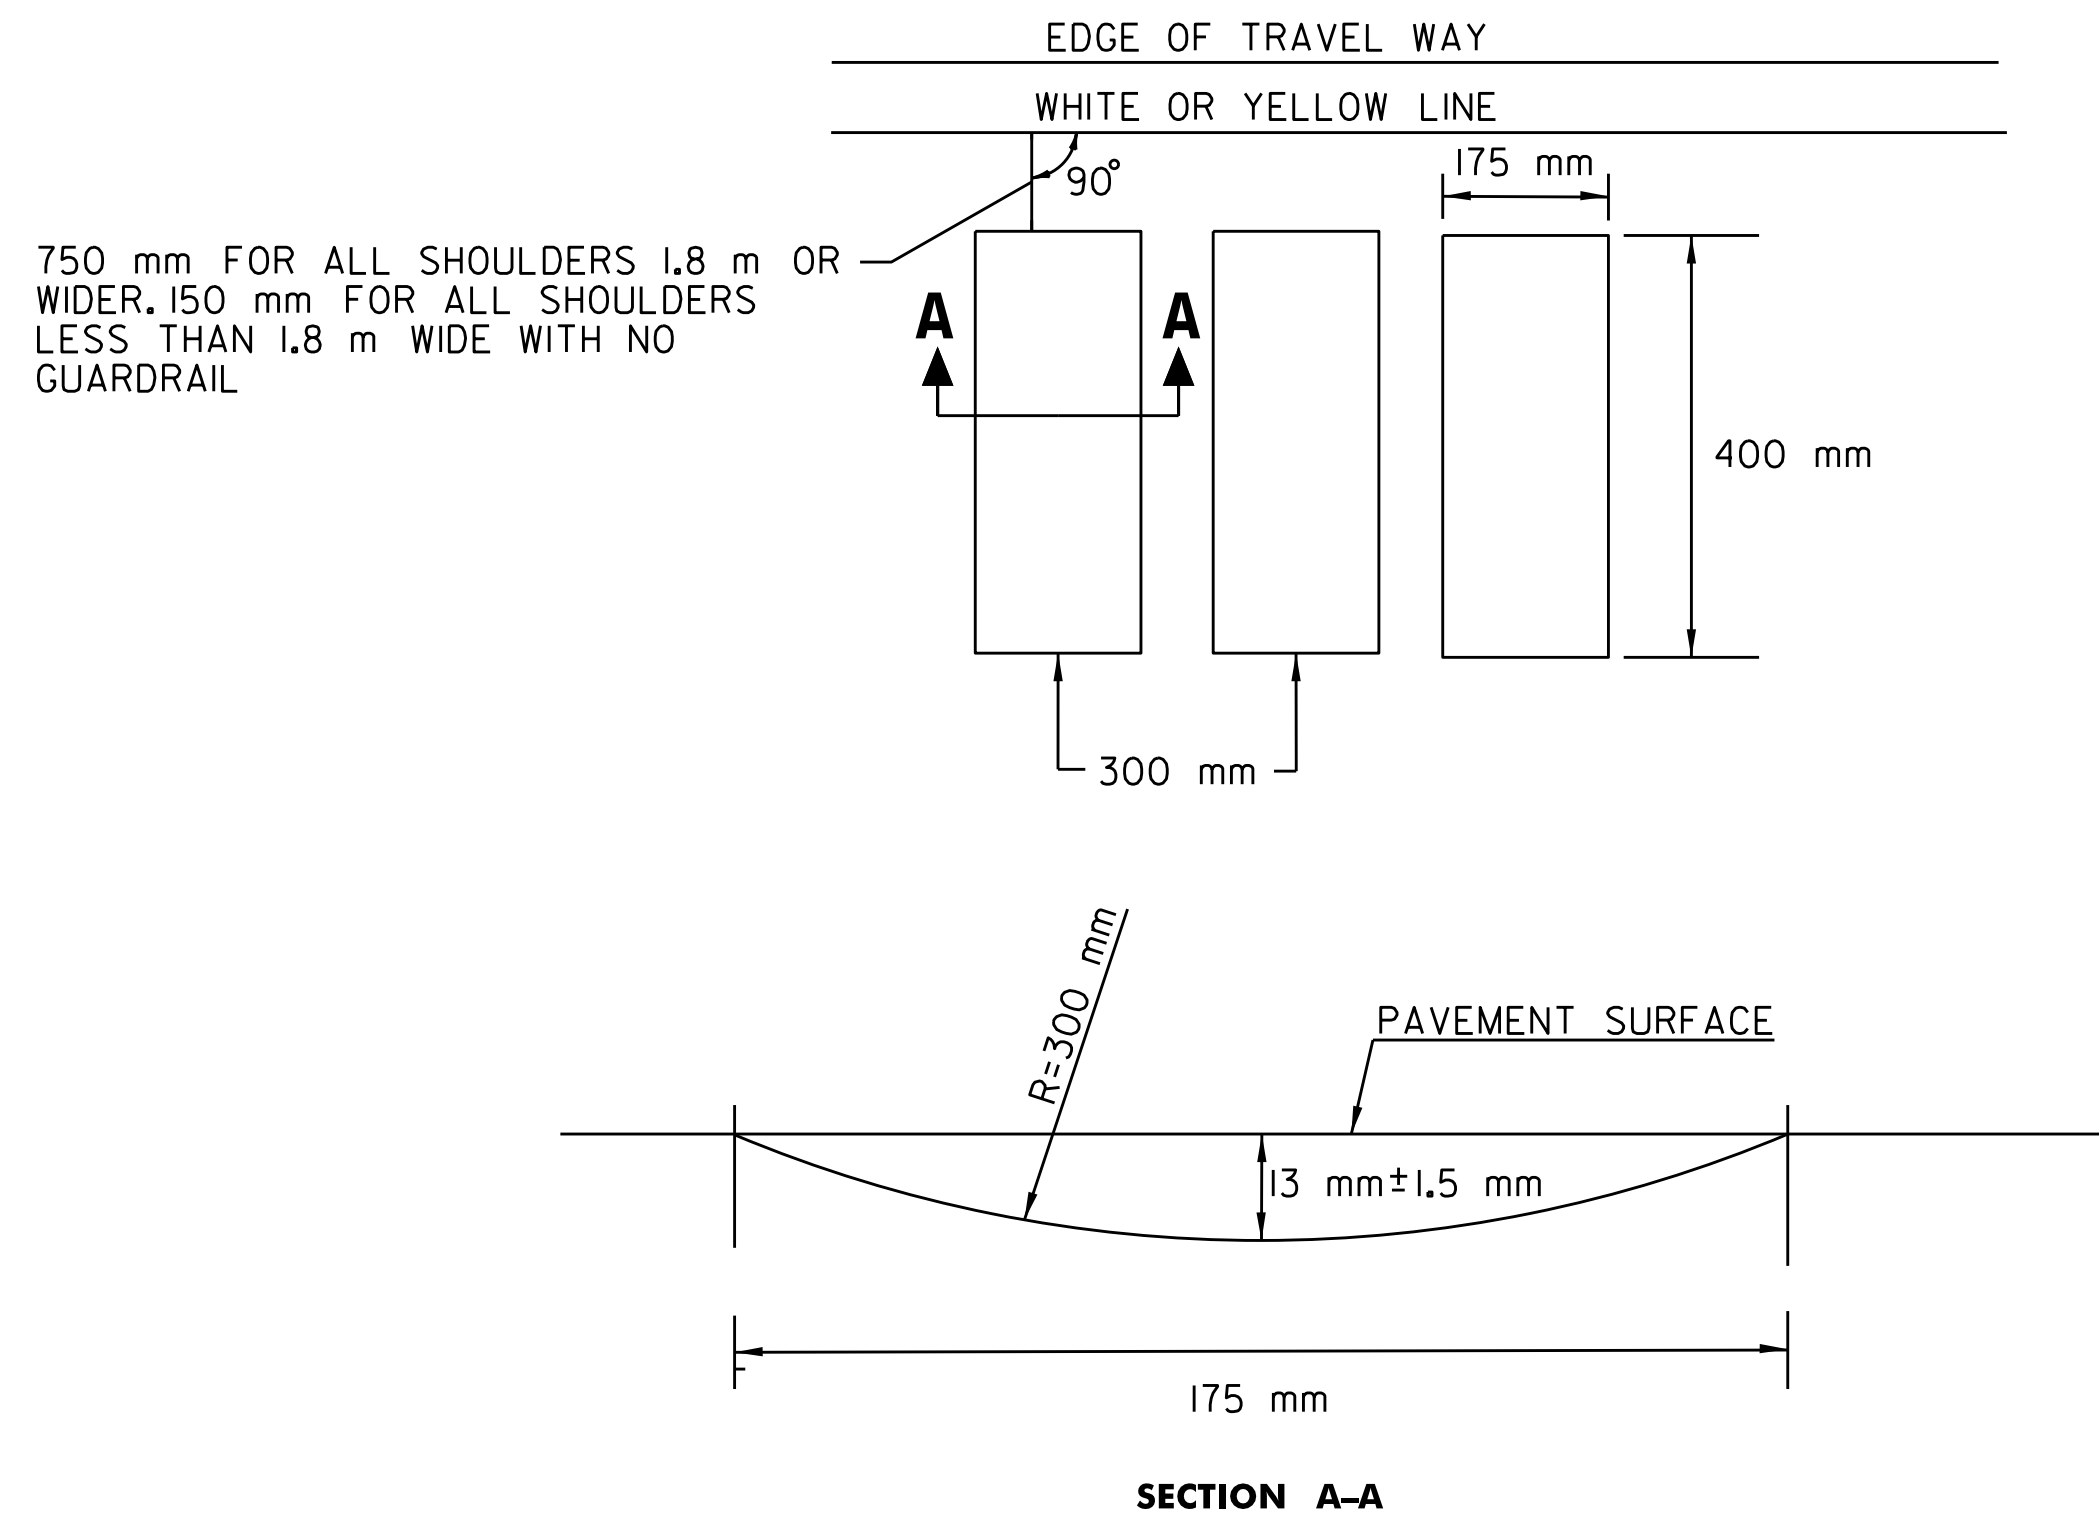

BRIDGE DETAIL

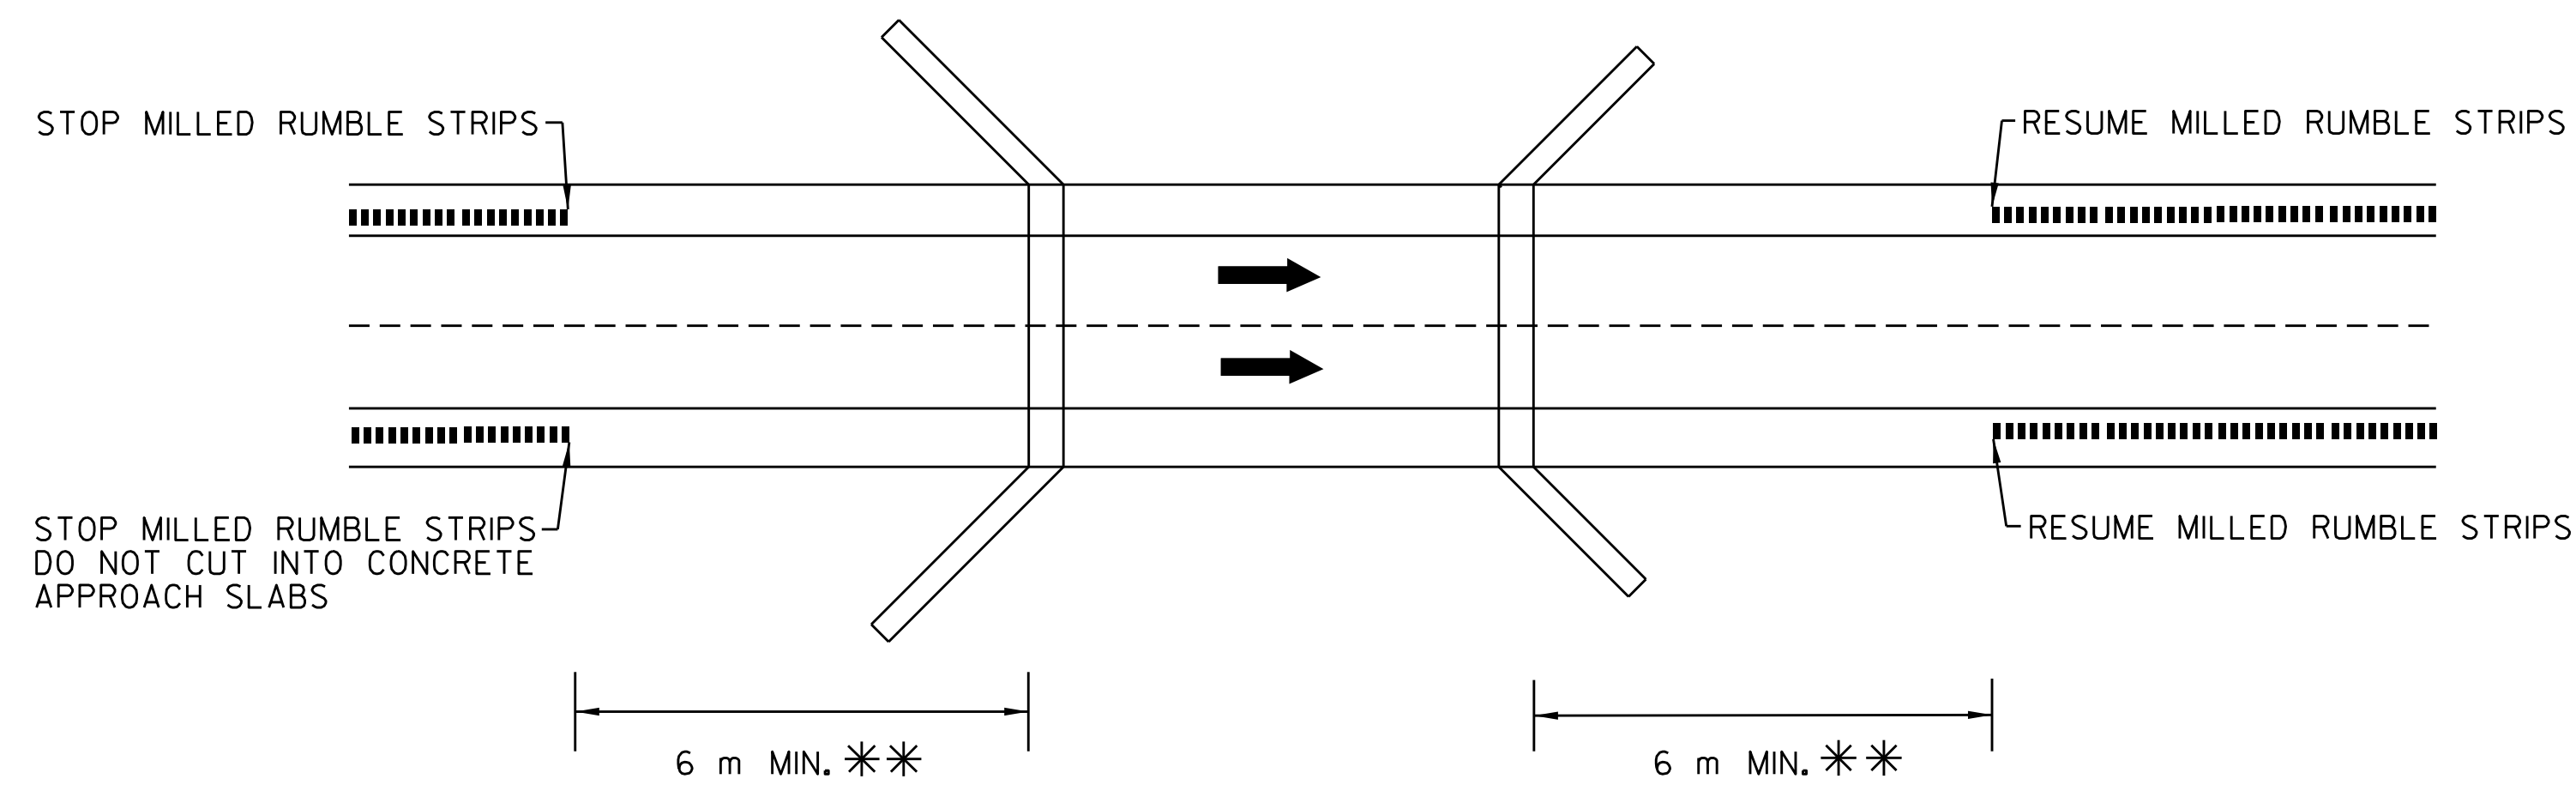

** BRIDGE RAIL WILL DETERMINE MINIMUM DISTANCE IN SOME CASES.

NOTE:

MILLED RUMBLE STRIPS WILL NOT BE REQUIRED IN GUARDRAIL AREAS ADJACENT TO THE 1.2 m SHOULDER.

LEGEND

- DIRECTION OF TRAFFIC FLOW
- MILLED RUMBLE STRIPS

DATUM	
VERTICAL	N/A
HORIZONTAL	N/A

MILLED RUMBLE STRIP DETAIL SHEET #2

DESIGNED BY	_____	DATE	10-02
DRAWN BY	_____	DATE	10-02
DESIGN FILE NO	pave/03a040A/03a040A.dgn		
PRF FILE	p03a040Ars2.i	DATE PLOTTED	31-OCT-2011 16:04
PROJ. NAME	WATERBURY - BOLTON		
PROJ. NO.	IM 089-2(33)		
SHEET	15	OF	16 SHEETS