

INDEX OF SHEETS

1. TITLE SHEET
2. GENERAL NOTES AND EXISTING PIER DETAILS
3. PIER 1 AND 4 PROPOSED TYPICAL SPLINT/REINFORCEMENT DETAILS
4. PIER 2 AND 3 PROPOSED TYPICAL SPLINT/REINFORCEMENT DETAILS
5. PROPOSED CONNECTION AND FOOTING DETAILS
6. EROSION CONTROL NARRATIVE
7. EROSION CONTROL PLAN
8. EROSION CONTROL DETAILS
- 9.-15. ORIGINAL CONSTRUCTION PLANS (RECORD 1958)


LIST OF STANDARDS

E-100	CONSTRUCTION APPROACH SIGNS	1/2/04
E-100A	SIDE ROAD CONSTRUCTION-APPROACH SIGNS	1/2/04
E-101	CONSTRUCTION SIGN DETAILS	5/30/03
E-102	CONSTRUCTION SIGN DETAILS	6/30/03
E-102A	CONSTRUCTION SIGN DETAILS	8/8/95
E-103	MAINLINE TRAFFIC CONTROL DIVIDED HIGHWAY ONE LANE CLOSED	3/01/04
E-107	DELINEATION, BARRICADES AND DETOURS FOR CONSTRUCTION AREAS	6/30/03
E-107A	BREAKAWAY BARRICADE DETAILS	8/8/95
E-198	FREEWAY-EXPRESSWAY DELINEATORS AND MILEPOSTS	4/14/97
T-1	TEMPORARY EROSION CONTROL DETAILS	6/1/94
T-2	TEMPORARY EROSION CONTROL DETAILS	6/1/94


LIST OF QUANTITIES

ITEM NUMBER	DESCRIPTION	UNIT	TOTAL QUANTITIES		ROUND	FINAL
			BRIDGE	EROSION CONTROL		
204.30	GRANULAR BACKFILL FOR STRUCTURES (MOD.)	CY	35		3	
501.25	CONCRETE, CLASS B	CY	11		0.3	
506.60	STRUCTURAL STEEL (MOD. - HP 12 X 53)	LB	88500		697	
506.60	STRUCTURAL STEEL (CHANNELS AND TENSION RODS)	LB	11500		228	
507.15	REINFORCING STEEL	LB	925		24	
608.26	ALL PURPOSE EXCAVATOR RENTAL, TYPE II	HR	64		EST.	
613.10	STONE FILL, TYPE I (MOD. - CRUSHED STONE BERMS)	CY		10	EST.	
620.70	SNOW FENCE (MOD. - PDF)	LF		1000	35	
630.10	UNIFORMED TRAFFIC OFFICERS	HR	40		EST.	
630.15	FLAGGERS	HR	80		EST.	
635.10	MOBILIZATION	LS	1		-	
641.10	TRAFFIC CONTROL	LS	1		-	
649.51	GEOTEXTILE FOR SILT FENCE	SY		50	EST.	
651.15	SEED	LB		30	EST.	
651.18	FERTILIZER	LB		250	EST.	
651.20	AGRICULTURAL LIMESTONE	TON		1	EST.	
651.25	HAY MULCH	TON		1	EST.	
651.27	CEDAR BARK MULCH (MOD.)	CY		20	EST.	
652.10	EROSION PREVENTION & SEDIMENT CONTROL PLAN	LS		1	-	
652.20	MONITORING EROSION PREVENTION & SEDIMENT CONTROL PLAN	HR		20	EST.	
652.30	MAINTENANCE OF EROSION PREVENTION & SEDIMENT CONTROL PLAN (N. A. B. I.)	LU		1	-	
654.10	EROSION MATTING	SY		100	EST.	

# STATE OF VERMONT AGENCY OF TRANSPORTATION

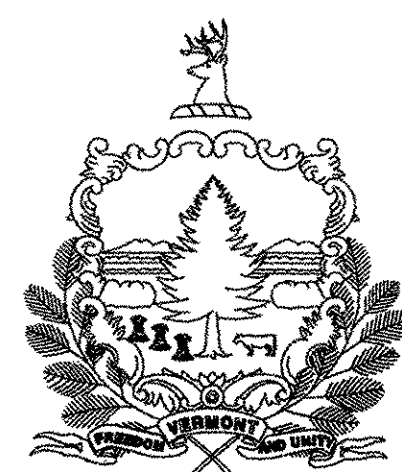

## PROPOSED IMPROVEMENT BRIDGE PROJECT TOWN OF BRATTLEBORO COUNTY OF WINDHAM INTERSTATE ROUTE 91 BRIDGE NO. 6N AND 6S

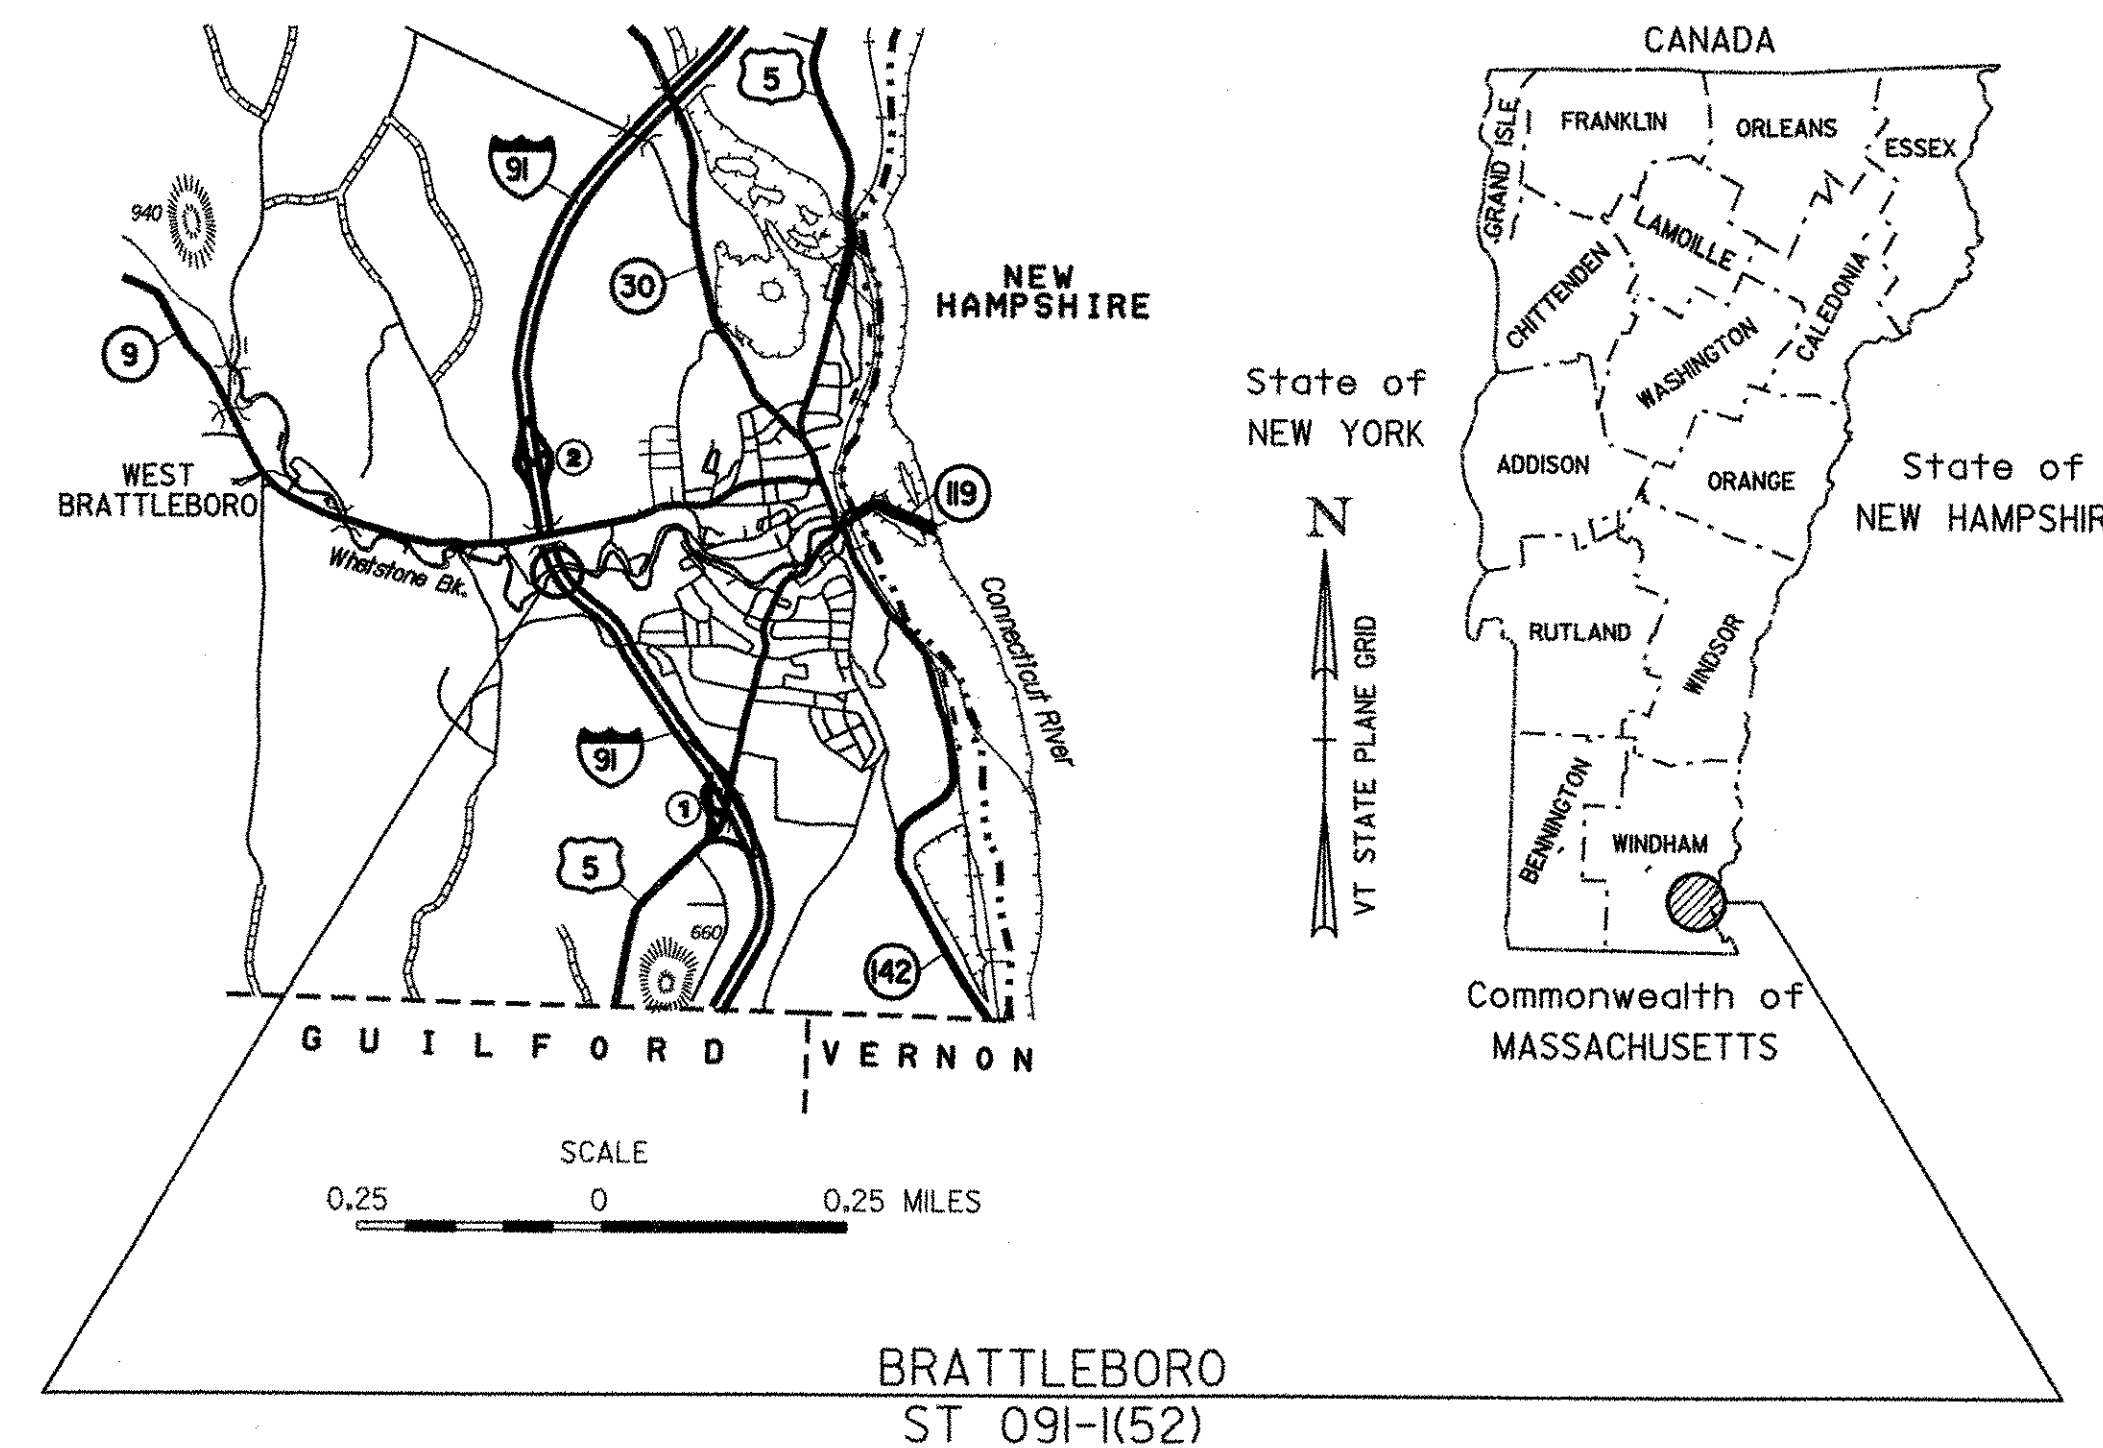

**PROJECT LOCATION**  
BEGINNING AT A POINT 0.549 MILES NORTH OF THE GUILFORD - BRATTLEBORO TOWN LINE AND EXTENDING NORTHERLY ALONG INTERSTATE 91 FOR A DISTANCE OF 0.079 MILES.

**PROJECT DESCRIPTION**  
WORK TO BE PERFORMED UNDER THIS PROJECT INCLUDES THE SHORING AND REINFORCEMENT OF THE EASTERLY PIER COLUMNS FOR BRIDGES 6N AND 6S.


LENGTH OF PROJECT: 415.00 FEET

**BUILT AS DESIGNED**

**CONVENTIONAL SYMBOLS**

COUNTY LINE	
TOWN LINE	
LIMITS OF ACCESS	
POINT OF ACCESS	
FENCE LINE	
STONE WALL	
TRAVELED WAY	
GUARD RAIL	
RAILROAD	
SURVEY LINE	
CULVERT	
POWER POLE	
TELEPHONE POLE	
TREES	
CONTROL OF ACCESS	
PROPERTY LINE	
R.O.W. TAKING LINE	
SLOPE RIGHTS	
TOP OF CUT	
TOE OF SLOPE	

SURVEYED BY :	N. A.
SURVEYED DATE :	N. A.
DATUM	
VERTICAL	N. A.
HORIZONTAL	N. A.

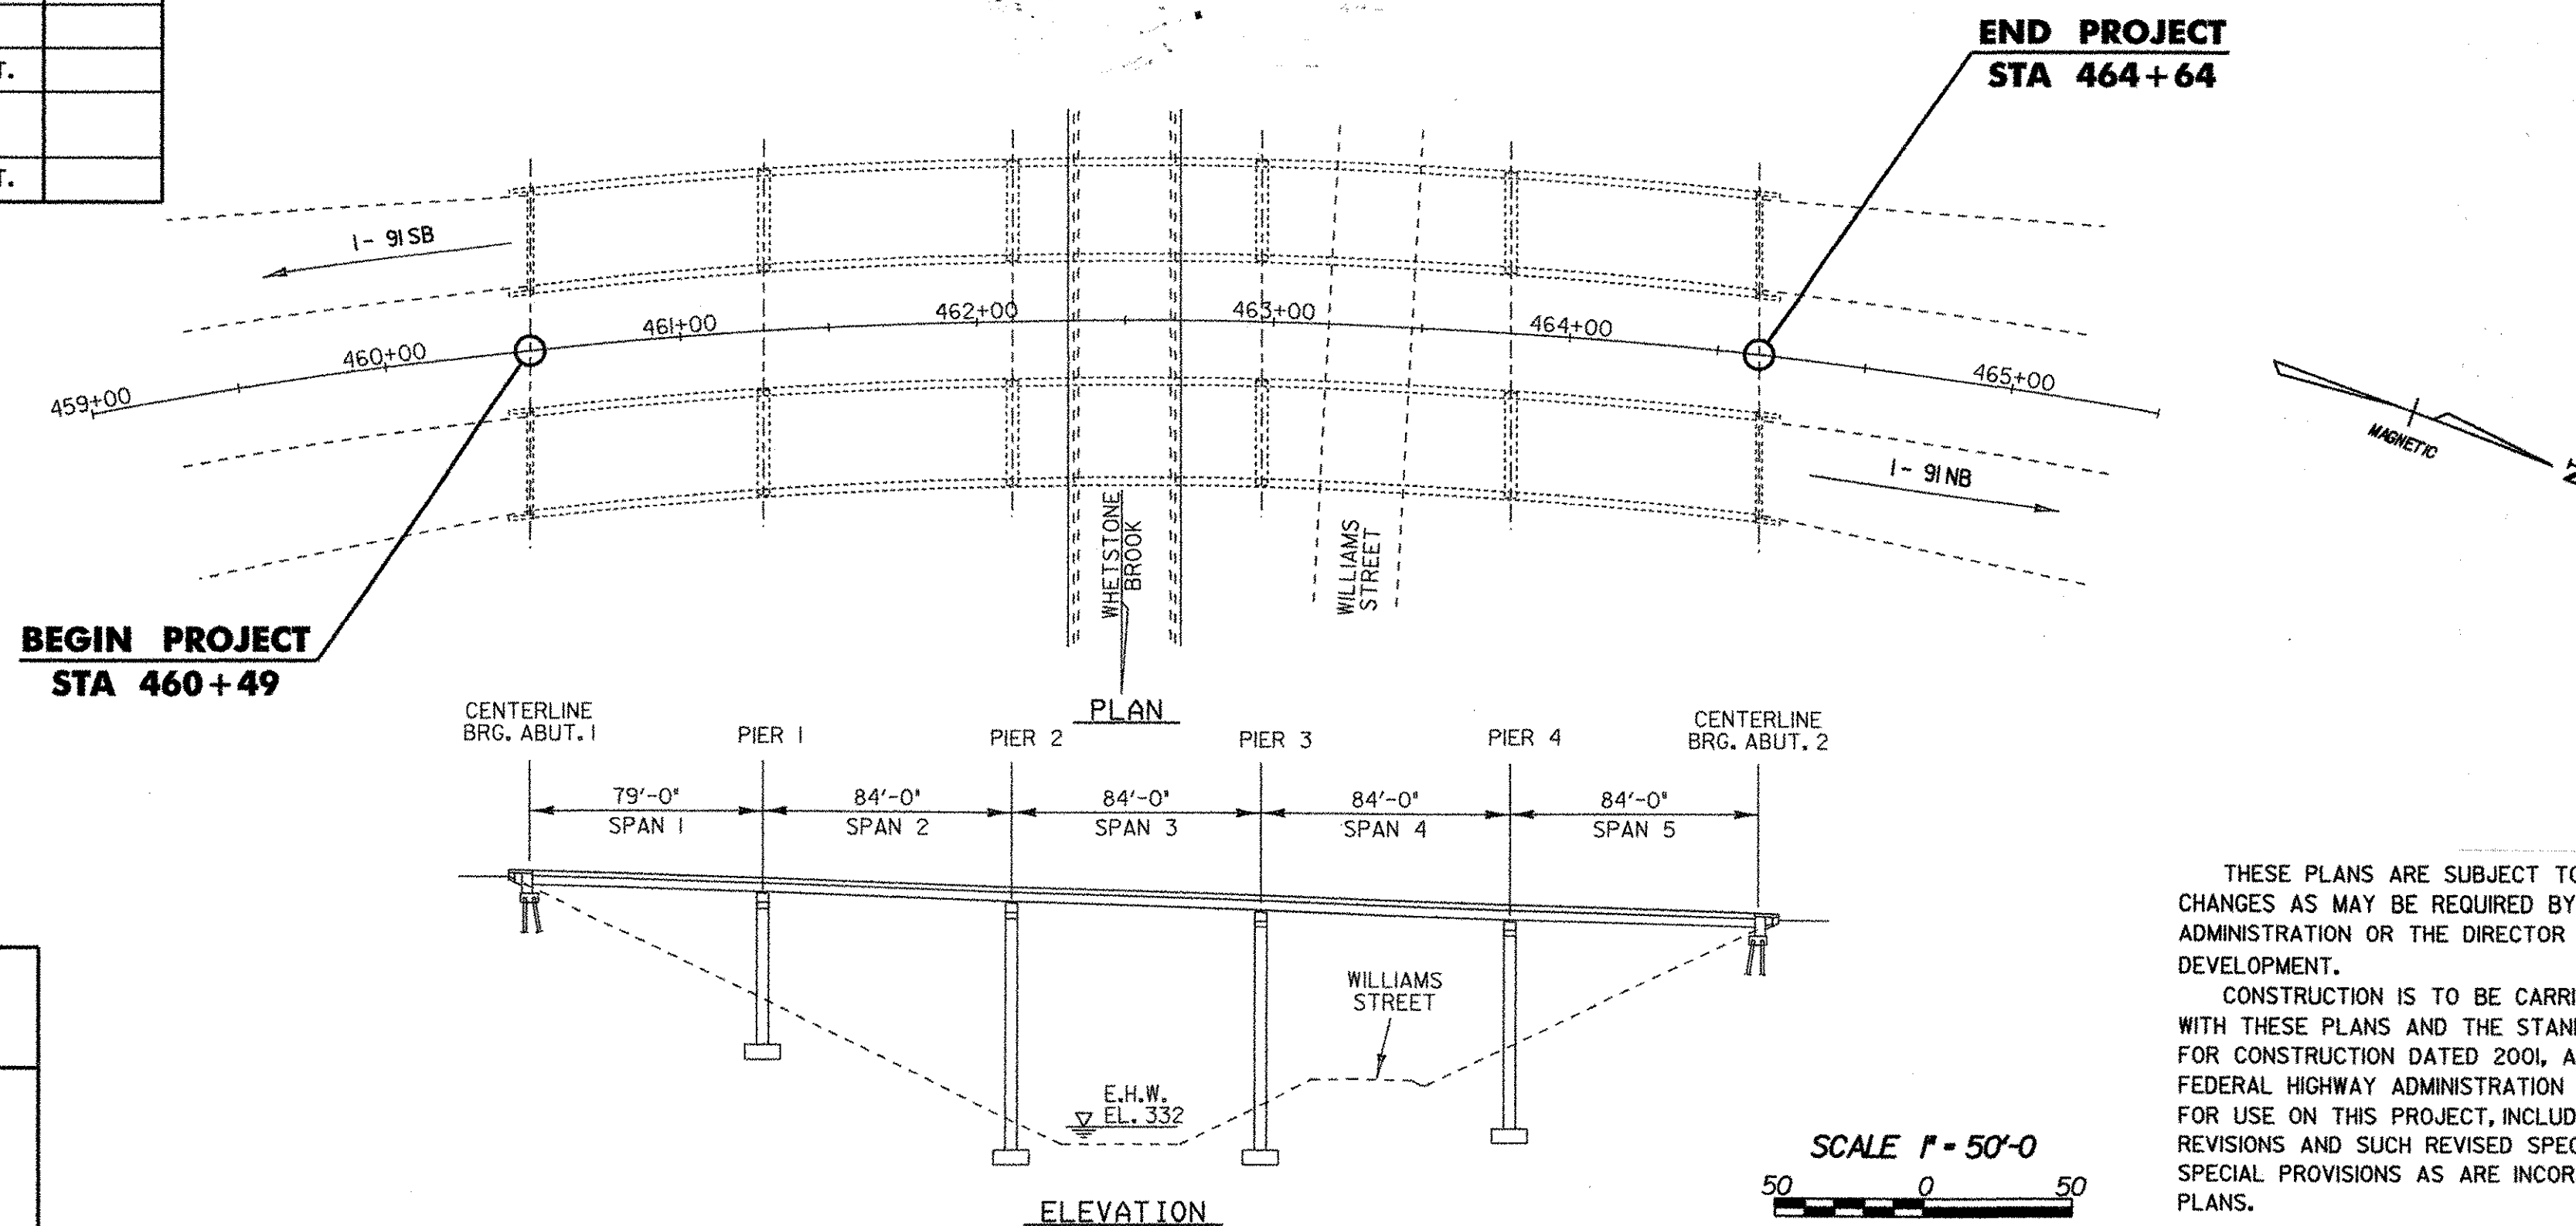

**RECORD PLANS**

CONTRACTOR: KUBRICKY CONSTRUCTION CORP. - GLENS FALLS, NY

RESIDENT ENGINEER: FRED ROSS

CONSTRUCTION BEGAN: SEPTEMBER 13, 2004

CONSTRUCTION COMPLETE: OCTOBER 6, 2004

RECORD PLANS BY: FRED ROSS & N. GARBACIK

I HEREBY CERTIFY THAT ALL THE CONSTRUCTION REQUIRED BY THIS SET OF DRAWINGS HAS BEEN ACCOMPLISHED AS INDICATED HEREIN.

BY: *Fred W. Ross III* RESIDENT ENGINEER  
DATE: 1-23-07

NOTE: Any further information concerning final quantities, amounts or other details relative to this project may be found at Central Files in the electronic archives.

THESE PLANS ARE SUBJECT TO SUCH ENGINEERING CHANGES AS MAY BE REQUIRED BY THE FEDERAL HIGHWAY ADMINISTRATION OR THE DIRECTOR OF PROGRAM DEVELOPMENT.

CONSTRUCTION IS TO BE CARRIED ON IN ACCORDANCE WITH THESE PLANS AND THE STANDARD SPECIFICATIONS FOR CONSTRUCTION DATED 2001, AS APPROVED BY THE FEDERAL HIGHWAY ADMINISTRATION ON JANUARY 4, 2001 FOR USE ON THIS PROJECT, INCLUDING ALL SUBSEQUENT REVISIONS AND SUCH REVISED SPECIFICATIONS AND SPECIAL PROVISIONS AS ARE INCORPORATED IN THESE PLANS.

DIRECTOR OF PROGRAM DEVELOPMENT	APPROVED: <i>[Signature]</i> DATE: 4/28/04
PROJECT MANAGER :	S. FARNSWORTH
PROJECT NAME :	BRATTLEBORO
PROJECT NUMBER :	ST 091-1(52)
SHEET 1 OF 15 SHEETS	