


Weight of Hammer = 350#  
 Drop of Hammer = 24"  
 Diameter of Casing = 2 1/2"  
 Thickness of Shell = 3/8"


For Location of Borings, See 1" = 20' 0" Plan Sheet

**FOUNDATION INFORMATION**


Obtained for design purposes only, and the State assumes no responsibility whatsoever for the sufficiency or accuracy of the information shown. Boulders may be encountered at any pier or abutment location.

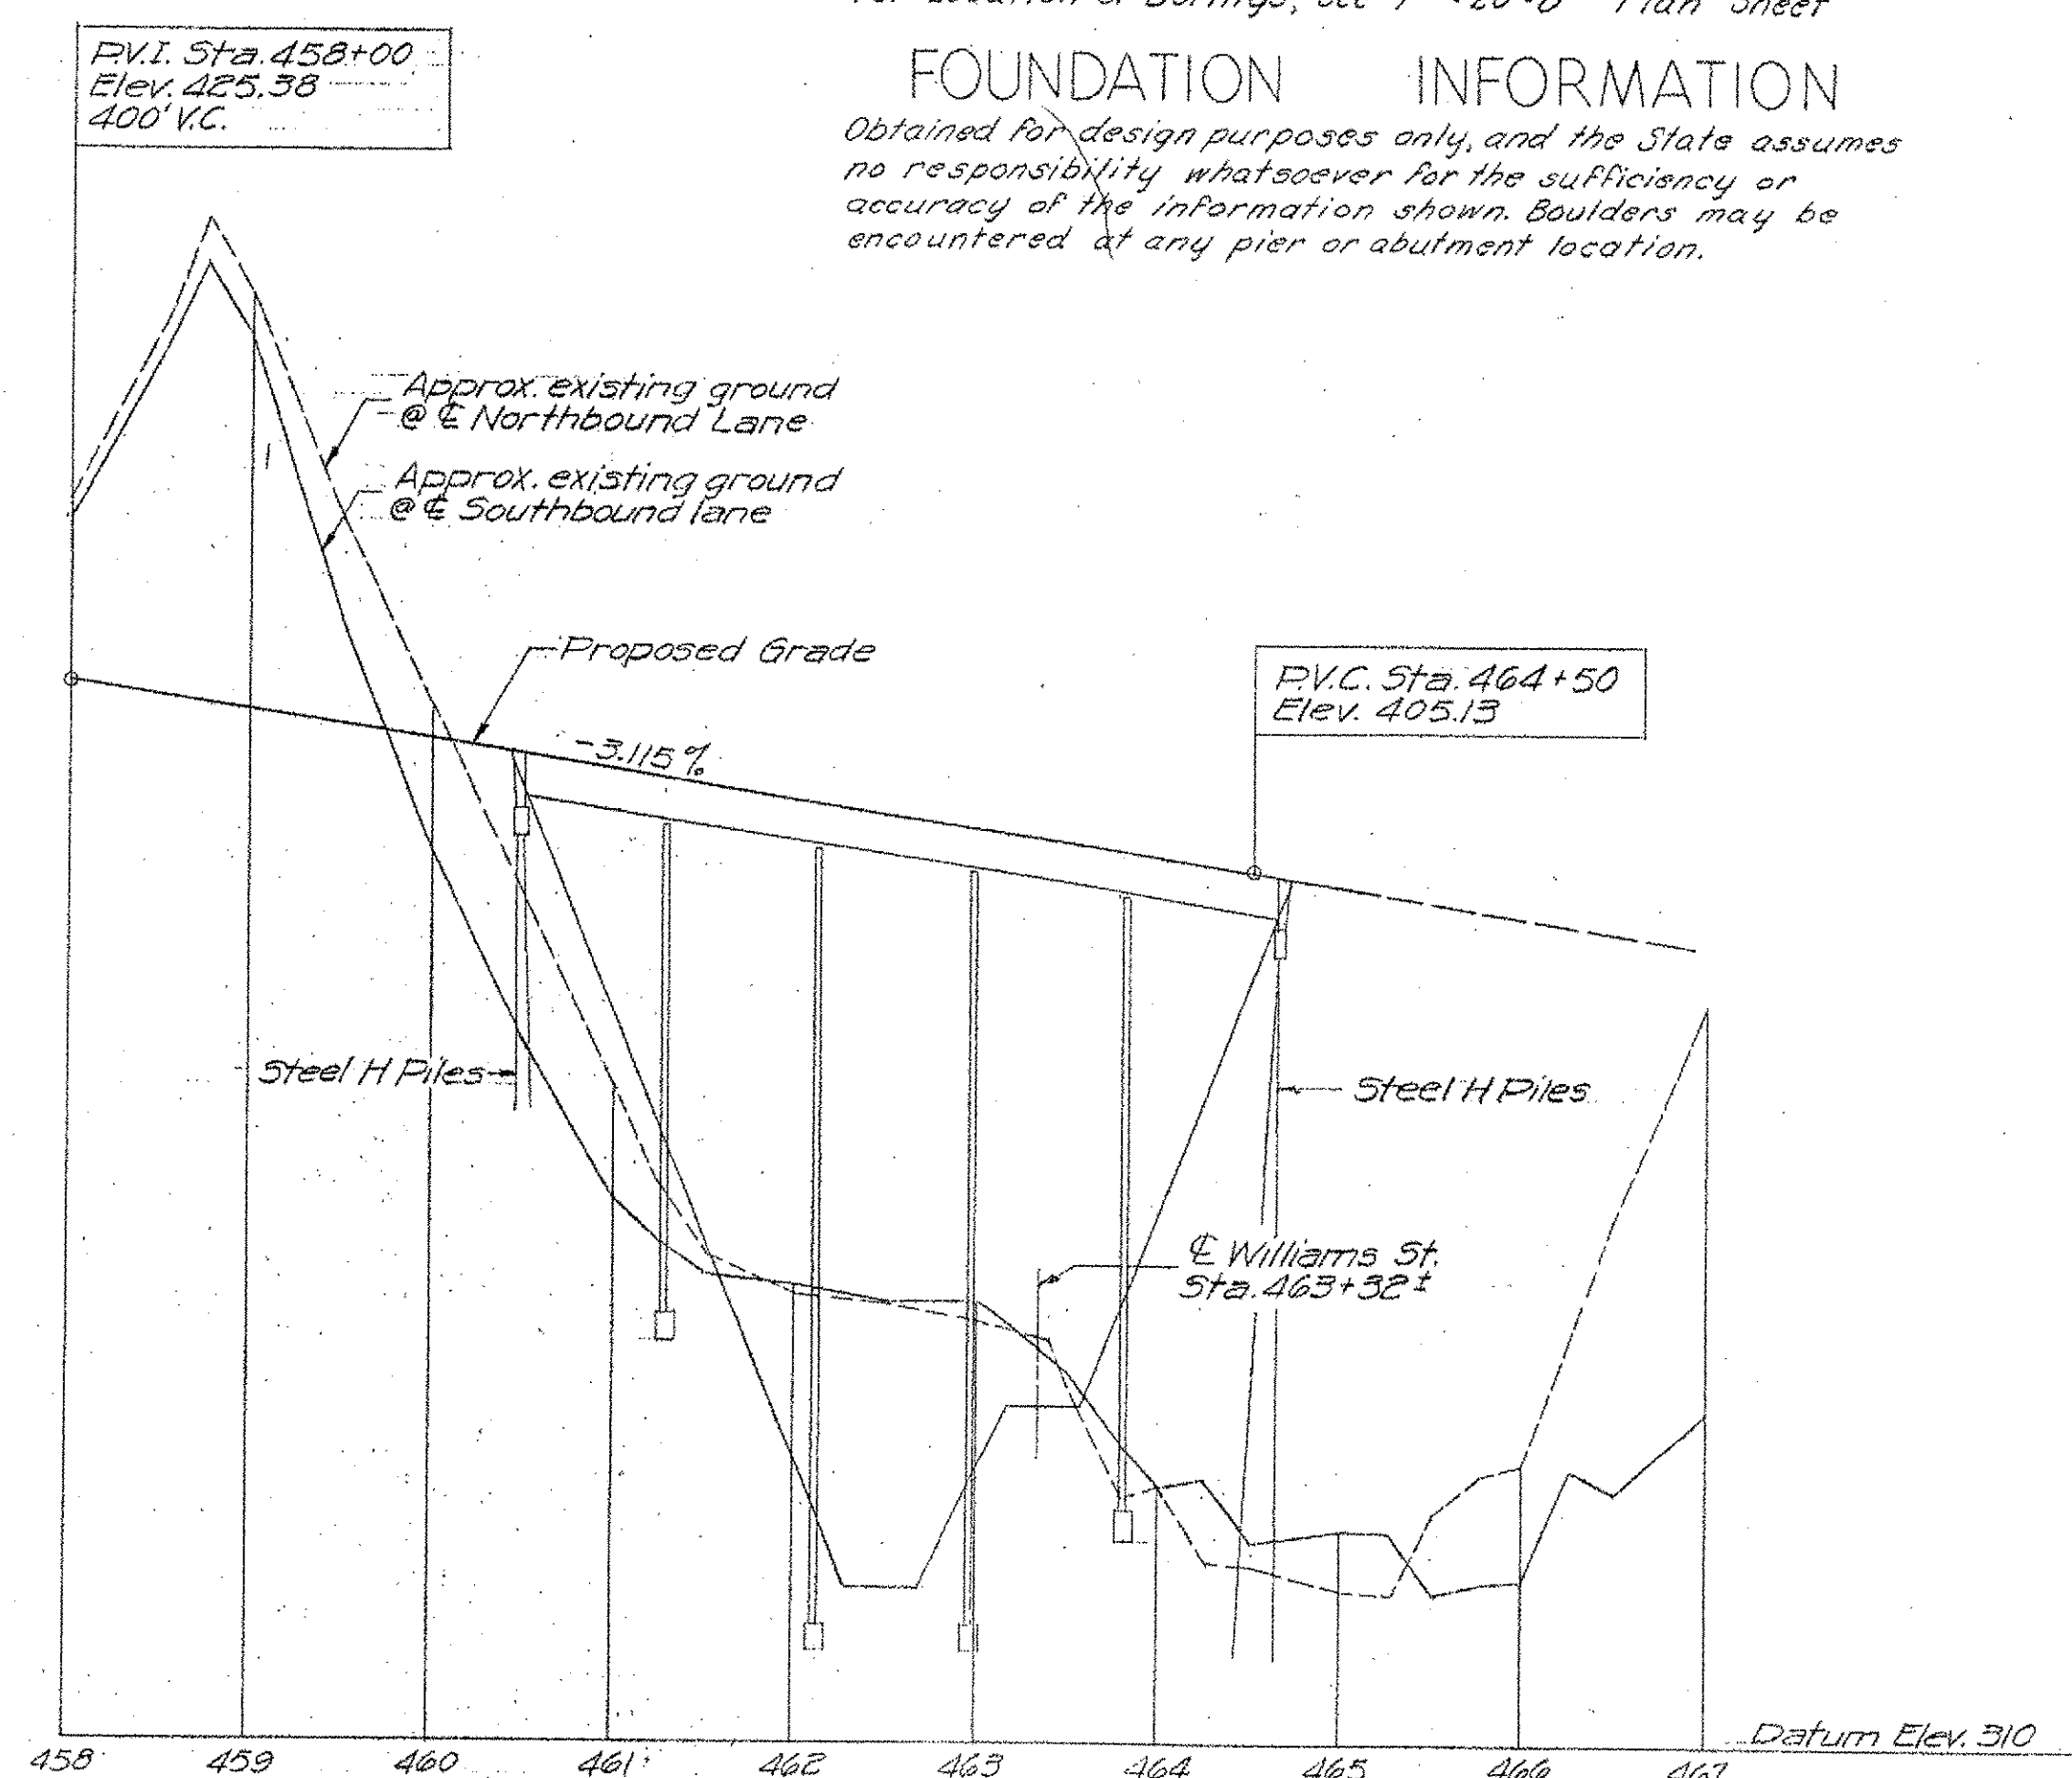


PROFILE ROUTE 1

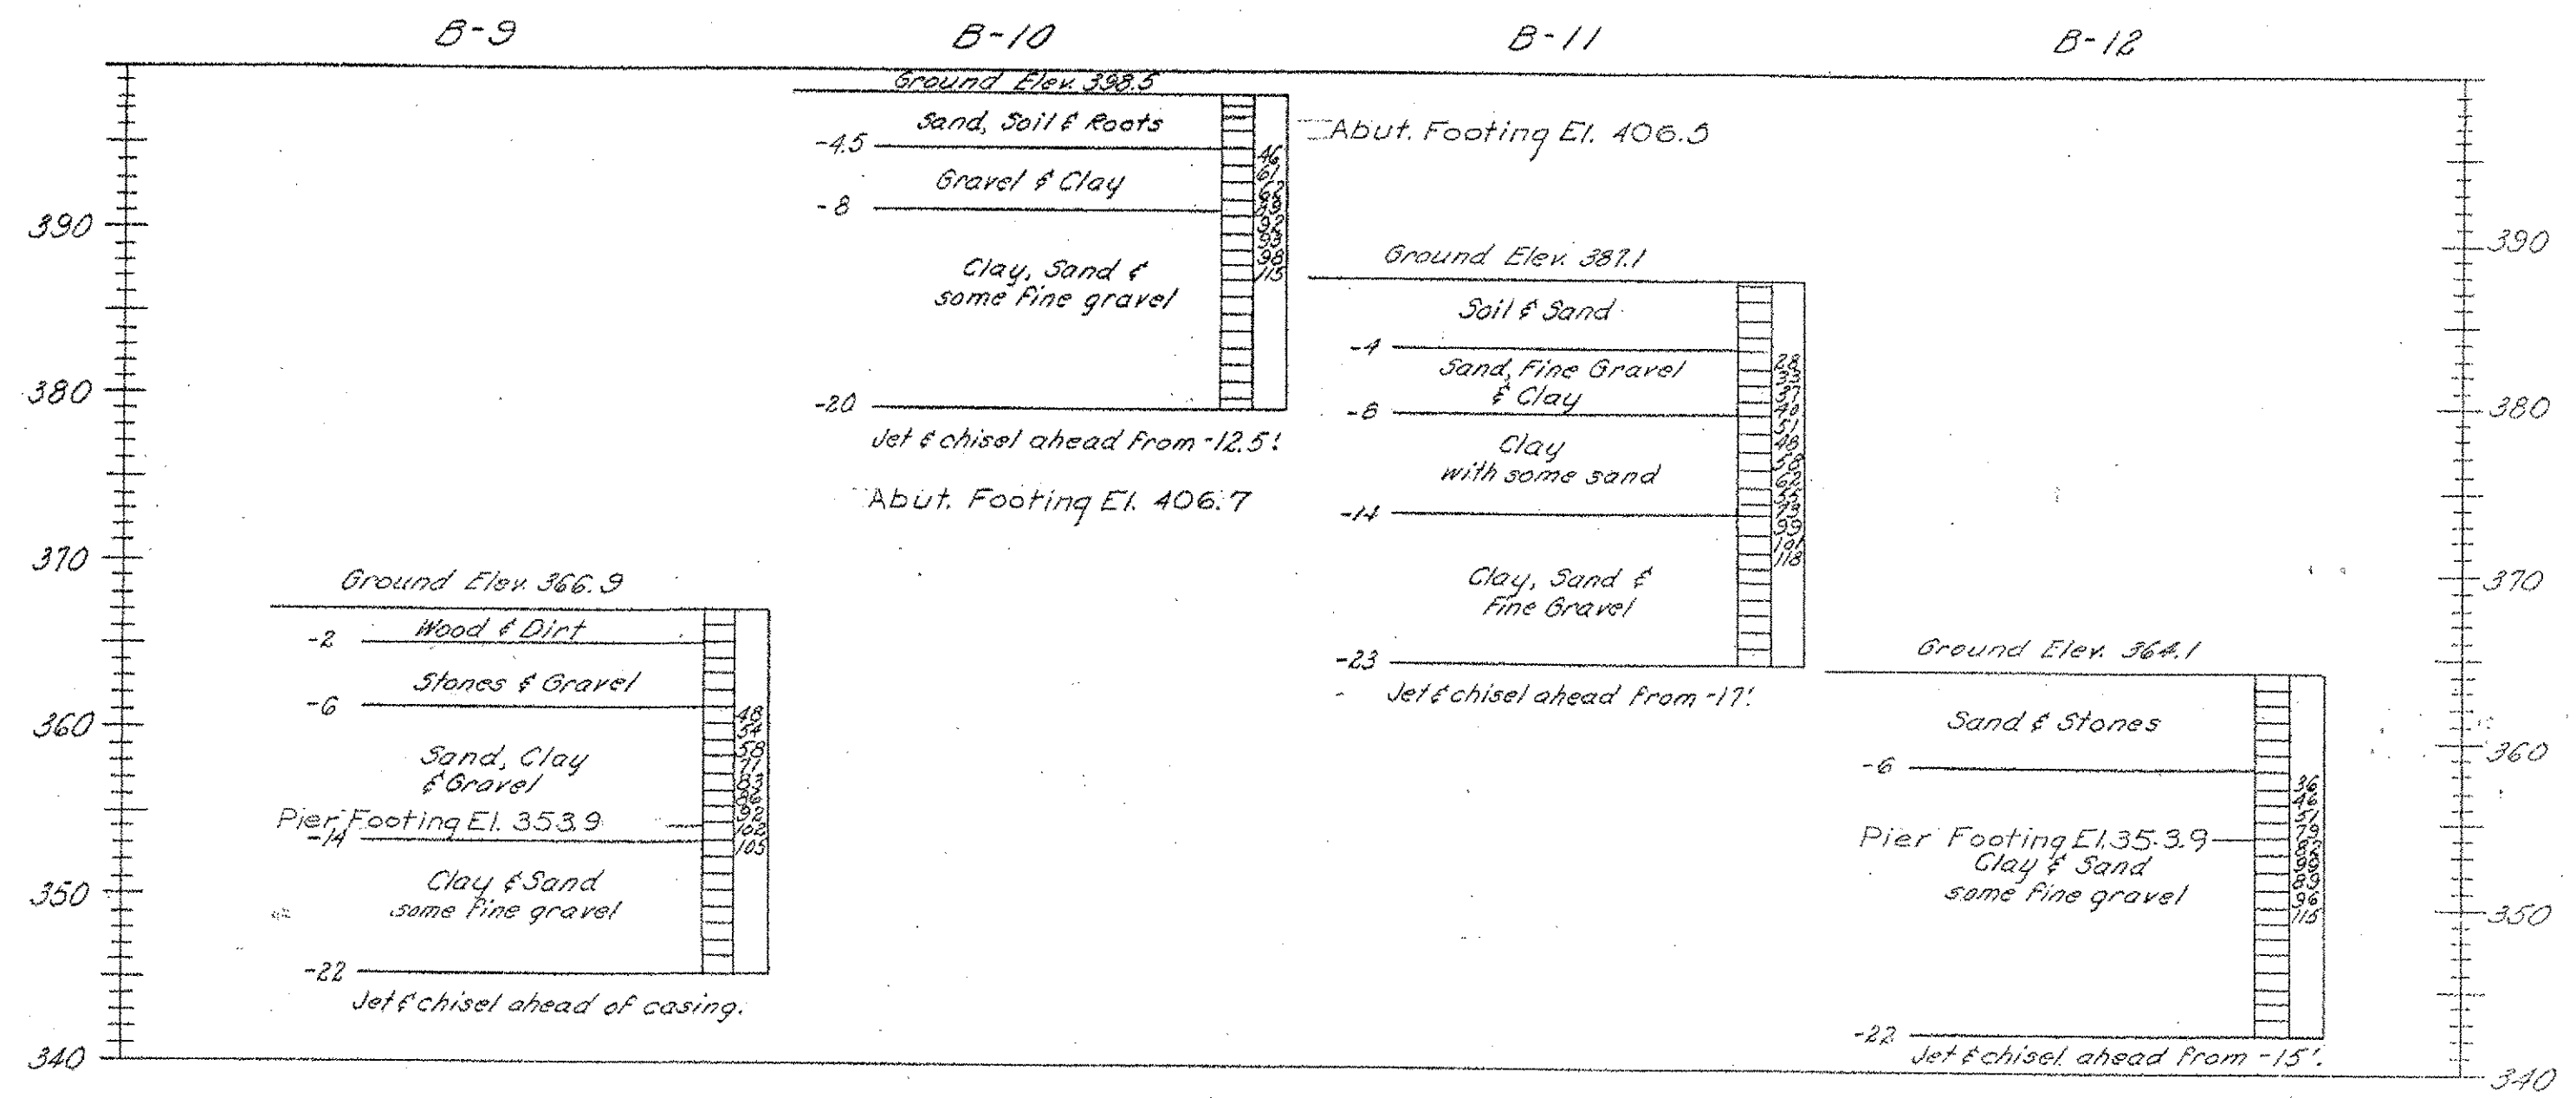


PROFILE WILLIAMS STREET

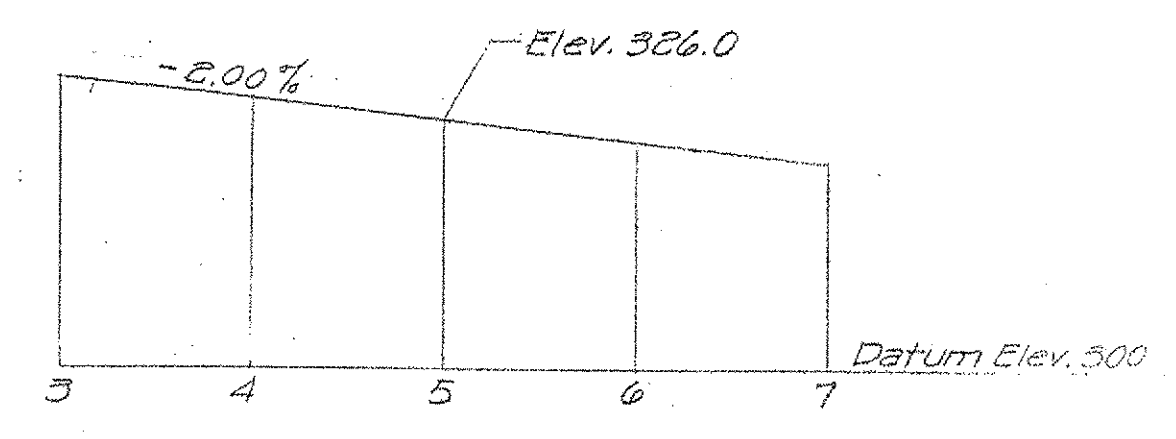

PROFILE OF PROPOSED STREAM CHANNEL

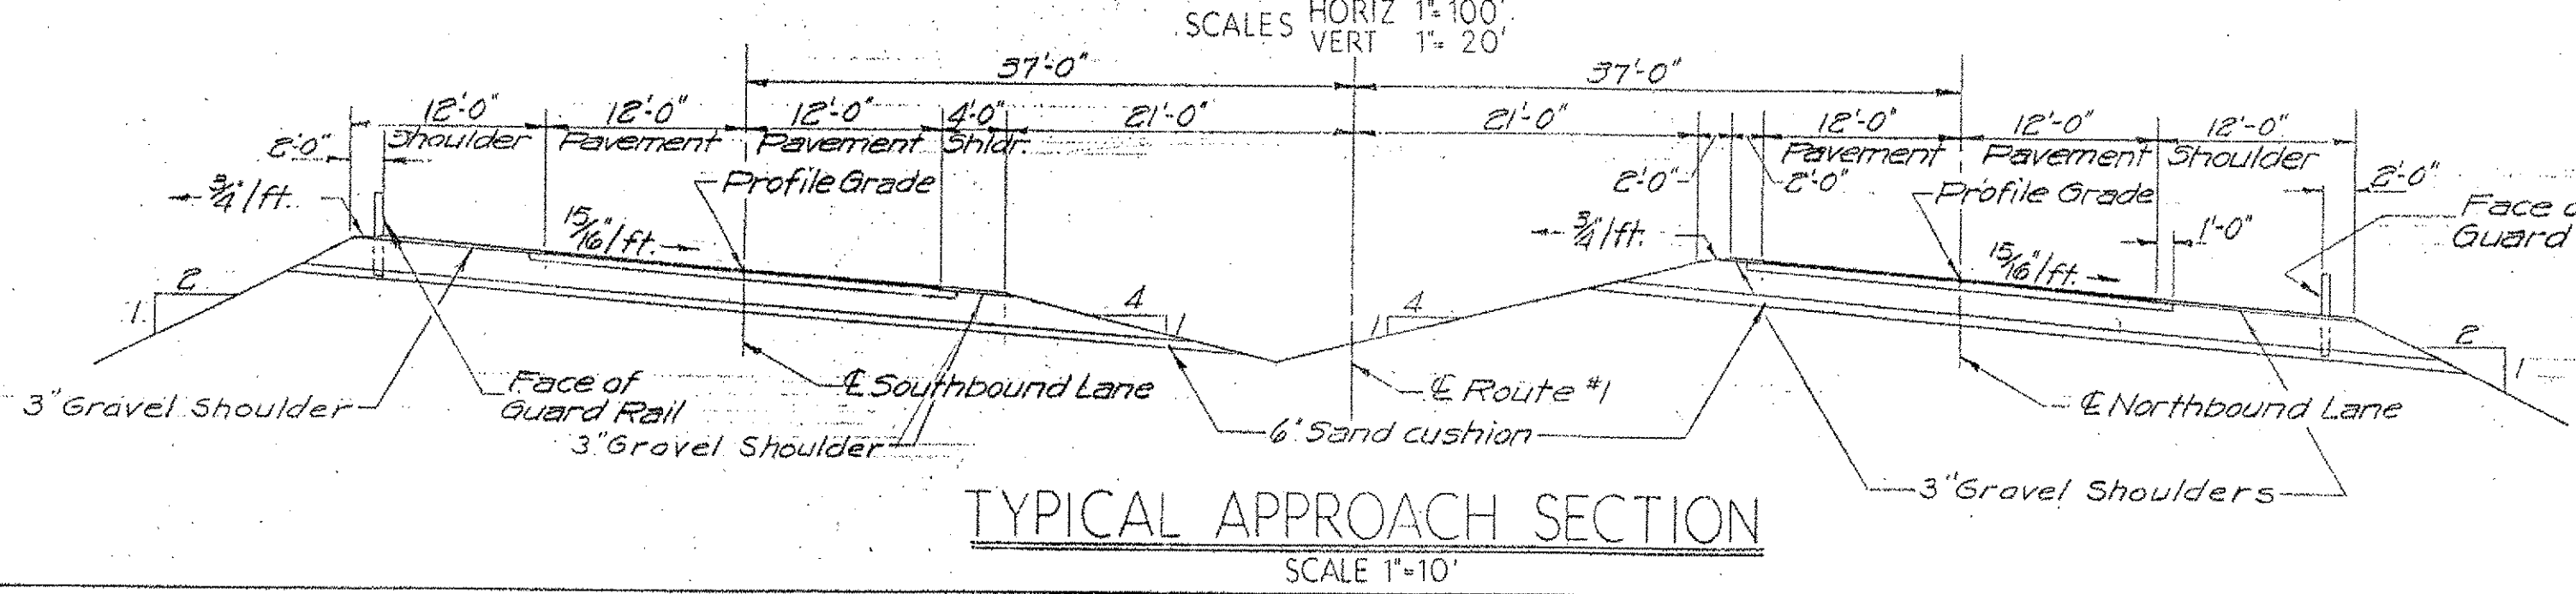

TYPICAL APPROACH SECTION

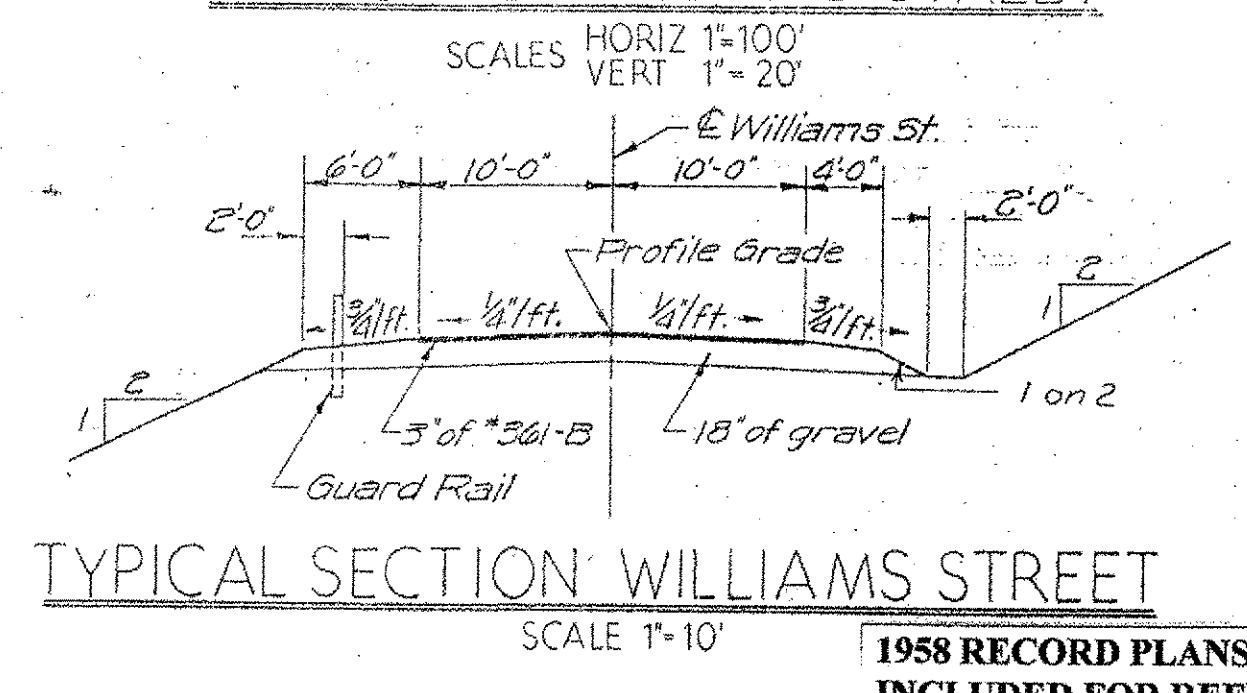

TYPICAL SECTION WILLIAMS STREET

VERMONT  
 STATE HIGHWAY DEPARTMENT  
 TOWN OF BRATTLEBORO  
 INTERSTATE ROUTE 1

WHETSTONE BROOK BRIDGE  
 BORING LOGS, PROFILES  
 & SECTIONS

WM.H. Mc FARLAND  
 ENGINEER  
 BINGHAMTON, NY

DESIGNED BY: F.V.C. CHECKED BY: L.H.S. DATE: 10-3-37  
 DRAWN BY: M.A.D. C.C.B. IN CHARGE: H.S. Gales SCALE: AS SHOWN

1958 RECORD PLANS  
 INCLUDED FOR REFERENCE PURPOSES ONLY

PROJECT NO. 1- 91-1(2) SHEET 12 OF 15  
 BRIDGE SHEET 2 OF 3