

STATE OF VERMONT AGENCY OF TRANSPORTATION




PROPOSED IMPROVEMENT

TOWN OF DERBY COUNTY OF ORLEANS INTERSTATE 91


BEGINNING AT A POINT ON I-91 APPROXIMATELY 345 FEET SOUTH OF THE BORDER
IN THE SOUTHBOUND LANE, AND EXTENDING NORTHERLY 335 FEET

LENGTH OF ROADWAY = 335 FEET = 0.063 MILES
LENGTH OF PROJECT = 335 FEET = 0.063 MILES

WORK TO BE PERFORMED UNDER THIS PROJECT INCLUDES SOUTHBOUND LANE WIDENING
OF EXISTING 10' SHOULDERS TO NEW 12' TRUCK LANES, AS WELL AS NEW 6' SHOULDERS.
WORK WILL ALSO INCLUDE SUBBASE, GRADING, GUARDRAIL, AND OTHER ROADWAY RELATED
ITEMS.

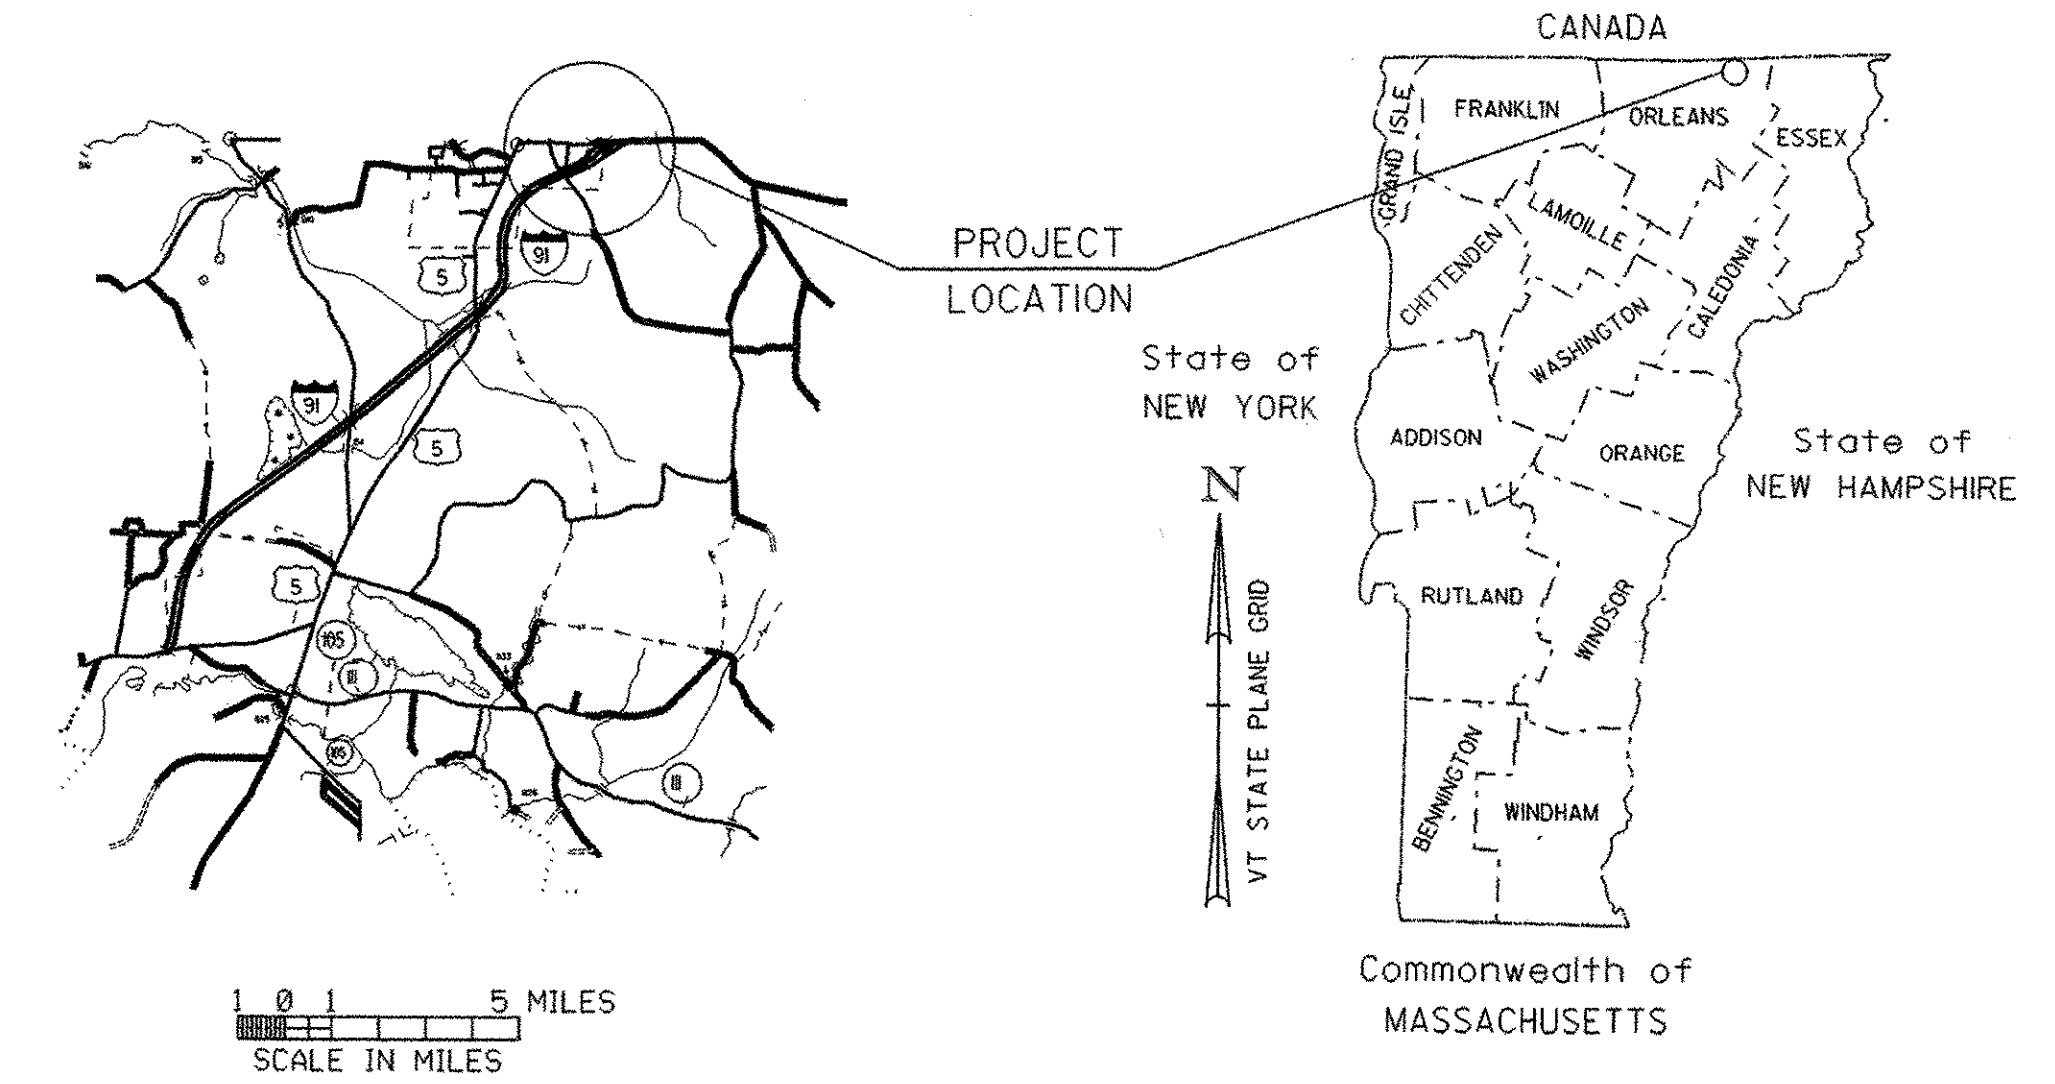


RECORD PLANS	
CONTRACTOR:	CAPITOL EARTHMOVING, INC. - BARRE, VT
RESIDENT ENGINEER:	DOUG BUMP <i>S</i>
CONSTRUCTION BEGAN:	September 21, 2006
CONSTRUCTION COMPLETE:	NOVEMBER 7, 2006
RECORD PLANS BY:	DOUG BUMPS & C. PIERCE
I HEREBY CERTIFY THAT ALL THE CONSTRUCTION REQUIRED BY THIS SET OF DRAWINGS HAS BEEN ACCOMPLISHED AS INDICATED HEREIN.	
BY:	<i>Douglas Bump</i> RESIDENT ENGINEER
DATE:	5/11/07
NOTE: Any further information concerning final quantities, amounts or other details relative to this project may be found at Central Files in the electronic archives.	

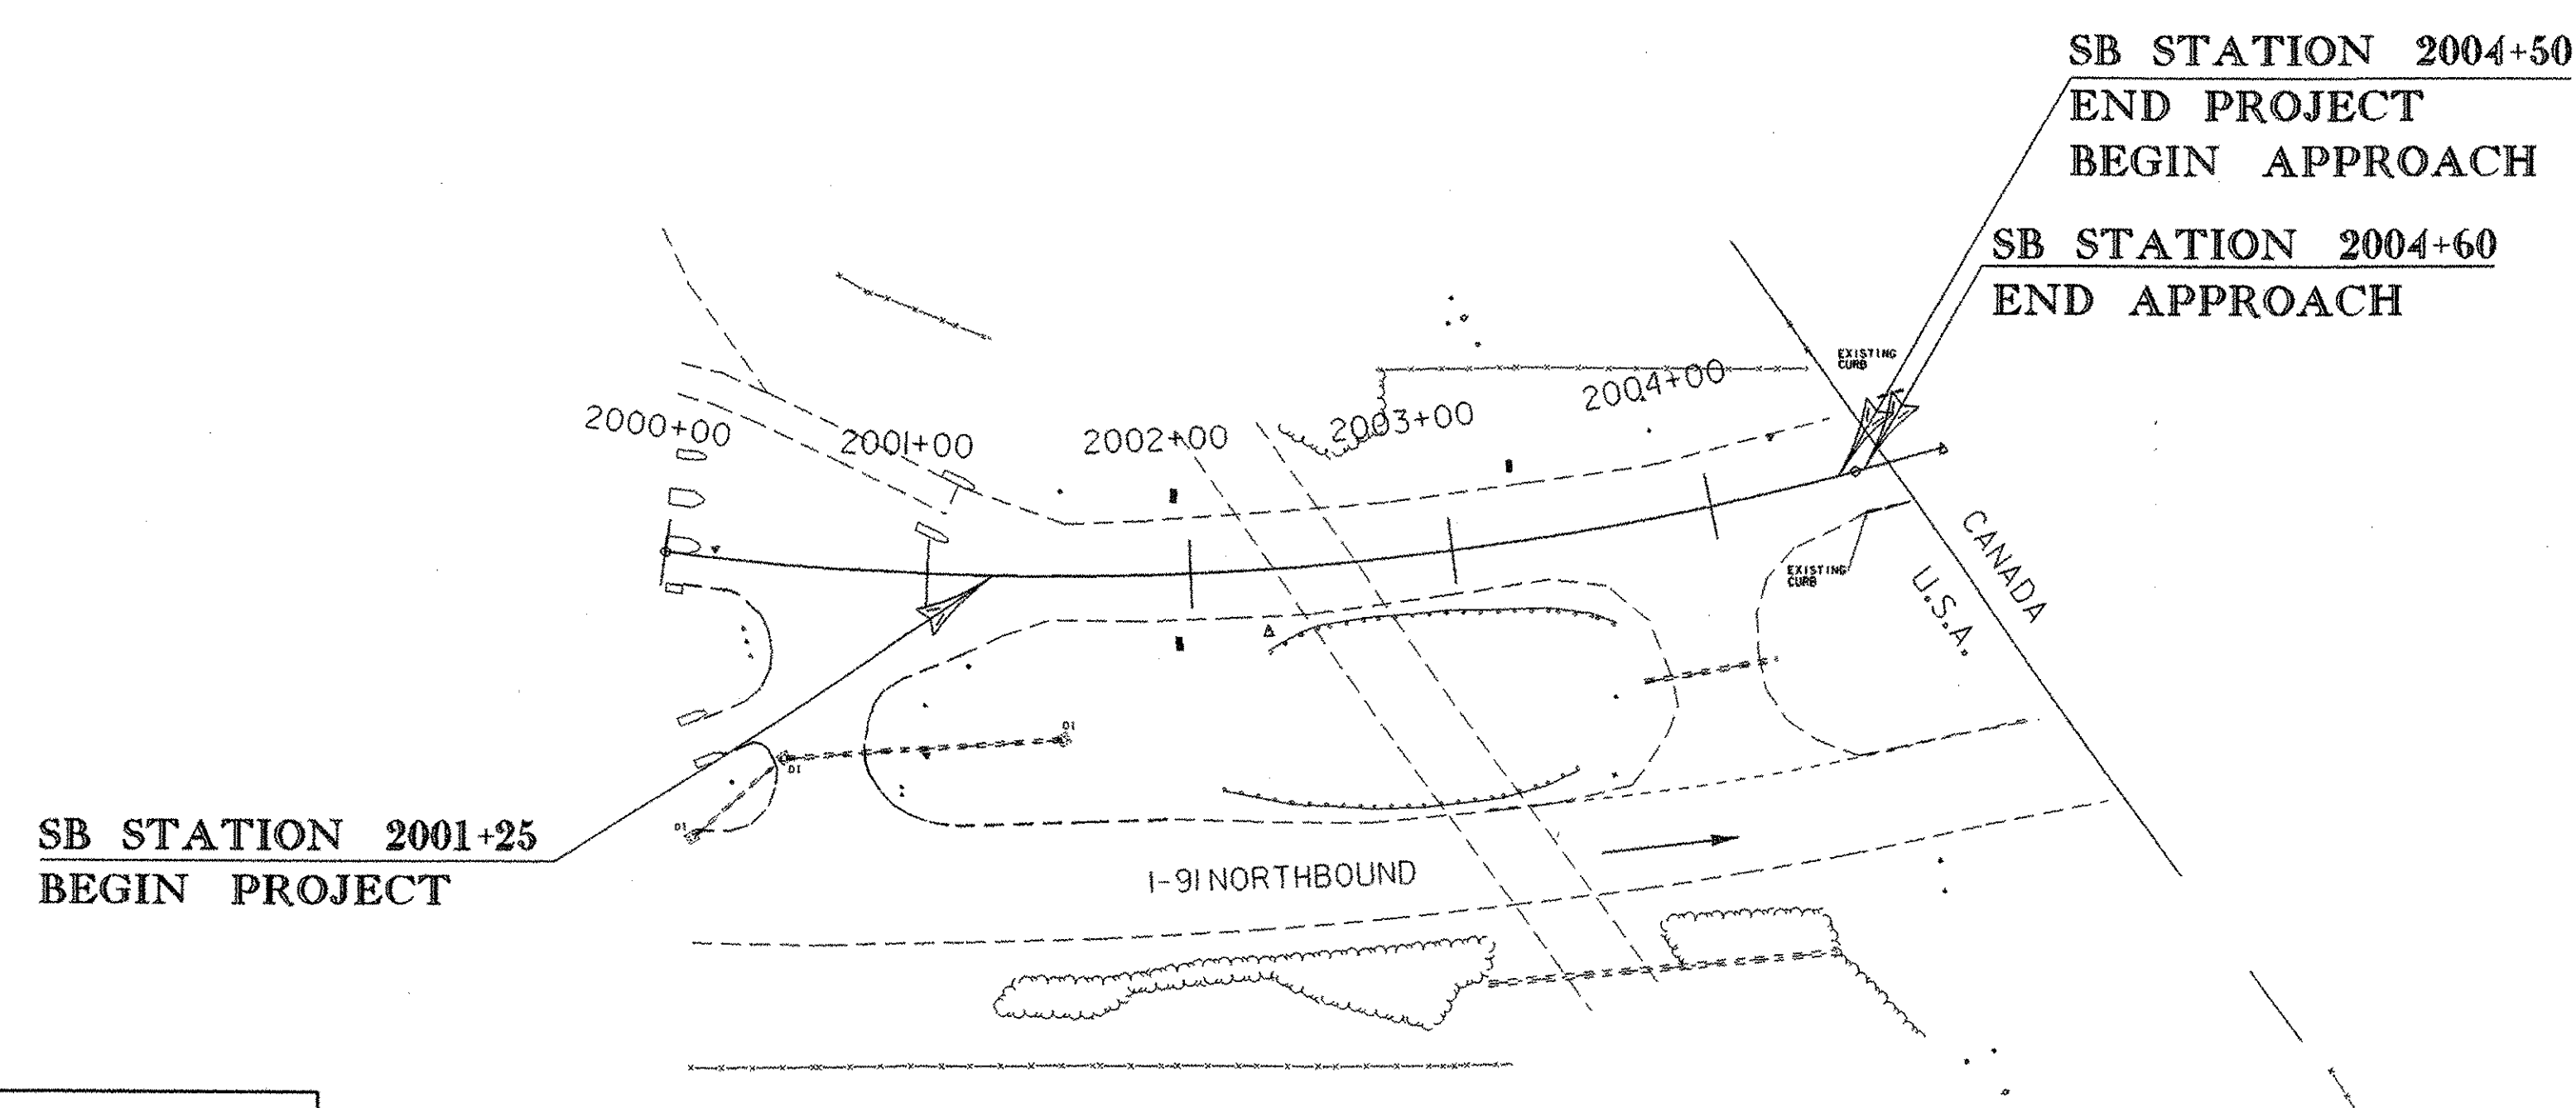

CONVENTIONAL SYMBOLS	
COUNTY LINE	
TOWN LINE	
LIMITS OF ACCESS	
POINT OF ACCESS	
FENCE LINE	
STONE WALL	
TRAVELED WAY	
GUARD RAIL	
RAILROAD	
SURVEY LINE	
CULVERT	
POWER POLE	
TELEPHONE POLE	
TREES	
CONTROL OF ACCESS	
PROPERTY LINE	
R.O.W. TAKING LINE	
SLOPE RIGHTS	
TOP OF CUT	
TOE OF SLOPE	

SURVEYED BY : R. GILMAN
SURVEYED DATE : DEC. 2003

DATUM
VERTICAL NAVD 88
HORIZONTAL NAD-83 (96)

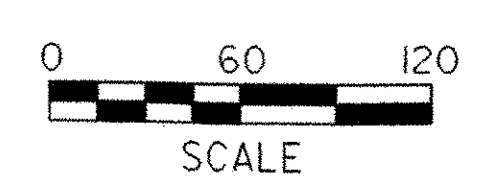

THESE PLANS ARE SUBJECT TO SUCH ENGINEERING CHANGES AS MAY BE REQUIRED BY THE FEDERAL HIGHWAY ADMINISTRATION OR THE DIRECTOR OF PROGRAM DEVELOPMENT.

CONSTRUCTION IS TO BE CARRIED ON IN ACCORDANCE WITH THESE PLANS AND THE STANDARD SPECIFICATIONS FOR CONSTRUCTION DATED 2001, AS APPROVED BY THE FEDERAL HIGHWAY ADMINISTRATION ON JANUARY 4, 2001 FOR USE ON THIS PROJECT, INCLUDING ALL SUBSEQUENT REVISIONS AND SUCH REVISED SPECIFICATIONS AND SPECIAL PROVISIONS AS ARE INCORPORATED IN THESE PLANS.

DEPARTMENT OF TRANSPORTATION FEDERAL HIGHWAY ADMINISTRATION	
APPROVED <i>Mark D. Richter</i>	DATE 7-24-06
DIRECTOR OF PROGRAM DEVELOPMENT	
APPROVED <i>Rita Thibault</i>	DATE 7-13-06
PROJECT MANAGER : S. LEWIS	
PROJECT NAME : DERBY	
PROJECT NUMBER : IM 091-3 (41)	
SHEET 1 OF 20 SHEETS	

