
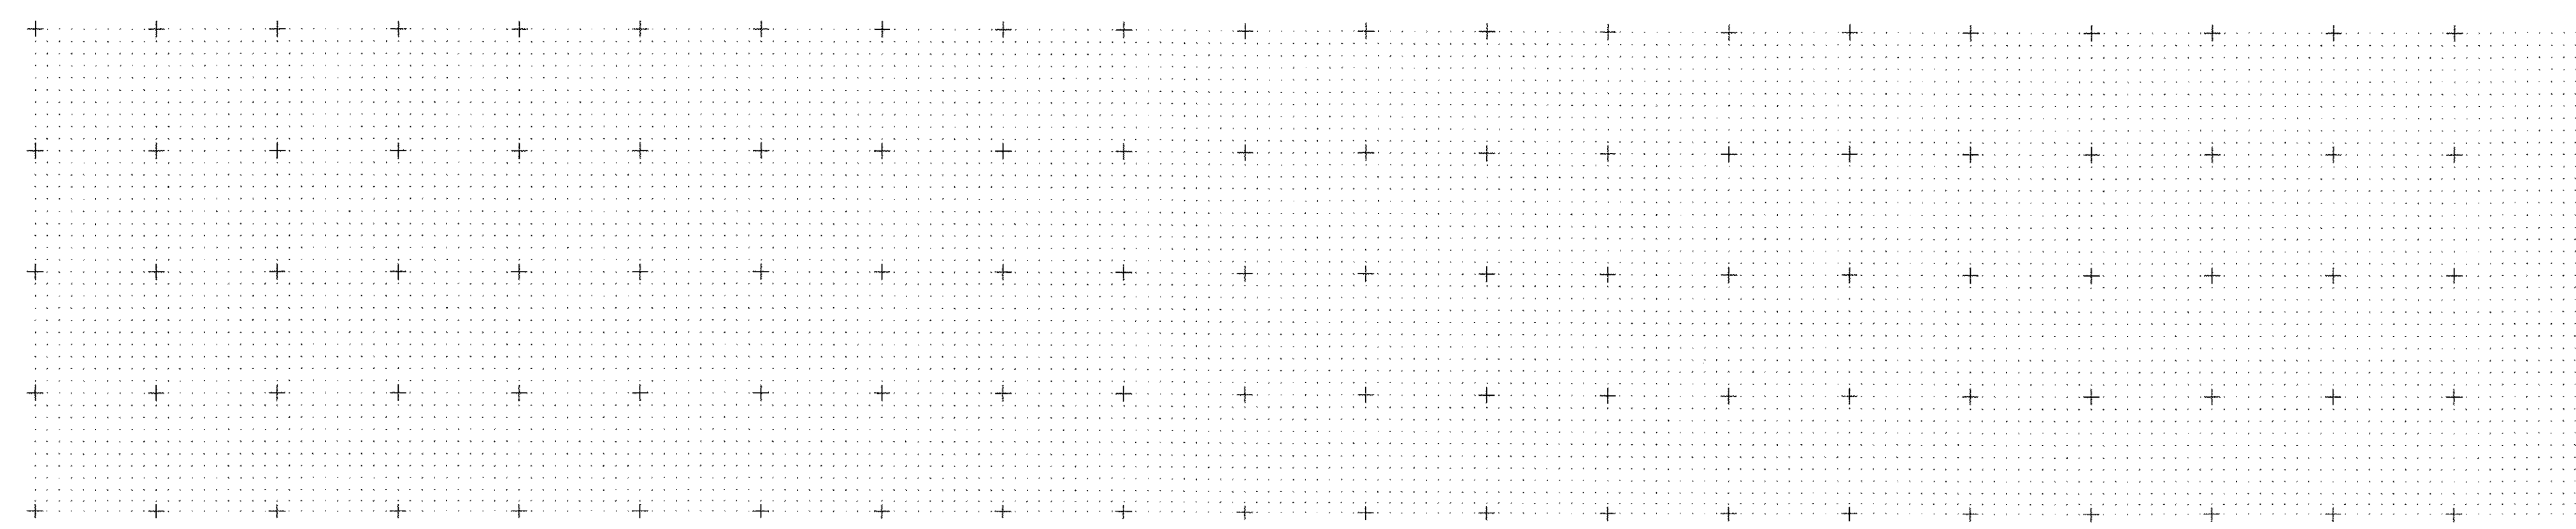
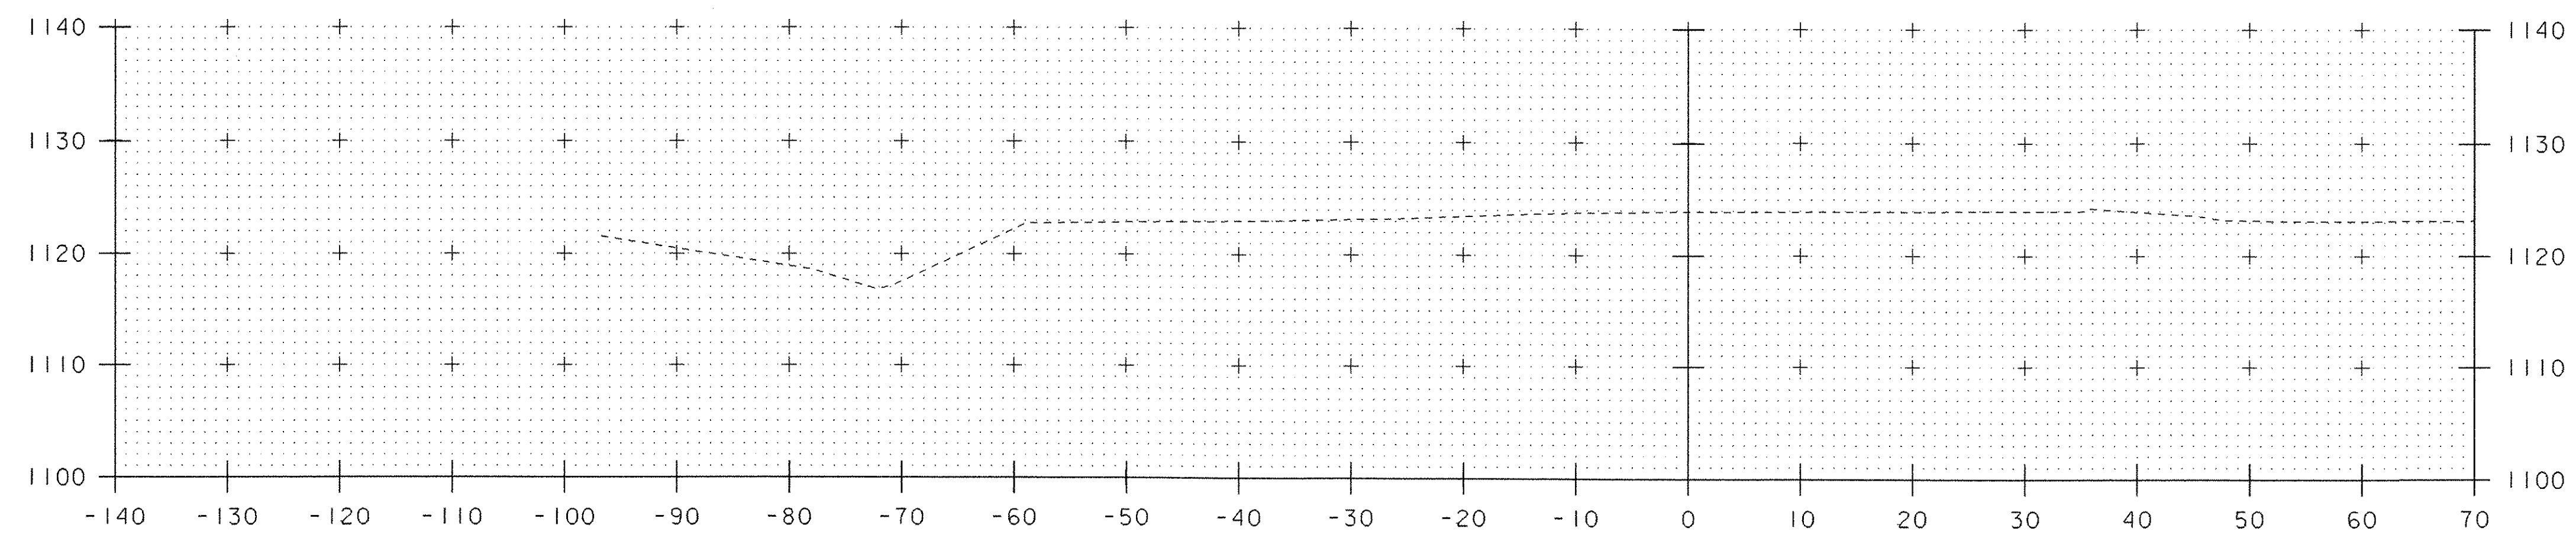


SB CROSS SECTIONS

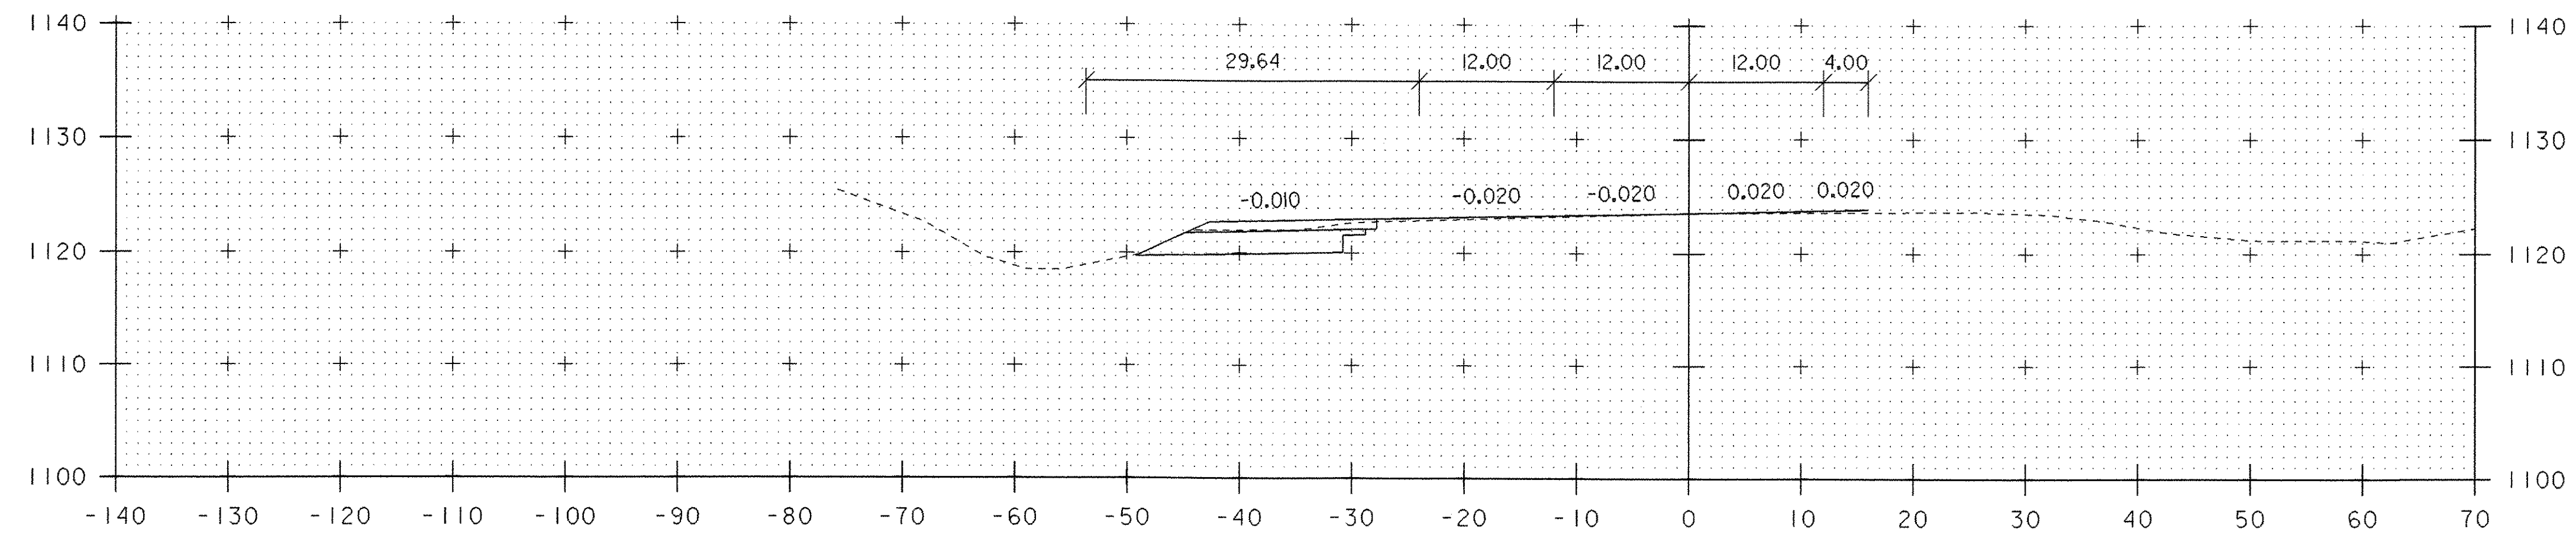

PROJECT NAME: DERBY	
PROJECT NUMBER: IM 09-3(4)	
FILE NAME: 03A088/DESIGN/D03A088XS	PLOT DATE: 17-JUL-2006
PROJECT LEADER: A. J. BOMBARDIER	DRAWN BY: J. L. SCHULTZ
DESIGNED BY: J. L. SCHULTZ	CHECKED BY: A. BOMBARDIER
CROSS SECTION SHEET 1	SHEET 15 OF 20