
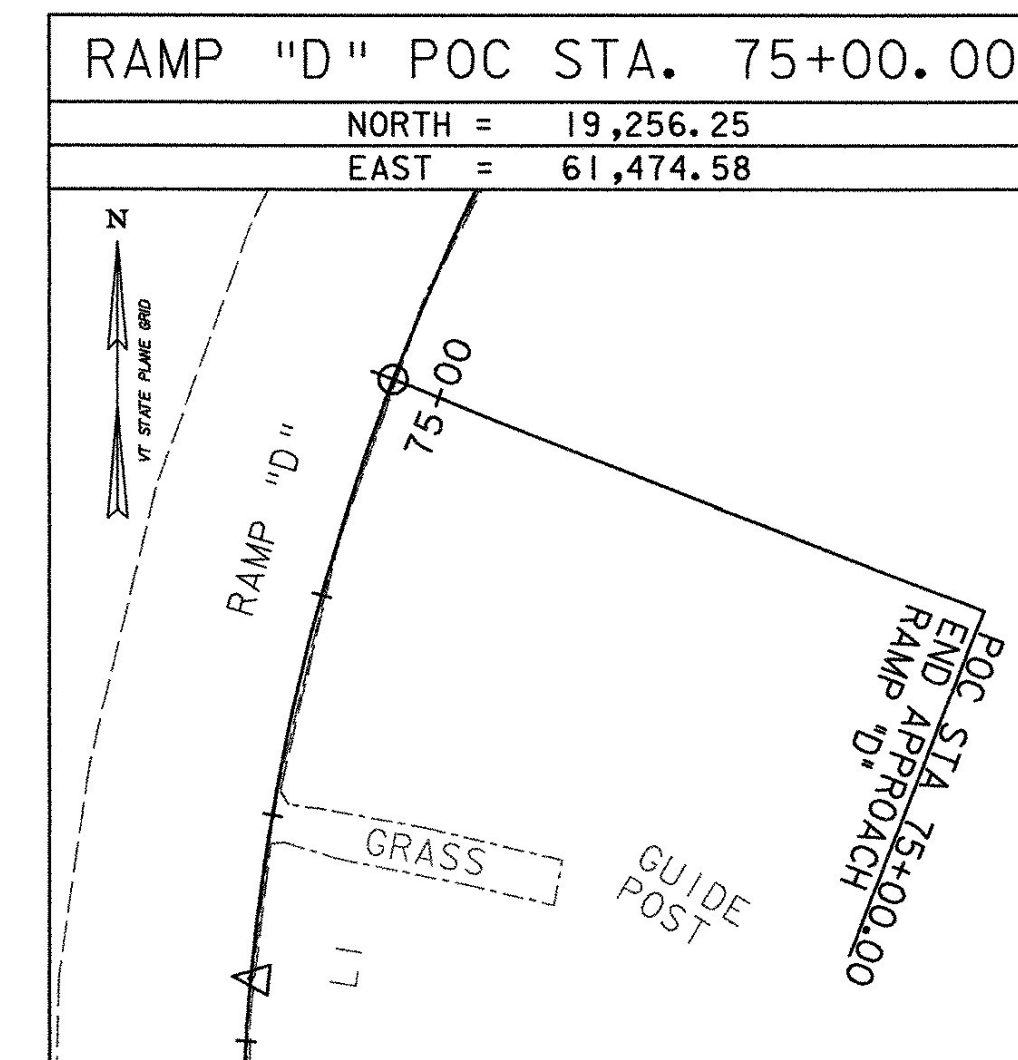
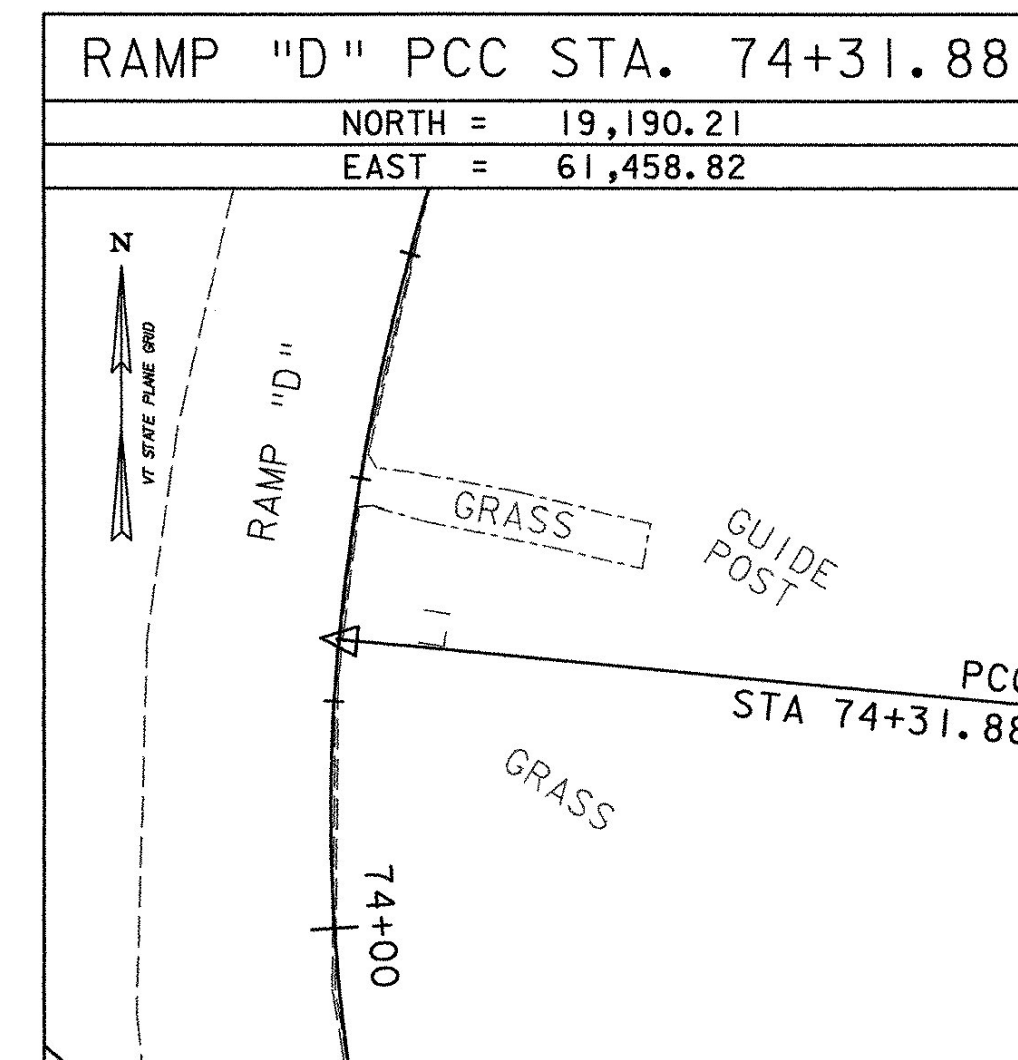
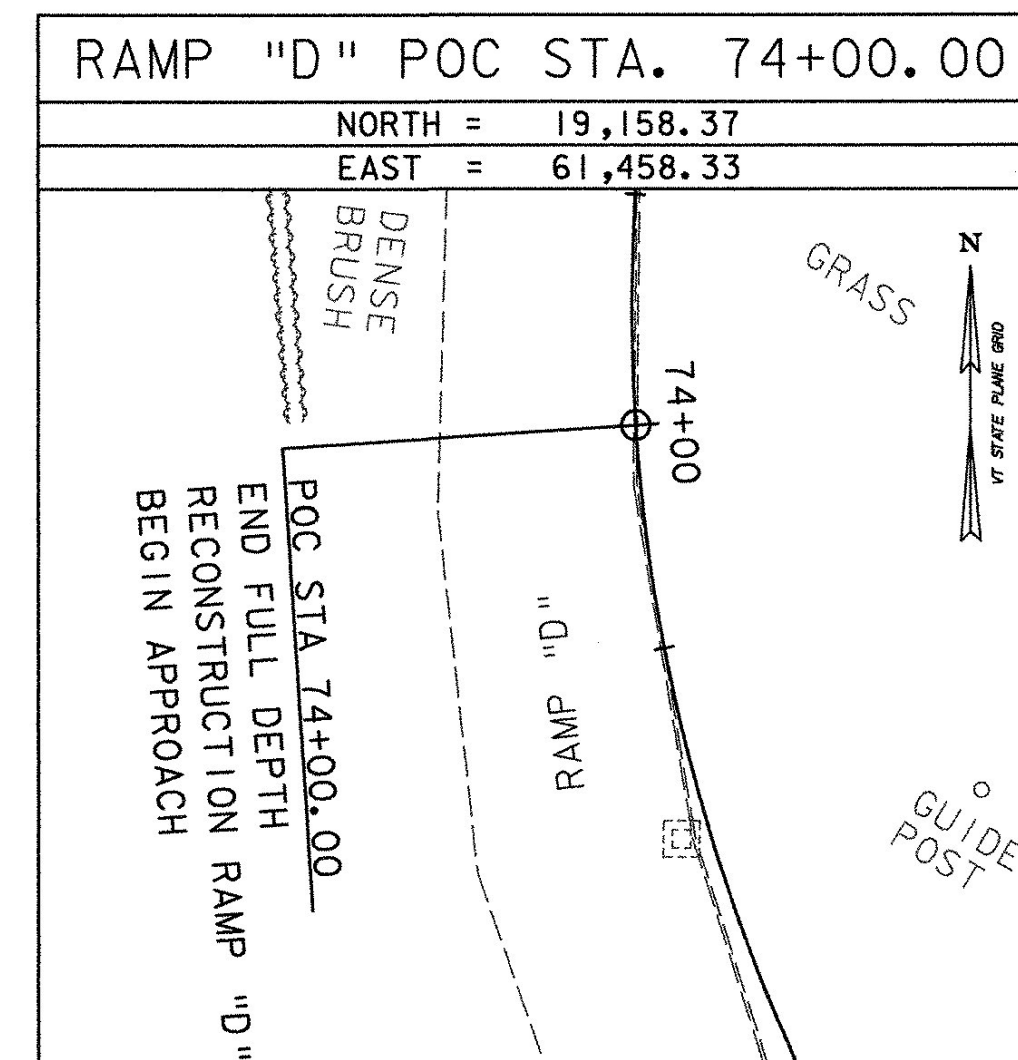
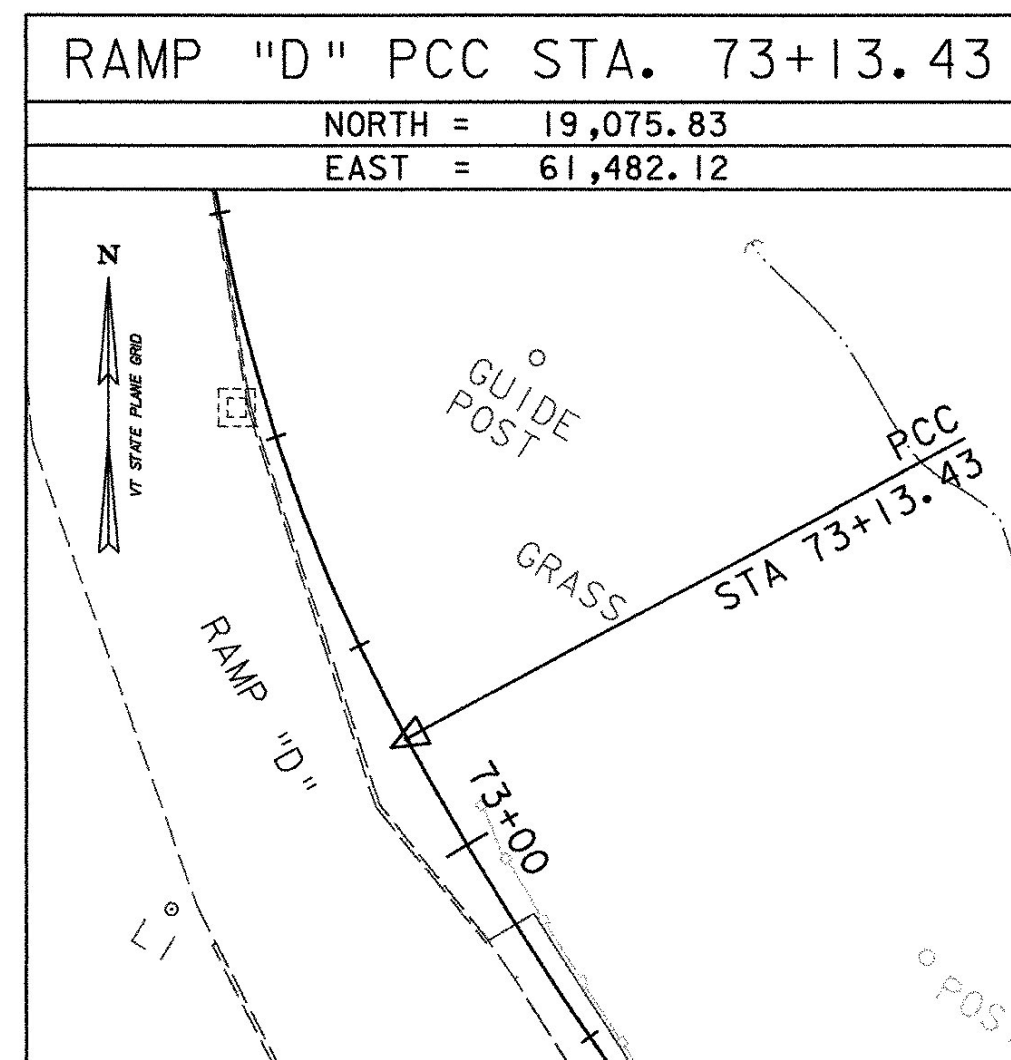
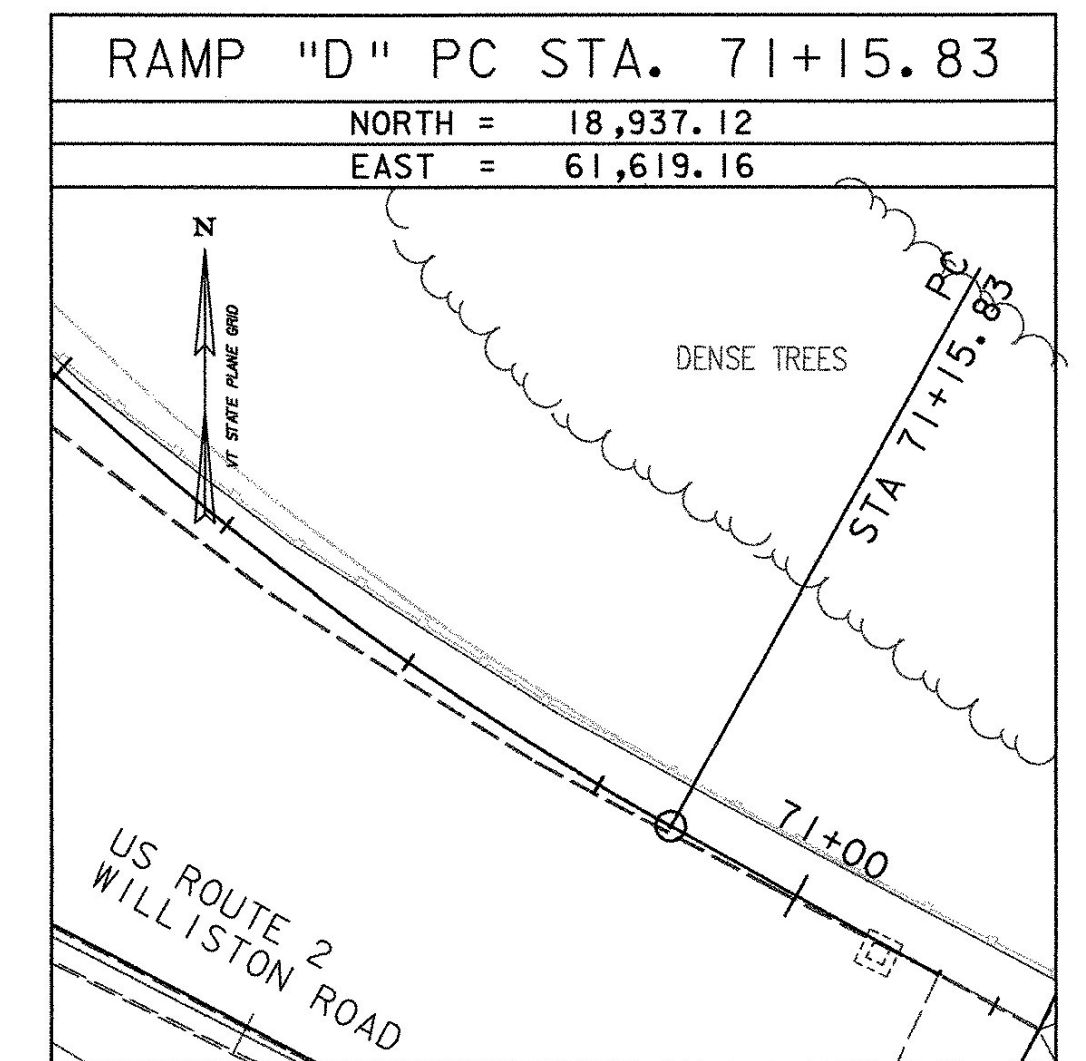
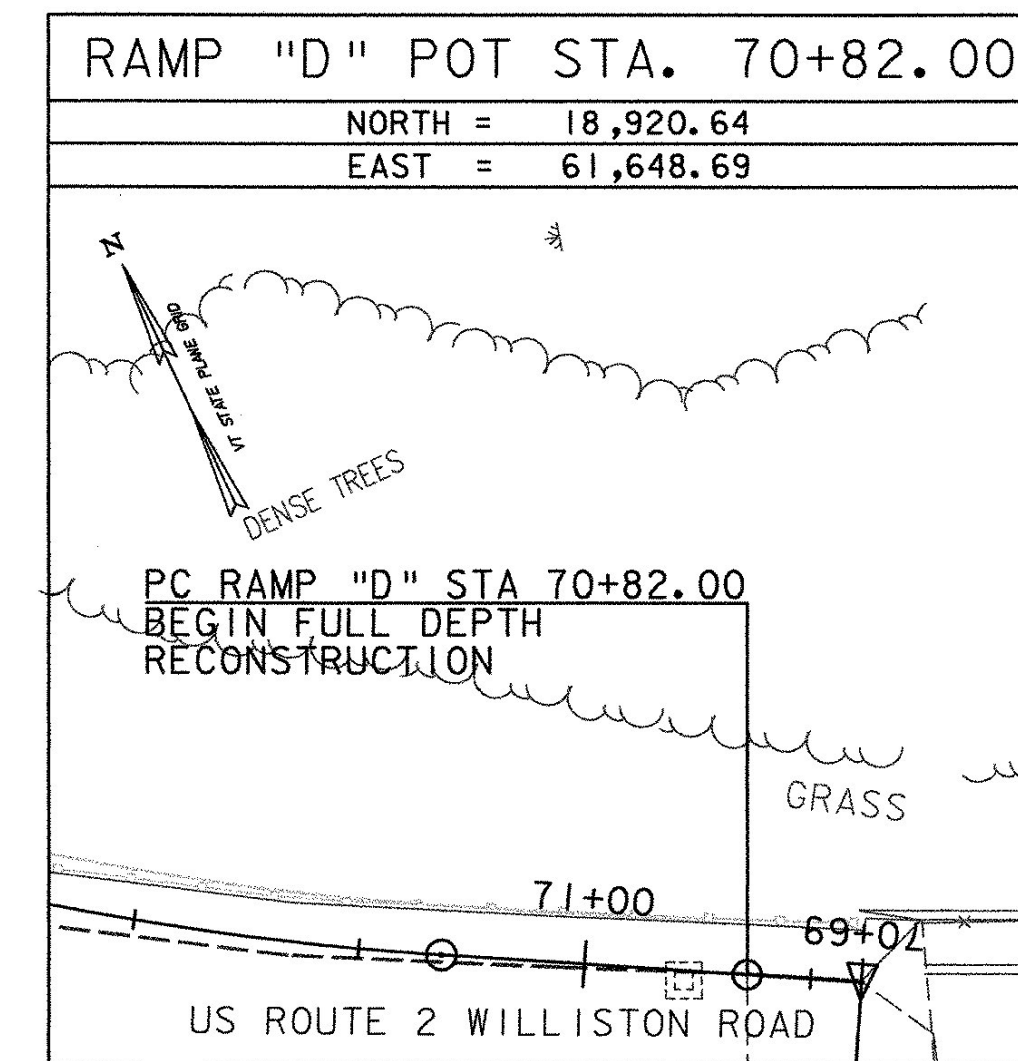
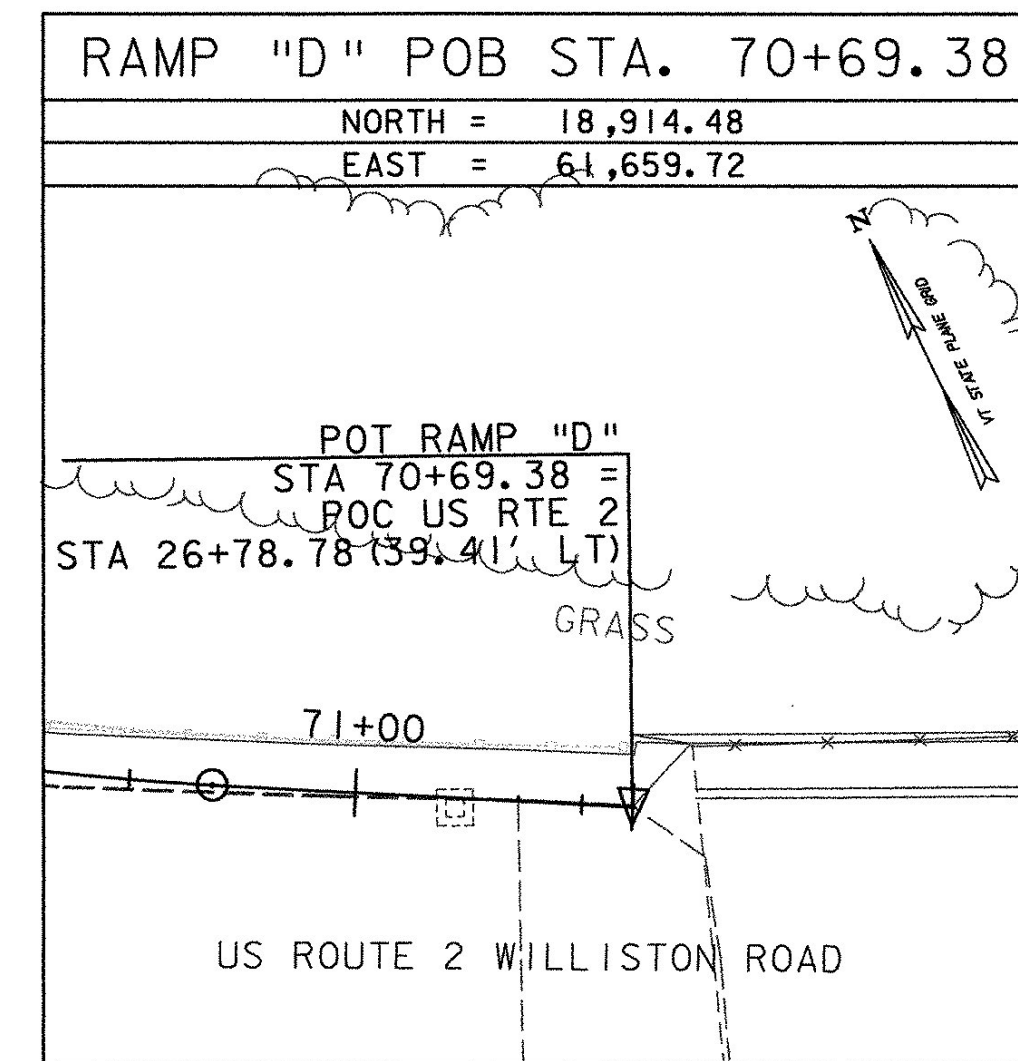
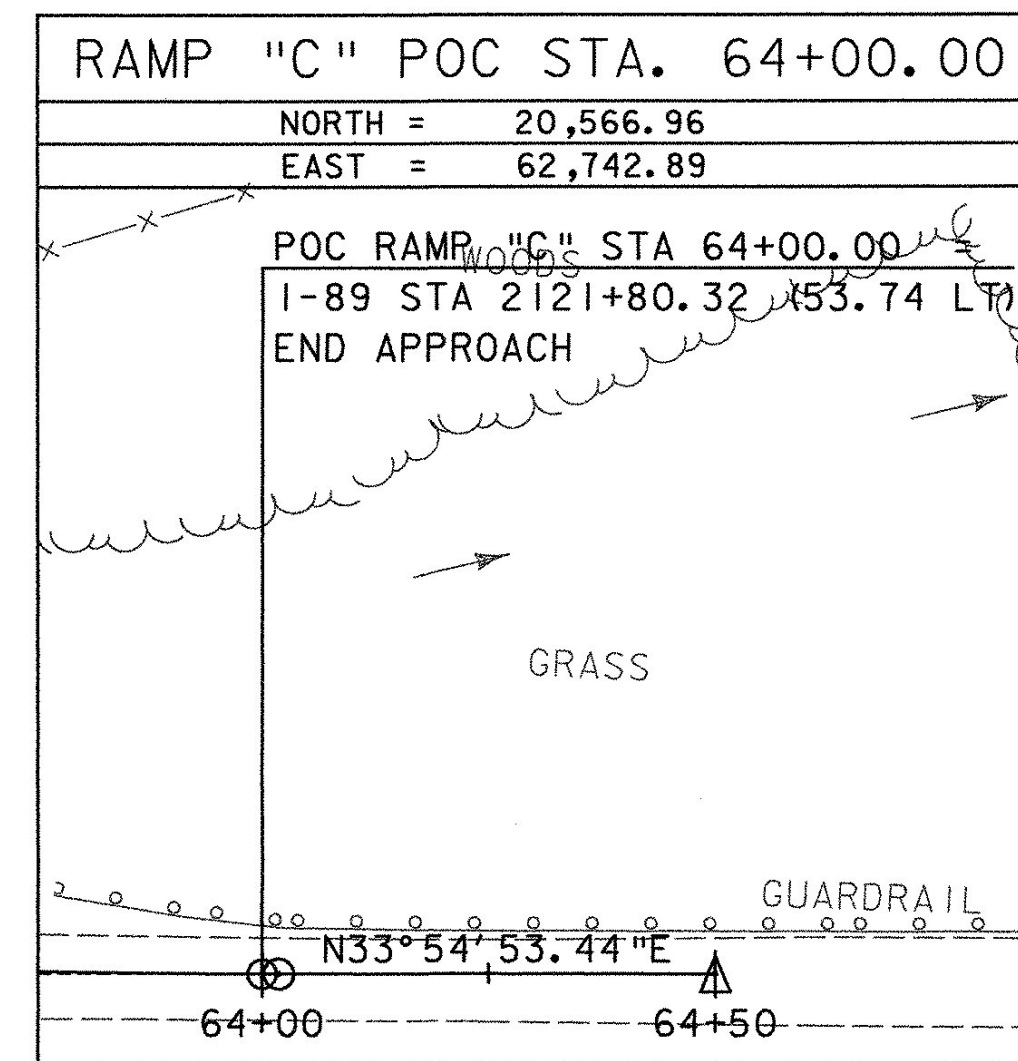
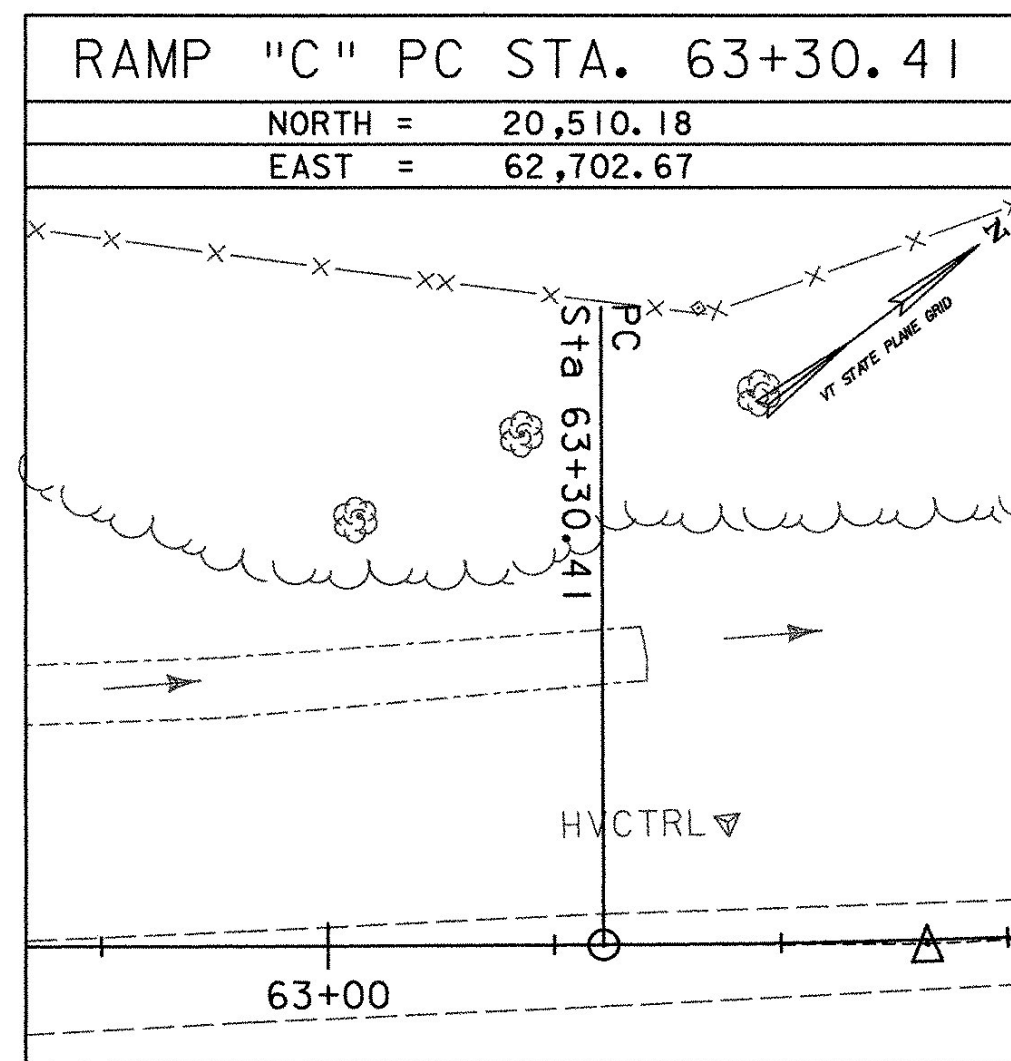
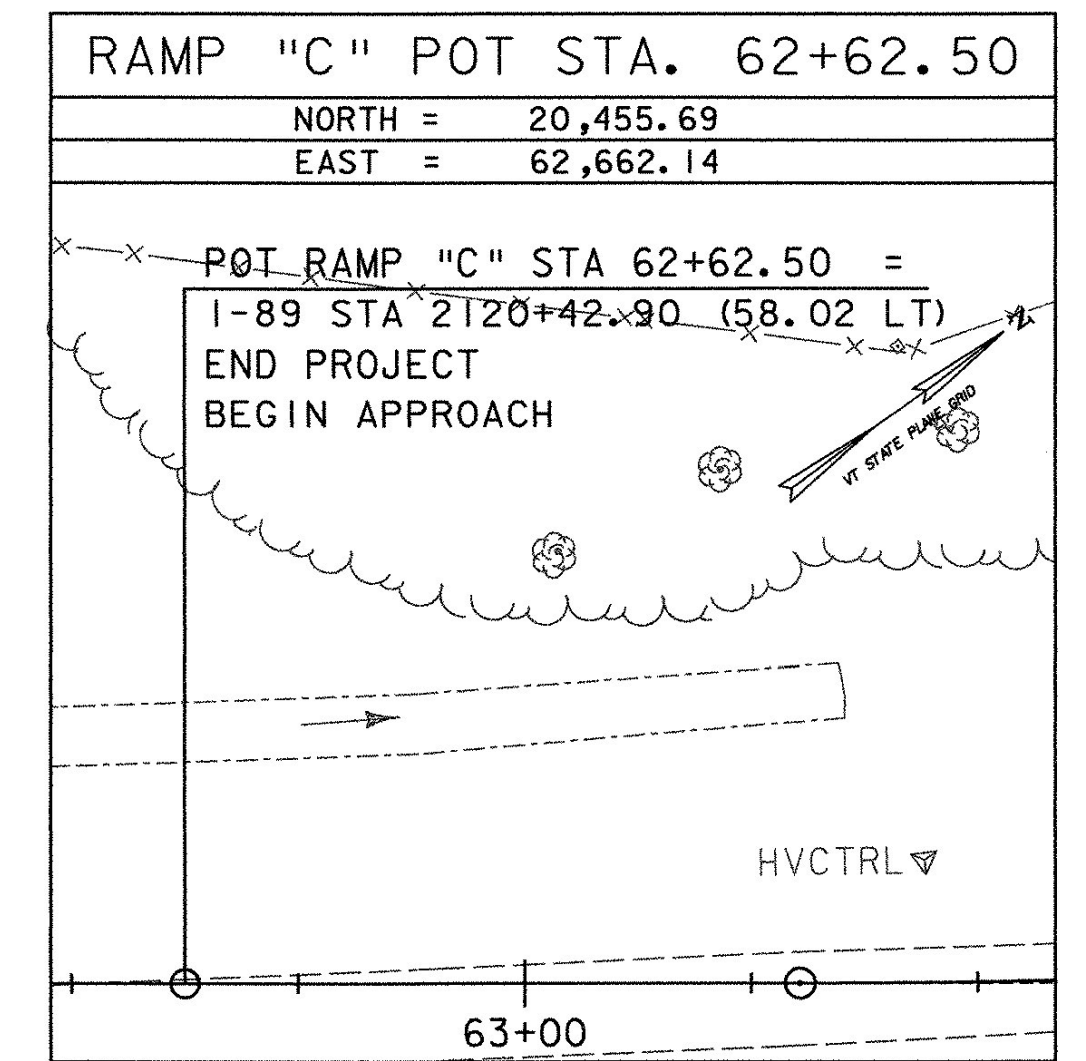
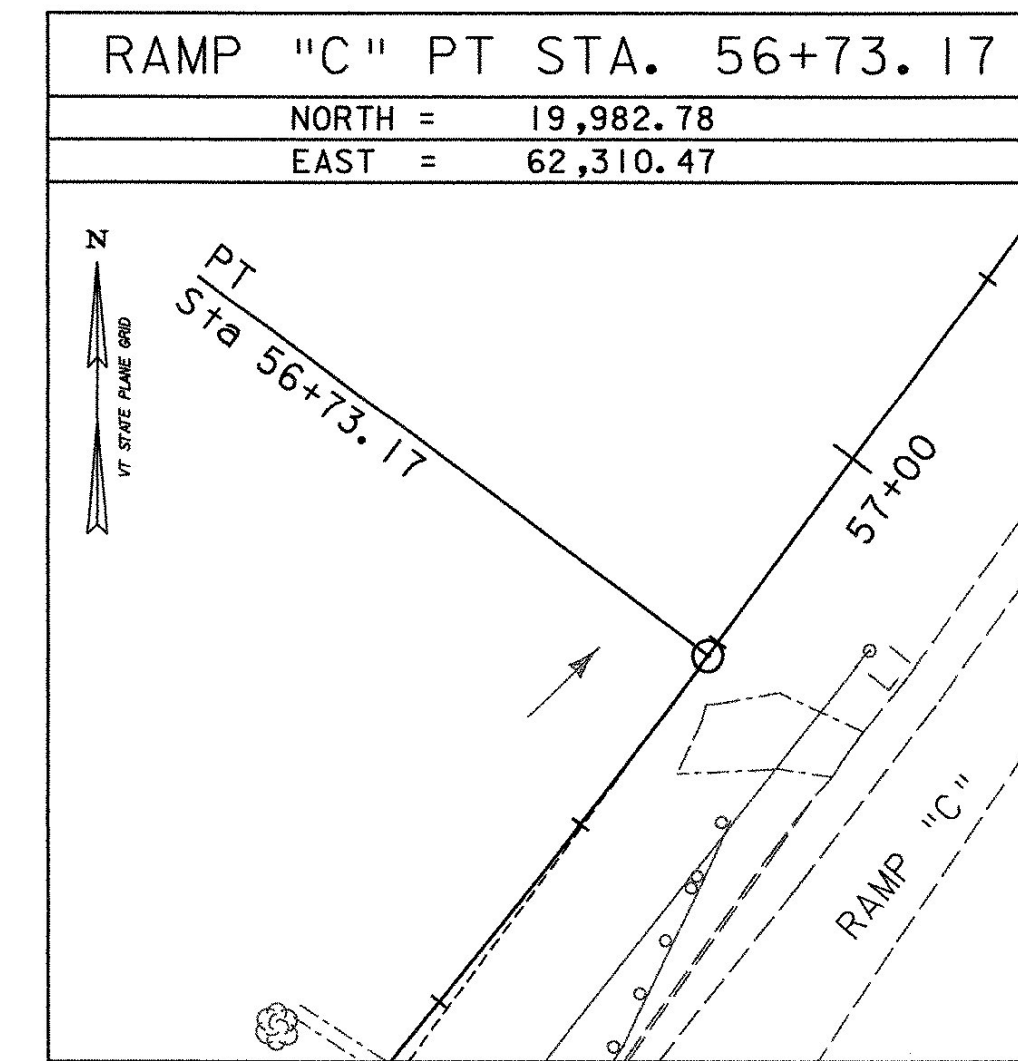
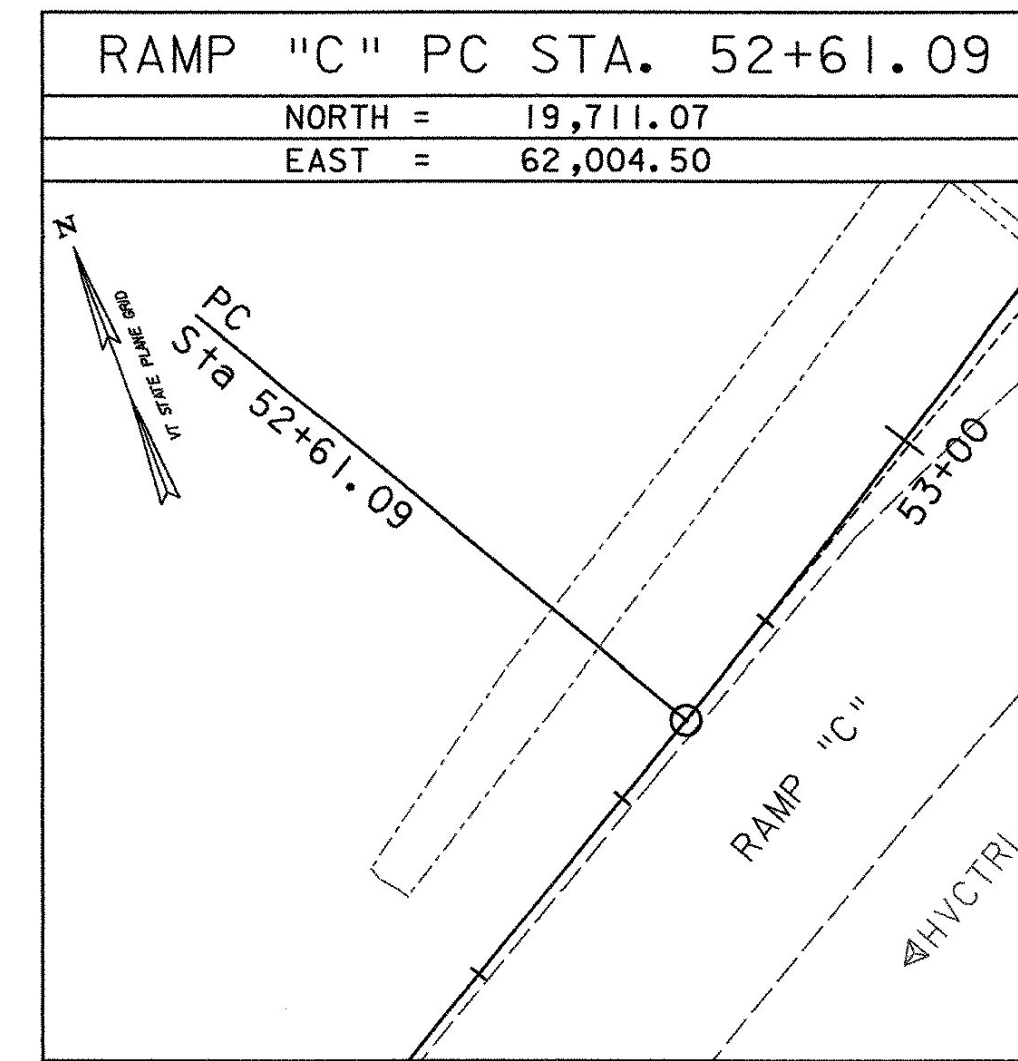
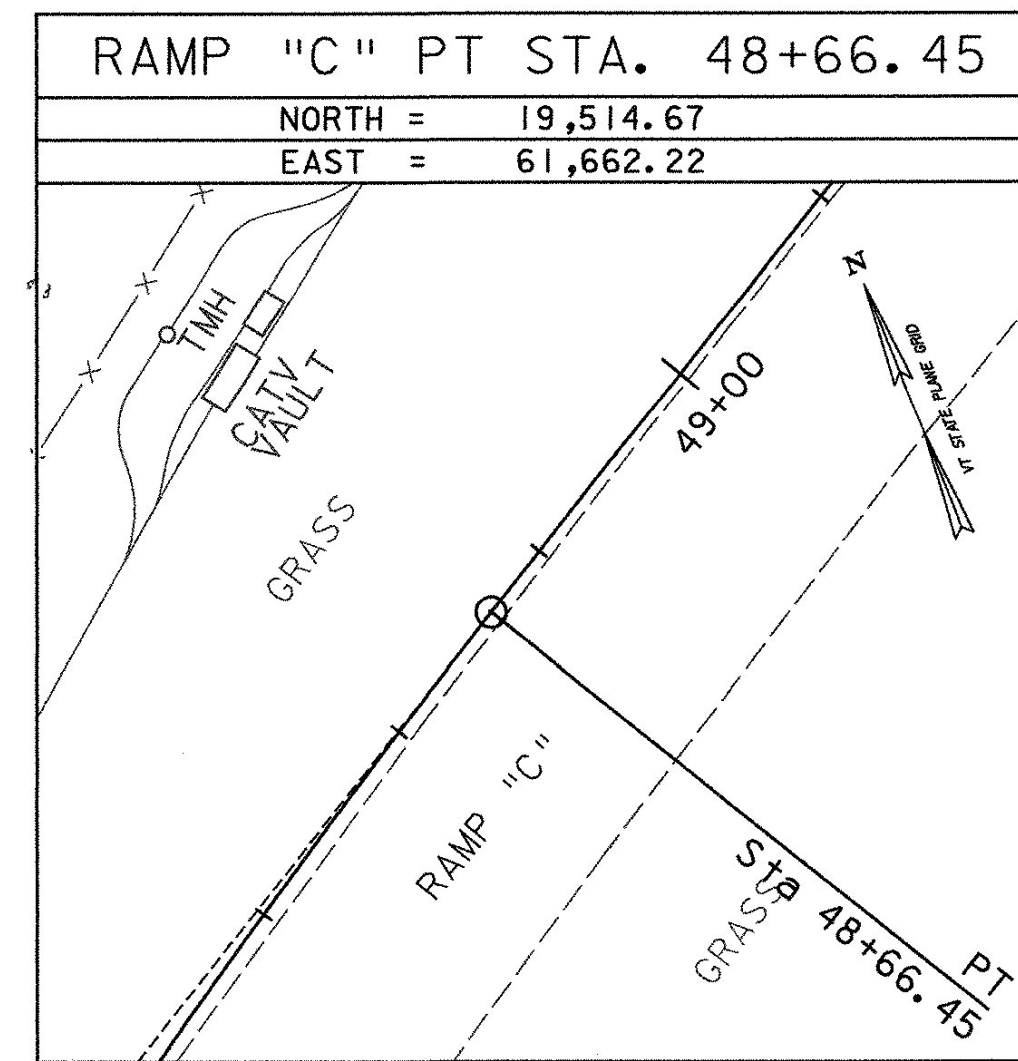


ALIGNMENT TIES

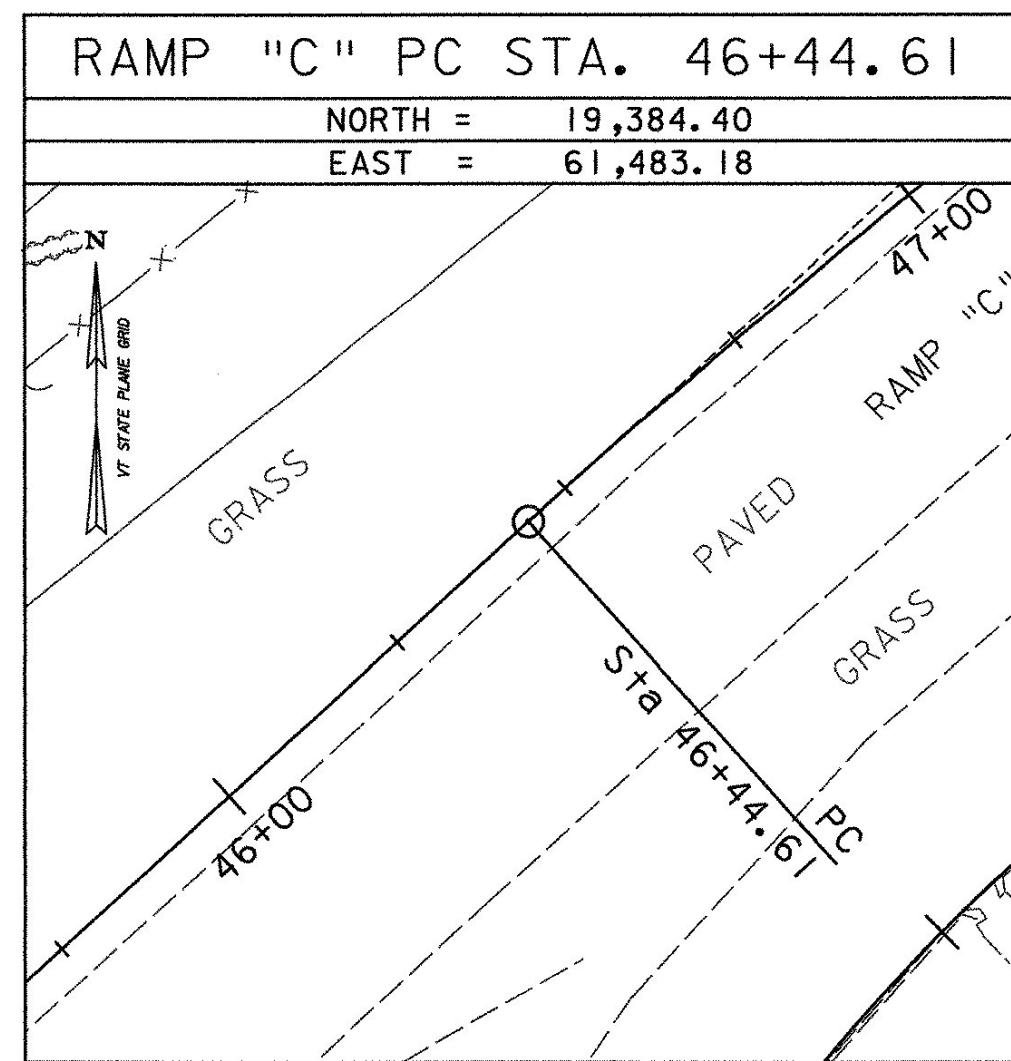

DATUM	
VERTICAL	NAVD 88
HORIZONTAL	NAD 83 (96)
ADJUSTMENT	Compass

PROJECT NAME:	SOUTH BURLINGTON
PROJECT NUMBER:	IM 089-3(37)
FILE NAME:	z03a1781e.dgn
PROJECT LEADER:	KEN UPMAL
DESIGNED BY:	
TIE SHEET	2 OF 2
PLOT DATE:	5/5/2006
DRAWN BY:	E. ATKINS
CHECKED BY:	
SHEET	12 OF 99