


- EXISTING DRAINAGE
- RAMP "D" 70+89 LT ~ 70+93 RT
- EXISTING PIPE & DI - RETAIN
- REMOVE EXISTING SIDEWALK (COMMON EXCAVATION)
- RAMP "D" 70+82 ~ 72+50 LT
- COLD PLANING-BIT PAVEMENT
- US ROUTE 2 25+00 ~ 26+67
- CHANGING ELEV. OF DROP INLETS, CATCH BASINS OR MANHOLE
- RAMP "D" 70+89 LT
- CLASS III WETLAND
- STONE FILL TYPE II
- RAMP "D" 71+50 ~ 72+50 RT
- REMOVING AND RESETTING CURB
- RAMP "D" EXISTING 70+82 ~ 72+50 LT RESET TO 70+82 ~ 72+50 RT
- PORTLAND CEMENT CONCRETE SIDEWALK, 5 INCH (MOD.)
- RAMP "D" 70+82 ~ 72+50 RT (5' WIDE)
- REMOVING AND RESET GUARDRAIL (MOD. - 8' POSTS)
- RAMP "D" EXISTING 70+69 - 6.9' RT ~ 72+50 - 5.5' RT RESET TO
- RAMP "D" 70+69 - 6.8' RT ~ 72+50 - 5.7' RT
- GRUBBING MATERIAL
- RAMP "D" 71+50 ~ 72+50 RT
- WIRED CONDUIT (2") (PVC)
- RAMP "D" 72+63 RT(PB) ~ RAMP "D" 72+10 RT(LP) - 54'
- LIGHT POLE BASE
- RAMP "D" 72+10 ~ 9.0' RT
- REMOVING AND RESETTING LIGHT POLE
- RAMP "D" 72+10 RT TO 72+10 - 9.0' RT
- BM #C95034 STANDARD DISK ELEV. = 332.20

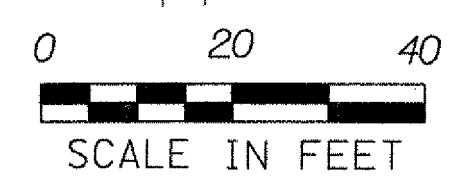

ROADWAY LAYOUT SHEET 4

| | | | |
|-----------------|---------------------|-------------|------------|
| PROJECT NAME: | SOUTH BURLINGTON | PLOT DATE: | 5/5/2006 |
| PROJECT NUMBER: | IM 089-3(37) | DRAWN BY: | P.MILEWSKI |
| FILE NAME: | z03dl78bdr.dgn | CHECKED BY: | K.JISHKURA |
| PROJECT LEADER: | KEN UPMAL | SHEET | 16 OF 99 |
| DESIGNED BY: | E.ATKINS/P.MILEWSKI | | |

DATUM
 VERTICAL NAVD 88
 HORIZONTAL NAD 83 (1996)