


MATCHLINE STA. 30+00
ROADWAY LAYOUT SHEET 4

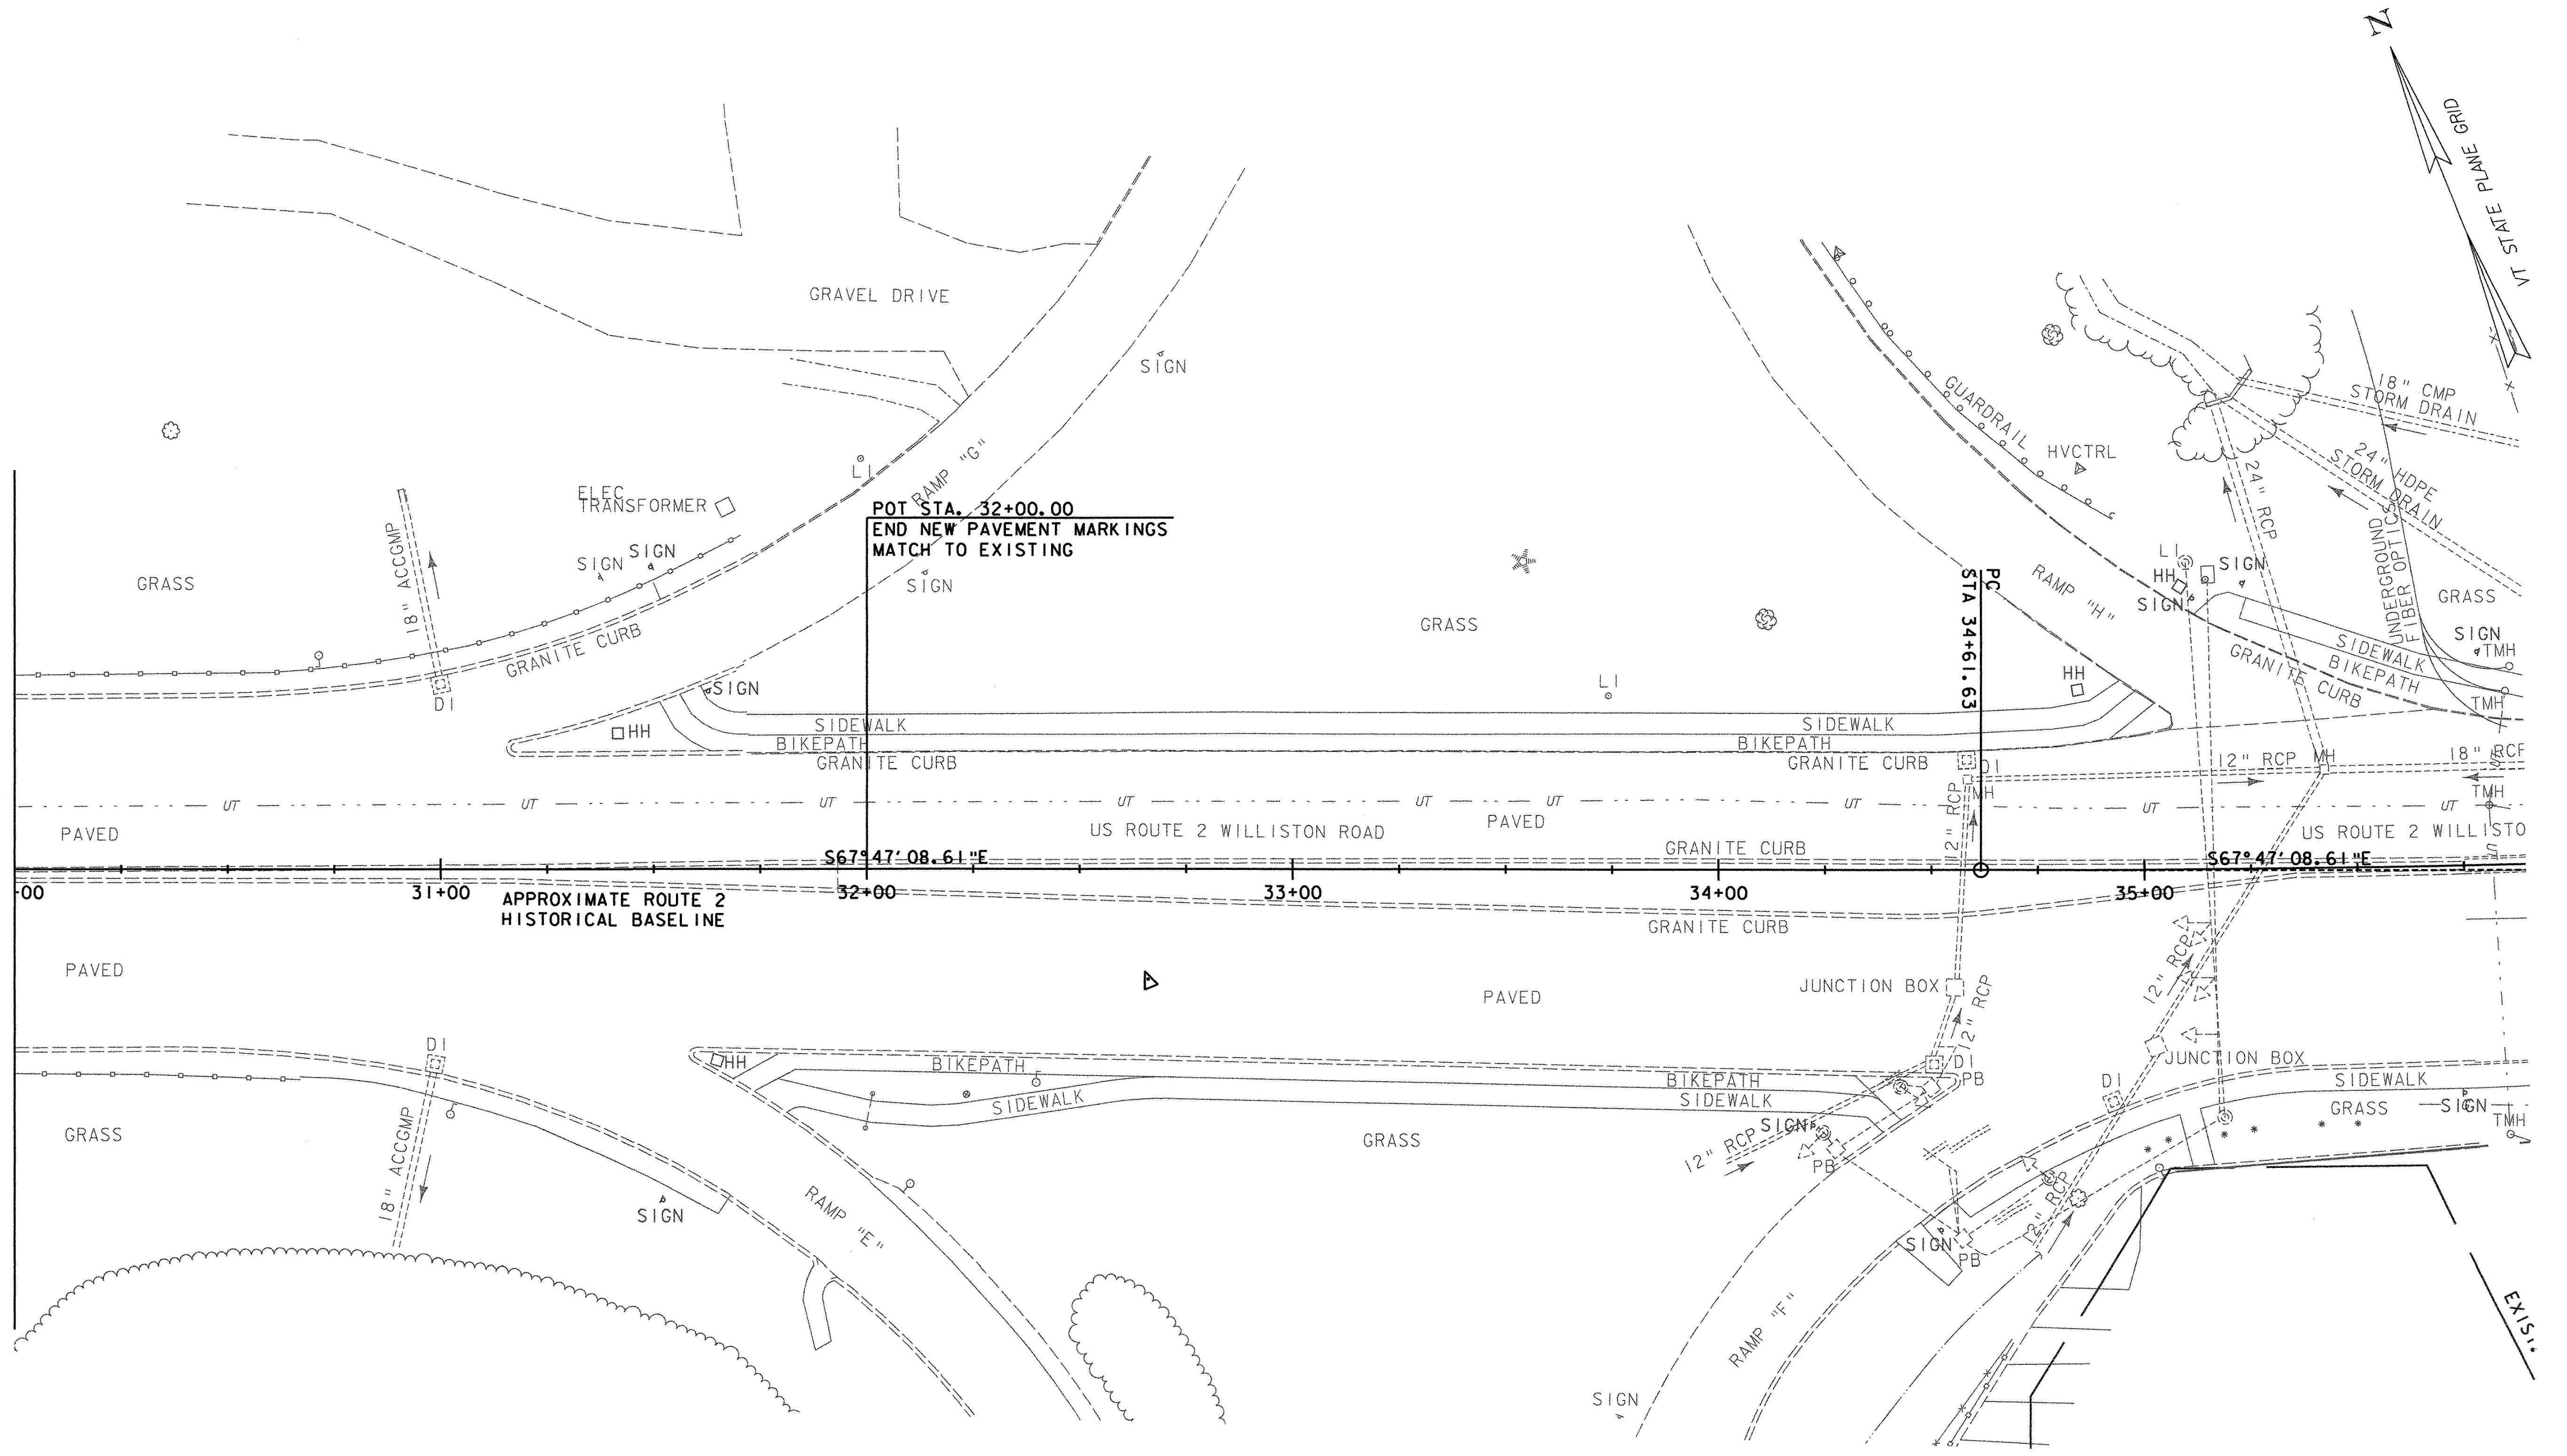

ROADWAY LAYOUT SHEET 5

PROJECT NAME:	SOUTH BURLINGTON	FILE NAME:	z03a178bdr.dgn	PLOT DATE:	5/5/2006
PROJECT NUMBER:	IM 089-3(37)	PROJECT LEADER:	KEN UPMAL	DRAWN BY:	P.MILEWSKI
		DESIGNED BY:	E.ATKINS/P.MILEWSKI	CHECKED BY:	K.JISHIKURA
				SHEET 17	OF 99

DATUM	
VERTICAL	NAVD 88
HORIZONTAL	NAD 83 (1996)