


DATUM
 VERTICAL NAVD 88
 HORIZONTAL NAD 83 (1996)

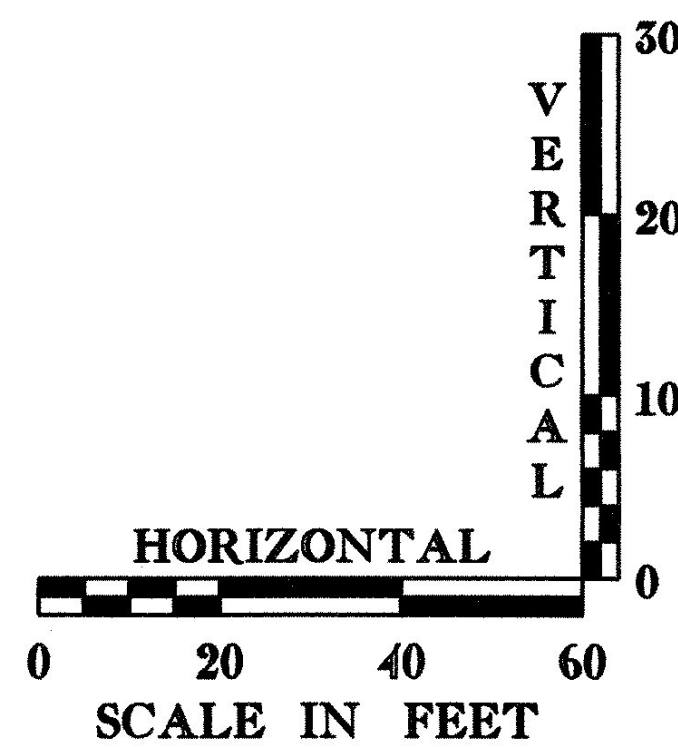

THE GRADES SHOWN TO THE NEAREST TENTH ARE THE ORIGINAL GROUND ELEVATIONS ALONG THE PROPOSED ALIGNMENT. THE GRADES IN PARENTHESES ARE THE ORIGINAL GROUND ELEVATIONS ALONG THE EXISTING WESTERN EDGE OF RAMP "C". THE GRADES SHOWN TO THE NEAREST HUNDREDTH ARE THE PROPOSED GRADES FOR THE NEW ALIGNMENT.

RAMP "C" PROFILE SHEET 2

PROJECT NAME: SOUTH BURLINGTON	PLOT DATE: 5/5/2006
PROJECT NUMBER: IM 089-3(37)	DRAWN BY: E. ATKINS
FILE NAME: z03al78xs.dgn	CHECKED BY: K. ISHIKURA
PROJECT LEADER: KEN UPMAL	SHEET 25 OF 99
DESIGNED BY: E. ATKINS	
P. MILEWSKI	