


DATUM  
 VERTICAL NAVD 88  
 HORIZONTAL NAD 83 (1996)

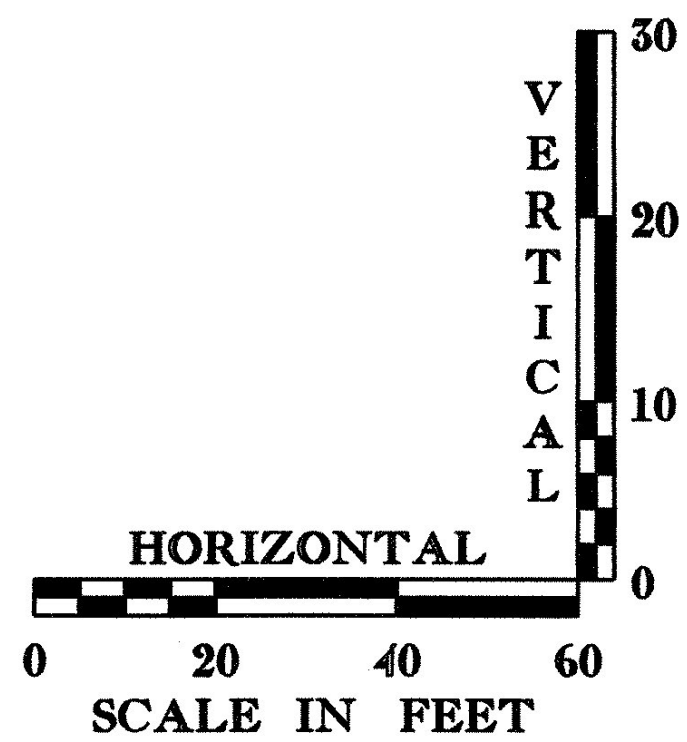

THE GRADES SHOWN TO THE NEAREST TENTH ARE THE ORIGINAL GROUND ELEVATIONS ALONG THE PROPOSED ALIGNMENT. THE GRADES SHOWN TO THE NEAREST HUNDRETH ARE THE PROPOSED GRADES FOR THE NEW ALIGNMENT.

### RAMP "D" PROFILE SHEET I

PROJECT NAME: SOUTH BURLINGTON	PLOT DATE: 5/5/2006
PROJECT NUMBER: IM 089-3(37)	DRAWN BY: E. ATKINS
FILE NAME: z03dl78xs.dgn	CHECKED BY: K. ISHIKURA
PROJECT LEADER: KEN UPMAL	SHEET 29 OF 99
DESIGNED BY: E. ATKINS	
P. MILEWSKI	