


**LEGEND**

---	SOIL TYPE BOUNDARY
—300—	10' INTERVAL CONTOUR
---	2' INTERVAL CONTOUR
---	EXIST. PROPERTY/ROW LINE
(ABAND)	EXIST. ABANDONED UTILITY
(REC)	RECORD INFORMATION

**SOIL LEGEND**

SOIL DESIGNATION	HYDROLOGIC SOIL GROUP CLASSIFICATION	SOIL ERODABILITY COEFFICIENTS
AdA = ADAMS AND WINDSOR LOAMY SANDS, 0 TO 5 PERCENT SLOPES	A	0.17 (NOT HIGHLY ERODABLE)
Fu = FILL LAND	NOT RATED	(NOT RATED)
H1B = HARTLAND VERY FINE SANDY LOAM, 2 TO 6 PERCENT SLOPES	B	0.49 (POTENTIALLY HIGHLY ERODABLE)
H1D = HARTLAND VERY FINE SANDY LOAM, 12 TO 25 PERCENT SLOPES	B	0.49 (HIGHLY ERODABLE)
VeB = VERGENNES CLAY, 2 TO 6 PERCENT SLOPES	D	0.49 (POTENTIALLY HIGHLY ERODABLE)

**DATUM**  
 VERTICAL NAVD 88  
 HORIZONTAL NAD 83 (1996)

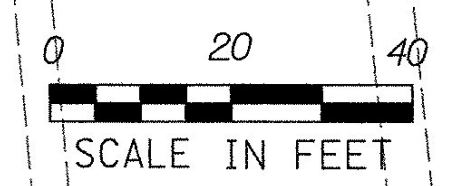

**EXISTING CONDITIONS  
 PLAN SHEET 4**

PROJECT NAME: SOUTH BURLINGTON	PLOT DATE: 5/5/2006
PROJECT NUMBER: IM 089-3(37)	DRAWN BY: P.MILEWSKI
FILE NAME: z03af78bdr.dgn	CHECKED BY: K.ISHIKURA
PROJECT LEADER: KEN UPMAL	SHEET 39 OF 99
DESIGNED BY: E.ATKINS/P.MILEWSKI	