

SEED
RAMP "C" 41+40 LT ~ 41+67 LT
SEED ~ WINTER RYE
RAMP "C" 41+46 LT ~ 41+67 LT
HAY MULCH
RAMP "C" 41+46 LT ~ 41+67 LT
GEOTEXTILE FABRIC FOR FILTERS
EXIST. DI 39+44.2 LT (8 S.F.)
EXIST. DI 40+46.6 LT (8 S.F.)

POT US ROUTE 2 STA. 15+75.00
BEGIN NEW PAVEMENT MARKINGS

POT RAMP "C" STA 39+75.00 =
RT. 2 STA 18+07.76 (32.92 LT)
BEGIN APPROACH


POT RAMP "C" STA 41+12.50
END APPROACH
BEGIN PROJECT
IM 089-3 (37)

MATCHLINE STA. 14+00
EROSION CONTROL & GRADING SHEET 1

MATCHLINE STA. 20+00
EROSION CONTROL & GRADING SHEET 3

DATUM
VERTICAL NAVD 88
HORIZONTAL NAD 83 (1996)

EROSION CONTROL LEGEND	
	INLET PROTECTION (SEE DETAIL SHEETS FOR APPROPRIATE METHOD)
	TEMPORARY STONE CHECK DAM
	SILT FENCE
	PROJECT DEMARCATION FENCING (LIMIT OF DISTURBANCE)
	FILTER CURTAIN
	PROPOSED 10' INTERVAL CONTOUR
	PROPOSED 2' INTERVAL CONTOUR
	STONE DITCH
	DITCH W/ EROSION MATTING
	STABILIZED CONST. ENTRANCE

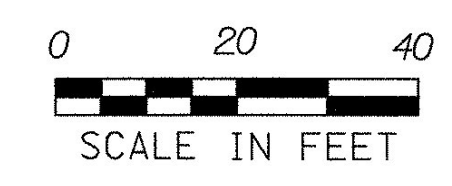

EROSION CONTROL & GRADING LAYOUT SHEET 2

PROJECT NAME: SOUTH BURLINGTON	PLOT DATE: 5/5/2006
PROJECT NUMBER: IM 089-3(37)	DRAWN BY: P.MILEWSKI
FILE NAME: z03a178bdr.dgn	CHECKED BY: K.JSHIKURA
PROJECT LEADER: KEN UPMAL	SHEET 46 OF 99
DESIGNED BY: E.ATKINS/P.MILEWSKI	