


MATCHLINE STA. 30+00
EROSION CONTROL & GRADING SHEET 4

EROSION CONTROL LEGEND	
	INLET PROTECTION (SEE DETAIL SHEETS FOR APPROPRIATE METHOD)
	TEMPORARY STONE CHECK DAM
	SILT FENCE
	PROJECT DEMARCATION FENCING (LIMIT OF DISTURBANCE)
	FILTER CURTAIN
	PROPOSED 10' INTERVAL CONTOUR
	PROPOSED 2' INTERVAL CONTOUR
	STONE DITCH
	DITCH W/ EROSION MATTING
	STABILIZED CONST. ENTRANCE

NOTE: NO EROSION PREVENTION AND SEDIMENT CONTROL MEASURES ARE REQUIRED ON THIS SHEET.

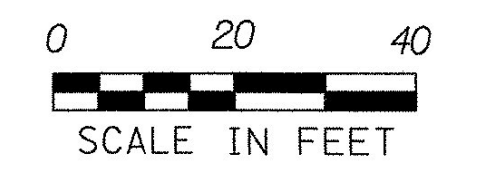

EROSION CONTROL & GRADING LAYOUT SHEET 5

DATUM
 VERTICAL NAVD 88
 HORIZONTAL NAD 83 (1996)

PROJECT NAME: SOUTH BURLINGTON
 PROJECT NUMBER: IM 089-3(37)
 FILE NAME: z03al78bdr.dgn
 PROJECT LEADER: KEN UPMAL
 DESIGNED BY: E.ATKINS/P.MILEWSKI
 PLOT DATE: 5/5/2006
 DRAWN BY: P.MILEWSKI
 CHECKED BY: K.JSHIKURA
 SHEET 49 OF 99