

STONE FILL, TYPE 1 (MOD. - CONSTRUCTION ENTRANCE)

RAMP 'D' 75+04 LT (STABILIZED CONSTRUCTION ENTRANCE)
RAMP 'D' 76+23 RT (STABILIZED CONSTRUCTION ENTRANCE)

GEOTEXTILE FOR ROADBED SUBGRADE SEPARATOR

RAMP 'D' 75+04 LT (STABILIZED CONSTRUCTION ENTRANCE)
RAMP 'D' 76+23 RT (STABILIZED CONSTRUCTION ENTRANCE)

SNOW FENCE (MOD. - PDF)

RAMP 'C' 45+00 LT ~ 50+00 LT
RAMP 'C' 45+55 RT ~ 50+00 RT
RAMP 'D' 75+00 RT ~ 76+68 RT

GEOTEXTILE FOR SILT FENCE

RAMP 'C' 45+50 RT ~ 49+70 RT
RAMP 'D' 75+00 RT ~ 75+80 RT
RAMP 'D' 75+98 RT ~ 76+64 RT

EROSION MATTING

RAMP 'C' 45+00 ~ 46+00 LT (GRASS CHANNEL)
RAMP 'D' 75+00 ~ 75+97 RT (GRASS CHANNEL)

SEED


RAMP 'C' 45+00 LT ~ 50+00 LT
RAMP 'C' 45+00 RT ~ 50+00 RT
RAMP 'D' 75+00 RT ~ 76+50 RT

SEED - WINTER RYE

RAMP 'C' 45+00 LT ~ 50+00 LT
RAMP 'C' 45+00 RT ~ 50+00 RT
RAMP 'D' 75+00 RT ~ 76+50 RT

HAY MULCH

RAMP 'C' 45+00 LT ~ 50+00 LT
RAMP 'C' 45+00 RT ~ 50+00 RT
RAMP 'D' 75+00 RT ~ 76+50 RT

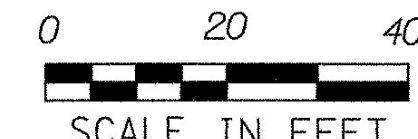

EROSION CONTROL & GRADING LAYOUT SHEET 6

EROSION CONTROL LEGEND	
	INLET PROTECTION (SEE DETAIL SHEETS FOR APPROPRIATE METHOD)
	TEMPORARY STONE CHECK DAM
	SILT FENCE
	PROJECT DEMARCATION FENCING (LIMIT OF DISTURBANCE)
	FILTER CURTAIN
	PROPOSED 10' INTERVAL CONTOUR
	PROPOSED 2' INTERVAL CONTOUR
	STONE DITCH
	DITCH W/ EROSION MATTING
	STABILIZED CONST. ENTRANCE

DATUM
VERTICAL NAVD 88
HORIZONTAL NAD 83 (1996)

PROJECT NAME: SOUTH BURLINGTON
PROJECT NUMBER: IM 089-3(37)
FILE NAME: z03a178bdr.dgn
PROJECT LEADER: KEN UPMAL
DESIGNED BY: E. ATKINS/P. MILEWSKI
PLOT DATE: 5/5/2006
DRAWN BY: P. MILEWSKI
CHECKED BY: K. ISHIKURA
SHEET 50 OF 99