
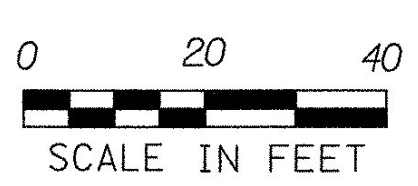


MATCHLINE STA. 14+00
PAVEMENT MARKING AND
SIGNING LAYOUT SHEET 1

MATCHLINE STA. 20+00
PAVEMENT MARKING AND
SIGNING LAYOUT SHEET 3

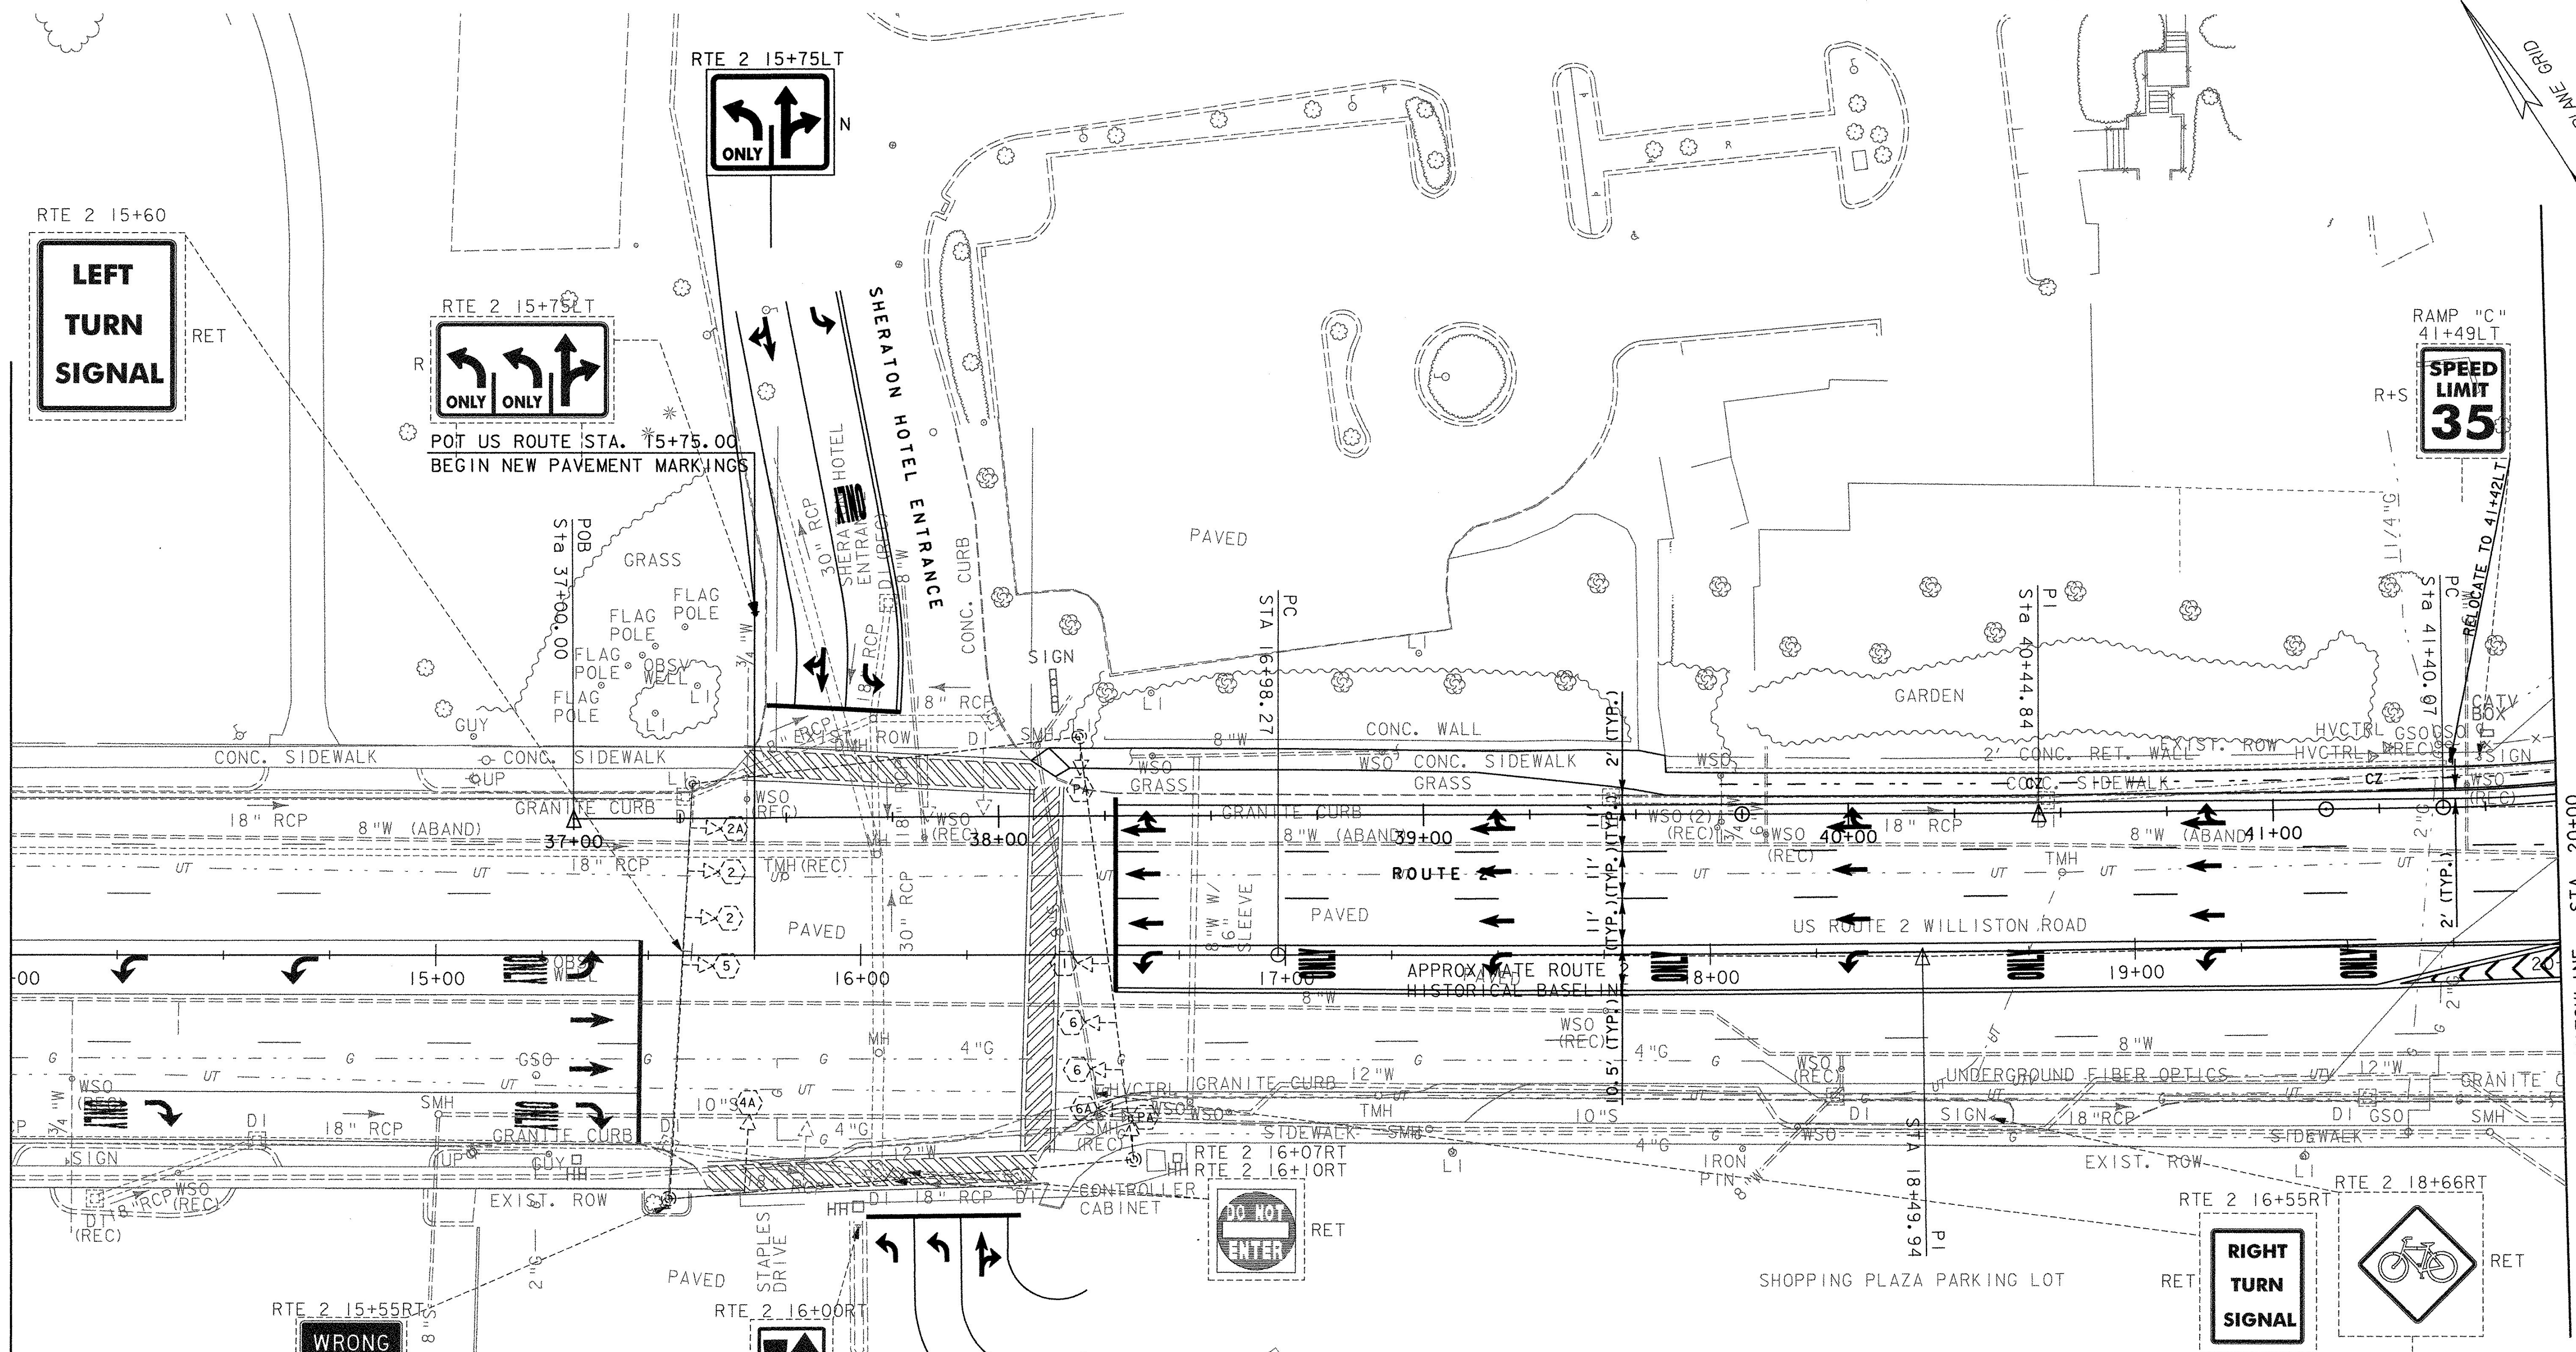

DATUM
VERTICAL NAVD 88
HORIZONTAL NAD 83 (1996)

SIGN LEGEND

	= EXISTING SIGN
	= NEW SIGN
R	= REMOVE EXISTING SIGN AND POST
R+S	= SALVAGE SIGN AND RELOCATE TO NOTED LOCATION WITH NEW SIGN POST, REMOVE AND DISPOSE EXISTING SIGN POST
N	= NEW
RET	= RETAIN AT EXISTING LOCATION
B-B	= BACK TO BACK

DURABLE 4" WHITE LINE
 RAMP "C" 37+39 ~ 37+52, LT, 94 LF
 RAMP "C" 37+50 ~ 37+64, LT, 97 LF
 RAMP "C" 37+80 ~ 37+93, RT, 48 LF
 RAMP "C" 37+91 ~ 38+20, RT, 59 LF
 RAMP "C" 38+02 ~ 38+20, RT, 34 LF
 RAMP "C" 38+27 ~ 41+67, LT, 340 LF
 RAMP "C" 38+27 ~ 41+24, RT, 297 LF
 RAMP "C" 38+27 ~ 41+67, RT, 9 X 10' = 90 LF
 RAMP "C" 38+27 ~ 41+67, RT, 9 X 10' = 90 LF

DURABLE 4" YELLOW LINE
 RAMP "C" 38+27 ~ 41+23, RT, 296' X 2 LINES = 592 LF
 RAMP "C" 41+23 ~ 41+67, RT, 44' X 2 LINES = 88 LF
 RAMP "C" 41+23 ~ 41+67, RT, 44' X 2 LINES = 88 LF
 RAMP "C" 37+62 ~ 37+77 LT, 99' X 2 LINES = 198 LF

TEMPORARY 8" YELLOW LINE
 RAMP "C" 41+30 ~ 41+67, RT, 32 LF

DURABLE 24" STOP BAR
 SHERATON DRIVEWAY, 32 LF
 STAPLES DRIVEWAY, 36 LF
 RAMP "C" 38+27, 46 LF

TEMPORARY 4" YELLOW LINE
 RAMP "C" 38+27 ~ 41+23, RT, 296' X 2 LINES = 592 LF
 RAMP "C" 41+23 ~ 41+67, RT, 44' X 2 LINES = 88 LF
 RAMP "C" 41+23 ~ 41+67, RT, 44' X 2 LINES = 88 LF

TEMPORARY 24" STOP BAR
 RAMP "C" 38+27, 46 LF

DURABLE LETTER OR SYMBOL
 RAMP "C" 37+47 ~ 37+71, LT, OTY=5 EA:
 2 THRU/RIGHT ARROWS
 2 LEFT ARROWS
 1 "ONLY" (11 X 4 = 4)
 RAMP "C" 37+71 ~ 38+00, RT, OTY=3 EA:
 1 THRU/RIGHT ARROWS
 2 LEFT ARROWS
 RAMP "C" 38+30 ~ 41+11, RT, OTY =20 EA:
 4 THRU/RIGHT ARROWS
 8 THRU ARROWS
 4 LEFT ARROWS
 4 "ONLY" (4X4=16)

TEMPORARY LETTER OR SYMBOL
 RAMP "C" 38+30 ~ 41+11, RT, OTY =20 EA:
 4 THRU/RIGHT ARROWS
 8 THRU ARROWS
 4 LEFT ARROWS
 4 "ONLY" (4X4=16)

ERECTING SALVAGED SIGNS
 1 EACH

REMOVAL OF EXISTING PAVEMENT MARKINGS
 RAMP "C" 37+39 ~ 37+77 LT
 RAMP "C" 38+27 ~ 39+75 LT-RT

PAVEMENT MARKING AND SIGNING LAYOUT SHEET 2

PROJECT NAME: SOUTH BURLINGTON	PLOT DATE: 5/5/2006
PROJECT NUMBER: IM 089-3(37)	DRAWN BY: V.KACOYANNAKIS
FILE NAME: z03a178pmbdr.dgn	CHECKED BY: J.FORD
PROJECT LEADER: KEN UPMAL	SHEET 55 OF 99
DESIGNED BY: V.KACOYANNAKIS	