


MATCHLINE STA. 20+00
PAVEMENT MARKING AND
SIGNING LAYOUT SHEET 2

MATCHLINE STA. 25+00
PAVEMENT MARKING AND
SIGNING LAYOUT SHEET 4

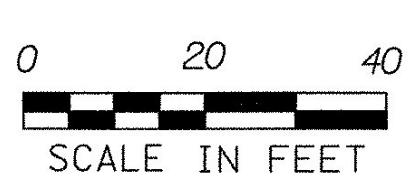

DATUM
VERTICAL NAVD 88
HORIZONTAL NAD 83 (1996)

SIGN LEGEND

- = EXISTING SIGN
- = NEW SIGN
- R = REMOVE EXISTING SIGN AND POST
- R+S = SALVAGE SIGN AND RELOCATE TO NOTED LOCATION WITH NEW SIGN POST. REMOVE AND DISPOSE EXISTING SIGN POST
- N = NEW
- RET = RETAIN AT EXISTING LOCATION
- B-B = BACK TO BACK

DURABLE 4' WHITE LINE
 RAMP 'C' 41+67 ~ 43+03, 136 LF
 RAMP 'C' 41+67 ~ 43+00, 24 X 2' = 48 LF
 RAMP 'C' 43+19 ~ 45+00, 5 X 10' = 50 LF
 RAMP 'D' 72+42 ~ 72+77, LT, 37 LF
 US ROUTE 2 21+06 ~ 25+00 LT, 392 LF
 US ROUTE 2 20+00 ~ 25+00 LT, 13 X 10', 130 LF
 US ROUTE 2 20+00 ~ 25+00 LT, 13 X 10', 130 LF

DURABLE 6' WHITE LINE
 RAMP 'C' 43+17 ~ 45+00, 184 LF
 RAMP 'D' 72+92 ~ 75+00, 212 LF

TEMPORARY 4' WHITE LINE
 RAMP 'C' 41+67 ~ 43+03, 136 LF
 RAMP 'C' 41+67 ~ 43+00, 24 X 2' = 48 LF
 RAMP 'C' 43+19 ~ 45+00, 5 X 10' = 50 LF
 RAMP 'D' 72+42 ~ 72+77, LT, 37 LF
 US ROUTE 2 21+06 ~ 25+00 LT, 392 LF
 US ROUTE 2 20+00 ~ 25+00 LT, 13 X 10', 130 LF
 US ROUTE 2 20+00 ~ 25+00 LT, 13 X 10', 130 LF

TEMPORARY 6' WHITE LINE
 RAMP 'C' 43+17 ~ 45+00, 184 LF
 RAMP 'D' 72+92 ~ 75+00, 212 LF

DURABLE 8' YELLOW LINE
 US ROUTE 2 CHEVRON MARKINGS,
 20+00 ~ 20+57, 22 LF

DURABLE 24" STOP BAR
 RAMP 'C' 43+19, 30 LF
 US ROUTE 2 21+37, 33 LF

TEMPORARY 8' YELLOW LINE
 US ROUTE 2 CHEVRON MARKINGS,
 20+00 ~ 20+57, 22 LF

TEMPORARY 24" STOP BAR
 RAMP 'C' 43+19, 30 LF
 US ROUTE 2 21+37, 33 LF

TEMPORARY LETTER OR SYMBOL BAR TYPE
 RAMP 'C' 43+12, 30 LF
 RAMP 'D' 72+89, 22 LF

TEMPORARY CROSSWALK BAR TYPE
 RAMP 'C' 43+12, 30 LF
 RAMP 'D' 72+89, 22 LF

NOTE:
SEE SHEET NO. 69 FOR BAR TYPE CROSSWALK DETAIL

TEMPORARY 6' YELLOW LINE
 RAMP 'C' 43+19 ~ 45+00, 171 LF
 RAMP 'D' 72+92 ~ 75+00, 226 LF

REMOVING SIGNS
 6 EACH

ERECTING SALVAGED SIGNS
 2 EACH

PAINTED ISLAND (MOD. - GREEN BIKE PATH)
 RAMP 'D' CROSSING
 15' WIDTH - 110 SF
 RAMP 'D' 72+50 RT - 72+83 RT
 15' WIDTH - 150 SF

DURABLE 4' YELLOW LINE
 US ROUTE 2 20+00 ~ 20+72, RT, 65' X 2 LINES, 130 LF
 US ROUTE 2 20+00 ~ 20+05, 3.5' X 2 LINES, 7 LF
 US ROUTE 2 20+00 ~ 25+00 LT, 495 LF

TEMPORARY 4' YELLOW LINE
 US ROUTE 2 20+00 ~ 20+72, RT, 65' X 2 LINES, 130 LF
 US ROUTE 2 20+00 ~ 20+05, 3.5' X 2 LINES, 7 LF
 US ROUTE 2 20+00 ~ 25+00 LT, 495 LF

DURABLE 12' WHITE LINE
 RAMP 'C' GORE AREA TOTAL 112 LF
 RAMP 'D' GORE AREA TOTAL 154 LF

TEMPORARY 12' WHITE LINE
 RAMP 'C' GORE AREA TOTAL 112 LF
 RAMP 'D' GORE AREA TOTAL 154 LF

PAVEMENT MARKING AND SIGNING LAYOUT SHEET 3

PROJECT NAME: SOUTH BURLINGTON	PLOT DATE: 5/5/2006
PROJECT NUMBER: IM 089-3(37)	DRAWN BY: V.KACOYANNAKIS
FILE NAME: z03a178pmbdr.dgn	CHECKED BY: J.FORD
PROJECT LEADER: KEN UPMAL	SHEET 56 OF 99
DESIGNED BY: V.KACOYANNAKIS	