


MATCHLINE STA. 55+00
PAVEMENT MARKING AND
SIGNING LAYOUT SHEET 7

MATCHLINE STA. 60+00
PAVEMENT MARKING AND
SIGNING LAYOUT SHEET 9

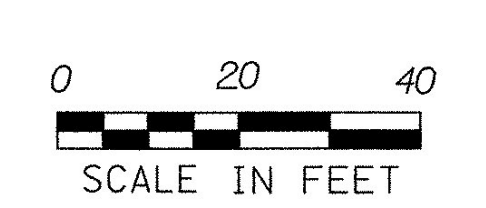

DATUM
VERTICAL NAVD 88
HORIZONTAL NAD 83 (1996)

SIGN LEGEND

	= EXISTING SIGN
	= NEW SIGN
	= REMOVE EXISTING SIGN AND POST
	= SALVAGE SIGN AND RELOCATE TO NOTED LOCATION WITH NEW SIGN POST, REMOVE AND DISPOSE EXISTING SIGN POST
	= NEW
	= RETAIN AT EXISTING LOCATION
	= BACK TO BACK

DURABLE 6" WHITE LINE
RAMP 'C' 55+00 ~ 60+00, 500 LF
I-89 212+61 ~ 217+75, 12X10' = 120' LF

TEMPORARY 6" WHITE LINE
RAMP 'C' 55+00 ~ 60+00, 500 LF

DURABLE 6" YELLOW LINE
RAMP 'C' 55+00 ~ 56+55, 156 LF
I-89 212.61 ~ 217.75, 514 LF

TEMPORARY 6" YELLOW LINE
RAMP 'C' 55+00 ~ 56+55, 156 LF

DURABLE 12" WHITE LINE
RAMP 'C' 56+55 ~ 60+00, 345 LF
I-89 212+72 ~ 217+80, 725 LF
CHEVRON MARKINGS 56+90 ~ 56+55, 890 LF

TEMPORARY 12" WHITE LINE
RAMP 'C' 56+55 ~ 60+00, 345 LF
CHEVRON MARKINGS 56+90 ~ 56+55, 890 LF

REMOVING SIGNS
2 EACH

OVERHEAD TRAFFIC SIGN SUPPORT, REMOVED
I-89 213+50

REMOVAL OF EXISTING PAVEMENT MARKINGS

NOTE: I-89 212+60 ~ 217+78 LT
SEE TRAFFIC MANAGEMENT PLANS FOR TEMPORARY PAVEMENT MARKINGS ON I-89.

PAVEMENT MARKING AND SIGNING LAYOUT SHEET 8

PROJECT NAME: SOUTH BURLINGTON	PLOT DATE: 5/5/2006
PROJECT NUMBER: IM 089-3(37)	DRAWN BY: V.KACOYANNAKIS
FILE NAME: z03al78pmbdr.dgn	CHECKED BY: J.FORD
DESIGNED BY: V.KACOYANNAKIS	SHEET 61 OF 99