




48+66.45 PT

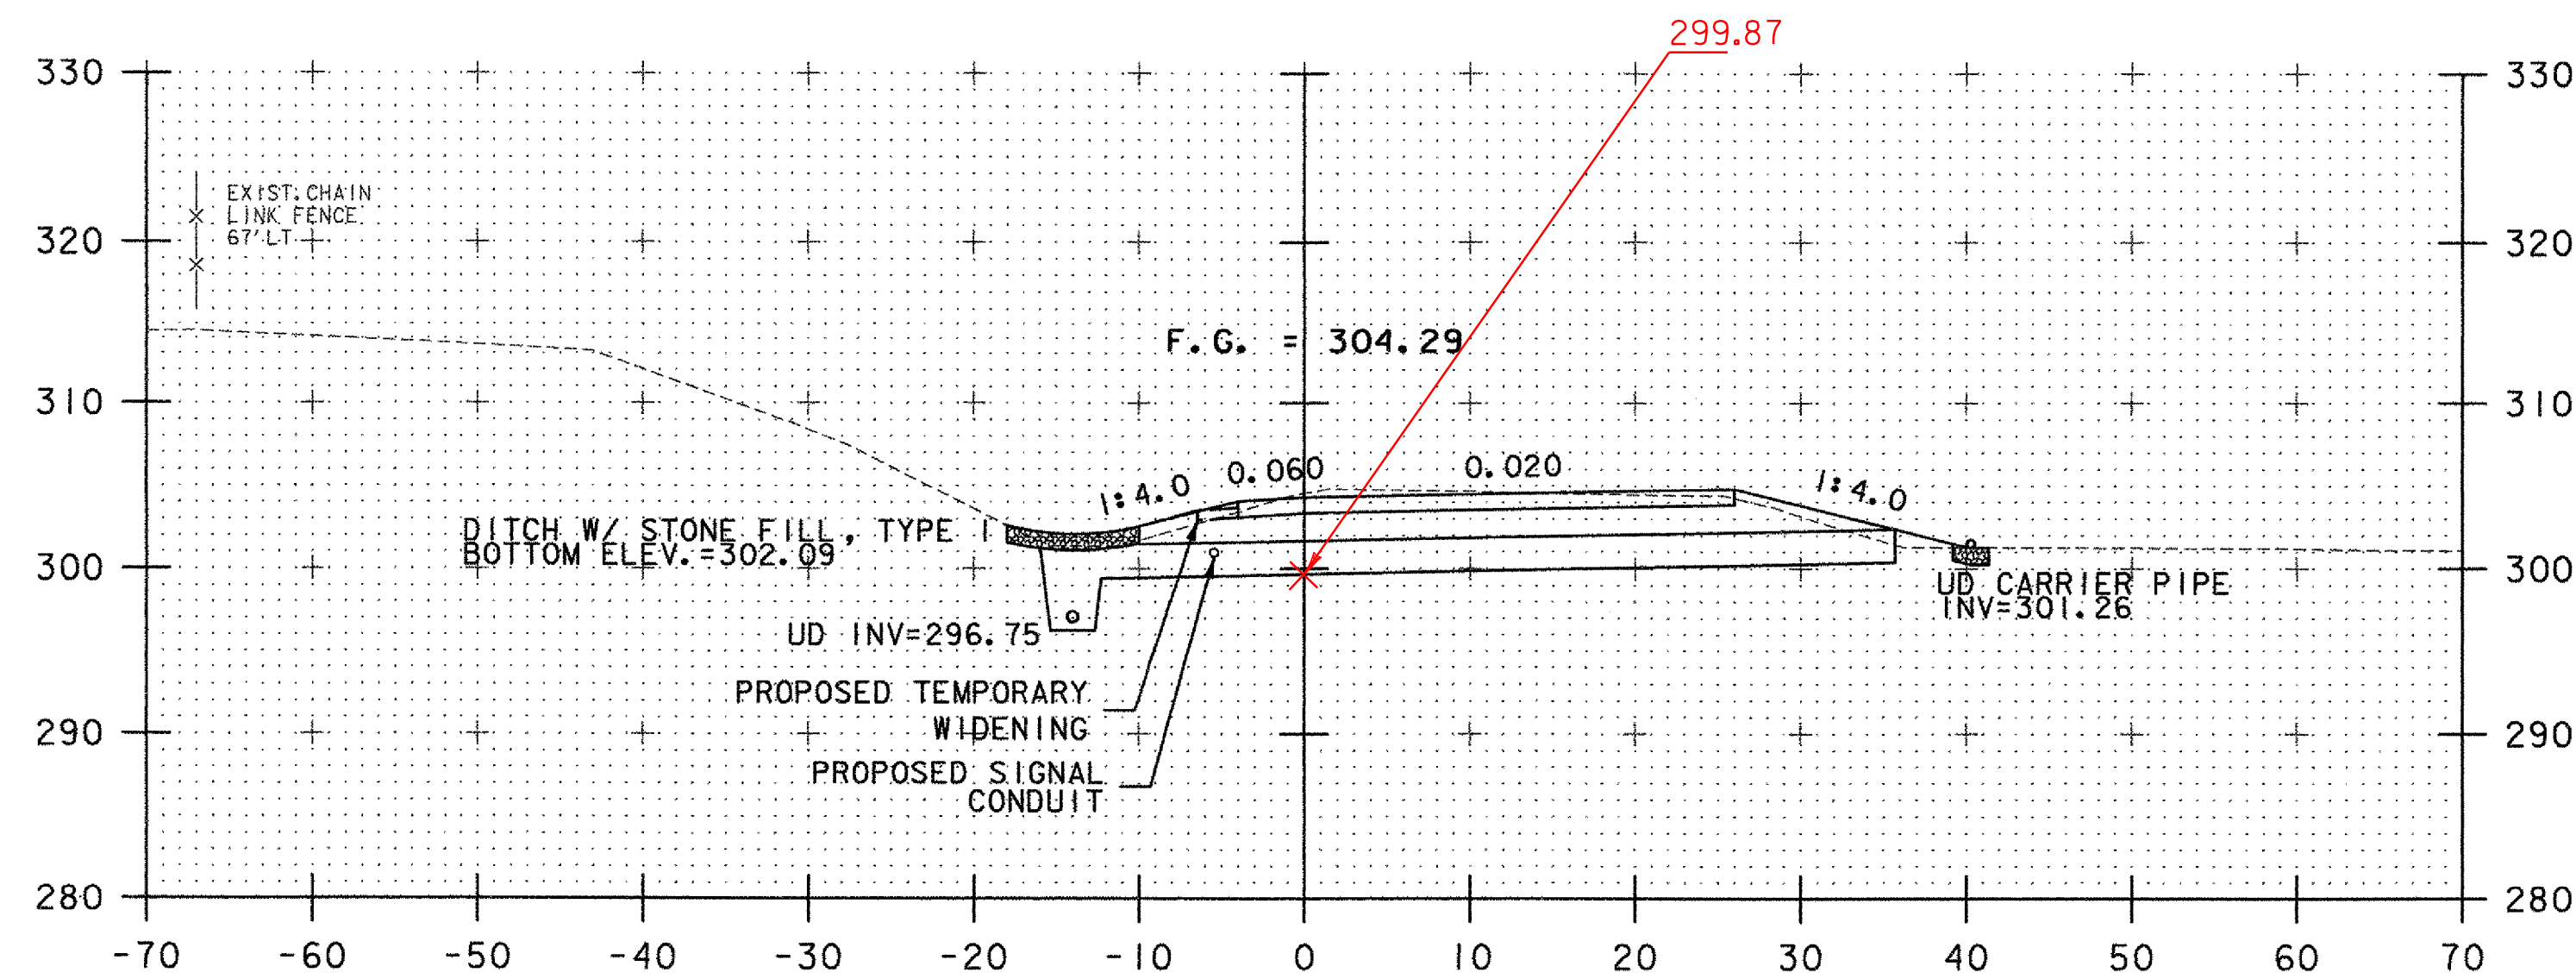


50+00

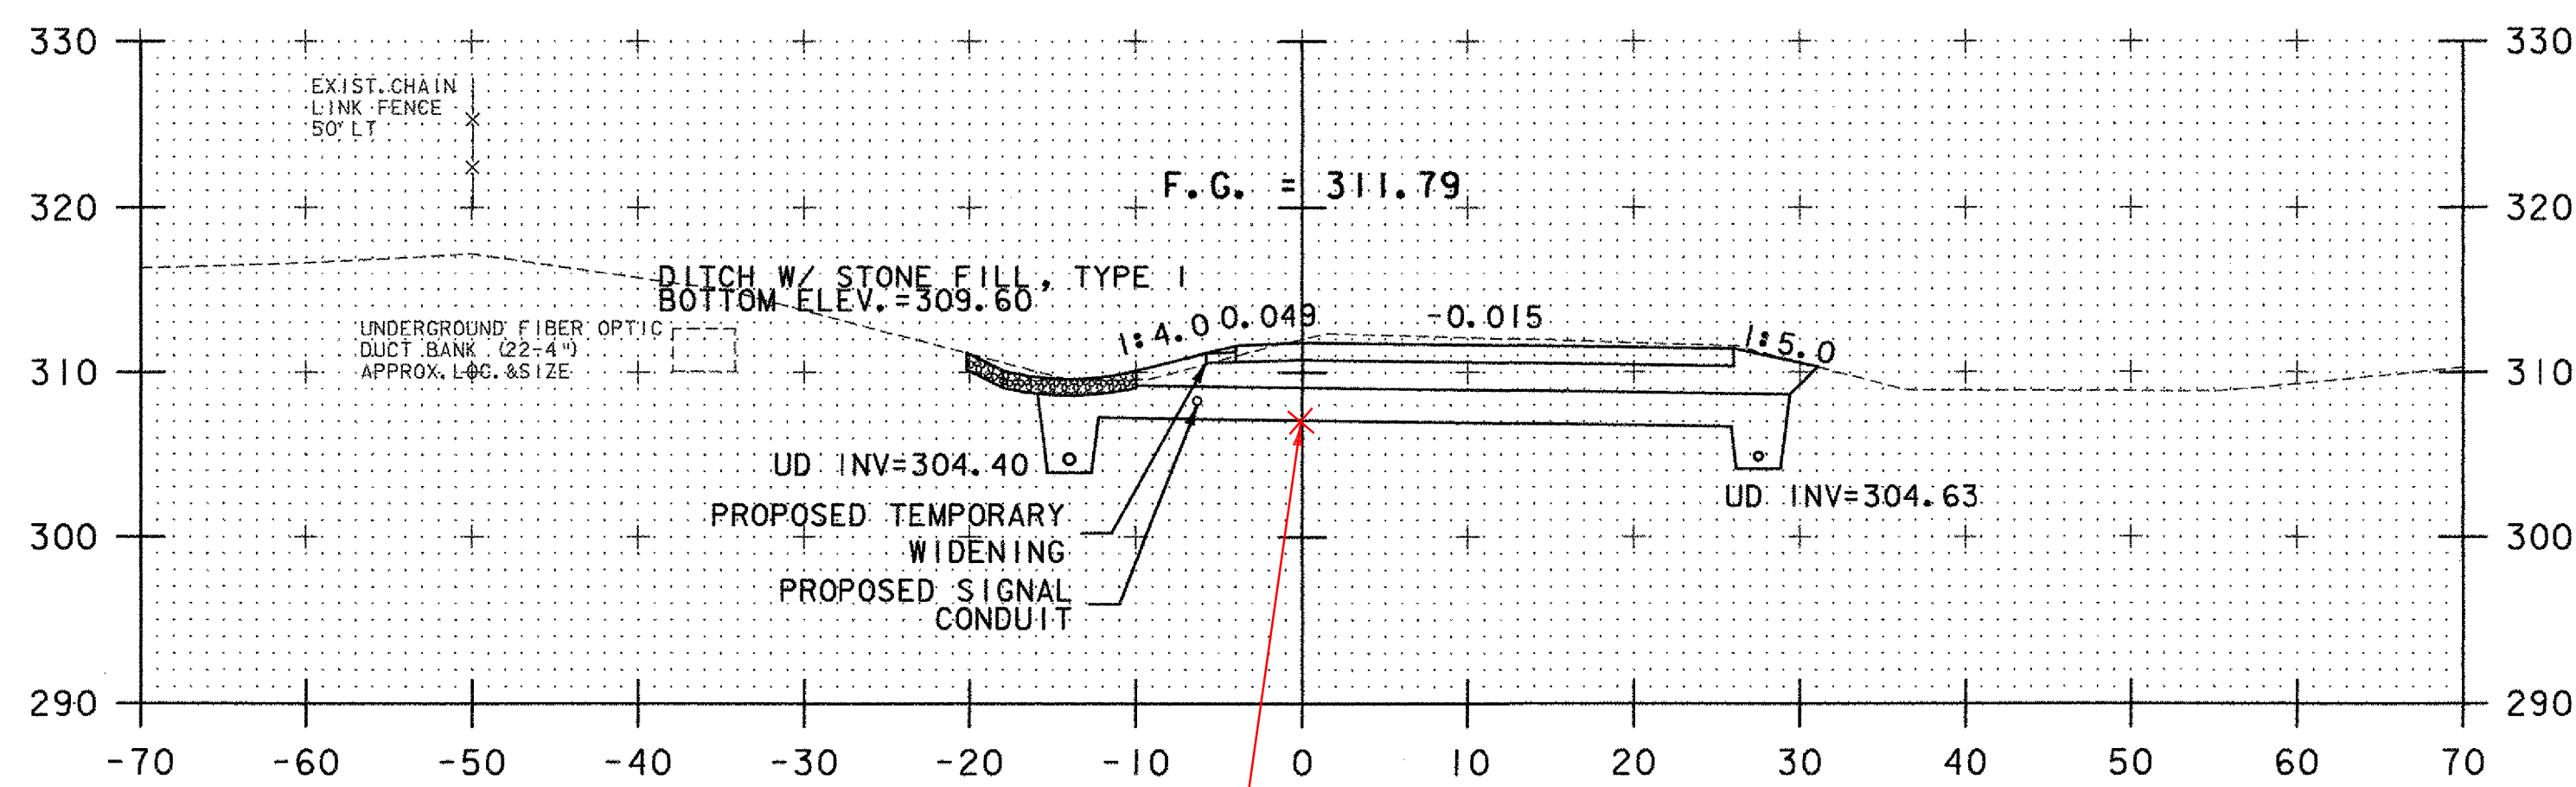


48+50

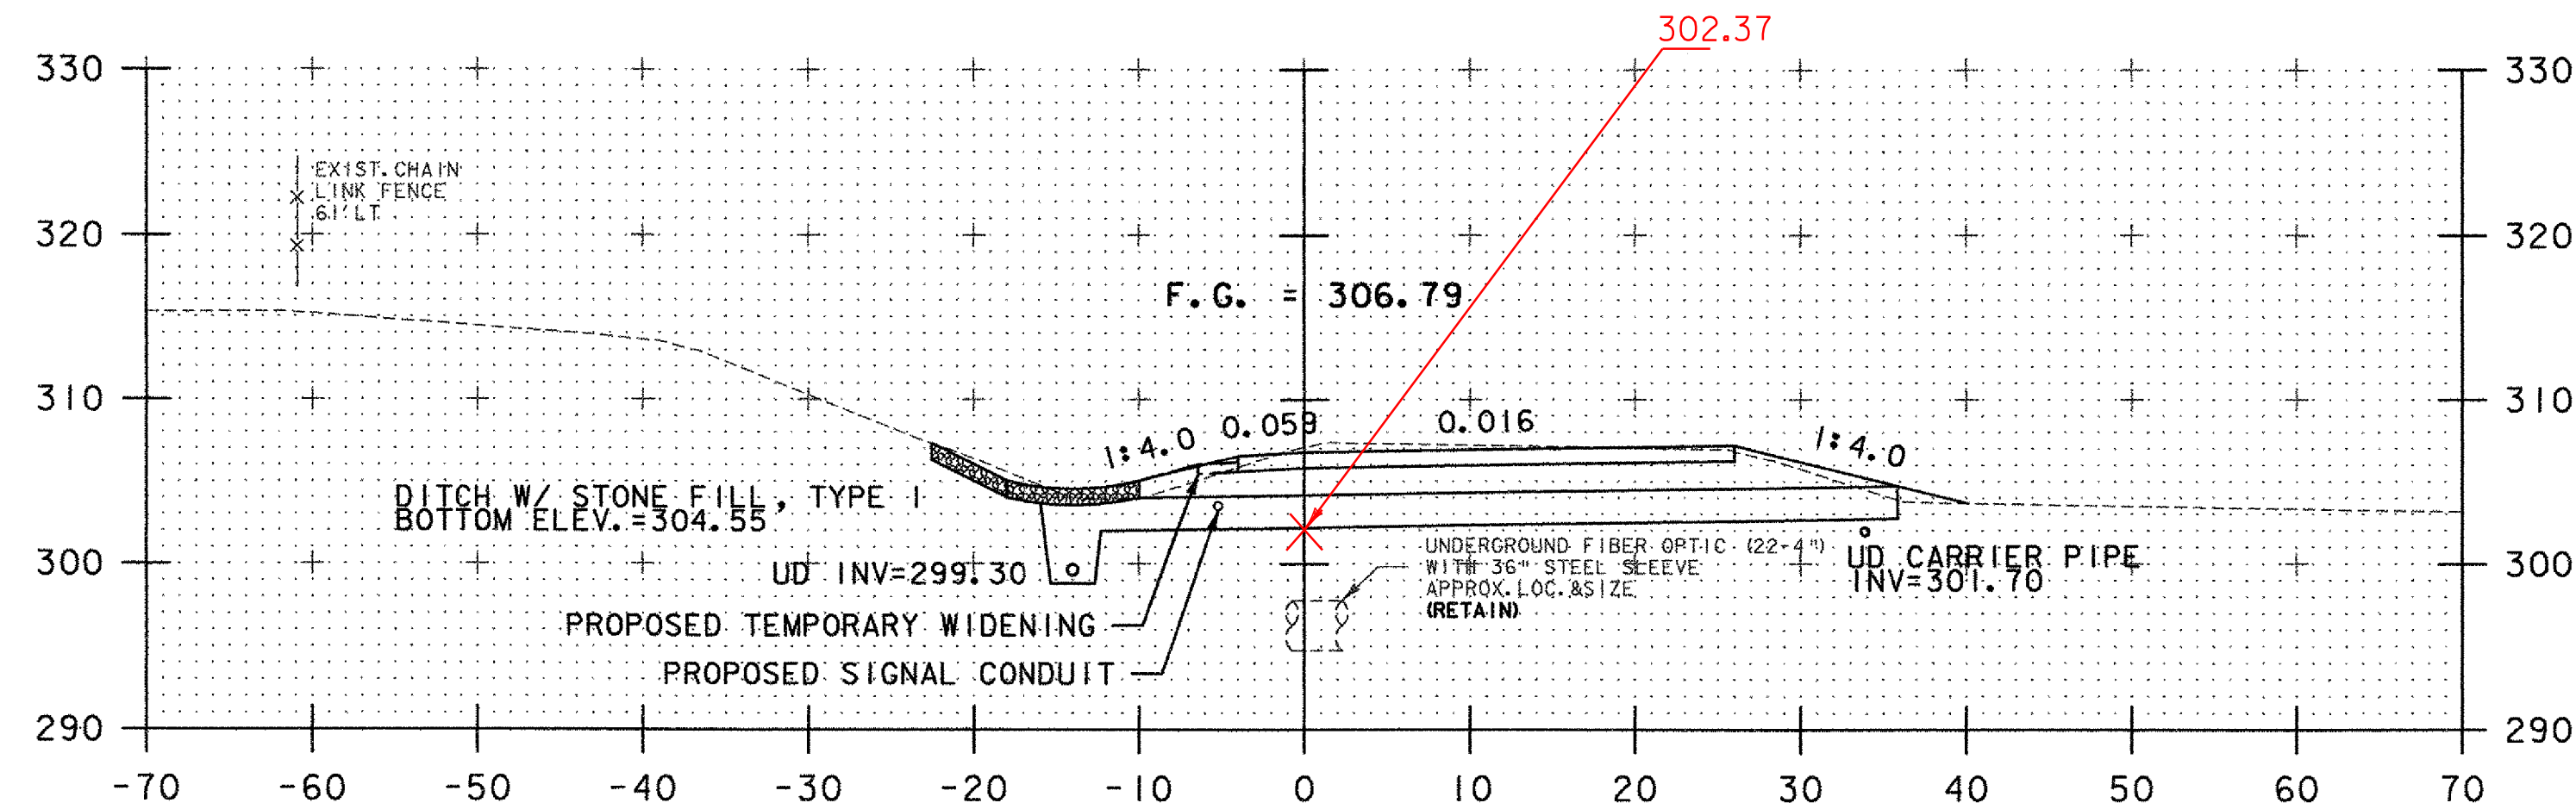

49+50

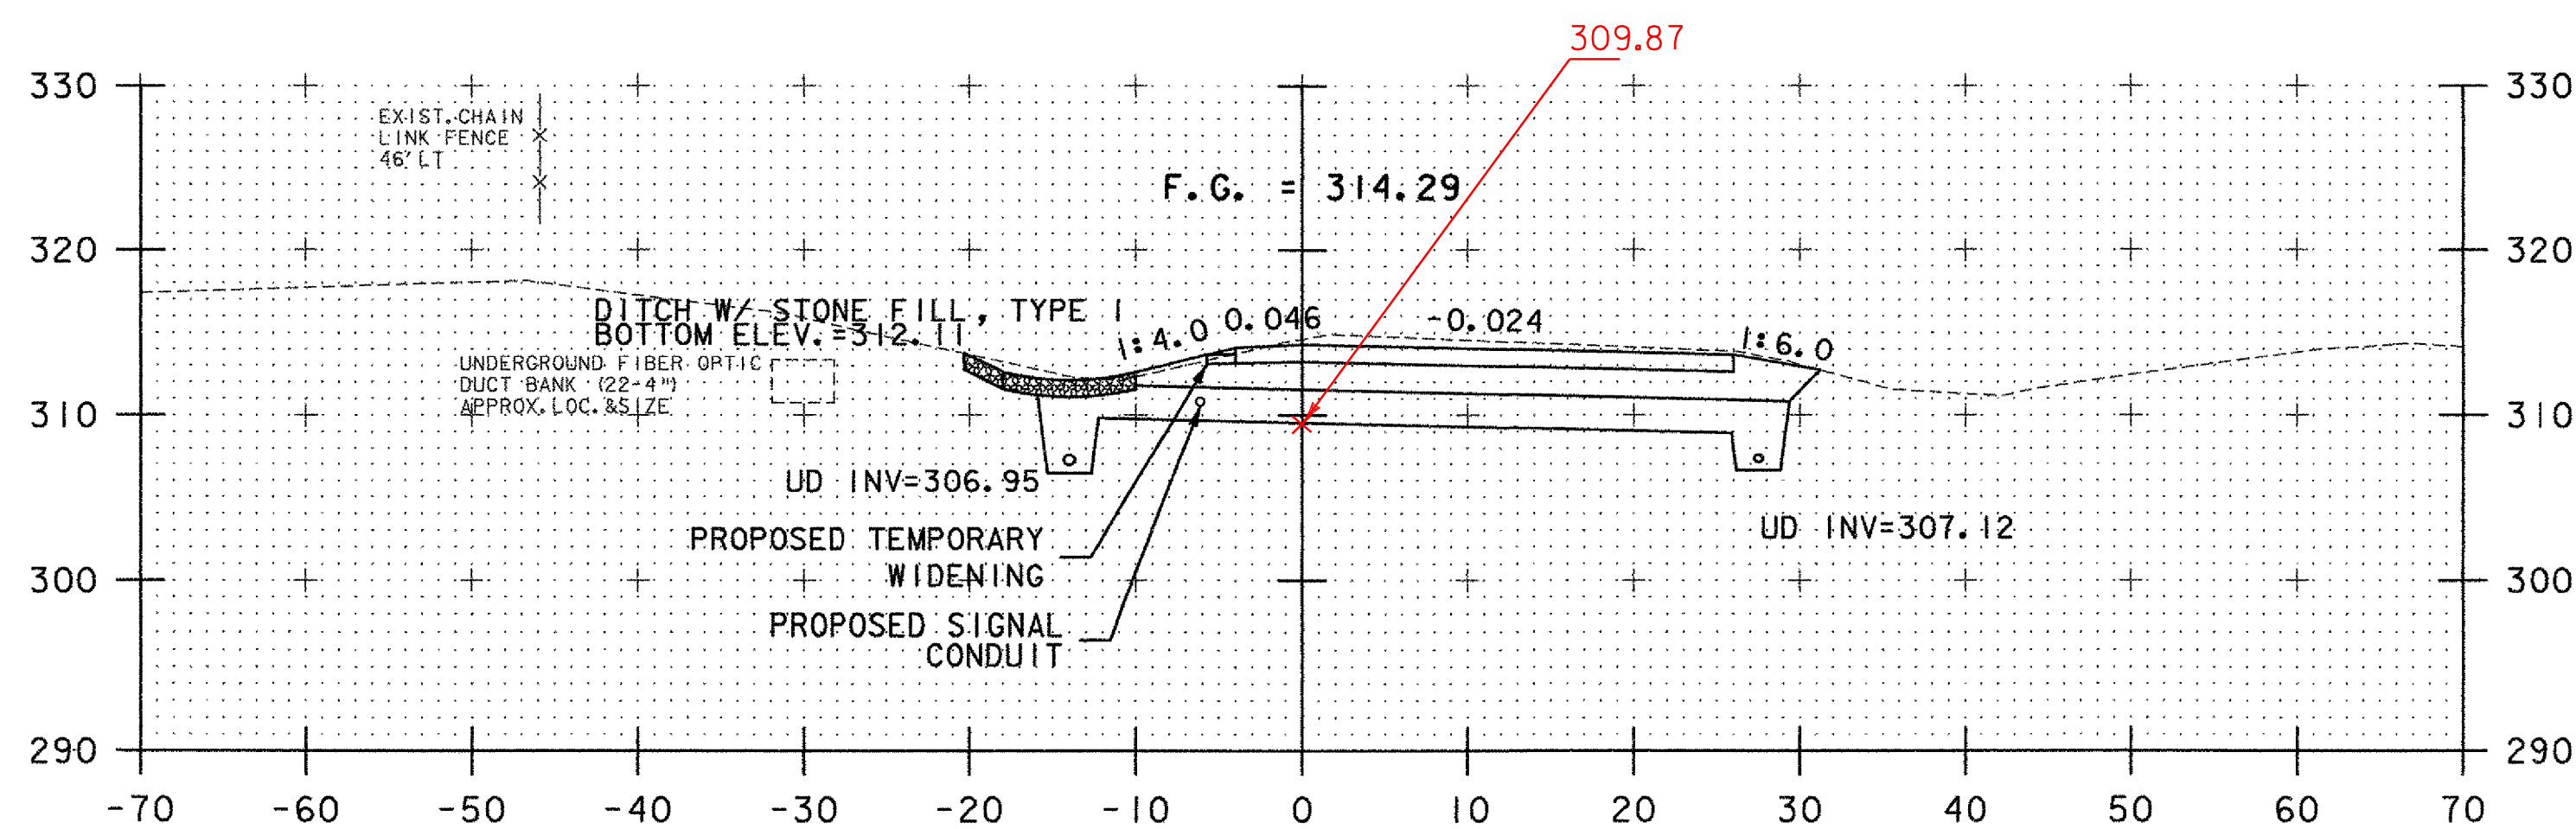


48+00

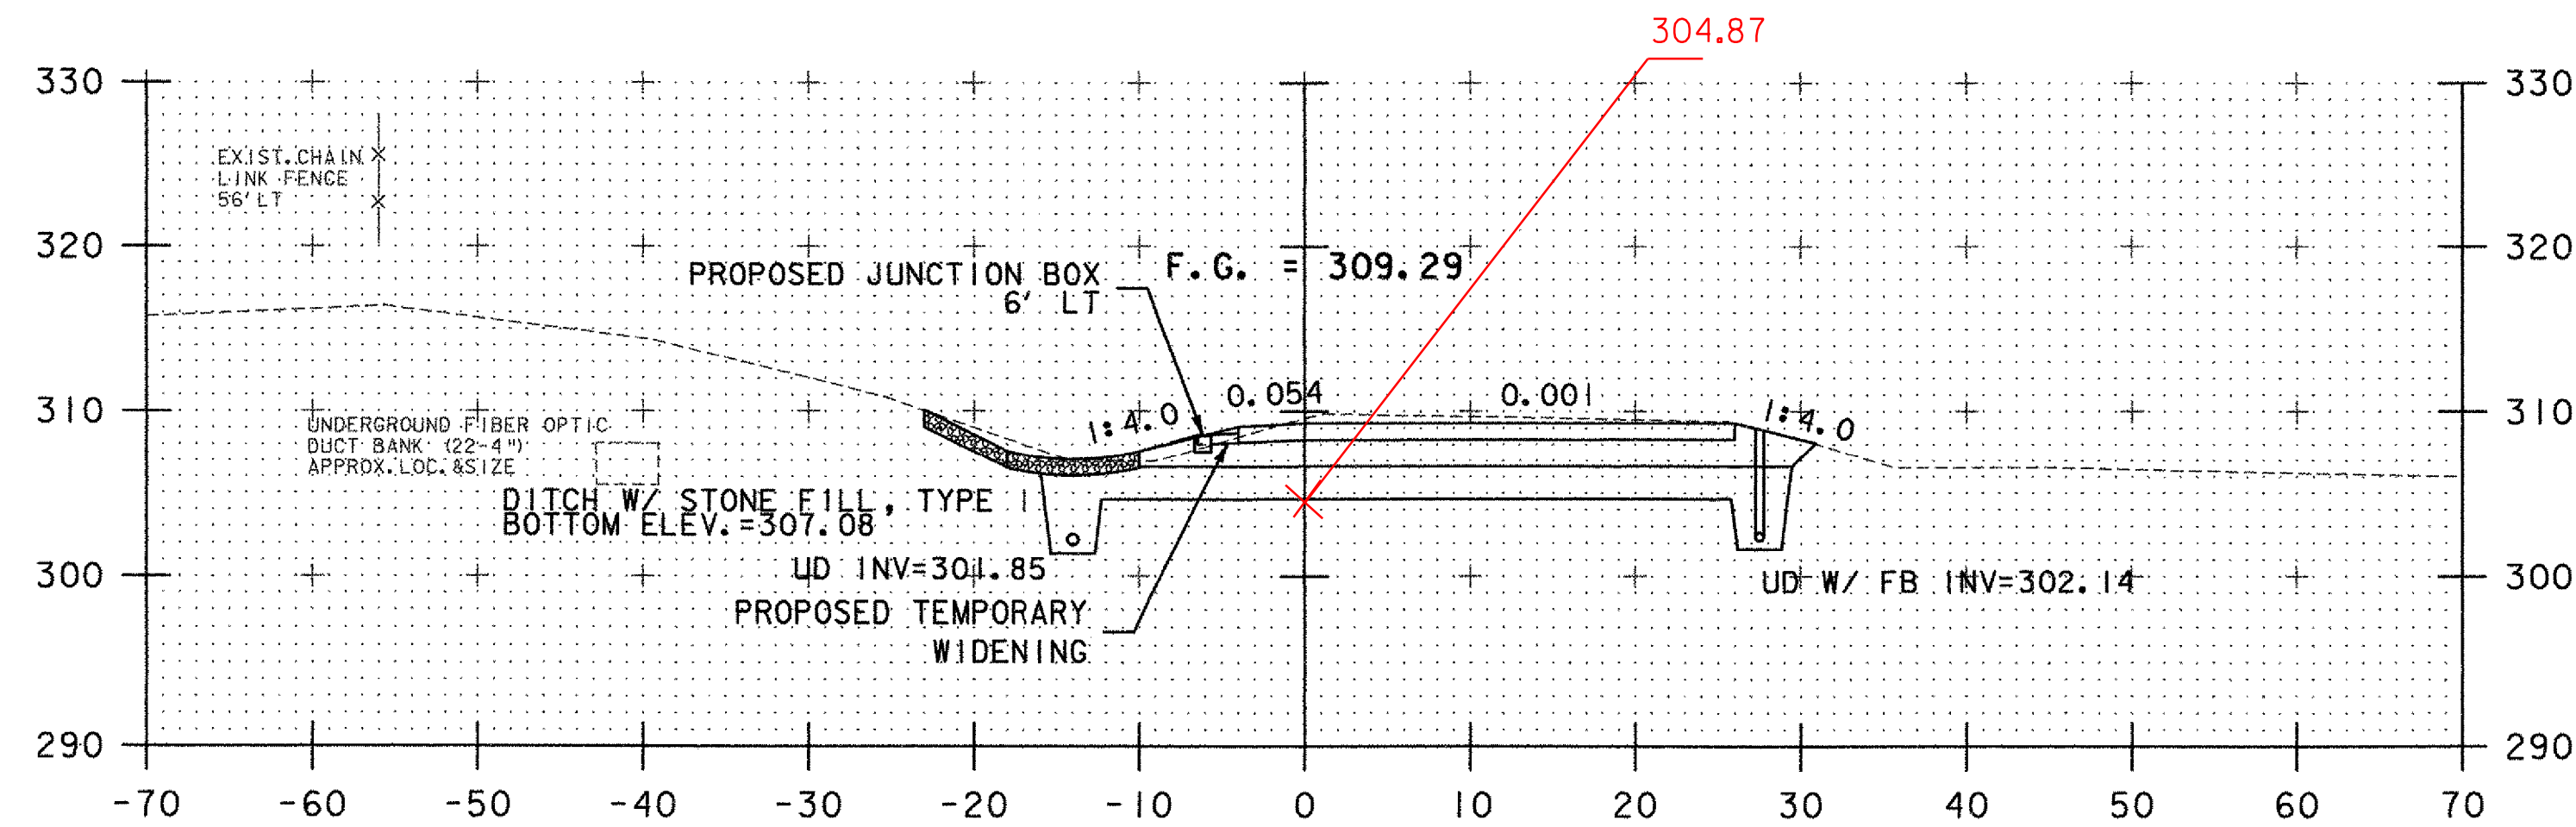

49+00

RAMP "C" SECTIONS SHEET 5

| | |
|--------------------------------|-------------------------|
| PROJECT NAME: SOUTH BURLINGTON | |
| PROJECT NUMBER: IM 089-3(37) | |
| FILE NAME: z03a178xs.dgn | PLOT DATE: 5/5/2006 |
| PROJECT LEADER: KEN UPMAL | DRAWN BY: E. ATKINS |
| DESIGNED BY: E. ATKINS | CHECKED BY: K. ISHIKURA |
| | SHEET 86 OF 99 |

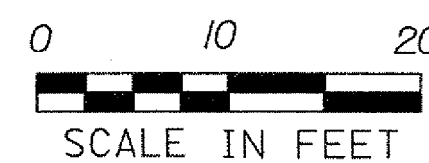

STA. 48+00 TO STA. 50+00

DATUM
VERTICAL NAVD 88
HORIZONTAL NAD 83 (1996)