




52+61.09 PC

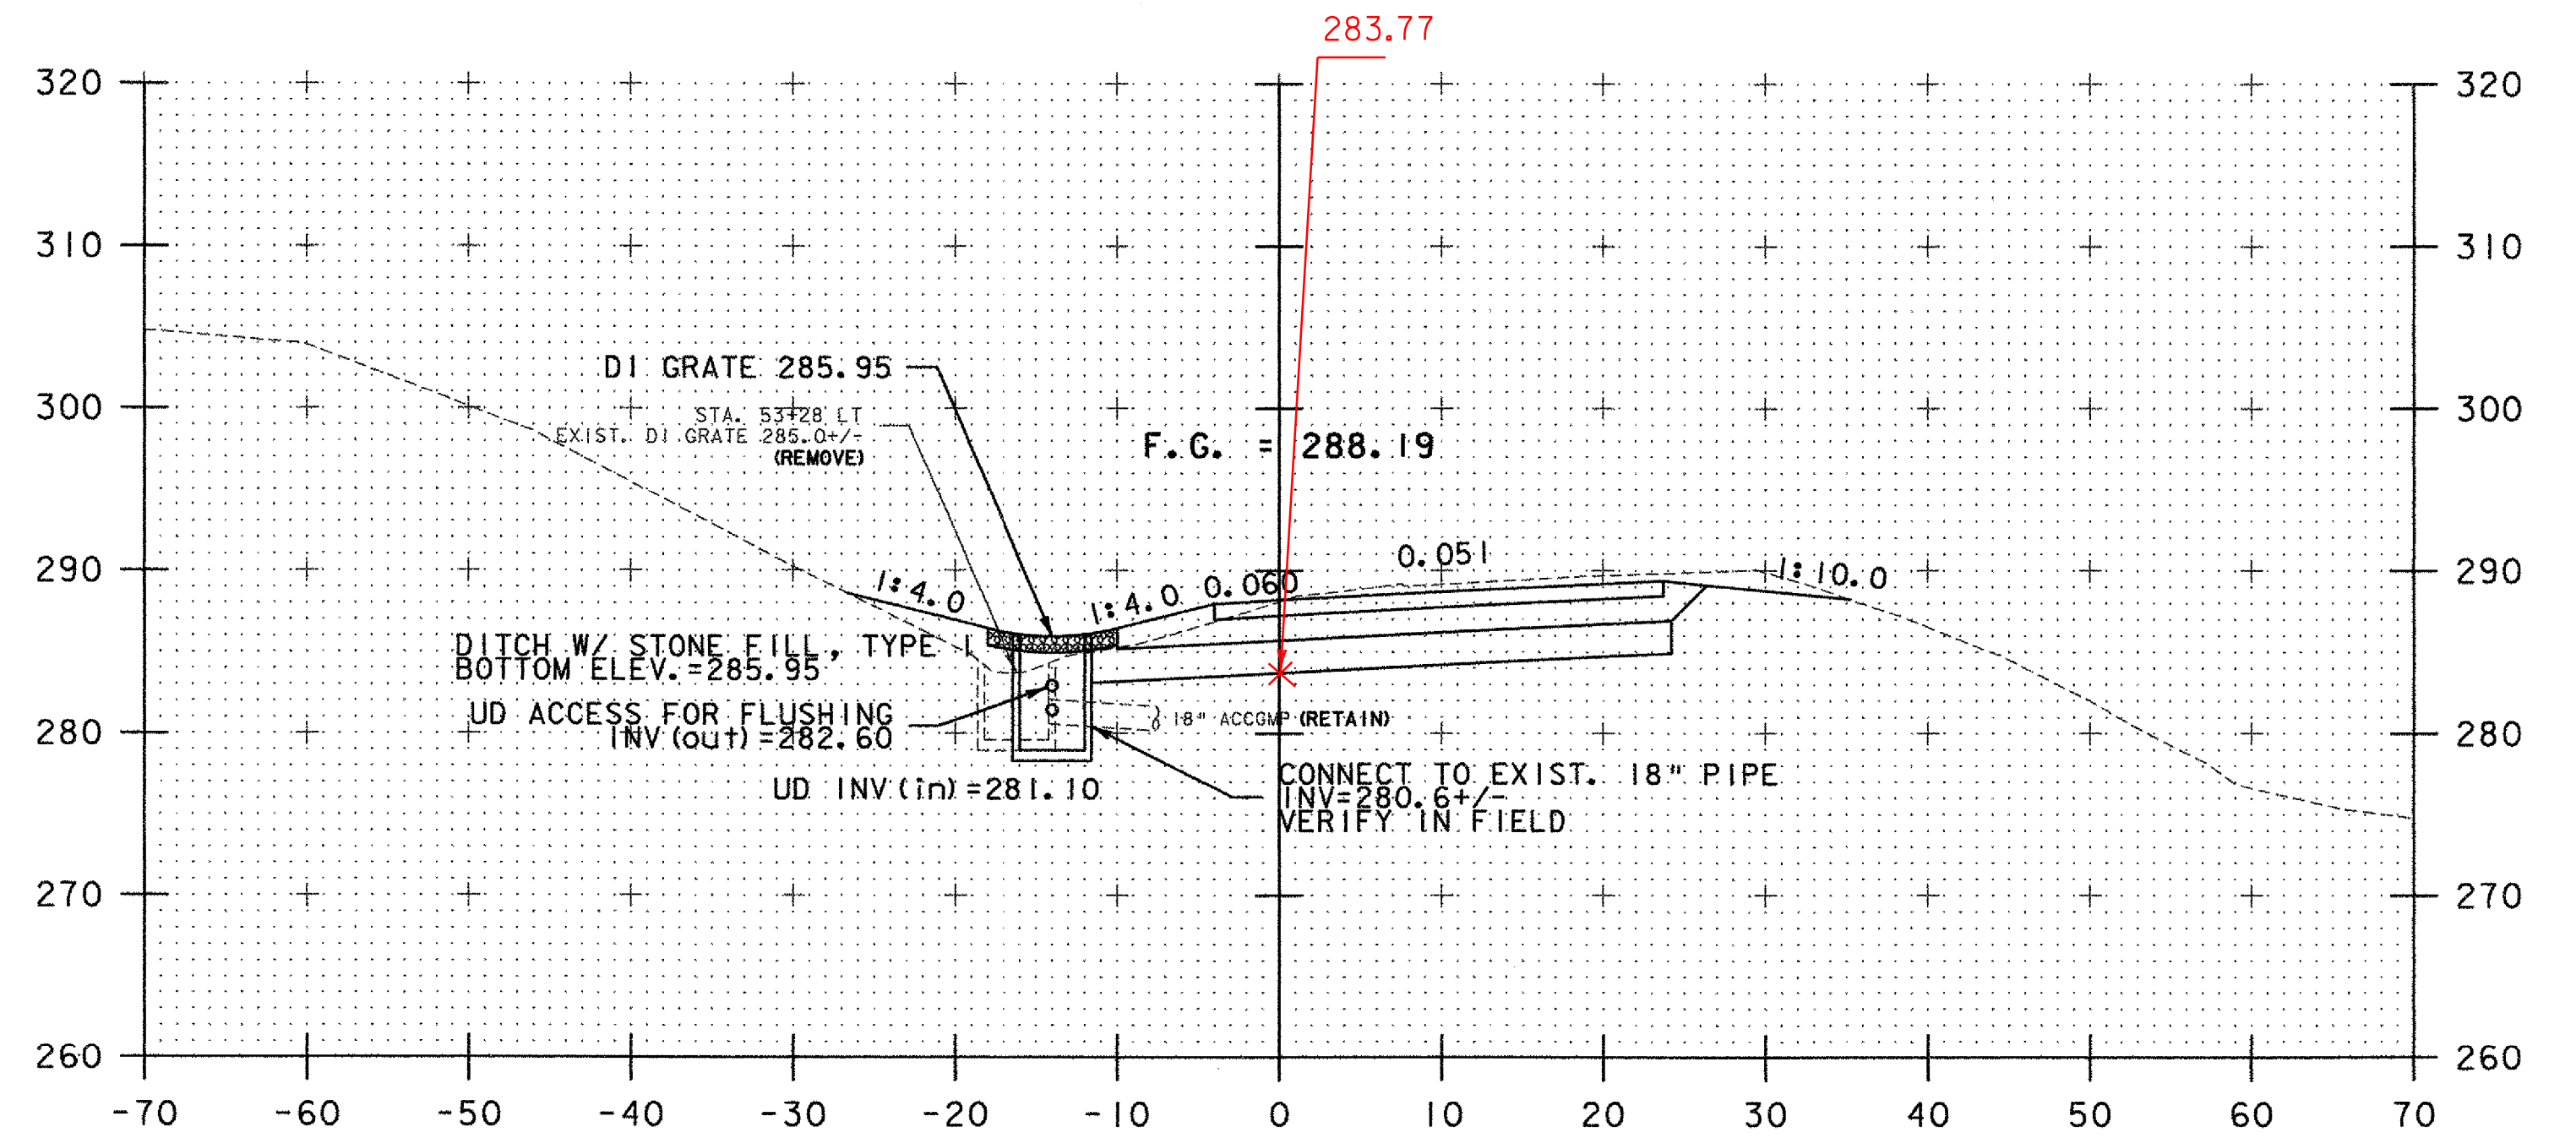

53+27.08  
DI

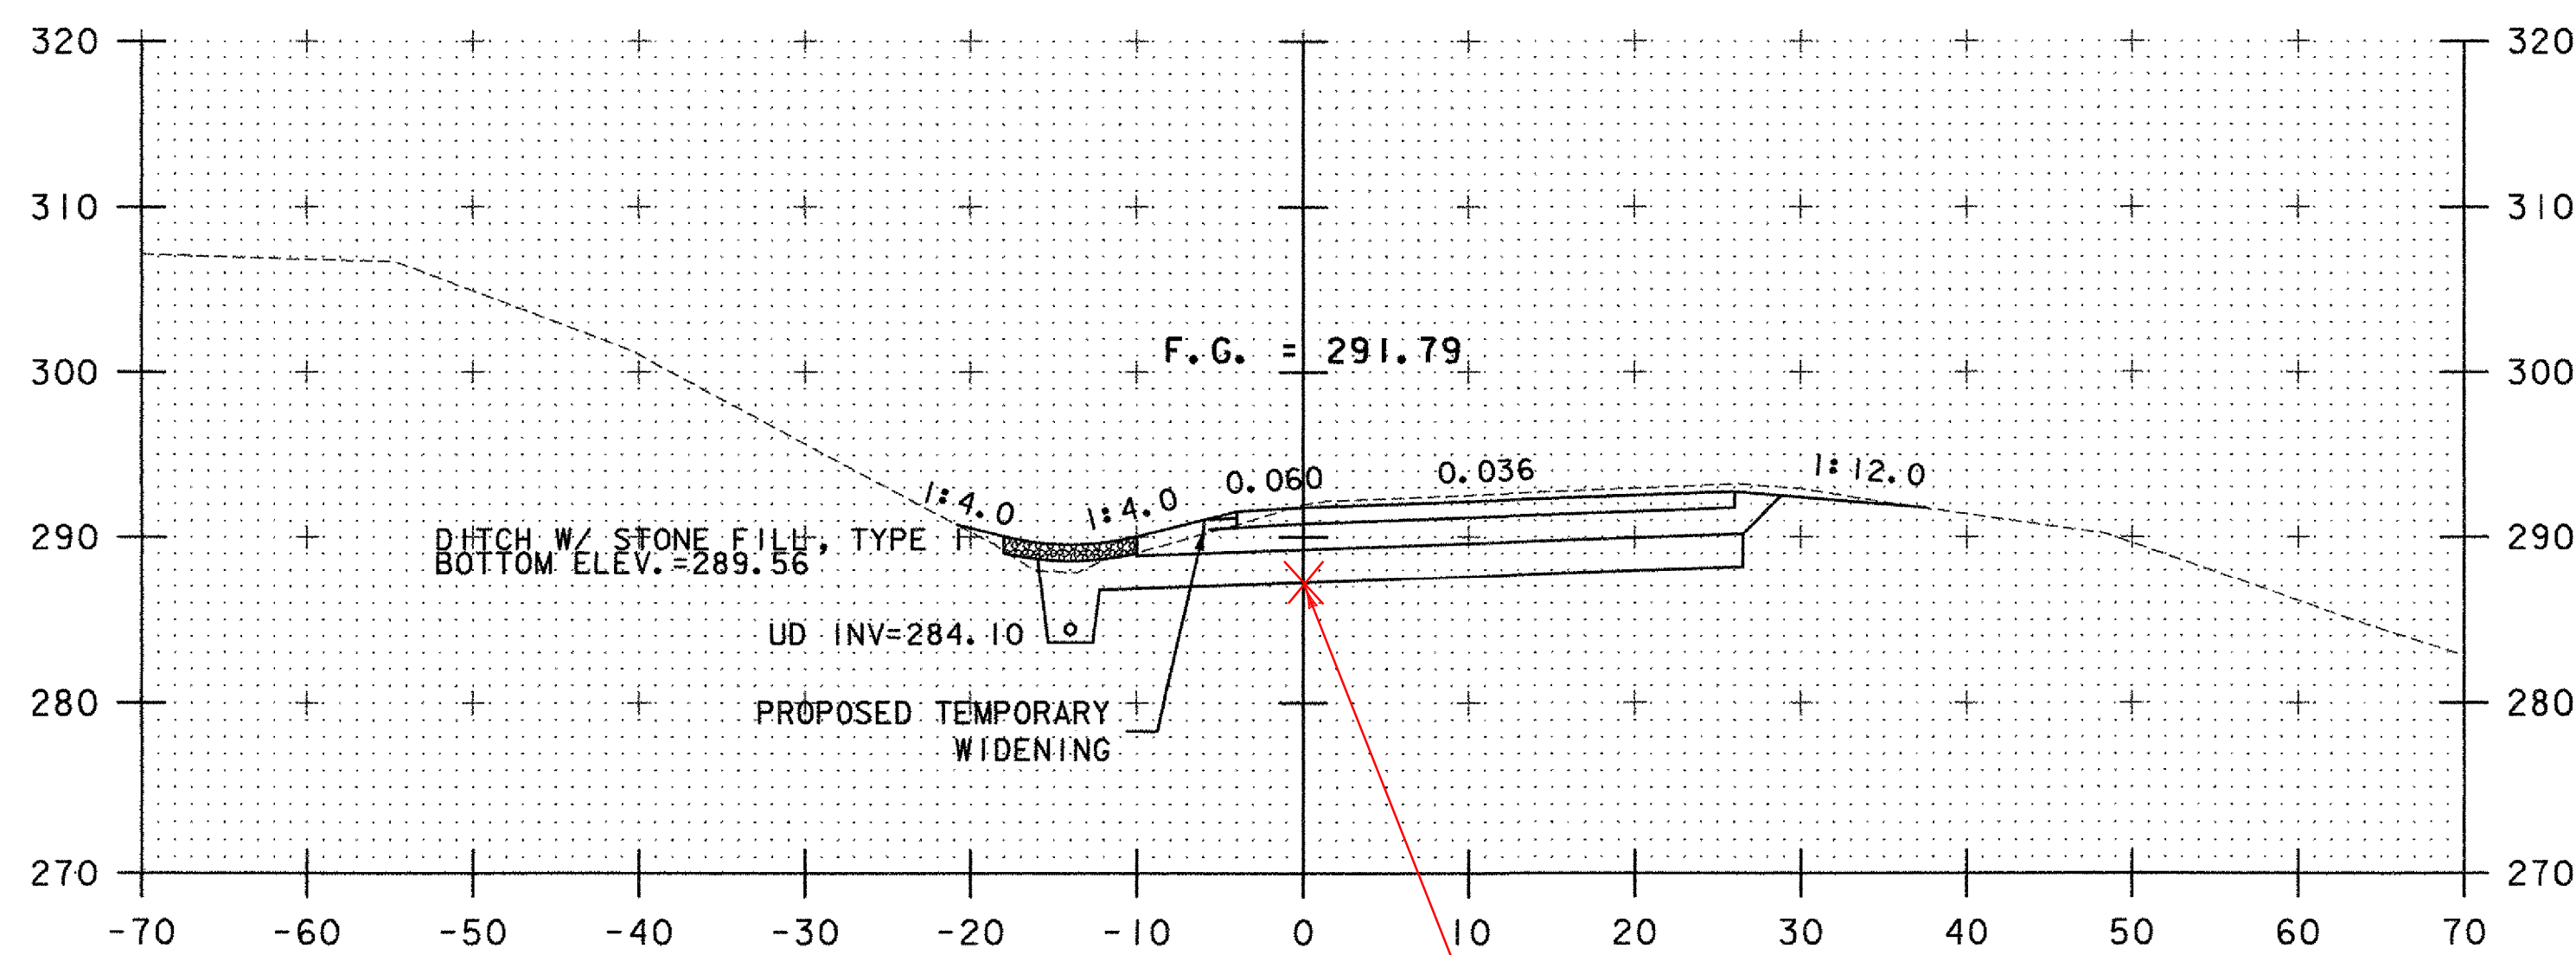

52+50 287.37

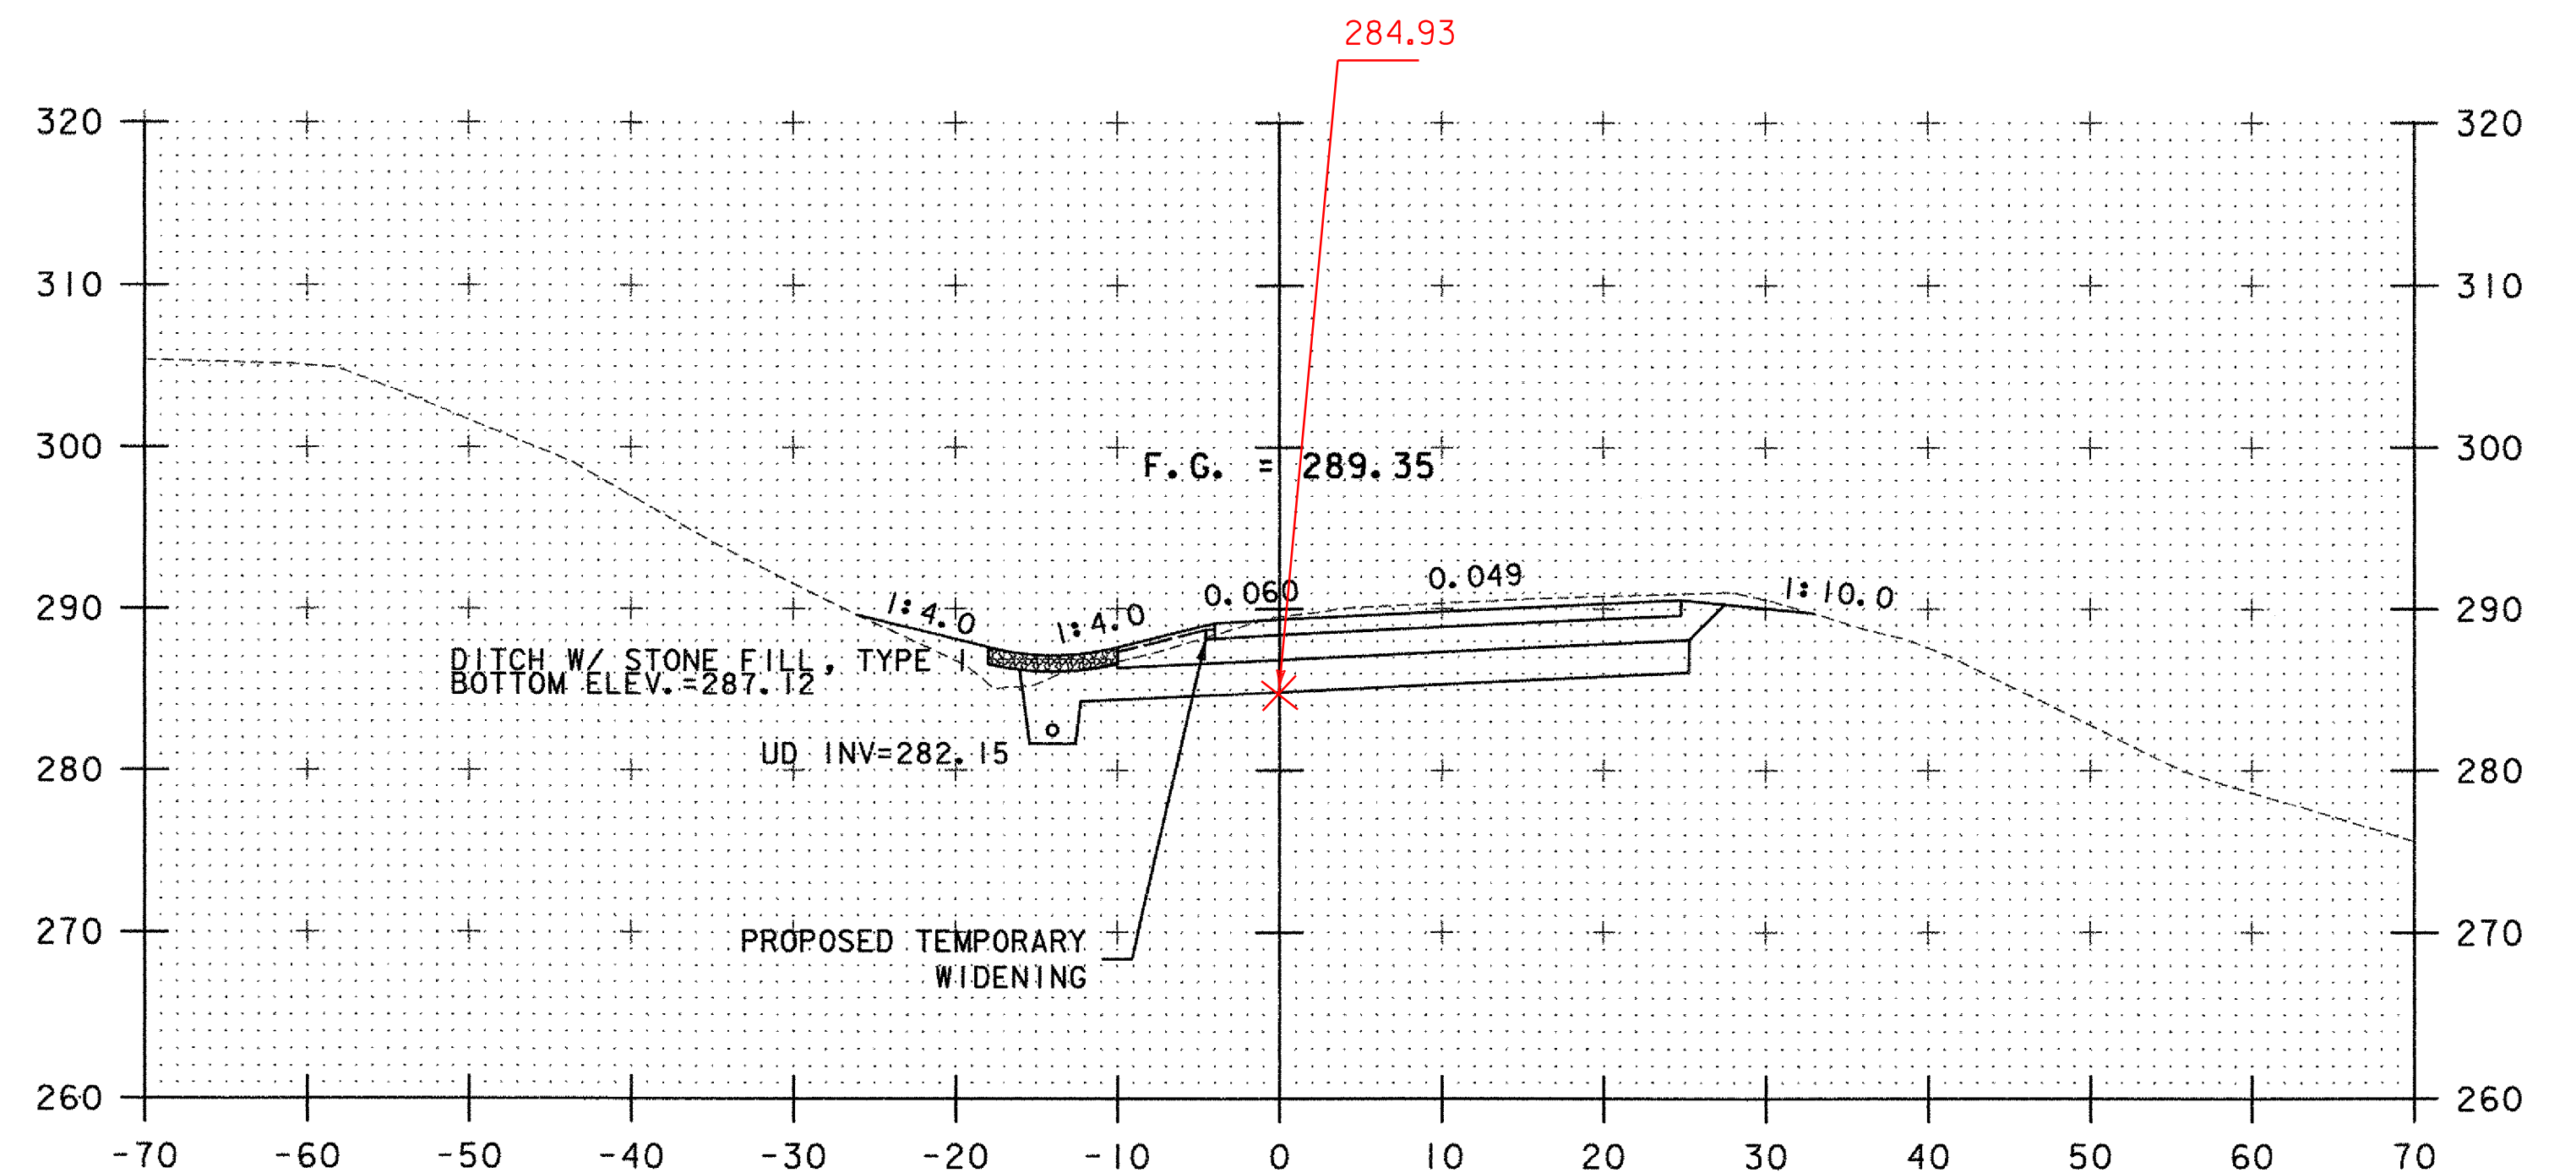


53+00

RAMP "C" SECTIONS SHEET 7

PROJECT NAME: SOUTH BURLINGTON  
PROJECT NUMBER: IM 089-3(37)

FILE NAME: z03a178xs.dgn  
PROJECT LEADER: KEN UPMAL  
DESIGNED BY: E. ATKINS

PLOT DATE: 5/5/2006  
DRAWN BY: E. ATKINS  
CHECKED BY: K. ISHIKURA  
SHEET 88 OF 99

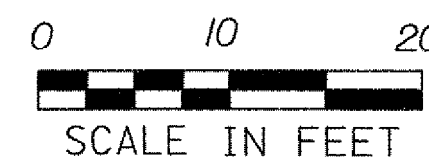

DATUM  
VERTICAL NAVD 88  
HORIZONTAL NAD 83 (1996)

STA. 52+50 TO STA. 53+27.08