




56+00

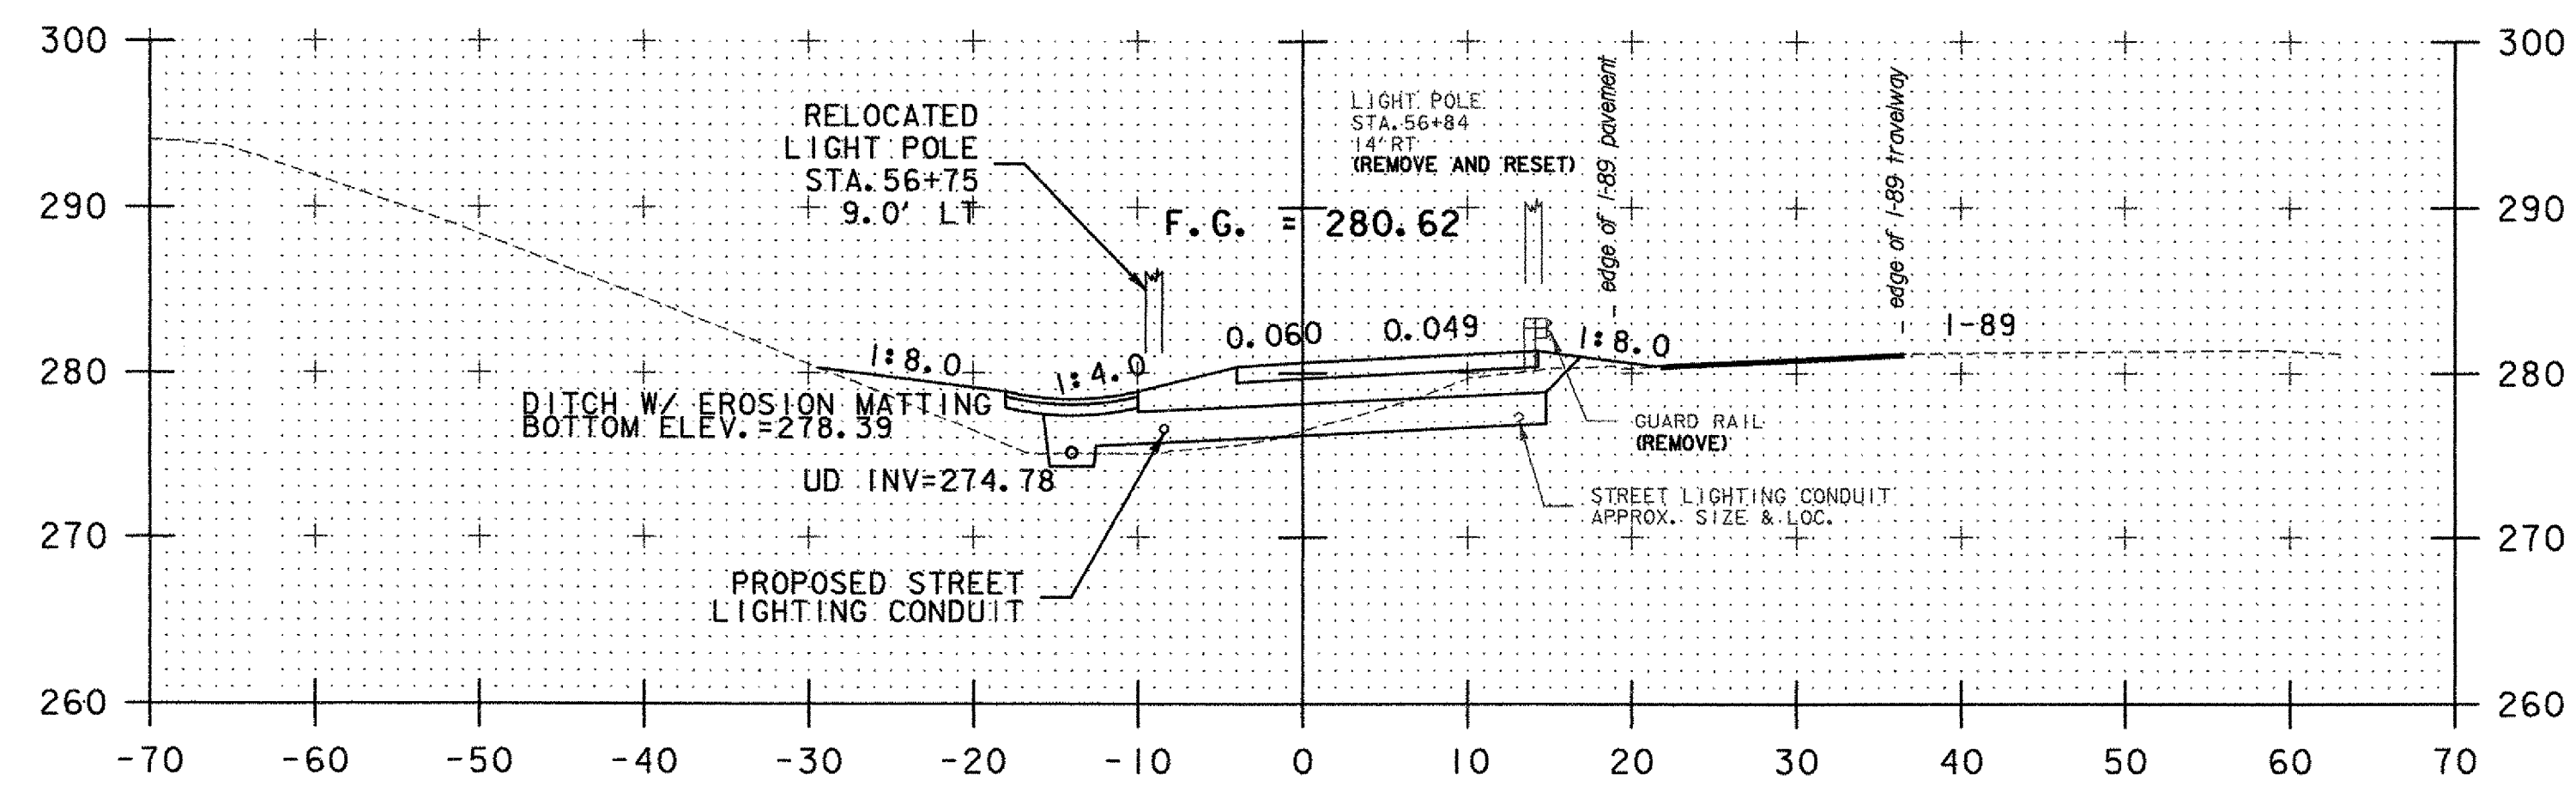

56+50

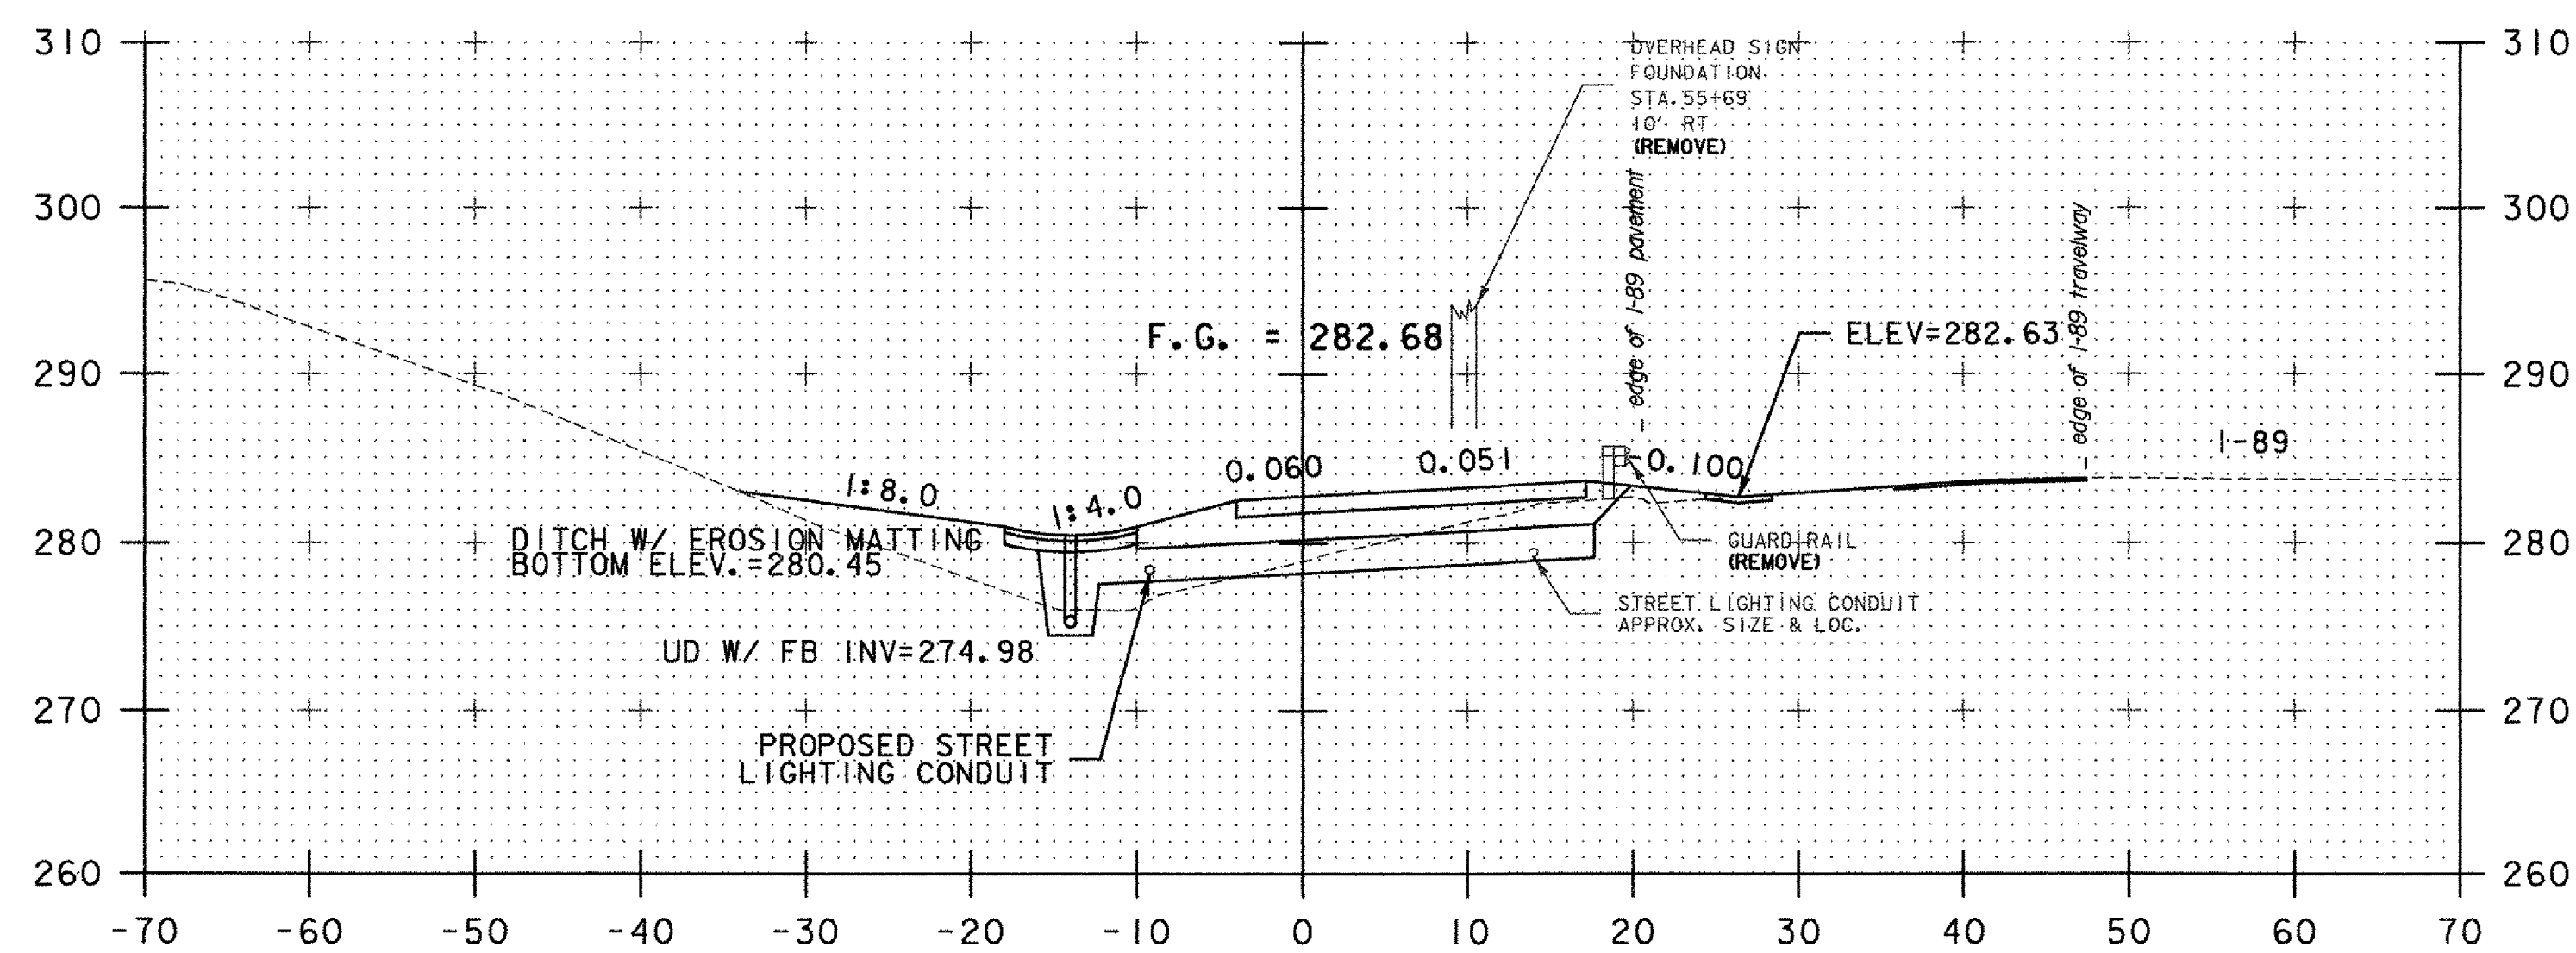

55+50

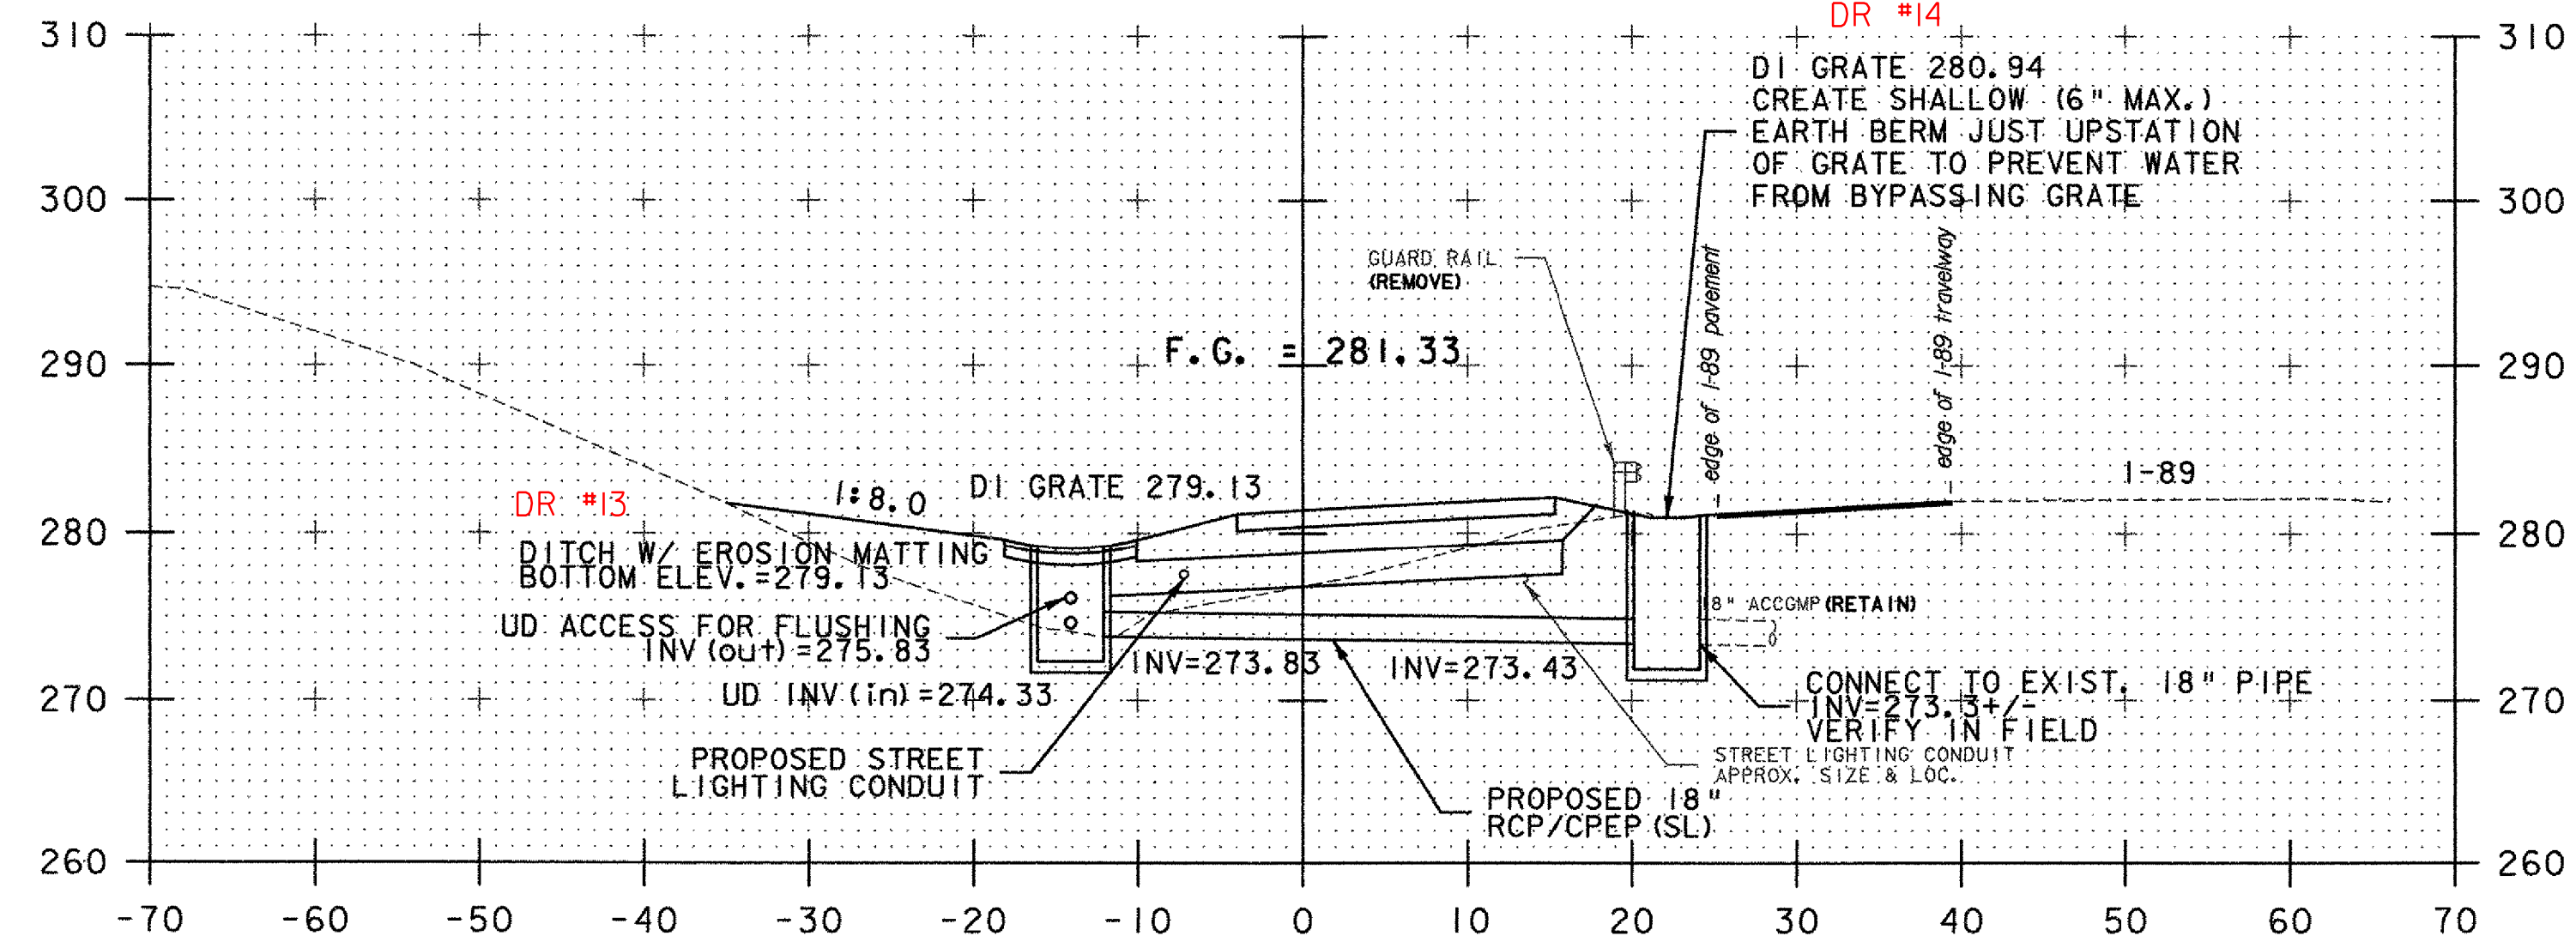

56+15.75


RAMP "C" SECTIONS SHEET 9

DI  
SKEWED 6° 43' 01.9"

PROJECT NAME: SOUTH BURLINGTON  
PROJECT NUMBER: IM 089-3(37)

FILE NAME: z03a178xs.dgn  
PROJECT LEADER: KEN UPMAL  
DESIGNED BY: E. ATKINS  
PLOT DATE: 5/5/2006  
DRAWN BY: E. ATKINS  
CHECKED BY: K. ISHIKURA  
SHEET 90 OF 99

DATUM  
VERTICAL NAVD 88  
HORIZONTAL NAD 83 (1996)

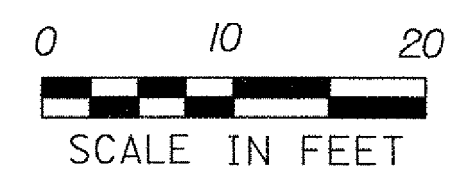

STA. 55+50 TO STA. 56+50