


RAMP "C" SECTIONS SHEET 10

PROJECT NAME: SOUTH BURLINGTON	
PROJECT NUMBER: IM 089-3(37)	
FILE NAME: z03a178xs.dgn	PLOT DATE: 5/5/2006
PROJECT LEADER: KEN UPMAL	DRAWN BY: E. ATKINS
DESIGNED BY: E. ATKINS	CHECKED BY: K. ISHIKURA
	SHEET 91 OF 99

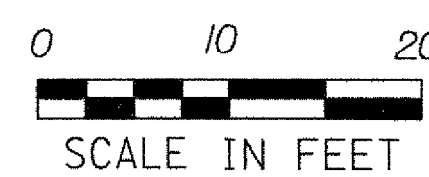

STA. 56+73.17 TO STA. 58+50

DATUM
VERTICAL NAVD 88
HORIZONTAL NAD 83 (1996)