



63+00

F.G. = 267.30
END PROJECT
BEGIN APPROACH
STA. 62+62.50
ELEV. = 268.03

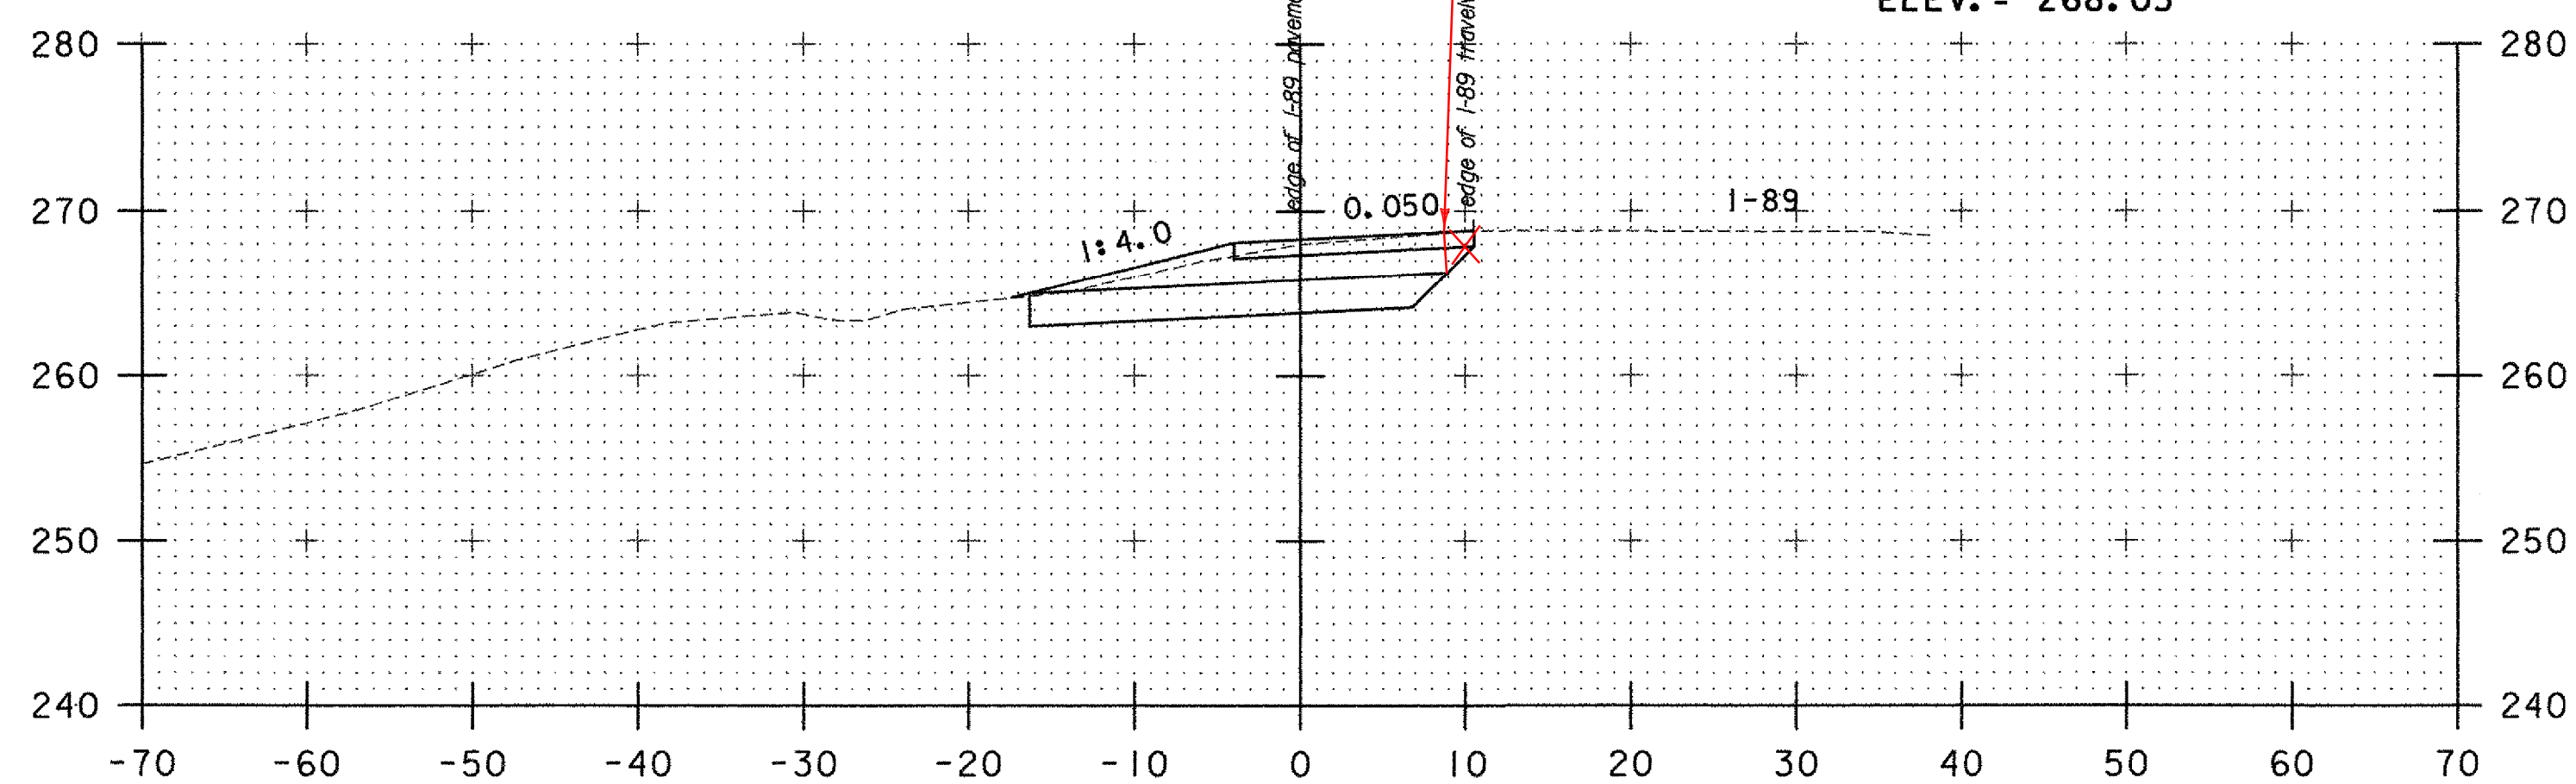


62+50

F.G. = 268.29

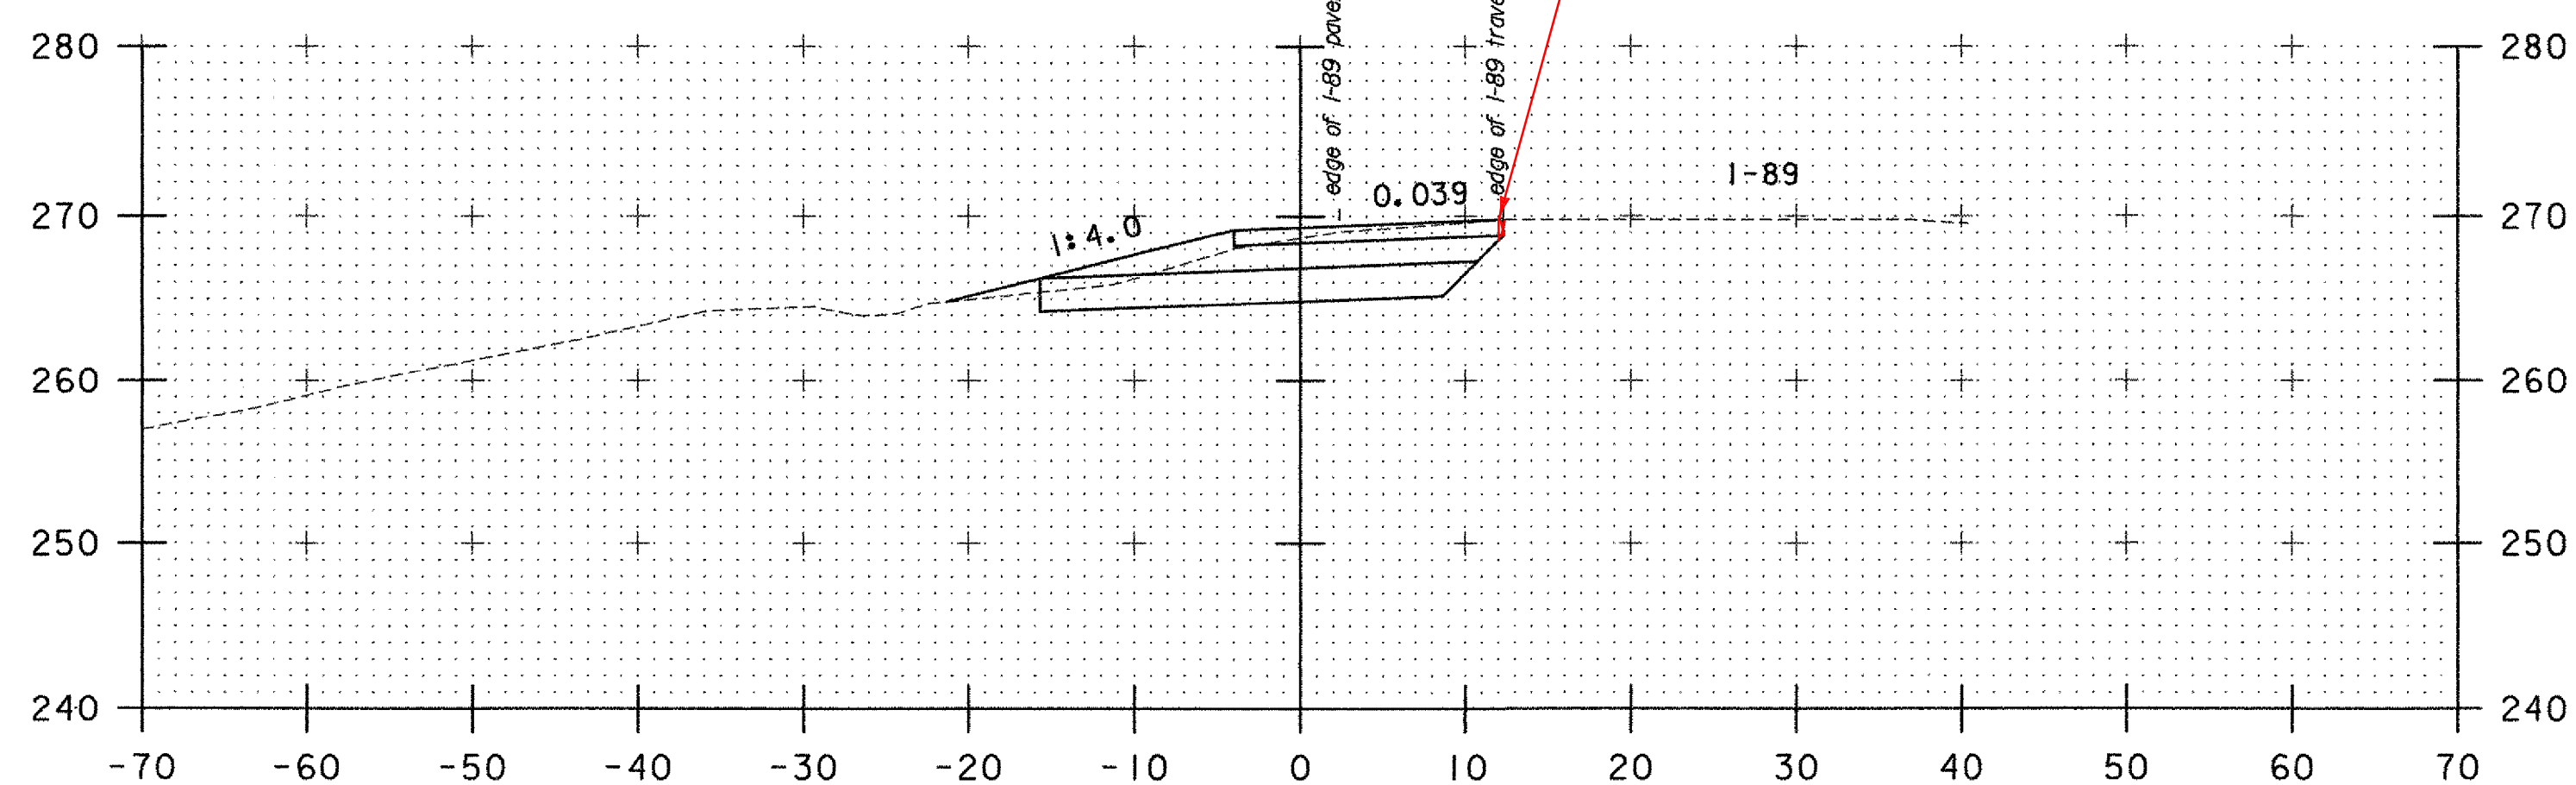


62+00

F.G. = 269.32

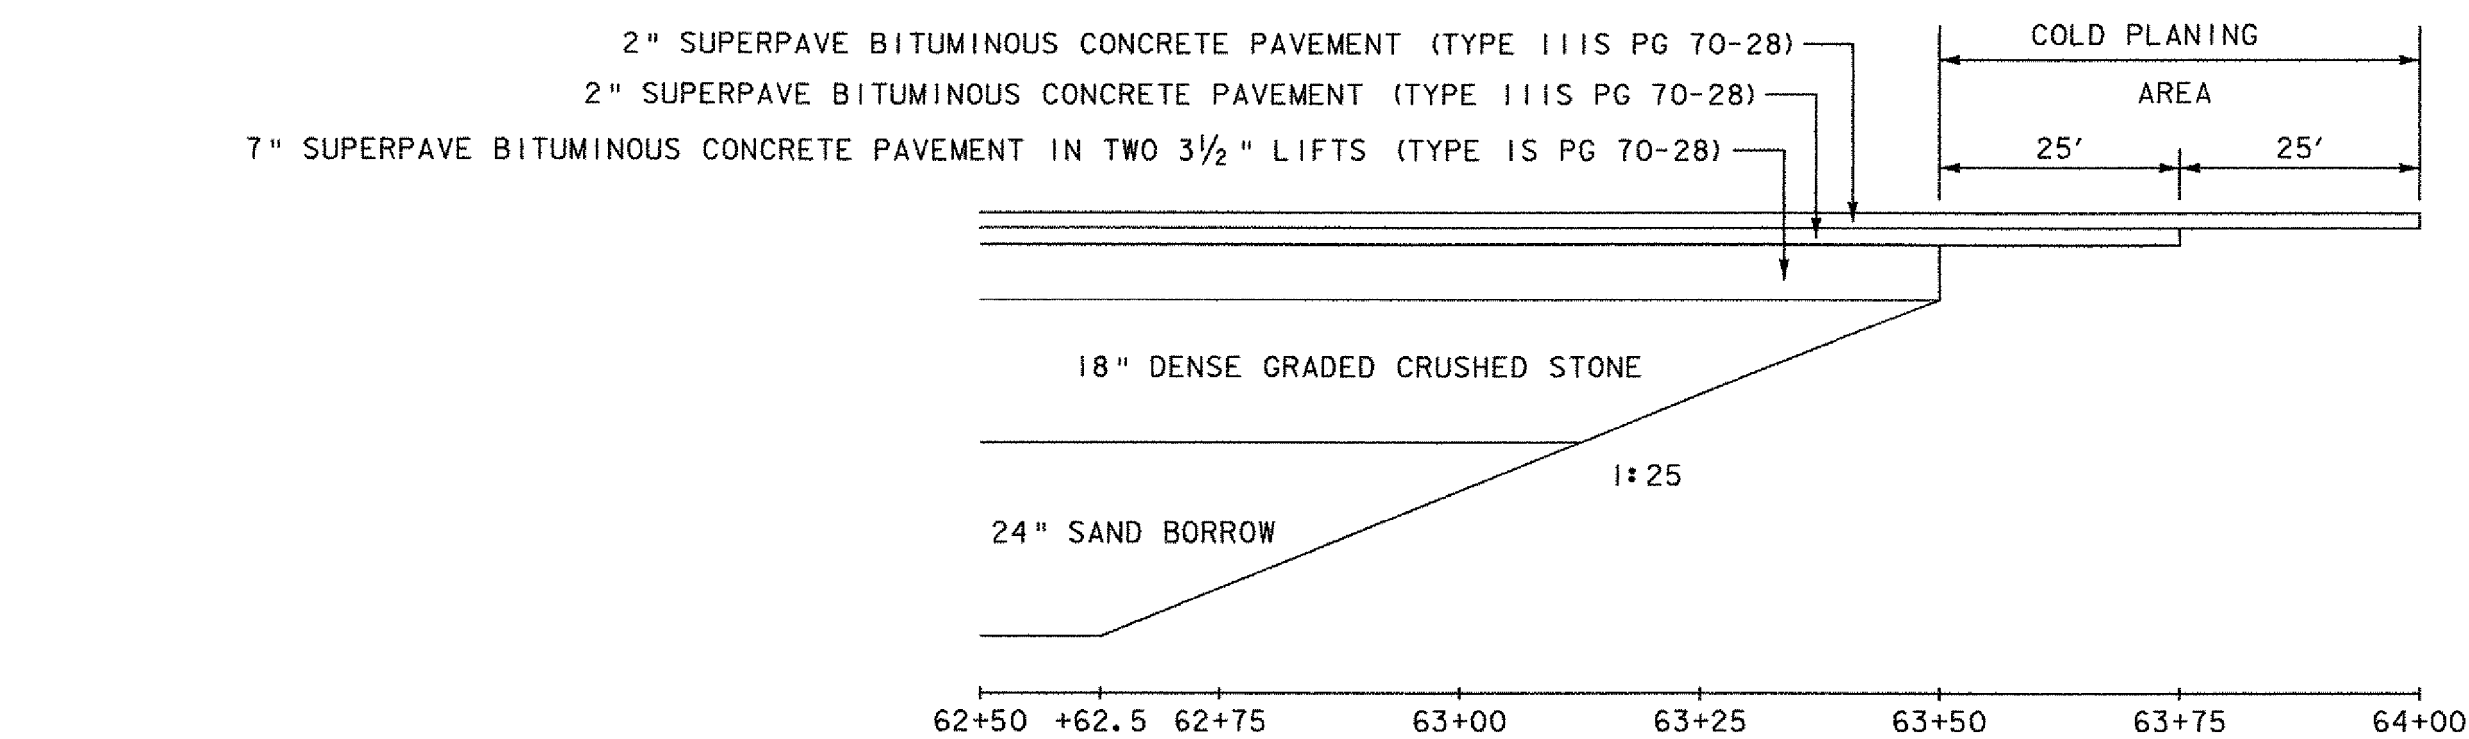


MATERIAL TRANSITION DETAIL
NOT TO SCALE

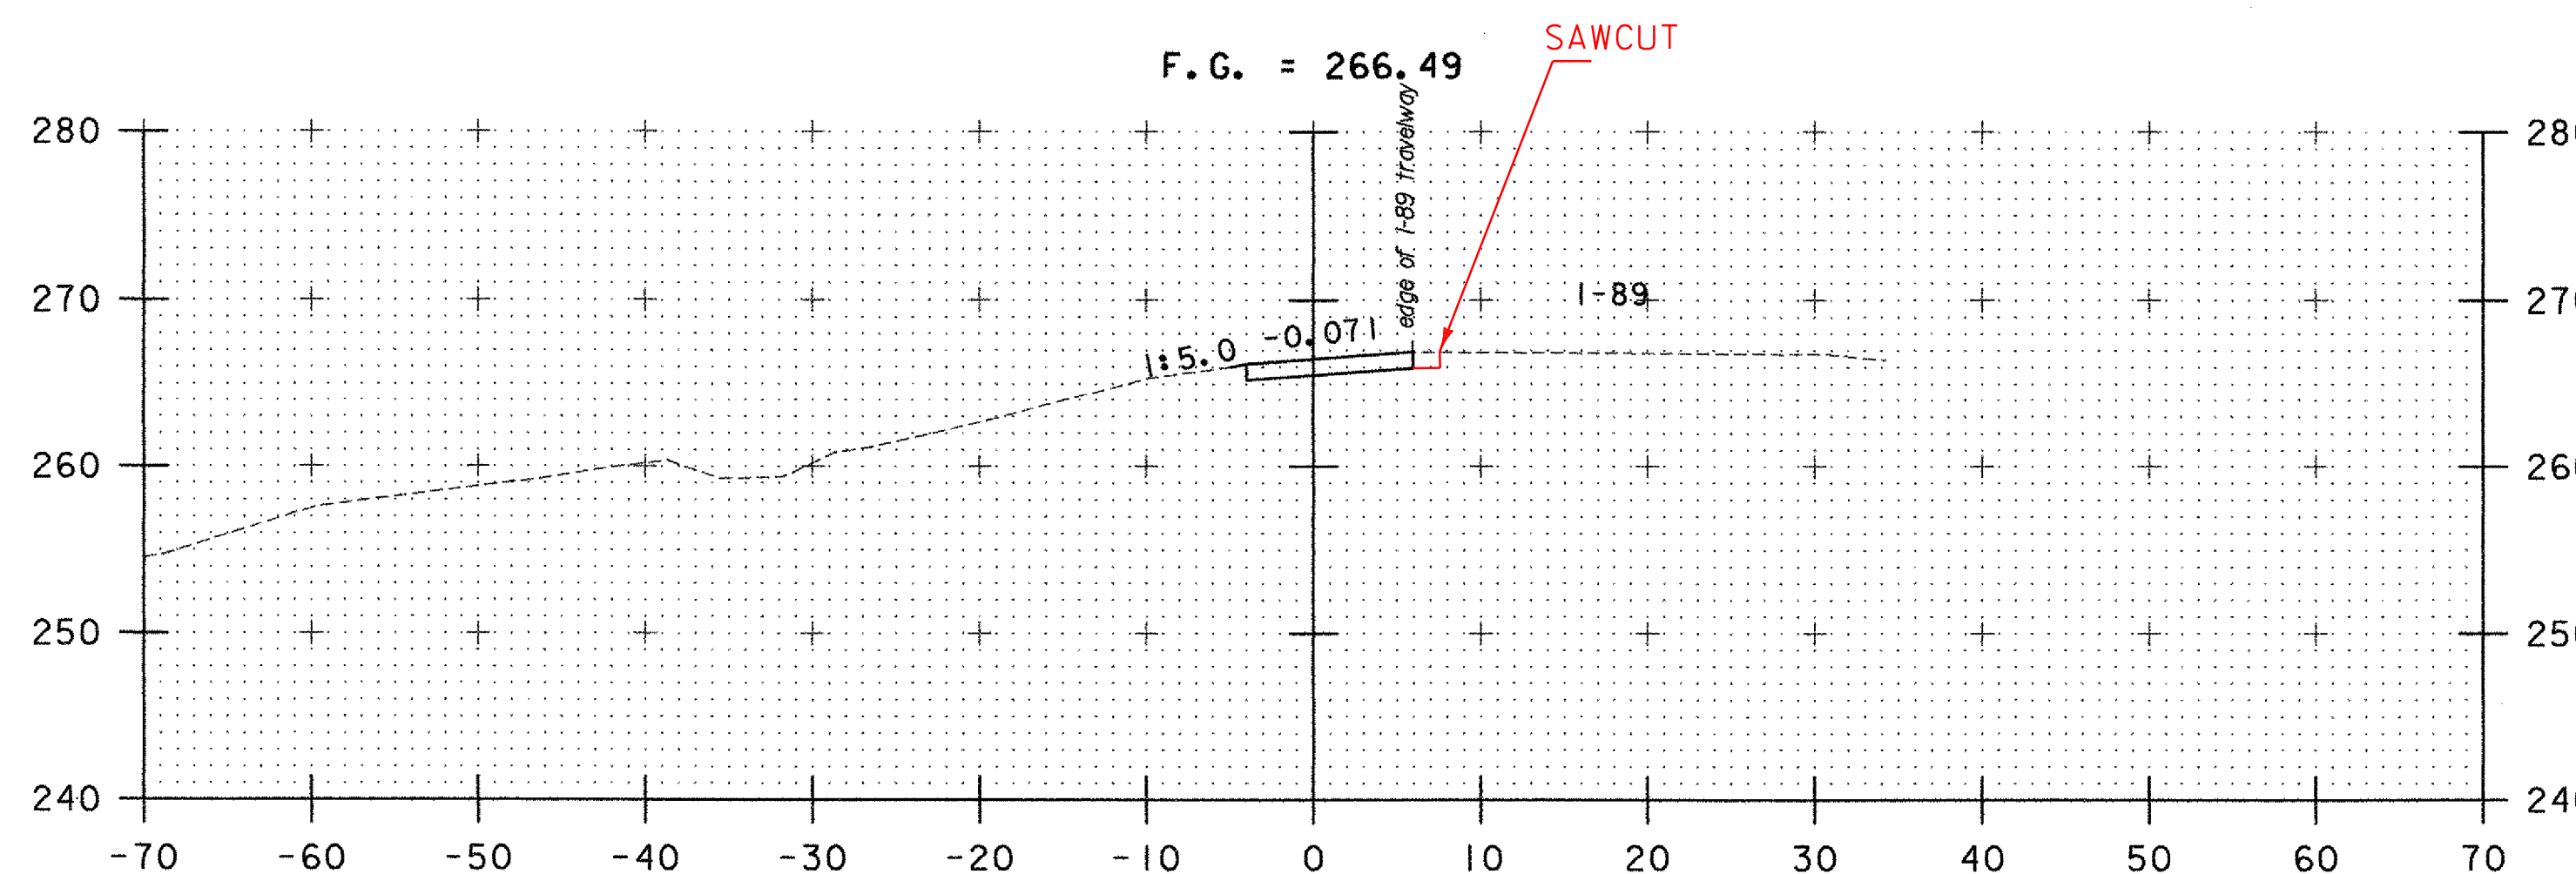

63+50

F.G. = 266.49

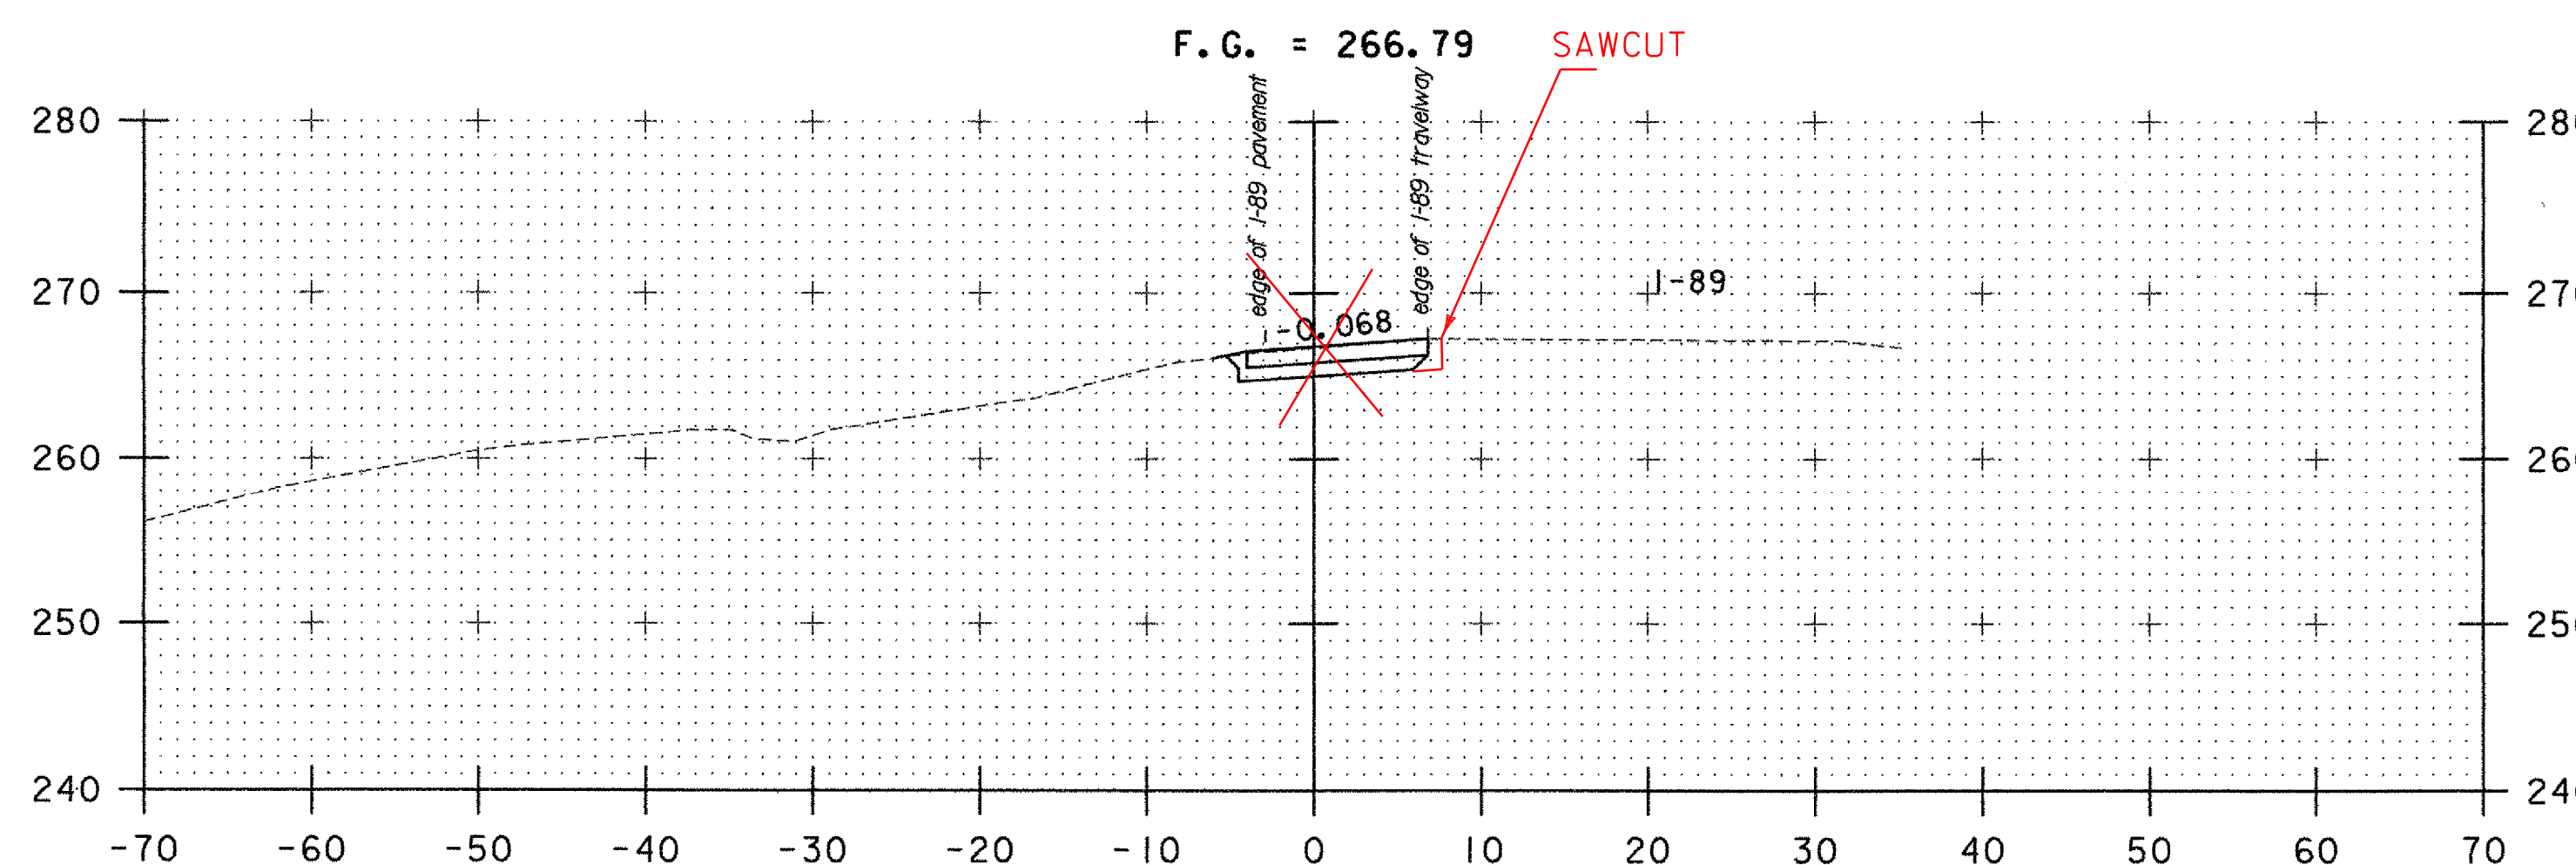

~~63+30.41 PC~~


F.G. = 266.79

RAMP "C" SECTIONS SHEET 12

PROJECT NAME: SOUTH BURLINGTON
PROJECT NUMBER: IM 089-3(37)

FILE NAME: z03a178xs.dgn
PROJECT LEADER: KEN UPMAL
DESIGNED BY: E. ATKINS

PLOT DATE: 5/5/2006
DRAWN BY: E. ATKINS
CHECKED BY: K. ISHIKURA
SHEET 93 OF 99

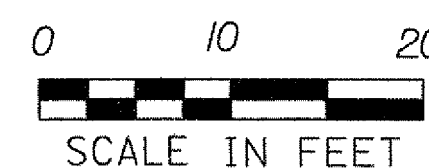

STA. 62+00 TO STA. 63+50

DATUM
VERTICAL NAVD 88
HORIZONTAL NAD 83 (1996)