




64+01.84 PT

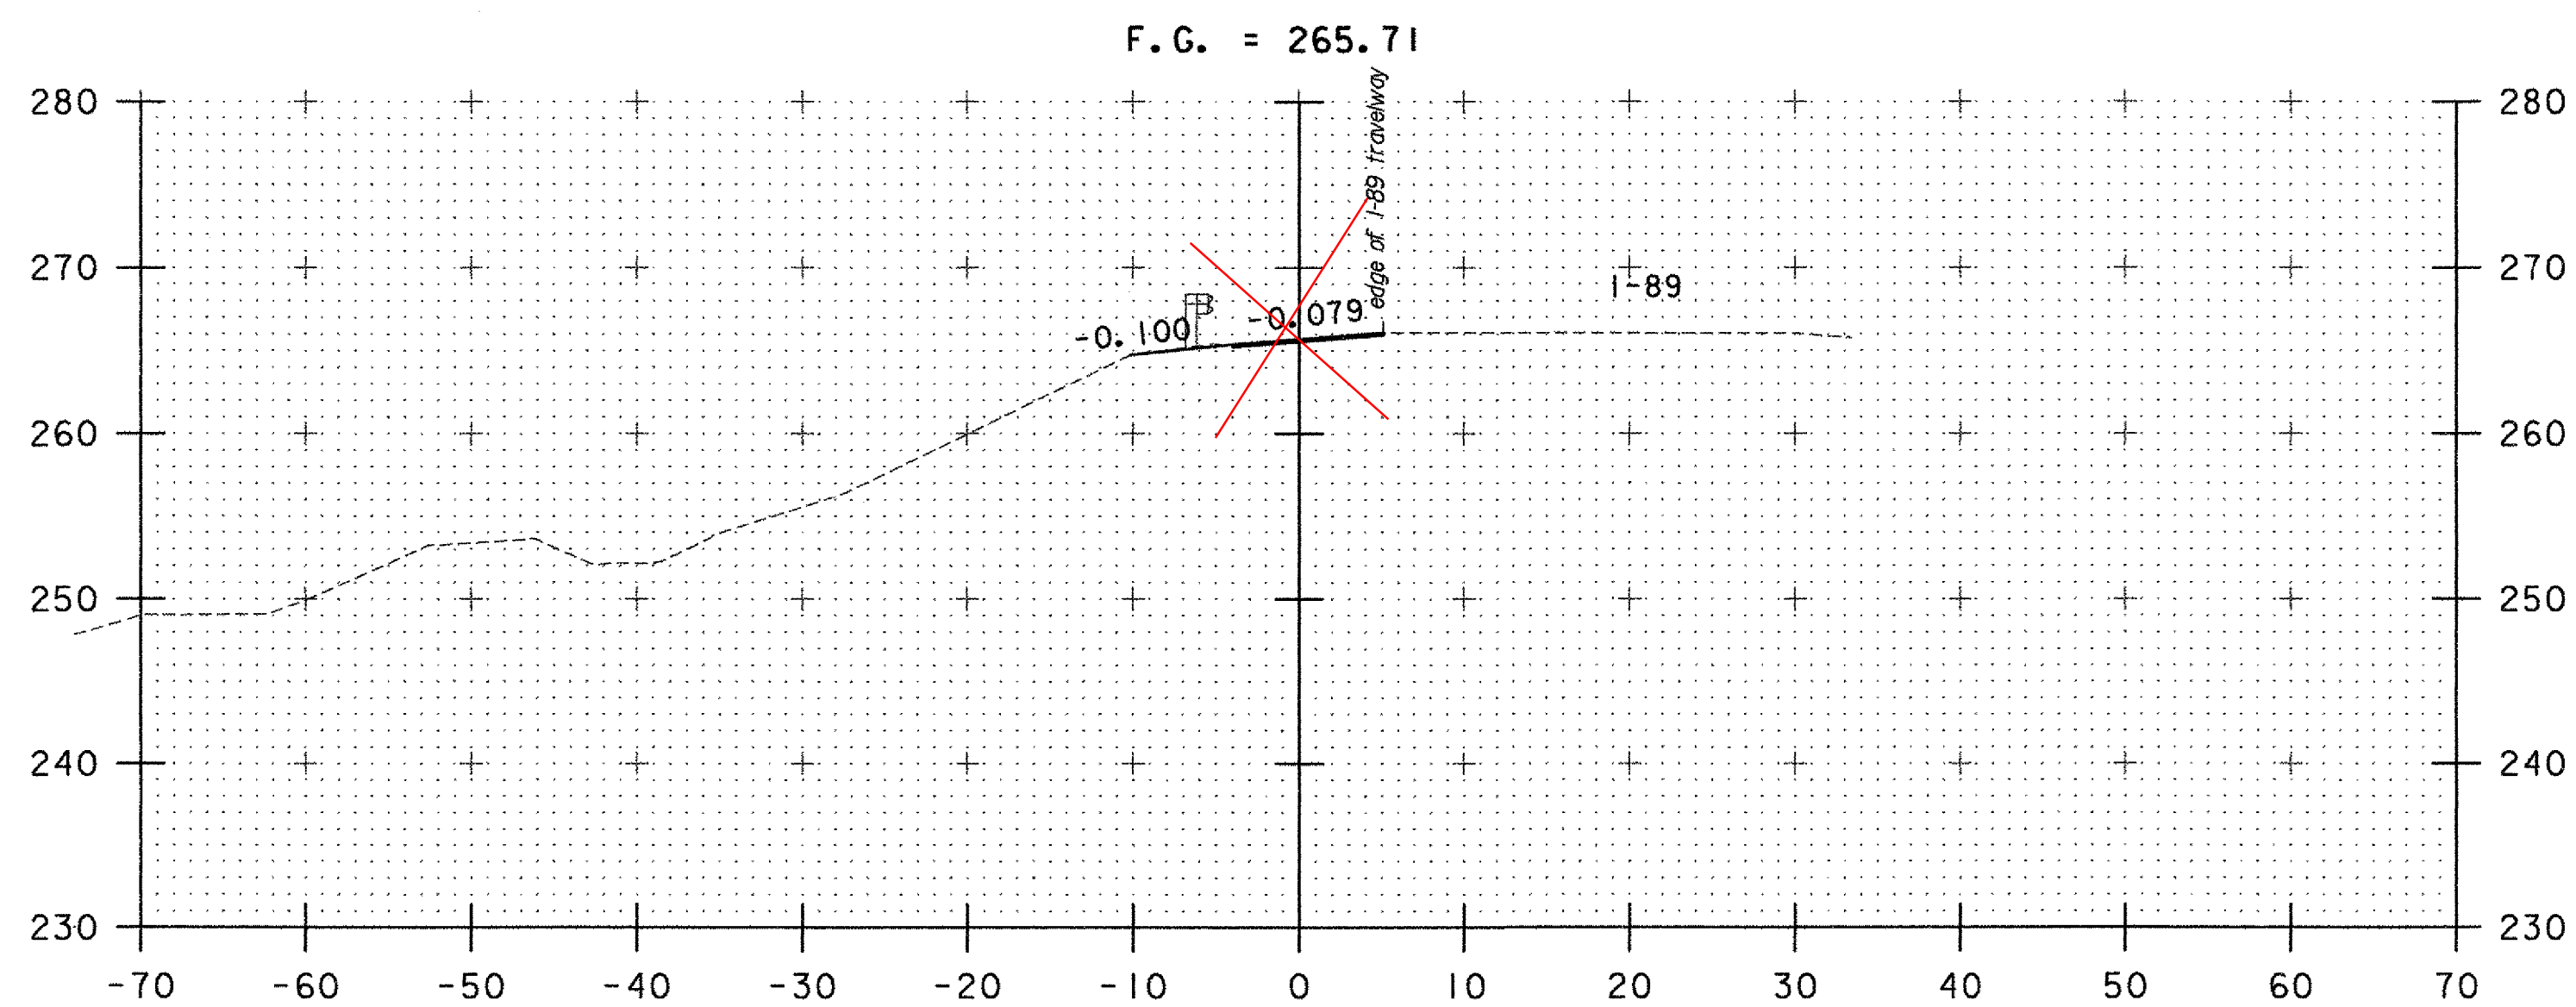

64+00
 END APPROACH
 MATCH EXISTING BCP

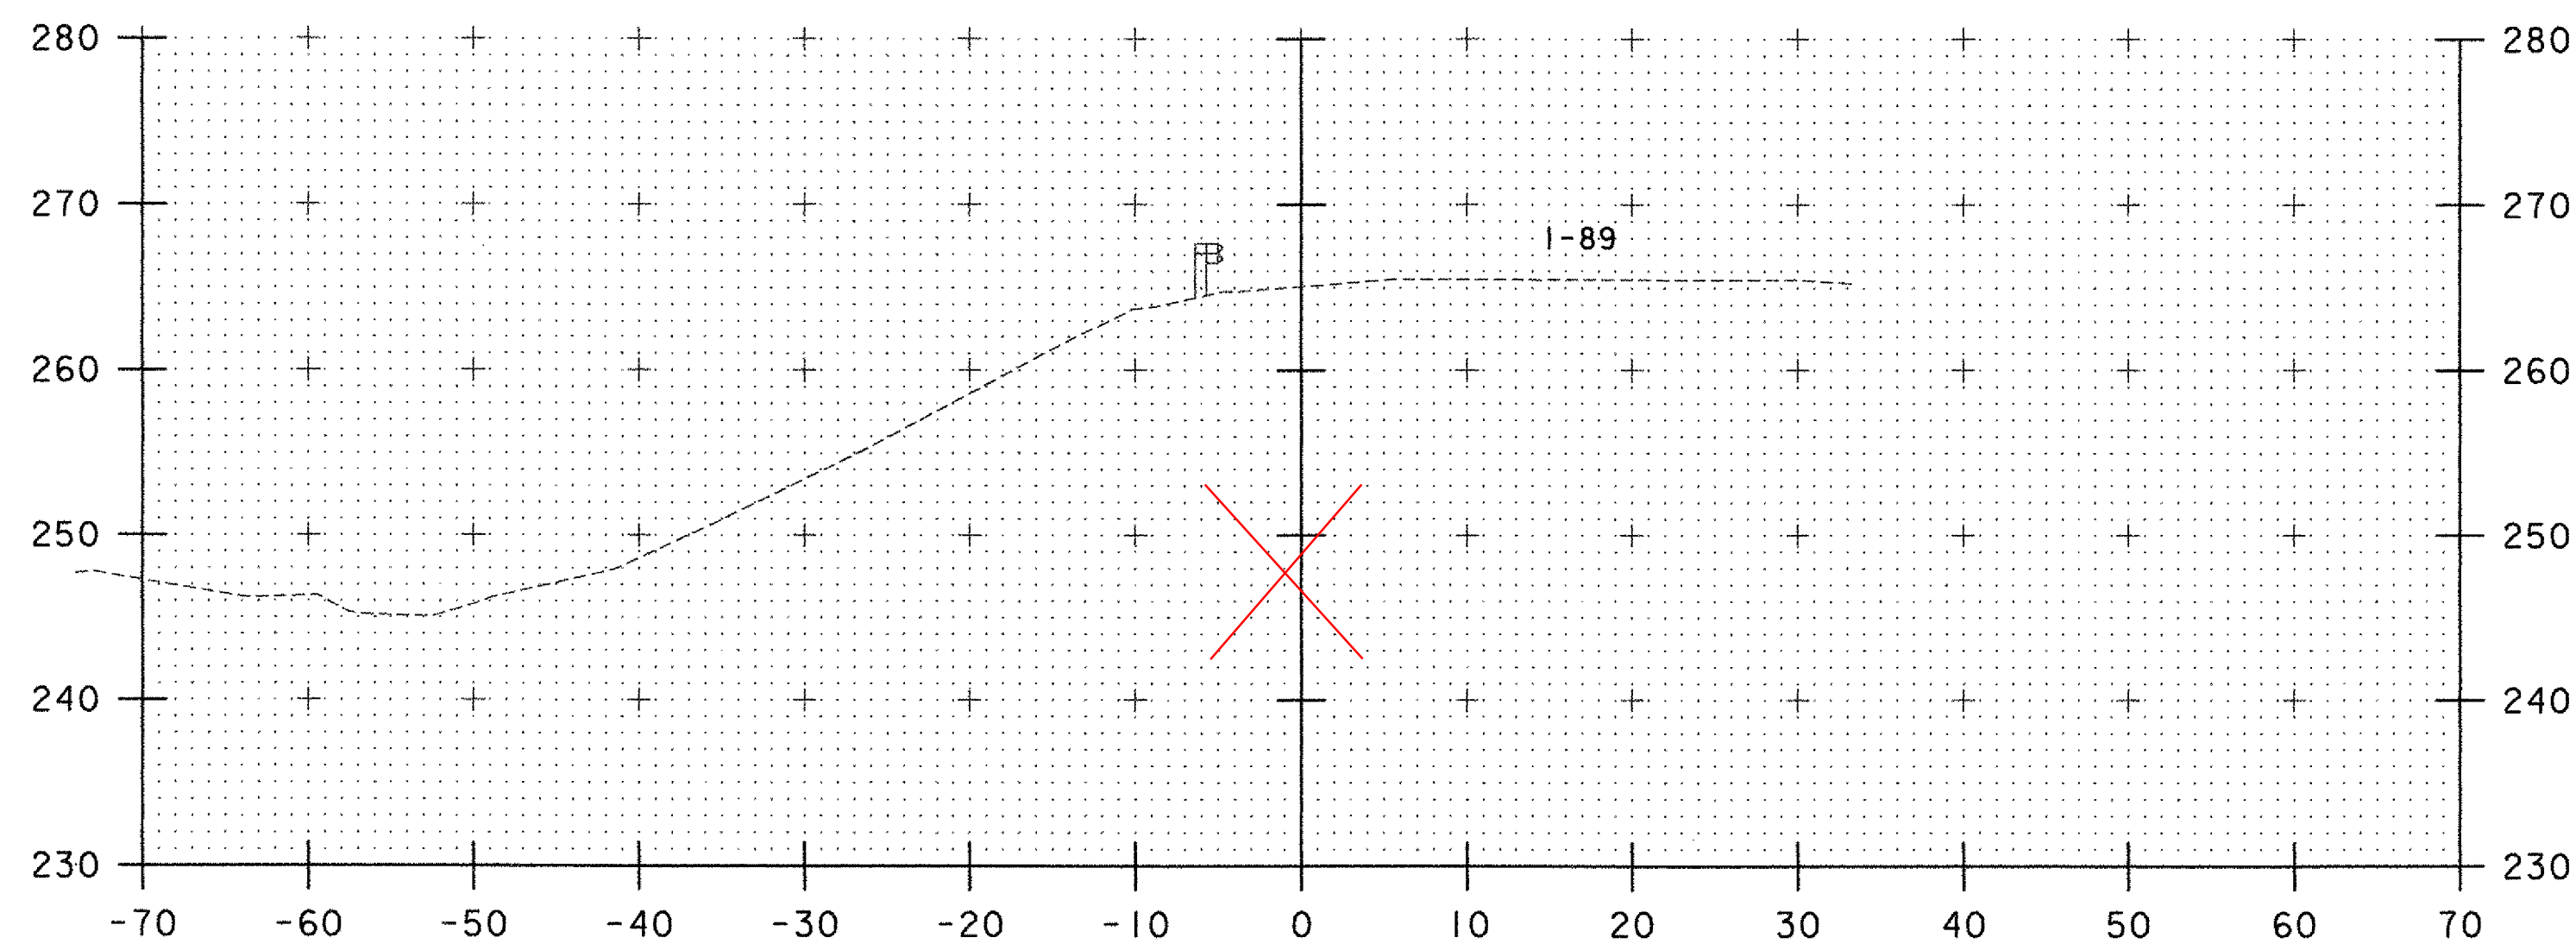

64+50

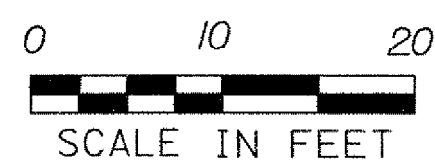

STA. 64+00 TO STA. 64+50

RAMP "C" SECTIONS SHEET 13

PROJECT NAME: SOUTH BURLINGTON	
PROJECT NUMBER: IM 089-3(37)	
FILE NAME: z03cl78xs.dgn	PLOT DATE: 5/5/2006
PROJECT LEADER: KEN UPMAL	DRAWN BY: E. ATKINS
DESIGNED BY: E. ATKINS	CHECKED BY: K. ISHIKURA
	SHEET 94 OF 99

DATUM
 VERTICAL NAVD 88
 HORIZONTAL NAD 83 (1996)