

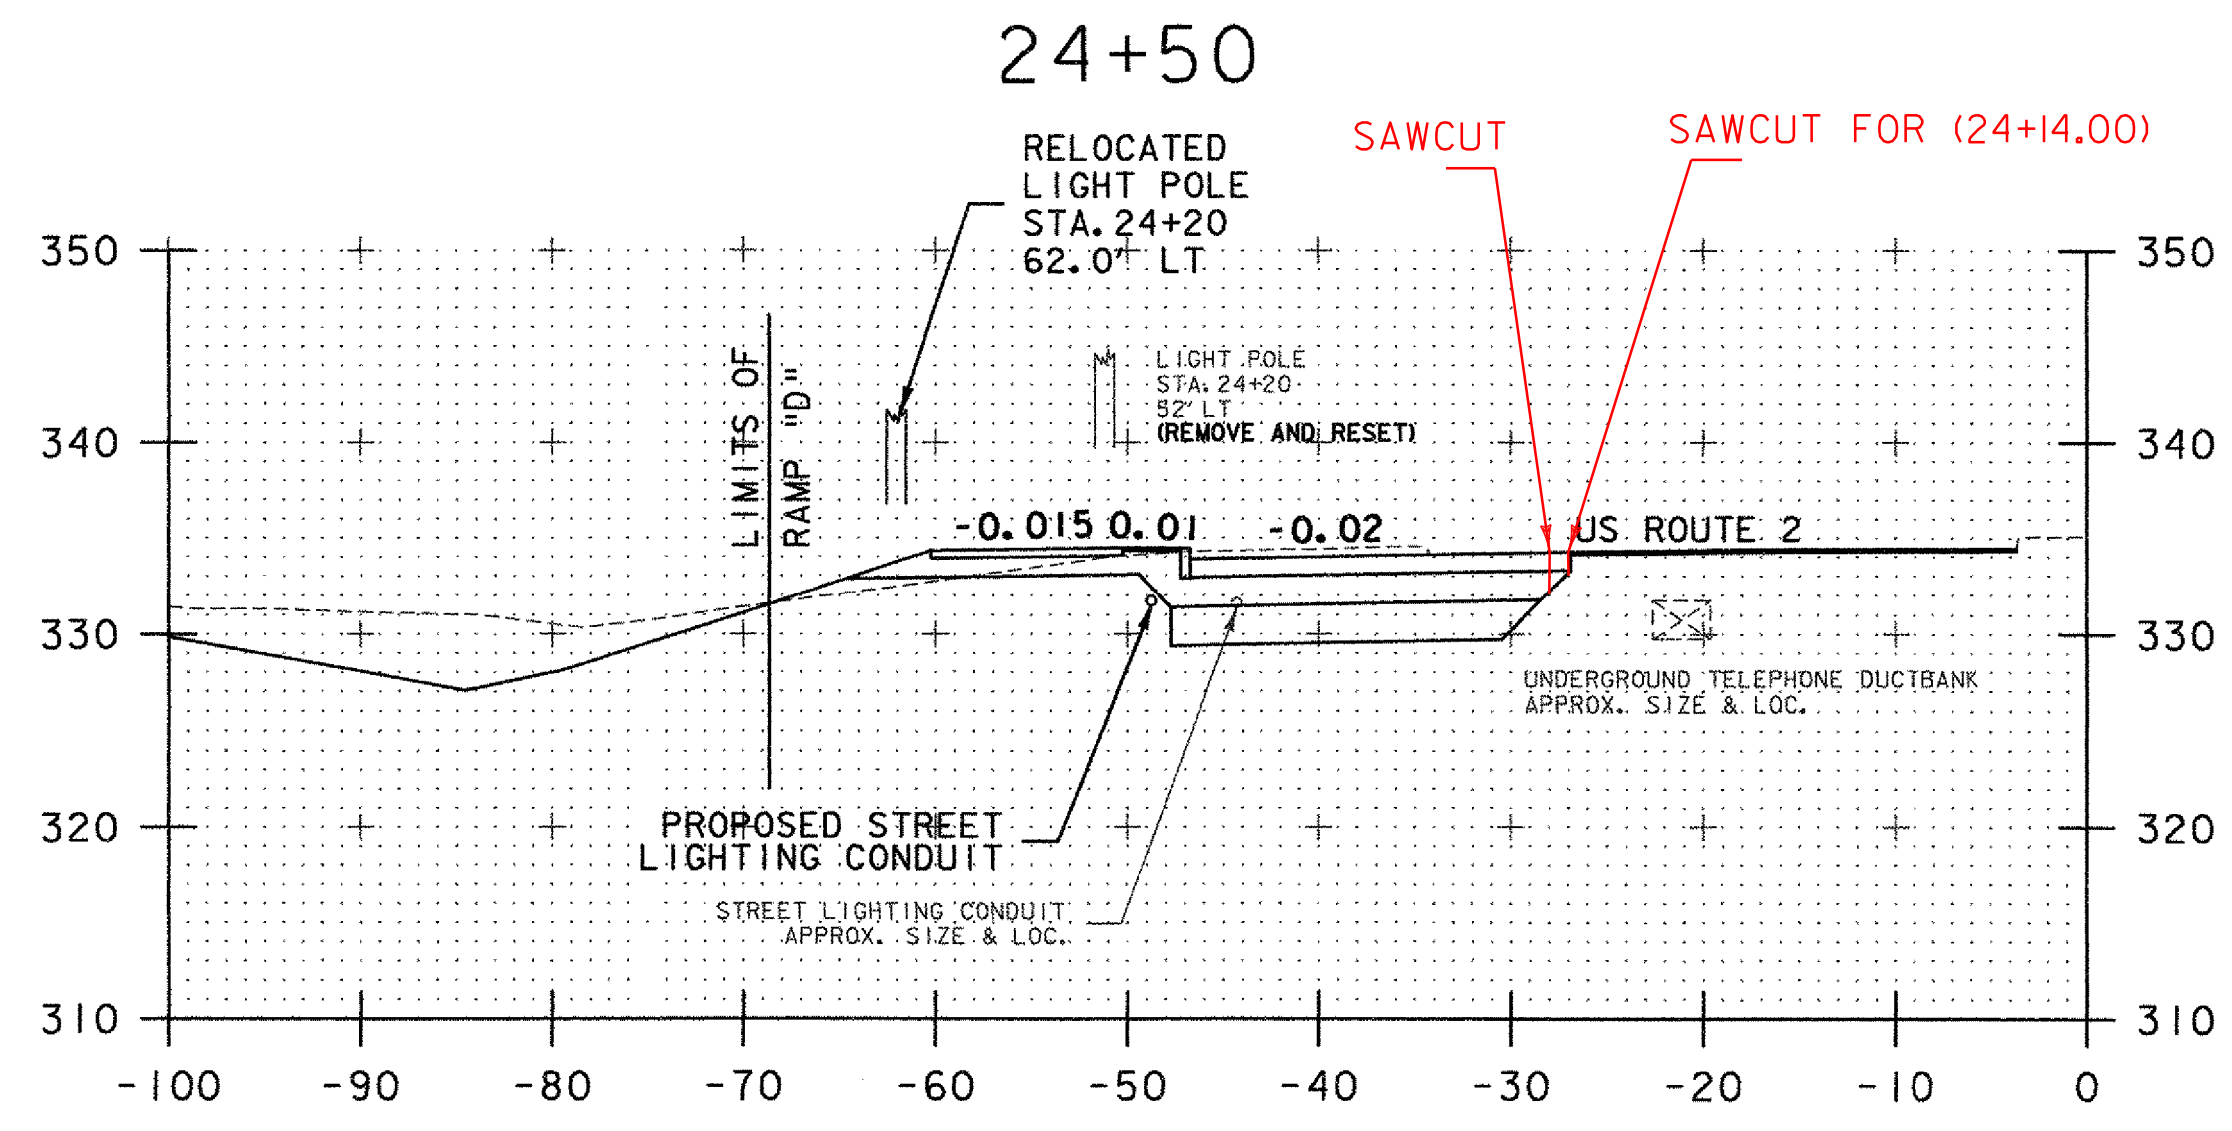
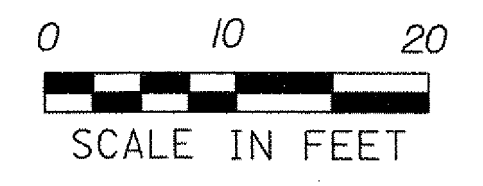


USE FOR STA 24+83.30 ALSO

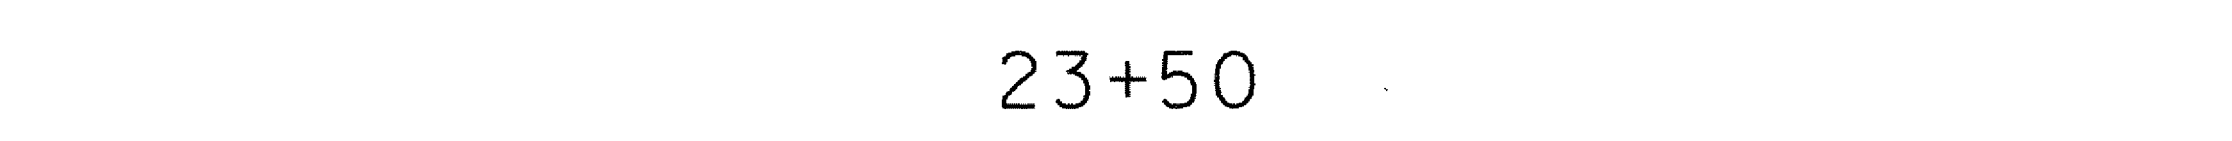

USE FOR STA 24+14 ALSO W/ SAWCUT 27' LT

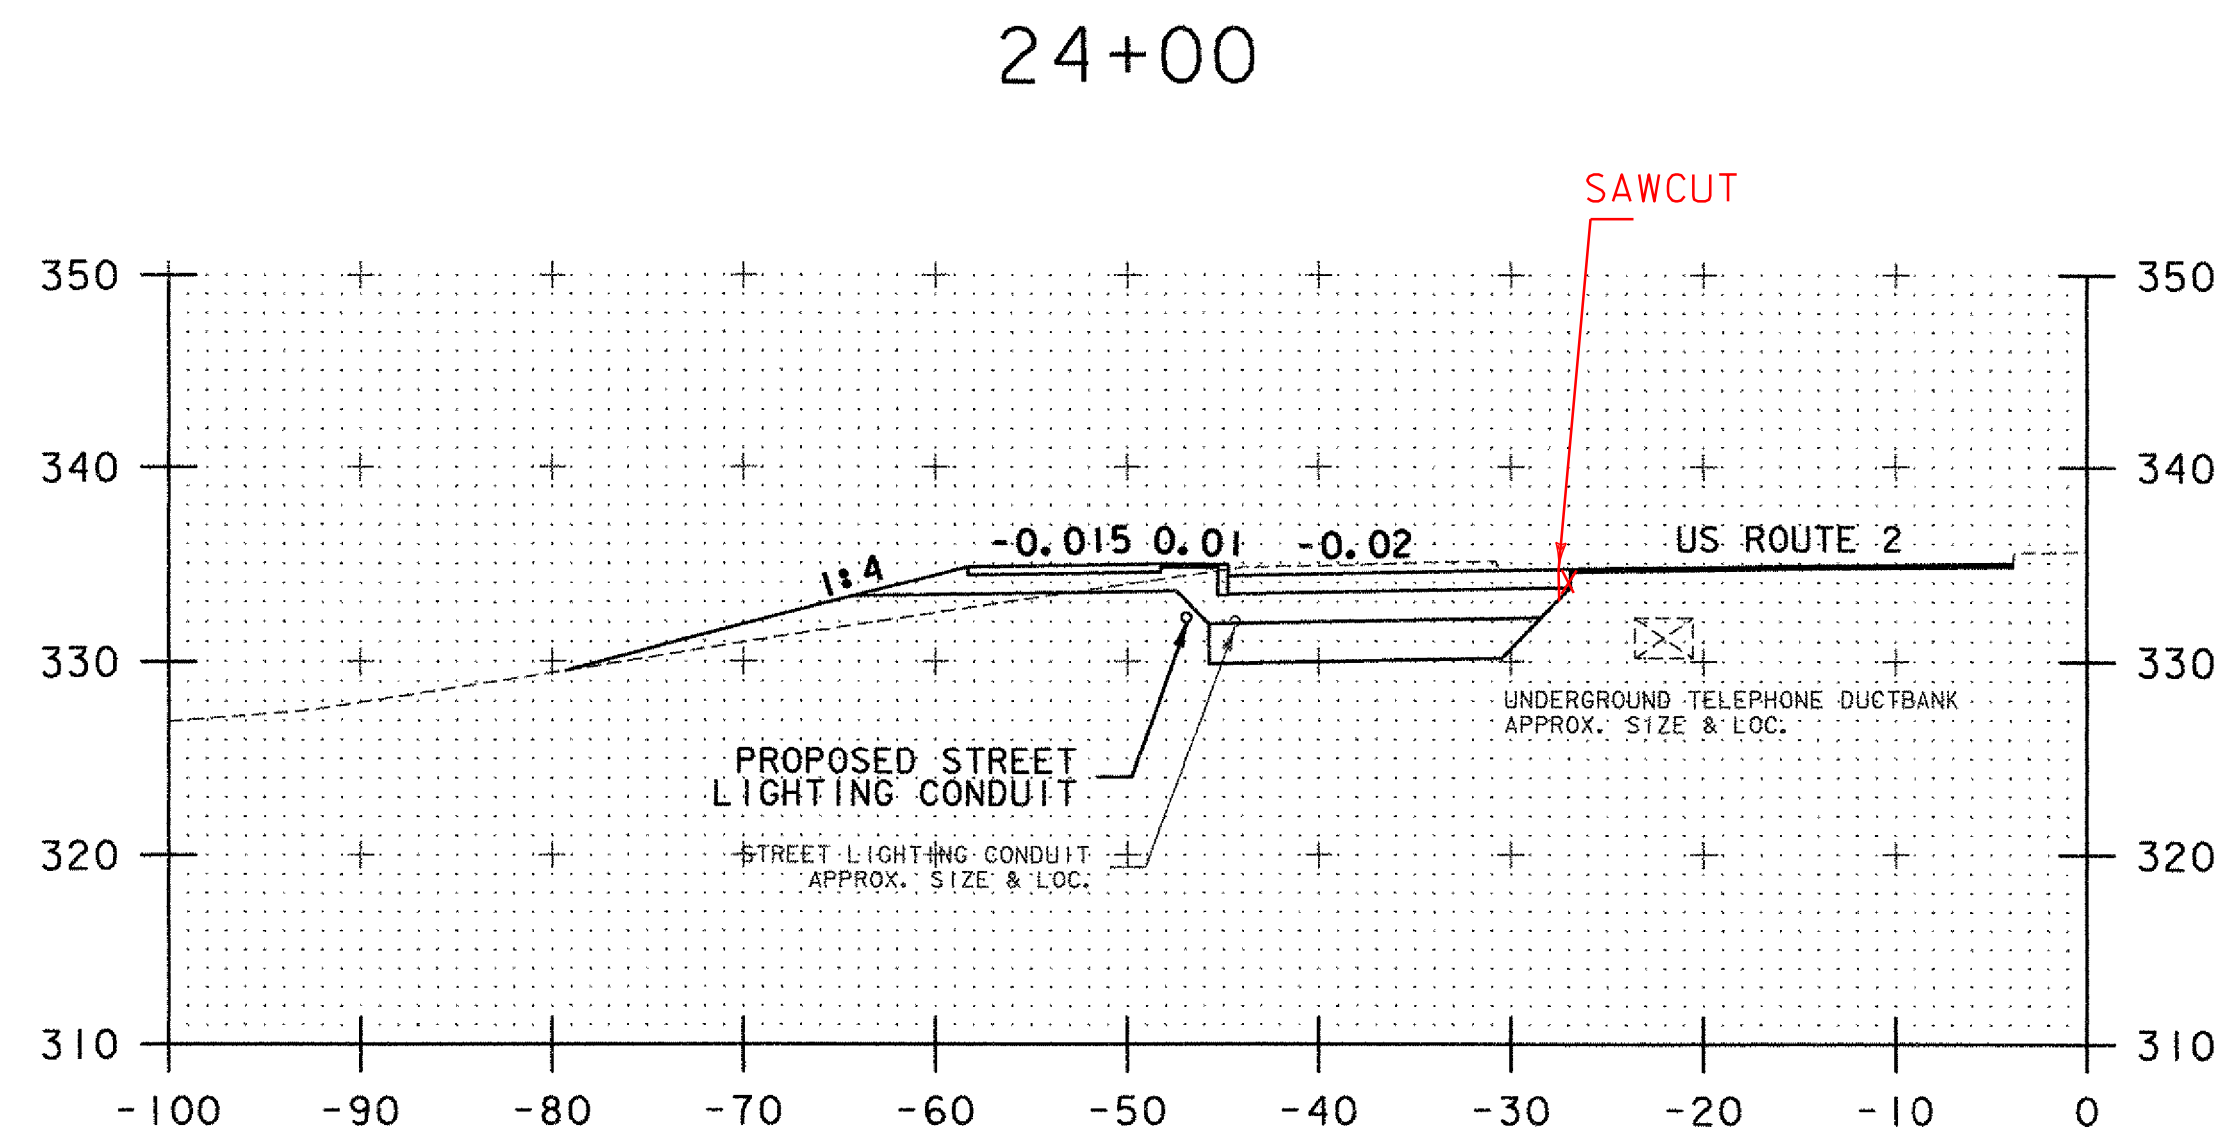

US RTE 2 SECTIONS SHEET 2

PROJECT NAME: SOUTH BURLINGTON	
PROJECT NUMBER: IM 089-3(37)	
FILE NAME: z03cl78xs.dgn	PLOT DATE: 5/5/2006
PROJECT LEADER: KEN UPMAL	DRAWN BY: E. ATKINS
DESIGNED BY: E. ATKINS	CHECKED BY: K. ISHIKURA
SHEET 96 OF 99	

STA. 23+50 TO STA. 24+50

DATUM	
VERTICAL	NAVD 88
HORIZONTAL	NAD 83 (1996)