


RAMP "D" SECTIONS SHEET 1

| | |
|--------------------------------|-------------------------|
| PROJECT NAME: SOUTH BURLINGTON | PLOT DATE: 5/5/2006 |
| PROJECT NUMBER: IM 089-3(37) | DRAWN BY: E. ATKINS |
| FILE NAME: z03a178xs.dgn | CHECKED BY: K. ISHIKURA |
| PROJECT LEADER: KEN UPMAL | SHEET 97 OF 99 |
| DESIGNED BY: E. ATKINS | |

STA. 70+82 TO STA. 72+63.50

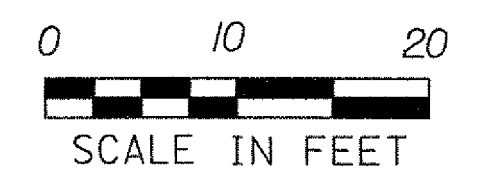

DATUM
VERTICAL NAVD 88
HORIZONTAL NAD 83 (1996)

NOTE: REFER TO RAMP "D" TRAFFIC MANAGEMENT PLANS FOR TEMPORARY WIDENING WORK.