


DATUM  
VERTICAL NAVD 88  
HORIZONTAL NAD 83 (1996)

NOTE: REFER TO RAMP "D" TRAFFIC MANAGEMENT PLANS FOR TEMPORARY WIDENING WORK.

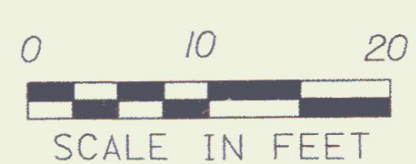

RAMP "D" SECTIONS SHEET 2

PROJECT NAME: SOUTH BURLINGTON	PLOT DATE: 5/5/2006
PROJECT NUMBER: IM 089-3(37)	DRAWN BY: E. ATKINS
FILE NAME: z03al78xs.dgn	CHECKED BY: K. ISHIKURA
PROJECT LEADER: KEN UPMAL	SHEET 98 OF 99
DESIGNED BY: E. ATKINS	

STA. 73+00 TO STA. 74+00