




75+00
END APPROACH
MATCH EXISTING BCP

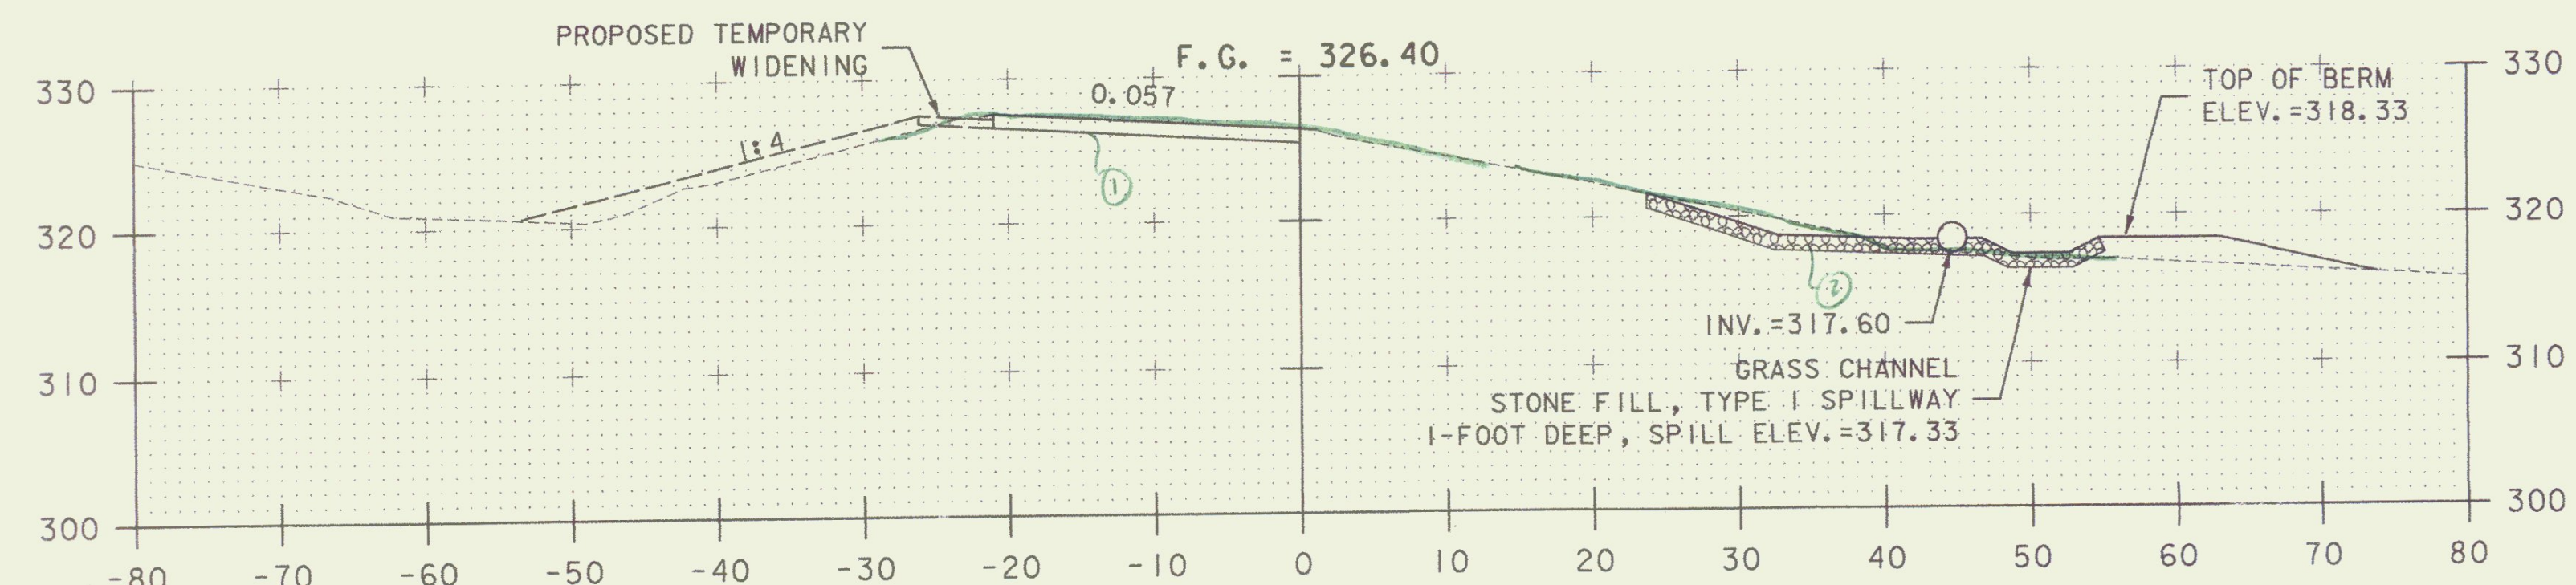


74+50

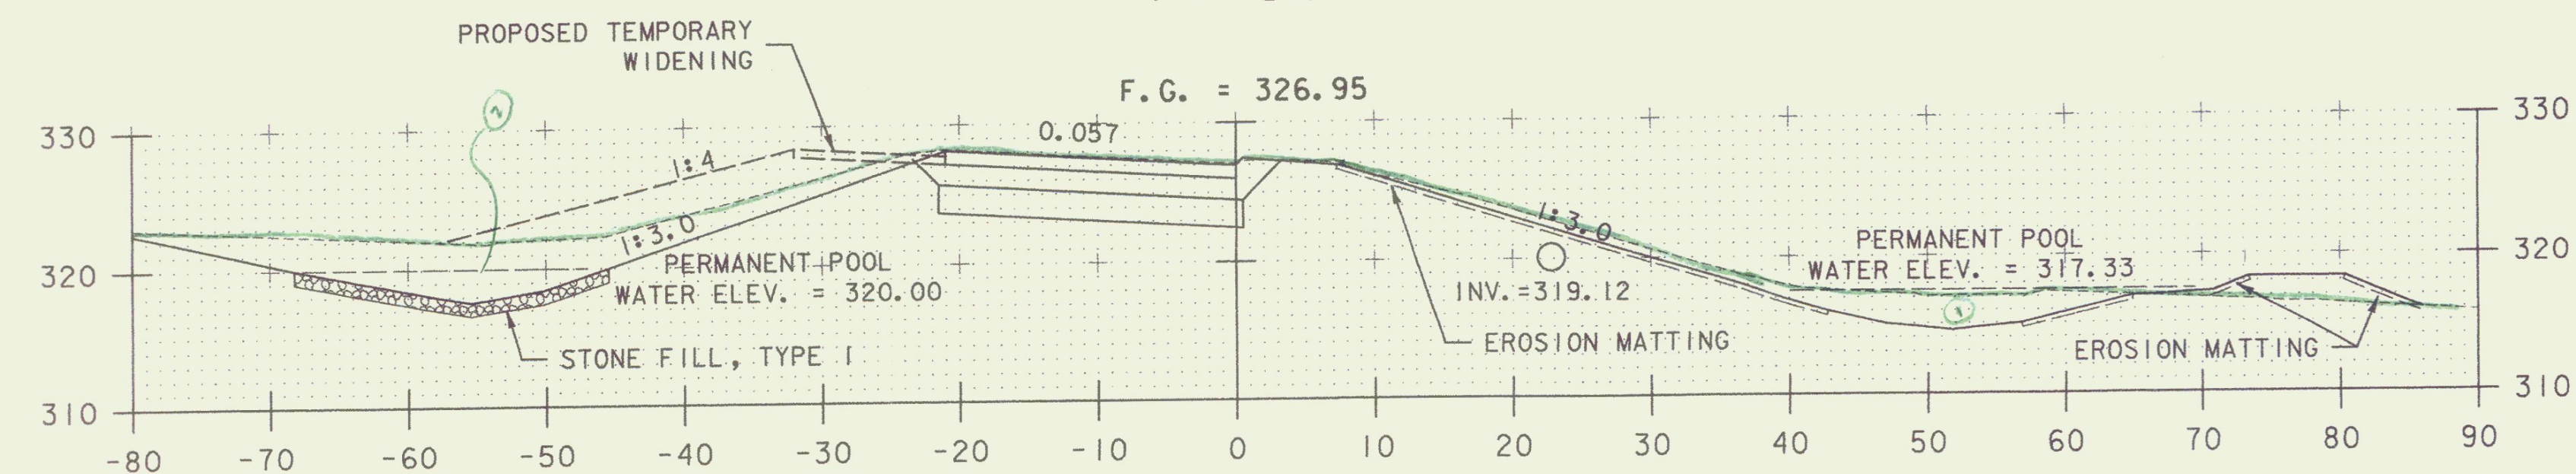


74+31.88
PCC

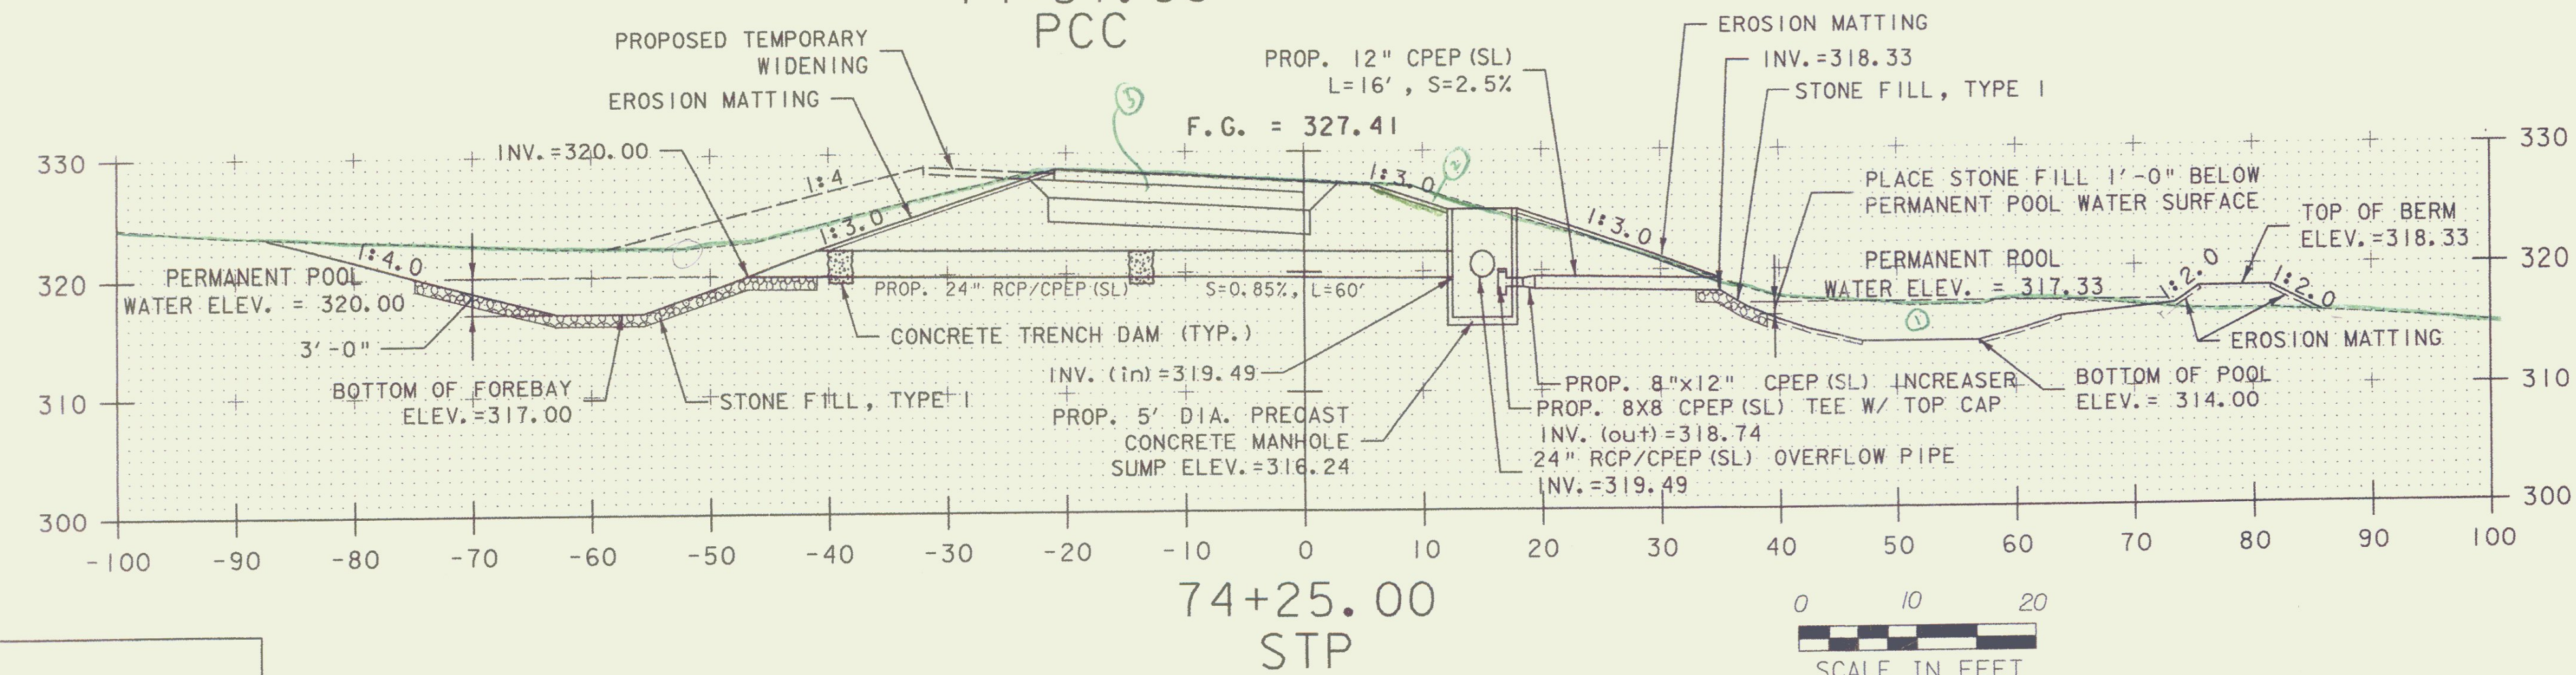


74+25.00
STP

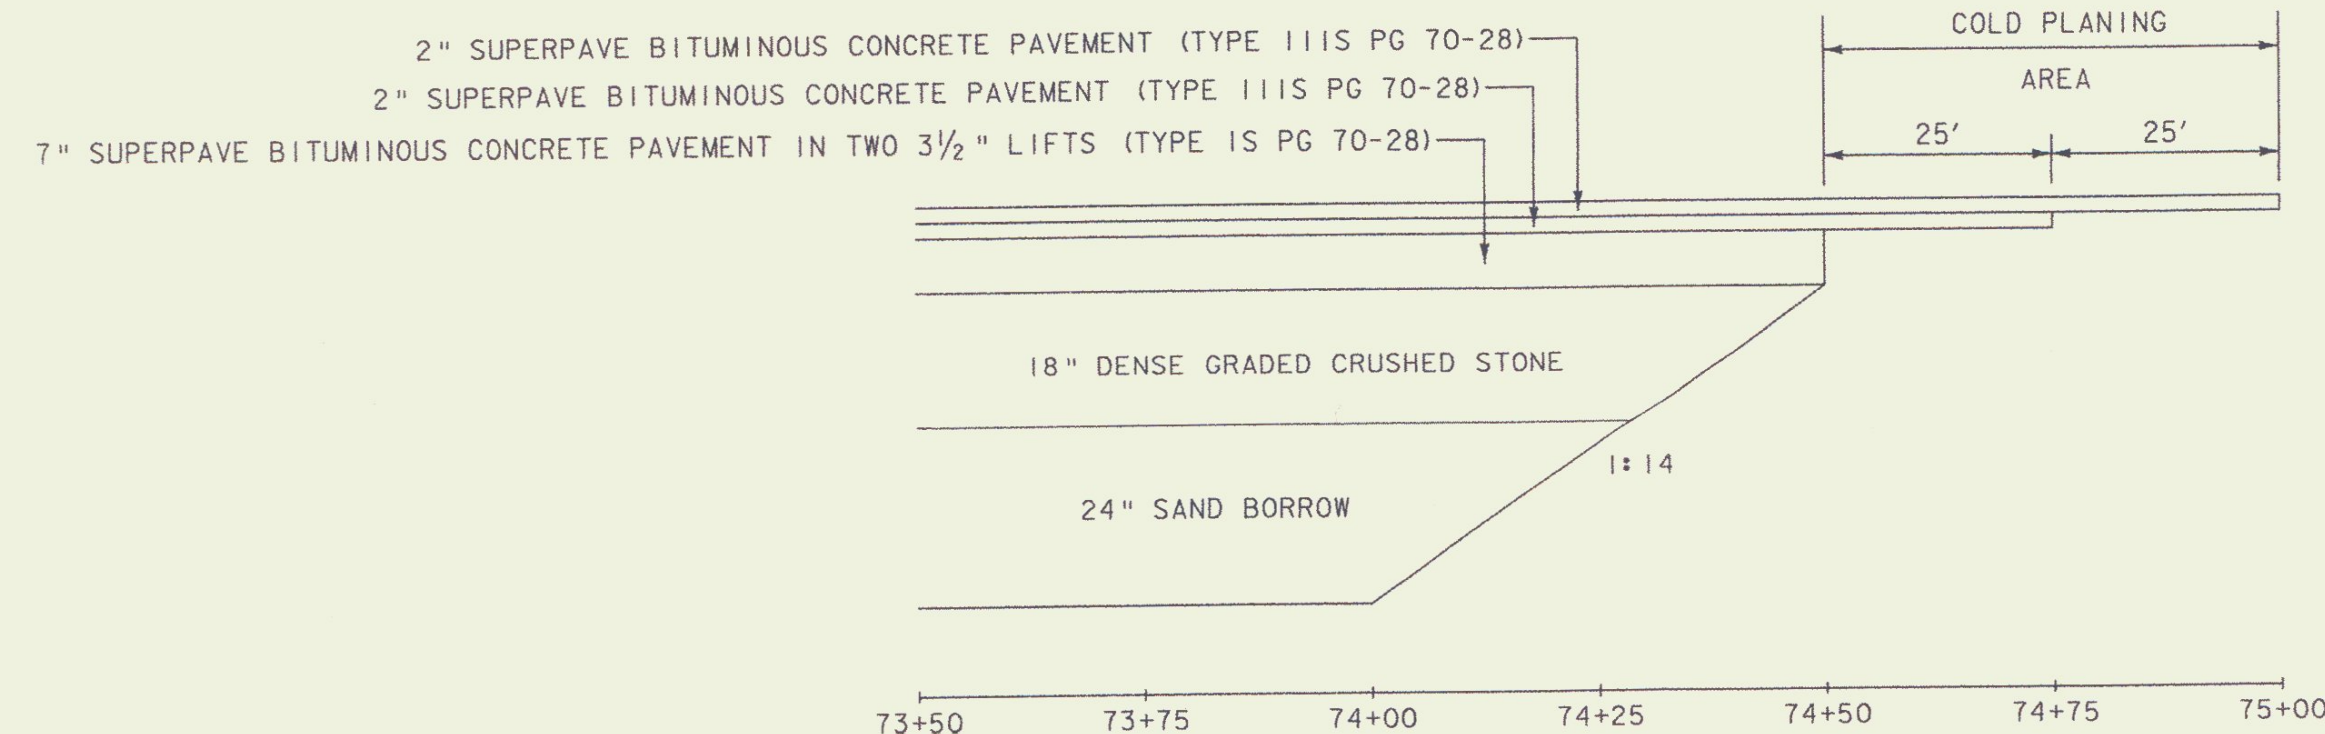


MATERIAL TRANSITION DETAIL
NOT TO SCALE

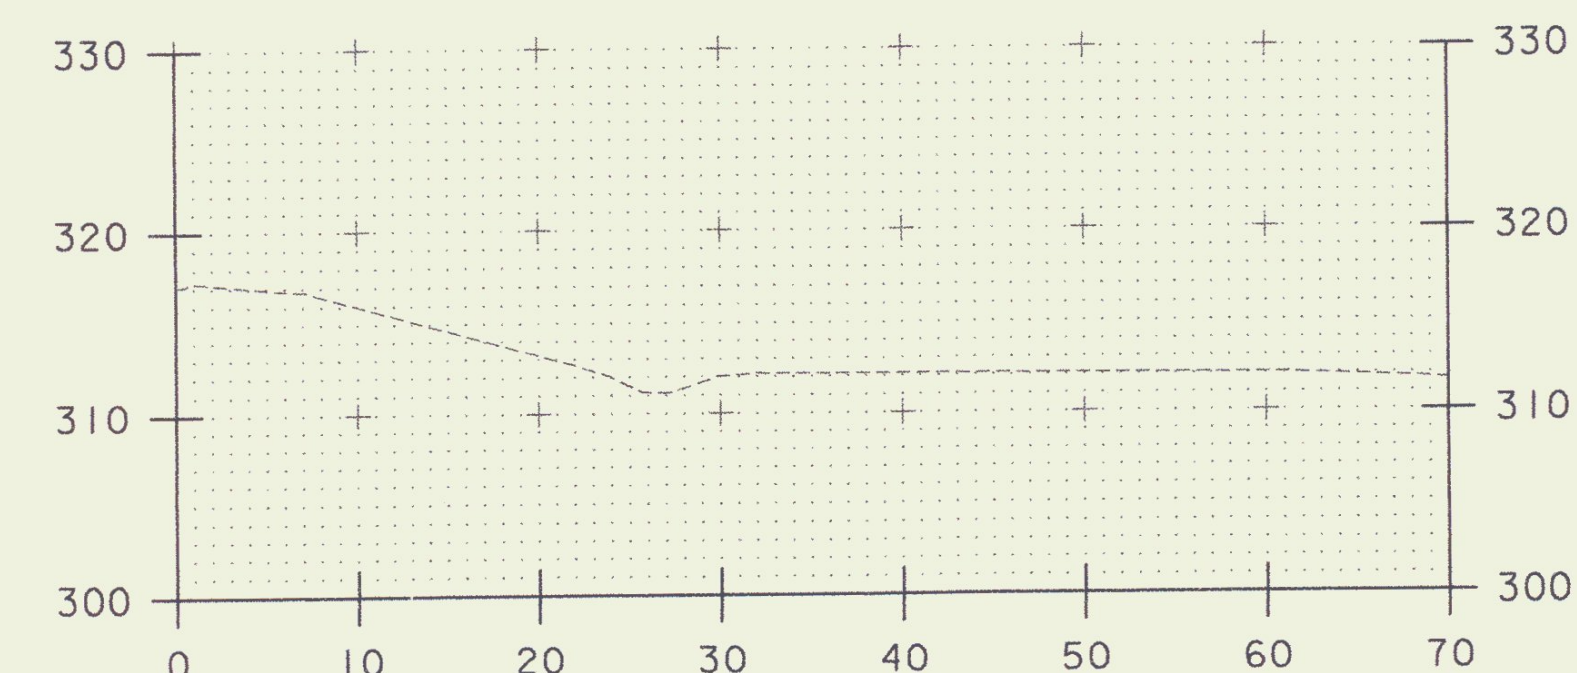

76+50

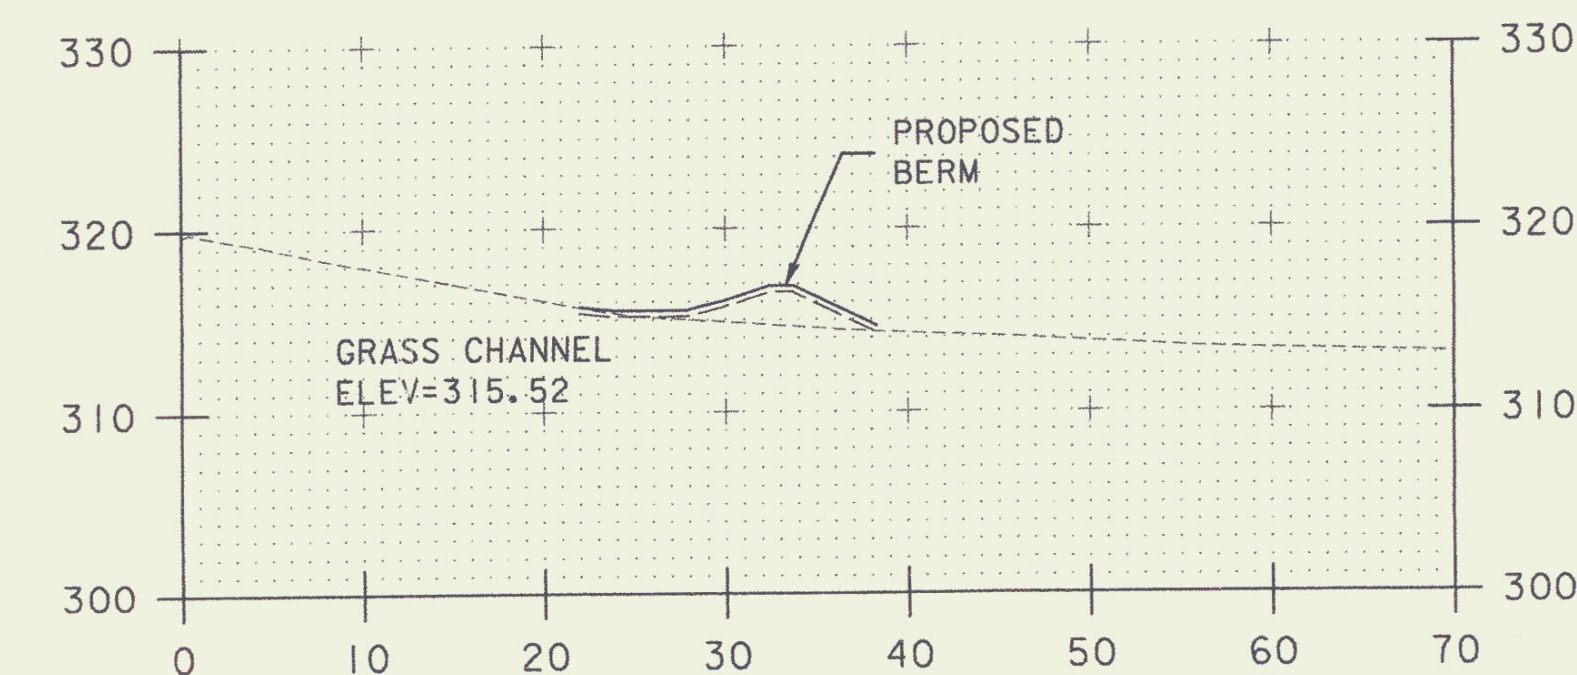

76+00

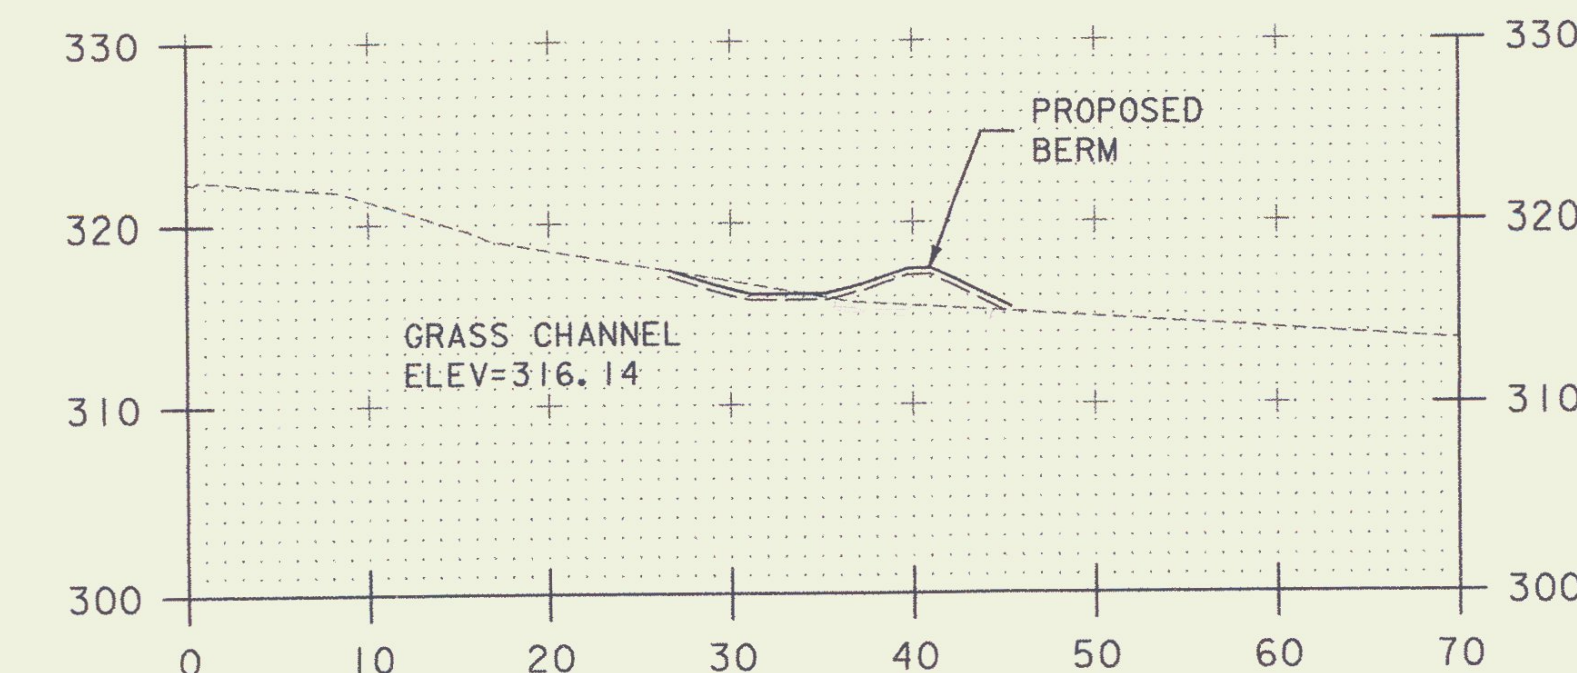

75+50


RAMP "D" SECTIONS SHEET 3

PROJECT NAME: SOUTH BURLINGTON
PROJECT NUMBER: IM 089-3(37)

FILE NAME: z03dl78xs.dgn
PROJECT LEADER: KEN UPMAL
DESIGNED BY: E. ATKINS

PLOT DATE: 5/5/2006
DRAWN BY: E. ATKINS
CHECKED BY: K. ISHIKURA
SHEET 99 OF 99

DATUM
VERTICAL NAVD 88
HORIZONTAL NAD 83 (1996)

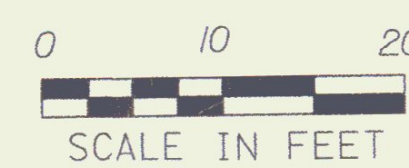

STA. 74+25 TO STA. 76+50