


LEGEND	
FILTER FABRIC DROP INLET PROTECTION	
PROJECT DEMARCATION FENCE	
SILT FENCE (LINE STYLE)	
STABILIZED CONSTRUCTION ENTRANCE	
CHECK DAM	
ADAPTED FROM DETAILS PROVIDED BY NEW YORK STATE DEC ORIGINALLY DEVELOPED BY US&HRC VERMONT DEPARTMENT OF ENVIRONMENTAL CONSERVATION	STANDARD SYMBOLS

NOTES:
REFER TO THE VERMONT STANDARDS & SPECIFICATIONS FOR EROSION PREVENTION & SEDIMENT CONTROL, "2006" FROM THE VT AGENCY OF NATURAL RESOURCES FOR ADDITIONAL GUIDANCE.

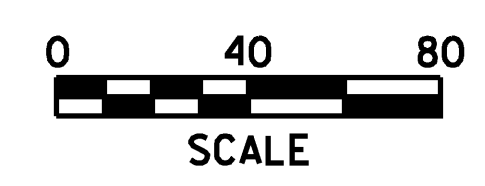

PROJECT NAME:	HARTFORD REST AREAS
PROJECT NUMBER:	IM BLDG(10)
FILE NAME:	... \plot files\04026pit-ero.dgn
PROJECT LEADER:	JTM
DESIGNED BY:	PZA
EROSION CONTROL SHEET 10	CHECKED BY: JTM
	SHEET 33 OF 70