
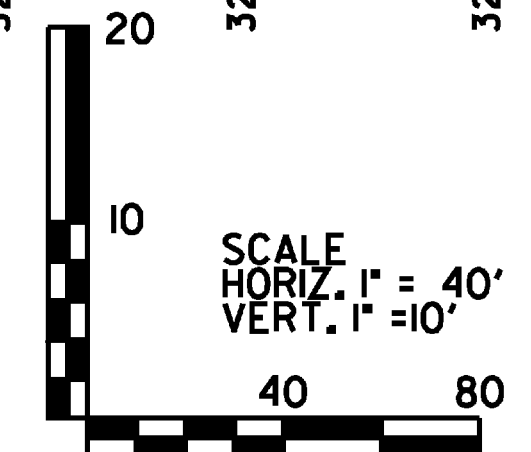
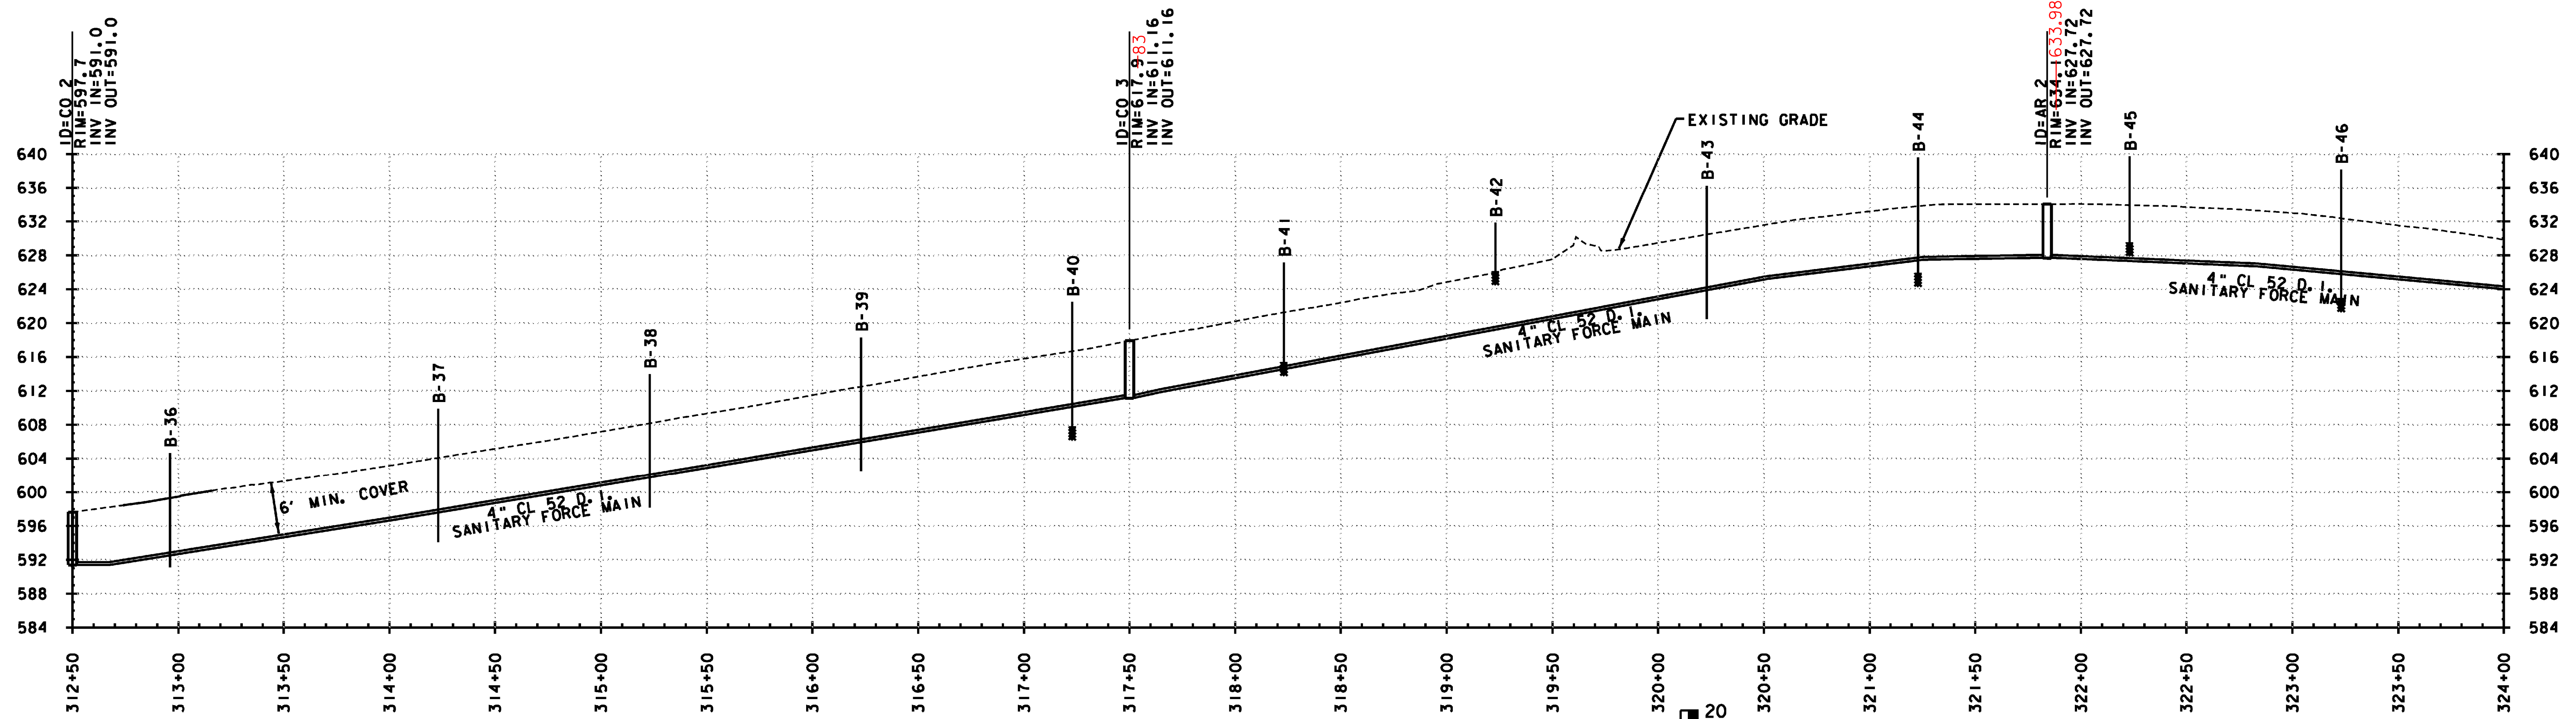


**SANITARY SEWER SYSTEM**

STRUCTURES		PIPES	
C02	STA. 312+50 <sup>49</sup> NEW 5" ID PRECAST CLEANOUT	FMI 1	STA. 312+50 <sup>49</sup> - STA. 317+50 NEW 4" x 500' CL 52 D.I. SANITARY FORCE MAIN
C03	STA. 317+50 NEW 5" ID PRECAST CLEANOUT	FMI 2	STA. 317+50 <sup>85</sup> - STA. 321+84 <sup>85</sup> NEW 4" x 434' CL 52 D.I. SANITARY FORCE MAIN
AR2	STA. 321+84 <sup>83</sup> NEW 5" ID PRECAST AIR RELEASE	FMI 3	STA. 321+84 <sup>83</sup> - STA. 327+84 <sup>85</sup> NEW 4" x 600' CL 52 D.I. SANITARY FORCE MAIN

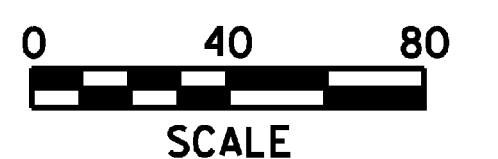

PROJECT NAME:	HARTFORD REST AREAS
PROJECT NUMBER:	IM BLDG(10)
FILE NAME:	...plot files\04026pit-ut1.dgn
PROJECT LEADER:	JTM
DESIGNED BY:	MEHP
PLAN & PROFILE SHEET 4	
PLOT DATE:	5/19/2008
DRAWN BY:	PZA
CHECKED BY:	JTM
SHEET 40	OF 70