



**SANITARY SEWER SYSTEM**

**STRUCTURES**

- C04 STA. 327+84.85  
NEW 5' ID PRECAST CLEANOUT
- C05 STA. 333+72  
NEW 5' ID PRECAST CLEANOUT

**PIPES**

- FM13 STA. 321+84 - STA. 327+84.85  
NEW 4" x 600' CL 52 D.I. SANITARY FORCE MAIN
- FM14 STA. 327+84 - STA. 333+72  
NEW 4" x 588' CL 52 D.I. SANITARY FORCE MAIN
- FM15 STA. 333+72 - STA. 339+00  
NEW 4" x 528' CL 52 D.I. SANITARY FORCE MAIN

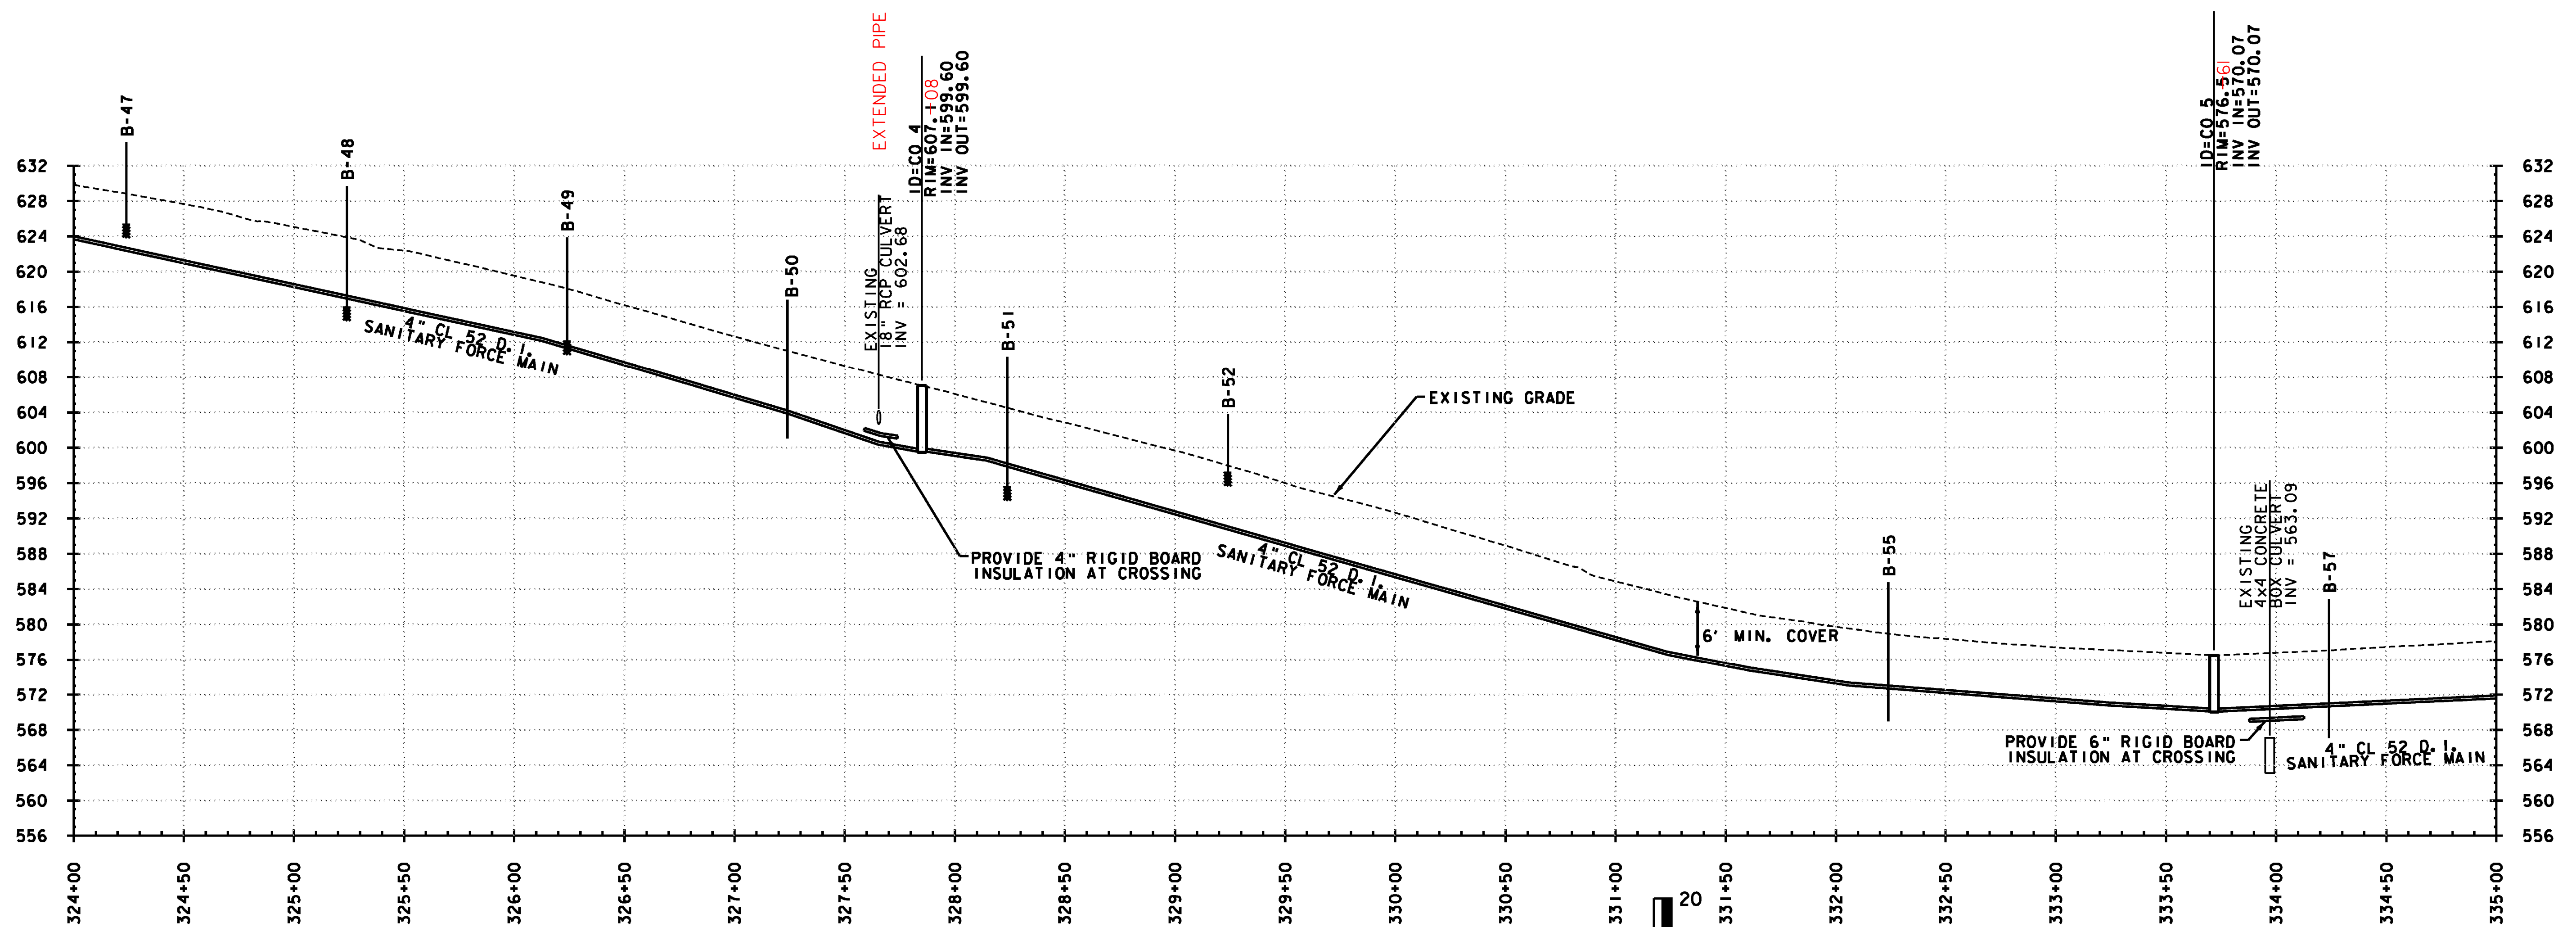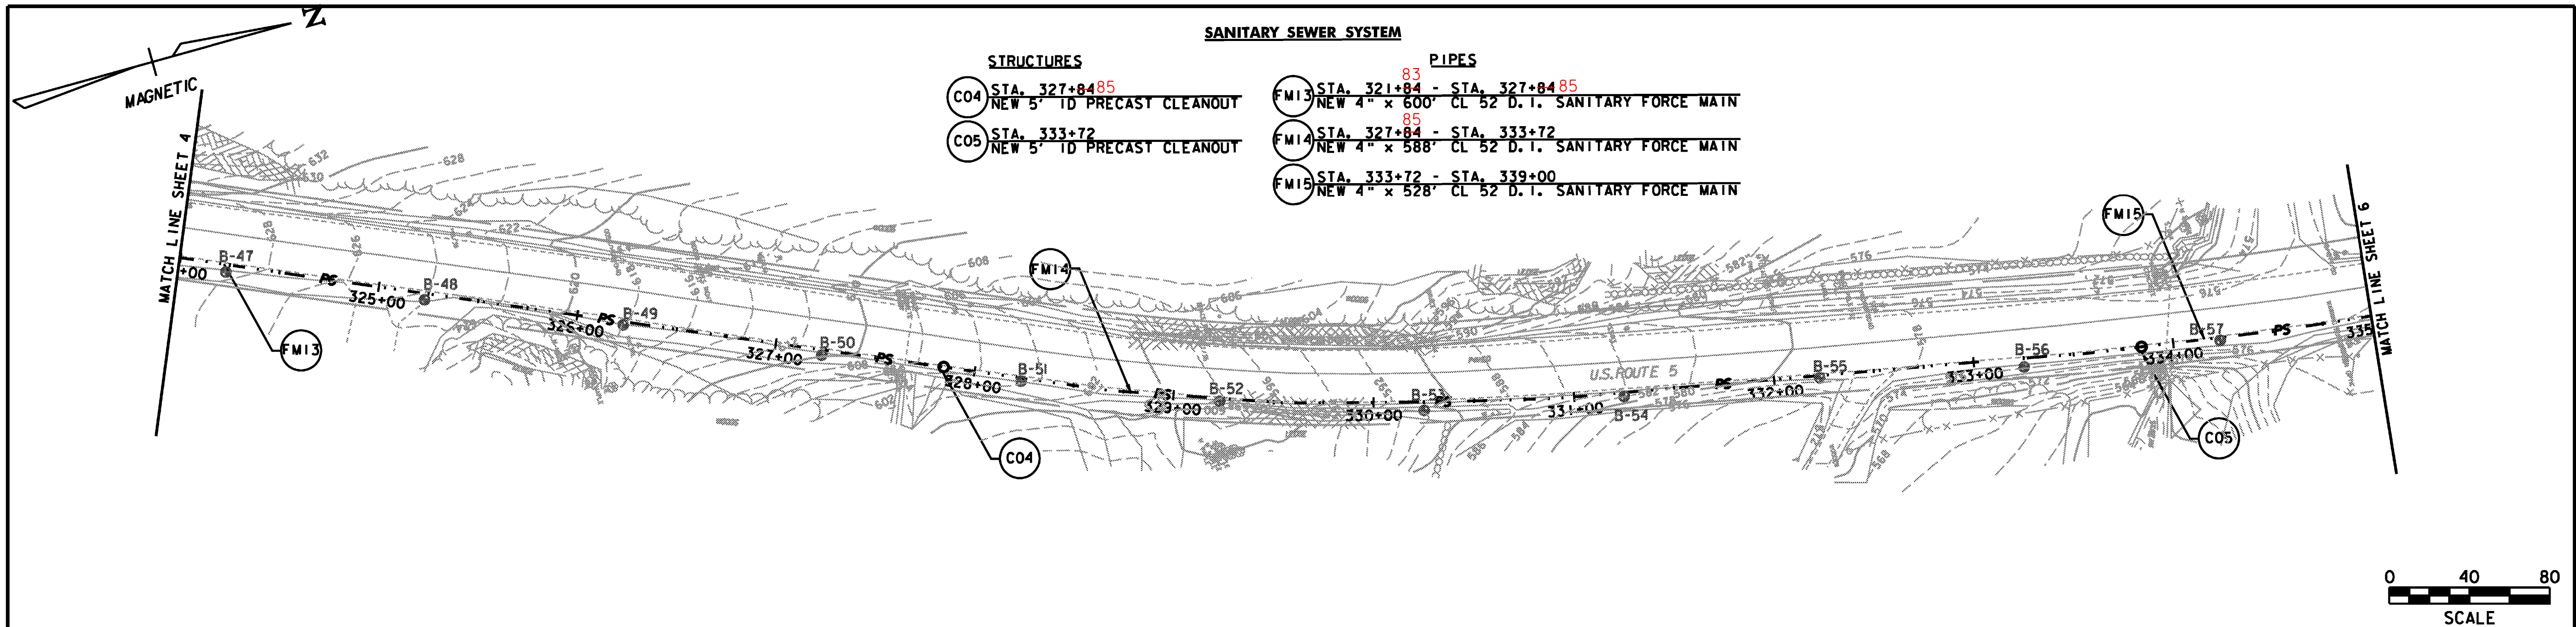

PROJECT NAME:	HARTFORD REST AREAS
PROJECT NUMBER:	IM BLDG(10)
FILE NAME:	...\\plot files\04026\plot-utl.dgn
PLOT DATE:	5/19/2008
PROJECT LEADER:	JTM
DRAWN BY:	PZA
DESIGNED BY:	MEHP
CHECKED BY:	JTM
PLAN & PROFILE SHEET 5	SHEET 41 OF 70