


SIGN & DELINEATOR LEGEND

- N = NEW
- R = REMOVE
- R&S = REMOVE & SALVAGE
- S = SALVAGE SIGN
- RET = RETAIN
- (B-B) = BACK TO BACK

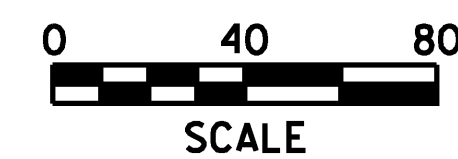

PROJECT NAME: HARTFORD REST AREAS
 PROJECT NUMBER: IM BLDG(10)

FILE NAME: ... \Plot Files\04a026plt-sgn.dgn PLOT DATE: 5/19/2008
 PROJECT LEADER: JTM DRAWN BY: PZA
 DESIGNED BY: CHECKED BY: JTM
 TRAFFIC SIGNING SHEET 5 SHEET 63 OF 70