


SIGN & DELINEATOR LEGEND

- N = NEW
- R = REMOVE
- R&S = REMOVE & SALVAGE
- S = SALVAGE SIGN
- RET = RETAIN
- (B-B) = BACK TO BACK

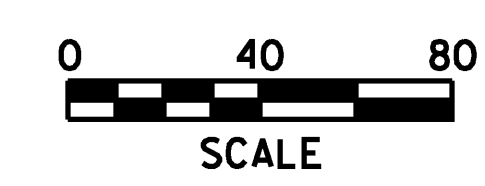

PROJECT NAME: HARTFORD REST AREAS	
PROJECT NUMBER: IM BLDG(10)	
FILE NAME: ... \Plot Files\04a026pl1-sgn.dgn	DATE: 5/19/2008
PROJECT LEADER: JTM	DRAWN BY: PZA
DESIGNED BY:	CHECKED BY: JTM
TRAFFIC SIGNING SHEET 7	SHEET 65 OF 70