


**SIGN & DELINEATOR LEGEND**

- N = NEW
- R = REMOVE
- R&S = REMOVE & SALVAGE
- S = SALVAGE SIGN
- RET = RETAIN
- B-B = BACK TO BACK

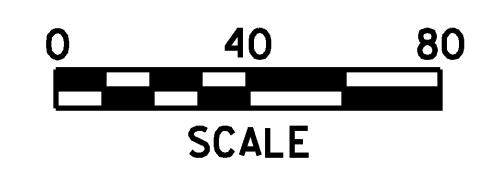

PROJECT NAME: HARTFORD REST AREAS	
PROJECT NUMBER: IM BLDG(10)	
FILE NAME: ... \Plot Files\04a026plt-sgn.dgn	DATE: 5/19/2008
PROJECT LEADER: JTM	DRAWN BY: PZA
DESIGNED BY:	CHECKED BY: JTM
TRAFFIC SIGNING SHEET 8	SHEET 66 OF 70