


SIGN & DELINEATOR LEGEND

- N = NEW
- R = REMOVE
- R&S = REMOVE & SALVAGE
- S = SALVAGE SIGN
- RET = RETAIN
- B-B = BACK TO BACK

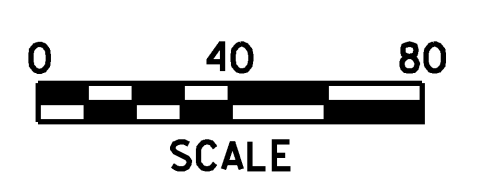

PROJECT NAME:	HARTFORD REST AREAS
PROJECT NUMBER:	IM BLDG(10)
FILE NAME:	...\\Plot Files\\u04a026plt-sgn.dgn
PLLOT DATE:	5/19/2008
PROJECT LEADER:	JTM
DRAWN BY:	PZA
DESIGNED BY:	JTM
CHECKED BY:	JTM
TRAFFIC SIGNING SHEET 11	SHEET 69 OF 70