
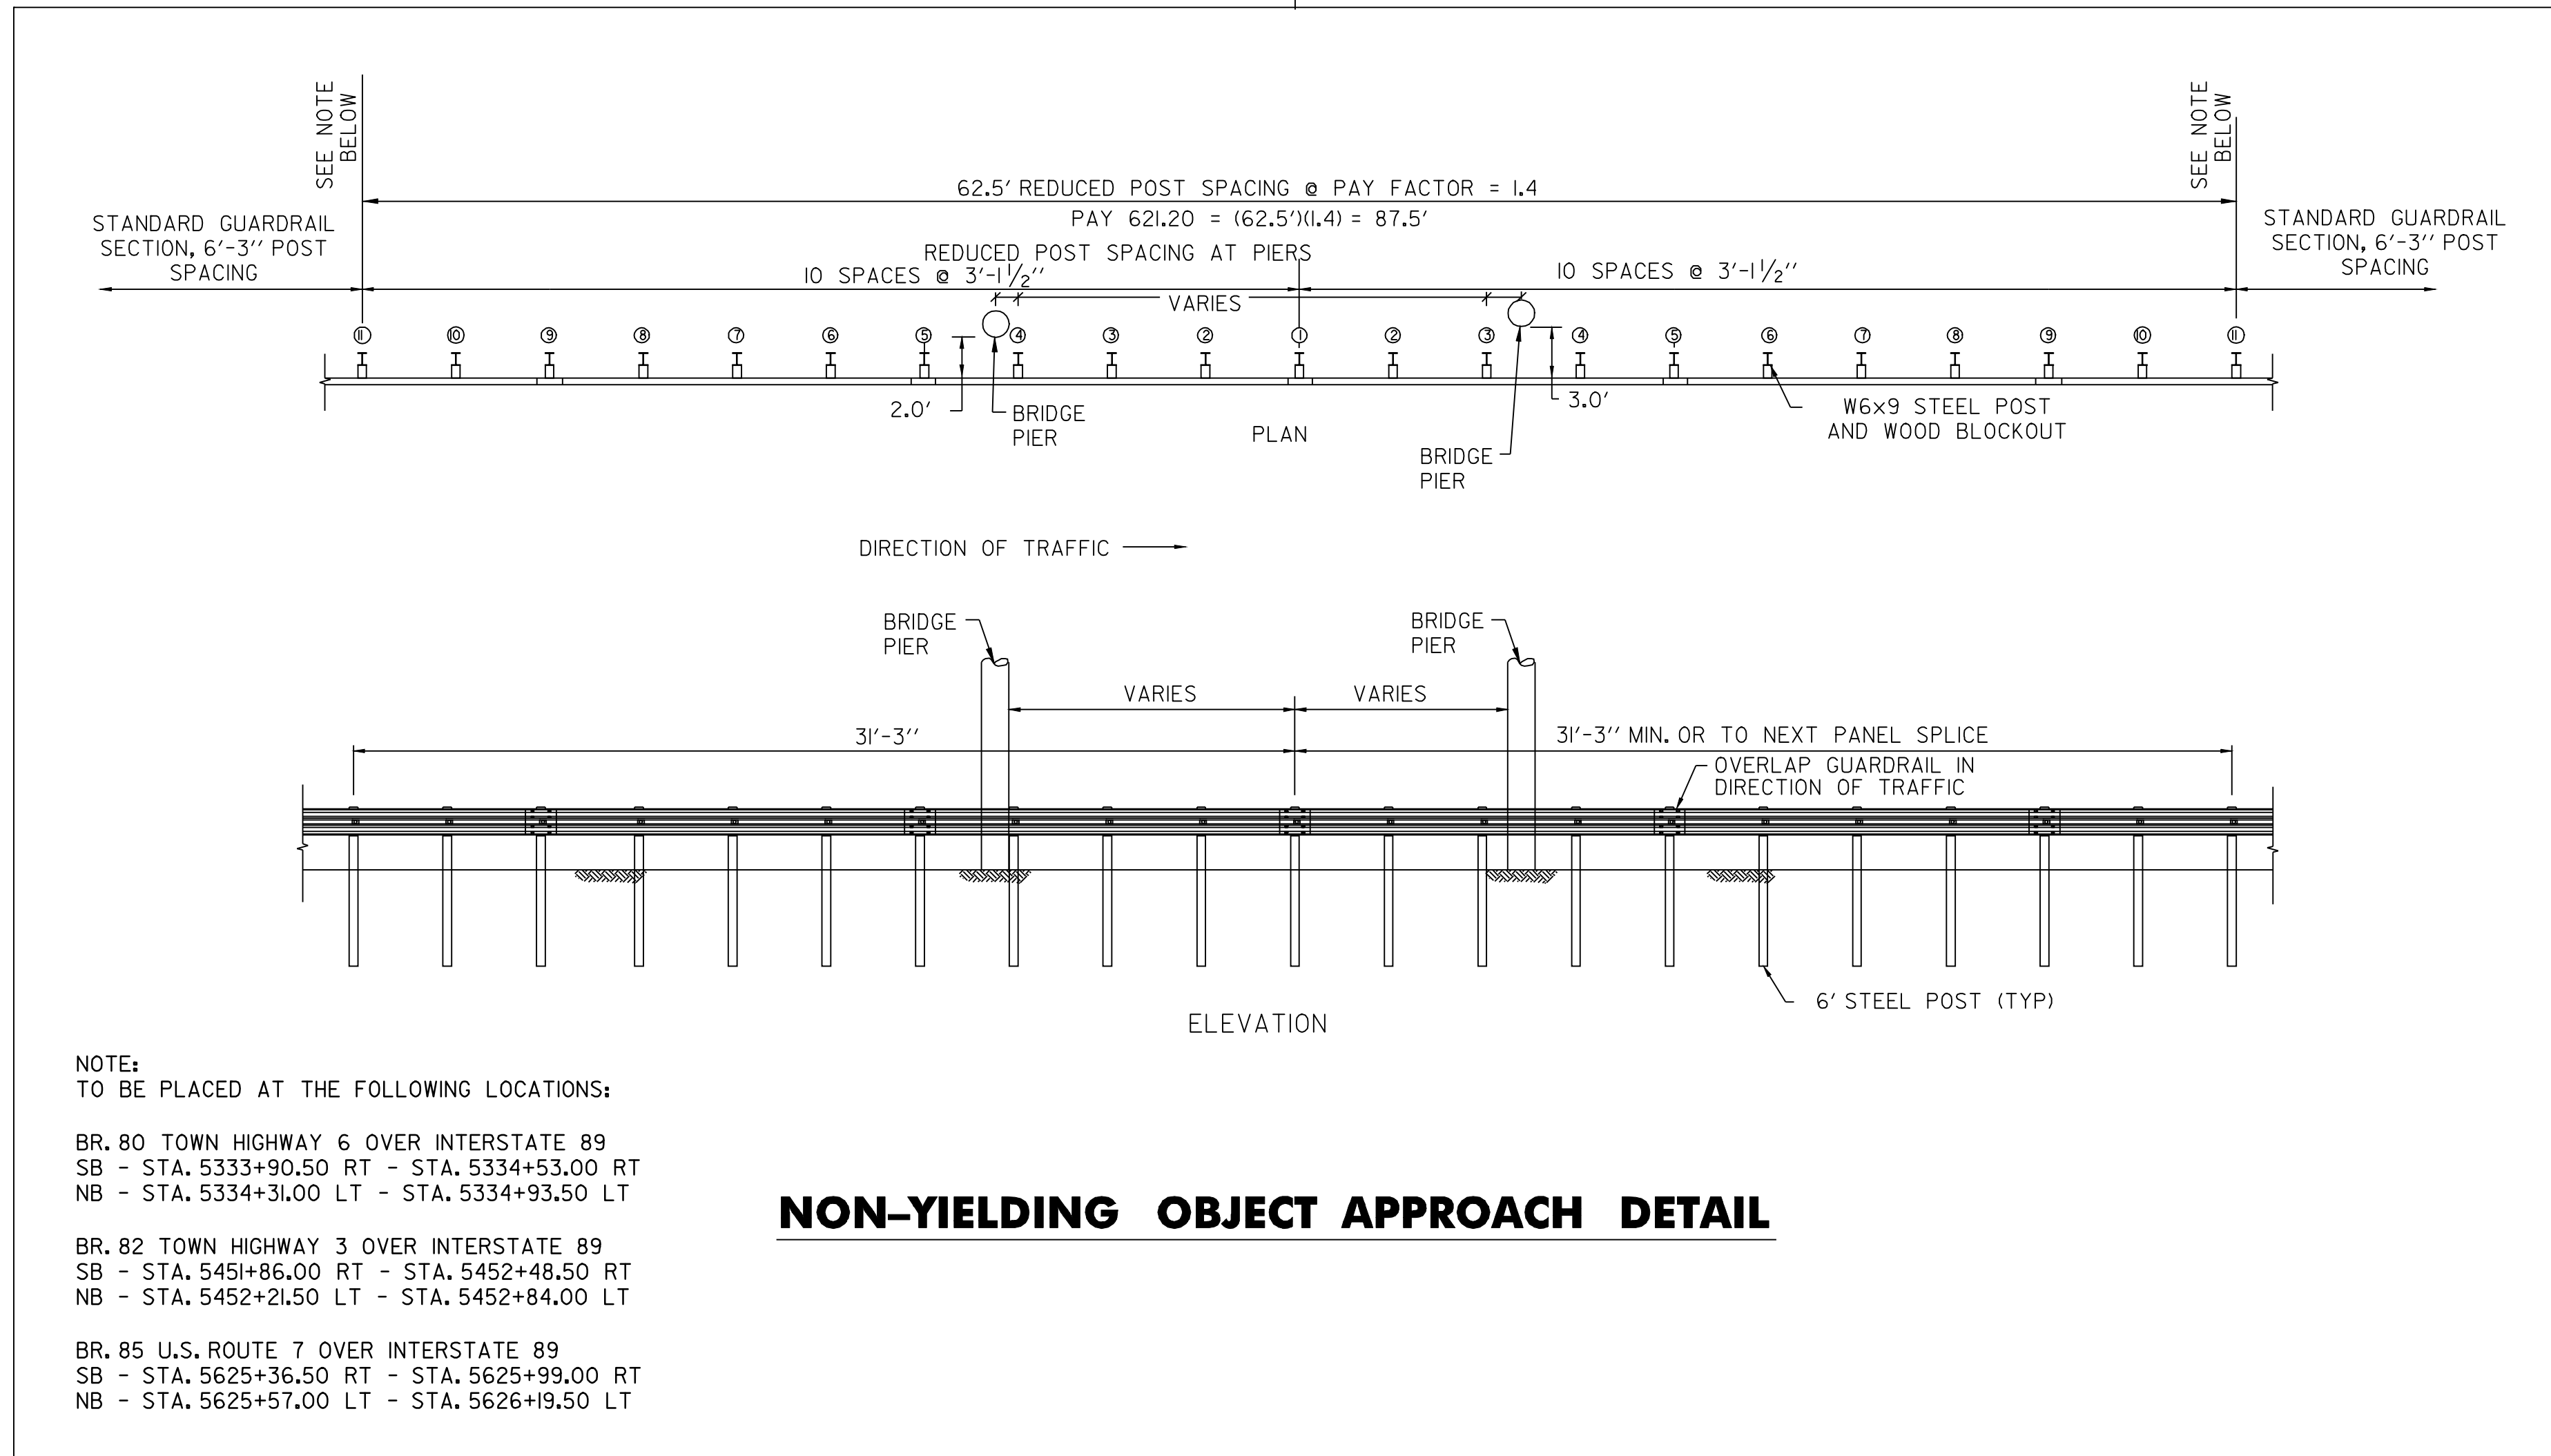


LOCATIONS:

BR. 80 TOWN HIGHWAY 6 OVER INTERSTATE 89  
 NB MM 100.941 TO NB MM 101.138  
 SB MM 101.028 TO SB MM 101.120

# GUARDRAIL TREATMENT AT BULLNOSE LOCATIONS—OVERPASSES

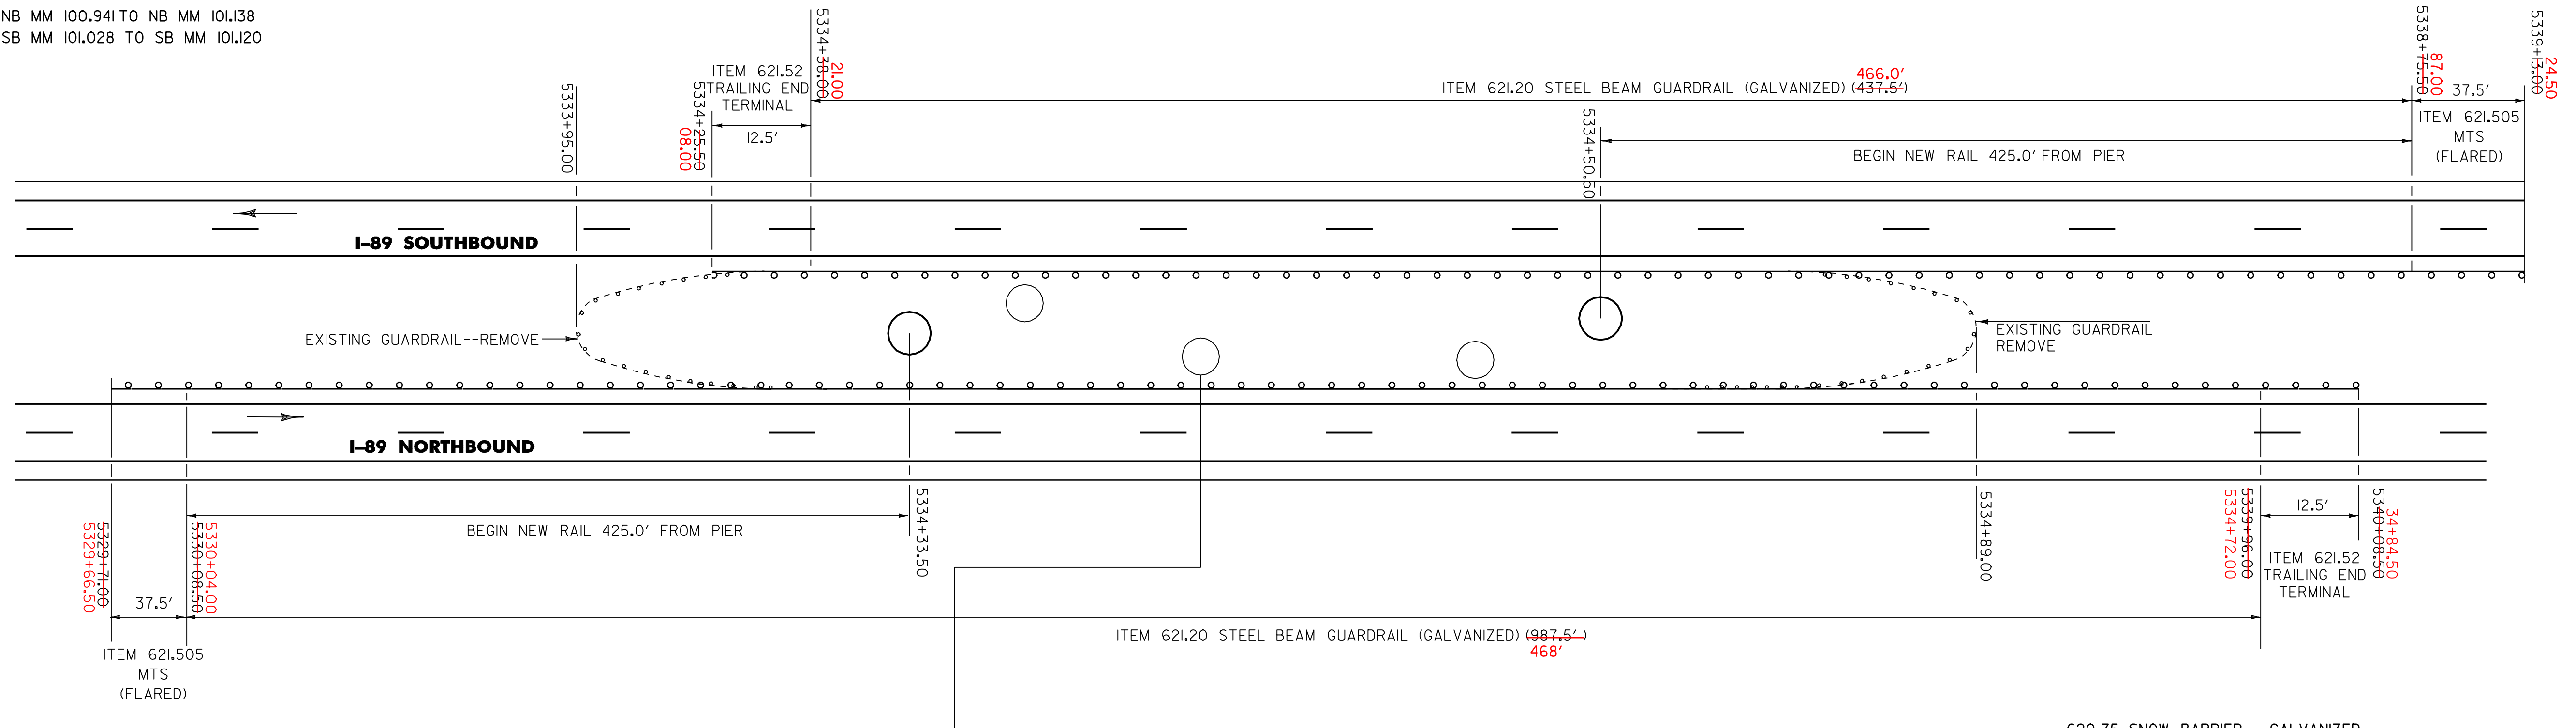

NOTE:  
 TO BE PLACED AT THE FOLLOWING LOCATIONS:

BR. 80 TOWN HIGHWAY 6 OVER INTERSTATE 89  
 SB - STA. 5333+90.50 RT - STA. 5334+53.00 RT  
 NB - STA. 5334+31.00 LT - STA. 5334+93.50 LT

BR. 82 TOWN HIGHWAY 3 OVER INTERSTATE 89  
 SB - STA. 5451+86.00 RT - STA. 5452+48.50 RT  
 NB - STA. 5452+21.50 LT - STA. 5452+84.00 LT

BR. 85 U.S. ROUTE 7 OVER INTERSTATE 89  
 SB - STA. 5625+36.50 RT - STA. 5625+99.00 RT  
 NB - STA. 5625+57.00 LT - STA. 5626+19.50 LT

## NON-YIELDING OBJECT APPROACH DETAIL

### 620.75 SNOW BARRIER - GALVANIZED

5334+26.0 (10 LF)  
 5334+58.0 (15 LF)

### 621.20 STEEL BEAM GUARDRAIL (GALVANIZED)

NB-- STA. 5330+08.50 LT - STA. 5339+96.00 LT  
 SB-- STA. 5334+38.00 RT - STA. 5338+75.50 RT  
 SEE CHANGES ABOVE

### 621.505 MANUFACTURED TERMINAL SECTION (FLARED)

NB--STA. 5329+71.00 LT - STA. 5330+08.50 LT  
 SB--STA. 5338+75.50 RT - STA. 5339+13.00 RT  
 SEE CHANGES ABOVE

### 621.52 TRAILING END TERMINAL

NB--STA. 5339+96.00 LT - STA. 5340+08.50 LT  
 SB--STA. 5334+25.50 RT - STA. 5334+38.00 RT  
 SEE CHANGES ABOVE

### 621.80 REMOVAL & DISPOSAL OF GUARDRAIL

NB--STA. 5333+95.00 LT - STA. 5334+89.00 LT (94.00 LF)  
 SB--STA. 5333+95.00 RT - STA. 5334+89.00 RT (94.00 LF)  
 SEE CHANGES ABOVE

THE CONTRACTOR SHALL WIDEN WITH EARTH BORROW ADJACENT TO THE 4.0' SHOULDER TO PROVIDE BACKING FOR THE NEW GUARDRAIL AND TO CONSTRUCT A FLARE FOR THE END TERMINAL. CONSTRUCTION OF THE WIDENING AND TERMINAL FLARE SHALL BE COMPLETED IN ACCORDANCE WITH STANDARD G-19.

<b>BULLNOSE TREATMENT DETAIL</b>	PROJECT NAME: COLCHESTER - GEORGIA	
	PROJECT NUMBER: IM 089-3(59)	
	FILE NAME: p04g030.DGN	PLOT DATE: 12-OCT-2010 16:39
	PROJECT LEADER: EPD	DRAWN BY: RHB/SJB
DESIGNED BY: JDA	CHECKED BY: EPD	
PLOT FILE:		SHEET 13 OF 22