


GUARDRAIL TREATMENT AT BULLNOSE LOCATIONS - BRIDGES

LOCATIONS:
 BR. 81 INTERSTATE 89 OVER LAMOILLE RIVER
 SB MM 101.587 TO SB MM 101.677 BR 81S
 NB MM 101.587 TO NB MM 101.677 BR 81N

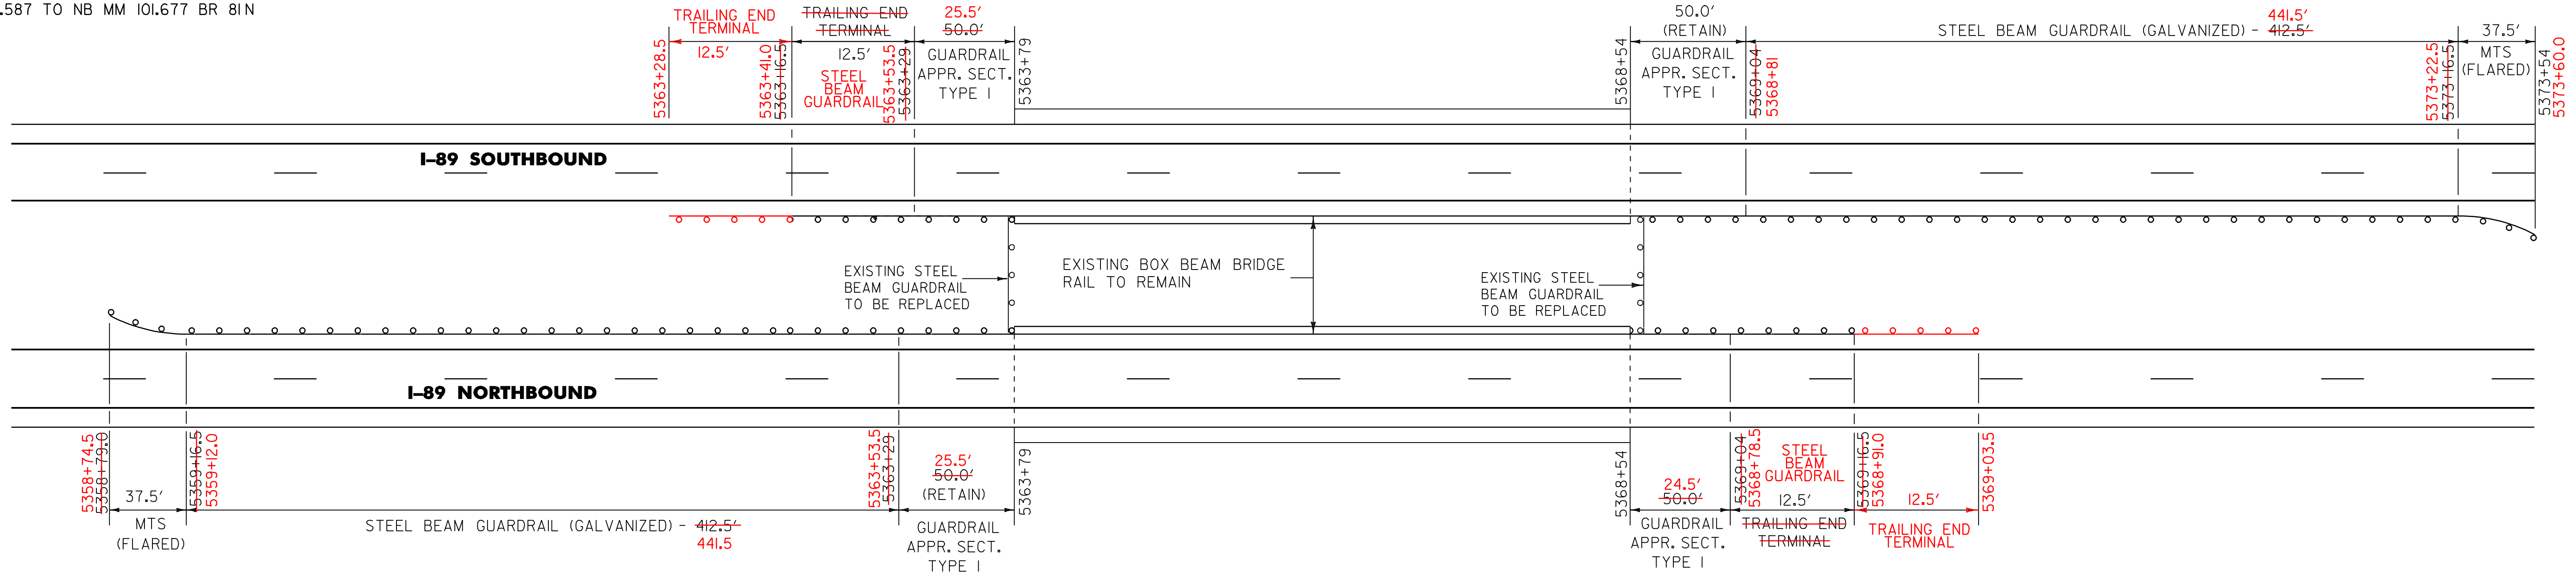

621.20 STEEL BEAM GUARDRAIL (GALVANIZED)
 NB -- 5359+16.5 - 5363+29.0 LT
 SB -- 5369+04.0 - 5373+16.5 RT
 NB & SB -- 5363+79 (39.0 LF)
 NB & SB -- 5368+54 (39.0 LF)
 SEE CHANGES ABOVE

621.80 REMOVING AND DISPOSAL OF GUARDRAIL
 NB -- 5361+41.5 - 5361+79.0 LT (64.50 LF)
 SB -- 5370+79.0 - 5370+91.5 RT (12.50 LF)
 NB & SB -- 5363+79 (39.0 LF)
 NB & SB -- 5368+54 (39.0 LF)
 SEE CHANGES ABOVE


621.505 MANUFACTURED TERMINAL SECTION (FLARED)
 NB -- 5358+79.0 - 5359+16.5 LT
 SB -- 5373+16.5 - 5373+54 RT
 SEE CHANGES ABOVE

621.52 TRAILING END TERMINAL
 NB -- 5369+04 - 5369+16.5 LT
 SB -- 5373+16.5 - 5363+29 RT
 SEE CHANGES ABOVE

621.70 GUARDRAIL APPROACH SECTION TYPE I (GALVANIZED)
 NB -- 5368+54.0 - 5369+04.0 LT
 SB -- 5363+29.0 - 5363+79.0 RT
 SEE CHANGES ABOVE

GUARDRAIL TREATMENT AT BULLNOSE LOCATIONS—OVERPASSES

LOCATIONS:
 BR. 82 TOWN HIGHWAY 3 OVER INTERSTATE 89
 NB MM 103.175 TO NB MM 103.371
 SB MM 103.261 TO SB MM 103.354

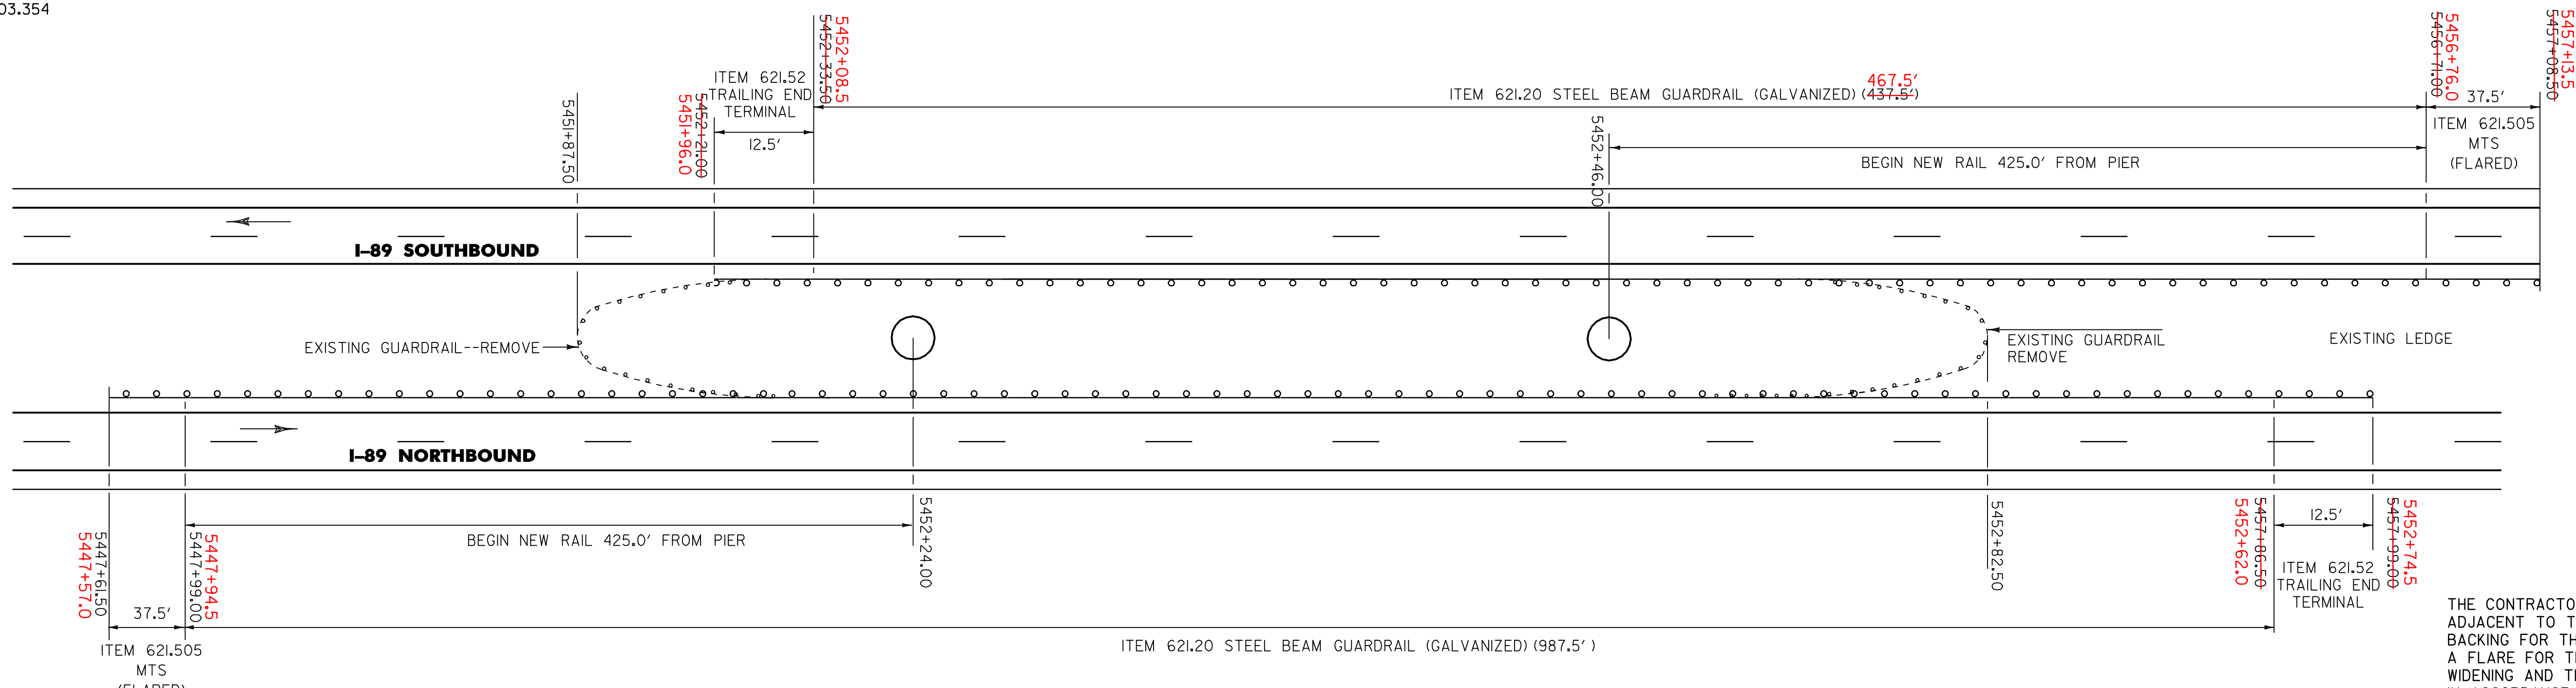

THE CONTRACTOR SHALL WIDEN WITH EARTH BORROW ADJACENT TO THE 4.0' SHOULDER TO PROVIDE BACKING FOR THE NEW GUARDRAIL AND TO CONSTRUCT A FLARE FOR THE END TERMINAL. CONSTRUCTION OF THE WIDENING AND TERMINAL FLARE SHALL BE COMPLETED IN ACCORDANCE WITH STANDARD G-19.

620.75 SNOW BARRIER - GALVANIZED
 5452+16.5 (110 LF)
 5452+90.0 (115 LF)

621.20 STEEL BEAM GUARDRAIL (GALVANIZED)
 NB-- STA. 5447+99.00 LT - STA. 5457+86.50 LT
 SB-- STA. 5452+33.50 RT - STA. 5456+71.00 RT
 SEE CHANGES ABOVE

621.505 MANUFACTURED TERMINAL SECTION (FLARED)
 NB--STA. 5447+61.50 LT - STA. 5447+99.00 LT
 SB--STA. 5456+71.00 RT - STA. 5457+08.50 RT
 SEE CHANGES ABOVE

621.52 TRAILING END TERMINAL
 NB--STA. 5457+86.50 LT - STA. 5457+99.00 LT
 SB--STA. 5452+21.00 RT - STA. 5452+33.50 RT
 SEE CHANGES ABOVE

621.80 REMOVAL & DISPOSAL OF GUARDRAIL
 NB--STA. 5451+87.50 LT - STA. 5452+82.50 LT (95.00 LF)
 SB--STA. 5451+87.50 RT - STA. 5452+82.50 RT (95.00 LF)
 SEE CHANGES ABOVE

BULLNOSE TREATMENT DETAIL

PROJECT NAME: COLCHESTER - GEORGIA
 PROJECT NUMBER: IM 089-3(59)

FILE NAME: p04g030.DGN
 PROJECT LEADER: EPD
 DESIGNED BY: JDA
 PLOT FILE:
 PLOT DATE: 12-OCT-2010 16:39
 DRAWN BY: RHB/SJB
 CHECKED BY: EPD
 SHEET 14 OF 22