


GUARDRAIL TREATMENT AT BULLNOSE LOCATIONS - BRIDGES


LOCATIONS:
 BR. 84 INTERSTATE 89 OVER TOWN HIGHWAY 6
 SB MM 105.662 TO SB MM 105.678 BR 84 S
 NB MM 105.662 TO NB MM 105.678 BR 84 N

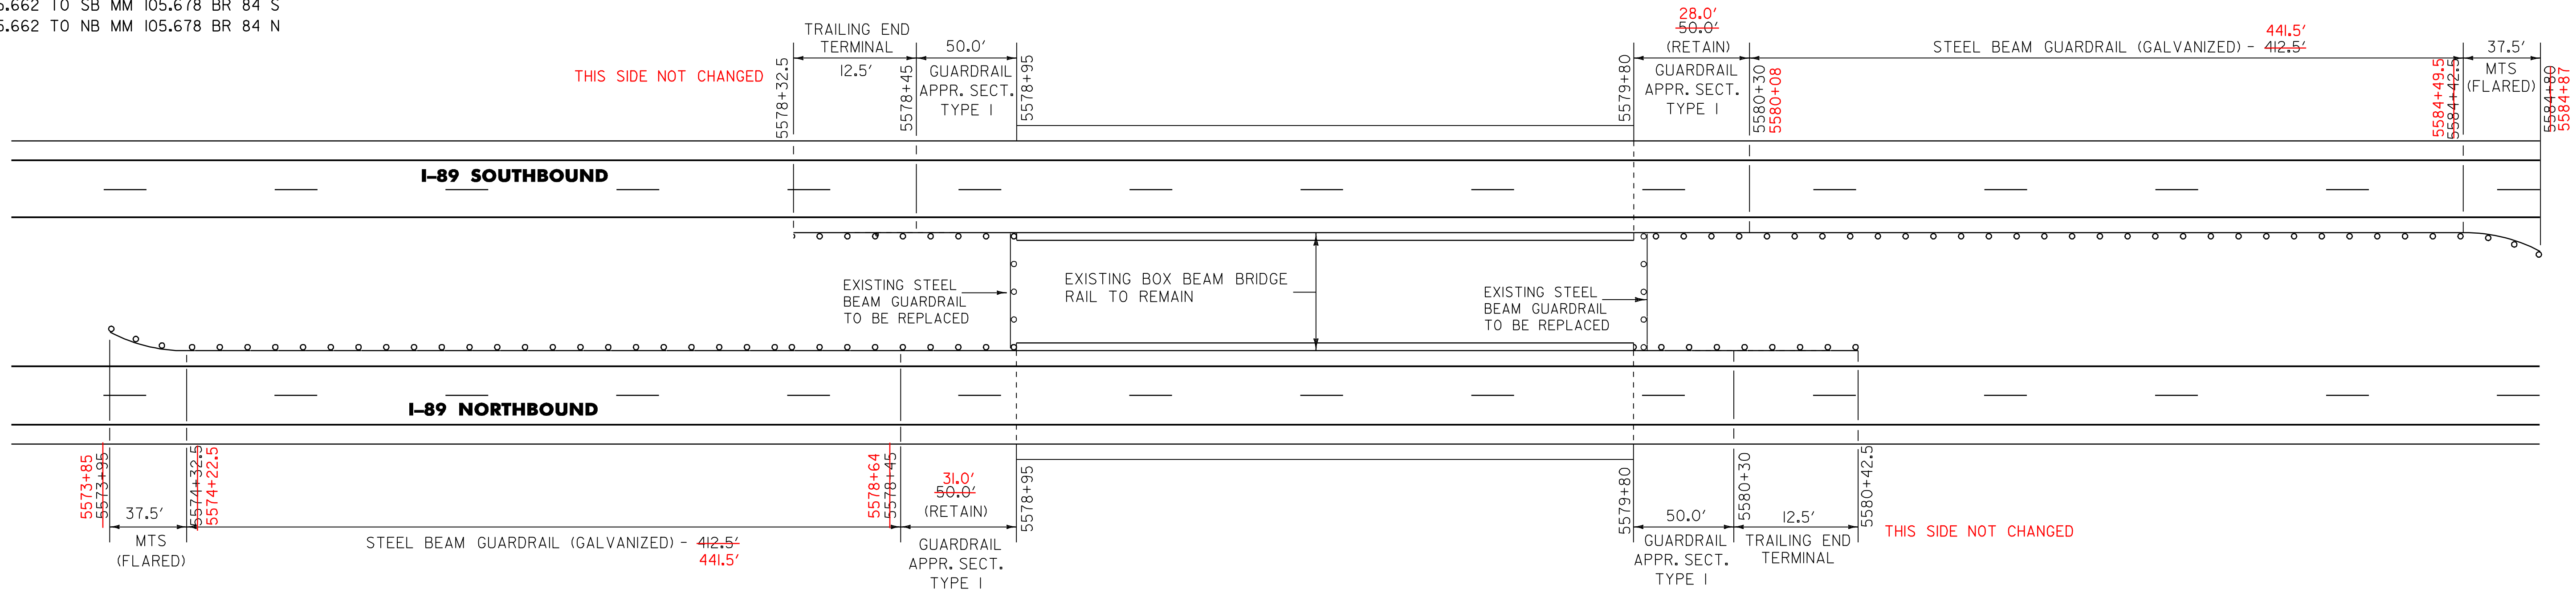

- | | | | | |
|---|--|---|---|--|
| <p>621.20 STEEL BEAM GUARDRAIL (GALVANIZED)
 NB -- 5574+32.5 - 5578+45.0 LT
 SB -- 5580+30.0 - 5584+42.5 RT
 NB & SB -- 5578+95 (I21.0 LF)
 NB & SB -- 5579+80 (I21.0 LF)
 SEE CHANGES ABOVE</p> | <p>621.80 REMOVING AND DISPOSAL OF GUARDRAIL
 NB -- 5574+93.0 - 5575+05.5 LT (I2.5 LF)
 NB -- 5579+80.0 - 5580+30.0 LT (50.0 LF)
 SB -- 5583+57.0 - 5583+94.5 RT (37.5 LF)
 NB & SB -- 5578+95 (I21.0 LF)
 NB & SB -- 5579+80 (I21.0 LF)
 SEE CHANGES ABOVE</p> | <p>621.505 MANUFACTURED TERMINAL SECTION (FLARED)
 NB -- 5573+95.0 - 5574+32.5 LT
 SB -- 5584+42.5 - 5584+80.0 RT
 SEE CHANGES ABOVE</p> | <p>621.52 TRAILING END TERMINAL
 NB -- 5580+30 - 5580+42.5 LT
 SB -- 5578+32.5 - 5578+45 RT
 SEE CHANGES ABOVE</p> | <p>621.70 GUARDRAIL APPROACH SECTION TYPE I (GALVANIZED)
 NB -- 5579+80.0 - 5580+30.0 LT
 SB -- 5578+45.0 - 5578+95.0 RT
 SEE CHANGES ABOVE</p> |
|---|--|---|---|--|

LOCATIONS:
 BR. 85 U.S. ROUTE 7 OVER INTERSTATE 89
 NB MM 106.458 - NB MM 106.654
 SB MM 106.544 - SB MM 106.640

- | | | | | |
|--|---|---|---|--|
| <p>620.75 SNOW BARRIER - GALVANIZED
 5625+52.0 (I10 LF)
 5626+04.0 (I15 LF)</p> | <p>621.20 STEEL BEAM GUARDRAIL (GALVANIZED)
 NB-- STA. 5621+34.50 LT - STA. 5631+22.00 LT
 SB-- STA. 5625+72.00 RT - STA. 5630+21.50 RT
 SEE CHANGES BELOW</p> | <p>621.505 MANUFACTURED TERMINAL SECTION (FLARED)
 NB--STA. 5620+97.00 LT - STA. 5621+34.50 LT
 SB--STA. 5630+21.50 RT - STA. 5630+59.00 RT
 SEE CHANGES BELOW</p> | <p>621.52 TRAILING END TERMINAL
 NB--STA. 5631+22.00 LT - STA. 5631+34.50 LT
 SB--STA. 5625+59.50 RT - STA. 5625+72.00 RT
 SEE CHANGES BELOW</p> | <p>621.80 REMOVAL & DISPOSAL OF GUARDRAIL
 NB--STA. 5625+23.50 LT - STA. 5626+32.50 LT (I09.00 LF)
 SB--STA. 5625+23.50 RT- STA. 5626+32.50 RT (I09.00 LF)
 SEE CHANGES BELOW</p> |
|--|---|---|---|--|

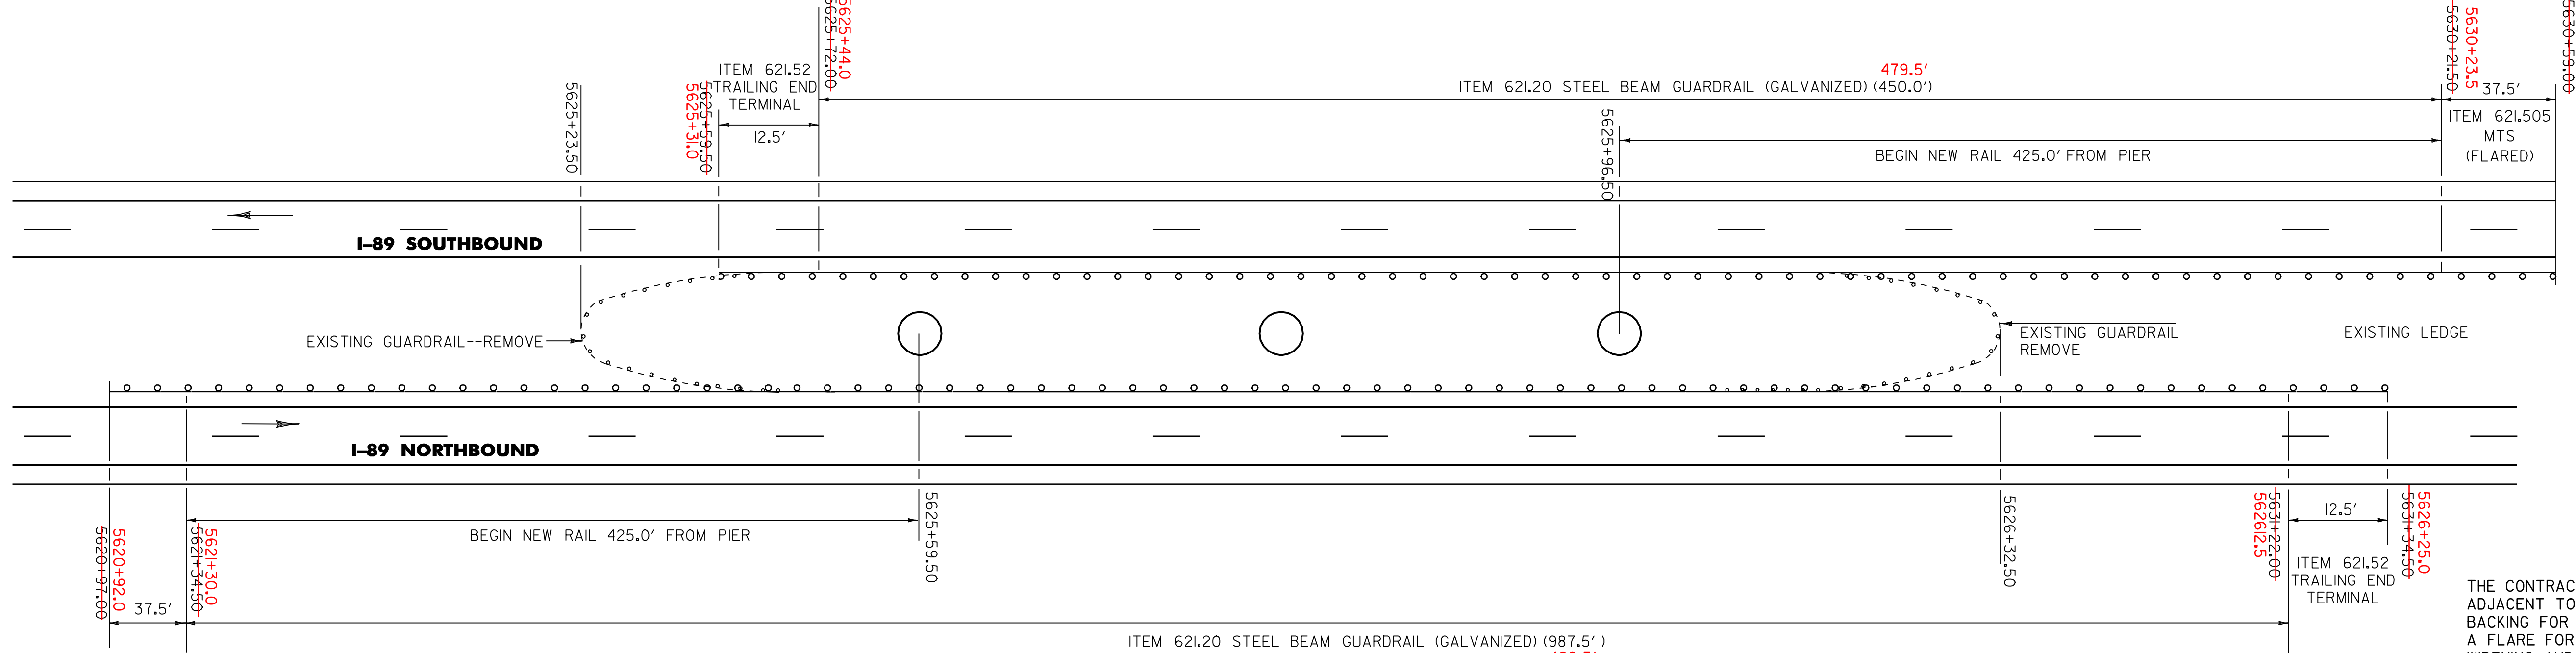

THE CONTRACTOR SHALL WIDEN WITH EARTH BORROW ADJACENT TO THE 4.0' SHOULDER TO PROVIDE BACKING FOR THE NEW GUARDRAIL AND TO CONSTRUCT A FLARE FOR THE END TERMINAL. CONSTRUCTION OF THE WIDENING AND TERMINAL FLARE SHALL BE COMPLETED IN ACCORDANCE WITH STANDARD G-19.

BULLNOSE TREATMENT DETAIL	PROJECT NAME: COLCHESTER - GEORGIA	
	PROJECT NUMBER: IM 089-3(59)	
	FILE NAME: p04g030.DGN	PLOT DATE: 12-OCT-2010 16:39
	PROJECT LEADER: EPD	DRAWN BY: RHB/SJB
DESIGNED BY: JDA	CHECKED BY: EPD	
PLOT FILE:	SHEET 15 OF 22	