



INDEX OF SHEETS

- 1 COMPOSITE TITLE SHEET
- 2-5 COMPOSITE QUANTITY SHEETS
- 6 TITLE SHEET - BOLTON - SO. BURLINGTON  
AC IM 089-2(36)
- 7-10 TYPICAL SHEETS
- 11-14 QUANTITY SHEETS
- 15-23 ITEM DETAIL SHEETS
- 24-26 PAVING PROJECT LAYOUT SHEETS
- 27 INT. # 11 RAMP DETAIL SHEETS
- 28 INT. # 12 RAMP DETAIL SHEETS
- 29 INT. # 13 RAMP DETAIL SHEETS
- 30 SOUTHBOUND REST AREA
- 31-32 MILLED RUMBLE STRIPS DETAIL SHEETS
- 33 TRAFFIC CONTROL PLAN @ EXIT 13 # 01
- 34 TRAFFIC CONTROL PLAN @ EXIT 13 # 02
- 35-36 DETAIL SHEETS
- 37-38 SIGN SUMMARY SHEETS
- 39-40 CONSTRUCTION APPROACH SIGNING SHEETS
- 41 EROSION CONTROL NARRATIVE
- 42 EROSION CONTROL PLAN
- 43 SILT FENCE DETAILS
- 44 INLET AND CHECK DAM DETAILS
- 45 CONSTRUCTION ENTRANCE DETAILS
- 46 TITLE SHEET - WILLISTON IM 089-2(35)
- 47 TYPICAL SECTION SHEET
- 48-49 QUANTITY SHEETS
- 50 SIGN SUMMARY SHEET
- 51 SIGN SUMMARY AND DETAIL SHEET
- 52 TIE SHEET
- 53 LAYOUT SHEET
- 54 SIGNS & PAVEMENT MARKING SHEET
- 55 TRAFFIC SIGNAL PLAN SHEET
- 56 SIGN ACTUATION NOTES AND DETAILS
- 57 EROSION CONTROL NARRATIVE
- 58 EROSION CONTROL EXISTING CONDITIONS
- 59 EROSION AND SEDIMENT CONTROL PLAN
- 60 EROSION CONTROL FINAL CONDITIONS
- 61 SILT FENCE DETAILS
- 62 CHECK DAM & CATCH BASIN PROTECTION DETAILS
- 63 EROSION MATTING DETAILS
- 64 CONSTRUCTION ENTRANCE DETAILS
- 65 CONCRETE PAD DETAILS
- 66 SIGN BRIDGE DETAILS
- 67 SIGN BRIDGE NOTES
- 68 TRAFFIC CONTROL SHEET
- 69-76 CROSS SECTION SHEETS

STATE OF VERMONT  
AGENCY OF TRANSPORTATION

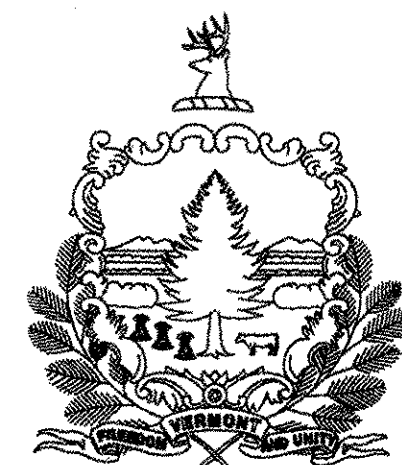



PROPOSED IMPROVEMENT  
TOWNS OF  
BOLTON, RICHMOND,  
WILLISTON, & SO. BURLINGTON  
COUNTY OF CHITTENDEN  
INTERSTATE ROUTE 89 SB

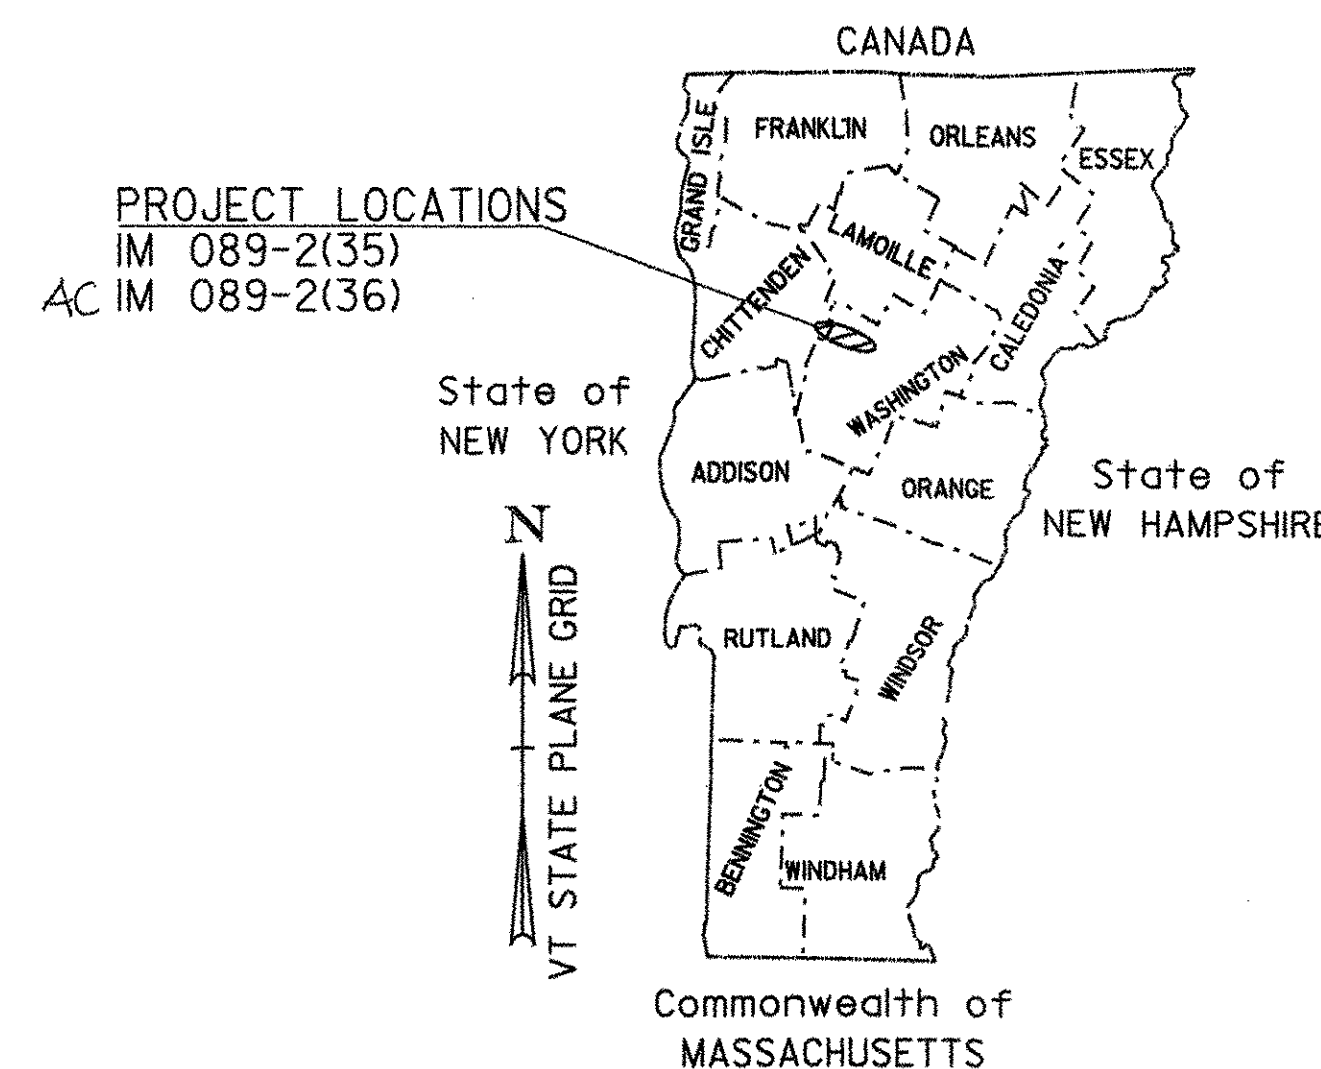

**BOLTON-SO. BURLINGTON**

AC IM 089-2(36)

SEE SHEETS 06 - 40

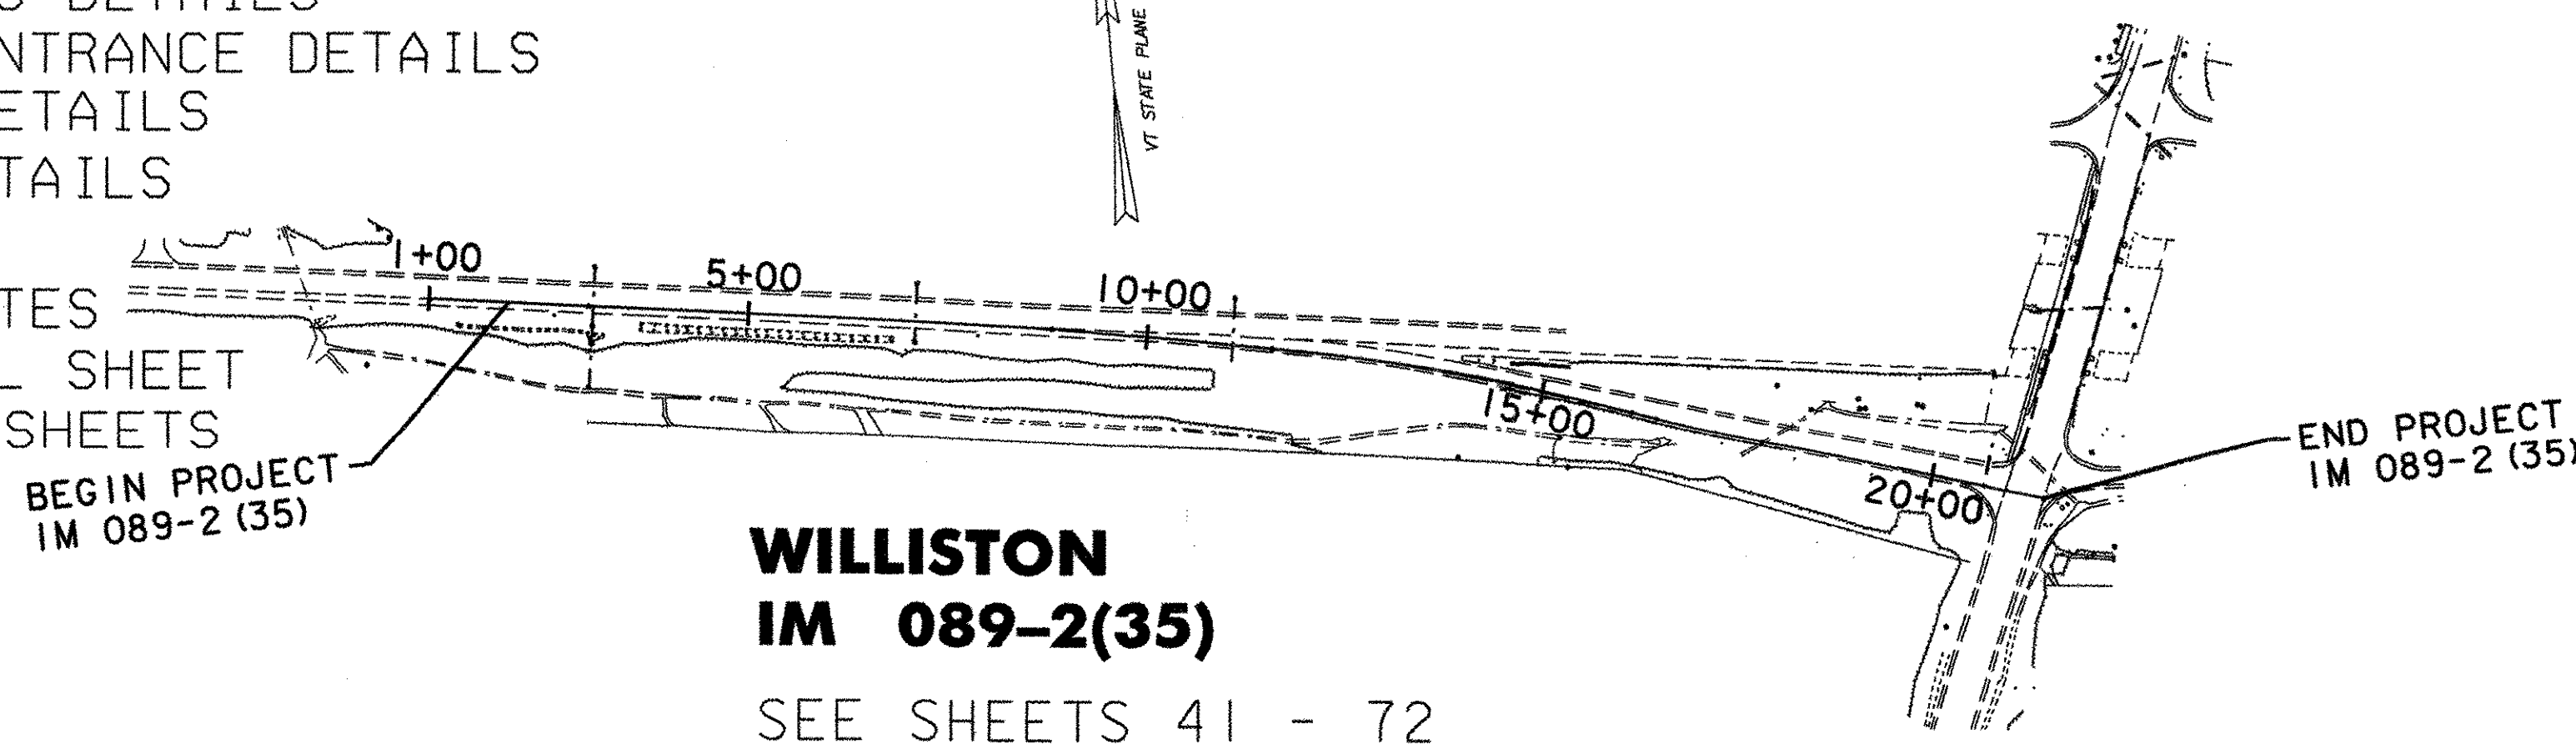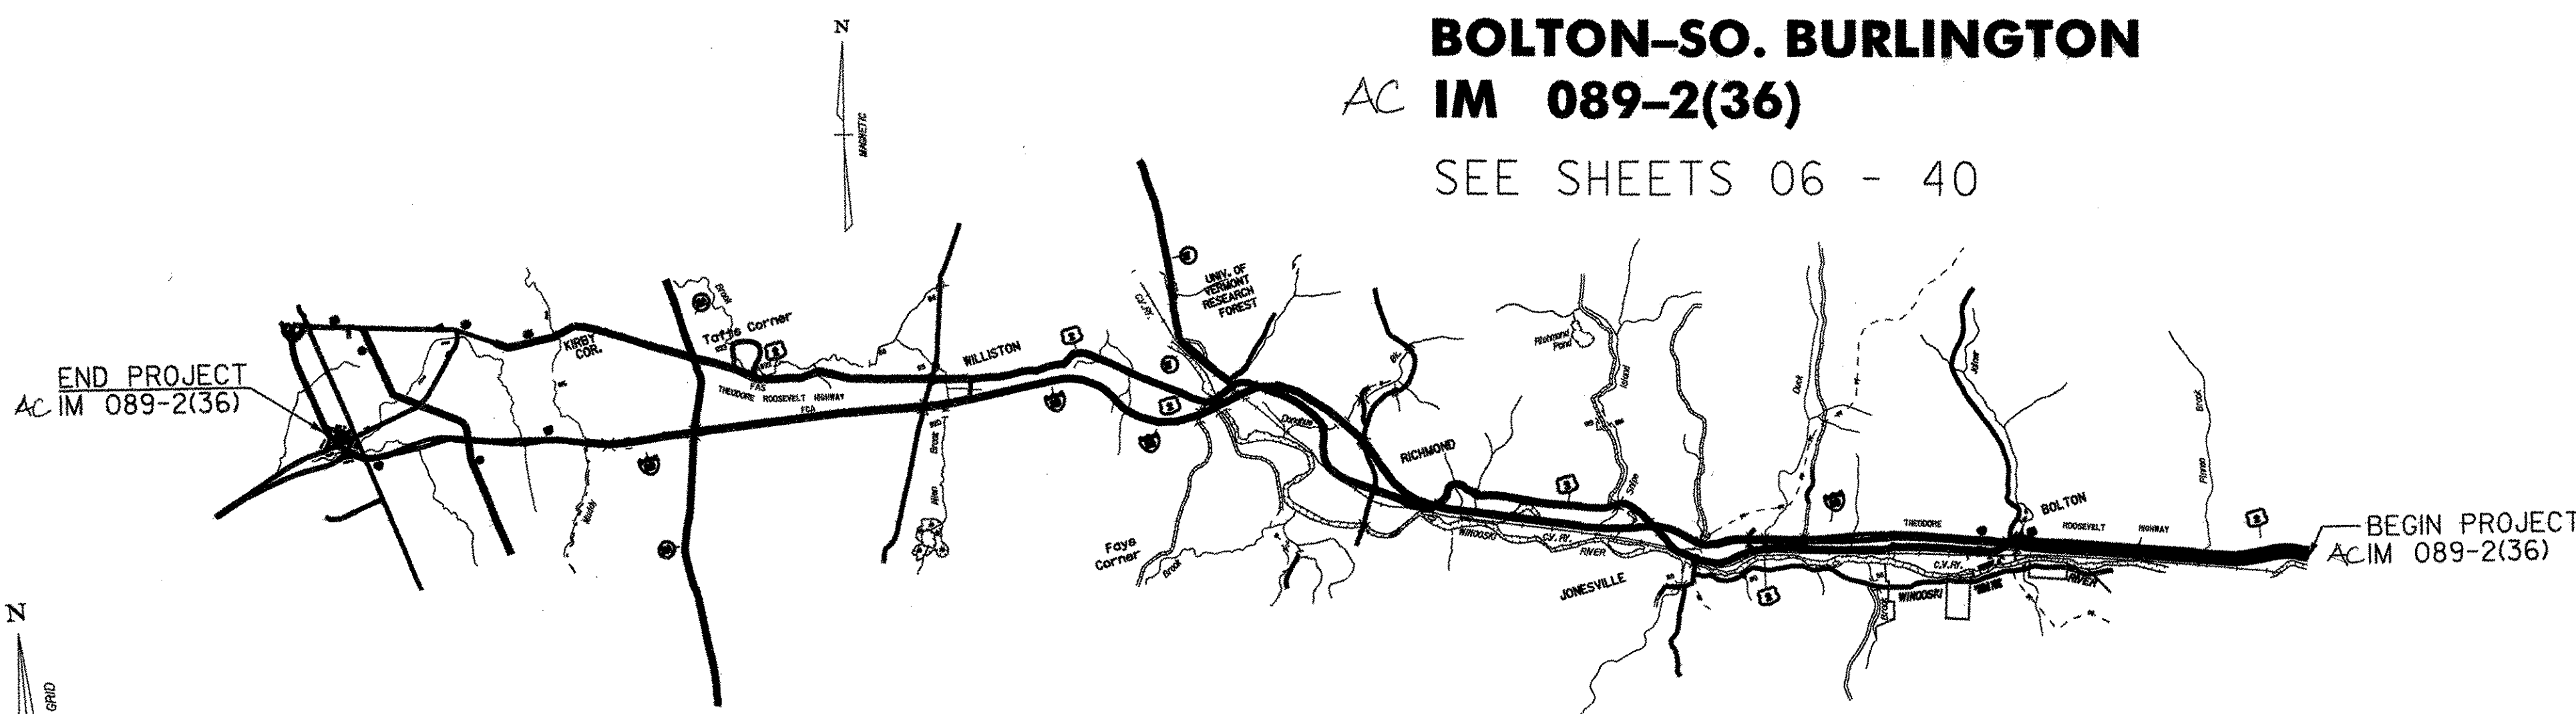

**WILLISTON  
IM 089-2(35)**

SEE SHEETS 41 - 72

THESE PLANS ARE SUBJECT TO SUCH ENGINEERING CHANGES AS MAY BE REQUIRED BY THE FEDERAL HIGHWAY ADMINISTRATION OR THE DIRECTOR OF PROGRAM DEVELOPMENT.  
CONSTRUCTION IS TO BE CARRIED ON IN ACCORDANCE WITH THESE PLANS AND THE STANDARD SPECIFICATIONS FOR CONSTRUCTION DATED 2001, AS APPROVED BY THE FEDERAL HIGHWAY ADMINISTRATION ON JANUARY 4, 2001 FOR USE ON THIS PROJECT, INCLUDING ALL SUBSEQUENT REVISIONS AND SUCH REVISED SPECIFICATIONS AND SPECIAL PROVISIONS AS ARE INCORPORATED IN THESE PLANS.

/pave/04all4/04all4.dgn IPARM NAME: p04all4cts.1

DEPARTMENT OF TRANSPORTATION FEDERAL HIGHWAY ADMINISTRATOR	
APPROVED <i>[Signature]</i>	DATE 5/23/05
DIRECTOR OF PROGRAM DEVELOPMENT	
APPROVED <i>[Signature]</i>	DATE 5/4/05
PROJECT MANAGER :	
PROJECT NAME : BOLTON-SO. BURLINGTON WILLISTON	
PROJECT NUMBER : AC IM 089-2(36) IM 089-2(35)	
SHEET 1 OF 76 SHEETS	