

U-TURN SIGNAGE DETAIL

REFER TO SHEETS 15-23 FOR LOCATIONS AND QUANTITIES OF GUARDRAIL ITEMS.


646.414 DURABLE 6" WHITE LINE (MOD.)
 3780+68 TO 4065+23 SOLID LT
 3780+68 TO 4065+23 DASHED CL

646.614 TEMPORARY 6" WHITE LINE
 3780+68 TO 4065+23 SOLID LT
 3780+68 TO 4065+23 DASHED CL

646.415 DURABLE 6" YELLOW LINE (MOD.)
 3780+68 TO 4065+23 SOLID RT

646.615 TEMPORARY 6" YELLOW LINE
 3780+68 TO 4065+23 SOLID RT

**STA 4065+23
 (MM 76.993)**

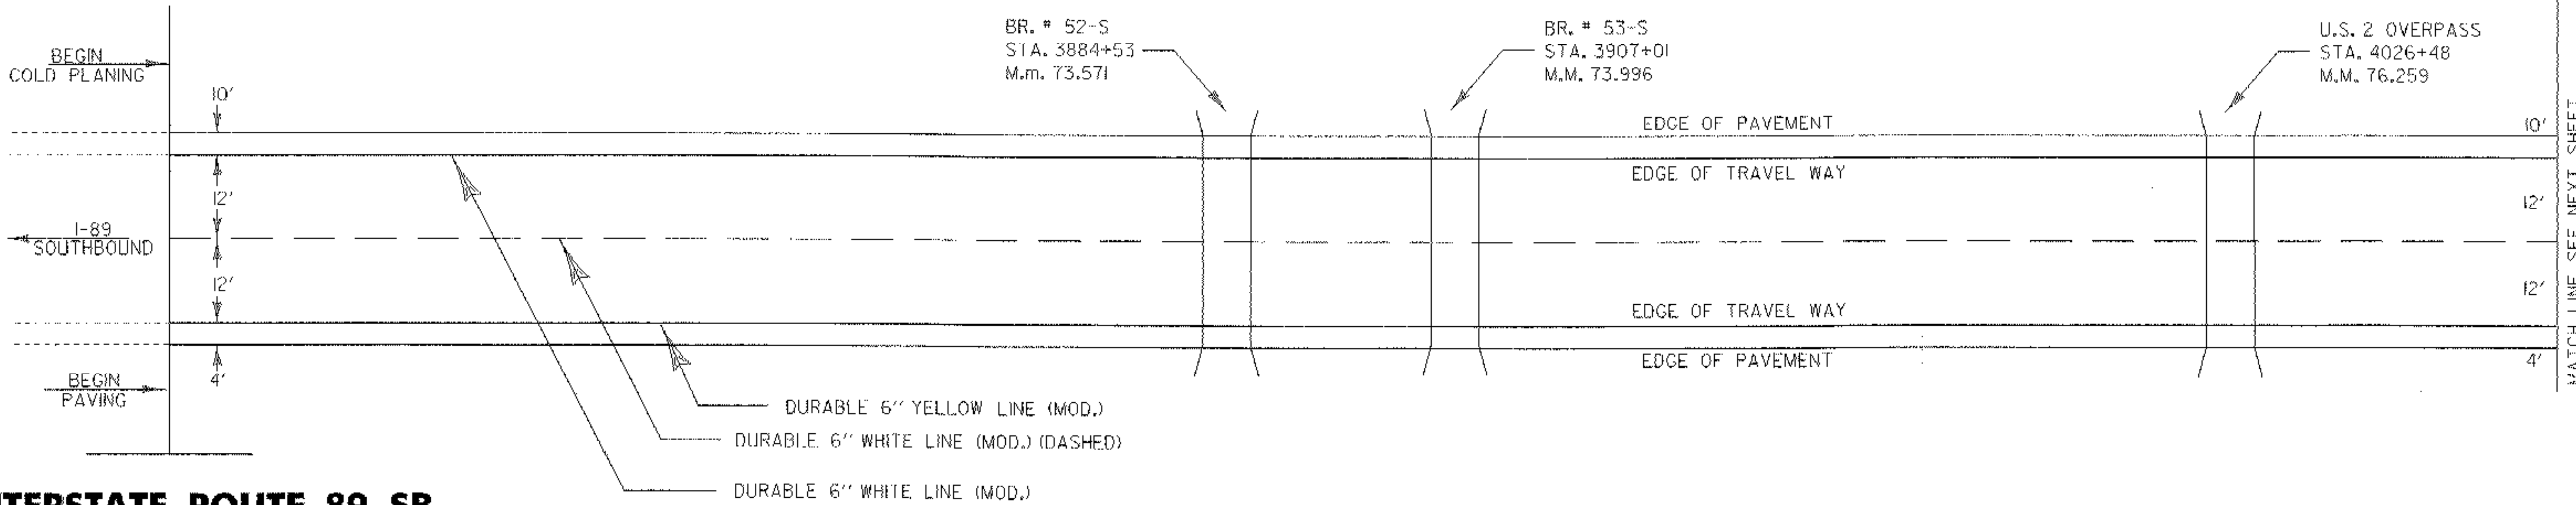

**INTERSTATE ROUTE 89 SB
 STA 3780+68
 (MM 71.604)
 BEGIN PROJECT
 IM 089-2(36)**

NOT TO SCALE

PAVING PROJECT LAYOUT # 1	PROJECT NAME: BOLTON - SO. BURLINGTON
	PROJECT NUMBER: AC IM 089-2(36)
FILE NAME: /pave/04all4/p04all4.dgn	PLOT DATE: 17-MAY-2005
PROJECT LEADER:	DRAWN BY:
DESIGNED BY:	CHECKED BY:
IPARM NAME: p04i14i01i	SHEET 24 OF 76