

STA. 4410+65 83.535  
 STA. 4457+38 84.420  
~~STA. 4179+38 NEW U-TURN SHEET 25~~  
~~STA. 4293+12 SHEET 25~~  
 STA. 4595+66 87.039

REFER TO SHEETS 15-23 FOR LOCATIONS AND QUANTITIES OF GUARDRAIL ITEMS.


646.414 DURABLE 6" WHITE LINE (MOD.)  
 4349+82 TO 4634+36 SOLID LT  
 4349+82 TO 4634+36 DASHED CL

646.614 TEMPORARY 6" WHITE LINE  
 4349+82 TO 4634+36 SOLID LT  
 4349+82 TO 4634+36 DASHED CL

646.415 DURABLE 6" YELLOW LINE (MOD.)  
 2801+04 TO 3078+66 SOLID RT


646.615 TEMPORARY 6" YELLOW LINE  
 2801+04 TO 3078+66 SOLID RT

**END PROJECT  
 STA 4634+36  
 (MM 87.772)  
 IM 089-2(36)**

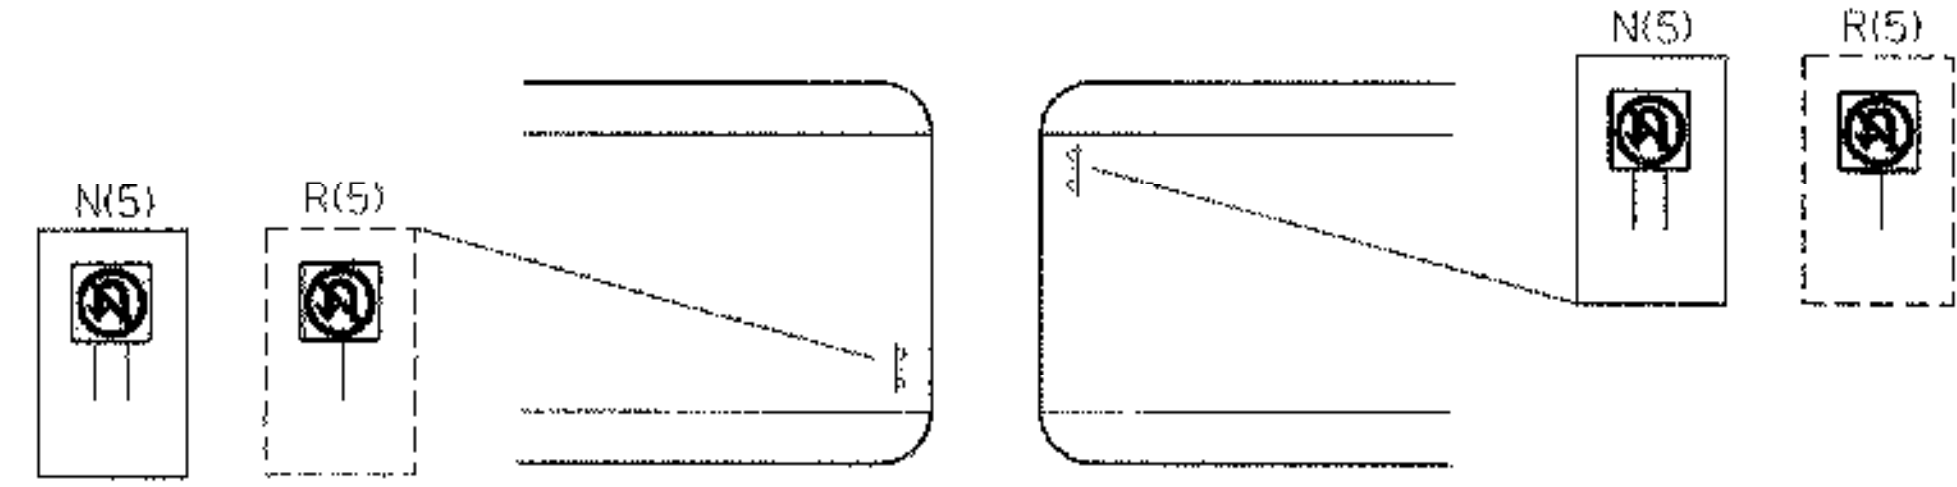

**U-TURN SIGNAGE DETAIL**

**STA 4349+82  
 (MM 82.383)**

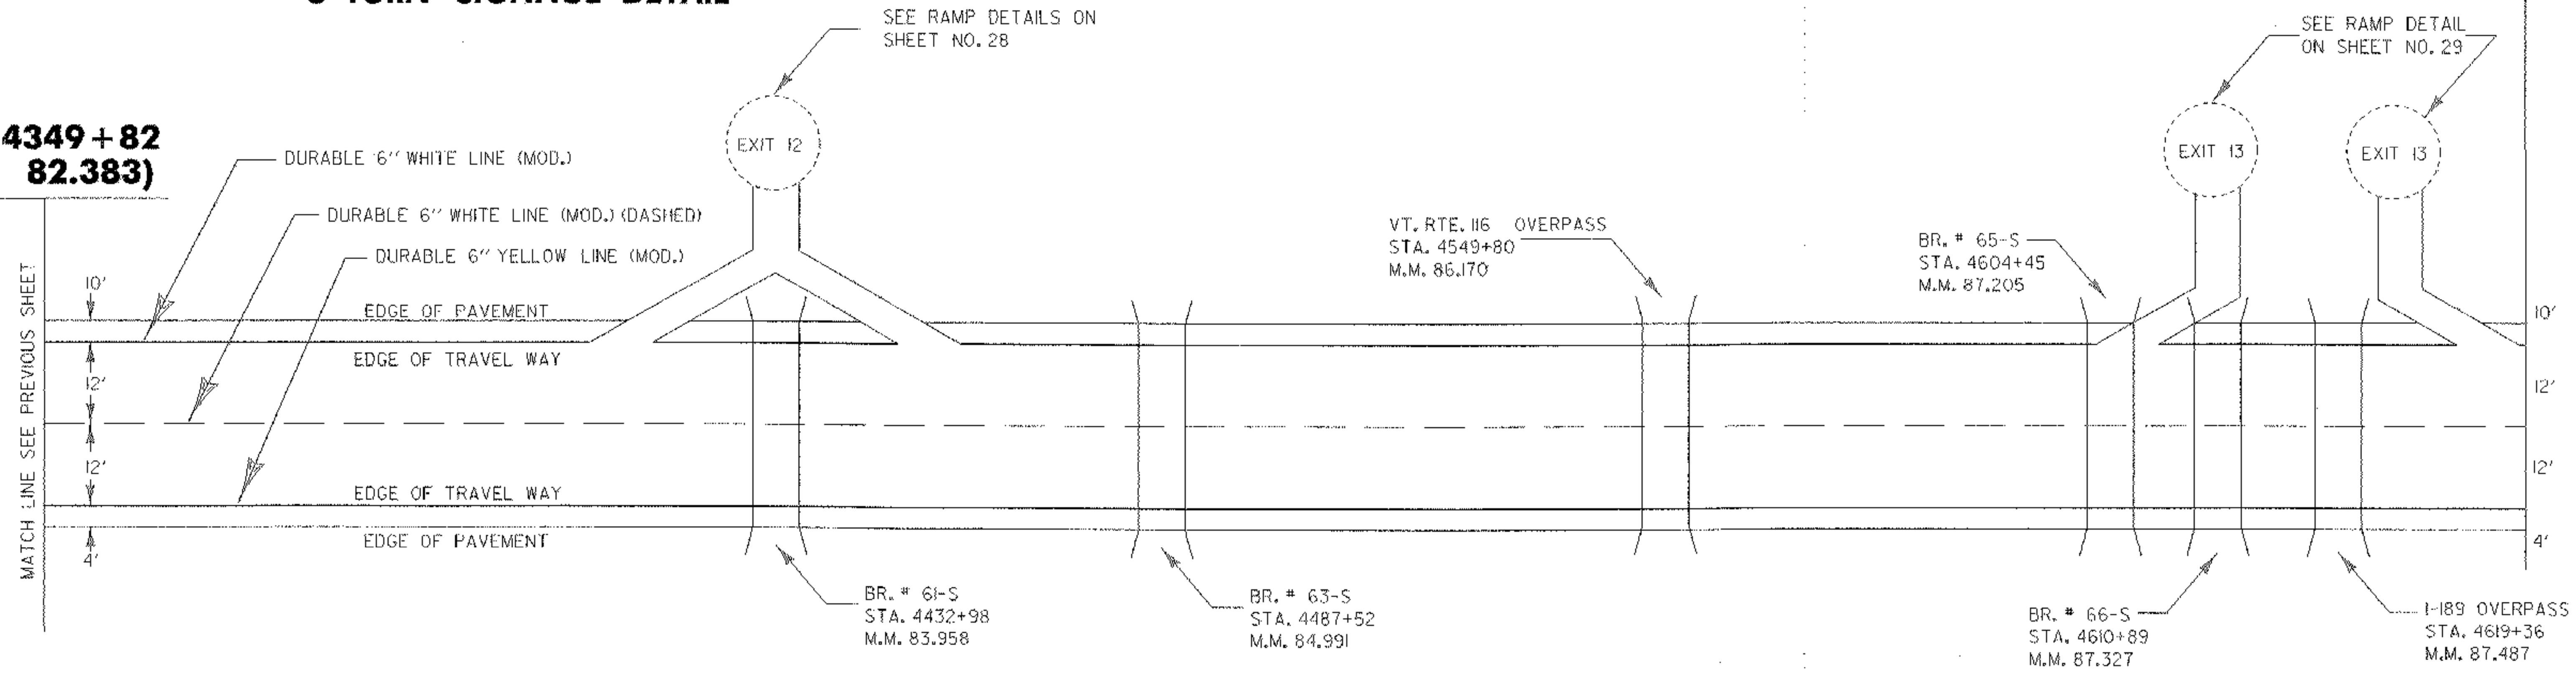

NOT TO SCALE

<b>PAVING        PROJECT        LAYOUT # 3</b>	PROJECT NAME: BOLTON - SO. BURLINGTON
	PROJECT NUMBER: AC IM 089-2(36)
	FILE NAME: /pave/p04all4/p04all4.dgn
	IPARM NAME: p04all4i03.i
	PLOT DATE: 17-MAY-2005
	DRAWN BY:
	CHECKED BY:
	SHEET 26 OF 76