
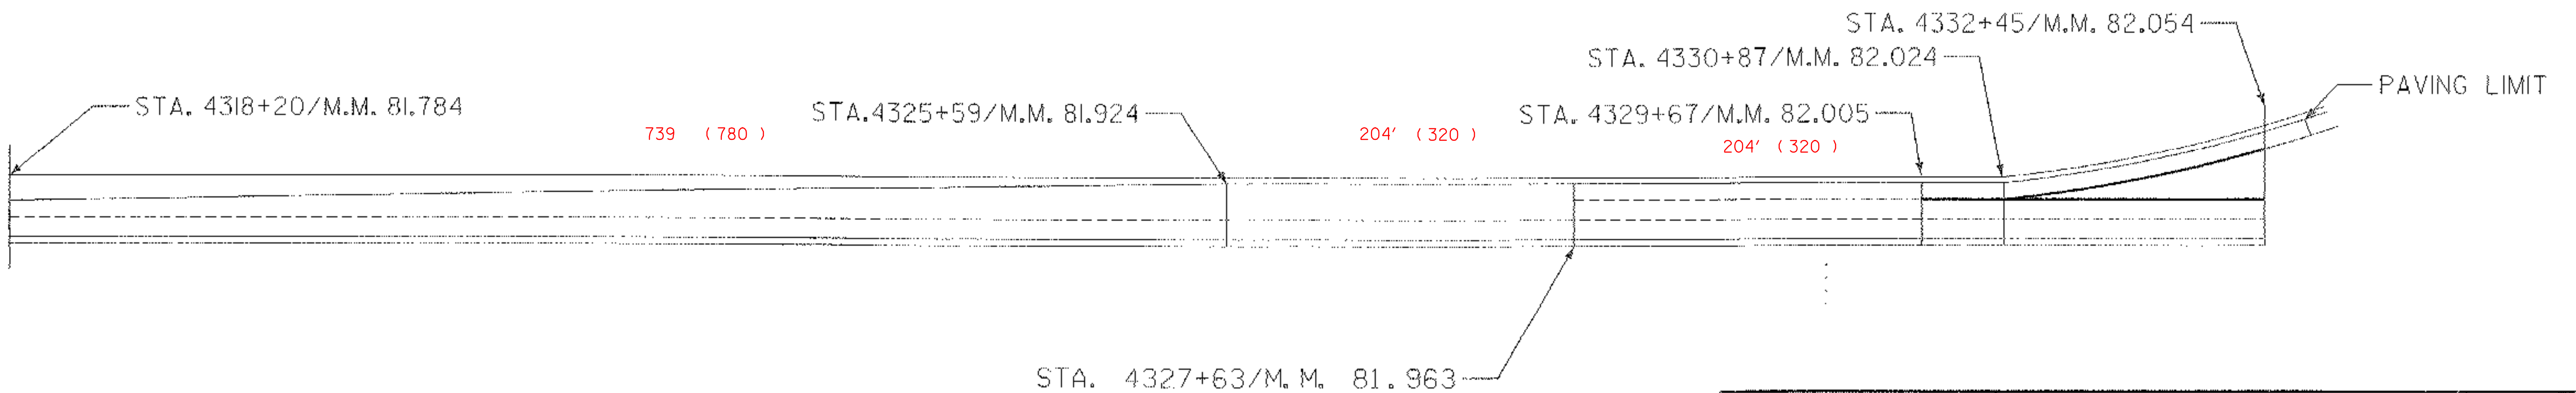


646.414 DURABLE 6" WHITE LINE (MOD.)
 OFF RAMP RT. EDGELINE - 761'
 OFF RAMP RT. DOTTED LINE - 92'
 OFF RAMP DASH LINE - 43'
 ON RAMP RT. EDGELINE - 1425'
 ON RAMP DASH LINE - 51'

646.44 DURABLE 12" WHITE LINE (MOD.)
 OFF RAMP - 410'
 ON RAMP - 436'

646.614 TEMPORARY 6" WHITE LINE
 OFF RAMP RT. EDGELINE - 761'
 OFF RAMP RT. DOTTED LINE - 92'
 OFF RAMP DASH LINE - 43'
 ON RAMP RT. EDGELINE - 1425'
 ON RAMP DASH LINE - 51'

646.64 TEMPORARY 12" WHITE LINE
 OFF RAMP - 410'
 ON RAMP - 436'

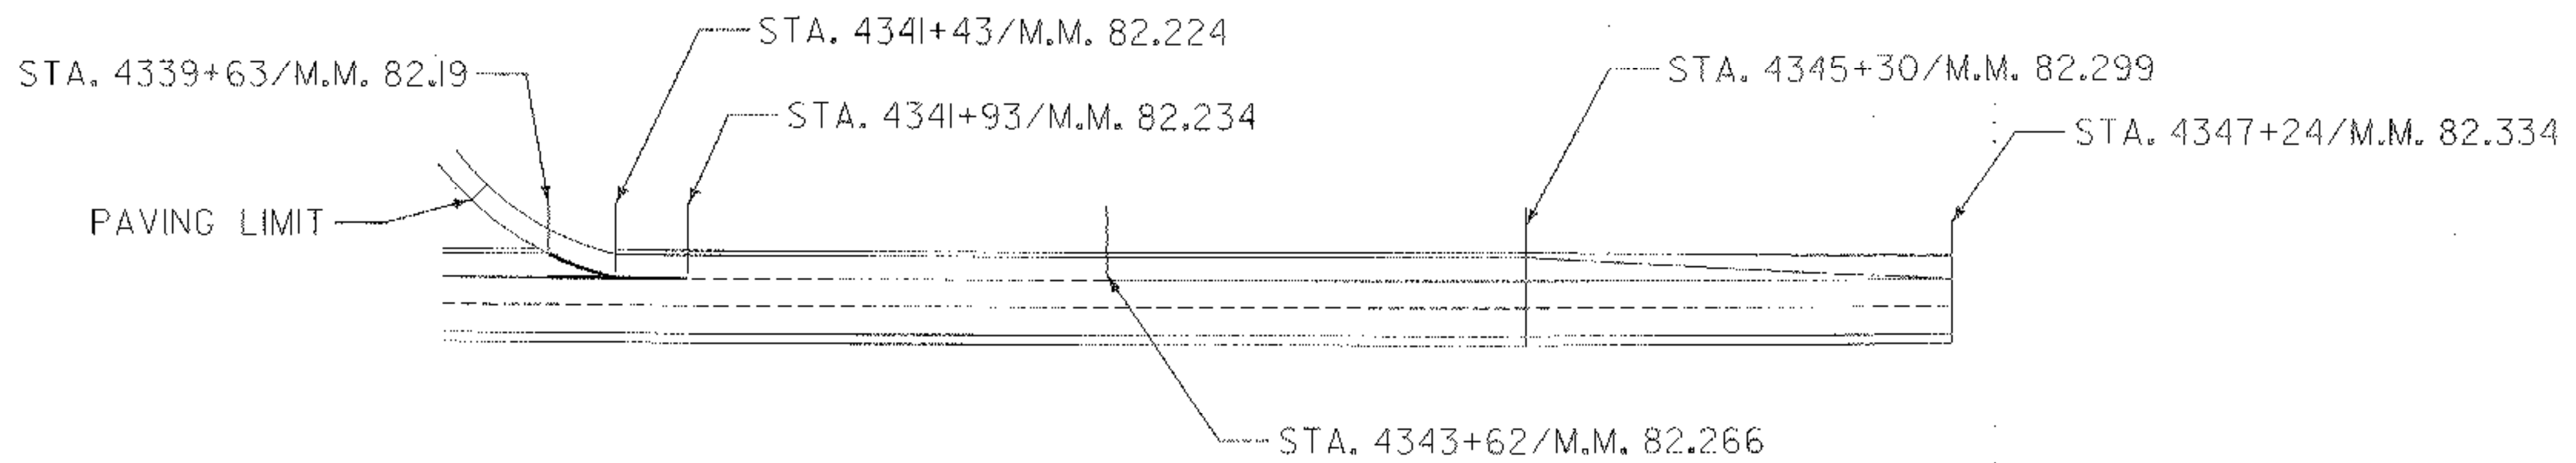

SOUTHBOUND REST AREA PAVEMENT MARKING DETAILS & PAVING LIMITS	PROJECT NAME: BOLTON - SO. BURLINGTON	FILE NAME: /pave/p04dl4/p04dl4.dgn	PLOT DATE: 17-MAY-2005
	PROJECT NUMBER: AC IM 089-2(36)	PROJECT LEADER:	DRAWN BY:
	DESIGNED BY:	CHECKED BY:	
	IPARM FILE NAME: p04dl4sbr.d		SHEET 30 OF 76