



INDEX OF SHEETS

- 1 COMPOSITE TITLE SHEET
- 2-5 COMPOSITE QUANTITY SHEETS
- 6 TITLE SHEET - BOLTON - SO. BURLINGTON
AC IM 089-2(36)
- 7-10 TYPICAL SHEETS
- 11-14 QUANTITY SHEETS
- 15-23 ITEM DETAIL SHEETS
- 24-26 PAVING PROJECT LAYOUT SHEETS
- 27 INT. # 11 RAMP DETAIL SHEETS
- 28 INT. # 12 RAMP DETAIL SHEETS
- 29 INT. # 13 RAMP DETAIL SHEETS
- 30 SOUTHBOUND REST AREA
- 31-32 MILLED RUMBLE STRIPS DETAIL SHEETS
- 33 TRAFFIC CONTROL PLAN @ EXIT 13 # 01
- 34 TRAFFIC CONTROL PLAN @ EXIT 13 # 02
- 35-36 DETAIL SHEETS
- 37-38 SIGN SUMMARY SHEETS
- 39-40 CONSTRUCTION APPROACH SIGNING SHEETS
- 41 EROSION CONTROL NARRATIVE
- 42 EROSION CONTROL PLAN
- 43 SILT FENCE DETAILS
- 44 INLET AND CHECK DAM DETAILS
- 45 CONSTRUCTION ENTRANCE DETAILS
- 46 TITLE SHEET - WILLISTON IM 089-2(35)
- 47 TYPICAL SECTION SHEET
- 48-49 QUANTITY SHEETS
- 50 SIGN SUMMARY SHEET
- 51 SIGN SUMMARY AND DETAIL SHEET
- 52 TIE SHEET
- 53 LAYOUT SHEET
- 54 SIGNS & PAVEMENT MARKING SHEET
- 55 TRAFFIC SIGNAL PLAN SHEET
- 56 SIGN ACTUATION NOTES AND DETAILS
- 57 EROSION CONTROL NARRATIVE
- 58 EROSION CONTROL EXISTING CONDITIONS
- 59 EROSION AND SEDIMENT CONTROL PLAN
- 60 EROSION CONTROL FINAL CONDITIONS
- 61 SILT FENCE DETAILS
- 62 CHECK DAM & CATCH BASIN PROTECTION DETAILS
- 63 EROSION MATTING DETAILS
- 64 CONSTRUCTION ENTRANCE DETAILS
- 65 CONCRETE PAD DETAILS
- 66 SIGN BRIDGE DETAILS
- 67 SIGN BRIDGE NOTES
- 68 TRAFFIC CONTROL SHEET
- 69-76 CROSS SECTION SHEETS

STATE OF VERMONT
AGENCY OF TRANSPORTATION

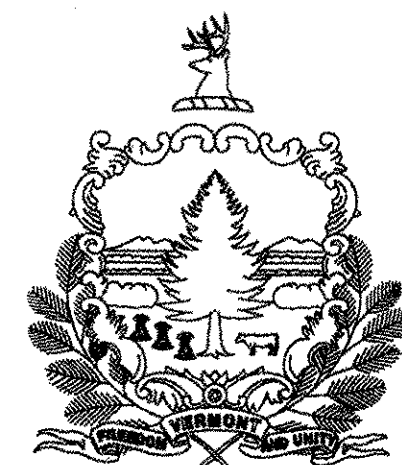



PROPOSED IMPROVEMENT
TOWNS OF
BOLTON, RICHMOND,
WILLISTON, & SO. BURLINGTON
COUNTY OF CHITTENDEN
INTERSTATE ROUTE 89 SB

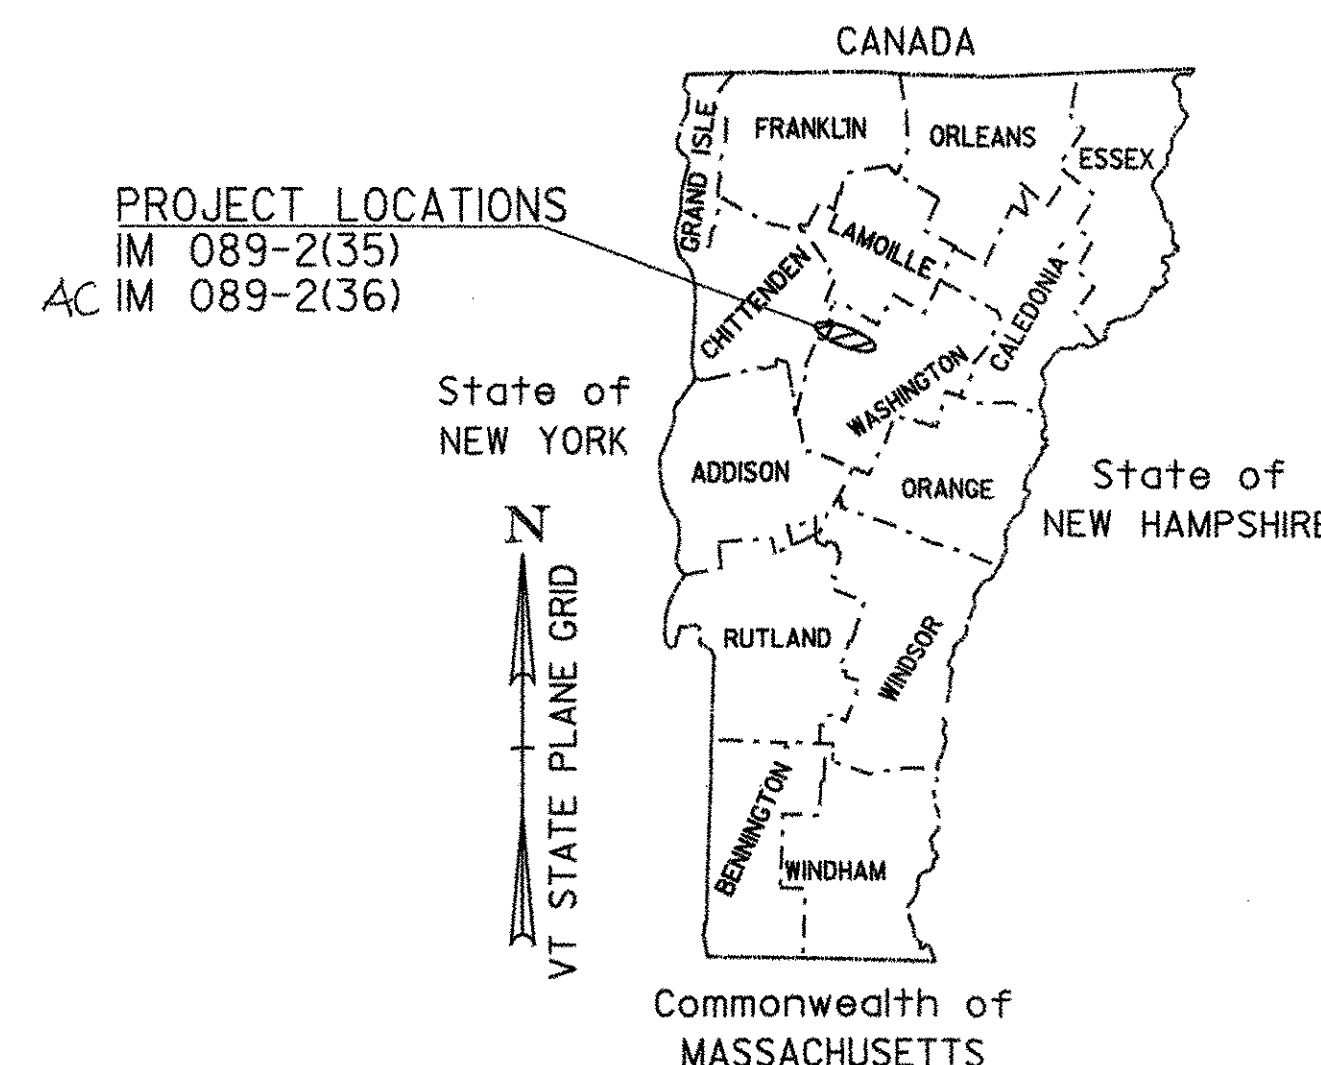

BOLTON-SO. BURLINGTON

AC IM 089-2(36)

SEE SHEETS 06 - 40

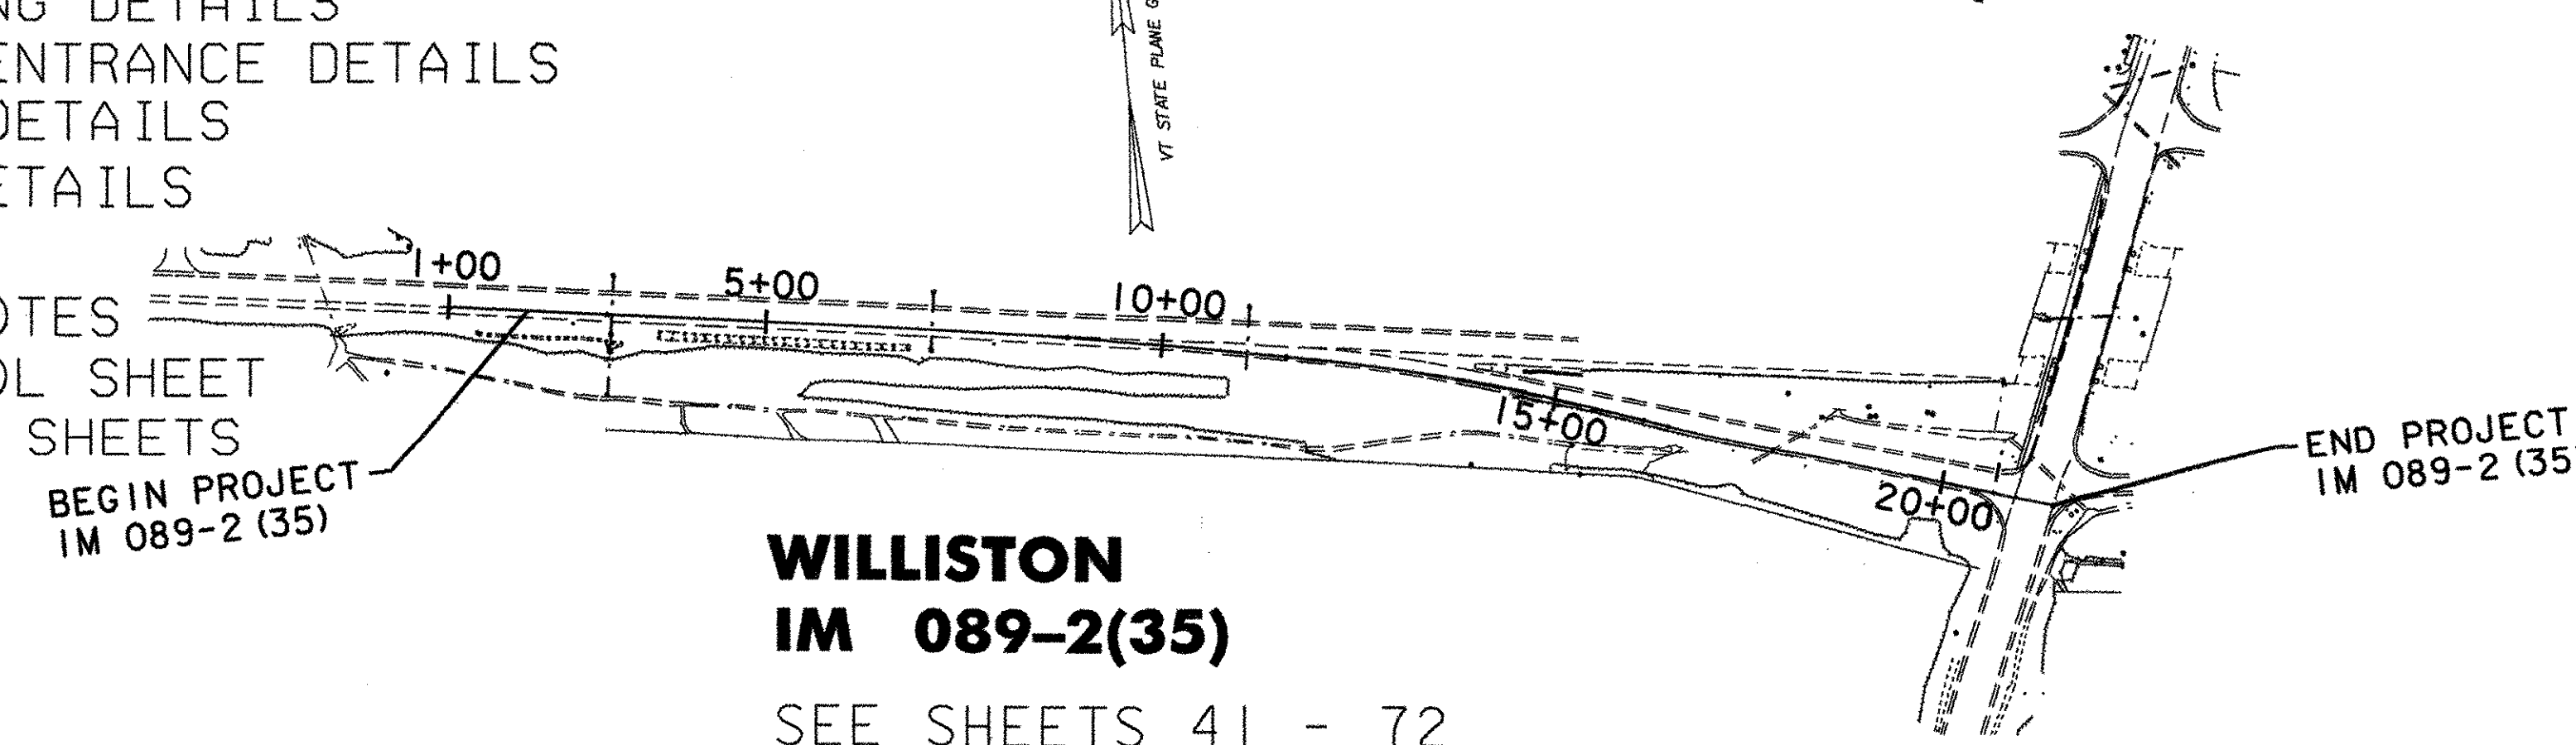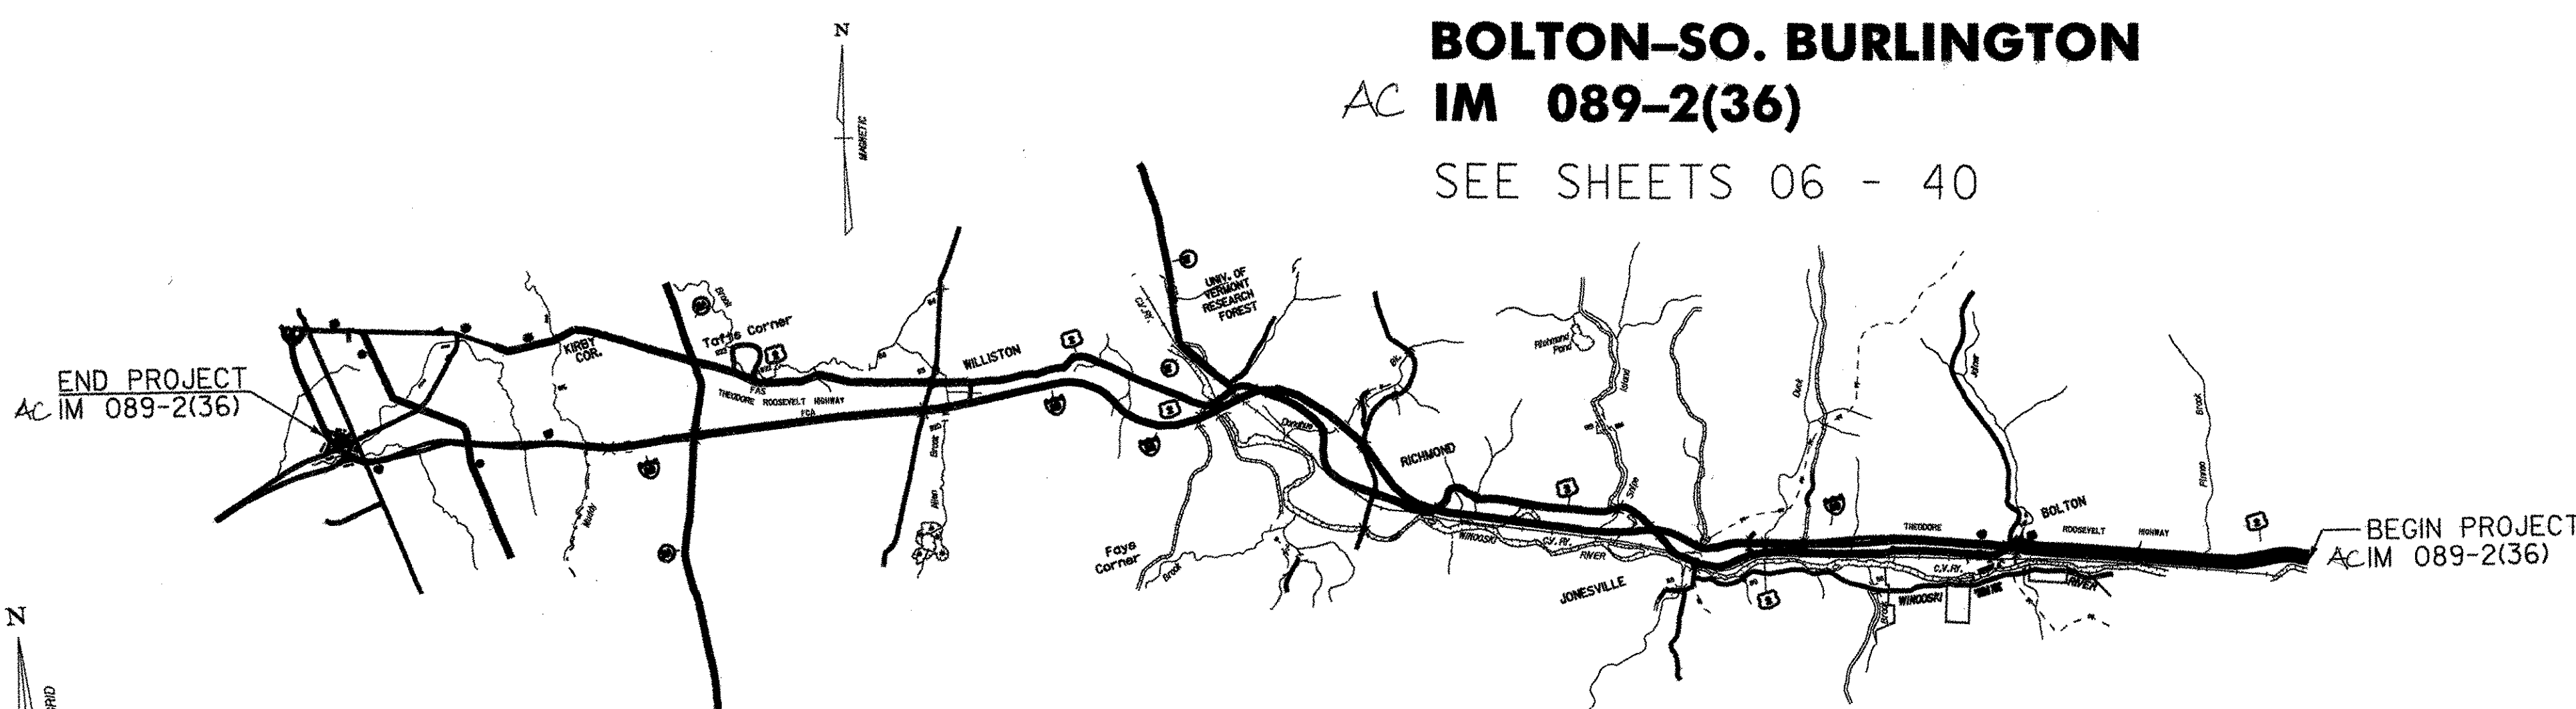

WILLISTON
IM 089-2(35)

SEE SHEETS 41 - 72

THESE PLANS ARE SUBJECT TO SUCH ENGINEERING CHANGES AS MAY BE REQUIRED BY THE FEDERAL HIGHWAY ADMINISTRATION OR THE DIRECTOR OF PROGRAM DEVELOPMENT.
CONSTRUCTION IS TO BE CARRIED ON IN ACCORDANCE WITH THESE PLANS AND THE STANDARD SPECIFICATIONS FOR CONSTRUCTION DATED 2001, AS APPROVED BY THE FEDERAL HIGHWAY ADMINISTRATION ON JANUARY 4, 2001 FOR USE ON THIS PROJECT, INCLUDING ALL SUBSEQUENT REVISIONS AND SUCH REVISED SPECIFICATIONS AND SPECIAL PROVISIONS AS ARE INCORPORATED IN THESE PLANS.

/pave/04all4/04all4.dgn IPARM NAME: p04all4cts.1

| | |
|---|--------------|
| DEPARTMENT OF TRANSPORTATION FEDERAL HIGHWAY ADMINISTRATOR | |
| APPROVED <i>[Signature]</i> | DATE 5/23/05 |
| DIRECTOR OF PROGRAM DEVELOPMENT | |
| APPROVED <i>[Signature]</i> | DATE 5/4/05 |
| PROJECT MANAGER : | |
| PROJECT NAME : BOLTON-SO. BURLINGTON WILLISTON | |
| PROJECT NUMBER : AC IM 089-2(36) IM 089-2(35) | |
| SHEET 1 OF 76 SHEETS | |

COMPOSITE QUANTITY SHEET 1

| WILLISTON IM 089-2(35) | | BOLTON-SO. BURLINGTON AC IM 089-2(36) | | SUMMARY OF ESTIMATED QUANTITIES | | | | | DETAILED SUMMARY OF QUANTITIES | | | DETAILED SUMMARY OF QUANTITIES | | |
|---------------------------|---------|--|---------|---------------------------------|------|--|----------------|-----|--------------------------------|------|-------|--------------------------------|------|-------|
| | ROADWAY | BRIDGE | ROADWAY | QUANTITIES GRAND TOTAL | UNIT | ITEMS | ITEM NUMBER | RND | QUANTITIES | UNIT | ITEMS | QUANTITIES | UNIT | ITEMS |
| | 1 | | | 1 | LS | CLEARING AND GRUBBING (INCL. INDV. TREES & STUMPS) | 201.10 | | | | | | | |
| | 1,800 | | 1,200 | 3,000 | CY | COMMON EXCAVATION | 203.15 | | | | | | | |
| | | | 1 | 1 | CY | SOLID ROCK EXCAVATION | 203.16 | | | | | | | |
| | 1,000 | | 1,800 | 2,800 | CY | EARTH BORROW | 203.30 | | | | | | | |
| | 400 | | 39 | 439 | CY | SAND BORROW | 203.31 | | | | | | | |
| | 4,500 | | 250 | 4,750 | SY | FINE GRADING - SUBGRADE | 203.40 | | | | | | | |
| | | | 43,000 | 43,000 | LF | SHOULDER BERM REMOVAL | 203.99 | | | | | | | |
| | | | 1 | 1 | CY | TRENCH EXCAVATION OF EARTH (N.A.B.I.) | 204.20 | | | | | | | |
| | 3,100 | | 385,000 | 388,100 | SY | COLD PLANING - BIT. PAVEMENT | 210.10 | | | | | | | |
| | | | 144,000 | 144,000 | LF | MILLED RUMBLE STRIPS | 213.10 | | | | | | | |
| | 1,200 | | 250 | 1,450 | CY | SUBBASE OF DENSE GRADED CRUSHED STONE | 301.35 | | | | | | | |
| | 250 | | 3,600 | 3,850 | TON | AGGREGATE SHOULDERS (MOD.) | 402.12 | | | | | | | |
| | 1 | | 480 | 481 | CWT | EMULSIFIED ASPHALT | 404.65 | | | | | | | |
| | | | 1 | 1 | LU | PRICE ADJUSTMENT ASPHALT CEMENT (N.A.B.I.) | 406.50 | | | | | | | |
| | 1,300 | | 39,000 | 40,300 | TON | SUPERPAVE BITUMINOUS CONCRETE PAVEMENT (PG 64-28) | 490.30 | | | | | | | |
| | | | 1,550 | 1,550 | LF | BRIDGE EXPANSION JOINT (ASPHALTIC PLUG) | 516.10 | | | | | | | |
| | | | 100 | 100 | CF | RAPID SETTING CONC. REPAIR MATERIAL W/COARSE AGGREGATE | 580.20 | | | | | | | |
| | | | 60 | 60 | LF | 18" CPEP | 601.0915 | | | | | | | |
| | | | 2 | 2 | EA | 18" CPEPES | 601.7015 | | | | | | | |
| | | | 20 | 20 | EA | REHABING DI,CB OR MH CLASS I | 604.412 | | | | | | | |
| | | | 1 | 1 | EA | CAPPING EXISTING DROP INLETS | 604.60 | | | | | | | |
| | | | 500 | 500 | HR | POWER GRADER RENTAL | 608.15 | | | | | | | |
| | | | 500 | 500 | HR | ALL PURPOSE EXCAVATOR RENTAL, TYPE I | 608.25 | | | | | | | |
| | | | 300 | 300 | HR | POWER BROOM RENTAL | 608.30 | | | | | | | |
| | | | 300 | 300 | HR | POWER BROOM RENTAL, TYPE II | 608.31 | | | | | | | |
| | | | 500 | 500 | HR | TRUCK RENTAL | 608.37 | | | | | | | |

PROJECT : BOLTON - SO. BURLINGTON, WILLISTON
PROJECT NO. : AC IM 089-2(36) IM 089-2(35)

DESIGN FILE NAME: /pave/04all4/p04all4.dgn
IPARM FILE NAME: p04all4cgs1.i
SURVEYED BY: _____
SQUAD LEADER: _____
PLOT DATE: 17-MAY-2005
SURVEY DATE: _____
DRAWN BY: _____
SHEET: 2 OF 76

COMPOSITE QUANTITY SHEET 2

| WILLISTON IM 089-2(35) | | BOLTON-SO. BURLINGTON AC IM 089-2(36) | | | SUMMARY OF ESTIMATED QUANTITIES | | | | | DETAILED SUMMARY OF QUANTITIES | | | DETAILED SUMMARY OF QUANTITIES | | |
|---------------------------|---------|--|--------|---------|---------------------------------|------|---|-------------|-----|--------------------------------|------|-------|--------------------------------|------|-------|
| EROSION CONTROL | ROADWAY | EMPLOYEE TRAINEESHIP | BRIDGE | ROADWAY | QUANTITIES GRAND TOTAL | UNIT | ITEMS | ITEM NUMBER | RND | QUANTITIES | UNIT | ITEMS | QUANTITIES | UNIT | ITEMS |
| | | | | 500 | 500 | HR | LOADER RENTAL, TYPE I | 608.40 | | | | | | | |
| | | | | 149 | 149 | HR | LOADER RENTAL, TYPE II (MOD.-REHAB CABLE RAIL) | 608.41 | | | | | | | |
| 25 | | | | 5 | 30 | CY | STONE FILL, TYPE I | 613.10 | | | | | | | |
| 50 | | | | | 50 | CY | STONE FILL, TYPE II | 613.11 | | | | | | | |
| | | | | 400 | 400 | LF | TREATED TIMBER CURB | 616.35 | | | | | | | |
| | | | | 620 | 620 | LF | REMOVAL OF EXISTING CURB | 616.41 | | | | | | | |
| | | | | 100 | 100 | TON | BITUMINOUS CONCRETE GUTTERS AND TRAFFIC ISLANDS | 616.47 | | | | | | | |
| 2,400 | | | | 700 | 3,100 | LF | SNOW FENCE (MOD. - PDF) | 620.70 | | | | | | | |
| | 450 | | | 9250 | 9,700 | LF | STEEL BEAM GUARDRAIL (GALVANIZED) | 621.20 | | | | | | | |
| | 2 | | | 47 | 49 | EA | MANUFACTURED TERMINAL SECTION (FLARED) | 621.505 | | | | | | | |
| | 1 | | | 16 | 17 | EA | TRAILING END TERMINAL | 621.52 | | | | | | | |
| | 1 | | | | 1 | EA | ENERGY ABSORPTION ATTENUATOR (SAND FILLED PLASTIC BARREL) | 621.56 | | | | | | | |
| | | | | 548 | 548 | EA | ANCHOR FOR CABLE RAIL (MOD.-CABLE RAIL HARDWARE) | 621.65 | | | | | | | |
| | | | | 1250 | 1250 | EA | REPLACE GUARD RAIL POST ASSEMBLY | 621.76 | | | | | | | |
| | | | | 550 | 550 | EA | REPLACE GUARD RAIL BEAM UNIT | 621.77 | | | | | | | |
| | | | | 7200 | 7200 | LF | ADJUST HEIGHT OF GUARD RAIL | 621.79 | | | | | | | |
| | 54 | | | 3600 | 3654 | LF | REMOVAL AND DISPOSAL OF GUARD RAIL | 621.80 | | | | | | | |
| | 700 | | | | 700 | LF | TEMPORARY TRAFFIC BARRIER | 621.90 | | | | | | | |
| | | | | 2000 | 2000 | HR | UNIFORMED TRAFFIC OFFICERS | 630.10 | | | | | | | |
| | | | | 3,000 | 3,000 | HR | FLAGGERS | 630.15 | | | | | | | |
| | | | | 1 | 1 | LS | FIELD OFFICE - ENGINEERS | 631.10 | | | | | | | |
| | | | | 1 | 1 | LS | TESTING EQUIPMENT - BITUMINOUS | 631.17 | | | | | | | |
| | | | | 1 | 1 | LU | FIELD OFFICE - TELEPHONE (N.A.B.I.) | 631.25 | | | | | | | |
| | | 520 | | | 520 | HR | EMPLOYEE TRAINEESHIP | 634.10 | | | | | | | |
| | | | | 1 | 1 | LS | MOBILIZATION/DEMobilIZATION | 635.11 | | | | | | | |
| | | | | 1 | 1 | LS | TRAFFIC CONTROL | 641.10 | | | | | | | |
| | | | | 1 | 1 | LS | PUBLIC RELATIONS OFFICER | 641.12 | | | | | | | |

REVISED 06-10-05 LSW
 PROJECT : BOLTON - SO. BURLINGTON WILLISTON
 PROJECT NO.: AC IM 089-2(36) IM 089-2(35)
 DESIGN FILE NAME: /pave/04all4/p04all4.dgn PLOT DATE: 13-JUN-2005
 IPARM FILE NAME: p04all4cqs2.i SURVEY DATE: _____
 SURVEYED BY: _____ DRAWN BY: _____
 SQUAD LEADER: _____ SHEET: 3 OF 76

COMPOSITE QUANTITY SHEET 3

| WILLISTON IM 089-2(35) | | BOLTON-SO. BURLINGTON AC IM 089-2(36) | | | SUMMARY OF ESTIMATED QUANTITIES | | | | | DETAILED SUMMARY OF QUANTITIES | | | DETAILED SUMMARY OF QUANTITIES | | |
|---------------------------|---------|--|--------|---------|---------------------------------|------|--|-------------|-----|--------------------------------|------|-------|--------------------------------|------|-------|
| EROSION CONTROL | ROADWAY | EROSION CONTROL | BRIDGE | ROADWAY | QUANTITIES GRAND TOTAL | UNIT | ITEMS | ITEM NUMBER | RND | QUANTITIES | UNIT | ITEMS | QUANTITIES | UNIT | ITEMS |
| | | | | 6 | 6 | EA | PORTABLE CHANGEABLE MESSAGE SIGNS | 641.5 | | | | | | | |
| | | | | 4 | 4 | EA | PORTABLE ARROW BOARDS | 641.6 | | | | | | | |
| | 3,000 | | | 119,000 | 122,000 | LF | DURABLE 6" WHITE LINE (MOD.-RETROREFLECTIVITY/INLAID) | 646.414 | | | | | | | |
| | 640 | | | 93,100 | 93,740 | LF | DURABLE 6" YELLOW LINE (MOD.-RETROREFLECTIVITY/INLAID) | 646.415 | | | | | | | |
| | 1,300 | | | 1,800 | 3,100 | LF | DURABLE 12" WHITE LINE (MOD.-RETROREFLECTIVITY/INLAID) | 646.44 | | | | | | | |
| | 80 | | | 110 | 190 | LF | DURABLE 24" STOP BAR | 646.46 | | | | | | | |
| | 40 | | | 68 | 108 | EA | DURABLE LETTER OR SYMBOL | 646.50 | | | | | | | |
| | 120 | | | | | | | | | | | | | | |
| | 3,000 | | | 119,000 | 122,000 | LF | TEMPORARY 6" WHITE LINE (PAINT) | 646.614 | | | | | | | |
| | 130 | | | 2,400 | 2,530 | LF | TEMPORARY 6" WHITE LINE (TAPE, TYPE II) | 646.614 | | | | | | | |
| | 640 | | | 93,100 | 93,740 | LF | TEMPORARY 6" YELLOW LINE (PAINT) | 646.615 | | | | | | | |
| | | | | 2,200 | 2,200 | LF | TEMPORARY 6" YELLOW LINE (TAPE, TYPE II) | 646.615 | | | | | | | |
| | 1,300 | | | 1,800 | 3,100 | LF | TEMPORARY 12" WHITE LINE (PAINT) | 646.64 | | | | | | | |
| | 730 | | | 70 | 800 | LF | TEMPORARY 12" WHITE LINE (TAPE, TYPE II) | 646.64 | | | | | | | |
| | 50 | | | 108 | 158 | LF | TEMPORARY 24" STOP BAR (PAINT) | 646.66 | | | | | | | |
| | 40 | | | 68 | 108 | EA | TEMPORARY LETTERS OR SYMBOLS (PAINT) | 646.70 | | | | | | | |
| | | | | 7000 | 7000 | EA | LINE STRIPING TARGETS | 646.76 | | | | | | | |
| | 380 | | | 731 | 1,111 | SF | REMOVAL OF EXISTING PAVEMENT MARKINGS | 646.85 | | | | | | | |
| | | | | 500 | 500 | SF | BLACK PAVEMENT MARKING MASKING TAPE | 646.86 | | | | | | | |
| | 45 | | | | 45 | SY | GEOTEXTILE UNDER STONE FILL | 649.31 | | | | | | | |
| | 500 | | | 250 | 750 | SY | GEOTEXTILE FOR SILT FENCE | 649.51 | | | | | | | |
| | 50 | | | 30 | 80 | LB | SEED | 651.5 | | | | | | | |
| | | | | 100 | 100 | LB | SEED (MOD.) | 651.5 | | | | | | | |
| | 400 | | | 250 | 650 | LB | FERTILIZER | 651.8 | | | | | | | |
| | 2 | | | 1 | 3 | TON | AGRICULTURAL LIMESTONE | 651.20 | | | | | | | |
| | 2 | | | 1 | 3 | TON | HAY MULCH | 651.25 | | | | | | | |
| | 10 | | | 75 | 85 | CY | TOPSOIL | 651.35 | | | | | | | |
| | 0.5 | | 0.5 | | 1 | LS | EROSION PREVENTION & SEDIMENT CONTROL PLAN | 652.10 | | | | | | | |
| | 20 | | 20 | | 40 | HR | MONITORING EROSION PREVENTION & SEDIMENT CONTROL PLAN | 652.20 | | | | | | | |

PROJECT : BOLTON - SO. BURLINGTON
WILLISTON

PROJECT NO. :
AC IM 089-2(36)
IM 089-2(35)

DESIGN FILE NAME: /pave/04all4/p04all4.dgn
IPARM FILE NAME: p04all4cqs3.1

PLOT DATE: 17-MAY-2005
SURVEYED BY: _____
DRAWN BY: _____
SQUAD LEADER: _____

SHEET: 4 OF 76

COMPOSITE QUANTITY SHEET 4

| WILLISTON IM 089-2(35) | | BOLTON-SO, BURLINGTON AC IM 089-2(36) | | | SUMMARY OF ESTIMATED QUANTITIES | | | | | DETAILED SUMMARY OF QUANTITIES | | | DETAILED SUMMARY OF QUANTITIES | | |
|---------------------------|---------|--|--------|---------|---------------------------------|------|--|-------------|-----|--------------------------------|------|-------|--------------------------------|------|-------|
| EROSION CONTROL | ROADWAY | EROSION CONTROL | BRIDGE | ROADWAY | QUANTITIES GRAND TOTAL | UNIT | ITEMS | ITEM NUMBER | RND | QUANTITIES | UNIT | ITEMS | QUANTITIES | UNIT | ITEMS |
| 0.5 | | 0.5 | | | 1 | LU | MAINTENANCE OF EROSION PREVENTION & SEDIMENT CONTROL PLAN (N.A.B.I.) | 652.30 | | | | | | | |
| 1300 | | | | | 1300 | SY | EROSION MATTING | 654.10 | | | | | | | |
| | 176 | | | 400 | 576 | SF | TRAFFIC SIGNS, TYPE A | 675.20 | | | | | | | |
| | | | | | | | BEGIN OPTION ITEMS | | | | | | | | |
| | 100 | | | 850 | 950 | LF | FLANGED CHANNEL SIGN POSTS | 675.301 | | | | | | | |
| | 100 | | | 850 | 950 | LF | SQUARE TUBE STEEL POSTS AND ANCHORS | 675.341 | | | | | | | |
| | | | | | | | END OPTION ITEMS | | | | | | | | |
| | | | | 21 | 21 | LB | TUBULAR ALUMINUM SIGN POSTS | 675.32 | | | | | | | |
| | 200 | | | 403 | 603 | LB | TUBULAR STEEL SIGN POSTS | 675.33 | | | | | | | |
| | 2 | | | | 2 | EA | FOUNDATIONS FOR W-SHAPE STEEL POSTS, 24" DIAMETER | 675.41 | | | | | | | |
| | 2 | | | 4 | 6 | EA | FOUNDATIONS FOR TUBULAR STEEL POSTS | 675.43 | | | | | | | |
| | 1 | | | | 1 | EA | FOUNDATIONS FOR TUBULAR STEEL POSTS (MOD.-CONCRETE PAD) | 675.43 | | | | | | | |
| | 30 | | | 48 | 78 | EA | REMOVING SIGNS | 675.50 | | | | | | | |
| | 6 | | | | 6 | EA | ERECTING SALVAGED SIGNS | 675.60 | | | | | | | |
| | 7 | | | | 7 | EA | SETTING SALVAGED POSTS | 675.61 | | | | | | | |
| | 10 | | | 1,000 | 1,010 | EA | DELINEATORS W/STEEL POSTS | 676.10 | | | | | | | |
| | | | | 760 | 760 | EA | REMOVAL OF EXISTING DELINEATORS | 676.12 | | | | | | | |
| | 1 | | | | 1 | EA | OVERHEAD TRAFFIC SIGN SUPPORT, TUBULAR BEAM | 677.11 | | | | | | | |
| | 1 | | | | 1 | EA | TRAFFIC CONTROL SIGNAL SYSTEM - INTERSECTION (MOD.) | 678.15 | | | | | | | |
| | 1 | | | | 1 | EA | FLASHING BEACON-GROUND MOUNTED (MOD.-ACTUATED SIGN) | 678.16 | | | | | | | |
| | 100 | | | | 100 | LF | VEHICLE LOOP DETECTOR | 678.22 | | | | | | | |
| | 4500 | | | | 4500 | LF | WIRED CONDUIT (2" PVC) | 678.23 | | | | | | | |
| | 11 | | | | 11 | EA | PULL BOX - STANDARD | 678.25 | | | | | | | |
| | 1 | | | | 1 | EA | JUNCTION BOX | 678.26 | | | | | | | |
| | 60 | | | | 60 | LF | ELECTRICAL CONDUIT SLEEVE (6" DIA.) | 678.30 | | | | | | | |
| | | | | 1 | 1 | LU | PRICE ADJUSTMENT, FUEL (N.A.B.I.) | 690.50 | | | | | | | |
| | | | | 1 | 1 | LU | INCENTIVE/DISINCENTIVE WORK ORDER (N.A.B.I.) | 995.10 | | | | | | | |

REVISED 06-10-05 LSW
 PROJECT : BOLTON - SO, BURLINGTON WILLISTON
 PROJECT NO. : AC IM 089-2(36) IM 089-2(35)
 DESIGN FILE NAME: /pave/04all4/p04all4.dgn PLOT DATE: 14-JUN-2005
 IPARM FILE NAME: p04all4cqs4.l SURVEY DATE: _____
 SURVEYED BY: _____ DRAWN BY: _____
 SQUAD LEADER: _____ SHEET: 5 OF 76


INDEX OF SHEETS

| | |
|-------|--------------------------------------|
| 6 | TITLE SHEET |
| 7-10 | TYPICAL SHEETS |
| 11-14 | QUANTITY SHEETS |
| 15-23 | ITEM DETAIL SHEETS |
| 24-26 | PAVING PROJECT LAYOUT SHEETS |
| 27 | INT. # 11 RAMP DETAIL SHEETS |
| 28 | INT. # 12 RAMP DETAIL SHEETS |
| 29 | INT. # 13 RAMP DETAIL SHEETS |
| 30 | SOUTHBOUND REST AREA |
| 31-32 | MILLED RUMBLE STRIPS DETAIL SHEETS |
| 33 | TRAFFIC CONTROL PLAN @ EXIT 13 # 01 |
| 34 | TRAFFIC CONTROL PLAN @ EXIT 13 # 02 |
| 35-36 | DETAIL SHEETS |
| 37-38 | SUMMARY SHEETS |
| 39-40 | CONSTRUCTION APPROACH SIGNING SHEETS |
| 41 | EROSION CONTROL NARRATIVE |
| 42 | EROSION CONTROL PLAN |
| 43 | SILT FENCE DETAILS |
| 44 | INLET AND CHECK DAM DETAILS |
| 45 | CONSTRUCTION ENTRANCE DETAIL |

STANDARDS

| | | |
|--------|---|----------|
| B-17 | DETAIL OF U-TURN TURNOUTS | 02/23/95 |
| C-1 | CURBS, VERTICAL GRANITE CURB, TREATED TIMBER CURB | 01/03/00 |
| D-3 | TREATED GUTTERS | 06/01/94 |
| D-15 | PRECAST REINFORCED CONCRETE CB OR MH W/ CI GRATE OR COVER, CI GRATE W/ FRAME, TYPES D & E | 06/01/94 |
| E-100 | CONSTRUCTION APPROACH SIGNS | 01/02/04 |
| E-101 | CONSTRUCTION SIGN DETAILS | 05/30/03 |
| E-102 | CONSTRUCTION SIGN DETAILS | 06/30/03 |
| E-102A | CONSTRUCTION SIGN DETAILS | 05/01/04 |
| E-103 | MAINLINE TRAFFIC CONTROL DIVIDED HIGHWAY ONE LANE CLOSED | 03/01/04 |
| E-105 | TRAFFIC CONTROL FOR CONSTRUCTION VEHICLE U-TURNS ON DIVIDED HIGHWAY | 05/01/04 |
| E-106 | TRAFFIC CONTROL - MISCELLANEOUS DETAILS | 03/01/04 |
| E-107 | DELINEATION, BARRICADES AND DETOURS FOR U-TURNS ON DIVIDED HIGHWAY | 06/30/03 |
| E-107A | BREAKAWAY BARRICADE DETAILS | 08/08/95 |
| E-108 | CONSTRUCTION ZONE LONGITUDINAL DROP-OFFS | 08/18/95 |
| E-110 | MAJOR MAINTENANCE OPERATION LANE CLOSURE | 08/08/95 |
| E-112 | TRAFFIC CONTROL FOR TYPICAL MOVING MAINTENANCE OPERATIONS | 01/23/97 |
| E-119 | UTILITY WORK ZONE | 03/01/04 |
| E-120 | STANDARD SIGN PLACEMENT - EXPRESSWAY & FREEWAY | 08/08/95 |
| E-121 | STANDARD SIGN PLACEMENT - CONVENTIONAL ROAD | 08/08/95 |
| E-142 | REGULATORY SIGN DETAILS | 09/20/95 |
| E-143 | REGULATORY SIGN DETAILS | 06/15/04 |
| E-150 | WARNING SIGN DETAILS | 05/01/04 |
| E-160 | FLANGED CHANNEL STEEL SIGN POST DETAIL | 05/20/99 |
| E-164 | SQUARE STEEL SIGN POST | 05/20/99 |
| E-191 | PAVEMENT MARKING DETAILS | 02/01/99 |
| E-192 | PAVEMENT MARKING DETAILS | 10/12/00 |
| E-193 | PAVEMENT MARKING DETAILS | 08/18/95 |
| E-197 | DELINEATOR PLACEMENT TYPICAL | 08/18/95 |
| E-198 | FREEWAY - EXPRESSWAY DELINEATORS AND MILEPOSTS | 04/14/97 |
| E-199 | FREEWAY - EXPRESSWAY DELINEATORS AND MILEPOSTS MOUNTING ON BRIDGE RAIL | 08/18/95 |
| G-1 | STEEL BEAM GUARDRAIL WITH STEEL POSTS | 01/03/00 |
| G-6 | CABLE GUARD RAIL WITH STEEL POSTS | 06/01/94 |
| G-10 | ANCHOR FOR CABLE RAIL AT OPENINGS | 02/23/95 |
| G-19 | GENERIC GRADING PLANS FOR GUARDRAIL END TERMINALS | 11/15/02 |

STATE OF VERMONT AGENCY OF TRANSPORTATION

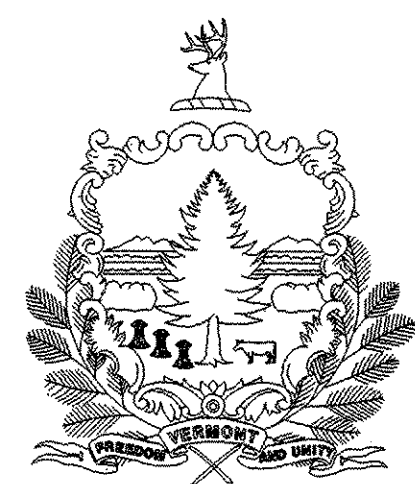


PROPOSED IMPROVEMENT TOWNS OF BOLTON, RICHMOND, WILLISTON, & SO. BURLINGTON COUNTY OF CHITTENDEN INTERSTATE ROUTE 89 SB

BEGINNING IN THE TOWN OF BOLTON ON INTERSTATE I-89 IN THE SOUTHBOUND BARREL AT STATION 3780+68 (MM 71.604) AND EXTENDING NORTHERLY A DISTANCE OF 85,368 FEET (16.168 MILES) TO STATION 4634+36 (MM 87.772) IN THE CITY OF SOUTH BURLINGTON

PROJECT DATA

| | |
|----------------------------|------------------------------|
| FROM | TO |
| STA 3780+68 (MM 71.604) SB | STA 4634+34 (MM 87.772) SB |
| LENGTH OF ROADWAY | = 85,368 FEET (16.168 MILES) |
| LENGTH OF PROJECT | = 85,368 FEET (16.168 MILES) |

WORK TO BE PERFORMED UNDER THIS PROJECT INCLUDES COLD PLANING AND RESURFACING OF THE SOUTHBOUND LANE INCLUDING INTERCHANGE RAMPS WITH NEW PAVEMENT MARKINGS, GUARDRAIL, SIGNS AND INCIDENTAL ITEMS AS SHOWN IN THE PROJECT QUANTITIES.

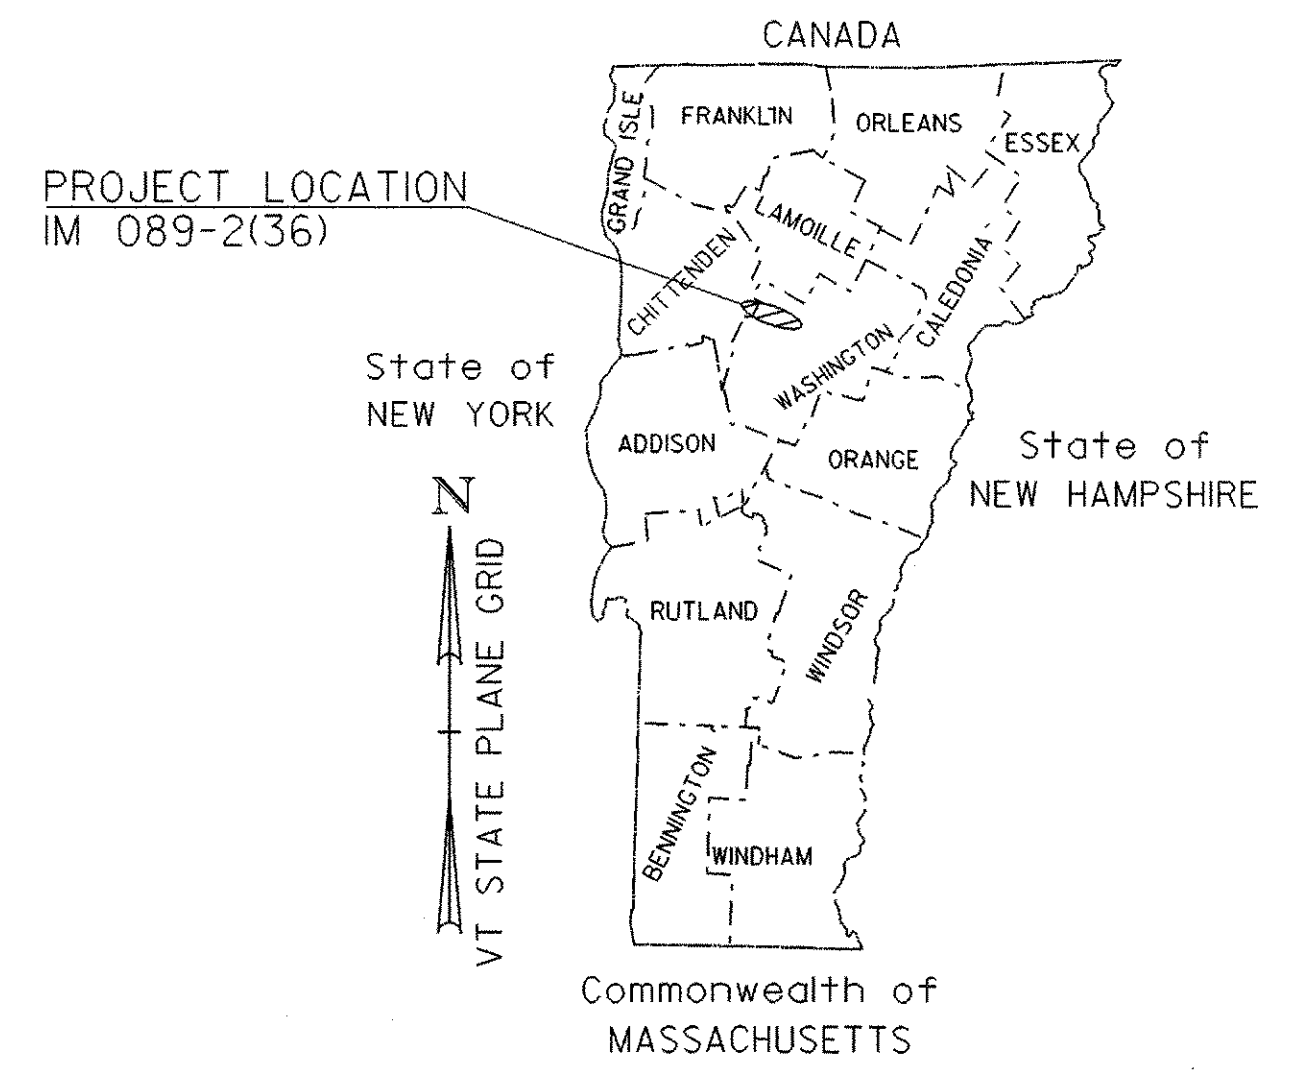

TRAFFIC DATA

(BEGIN OF PROJECT) M.M. 71.604 TO EXIT 11 SB

| | | | |
|-----------|-------|---|------------|
| 2005 | ADT | = | 14,000 |
| 2005 | DHV | = | 1,600 |
| 2015 | ADT | = | 17,500 |
| 2015 | DHV | = | 2,000 |
| 2005-2015 | ESALS | = | 5,978,000 |
| 2005-2025 | ESALS | = | 16,923,000 |

EXIT # 11 TO EXIT # 12 SB

| | | | |
|-----------|-------|---|------------|
| 2005 | ADT | = | 14,900 |
| 2005 | DHV | = | 1,900 |
| 2015 | ADT | = | 18,400 |
| 2015 | DHV | = | 2,300 |
| 2005-2015 | ESALS | = | 5,752,000 |
| 2005-2025 | ESALS | = | 16,305,000 |

EXIT 12 TO M.M. 87.772 (END OF PROJECT)


| | | | |
|-----------|-------|---|------------|
| 2005 | ADT | = | 19,200 |
| 2005 | DHV | = | 2,400 |
| 2015 | ADT | = | 23,800 |
| 2015 | DHV | = | 3,000 |
| 2005-2015 | ESALS | = | 7,483,000 |
| 2005-2025 | ESALS | = | 21,577,000 |

| BITUMINOUS CONCRETE PAVEMENT SUPERPAVE MIXTURE DESIGN CRITERIA | |
|--|------------|
| DESIGN LANE/DESIGN LIFE ESAL | 21,577,000 |
| DESIGN NUMBER OF GYRATIONS | 100 |
| PERFORMANCE GRADED ASPHALT BINDER | PG 64-28 |

RIGHT-OF-WAY LIMITS, IF APPLICABLE, ARE PROVIDED SOLELY FOR THE CONVENIENCE OF THE STATE AND ITS CONTRACTOR DURING THE COURSE OF THIS PAVING PROJECT. ANY REFERENCES TO OFFSETS ON THESE PLANS ARE APPROXIMATE AND SHOULD NOT BE RELIED UPON FOR ANY OTHER PURPOSES.

THESE PLANS ARE SUBJECT TO SUCH ENGINEERING CHANGES AS MAY BE REQUIRED BY THE FEDERAL HIGHWAY ADMINISTRATION OR THE DIRECTOR OF PROGRAM DEVELOPMENT.

CONSTRUCTION IS TO BE CARRIED ON IN ACCORDANCE WITH THESE PLANS AND THE STANDARD SPECIFICATIONS FOR CONSTRUCTION DATED 2001, AS APPROVED BY THE FEDERAL HIGHWAY ADMINISTRATION ON JANUARY 4, 2001 FOR USE ON THIS PROJECT, INCLUDING ALL SUBSEQUENT REVISIONS AND SUCH REVISED SPECIFICATIONS AND SPECIAL PROVISIONS AS ARE INCORPORATED IN THESE PLANS.

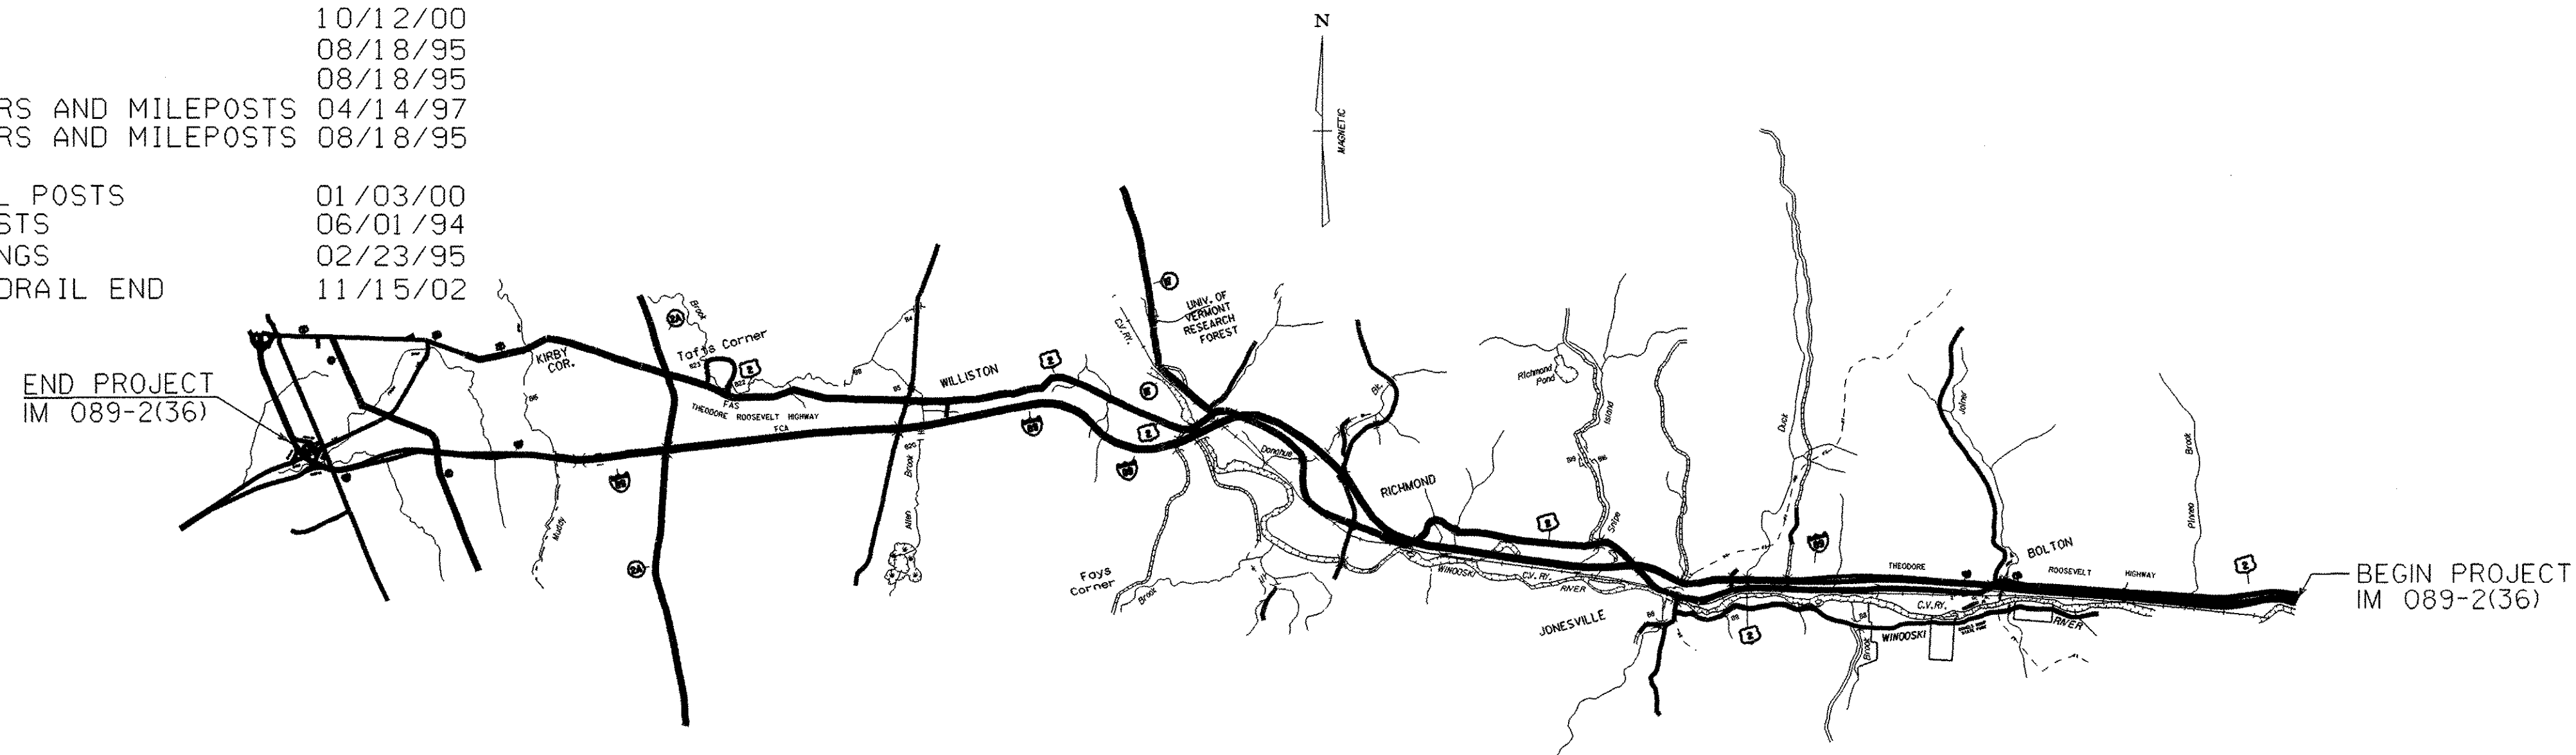

THESE PLANS ARE SUBJECT TO SUCH ENGINEERING CHANGES AS MAY BE REQUIRED BY THE FEDERAL HIGHWAY ADMINISTRATION OR THE DIRECTOR OF PROGRAM DEVELOPMENT.

CONSTRUCTION IS TO BE CARRIED ON IN ACCORDANCE WITH THESE PLANS AND THE STANDARD SPECIFICATIONS FOR CONSTRUCTION DATED 2001, AS APPROVED BY THE FEDERAL HIGHWAY ADMINISTRATION ON JANUARY 4, 2001 FOR USE ON THIS PROJECT, INCLUDING ALL SUBSEQUENT REVISIONS AND SUCH REVISED SPECIFICATIONS AND SPECIAL PROVISIONS AS ARE INCORPORATED IN THESE PLANS.

/pave/04all4/04all4.dgn IPARM NAME: p04all4ts.1

| | |
|----------------------|-----------------------|
| PROJECT MANAGER : | WOOLAVER |
| PROJECT NAME : | BOLTON-SO. BURLINGTON |
| PROJECT NUMBER : | AC IM 089-2(36) |
| SHEET 6 OF 76 SHEETS | |


**SEEDING FORMULA
RURAL AREAS**

| % WT. | LBS./A. | NAME | PUR % | GERM % |
|-------|---------|---------------------|-------|--------|
| 37.5 | 22.5 | CREeping RED FESCUE | 98 | 85 |
| 37.5 | 22.5 | TALL FESCUE | 95 | 90 |
| 5.0 | 3.0 | RED TOP | 95 | 90 |
| 15.0 | 9.0 | BIRDSFOOT TREFoil | 98 | 85 |
| 5.0 | 3.0 | ANNUAL RYEGRASS | 95 | 85 |
| 100.0 | 60.0 | | | |

NOTES:

- THE PAVEMENT WEARING COURSE SHALL BE TYPE IIS AS SHOWN ON THE TYPICALS. ALL ASPHALT CEMENT USED IN SUPERPAVE BITUMINOUS CONCRETE PAVEMENT SHALL BE PG 64-28.
- EMULSIFIED ASPHALT SHALL BE APPLIED ON ALL EXISTING PAVEMENT SURFACES AND ON COLD PLANED SURFACES, AT THE RATE OF 0.015 GAL./SY. OR AS DIRECTED BY THE RESIDENT ENGINEER.
- SUPERPAVE BITUMINOUS CONCRETE PAVEMENT TOLERANCE = 1/4" +/- (TOTAL THICKNESS).
- COLD PLANING SHALL BE COMPLETED ACCORDING TO TYPICAL OR AS DENOTED OTHERWISE ON THE PLANS. A FULL DEPTH BUTT JOINT SHALL BE CONSTRUCTED AT THE PROJECT BEGIN/END AND AT ALL RAMP APPROACHES AS SHOWN ON THE PROJECT PLANS OR AS OTHERWISE DIRECTED BY THE RESIDENT ENGINEER.
- AN ESTIMATE QUANTITY OF EARTH BORROW HAS BEEN INCLUDED FOR THE PROVISION OF CONSTRUCTING MTS FLARES WHICH SHALL BE CAPPED WITH AN ESTIMATED 3" DEPTH OF AGGREGATE SHOULDER (MOD.) MATERIAL UNLESS OTHERWISE DIRECTED BY THE RESIDENT ENGINEER. THE QUANTITIES INCLUDED REFLECT 26 CUBIC YARDS OF EARTH BORROW AND 6 TONS OF AGGREGATE SHOULDER (MOD.) MATERIAL FOR EACH GUARDRAIL TERMINAL.
- ALL EDGES OF PAVEMENT SHALL BE BACKED UP FULL HEIGHT WITH COLD PLANE GRINDINGS AS DIRECTED BY THE RESIDENT ENGINEER AND WILL BE PAID FOR UNDER ITEM 402.12, AGGREGATE SHOULDER (MOD.).
- ITEM 616.47, BITUMINOUS CONCRETE GUTTERS AND TRAFFIC ISLANDS WILL BE PAID ONLY WHERE SPECIFIED IN THE PLANS. ALL OTHER BITUMINOUS CONCRETE PAVEMENT WORK SHALL BE PAID FOR AT THE CONTRACT UNIT PRICE FOR ITEM 490.30, SUPERPAVE BITUMINOUS CONCRETE PAVEMENT.
- SEED MIXTURE: SHALL NOT HAVE A WEED CONTENT EXCEEDING 0.40% BY WEIGHT AND SHALL BE FREE OF ALL NOXIOUS SEED.
- FERTILIZER: FORMULA 10-20-10, TO BE USED WITH SEED, APPLIED AT THE RATE OF 500 LBS./ACRE. (HYDRO SEEDERS MAY USE 19-19-19 FORMULA).
- AGRICULTURAL LIMESTONE: TO BE APPLIED AT THE RATE OF 2 TONS/ACRE, OR AS DIRECTED BY THE ENGINEER.
- HAY MULCH: TO BE PLACED ON EARTH SLOPES AT THE RATE OF 2 TONS/ACRE, OR AS DIRECTED BY THE ENGINEER.
- TOPSOIL: TO BE USED WITH SEED AS INDICATED ON THE PLANS, OR AS DIRECTED BY THE ENGINEER.
- MARKER POSTS: TO BE PLACED AS INDICATED OR AS DIRECTED BY THE ENGINEER.
- THE CONTRACTOR SHALL TAKE PRECAUTIONS TO AVOID THE ACCUMULATION OF DEBRIS IN THE DRAINAGE STRUCTURES LOCATED AT THE CURB LINE AND IN THE EXPANSION JOINTS. BRIDGE DRAIN TROUGHS SHALL ALSO BE CLEANED WHEN COLD PLANING AND RUMBLE STRIPS ARE COMPLETED. PAYMENT SHALL BE INCLUDED UNDER ITEM 210.10, COLD PLANING.

AGGREGATE SHOULDER (MOD)(SEE NOTE #6)

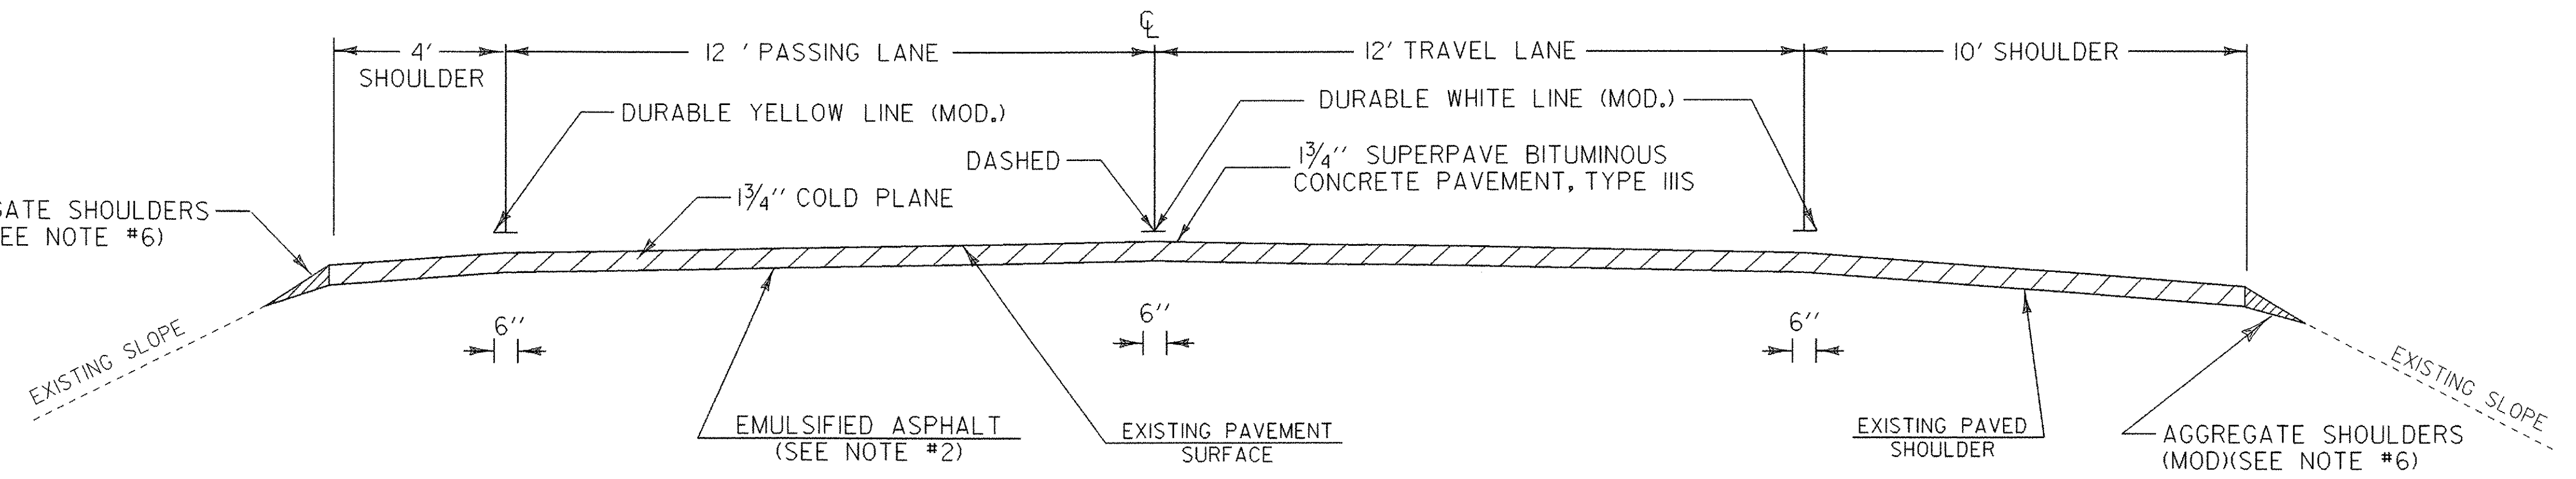


MAINLINE TYPICAL SECTION

BOLTON
STA 3780+68 (M.M. 71.604) TO STA 3875+58 (M.M. 73.401) SB
RICHMOND
STA 3875+58 (M.M. 73.401) TO STA 4199+89 (M.M. 79.543) SB
WILLISTON
STA 4199+89 (M.M. 79.543) TO STA 4487+53 (M.M. 84.991) SB
SO. BURLINGTON
STA 4487+53 (M.M. 84.991) TO STA 4634+36 (M.M. 87.772) SB

PROJECT PAVING LIMITS

| TOWN | BEGIN STATION | END STATION | LANE TYPICAL | WEARING DEPTH | NOTES |
|----------------|---------------|-------------|----------------|---------------|--|
| INTERSTATE-89 | | | | | |
| SOUTHBOUND | | | | | |
| BOLTON | 3780+68 | 3875+58 | 10'-12'-12'-4' | 1 3/4'' | COLD PLANE 1 3/4'', OVERLAY 1 3/4'' |
| RICHMOND | 3875+58 | 3884+18 | 10'-12'-12'-4' | 1 3/4'' | COLD PLANE 1 3/4'', OVERLAY 1 3/4'' |
| RICHMOND | 3884+18 | 3885+55 | 10'-12'-12'-4' | | COLD PLANE 1/4'', OVERLAY 1/4'', TYPE IVS, BRIDGE # 52 S |
| RICHMOND | 3885+55 | 3902+98 | 10'-12'-12'-4' | 1 3/4'' | COLD PLANE 1 3/4'', OVERLAY 1 3/4'' |
| RICHMOND | 3902+98 | 3905+62 | 2'-12'-12'-2' | | COLD PLANE 1/4'', OVERLAY 1/4'', TYPE IVS, BRIDGE # 53 S |
| RICHMOND | 3905+62 | 4069+77 | 10'-12'-12'-4' | 1 3/4'' | COLD PLANE 1 3/4'', OVERLAY 1 3/4'' |
| RICHMOND | 4069+77 | 4071+36 | 2'-12'-12'-2' | | COLD PLANE 1/4'', OVERLAY 1/4'', TYPE IVS, BRIDGE # 55 S |
| RICHMOND | 4071+36 | 4137+67 | 10'-12'-12'-4' | 1 3/4'' | COLD PLANE 1 3/4'', OVERLAY 1 3/4'' |
| RICHMOND | 4137+67 | 4140+05 | 2'-12'-12'-2' | | COLD PLANE 1/4'', OVERLAY 1/4'', TYPE IVS, BRIDGE # 56 S |
| RICHMOND | 4140+05 | 4143+48 | 10'-12'-12'-4' | 1 3/4'' | COLD PLANE 1 3/4'', OVERLAY 1 3/4'' |
| RICHMOND | 4143+48 | 4146+33 | 2'-12'-12'-2' | | COLD PLANE 1/4'', OVERLAY 1/4'', TYPE IVS, BRIDGE # 57 S |
| RICHMOND | 4146+33 | 4152+67 | 10'-12'-12'-4' | 1 3/4'' | COLD PLANE 1 3/4'', OVERLAY 1 3/4'' |
| RICHMOND | 4152+67 | 4158+53 | 2'-12'-12'-2' | | COLD PLANE 1/4'', OVERLAY 1/4'', TYPE IVS, BRIDGE # 58 S |
| RICHMOND | 4158+53 | 4168+77 | 10'-12'-12'-4' | 1 3/4'' | COLD PLANE 1 3/4'', OVERLAY 1 3/4'' |
| RICHMOND | 4168+77 | 4170+67 | 2'-12'-12'-2' | | COLD PLANE 1/4'', OVERLAY 1/4'', TYPE IVS, BRIDGE # 59 S |
| RICHMOND | 4170+67 | 4199+89 | 10'-12'-12'-4' | 1 3/4'' | COLD PLANE 1 3/4'', OVERLAY 1 3/4'' |
| WILLISTON | 4199+89 | 4432+03 | 10'-12'-12'-4' | 1 3/4'' | COLD PLANE 1 3/4'', OVERLAY 1 3/4'' |
| WILLISTON | 4432+03 | 4433+83 | 2'-12'-12'-2' | | DO NOT COLD PLANE BRIDGE # 63 S |
| WILLISTON | 4433+83 | 4487+47 | 10'-12'-12'-4' | 1 3/4'' | COLD PLANE 1 3/4'', OVERLAY 1 3/4'' |
| WILLISTON | 4487+47 | 4488+00 | 10'-12'-12'-4' | | COLD PLANE 1/4'', OVERLAY 1/4'', TYPE IVS, BRIDGE # 63 S |
| SO. BURLINGTON | 4487+53 | 4603+32 | 10'-12'-12'-4' | 1 3/4'' | COLD PLANE 1 3/4'', OVERLAY 1 3/4'' |
| SO. BURLINGTON | 4603+32 | 4604+37 | 2'-12'-12'-2' | | COLD PLANE 1/4'', OVERLAY 1/4'', TYPE IVS, BRIDGE # 65 S |
| SO. BURLINGTON | 4604+37 | 4613+35 | 10'-12'-12'-4' | 1 3/4'' | COLD PLANE 1 3/4'', OVERLAY 1 3/4'' |
| SO. BURLINGTON | 4613+35 | 4614+98 | 2'-12'-12'-2' | | COLD PLANE 1/4'', OVERLAY 1/4'', TYPE IVS, BRIDGE # 66 S |
| SO. BURLINGTON | 4614+98 | 4634+36 | 10'-12'-12'-4' | 1 3/4'' | COLD PLANE 1 3/4'', OVERLAY 1 3/4'' |
| RAMPS | | | | | |
| EXIT 11 | A, B, C, D, F | | VARIES | 1 3/4'' | COLD PLANE 1 3/4'', OVERLAY 1 3/4'' |
| EXIT 12 | B | | VARIES | 1 3/4'' | COLD PLANE 1 3/4'', OVERLAY 1 3/4'' |
| EXIT 13 | A, B | | VARIES | 1 3/4'' | COLD PLANE 1 3/4'', OVERLAY 1 3/4'' |

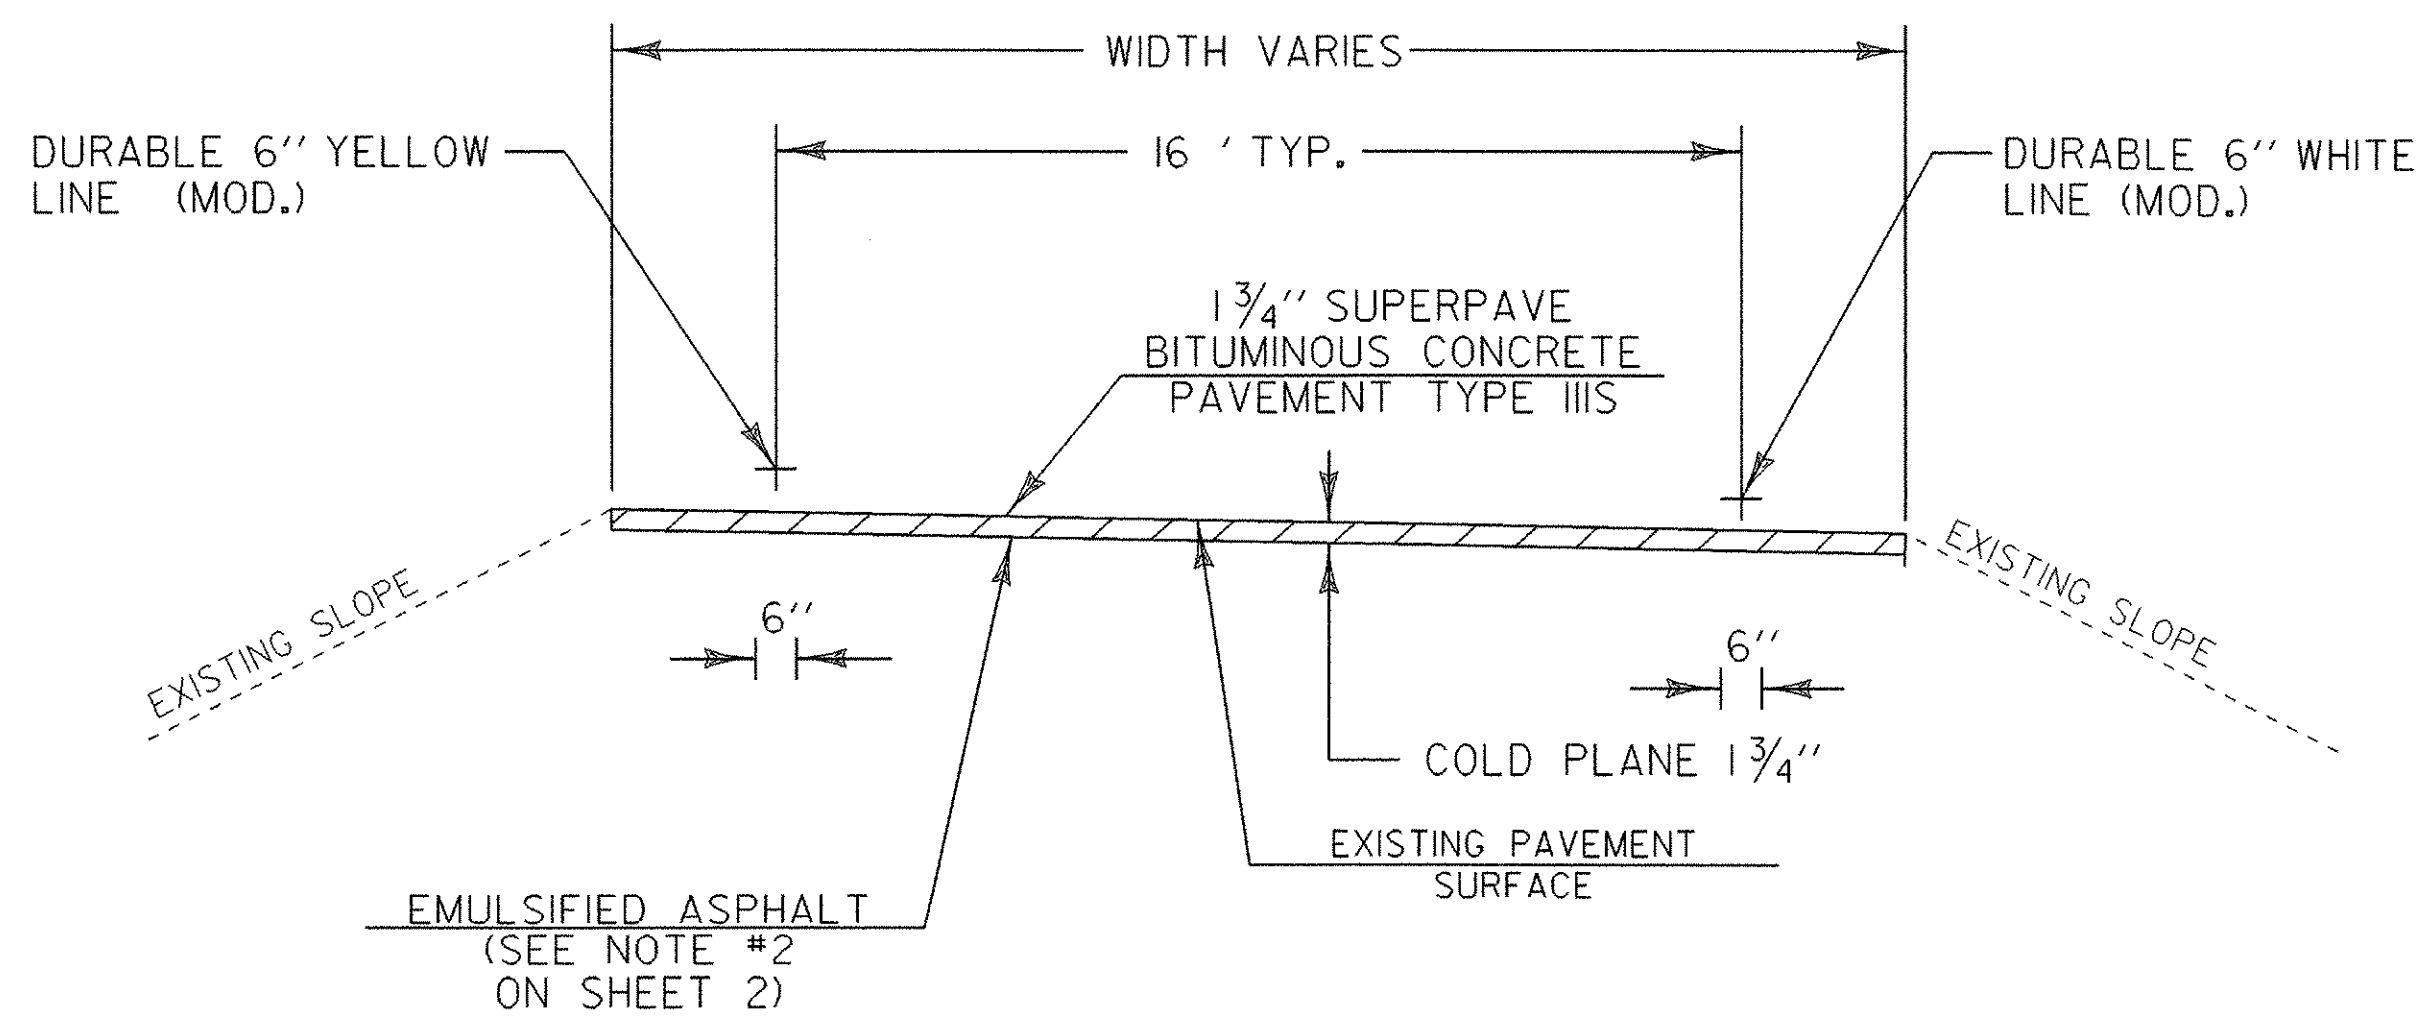

RAMP PAVEMENT TYPICAL

- LOCATION
- EXIT 11 OFF & ON RAMPS SB - SEE SHEET 22 FOR DETAILS
 - EXIT 11 OFF & ON RAMPS NB - SEE SHEET 22 FOR DETAILS
 - EXIT 12 ON RAMPS SB - SEE SHEET 22 FOR DETAILS
 - EXIT 13 OFF & ON RAMPS SB - SEE SHEET 22 FOR DETAILS

NOT TO SCALE


**PROJECT
TYPICAL
SHEET 1**

PROJECT NAME: BOLTON - SO. BURLINGTON

PROJECT NUMBER: AC IM 089-2(36)

FILE NAME: /pave/04all4/04all4.dgn
PROJECT LEADER:
DESIGNED BY:
IPARM NAME: p04all4p1.i

PLOT DATE: 17-MAY-2005
DRAWN BY:
CHECKED BY:
SHEET 7 OF 76

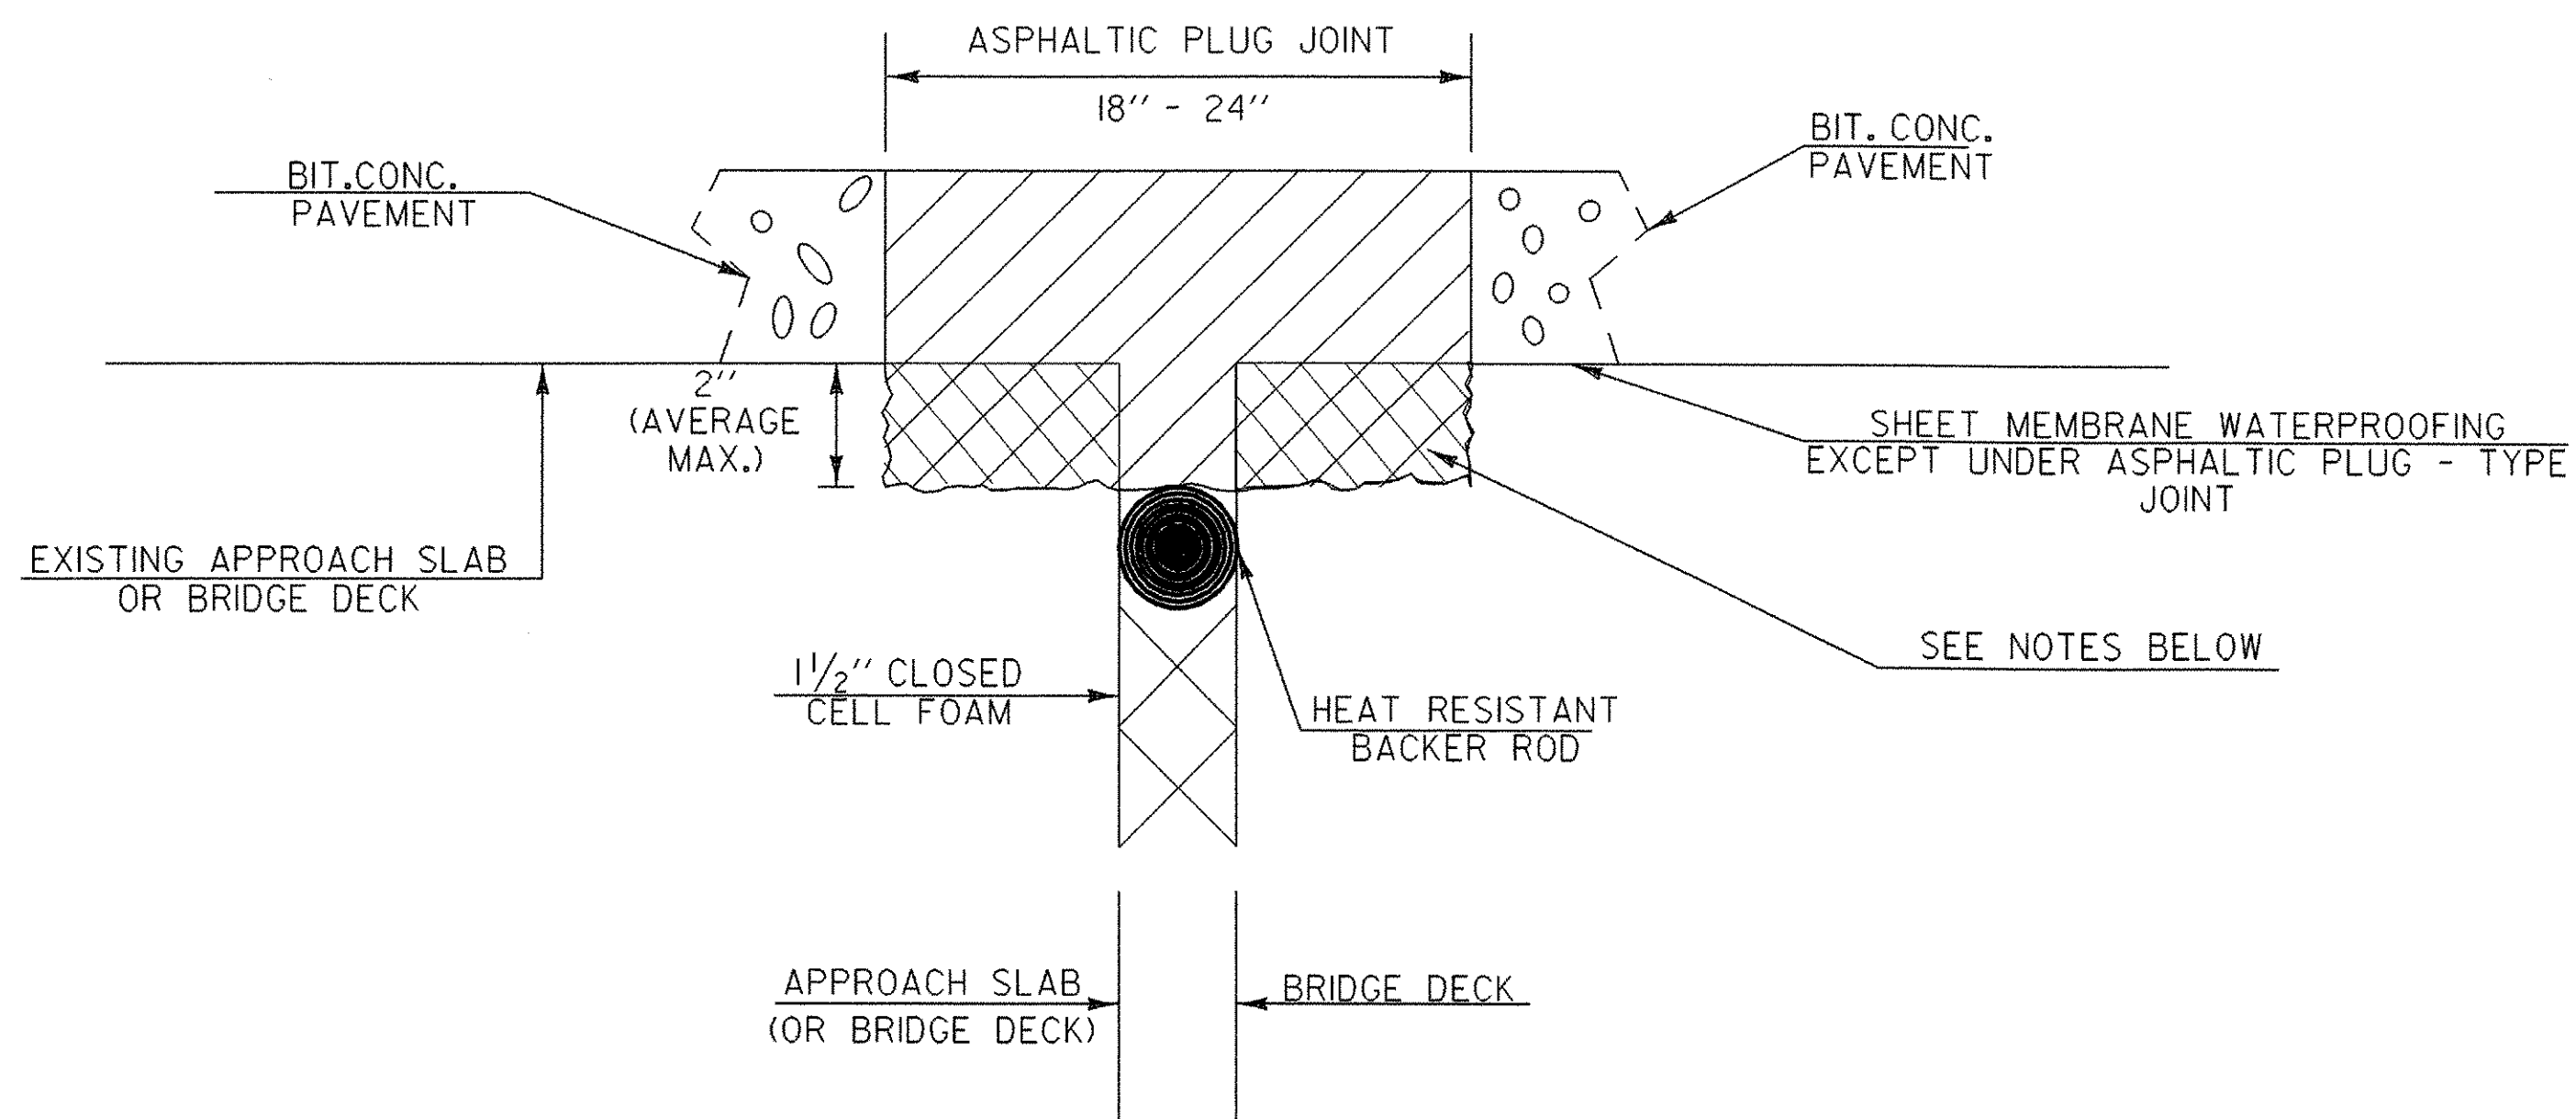


**ASPHALTIC PLUG - TYPE
JOINT DETAIL
REMOVAL OF UP TO
2" DETERIORATED CONCRETE**

NOTES:

- UPON ENCOUNTERING UP TO 2" AVERAGE OF DETERIORATED CONCRETE, THE CONTRACTOR SHALL REMOVE THE DETERIORATED MATERIAL AND REPLACE IT WITH THE ASPHALTIC PLUG JOINT MATERIAL AS DIRECTED BY THE RESIDENT ENGINEER.
- REMOVAL OF THE DETERIORATED CONCRETE WILL NOT BE PAID SEPARATELY BUT WILL BE CONSIDERED INCIDENTAL TO THE UNIT BID PRICE FOR THE ITEM 516.10. THE ADDITIONAL PLUG JOINT MATERIAL BELOW THE DESIGN DEPTH TO REPLACE THE DETERIORATED CONCRETE WILL BE CONSIDERED INCIDENTAL TO THE UNIT BID PRICE FOR THE ITEM 516.10.
- THE STEEL PLATE IN THE ASPHALTIC PLUG JOINT MAY BE OMITTED AS SHOWN IN THE DETAIL ABOVE IF DIRECTED BY THE RESIDENT ENGINEER.

* REFER TO SPECIAL PROVISIONS FOR BASIS OF PAYMENT

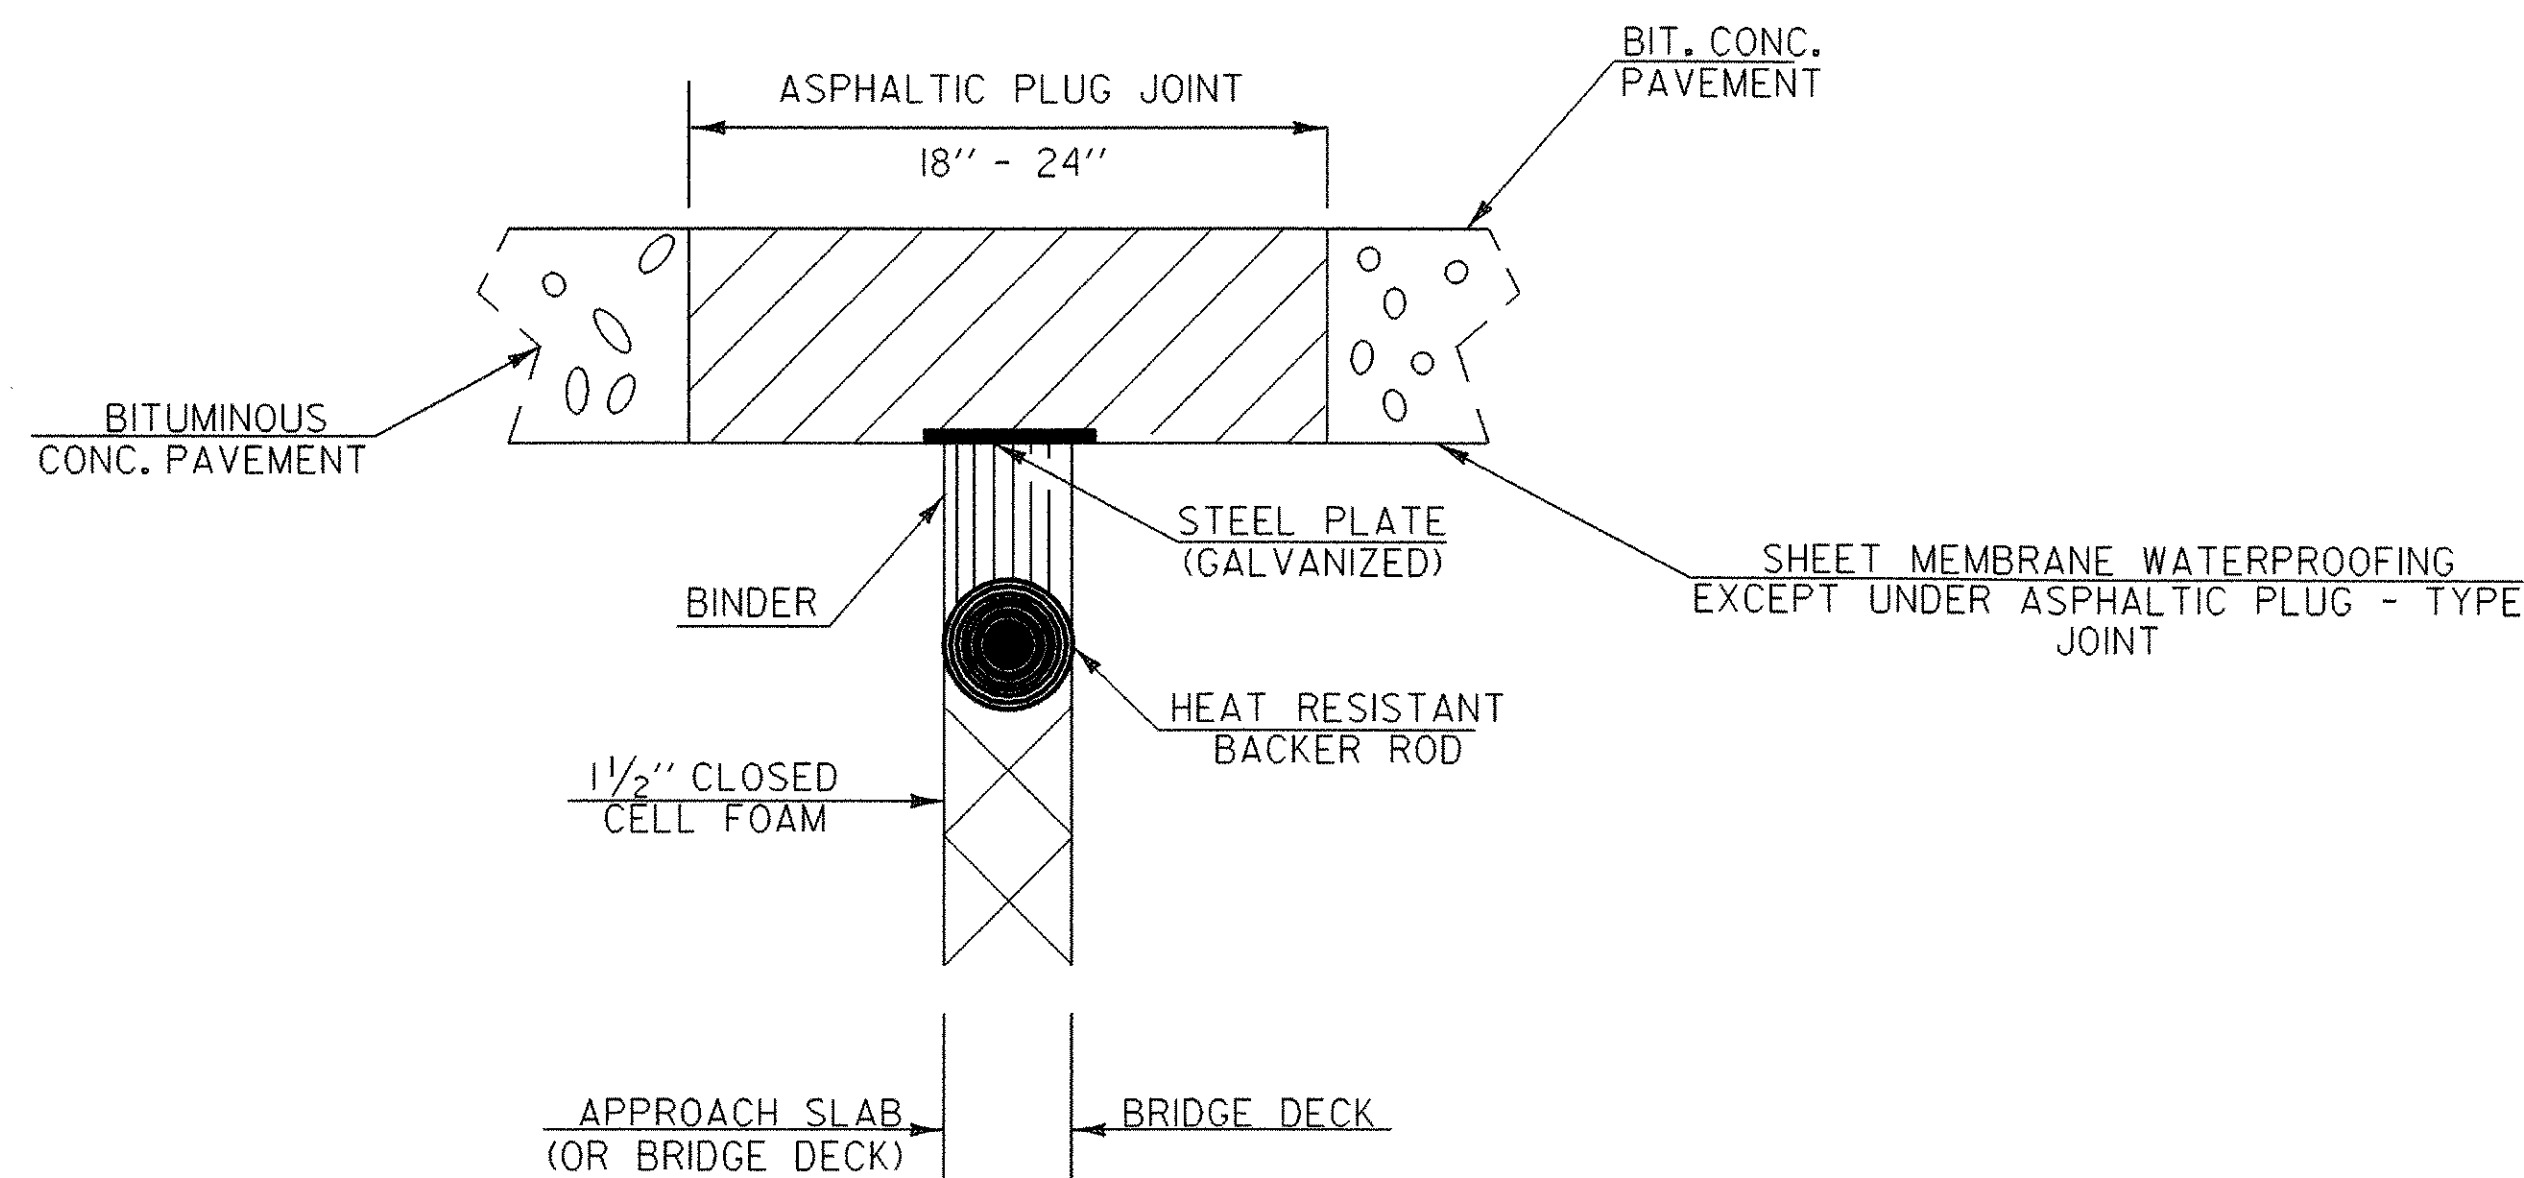

**ASPHALTIC PLUG - TYPE
JOINT DETAIL**

LOCATION

NOTE: REFER TO NOTE UNDER DETAIL AT TOP.

| TOWN | BRIDGE | EXISTING CONDITION AS PER BRIDGE INVENTORY | TREATMENT | LENGTHS |
|--|---|---|--|-----------------|
| RICHMOND M.M. 73.55 STA. 3883+42 | BR. # 52S 3 SIMPLE SPAN | 2 1/2' +/- OF EXISTING PAVEMENT WITH MEMBRANE ON BRIDGE | 5 PLUG JOINTS REQUIRED COLD PLANE 1 1/4 '' | 5 @ 38' |
| RICHMOND M.M. 74.00 STA. 3907+01 | BR. # 53S 3 SIMPLE SPAN | 2' +/- OF EXISTING PAVEMENT WITH MEMBRANE ON BRIDGE | 6 PLUG JOINTS REQUIRED COLD PLANE 1 1/4 '' | 6 @ 32' |
| RICHMOND M.M. 77.10 STA. 4070+00 | BR. # 55S 3 SIMPLE SPAN | 3' +/- OF EXISTING PAVEMENT WITH NO MEMBRANE ON BRIDGE | 6 PLUG JOINTS REQUIRED COLD PLANE 1 1/4 '' | 6 @ 32' |
| RICHMOND M.M. 78.41 STA. 4140+06 | BR. # 56S 3 SIMPLE SPAN | 3' +/- OF EXISTING PAVEMENT WITH NO MEMBRANE ON BRIDGE | 6 PLUG JOINTS REQUIRED COLD PLANE 1 1/4 '' | 6 @ 32' |
| RICHMOND M.M. 78.53 STA. 4146+64 | BR. # 57S 4 SPAN BRIDGE | 3' +/- OF EXISTING PAVEMENT WITH NO MEMBRANE ON BRIDGE | 6 PLUG JOINTS REQUIRED COLD PLANE 1 1/4 '' | 6 @ 42' |
| RICHMOND M.M. 78.75 STA. 4157+90 | BR. # 58S 3 SPAN CONTINUOUS 2 FINGER PLATE JOINTS | 3' +/- OF EXISTING PAVEMENT WITH NO MEMBRANE ON BRIDGE | 2 PLUG JOINTS REQUIRED COLD PLANE 1 1/4 '' UP TO AND BEYOND FINGER PLATE JOINTS | 2 @ 30' |
| RICHMOND M.M. 78.98 STA. 4170+01 | BR. # 59S 3 SIMPLE SPAN BEAM BRIDGE | 3' +/- OF EXISTING PAVEMENT WITH MEMBRANE ON BRIDGE | 3 PLUG JOINTS REQUIRED COLD PLANE 1 1/4 '' | 5 @ 32' |
| WILLISTON M.M. 83.96 STA. 4432+98 | BR. # 61S 3 SIMPLE SPAN BEAM BRIDGE | 3' +/- OF EXISTING PAVEMENT WITH NO MEMBRANE ON BRIDGE | COLD PLANE 1 1/4 '' UP TO AND BEYOND FINGER PLATE JOINTS | 2 @ 31' |
| WILLISTON M.M. 84.99 STA. 4487+52 | BR. # 63S 3 SIMPLE SPAN ROLLED BRIDGE | 3' +/- OF EXISTING PAVEMENT WITH MEMBRANE ON BRIDGE | 1 PLUG JOINT REQUIRED COLD PLANE 1 1/4 '' | 2 @ 38' |
| SO. BURL. M.M. 87.205 STA. 4604+45 | BR. # 65S 3 SIMPLE SPAN | 3' +/- OF EXISTING PAVEMENT WITH MEMBRANE ON BRIDGE | 1 PLUG JOINT REQUIRED COLD PLANE 1 1/4 '' | 2 @ 46' |
| SO. BURL. M.M. 87.327 STA. 4610+89 | BR. # 66S 3 SIMPLE SPAN | 3' +/- OF EXISTING PAVEMENT WITH MEMBRANE ON BRIDGE | 1 PLUG JOINT REQUIRED COLD PLANE 1 1/4 '' | 2 @ 31' |
| | | | | TOTAL 1,530' |


NOTE: EXISTING PAVEMENT THICKNESSES ARE BASED ON BRIDGE INSPECTION AND FILE INFORMATION WHICH HAVE NOT BEEN FIELD VERIFIED.
RESIDENT ENGINEER SHALL AT HIS/HER DISCRETION, SAW CUT THE FIXED JOINT AND FILL WITH HOT POURED MATERIALS.

NOT TO SCALE

**PROJECT
TYPICAL
SHEET 2**

PROJECT NAME: BOLTON - SO. BURLINGTON
PROJECT NUMBER: AC IM 089-2(36)

FILE NAME: /pave/04all4/04all4.dgn
PROJECT LEADER:
DESIGNED BY:
IPARM NAME: p04all4p+2.i
PLOT DATE: 17-MAY-2005
DRAWN BY:
CHECKED BY:
SHEET 8 OF 76

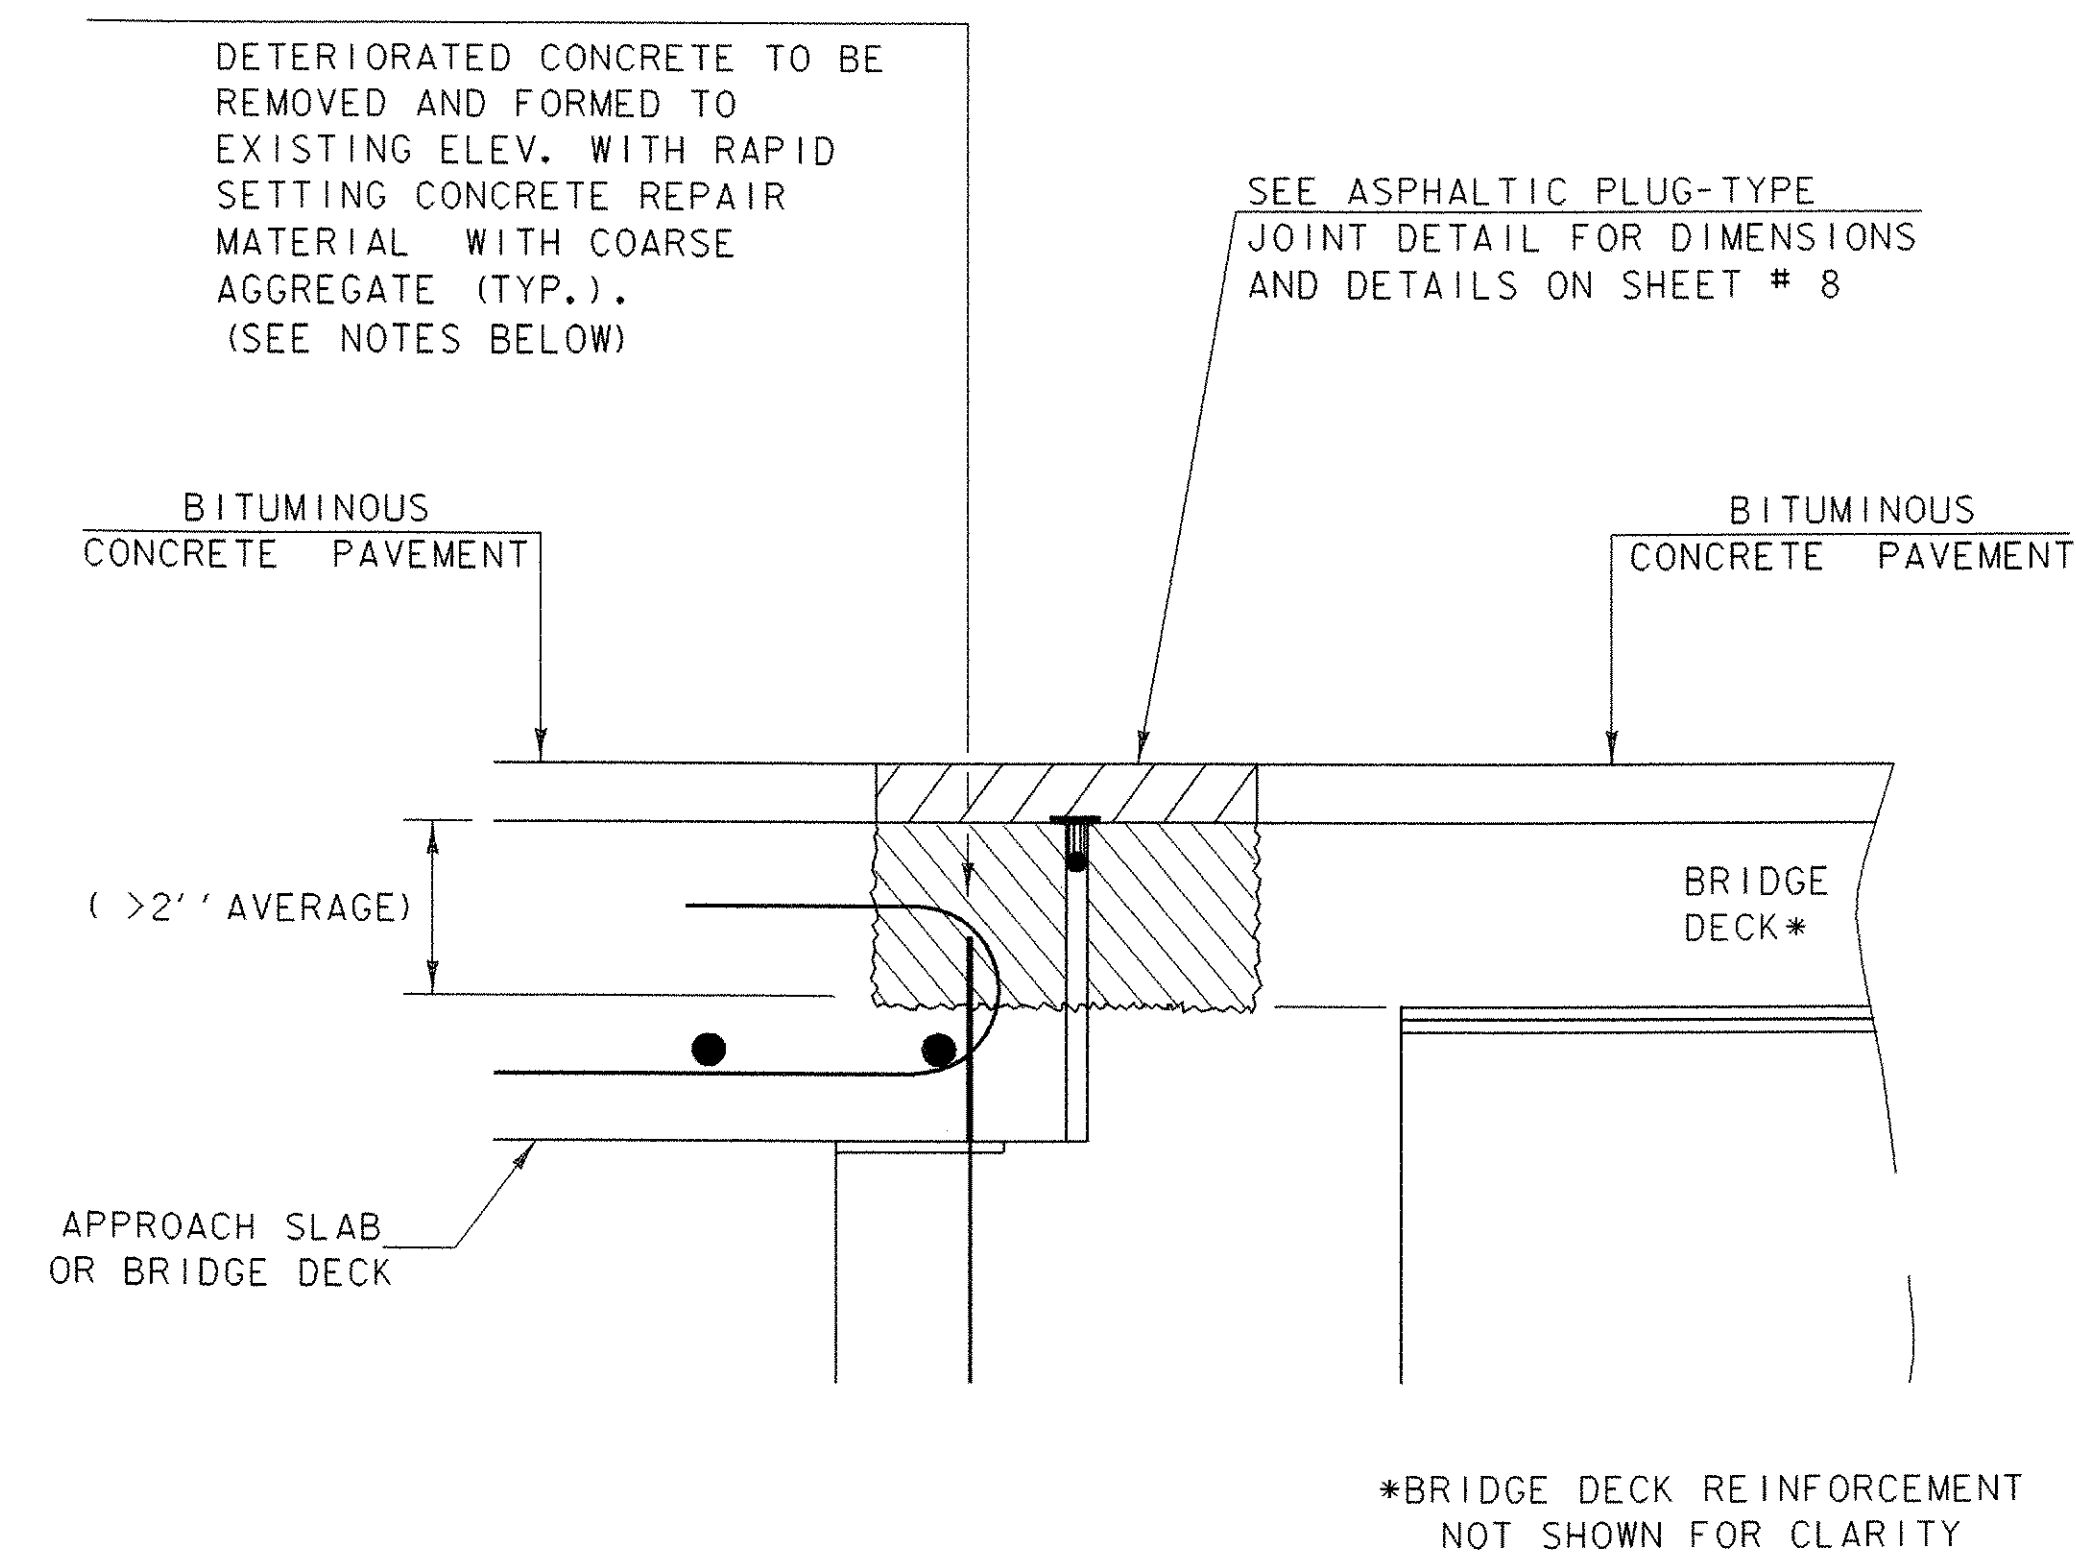

**ASPHALTIC PLUG - TYPE
JOINT DETAIL
REMOVAL OF >2''
DETERIORATED CONCRETE**

NOTES:

1. UPON ENCOUNTERING GREATER THAN 2'' AVERAGE OF DETERIORATED CONCRETE, THE CONTRACTOR SHALL REMOVE THE DETERIORATED MATERIAL AND REPLACE IT WITH RAPID SETTING CONCRETE REPAIR MATERIAL WITH COARSE AGGREGATE.
2. REMOVAL OF THE DETERIORATED CONCRETE WILL BE INCLUDED IN THE UNIT BID PRICE FOR ITEM 580.20 "RAPID SETTING CONCRETE REPAIR MATERIAL WITH COARSE AGGREGATE".
3. THE STEEL PLATE IN THE ASPHALTIC PLUG JOINT MAY BE OMITTED ONLY IF THE REPAIRED SURFACE IS SO IRREGULAR IT WILL CAUSE VERTICAL MOVEMENT AND IT IS DIRECTED BY THE RESIDENT ENGINEER.


NOT TO SCALE

**PROJECT
TYPICAL
SHEET 3**

PROJECT NAME: BOLTON - SO. BURLINGTON
PROJECT NUMBER: AC IM 089-2(36)

FILE NAME: /pave/04all4/04all4.dgn
PROJECT LEADER:
DESIGNED BY:
IPARM NAME: p04all4pt3.i


PLOT DATE: 17-MAY-2005
DRAWN BY:
CHECKED BY:
SHEET 9 OF 72

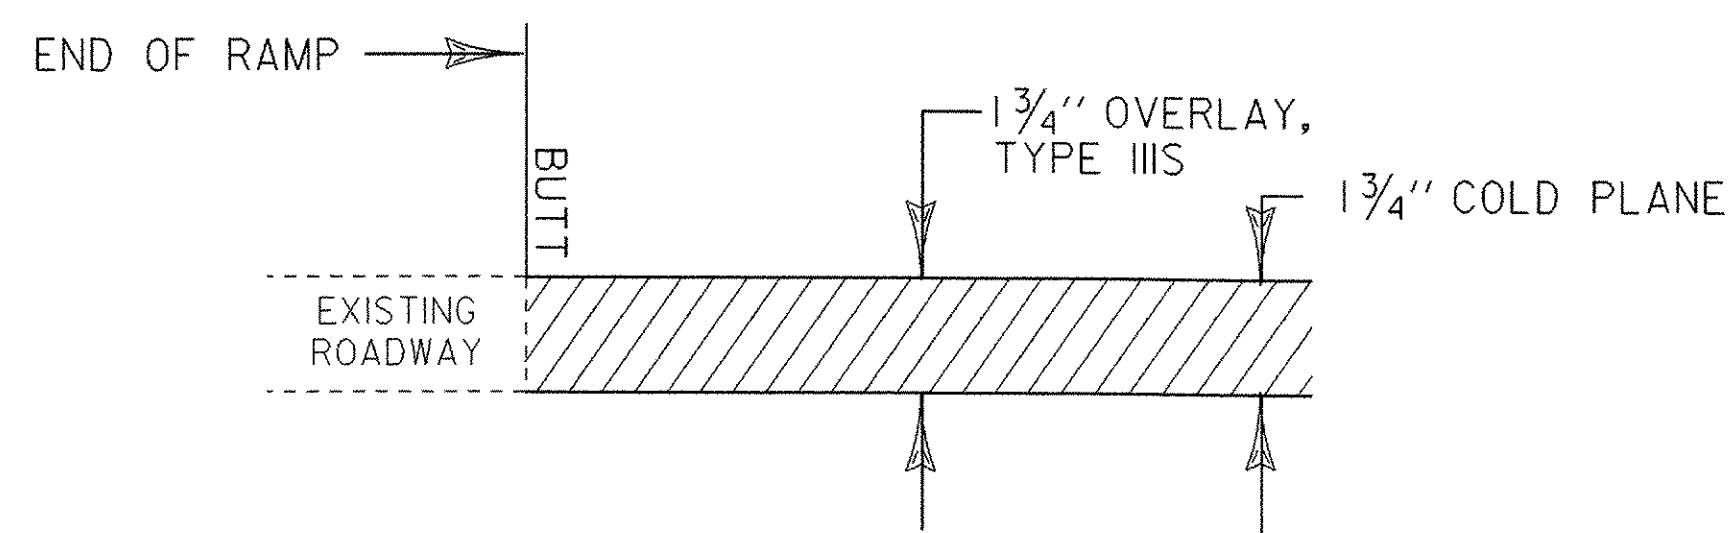

RAMP APPROACH AREA DETAIL

LOCATION


- EXIT 11 - END OF SOUTHBOUND OFF RAMP IN RICHMOND ON U.S. ROUTE 2
- EXIT 11 - BEGIN OF SOUTHBOUND ON RAMP IN RICHMOND ON U.S. ROUTE 2
- EXIT 11 - END OF NORTHBOUND OFF RAMP IN RICHMOND ON U.S. ROUTE 2
- EXIT 11 - BEGIN OF NORTHBOUND ON RAMP IN RICHMOND ON U.S. ROUTE 2
- EXIT 12 - BEGIN OF SOUTHBOUND ON RAMPS IN WILLISTON ON VT. ROUTE 2A
- EXIT 13 - END OF SOUTHBOUND OFF RAMPS IN SO. BURLINGTON ON THE I-189 INTERCHANGE
- EXIT 12 - BEGIN OF SOUTHBOUND ON RAMPS IN SO. BURLINGTON ON THE I-189 INTERCHANGE

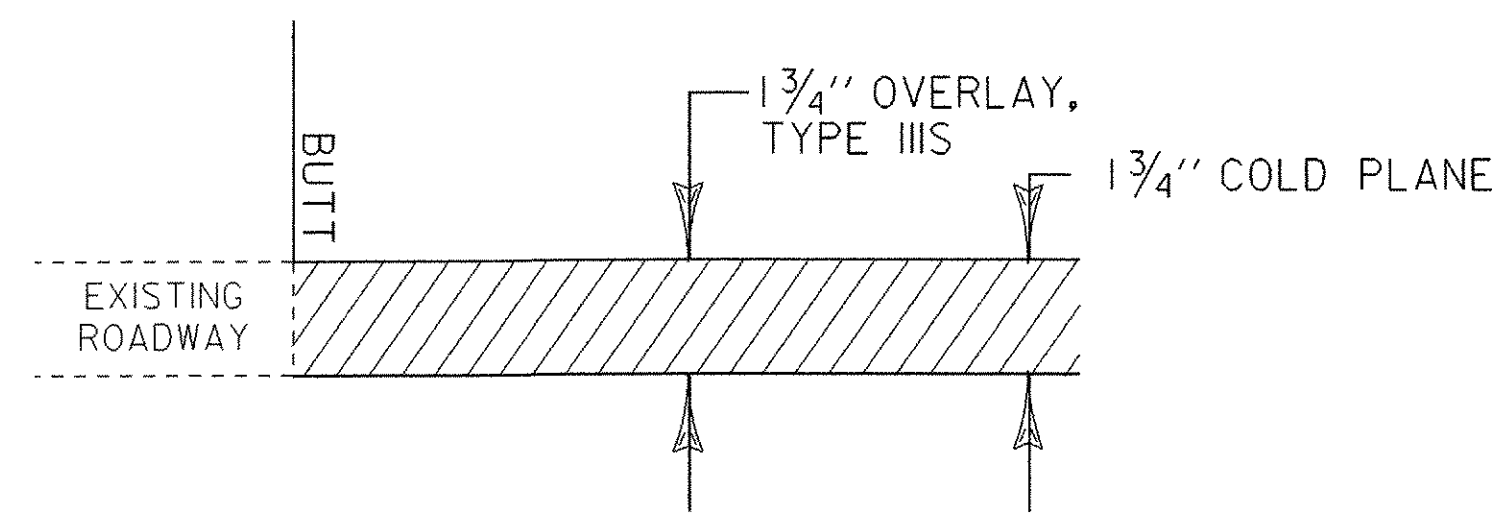

MAINLINE APPROACH AREA DETAIL

LOCATION

- BEGINNING OF PROJECT - STA 3780 + 68 (M.M. 71,604) SOUTHBOUND
- END OF PROJECT - STA. 4634 + 35 (M.M. 87,772) SOUTHBOUND

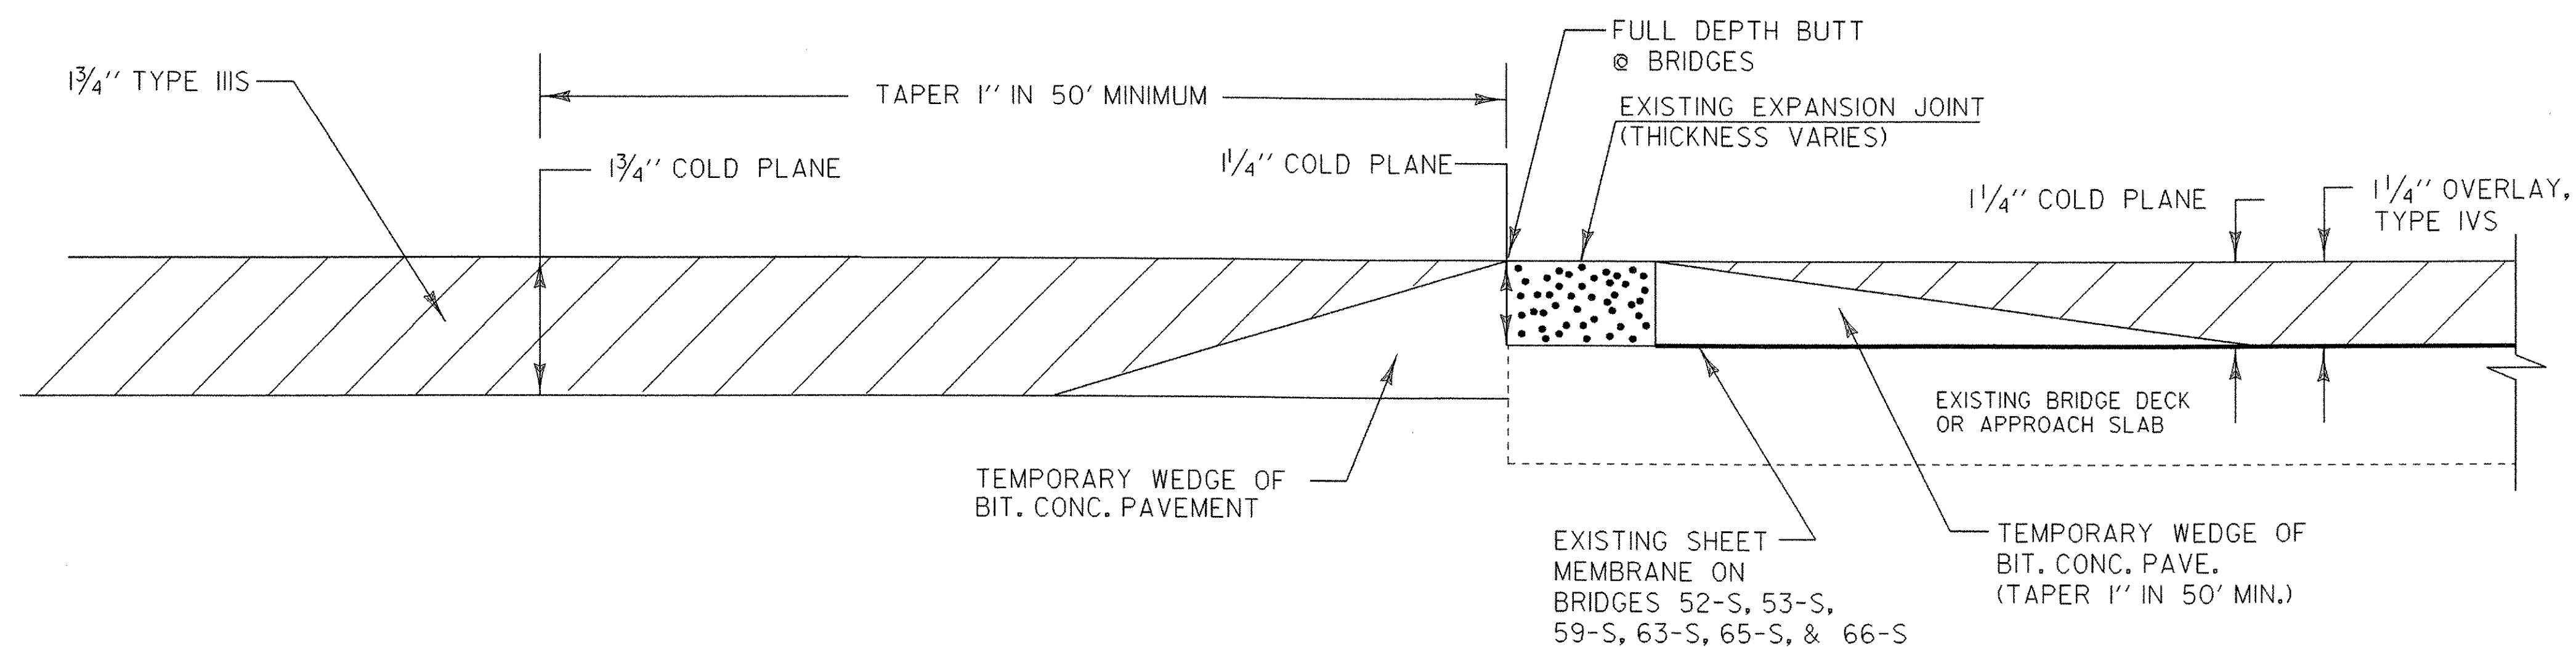

BRIDGE APPROACH DETAIL

| | | | |
|--------------|----------------------------|--------------|----------------------------|
| SB BR # 52-S | STA 3883+18 TO STA 3884+18 | SB BR # 59-S | STA 4167+77 TO STA 4168+77 |
| SB BR # 52-S | STA 3885+76 TO STA 3886+76 | SB BR # 59-S | STA 4170+67 TO STA 4171+67 |
| SB BR # 53-S | STA 3901+98 TO STA 3902+98 | SB BR # 61-S | STA 4431+03 TO STA 4432+03 |
| SB BR # 53-S | STA 3905+62 TO STA 3906+62 | SB BR # 61-S | STA 4433+83 TO STA 4434+83 |
| SB BR # 55-S | STA 4068+77 TO STA 4069+77 | SB BR # 63-S | STA 4486+47 TO STA 4487+47 |
| SB BR # 55-S | STA 4071+36 TO STA 4072+36 | SB BR # 63-S | STA 4488+00 TO STA 4489+00 |
| SB BR # 56-S | STA 4136+14 TO STA 4137+14 | SB BR # 65-S | STA 4602+32 TO STA 4603+32 |
| SB BR # 56-S | STA 4140+05 TO STA 4141+05 | SB BR # 65-S | STA 4604+37 TO STA 4605+37 |
| SB BR # 57-S | STA 4142+48 TO STA 4143+48 | SB BR # 66-S | STA 4613+93 TO STA 4612+93 |
| SB BR # 57-S | STA 4146+07 TO STA 4147+07 | SB BR # 66-S | STA 4614+99 TO STA 4615+99 |
| SB BR # 58-S | STA 4151+67 TO STA 4152+67 | | |
| SB BR # 58-S | STA 4158+53 TO STA 4159+53 | | |

NOT TO SCALE

**PROJECT
TYPICAL
SHEET 4**

PROJECT NAME: BOLTON - SO. BURLINGTON

PROJECT NUMBER: AC IM 089-2(36)

FILE NAME: /pave/04all4/04all4.dgn

PROJECT LEADER:

DESIGNED BY:

IPARM NAME: p04all4pt4.i

PLOT DATE: 17-MAY-2005

DRAWN BY:

CHECKED BY:

SHEET 10 OF 76

QUANTITY SHEET 2

SUMMARY OF ESTIMATED QUANTITIES

DETAILED SUMMARY OF QUANTITIES

DETAILED SUMMARY OF QUANTITIES

| | EMPLOYEE TRAINEESHIP | BRIDGE | ROADWAY | QUANTITIES GRAND TOTAL | UNIT | ITEMS | ITEM NUMBER | RND | | QUANTITIES | UNIT | ITEMS | | QUANTITIES | UNIT | ITEMS |
|--|-------------------------|--------|---------|---------------------------|------|--|----------------|-----|--|------------|------|-------|--|------------|------|-------|
| | | | 149 | 149 | HR | LOADER RENTAL, TYPE II (MOD.-REHAB. CABLE RAIL) | 608.41 | EST | | | | | | | | |
| | | | 5 | 5 | CY | STONE FILL, TYPE I | 613.10 | | | | | | | | | |
| | | | 400 | 400 | LF | TREATED TIMBER CURB | 616.35 | 5 | | | | | | | | |
| | | | 620 | 620 | LF | REMOVAL OF EXISTING CURB | 616.41 | 8 | | | | | | | | |
| | | | 100 | 100 | TON | BITUMINOUS CONCRETE GUTTERS AND TRAFFIC ISLANDS | 616.47 | EST | | | | | | | | |
| | | | 700 | 700 | LF | SNOW FENCE (MOD.-PDF) | 620.70 | | | | | | | | | |
| | | | 9,250 | 9,250 | LF | STEEL BEAM GUARDRAIL (GALVANIZED) | 621.20 | 13 | | | | | | | | |
| | | | 47 | 47 | EA | MANUFACTURED TERMINAL SECTION (FLARED) | 621.505 | 3 | | | | | | | | |
| | | | 16 | 16 | EA | TRAILING END TERMINAL | 621.52 | - | | | | | | | | |
| | | | 548 | 548 | EA | ANCHOR FOR CABLE RAIL (MOD.-CABLE RAIL HARDWARE) | 621.65 | EST | | | | | | | | |
| | | | 1,250 | 1,250 | EA | REPLACE GUARD RAIL POST ASSEMBLY | 621.76 | 18 | | | | | | | | |
| | | | 550 | 550 | EA | REPLACE GUARD RAIL BEAM UNIT | 621.77 | 28 | | | | | | | | |
| | | | 7,200 | 7,200 | LF | ADJUST HEIGHT OF GUARD RAIL | 621.79 | 44 | | | | | | | | |
| | | | 3,600 | 3,600 | LF | REMOVAL AND DISPOSAL OF GUARD RAIL | 621.80 | 36 | | | | | | | | |
| | | | 2,000 | 2,000 | HR | UNIFORMED TRAFFIC OFFICERS | 630.10 | EST | | | | | | | | |
| | | | 3,000 | 3,000 | HR | FLAGGERS | 630.15 | EST | | | | | | | | |
| | | | 1 | 1 | LS | FIELD OFFICE - ENGINEERS | 631.10 | - | | | | | | | | |
| | | | 1 | 1 | LS | TESTING EQUIPMENT - BITUMINOUS | 631.17 | - | | | | | | | | |
| | | | 1 | 1 | LU | FIELD OFFICE - TELEPHONE (N.A.B.I.) | 631.25 | - | | | | | | | | |
| | 520 | | 520 | 520 | HR | EMPLOYEE TRAINEESHIP | 634.10 | - | | | | | | | | |
| | | | 1 | 1 | LS | MOBILIZATION/DEMOLITION | 635.11 | - | | | | | | | | |
| | | | 1 | 1 | LS | TRAFFIC CONTROL | 641.10 | - | | | | | | | | |
| | | | 1 | 1 | LS | PUBLIC RELATIONS OFFICER | 641.12 | - | | | | | | | | |
| | | | 6 | 6 | EA | PORTABLE CHANGEABLE MESSAGE SIGNS | 641.15 | - | | | | | | | | |
| | | | 4 | 4 | EA | PORTABLE ARROW BOARDS | 641.16 | - | | | | | | | | |
| | | | 119,000 | 119,000 | LF | DURABLE 6" WHITE LINE (MOD.-RETROREFLECTIVITY/INLAID) | 646.414 | 317 | | | | | | | | |
| | | | 93,100 | 93,100 | LF | DURABLE 6" YELLOW LINE (MOD.-RETROREFLECTIVITY/INLAID) | 646.415 | 73 | | | | | | | | |

| | | | |
|-------------------|---------------------------------|---------------|-----------------|
| PROJECT : | BOLTON - SO, BURLINGTON | PROJECT NO. : | AC IM 089-2(36) |
| DESIGN FILE NAME: | <u>/pave/04all4/p04all4.dgn</u> | PLOT DATE: | 14-JUN-2005 |
| IPARM FILE NAME: | <u>p04all4qs2.i</u> | SURVEY DATE: | |
| SURVEYED BY: | | DRAWN BY: | |
| SQUAD LEADER: | | SHEET: | 12 OF 76 |

| LOCATION | | | DROP INLETS | | | | | GUARDRAIL | | | | | | | | | | | | | | | REMARKS | |
|------------------------|-----------|-------|--------------|-------------------|----------------------------|-------------------|---------------------|-----------------------|--|-------------|-----------------|----------------|---------|--------------------------------|-----------------|------------------------------|--|---------------------|----------------------------------|-------------------------------------|--------------|-----------------------------|---|--|
| STATION | STATION | POS. | 203.15 | 203.16 | 301.35 | 604.40 | 604.42 | 203.99 | 608.41 | 616.35 | 621.20 | 621.21 | 621.505 | 621.52 | 621.60 | 621.65 | | 621.75 | 621.76 | 621.77 | 203.30 | 621.79 | | 621.80 |
| | | | COMM. EXCAV. | SOLID ROCK EXCAV. | SUBBASE OF DENSE CR. STONE | CHANGE ELEV. D.L. | REHAB. D.L. CLASS 1 | SHOULDER BERM REMOVAL | LOADER RENTAL FOR CABLE RAIL TYPE II(MOD.) | TIMBER CURB | STEEL BEAM G.R. | H.D. BEAM G.R. | M.T.S. | M.T.S. (TRAILING END TERMINAL) | ANCHOR FOR G.R. | ANCHOR FOR CABLE RAIL (MOD.) | | REMOVE & RESET G.R. | REPLACE GUARD RAIL POST ASSEMBLY | REPLACE GUARD RAIL BEAM UNIT (2.5') | EARTH BORROW | ADJUST HEIGHT OF GUARD RAIL | REMOVE & DISP. G.R. | |
| | | | CY | CY | CY | EA | EA | LF | HR | LF | LF | LF | EA | EA | EA | EA | | LF | EA | EA | CY | LF | LF | |
| INTERSTATE ROUTE 89 SB | | | | | | | | | | | | | | | | | | | | | | | | |
| 3780+68 | 4634+34 | LT&RT | | | | | | | | | | | | | | | | | | | 1,222 | | | |
| 3779+64 | 3788+35 | LT | | | | | | 87' | 9.5 | | | | | | | | | | | | | | TO BE USED TO CONSTRUCT MTS FLARES 18 OCT 05 1 CREW HR = 5 HR | |
| 3794+42 | 3809+78 | LT | | | | | | 1536' | 16.5 | | | | | | | | | | | | | | 18 OCT 05 ONE REFLECTOR = 5 J HOOKS 1 CREW HR J BOLT REFLECTOR | |
| 3796+53 | 3800+23 | RT | | | | | | 307' | 3.5 | | | | | | | | | | | | | | 14 OCT 05 0 + (5 X 4) 20 = 20 | |
| 3824+83 | 3841+46 | LT | | | | | | 1663' | | | | | | | | | | | | | | | 18 OCT 05 TRAILING END LOW 62.5' | |
| 3841+08.5 | 3841+46 | LT | | | | | | | | | | | | | | | | | | | | | 37.5' | |
| 3853+03 | 3868+60 | RT | | | | | | 1557' | | | | | | | | | | | | | | | 14 OCT 05 | |
| 3868+22.5 | 3868+60 | RT | | | | | | | | | | | | | | | | | | | | | 37.5' | |
| 3853+56 | 3871+56 | LT | | | | | | 950' | | | | | | | | | | | | | | | 17 & 18 OCT 05 | |
| 3853+82 | 3862+32 | LT | | | | | | | | | 170' | | | | | | | | | | | | 17 & 18 OCT 05 | |
| 3856+25 | | LT | | | | | | | | | | | | | | | | | | | | | | |
| 3858+84 | | LT | | | | | | | | | | | | | | | | | | | | | | |
| 3859+10 | | LT | | | | | | | | | | | | | | | | | | | | | | |
| 3871+18.5 | 3871+56 | LT | | | | | | | | | | | | | | | | | | | | | 37.5' | |
| 3883+44 | 3884+18 | LT | | | | | | 74' | | | | | | | | | | | | | | | 18 OCT 05 17 OCT 05 | |
| 3883+70 | 3884+18 | LT | | | | | | | | | 10' | | | | | | | | | | | | | 17 OCT 05 |
| 3883+44 | 3884+18 | RT | | | | | | 74' | | | | | | | | | | | | | | | | |
| 3885+55 | 3888+19 | LT | | | | | | | | | | | | | | | | | | | | | | |
| 3885+55 | 3886+34 | LT | | | | | | 210' | | | 16' | | | | | | | | | | | | 17 OCT 05 | |
| 3887+81.5 | 3888+19 | LT | | | | | | | | | | | | | | | | | | | | | 37.5' | |
| 3887+81.5 | 3889+06.5 | LT | | | | | | | | | 125' | | | | | | | | | | | | | 17 OCT 05 |
| 3889+06.5 | 3888+44 | LT | | | | | | | | | | | | | | | | | | | | | | 17 OCT 05 |
| 3885+55 | 3887+23.5 | RT | | | | | | | | | | | | | | | | | | | | | | 13 OCT 05 |
| 3887+23.5 | 3887+61 | RT | | | | | | | | | | | | | | | | | | | | | | 13 OCT 05 |
| 3887+23.5 | 3889+86 | RT | | | | | | | | | 262.5' | | | | | | | | | | | | | MATCH EXISTING S-BEAM @ 3887+23.5 RT 13 OCT 05 |
| 3889+86 | 3890+23.5 | RT | | | | | | | | | | | | | | | | | | | | | | 13 OCT 05 |
| 3892+36 | 3895+85 | LT | | | | | | 349' | 4.5 | | | | | | | | | | | | | | | 18 OCT 05 5 MAN HR - 1HR OF TIME |
| 3901+39 | 3902+66 | LT | | | | | | 127' | | | | | | | | | | | | | | | | 17 OCT 05 ADDED 12.5 ADJ FOR 6" BOLT ON BRIDGE |
| 3902+40 | 3902+66 | LT | | | | | | | | | 26' | | | | | | | | | | | | | 17 OCT 05 |
| 3902+40 | 3903+19 | RT | | | | | | 79' | | | 27' | | | | | | | | | | | | | 17 OCT 05 |
| 3905+62 | 3908+88.5 | LT | | | | | | 132' | | | | | | | | | | | | | | | | 13 OCT 05 |
| 3905+62 | 3907+94 | LT | | | | | | | | | 47' | | | | | | | | | | | | | |
| 3907+94 | | LT | | | | | | | | | | | | | | | | | | | | | | |
| 3908+88.5 | 3909+26 | LT | | | | | | | | | | | | | | | | | | | | | | 37.5' |
| 3905+83 | 3910+26 | RT | | | | | | 232' | | | | | | | | | | | | | | | | 13 OCT 05 |
| 3905+83 | 3907+94 | RT | | | | | | | | | 42' | | | | | | | | | | | | | |
| 3910+26 | 3910+63.5 | RT | | | | | | | | | | | | | | | | | | | | | | 37.5' |
| SHEET 09 TOTALS | | | | | | | 3 | 8,162' | 16.20 | 31' | 387.5' | | 6.7 | | 32.71 | | | | | | 1,222 | 1874' | 262.5' | 837.5 |

**ITEM
DETAIL
SHEET 1**

PROJECT NAME: BOLTON - SO. BURLINGTON
PROJECT NUMBER: AC IM 089-2(36)
FILE NAME: /pave/04a14/p04a14.dgn
PROJECT LEADER:
DESIGNED BY:
IPARM NAME: p04a14i1

PLOT DATE: 17-MAY-2005
DRAWN BY:
CHECKED BY:
SHEET 15 OF 76

| LOCATION | | | DROP INLETS | | | | | | | GUARDRAIL | | | | | | | | | | REMARKS | | | | | | |
|------------------|-----------|------|---------------------------|-----------------------------------|--|-----------------------------------|--------------------------------------|---------------------------------------|---|--------------------------|---------------------------------|--------------------------------|-------------------|---|---------------------------------|--|-------------------------------------|--|--|---------|--|---|-------------------------------------|---|--|--|
| STATION | STATION | POS. | 203.15 COMM. EXCAV. | 203.16 SOLID ROCK EXCAV. | 301.35 SUBBASE OF DENSE CR. STONE | 604.40 CHANGE ELEV. D.J. | 604.412 REHAB. D.J. CLASS I | 203.99 SHOULDER BERM REMOVAL | 608.41 LOADER RENTAL FOR CABLE RAIL, TYPE HR | 616.35 TIMBER CURB | 621.20 STEEL BEAM G.R. | 621.21 H.D. BEAM G.R. | 621.505 M.T.S. | 621.52 M.T.S. (TRAILING END TERMINAL) | 621.60 ANCHOR FOR G.R. | 621.66 ANCHOR FOR CABLE RAIL (MOD.) | 621.75 REMOVE & RESET G.R. | 621.76 REPLACE GUARD RAIL POST ASSEMBLY | 621.77 REPLACE GUARD RAIL BEAM UNIT (12.5') | | 203.30 EARTH BORROW FOR FLARE CY | 621.79 ADJUST HEIGHT OF GUARD RAIL | 621.80 REMOVE & DISP. G.R. | | | |
| INTERSTATE ROUTE | 89 SB | | CY | CY | CY | EA | EA | LF | HR | LF | LF | LF | EA | EA | EA | EA | LF | EA | EA | EA | CY | LF | LF | | | |
| 3907+94 | | RT | | | | | I | | | | | | | | | | | | | | | | | | | |
| 3937+51 | 3941+10 | LT | | | | | | 359' | | | | | | | | | | -12 | -6 | 8 | | 12 | 37.5 | 17 OCT 05 | | |
| 3941+10 | 3941+47.5 | LT | | | | | | | | | | | | | | | | | | | | | 37.5 | 17 OCT 05 | | |
| 3980+86 | 4016+50 | LT | | | | | | 3,564' | -36 | 50 | | | | | | | | | | | | | | 12 & 17 OCT 05 REFLECTORS... 19 J HOOK + (5 X 11) 55 = 74 | | |
| 4025+21 | 4027+74 | RT | | | | | | 253' | | | | | | | | | | | | | | | | 22 SEP 05 | | |
| 4027+74 | 4028+11.5 | RT | | | | | | | | | | | | | | | | | | | | | 37.5' | 22 SEP 05 | | |
| 4027+74 | 4030+74 | RT | | | | | | | | | 300' | | | | | | | | | | | | | 22 SEP 05 | | |
| 4030+74 | 4031+11.5 | RT | | | | | | | | | | | | | | | | | | | 14 | | | 22 SEP 05 FLARECONS 6 OCT 05 | | |
| 4025+95 | 4028+00.5 | LT | | | | | | 205.5' | | | | | | | | | | | | | | | | 12 OCT 05 | | |
| 4028+00.5 | 4030+25.5 | LT | | | | | | | | | 225' | | | | | | | | | | | | | 12 OCT 05 | | |
| 4030+25.5 | 4030+63 | LT | | | | | | | | | | | | | | | | | | | | | | 12 OCT 05 | | |
| 4036+24 | 4038+77.5 | LT | | | | | | 253.5' | | | | | | | | | | | | | | | | 12 OCT 05 BCT HD 2-25' SECTIONS REPLACE W/ MTS & 12-6 BEAM UNIT | | |
| 4038+77.5 | 4039+15 | LT | | | | | | | | | | | | | | | | | | | | | 37.5' | 12 OCT 05 | | |
| 4045+01 | 4053+40 | RT | | | | | | 839' | -9 | 6 | | | | | | | | | | | | | | 22 SEP 05 J-HOOK REFLECTOR... 4 + (5X3) 15 = 19 | | |
| 4052+88 | 4069+51 | LT | | | | | | 1610' | | | | | | | | | | | | | | | | 11 & 12 OCT 05 | | |
| 4068+98 | 4069+51 | LT | | | | | | | | | 53' | | | | | | | | | | | | | | 11 OCT 05 | |
| 4069+38 | | LT | | | | | | | | | | | | | | | | | | | | | | | | |
| 4068+98 | 4069+51 | RT | | | | | | 53' | | | | | | | | | | | | | | | | | | |
| 4071+36 | 4076+26.5 | LT | | | | | | 490.5' | | | | | | | | | | | | | | | | | 11 OCT 05 | |
| 4071+36 | 4071+88 | LT | | | | | | 52' | | | | | | | | | | | | | | | | | 11 OCT 05 | |
| 4071+88 | | LT | | | | | | | | | | | | | | | | | | | | | | | | |
| 4076+26.5 | 4076+64 | LT | | | | | | | | | | | | | | | | | | | | | | 37.5 | 11 OCT 05 | |
| 4071+62 | 4074+67.5 | RT | | | | | | 305.5' | | | | | | | | | | | | | | | | | 22 SEP 05 | |
| 4074+67.5 | 4075+05 | RT | | | | | | | | | | | | | | | | | | | | | | 37.5 | 22 SEP 05 | |
| 4074+67.5 | 4075+92.5 | RT | | | | | | | | | 125' | | | | | | | | | | | | | | 22 SEP 05 | |
| 4075+92.5 | 4076+30 | RT | | | | | | | | | | | | | | | | | | | | | | | 22 SEP 05 FLARECONS 6 OCT 05 | |
| 4085+40 | 4108+10 | LT | | | | | | 2270' | -23 | 10 | | | | | | | | | | | | | | | 11 OCT 05 J-HOOK REF... 16 + (5X4) 20 = 36 | |
| 4136+04 | 4137+14 | LT | | | | | | 110' | | | | | | | | | | | | | | | | | 11 OCT 05 | |
| 4136+83 | | LT | | | | | | | | | | | | | | | | | | | | | | | | |
| 4136+83 | 4137+14 | LT | | | | | | | | | 31' | | | | | | | | | | | | | | 11 OCT 05 | |
| 4136+83 | 4137+14 | RT | | | | | | 111' | | | | | | | | | | | | | | | | | 11 OCT 05 | |
| 4140+05 | 4141+63 | LT | | | | | | 158' | | | | | | | | | | | | | | | | | 11 OCT 05 RAISE GR FROM BULLNOSE AT RAMP D TO ML BRIDGE (150 LF) | |
| 4140+31 | | LT | | | | | | | | | | | | | | | | | | | | | | | | |
| 4140+31 | 4143+22 | RT | | | | | | 291' | | | | | | | | | | | | | | | | | | |
| 4142+95 | | LT | | | | | | | | | | | | | | | | | | | | | | | | |
| 4146+07 | 4152+67 | LT | | | | | | 660' | | | | | | | | | | | | | | | | | 7 OCT 05 | |
| SHEET 10 TOTALS | | | | | | | 6 | 11,585' | 68 | 84' | 650' | | 6 | | | 251 | | 247 | 81 | | | | 891' | 150' | | |

| | | |
|------------------------------------|---------------------------------------|------------------------|
| ITEM DETAIL SHEET 2 | PROJECT NAME: BOLTON - SO. BURLINGTON | PLOT DATE: 17-MAY-2005 |
| | PROJECT NUMBER: AC IM 089-2(36) | DRAWN BY: |
| | FILE NAME: /pave/04all4/p04all4.dgn | CHECKED BY: |
| | PROJECT LEADER: | SHEET 16 OF 76 |

| LOCATION | | | GUARDRAIL | | | | | | | | | | | | | | | | | | | REMARKS | | |
|------------------|-----------|------|--------------|-------------|----------------------------|----------|------------|-----------------------|---|-------------|-----------------|----------------|---------|--------------------------------|-----------------|------------------------------|---------------------|----------------------------------|-------------------------------------|-----------------------------|---------------------|--------------|------------------------|--|
| STATION | STATION | POS. | 203.45 | 203.31 | 301.35 | 601.0915 | 601.7015 | 203.99 | 608.41 | 616.35 | 621.20 | 621.21 | 621.505 | 621.52 | 621.60 | 621.65 | 621.75 | 621.76 | 621.77 | 621.79 | 621.80 | | 203.30 | 203.40 |
| | | | COMM. EXCAV. | SAND BORROW | SUBBASE OF DENSE CR. STONE | 18" CPEP | 18" CPEPES | SHOULDER BERM REMOVAL | LOADER RENTAL FOR CABLE RAIL TYPE II (MOD.) | TIMBER CURB | STEEL BEAM G.R. | H.O. BEAM G.R. | M.T.S. | M.T.S. (TRAILING END TERMINAL) | ANCHOR FOR G.R. | ANCHOR FOR CABLE RAIL (MOD.) | REMOVE & RESET G.R. | REPLACE GUARD RAIL POST ASSEMBLY | REPLACE GUARD RAIL BEAM UNIT (2.5') | ADJUST HEIGHT OF GUARD RAIL | REMOVE & DISP. G.R. | EARTH BORROW | FINE GRADING SUB-GRADE | |
| INTERSTATE ROUTE | 89 SB | | CY | CY | CY | LF | EA | LF | HR | LF | LF | LF | EA | EA | EA | EA | LF | EA | EA | LF | LF | CY | SY | |
| 4146+07 | 4146+60 | RT | | | | | | 53' | | | | | | | | | | | -2 | 6+ | 37.5 | | | 6 OCT 05 |
| 4146+60 | 4147+12 | RT | | | | | | | | | | | | | | | | | | | | 127.52' | | 6 OCT 05 |
| 4146+60 | 4152+60 | RT | | | | | | | | | 600' | 550 | | | | | | | 2 | 2 | | | | 6 OCT 05 |
| 4148+97 | 4151+93 | CL | 370 | | | | | | | | | | | | | | | | | | | | | REMOVAL OF EXISTING U-TURN |
| 4151+93 | 4152+45 | RT | | | | | | | | | | | | | | | | | | | | 212.5 | | 6 OCT 05 |
| 4152+45 | 4152+67 | RT | | | | | | 25' | | | | | | | | | | | | | | 37.5 | | 5 OCT 05 |
| 4158+93 | 4160+79.5 | LT | | | | | | 226.5' | | | | | | | | | | | -7 | 2-3 | -45' | | | 7 OCT 05 |
| 4160+79.5 | 4161+17 | LT | | | | | | | | | | | | | | | | | | | | 37.5' | | 7 OCT 05 |
| 4160+79.5 | 4161+79.5 | LT | | | | | | | | | 100' | | | | | | | | | | | | | 7 OCT 05 |
| 4161+79.5 | 4162+16 | LT | | | | | | | | | | | | | | | | | | | | | | 7 OCT 05 |
| 4158+79 | 4159+04 | RT | | | | | | 25' | | | | | | | | | | | | | | | | 5 OCT 05 |
| 4159+04 | 4160+38 | RT | | | | | | | | | | | | | | | | | | | | 165 | | 5 OCT 05 BULLNOSE IN MEDIAN |
| 4159+04 | 4163+04 | RT | | | | | | | | | 400' | | | | | | | | | | | | | 5 OCT 05 |
| 4161+79.5 | 4162+16 | LT | | | | | | | | | 50 | | | | | | | | | | | | | 5 OCT 05 |
| 4163+04 | 4163+41.5 | RT | | | | | | | | | | | | | | | | | | | | 13 | | 5 OCT 05 CONST FLARE 10/6/05 |
| 4167+72 | 4168+90 | LT | | | | | | 118' | | | | | | | | | | | | | | | | 5 OCT 05 |
| 4167+72 | 4168+52 | RT | | | | | | | | | | | | | | | | | | | | 190 | | 5 OCT 05 BULLNOSE IN MEDIAN |
| 4168+27 | 4168+39.5 | RT | | | | | | | | | | | | | | | | | | | | | | 4 OCT 05 |
| 4168+52 | 4168+77 | RT | | | | | | 25' | | | | | | | | | | | | | | | | 4 OCT 05 |
| 4170+67 | 4174+21 | LT | | | | | | 354' | | | | | | | | | | | | | | | | 30 SEPT |
| 4174+21 | 4174+58.5 | LT | | | | | | | | | | | | | | | | | | | | 37.5' | | 4 OCT 05 |
| 4170+67 | 4170+92 | RT | | | | | | 25' | | | | | | | | | | | | | | | | 4 OCT 05 |
| 4170+92 | 4171+94 | RT | | | | | | | | | | | | | | | | | | | | 178 | | 4 OCT 05 BULLNOSE IN MEDIAN |
| 4170+92 | 4174+92 | RT | | | | | | | | | 400' | | | | | | | | | | | | | 4 OCT 05 |
| 4174+92 | 4175+29.5 | RT | | | | | | | | | | | | | | | | | | | | | 9 | 4 OCT 05 5 OCT 05 FLARE |
| 4179+36 | 4199+34 | CL | | 39 | 156 | 60' | 2 | 311' | | | | | | | | | | | | | | 545 | 222 | SEE STD. B-17 FOR DETAILS 42' X 50' DIMENSION TO BE USED (TO CONSTRUCT NEW U-TURN) |
| 4196+23 | 4199+34 | LT | | | | | | | | | | | | | | | | | | | | 62' | | 5 OCT 05 FLARE |
| 4199+34 | 4199+71.5 | LT | | | | | | | | | | | | | | | | | | | | 37.5 | 10 | 5 OCT 05 FLARE |
| 4211+33 | 4219+41 | LT | | | | | | 808' | | | | | | | | | | | | | | | | 5 OCT 05 FLARE |
| 4219+41 | 4219+78.5 | LT | | | | | | | | | | | | | | | | | | | | 37.5' | | 5 OCT 05 FLARE |
| 4213+92 | 4228+81 | RT | | | | | | 1489' | | | 87.5 | | | | | | | | | | | | | 9/21/05 |
| 4228+01.5 | 4228+39 | LT | | | | | | | | | 12.5 | | | | | | | | | | | | | 9/21/05 |
| 4228+81 | 4229+18.5 | RT | | | | | | | | | | | | | | | | | | | | 37.5' | 4 | 4 OCT 05 FLARE |
| 4230+92 | 4233+24 | RT | | | | | | 1879' | | | | | | | | | | | | | | | | 9/13/05 |
| 4249+71 | 4250+08.5 | RT | | | | | | 647' | | | | | | | | | | | | | | | | 9/13/05 |
| 4301+88 | 4309+48 | LT | | | | | | 760' | | | | | | | | | | | | | | | | 9/6/05 POST INSTALLED 9/29/05 3 REFLECTORS X 5 = 15 + 3 J'S = 18 |
| 4301+88 | 4309+38 | RT | | | | | | 750' | | | | | | | | | | | | | | | | 4 OCT 05 |
| 4309+38 | 4309+75.5 | RT | | | | | | | | | | | | | | | | | | | | 37.5' | 5 | 4 OCT 05 FLARE |
| 4315+87 | 4318+09 | LT | | | | | | 222' | | | | | | | | | | | | | | | | 09/29/05 |
| 4318+09 | 4318+46.5 | LT | | | | | | | | | | | | | | | | | | | | | | 09/29/05 |
| SHEET # TOTALS | | | 370 | 39 | 156 | 60' | 2 | 5838.5' | 8 | | 1600 | | 10 | 2 | | 29 | | 204 | 73 | 944' | 906.5' | 545 | 222 | |

**ITEM
DETAIL
SHEET 3**

PROJECT NAME: BOLTON - SO. BURLINGTON
PROJECT NUMBER: AC IM 089-2(36)
FILE NAME: /pave/04all4/p04all4.dgn
PROJECT LEADER:
DESIGNED BY:
IPARM NAME: p04all4td3.1
PLOT DATE: 17-MAY-2005
DRAWN BY:
CHECKED BY:
SHEET 17 OF 76

| LOCATION | | | DROP INLETS | | | | | GUARDRAIL | | | | | | | | | | | | | REMARKS | | | | | | | |
|------------------|-----------|-------|-----------------|----------------------|-------------------------------|----------------------|------------------------|--------------------------|--|----------------|--------------------|-------------------|-----------|-----------------------------------|--------------------|---------------------------------|--|------------------------|-------------------------------------|--|----------------------------|--------------------------------|------------------------|--------|---|---|---|----------------------|
| STATION | STATION | POS. | 203.15 | 203.16 | 301.35 | 604.40 | 604.42 | 203.99 | 608.41 | 616.35 | 621.20 | 621.21 | 621.505 | 621.52 | 621.60 | 621.65 | | 621.75 | 621.76 | 621.77 | | 203.30 | 621.79 | 621.80 | | | | |
| INTERSTATE ROUTE | ROUTE | 89 SB | COMM. EXCAV. CY | SOLID ROCK EXCAV. CY | SUBBASE OF DENSE CR. STONE CY | CHANGE ELEV. D.I. EA | REHAB. D.I. CLASS I EA | SHOULDER BERM REMOVAL LF | LOADER RENTAL FOR CABLE RAIL TYPE II (MOD.) HR | TIMBER CURB LF | STEEL BEAM G.R. LF | H.D. BEAM G.R. LF | M.T.S. EA | M.T.S. (TRAILING END TERMINAL) EA | ANCHOR FOR G.R. EA | ANCHOR FOR CABLE RAIL (MOD.) EA | | REMOVE & RESET G.R. LF | REPLACE GUARD RAIL POST ASSEMBLY EA | REPLACE GUARD RAIL BEAM UNIT (2.5') EA | EARTH BORROW FOR FLARES CY | ADJUST HEIGHT OF GUARD RAIL LF | REMOVE & DISP. G.R. LF | | | | | |
| 4318+09 | 4324+21.5 | LT | | | | | | | | | 612.5' | | | | | | | | | | | | | | ATTACH TO EXISTING GUARDRAIL @ STA. 4318+09 9/29/05 | | | |
| 4324+21.5 | 4324+59 | LT | | | | | | | | | | | | | | | | | | | 10 | | | | 9/29/05 5 OCT 05 FLARE | | | |
| 4315+87 | 4320+20 | RT | | | | | | 433' | | | | | | | | | | | | | | | | | 3 OCT 05 | | | |
| 4320+20 | 4320+37.5 | RT | | | | | | | | | | | | | | | | | | | | | | 37.5' | 3 OCT 05 | | | |
| 4320+37.5 | 4320+87.5 | RT | | | | | | | | | 50' | | | | | | | | | | | | | | 3 OCT 05 | | | |
| 4320+87.5 | 4321+25 | RT | | | | | | | | | | | | | | | | | | | | | | | 3 OCT 05 4 OCT 05 FLARE | | | |
| 4333+51 | | LT | | | | | | | | | | | | | | | | | | | | | | | | | | |
| 4347+24 | 4363+55 | RT | | | | | | 1631' | | | | | | | | | | | | | | | | | 3 OCT 05 TRUCK W/ COMPRESSOR IN ACCIDENT W/ CAR BETWEEN EXIT 13 - EXIT 12 COMING TO WORKSITE CAR AT FAULT | | | |
| 4363+55 | 4363+92.5 | RT | | | | | | | | | | | | | | | | | | | | | | 37.5' | 28 SEPT 05 4 OCT 05 FLARE | | | |
| 4349+88 | 4359+27 | LT | | | | | | | | | | | | | | | | | | | | | | | 9/6/05 | | | |
| 4359+27 | 4359+64.5 | LT-RT | | | | | | | | | | | | | | | | | | | | | | 37.5' | 9/6/05 5 OCT 05 FLARE | | | |
| 4372+10 | 4386+20 | RT | | | | | | 1410' | | | | | | | | | | | | | | | | | 28 SEP 05 | | | |
| 4386+20 | 4386+57.5 | RT | | | | | | | | | | | | | | | | | | | | | | 37.5' | 28 SEP 05 4 OCT 05 FLARE | | | |
| 4377+60 | 4393+17 | LT | | | | | | 1557' | -16-6 | | | | | | | 2358- | | | | | | | | | 29 SEP 05 4 REFLECTORS X 5 = 20 + 3 J'S = 23 | | | |
| 4400+04 | 4405+63 | RT | | | | | | 559' | 6 | | | | | | | 2421 | | | | | | | | | 28 SEP 05 4 REFLECTORS X 5 = 20 J HOOKS + 4 J'S = 24 | | | |
| 4429+66 | 4432+03 | RT | | | | | | 237' | | | 12.5 | | | | | | | | | | | | | | 16 AUG 05 | | | |
| 4430+18 | 4432+03 | LT | | | | | | 185' | | | | | | | | | | | | | | | | | 31 JUL 05 | | | |
| 4433+70 | 4439+05 | LT | | | | | | 535' | | | | | | | | | | | | | | | | | 31 JUL 05 FLARE 9/30/05 | | | |
| 4439+05 | 4439+42.5 | LT-RT | | | | | | | | | | | | | | | | | | | | | | 37.5' | 31 JUL 05 FLARE 9/30/05 | | | |
| 4475+00.5 | 4475+13 | LT | | | | | | | | | 25 | | | | | | | | | | | | | | 25 12.5' | 27 JUL 05 | | |
| 4475+13 | 4477+28 | LT | | | | | | 215' | | | | | | | | | | | | | | | | | 43' | 28 JUL 05 | | |
| 4477+28 | 4479+90.5 | LT | | | | | | | | | 262.5' | | | | | | | | | | | | | | 37.5' | 27 & 28 JUL 05 | | |
| 4479+90.5 | 4480+28 | LT | | | | | | | | | | | | | | | | | | | | | | | 6 | 28 JUL 05 | | |
| 4476+07.5 | 4476+20 | RT | | | | | | | | | | | | | | | | | | | | | | | | -12.5' | 8/9/05 | |
| 4476+20 | 4477+55 | RT | | | | | | 135' | | | | | | | | | | | | | | | | | | | | |
| 4477+55 | 4477+92.5 | RT | | | | | | | | | | | | | | | | | | | | | | | | 25 -37.5' | 8/9/05 BROWNELL RD. | |
| 4477+55 | 4481+17.5 | RT | | | | | | | | | 362.5' | | | | | | | | | | | | | | | | | |
| 4481+17.5 | 4481+55 | RT | | | | | | | | | | | | | | | | | | | | | | | | 6 | 37.5 12.5' | 8/9/05 FLARE 9/30/05 |
| 4486+93.5 | 4487+07 | LT | | | | | | | | | | | | | | | | | | | | | | | | 25 12.5' | 8/9/05 | |
| 4487+07 | 4487+47 | LT | | | | | | 40' | | | | | | | | | | | | | | | | | | | | |
| 4486+55.5 | 4486+68 | RT | | | | | | | | | | | | | | | | | | | | | | | | 37.5 12.5' | | |
| 4486+68 | 4487+47 | RT | | | | | | 79' | | | | | | | | | | | | | | | | | | | | |
| 4488+00 | 4490+27 | LT | | | | | | 227' | | | | | | | | | | | | | | | | | | | | |
| 4490+27 | 4490+64.5 | LT | | | | | | | | | | | | | | | | | | | | | | | | 37.5' | 27 JUL 05 | |
| 4490+27 | 4491+27 | LT | | | | | | | | | 100 | | | | | | | | | | | | | | | | | |
| 4491+27 | 4491+64.5 | LT | | | | | | | | | | | | | | | | | | | | | | | | | | |
| SHEET 12 TOTALS | | | | | | | | 7243' | 22 | | 1425 1387.5' | | 9 | 4-6 | | 79 | | | 225 | 148 | | | | 1609' | 337.5' | 27 JUL 05 27 JUL 05 27 JUL 05 ITEM DETAIL SHEET 4 | PROJECT NAME: BOLTON - SO. BURLINGTON PROJECT NUMBER: AC IM 089-2(36) FILE NAME: /pave/04d114/p04d114.dgn PROJECT LEADER: DESIGNED BY: IPARM NAME: p04d114d1 | |

PROJECT NAME: BOLTON - SO. BURLINGTON
PROJECT NUMBER: AC IM 089-2(36)
FILE NAME: /pave/04d114/p04d114.dgn
PROJECT LEADER:
DESIGNED BY:
IPARM NAME: p04d114d1

PLOT DATE: 17-MAY-2005
DRAWN BY:
CHECKED BY:
SHEET 18 OF 76

| LOCATION | | | DROP INLETS | | | | | GUARDRAIL | | | | | | | | | | | | | REMARKS | | | |
|------------------|-----------|------|--------------|-------------------|-------------|------------------------|----------------------------|-----------------------|---|-------------|-----------------|----------------|---------|--------------------------------|-----------------|------------------------------|--|---------------------|----------------------------------|-------------------------------------|--------------|-----------------------------|---------------------|--|
| STATION | STATION | POS. | 203.15 | 203.16 | 203.31 | 203.40 | 301.35 | 203.99 | 608.41 | 616.35 | 621.20 | 621.21 | 621.505 | 621.52 | 621.60 | 621.65 | | 621.75 | 621.76 | 621.77 | | 203.30 | 621.79 | 621.80 |
| | | | COMM. EXCAV. | SOLID ROCK EXCAV. | SAND BORROW | FINE GRADING SUB-GRADE | SUBBASE OF DENSE CR. STONE | SHOULDER BERM REMOVAL | LOADER RENTAL FOR CABLE RAIL TYPE II (MOD.) | TIMBER CURB | STEEL BEAM G.R. | H.D. BEAM G.R. | M.T.S. | M.T.S. (TRAILING END TERMINAL) | ANCHOR FOR G.R. | ANCHOR FOR CABLE RAIL (MOD.) | | REMOVE & RESET G.R. | REPLACE GUARD RAIL POST ASSEMBLY | REPLACE GUARD RAIL BEAM UNIT (2.5') | EARTH BORROW | ADJUST HEIGHT OF GUARD RAIL | REMOVE & DISP. G.R. | |
| INTERSTATE ROUTE | 89 SB | | CY | CY | CY | SY | CY | LF | HR | LF | LF | LF | EA | EA | EA | EA | | LF | EA | EA | | LF | LF | |
| 4488+79 | 4490+80 | RT | | | | | | 201' | | | | | | | | | | | | | | | | |
| 4490+80 | 4491+17.5 | RT | | | | | | | | | | | | | | | | | | | | | | |
| 4490+80 | 4493+05 | RT | | | | | | | | | 225' | | | | | | | | | | | | | 37.5' |
| 4493+05 | 4493+42.5 | RT | | | | | | | | | | | | | | | | | | | | | | 37.5' |
| 4535+47 | 4542+91 | LT | | | | | | 744' | 8-3 | | | | | | | 28 | | | | | 6 | | | 37.5' |
| 4549+19.5 | 4549+32 | LT | | | | | | | | | | | | | | | | | | | | | | 12.5'-37.5' |
| 4549+32 | 4550+66 | LT | | | | | | 134' | | | 37.5 | 25+12.5 | | | | | | | | | | | | 27 JUL 05 |
| 4550+66 | 4551+03.5 | LT | | | | | | | | | | | | | | | | | | | | | | 37.5' |
| 4550+66 | 4553+28.5 | LT | | | | | | | | | 262.5' | | | | | | | | | | | | | 26 JUL 05 |
| 4553+28.5 | 4553+66 | LT | | | | | | | | | | | | | | | | | | | 6 | | | 37.5' |
| 4549+46 | 4551+04 | RT | | | | | | | | | | | | | | | | | | | | | | 357' 158' |
| 4549+45.5 | 4549+58 | RT | | | | | | | | | | | | | | | | | | | | | | 8 AUG 05 |
| 4553+87 | 4554+00 | LT | | | | | | | | | | | | | | | | | | | | | | 8 AUG 05 |
| 4549+58 | 4553+58 | RT | | | | | | | | 425 | 400' | | | | | | | | | | | | | 8 AUG 05 |
| 4554+00 | 4558+00 | LT | | | | | | | | | 400 | | | | | | | | | | | | | 8 AUG 05 |
| 4553+58 | 4553+35.5 | RT | | | | | | | | | | | | | | | | | | | | | | 8 AUG 05 |
| 4558+00 | 4558+37.5 | LT | | | | | | | | | | | | | | | | | | | 6 | | | 8 AUG 05 |
| 4557+70 | 4557+70 | LT | | | | | | | | | | | | | | | | | | | | | | 8 AUG 05 |
| 4595+58 | 4602+58 | RT | 817 | | 182 | 1,089 | 726 | | | | | | | | | | | | | | | | | ITEM USED TO KNOCK TOP OF HEADWALL DOWN TO GRADE |
| 4602+30.5 | 4602+43 | LT | | | | | | | | | | | | | | | | | | | 228.9 | | | ITEMS TO BE USED FOR SHOULDER WIDENING |
| 4602+43 | 4602+84 | LT | | | | | | 41' | | | | | | | | | | | | | | | | EXIT I3 RAMP A (SB ON RAMP) FAIR CONSTRUCTED 28 SEP 05 |
| 4602+05 | 4602+67.5 | RT | | | | | | | | | | | | | | | | | | | | | | 8 AUG 05 |
| 4602+67.5 | 4602+80 | RT | | | | | | | | | | | | | | | | | | | | | | 8 AUG 05 |
| 4602+80 | 4603+05 | RT | | | | | | 25' | | | | | | | | | | | | | | | | 8 AUG 05 |
| 4604+95 | 4605+50 | RT | | | | | | 25' | | | | | | | | | | | | | | | | 8 AUG 05 |
| 4605+20 | 4606+22 | RT | | | | | | | | | | | | | | | | | | | | | | 162.5' 102' |
| 4605+20 | 4609+20 | RT | | | | | | | | | 400' | | | | | | | | | | | | | 7 AUG 05 |
| 4609+20 | 4609+57.5 | RT | | | | | | | | | | | | | | | | | | | | | | 7 AUG 05 |
| 4609+64.5 | 4609+77 | LT | | | | | | | | | 12.5 | | | | | | | | | | | | | 25' 12.5' |
| 4609+77 | 4613+35 | LT | | | | | | 358' | | | | | | | | | | | | | | | | 26 JUL 05 |
| 4612+29 | 4613+41 | RT | | | | | | | | | | | | | | | | | | | | | | 127' 112' |
| 4613+28.5 | 4613+41 | RT | | | | | | | | | | | | | | | | | | | | | | 25 |
| 4613+41 | 4613+66 | RT | | | | | | 25' | | | | | | | | | | | | | | | | 7 AUG 05 |
| 4615+25 | 4620+88.5 | LT | | | | | | 564' | | | | | | | | | | | | | | | | 5' |
| 4620+88.5 | 4621+26 | LT | | | | | | | | | | | | | | | | | | | | | | 113' 50' |
| 4621+26 | 4622+76 | LT | | | | | | | | | 200-154' | | | | | | | | | | | | | 37.5' |
| 4622+76 | 4623+13.5 | LT | | | | | | | | | | | | | | | | | | | | | | 26 JUL 05 |
| 4615+51 | 4615+76 | RT | | | | | | 25' | | | | | | | | | | | | | | | | 17 |
| 4615+76 | 4616+57 | RT | | | | | | | | | | | | | | | | | | | | | | 5' |
| 4615+76 | 4623+88.5 | RT | | | | | | | | | 812.5 | | | | | | | | | | | | | 225' 181' |
| 4615+76 | 4624+01 | RT | | | | | | | | | 277.5 | | | | | | | | | | | | | 26 JUL 05 |
| SHEET 13 TOTALS | | | 817 | 1 | 182 | 1,089 | 726 | 2142' | 8 | | 2262.5' | | 5-6 | 6-7 | | 28 | | | | | | | | 430' |

**ITEM
DETAIL
SHEET 5**

PROJECT NAME: BOLTON - SO. BURLINGTON
PROJECT NUMBER: AC IM 089-2(36)
FILE NAME: /pave/04all4/p04all4.dgn
PROJECT LEADER:
DESIGNED BY:
IPARM NAME: p04all4id5.i
PLOT DATE: 17-MAY-2005
DRAWN BY:
CHECKED BY:
SHEET 19 OF 76

| LOCATION | | | DROP INLETS | | | | | GUARDRAIL | | | | | | | | | | | | | | REMARKS | | | | |
|------------------------|-----------|------|---------------------------|-----------------------------------|--|-----------------------------------|-------------------------------------|---------------------------------------|---|--------------------------|---------------------------------|--------------------------------|-------------------|---|---------------------------------|--|-------------------------------------|--|---|---|---|---------|-------------------------------------|-----------|----------|------------------------------------|
| STATION | STATION | POS. | 203.15 COMM. EXCAV. | 203.16 SOLID ROCK EXCAV. | 301.35 SUBBASE OF DENSE CR. STONE | 604.40 CHANGE ELEV. D.I. | 604.42 REHAB. D.I. CLASS I | 203.99 SHOULDER BERM REMOVAL | 608.41 LOADER RENTAL FOR CABLE RAIL TYPE II (MOD.) | 616.35 TIMBER CURB | 621.20 STEEL BEAM G.R. | 621.21 H.D. BEAM G.R. | 621.505 M.T.S. | 621.52 M.T.S. (TRAILING END TERMINAL) | 621.60 ANCHOR FOR G.R. | 621.65 ANCHOR FOR CABLE RAIL (MOD.) | 621.75 REMOVE & RESET G.R. | 621.76 REPLACE GUARD RAIL POST ASSEMBLY | 621.77 REPLACE GUARD RAIL BEAM UNIT (2.5') | 203.30 EARTH BORROW FOR FLARES | 621.79 ADJUST HEIGHT OF GUARD RAIL | | 621.80 REMOVE & DISP. G.R. | | | |
| INTERSTATE ROUTE 89 SB | | | CY | CY | CY | EA | EA | LF | HR | LF | LF | LF | EA | EA | EA | EA | LF | EA | EA | EA | | LF | LF | | | |
| 4624+01 | 4624+38.5 | RT | | | | | | | | | | | I | | | | | | | | | | | | | |
| 4618+68 | 4620+26 | RT | | | | | | | | | | | | | | | | | | | | | 158' | | | |
| INTERSTATE ROUTE 89 NB | | | | | | | | | | | | | | | | | | | | | | | | | | |
| 3900+46 | 3900+83.5 | LT | | | | | | | | | | | I | | | | | | | | 45 CY | | | 9/7/05 | | |
| 3900+83.5 | 3902+08.5 | LT | | | | | | | | | 125' | | | | | | | | | | | | | 9/7/05 | | |
| 3901+71 | 3902+08.5 | LT | | | | | | | | | | | | | | | | | | | | | 37.5' | 9/7/05 | | |
| 3902+08.5 | 3905+14 | LT | | | | | | 305.5' | | | | | | | | | | -10-4 | -5-6 | | | -6'-25" | | 9/7/05 | | |
| 4019+75 | 4020+12.5 | LT | | | | | | | | | | | I | | | | | | | | 45 CY | | | 9/8/05 | | |
| 4020+12.5 | 4021+62.5 | LT | | | | | | | | | 150' | | | | | | | | | | | | | 9/7/05 | | |
| 4021+50 | 4021+62.5 | LT | | | | | | | | | | | | | | | | | | | | | 37.5' | 9/7/05 | | |
| 4021+62.5 | 4025+53 | LT | | | | | | 390.5' | | | | | | | | | | | | | | | 78' | 9/8/05 | | |
| 4062+42 | 4064+79.5 | LT | | | | | | | | | | | I | | | | | | | | 48 CY | | | 9/8/05 | | |
| 4064+79.5 | 4066+29.5 | LT | | | | | | | | | 150' | | | | | | | | | | | | | 37.5' | 9/8/05 | |
| 4064+79.5 | 4065+92 | LT | | | | | | | | | | | | | | | | | | | | | | | 9/8/05 | |
| 4065+92 | 4069+09 | LT | | | | | | 317' | | | | | | | | | | | | | | | -6'-12.5" | | 9/8/05 | |
| 4133+28 | 4133+65.5 | LT | | | | | | | | | | | I | | | | | | | | 28 CY | | | | 9/19/05 | |
| 4133+65.5 | 4135+40.5 | LT | | | | | | | | | 175' | | | | | | | | | | | | | | 9/8/05 | |
| 4135+03 | 4135+40.5 | LT | | | | | | | | | | | | | | | | | | | | | 37.5' | 9/8/05 | | |
| 4135+40.5 | 4137+99 | LT | | | | | | 258.5' | | | | | | | | | | | | | | | | | | |
| 4140+84 | 4143+27 | LT | | | | | | 243' | | | | | | | | | | | | | | | | | | |
| 4146+01 | 4146+26 | LT | | | | | | 25' | | | | | | | | | | | | | | | | | | |
| 4146+26 | 4146+91 | LT | | | | | | 65' | | | | | | | | | | | | | | | | | | |
| 4146+26 | 4152+51 | LT | | | | | | | | | 650 625' | | | | | | | | | | | | | | | |
| 4159+11 | 4159+90 | LT | | | | | | | | | | | | | | | | | | | | | | 79'-37.5' | 9/20/05 | BULLNOSES WILL BE REMOVED W/ SB GR |
| 4159+11 | 4159+23.5 | LT | | | | | | | | | | | | | | | | | | | | | | | 9/20/05 | |
| 4163+82.5 | 4164+20 | LT | | | | | | | | | | | | | | | | | | | 42 CY | | | | 21SEP 05 | |
| 4164+20 | 4168+20 | LT | | | | | | | | | 375 400' | | | | | | | | | | | | | | | |
| 4167+24 | 4168+20 | LT | | | | | | | | | | | | | | | | | | | | | | 96'-12.5' | 21SEP 05 | BULLNOSES WILL BE REMOVED W/ SB GR |
| 4168+20 | 4168+45 | LT | | | | | | 25' | | | | | | | | | | | | | | | | | 21SEP 05 | 2 - 10 GA PANEL REPLACED + 5 POSTS |
| 4169+93 | 4170+18 | LT | | | | | | | | | | | | | | | | | | | | | | | | |
| 4170+18 | 4170+30.5 | LT | | | | | | | | | | | | | | | | | | | | | | | | |
| 4170+18 | 4171+20 | LT | | | | | | | | | | | | | | | | | | | | | | | | |
| 4311+17 | 4315+67 | LT | | | | | | 450' | | | | | | | | | | | | | | | | | | |
| 4426+51.5 | 4426+89 | LT | | | | | | | | | | | | | | | | | | | | | | | 3 OCT 05 | |
| SHEET 14 TOTALS | | | | | | | | 2079.5' | | | 1625' | | -6-7 | 2 | | | 68 | 32 | | | | | 421' | 585' | | |

| | | |
|------------------------------------|---------------------------------------|------------------------|
| ITEM DETAIL SHEET 6 | PROJECT NAME: BOLTON - SO. BURLINGTON | PLOT DATE: 17-MAY-2005 |
| | PROJECT NUMBER: AC IM 089-2(36) | DRAWN BY: |
| | FILE NAME: /pave/04all4/p04all4.dgn | CHECKED BY: |
| | PROJECT LEADER: | SHEET 20 OF 76 |
| | DESIGNED BY: | |
| | IPARM NAME: p04all4id6.l | |

| LOCATION | | | DROP INLETS | | | | | GUARDRAIL | | | | | | | | | | | | | REMARKS | | | | | | |
|--------------------|-------------------------------|------|---------------------------|--------------------------|--|-----------------------------------|--------------------------------------|---------------------------------------|---|--------------------------|---------------------------------|--------------------------------|-------------------|---|---------------------------------|--|-------------------------------------|--|---|--|---------|---|-------------------------------------|---|----------------------------|----------------------------|--------------------------|
| STATION | STATION | POS. | 203.15 COMM. EXCAV. | 203.31 SAND BORROW | 301.35 SUBBASE OF DENSE CR. STONE | 604.40 CHANGE ELEV. D.J. | 604.412 REHAQ. D.J. CLASS I | 203.99 SHOULDER BERM REMOVAL | 608.41 LOADER RENTAL FOR CABLE RAIL TYPE II (MOD.) | 616.35 TIMBER CURB | 621.20 STEEL BEAM G.R. | 621.21 H.D. BEAM G.R. | 621.505 M.T.S. | 621.52 M.T.S. (TRAILING END TERMINAL) | 621.60 ANCHOR FOR G.R. | 621.65 ANCHOR FOR CABLE RAIL (MOD.) | 621.75 REMOVE & RESET G.R. | 621.76 REPLACE GUARD RAIL POST ASSEMBLY | 621.77 REPLACE GUARD RAIL BEAM UNIT (2.5') | 203.30 EARTH BORROW FOR FLARES | | 621.79 ADJUST HEIGHT OF GUARD RAIL | 621.80 REMOVE & DISP. G.R. | | | | |
| INTERSTATE ROUTE | 89 NB | | CY | CY | CY | EA | EA | LF | HR | LF | LF | LF | EA | EA | EA | EA | LF | EA | EA | CY | LF | LF | | | | | |
| 4426+89 | 4427+39 4426+39 | LT | | | | | | | | -150' | 150 | | | | | | | | | | | | 31 JUL 05 | | | | |
| 4428+01.5 | 4428+39 | LT | | | | | | | | | 12.5 | | | I | | | | | | | | | 37.5' | 1 AUG 05 | | | |
| 4428+39 | 4431+24 | LT | | | | | | 285' | | | | | | | | | | 9-0 | 4-5 | | | 57-62.5 | EXIT 12 1 AUG 05 | | | | |
| 4432+88 | 4439+42 | LT | | | | | | 654' | | | | | | | | | | | | | | | | | | | |
| 4473+80 | 4475+38 | LT | | | | | | 158' | | | 225 | | I | | | | | | | II | | 32' | 37.5 | UNDER PASS MM 84.75 LEADING 1 AUG 05 30 OCT FLARE | | | |
| 4475+38 | 4475+50.5 | LT | | | | | | | | | 12.5 | | | I | | | | | | | | 37.5 | 12.5-25 | UNDER PASS MM 84.75 TRAILING 1 AUG 05 | | | |
| 4481+26 | 4481+63.5 | LT | | | | | | | | | | | I | | | | | | | II | | | | | 3 OCT 05 FLARE | | |
| 5 | 7 | LT | | | | | | | | | 225' | | | | | | | | | | | | | | NB 84.87 | | |
| 4483+51 | 4483+88.5 | LT | | | | | | | | | | | | | | | | | | | | | 37.5' | | NB 84.91 | | |
| 4483+88.5 | 4485+92 | LT | | | | | | 203.5' | | | | | | | | | | | | | | | | | 18 NOV 05 | | |
| 4488+53 | 4489+32 | LT | | | | | | 79' | | | | | | I | | | | | | | | | | | | | |
| 4546+20.5 | 4546+58 | LT | | | | | | | | | | | | I | | | | | | II | | | | | 3 OCT 05 FLARE 2 AUG 05 GR | | |
| 4546+58 | 4550+58 | LT | | | | | | | | | 400' | | | | | | | | | | | | | | | 2 AUG 05 | |
| 4550+58 | 4550+70.5 | LT | | | | | | | | | | | | | | | | | | | | | | | | | |
| 4549+30 | 4550+89 | LT | | | | | | | | | | | | | | | | | | | | | | 159' | | | |
| 4599+32.5 | 4599+70 | LT | | | | | | | | | | | | I | | | | | | | II | | | | 3 OCT 05 FLARE 8 AUG 05 GR | | |
| 4599+70 | 4603+70 | LT | | | | | | | | | 400' | | | | | | | | | | | | | | | 3 AUG 05 | |
| 4603+70 | 4603+95 | LT | | | | | | 25' | | | | | | | | | | | | | | | | | | 3 AUG 05 | |
| 4602+63 | 4603+70 | LT | | | | | | | | | | | | | | | | | | | | | | | | 107-87.5 3 AUG 05 | |
| 4605+53 | 4605+78 | LT | | | | | | 25' | | | | | | | | | | | | | | | | | | | |
| 4605+78 | 4606+54 | LT | | | | | | | | | | | | | | | | | | | | | | | | | |
| 4605+78 | 4605+90.5 | LT | | | | | | | | | | | | | | | | | | | | | | | | 3 AUG 05 | |
| 9 | 4606+03.5 | LT | | | | | | | | | | | | I | | | | | | II | | | | | | 3 OCT 05 FLARE 4 AUG 05 GR | |
| 4609+41 | 4613+41 | LT | | | | | | | | | 400' | | | | | | | | | | | | | | | | BRIDGE 66 N 3 & 4 AUG 05 |
| 4612+66 | 4613+41 | LT | | | | | | | | | | | | | | | | | | | | | | | | | 75-62.5 3 AUG 05 |
| 4613+41 | 4613+41 | LT | | | | | | 25' | | | | | | | | | | | | | | | | | | | |
| 4615+51 | 4619+26 | LT | | | | | | 375' | | | | | | | | | | | | | | | | | | | |
| 4472+34 | 4472+71.5 | LT | | | | | | | | | | | | | I | | | | | | | | | | | | 1 AUG 05 |
| SHEET 15 TOTALS | | | | | | | | 1,829.5' | | 150' | 1825 | | | 6 | 5 | | | 60 | 26 | | | 367' | 504.5' | | | | |

| | |
|------------------------------------|---------------------------------------|
| ITEM DETAIL SHEET 7 | PROJECT NAME: BOLTON - SO. BURLINGTON |
| | PROJECT NUMBER: AC IM 089-2(36) |
| | FILE NAME: /pave/04all4/p04all4.dgn |
| | PROJECT LEADER: |
| DESIGNED BY: | PLOT DATE: 17-MAY-2005 |
| PARM NAME: p04all4td.t | DRAWN BY: |
| | CHECKED BY: |
| | SHEET 21 OF 76 |


| LOCATION | | | DROP INLETS | | | | | GUARDRAIL | | | | | | | | | | | | | | REMARKS | | | | |
|---------------------|---------|----------|---------------------------|-----------------------------------|--|---|-------------------------------------|---------------------------------------|--|--------------------------|---------------------------------|--------------------------------|-------------------|---|---------------------------------|--|---|-------------------------------------|--|--|---|---------|-------------------------------------|---------------|----------------|--------|
| STATION | STATION | POS. | 203.15 COMM. EXCAV. | 203.16 SOLID ROCK EXCAV. | 402.12 AGGREGATE SHOULDERS (MOD.) | 604.60 CAPPING EXISTING DROP INLETS | 604.42 REHAB. D.I. CLASS I | 203.99 SHOULDER BERM REMOVAL | 608.41 LOADER RENTAL FOR CABLE RAIL, TYPE II (MOD.) HR | 616.35 TIMBER CURB | 621.20 STEEL BEAM G.R. | 621.21 H.D. BEAM G.R. | 621.505 M.T.S. | 621.52 M.T.S. (TRAILING END TERMINAL) | 621.60 ANCHOR FOR G.R. | 621.65 ANCHOR FOR CABLE RAIL (MOD.) | 616.41 REMOVAL OF EXISTING CURB | 621.75 REMOVE & RESET G.R. | 621.76 REPLACE GUARD RAIL POST ASSEMBLY | 621.77 REPLACE GUARD RAIL BEAM UNIT (2'-5") | 621.79 ADJUST HEIGHT OF GUARD RAIL | | 621.80 REMOVE & DISP. G.R. | | | |
| EXIT # | # | RICHMOND | CY | CY | TONS | EA | EA | LF | HR | LF | LF | LF | EA | EA | EA | EA | LF | LF | EA | EA | | LF | LF | | | |
| RAMP "A" | | | | | | | | | | | | | | | | | | | | | | | | | | |
| 1+06 | 3+72 | RT | | | | | | 266' | 3 1 | | | | | | | 10 | | | 4 | | | 53' | | 27 OCT 05 | | |
| 13+75 | | LT | | | | | I | | | | | | | | | | | | | | | | | | | |
| 14+29 | 14+66.5 | RT | | | | | | | | | | | | I | | | | | | | | | 37.5' | | 25 OCT 05 | |
| 14+66.5 | 20+24 | RT | | | | | | 557.5' | | | | | | | | | | | 20 | 10 23 | 120' | | 25 OCT 05 | 12 BEAM UNITS | 11 MORE NEEDED | 27 OCT |
| 17+96 | | LT | | | | | I | | | | | | | | | | | | | | | | | | | |
| RAMP "B" | | | | | | | | | | | | | | | | | | | | | | | | | | |
| 1+50 | 5+82 | RT | 48 | | 21 29.8 | | | | | | | | | | | | | | | | | | | | | |
| 1+59 | | RT | | | | | I | | | | | | | | | | | | | | | | | | | |
| RAMP "C" | | | | | | | | | | | | | | | | | | | | | | | | | | |
| 2+10 | 6+85 | RT | | | | | | 475' | | | | | | | | | | | 15 | 7 16 | 95' | | 27 OCT 05 | | | |
| 3+15 | | RT | | | | | I | | | | | | | | | | | | | | | | | | | |
| 4+73 | | RT | | | | | I | | | | | | | | | | | | | | | | | | | |
| 9+48 | | RT | | | | | I | | | | | | | | | | | | | | | | | | | |
| 14+23 | 14+60.5 | RT | | | | | | | | | | | | I | | | | | | | | | 37.5' | | 27 OCT 05 | |
| 14+60.5 | 16+88 | RT | | | | | | 227.5' | | | | | | | | | | | 9 | 4 | 53' | | 27 OCT 05 | | | |
| 14+76 | | RT | | | | | I | | | | | | | | | | | | | | | | | | | |
| RAMP "D" | | | | | | | | | | | | | | | | | | | | | | | | | | |
| 6+06 | 11+09 | RT | | | | | | | | | | | | | | | | | | | | 4 | | 25 OCT 05 | | |
| 6+32 | | RT | | | | | I | 317' | | | | | | | | | | | 10 | 5 | 63' | | | | | |
| 7+92 | 10+81 | LT | | | | | | 289' | | | | | | | | | | | 9 | 4 18 | 58' 75 | | 10 7 OCT 05 & 18 OCT 05 | | | |
| 9+00 | | RT | | | | | I | | | | | | | | | | | | | | | | | | | |
| EXIT # 12 WILLISTON | | | | | | | | | | | | | | | | | | | | | | | | | | |
| RAMP "C" | | | | | | | | | | | | | | | | | | | | | | | | | | |
| 4+76 | 5+13.5 | RT | | | | | I | | | | | | | | | | | | | | | | | | | |
| 5+13.5 | 8+46 | RT | | | | | | 332.5' | | | | | | | | | | | 12 | 6 | 74' | | | | | |
| RAMP "D" | | | | | | | | | | | | | | | | | | | | | | | | | | |
| 5+28 | 12+17 | RT | | | | | | 689' | 7 | | | | | | 26 | | | 9 | | | 138' | | | | | |
| EXIT # 13 I-189 | | | | | | | | | | | | | | | | | | | | | | | | | | |
| RAMP "A" | | | | | | | | | | | | | | | | | | | | | | | | | | |
| 6+91 | 10+05 | LT | | | | | | 314' | 3 6 | | | | | | | 12 5 | | | 4 0 | | | 63' 48 | | 4 AUG | | |
| 13+25 | 13+62.5 | RT | | | | | | | | | | | | | | | | | | | | | 62.5' | 4 AUG | | |
| 13+62.5 | 16+93 | RT | | | | | | 330.5' | | | | | | | | | | | 1 | 5 2 | 66' 48 | | | | | |
| SHEET 16 TOTALS | | | | | | | 9 | 3798' | 13 | | | | 3 | | | 48 | | | 103 | 41 | | 783' | 112.5' | | | |

**ITEM
DETAIL
SHEET 8**

PROJECT NAME: BOLTON - SO. BURLINGTON
PROJECT NUMBER: AC IM 089-2(36)
FILE NAME: /pave/04all4/p04all4.dgn
PROJECT LEADER:
DESIGNED BY:
IPARM NAME: p04all4fid8.i
PLOT DATE: 17-MAY-2005
DRAWN BY:
CHECKED BY:
SHEET 22 OF 76

| LOCATION | | | DROP INLETS | | | | | | | | | | | | | GUARDRAIL | | | | | | | | | | 676.10 | | | | REMARKS |
|--|---------|------|-------------|--------|--------|--------|---------|-----------|--------|--------|--------|--------|---------|--------|--------|-----------|--------|--------|--------|----------|----------|----------|--------|--------|---------|----------|---------------------------|--|--|---------|
| STATION | STATION | POS. | 203.15 | 203.16 | 203.30 | 301.35 | 604.412 | 203.99 | 608.41 | 616.35 | 621.20 | 621.21 | 621.505 | 621.52 | 621.65 | 621.76 | 621.77 | 203.31 | 621.79 | 621.80 | 604.0915 | 607.7015 | 203.40 | TYPE I | TYPE II | TYPE III | TYPE I @ M.T.S. LOCATIONS | | | |
| SHEET TOTALS | | | CY | CY | CY | CY | EA | LF | HR | LF | LF | LF | EA | EA | EA | EA | EA | CY | LF | LF | LF | EA | SY | | | | | | | |
| SHEET 09-15 | | | | | 1,222 | | 3 | 8,162' | 16 | 30' | 416.5 | | -6-7 | | 71 | 261 | 112 | | 1,874' | 262.5' | | | | | | | | | | |
| SHEET 10-16 | | | | | | | 6 | 11,585' | 68 | 84' | 650' | | 6 | | 251 | 247 | 81 | | 891' | 150' | | | | | | | | | | |
| SHEET 11-17 | | | 370 | | 545 | 156 | | 5,838.5' | 8 | | 1,600 | | -8-9 | +2 | 29 | 204 | 73 | 39 | 944' | 906.5' | 60 | 2 | 222 | | | | | | | |
| SHEET 12-18 | | | | | | | 1 | 7,243' | 22 | | 1,425 | | 9 | 4-6 | 79 | 225 | 148 | | 1,609' | 337.5' | | | | | | | | | | |
| SHEET 13-19 | | | 817 | 1 | | 726 | | 2,142' | 8 | | 2,275 | | -5-6 | 6 | 28 | 73 | 28 | 182 | 430' | 703' | | | 1,089 | | | | | | | |
| SHEET 14-20 | | | | | | | | 2,079.5' | | | 1,625' | | -6-7 | 2 | | 68 | 32 | | 421' | 585' | | | | | | | | | | |
| SHEET 15-21 | | | | | | | | 1,829.5' | | 150' | 1,825 | | 4-6 | 3 | | 60 | 26 | | 367' | 504.5' | | | | | | | | | | |
| SHEET 16-22 | | | | | | | 9 | 3,798' | 13 | | | | 3 | | 48 | 103 | 41 | | 783' | 112.5' | | | | | | | | | | |
| SHEET 17 3780+68 - 4634+36 INCLUDING RAMPS | | | | | | | | | | | | | | | | | | | | | | | | 850 | 56 | 8 | 47 | | | |
| WILLISTON IM 089-2(35) | | | | | | | | | | | | | | | | | | | | | | | | | | | | | | |
| 14+47.5 | 14+85 | RT | | | | | | | | | | | 1 | | | | | | | | | | | | | | | | | |
| 14+85 | 18+10 | RT | | | | | | | | | | | | | | | | | | | | | | | | | | | | |
| 15+97 | 16+37.5 | LT | | | | | | | | | | | 1 | | | | | | | | | | | | | | | | | |
| 16+37.5 | 20+75 | LT | | | | | | | | | 437.5 | | | | | | | | | | | | | | | | | | | |
| 20+75 | 20+87.5 | LT | | | | | | | | | | | | 1 | | | | | | | | | | | | | | | | |
| SHEET 17 TOTALS | | | 1,187 | 1 | 1,767 | 882 | 19 | 42,677.5' | 135 | 545' | 10,454 | | 54 | 16 | 506 | 1,241 | 541 | 221 | 7,319' | 3,561.5' | 60 | 2 | 1,311 | | | 961 | | | | |
| ROUNDING | | | 13 | - | 33 | 18 | - | 322.5' | - | - | 62.5' | | - | - | - | 9 | 9 | 29 | 81' | 38.5' | - | - | 39 | | | 39 | | | | |
| TOTAL | | | 1,200 | 1 | 1,800 | 900 | 19 | 43,000' | 135 | 545' | 9,300' | | 47 | 16 | 506 | 1,250 | 550 | 250 | 7,400' | 3,600' | 60 | 2 | 1,350 | | | 1,000 | | | | |

| | |
|------------------------------------|---------------------------------------|
| ITEM DETAIL SHEET 9 | PROJECT NAME: BOLTON - SO. BURLINGTON |
| | PROJECT NUMBER: AC IM 089-2(36) |
| | FILE NAME: /pave/04d114/p04d114.dgn |
| | DESIGNED BY: IPARM NAME: p04d114d9.1 |
| | PLOT DATE: 17-MAY-2005 |
| | DRAWN BY: |
| | CHECKED BY: |
| | SHEET 23 OF 76 |

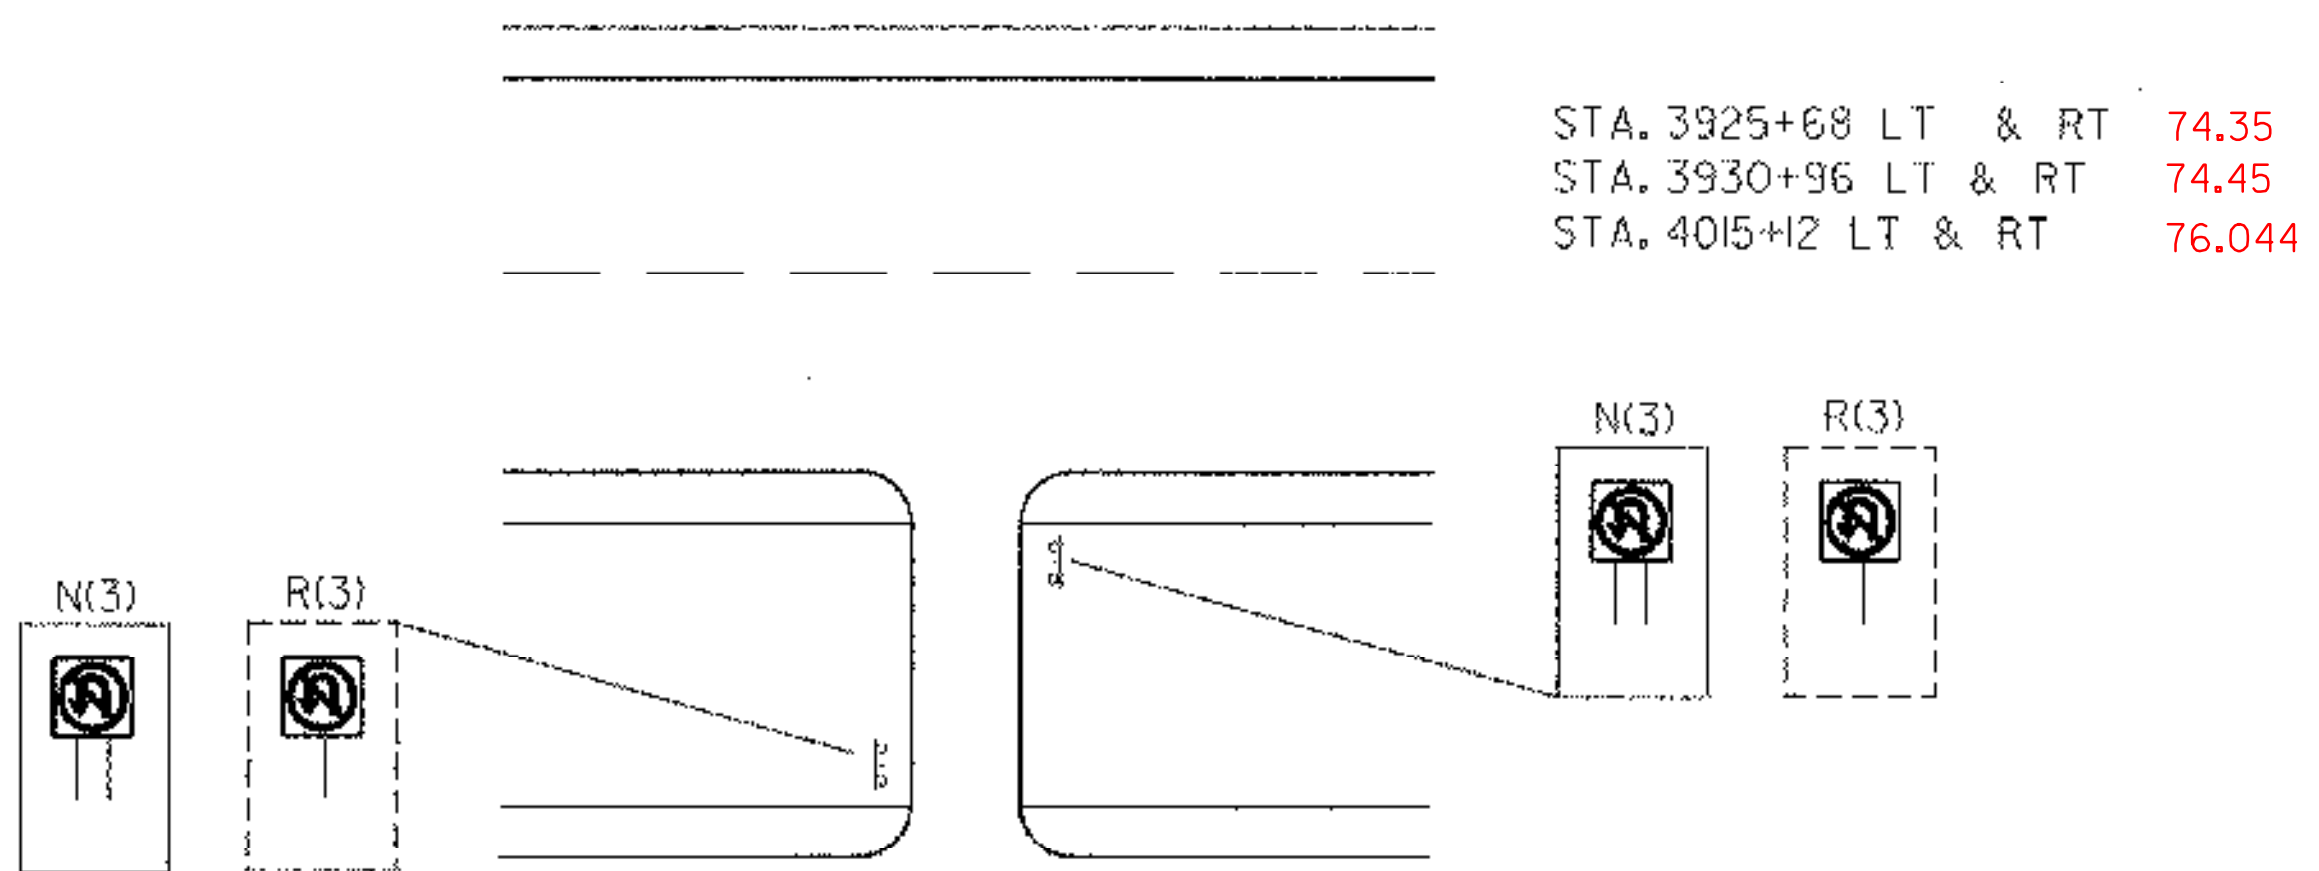

U-TURN SIGNAGE DETAIL

REFER TO SHEETS 15-23 FOR LOCATIONS AND QUANTITIES OF GUARDRAIL ITEMS.


646.414 DURABLE 6" WHITE LINE (MOD.)
 3780+68 TO 4065+23 SOLID LT
 3780+68 TO 4065+23 DASHED CL

646.614 TEMPORARY 6" WHITE LINE
 3780+68 TO 4065+23 SOLID LT
 3780+68 TO 4065+23 DASHED CL

646.415 DURABLE 6" YELLOW LINE (MOD.)
 3780+68 TO 4065+23 SOLID RT

646.615 TEMPORARY 6" YELLOW LINE
 3780+68 TO 4065+23 SOLID RT


**STA 4065+23
 (MM 76.993)**

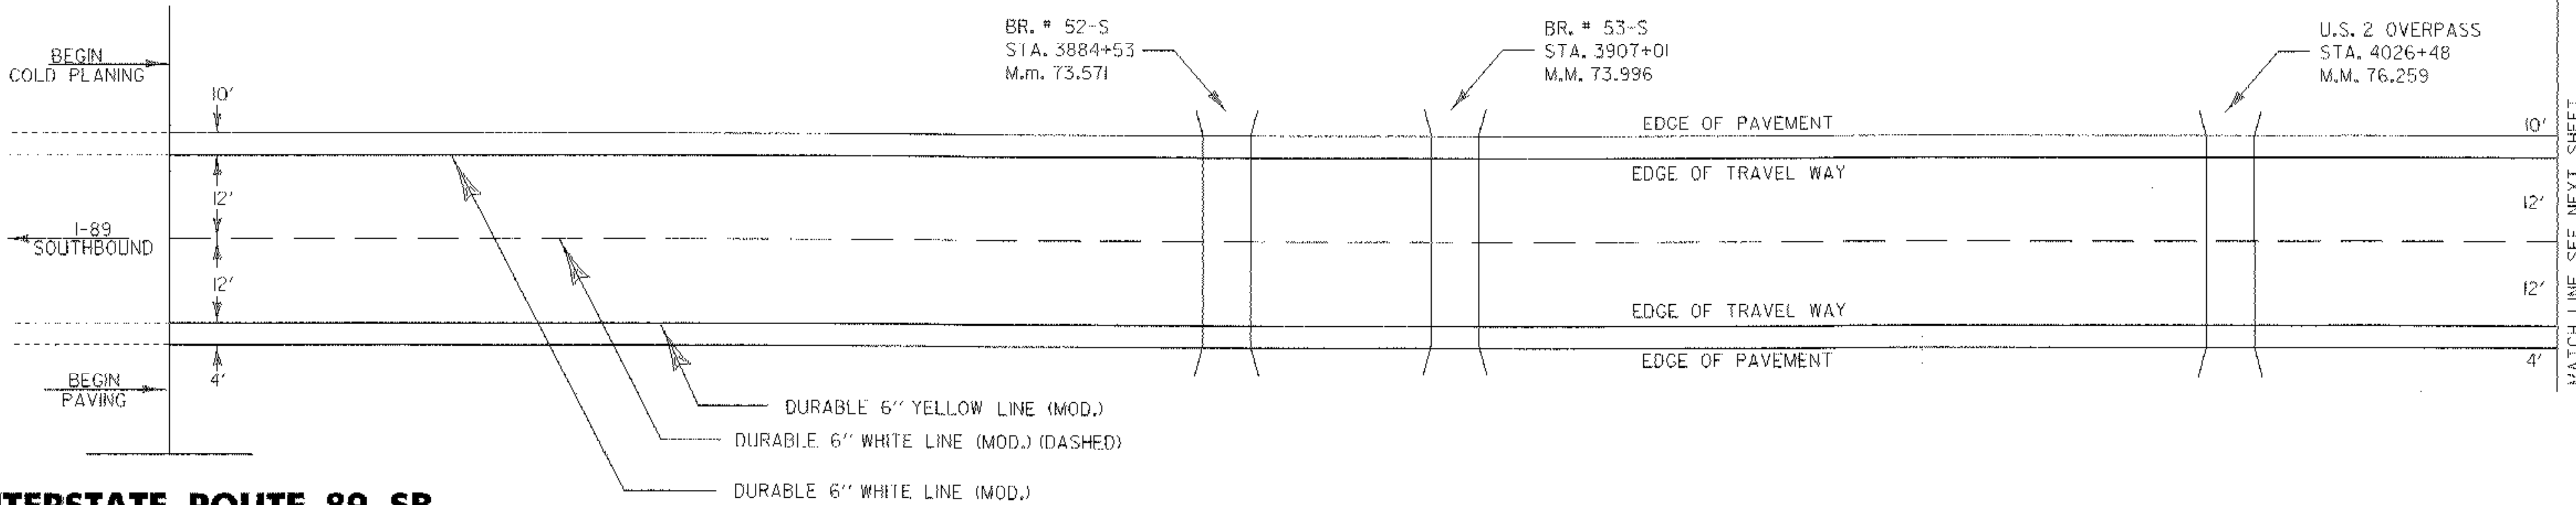

**INTERSTATE ROUTE 89 SB
 STA 3780+68
 (MM 71.604)
 BEGIN PROJECT
 IM 089-2(36)**

NOT TO SCALE

| | |
|--|---------------------------------------|
| PAVING PROJECT LAYOUT # 1 | PROJECT NAME: BOLTON - SO. BURLINGTON |
| | PROJECT NUMBER: AC IM 089-2(36) |
| FILE NAME: /pave/04all4/p04all4.dgn | PLOT DATE: 17-MAY-2005 |
| PROJECT LEADER: | DRAWN BY: |
| DESIGNED BY: | CHECKED BY: |
| IPARM NAME: p04114101 | SHEET 24 OF 76 |

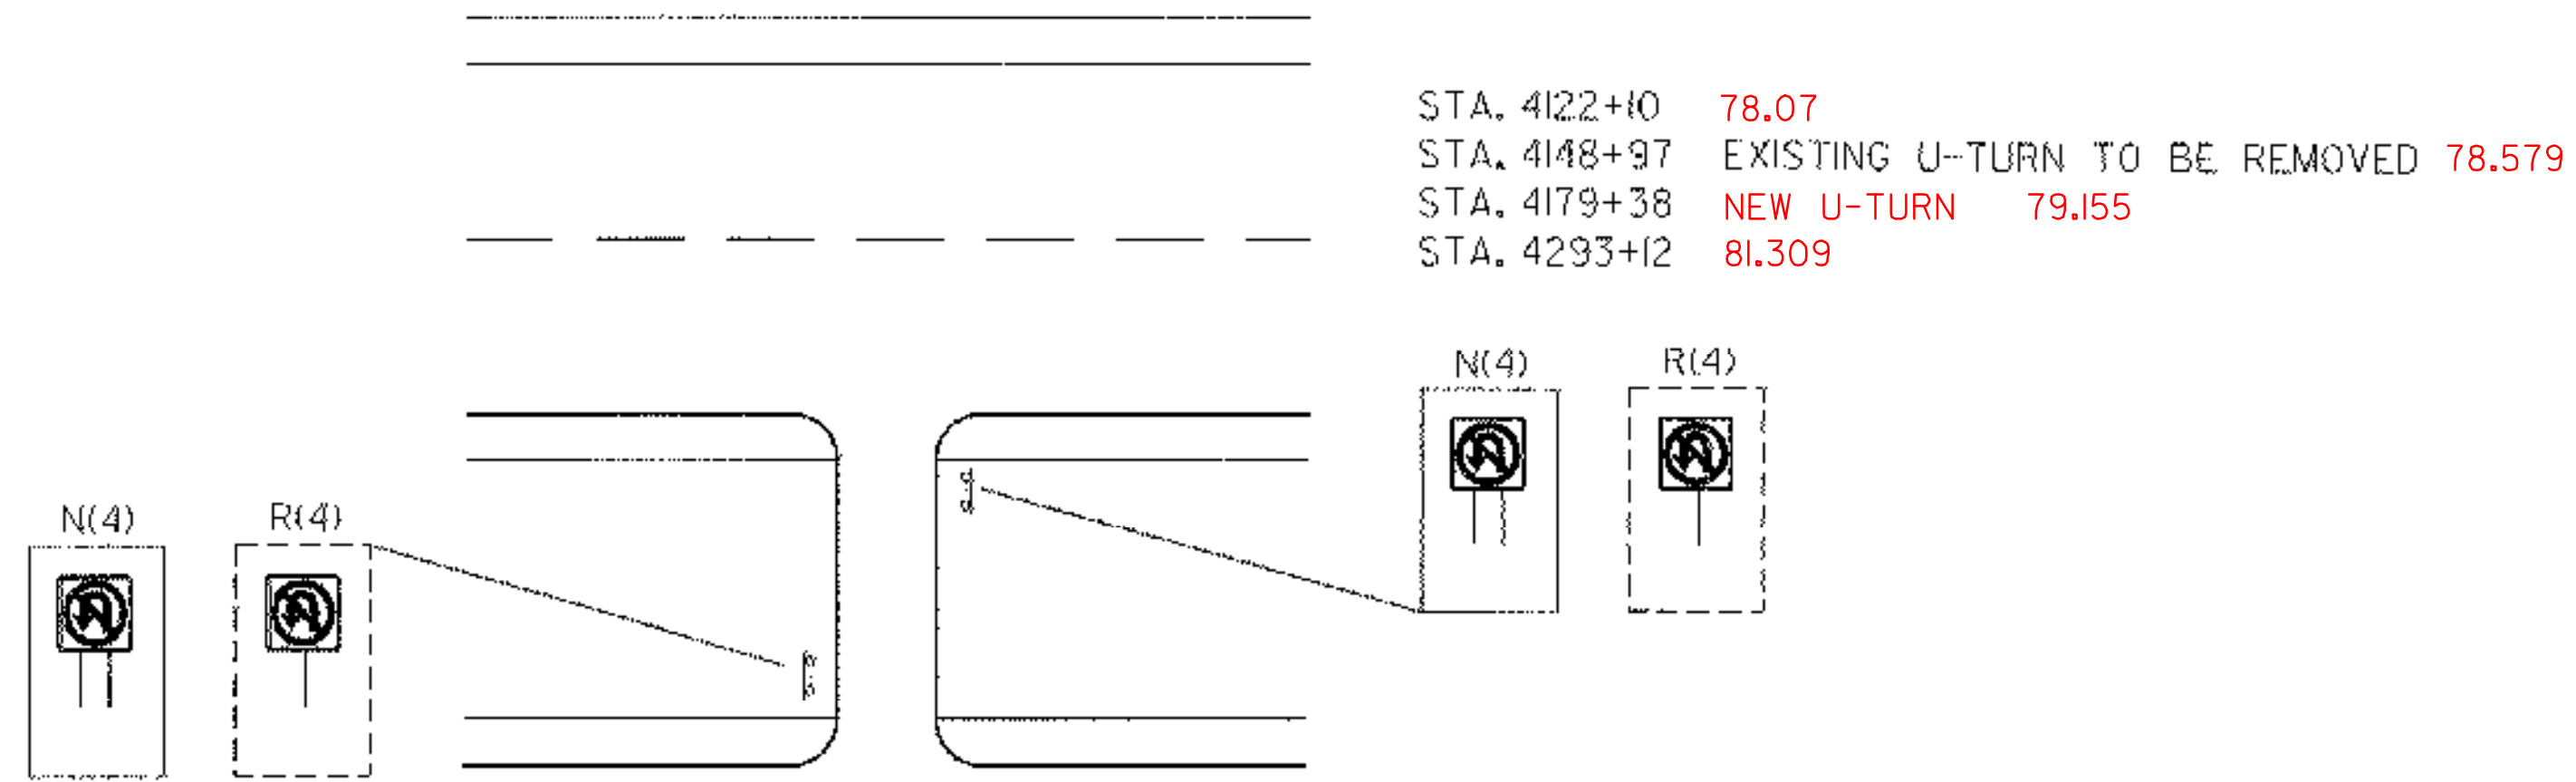

U-TURN SIGNAGE DETAIL

REFER TO SHEETS 15-23 FOR LOCATIONS AND QUANTITIES OF GUARDRAIL ITEMS.

646.414 DURABLE 6" WHITE LINE (MOD.)
 4065+23 TO 4349+82 SOLID LT
 4065+23 TO 4349+82 DASHED CL


646.614 TEMPORARY 6" WHITE LINE
 4065+23 TO 4349+82 SOLID LT
 4065+23 TO 4349+82 DASHED CL

646.415 DURABLE 6" YELLOW LINE (MOD.)
 4065+23 TO 4349+82 SOLID RT

646.615 TEMPORARY 6" YELLOW LINE
 4065+23 TO 4349+82 SOLID RT

**STA 4065+23
(MM 76.993)**

**STA 4349+82
(MM 82.383)**

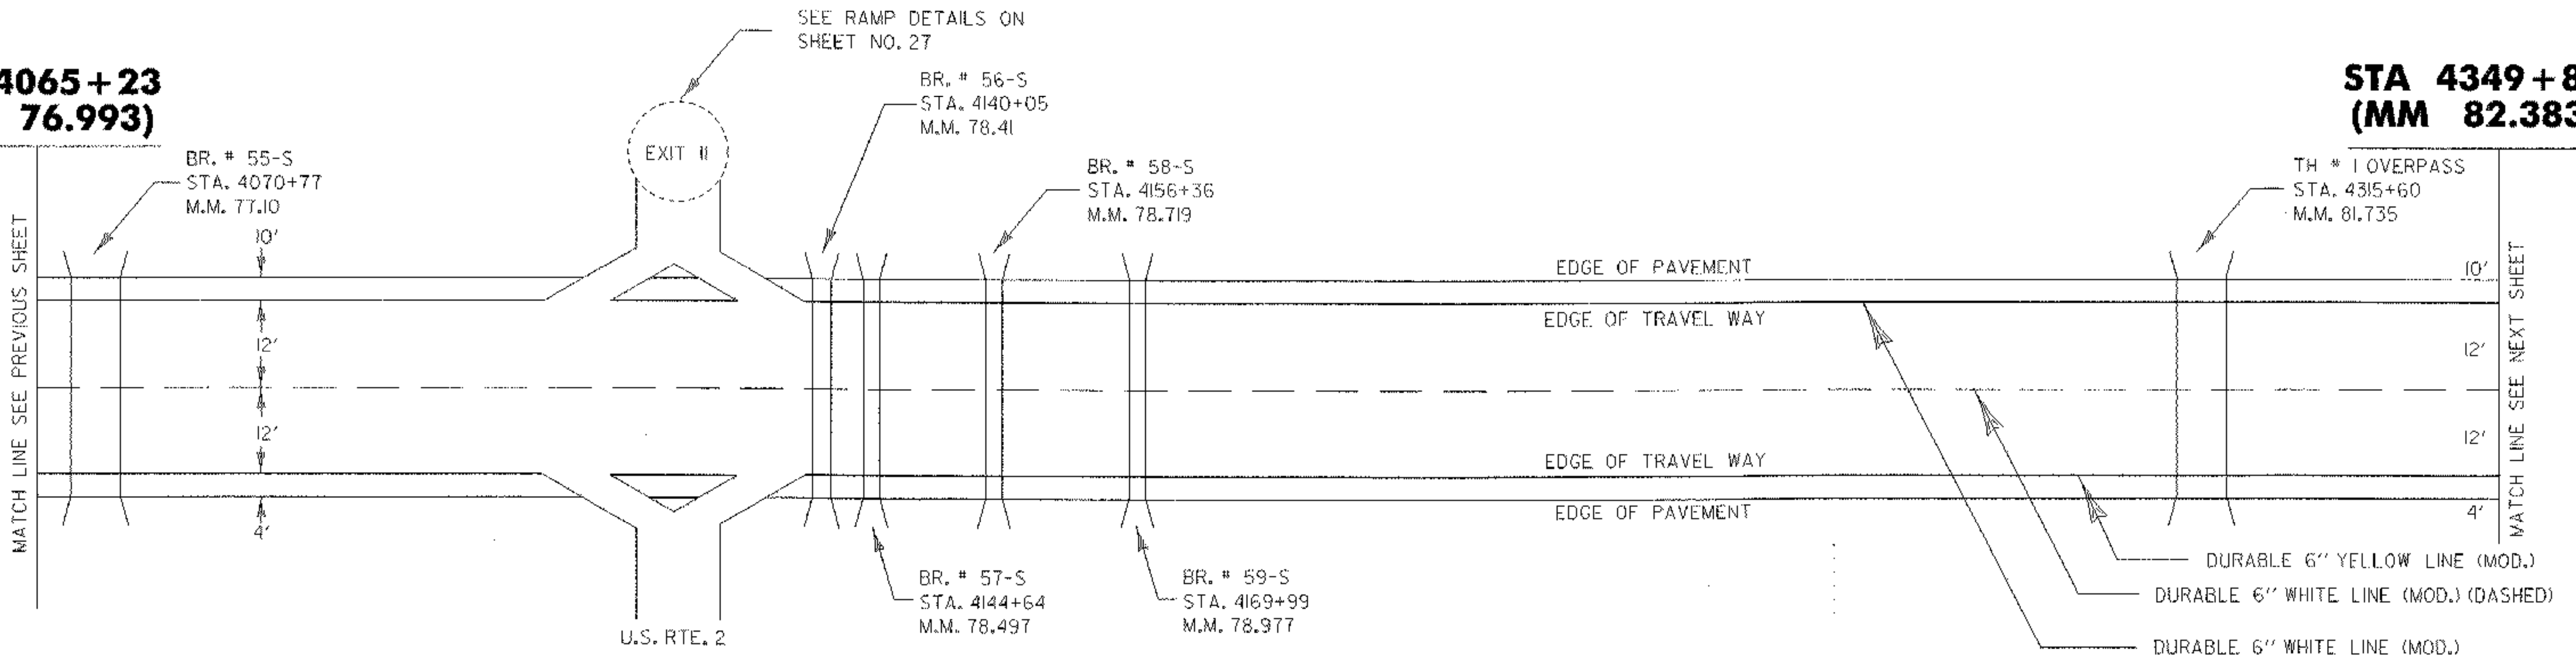

NOT TO SCALE

**PAVING
PROJECT
LAYOUT # 2**

| | |
|---------------------------------------|------------------------|
| PROJECT NAME: BOLTON - SO. BURLINGTON | PLOT DATE: 17-MAY-2005 |
| PROJECT NUMBER: AC IM 089-2(36) | DRAWN BY: |
| FILE NAME: /pave/04all4/p04all4.dgn | CHECKED BY: |
| PROJECT LEADER: | SHEET 25 OF 76 |
| DESIGNED BY: | |
| (PARM NAME: p04all4t02.l) | |

STA. 4410+65 83.535
 STA. 4457+38 84.420
~~STA. 4179+38 NEW U-TURN SHEET 25~~
~~STA. 4293+12 SHEET 25~~
 STA. 4595+66 87.039

REFER TO SHEETS 15-23 FOR LOCATIONS AND QUANTITIES OF GUARDRAIL ITEMS.


646.414 DURABLE 6" WHITE LINE (MOD.)
 4349+82 TO 4634+36 SOLID LT
 4349+82 TO 4634+36 DASHED CL

646.614 TEMPORARY 6" WHITE LINE
 4349+82 TO 4634+36 SOLID LT
 4349+82 TO 4634+36 DASHED CL

646.415 DURABLE 6" YELLOW LINE (MOD.)
 2801+04 TO 3078+66 SOLID RT


646.615 TEMPORARY 6" YELLOW LINE
 2801+04 TO 3078+66 SOLID RT

**END PROJECT
 STA 4634+36
 (MM 87.772)
 IM 089-2(36)**

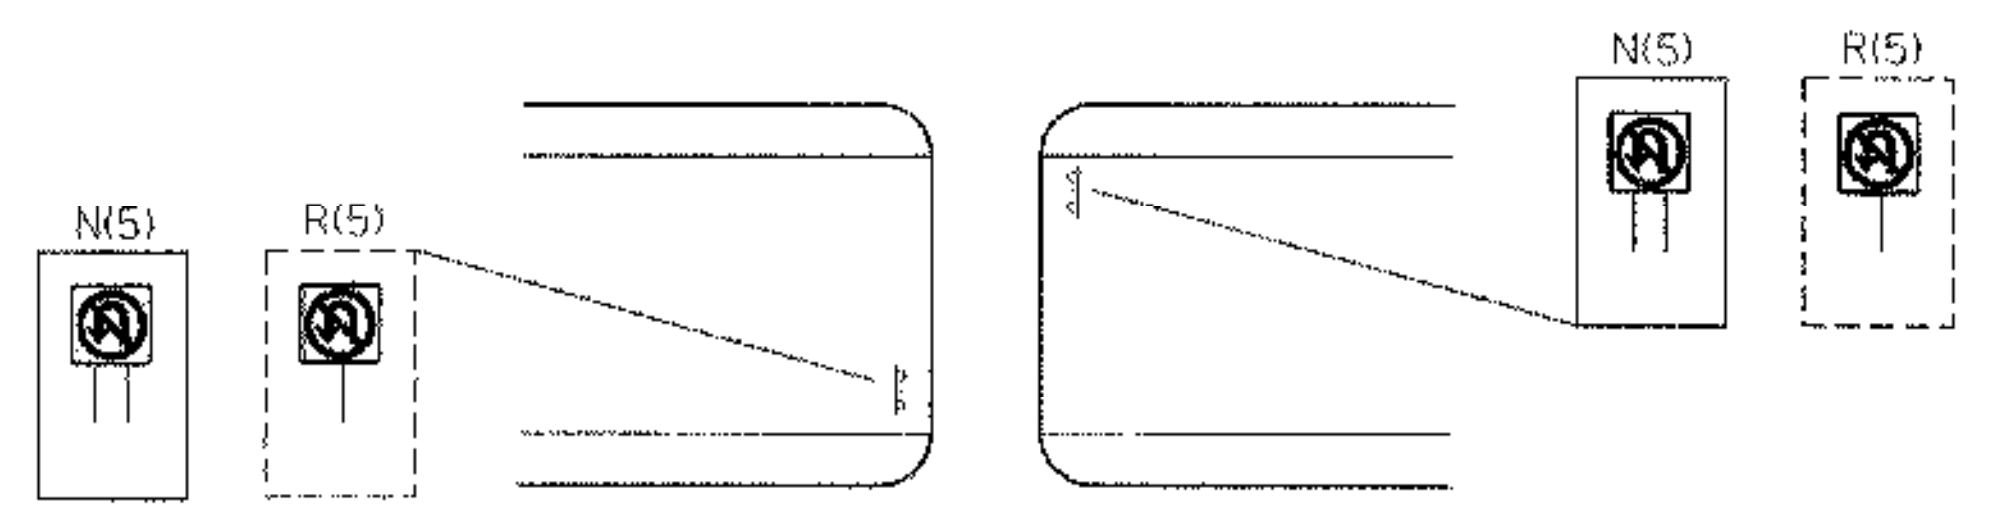



U-TURN SIGNAGE DETAIL

**STA 4349+82
 (MM 82.383)**

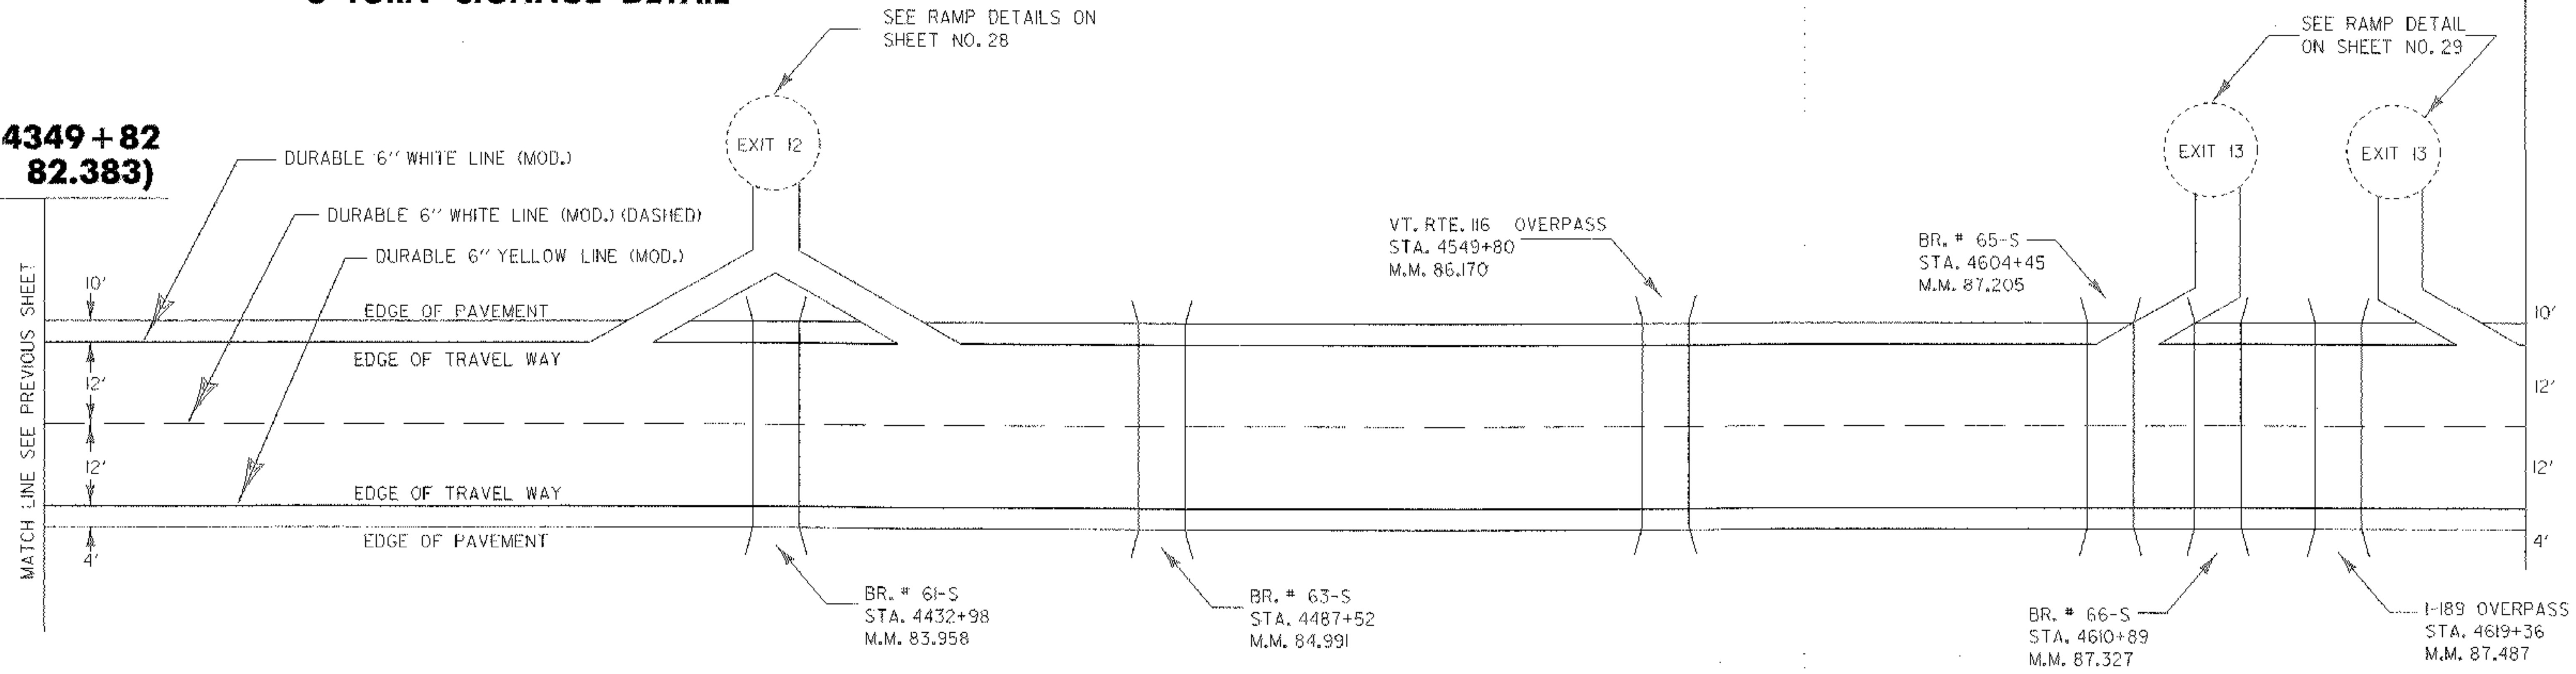

NOT TO SCALE

| | |
|--|---------------------------------------|
| PAVING PROJECT LAYOUT # 3 | PROJECT NAME: BOLTON - SO. BURLINGTON |
| | PROJECT NUMBER: AC IM 089-2(36) |
| | FILE NAME: /pave/04all4/p04all4.dgn |
| | IPARM NAME: p04all4i03.i |
| | PLOT DATE: 17-MAY-2005 |
| | DRAWN BY: |
| | CHECKED BY: |
| | SHEET 26 OF 76 |

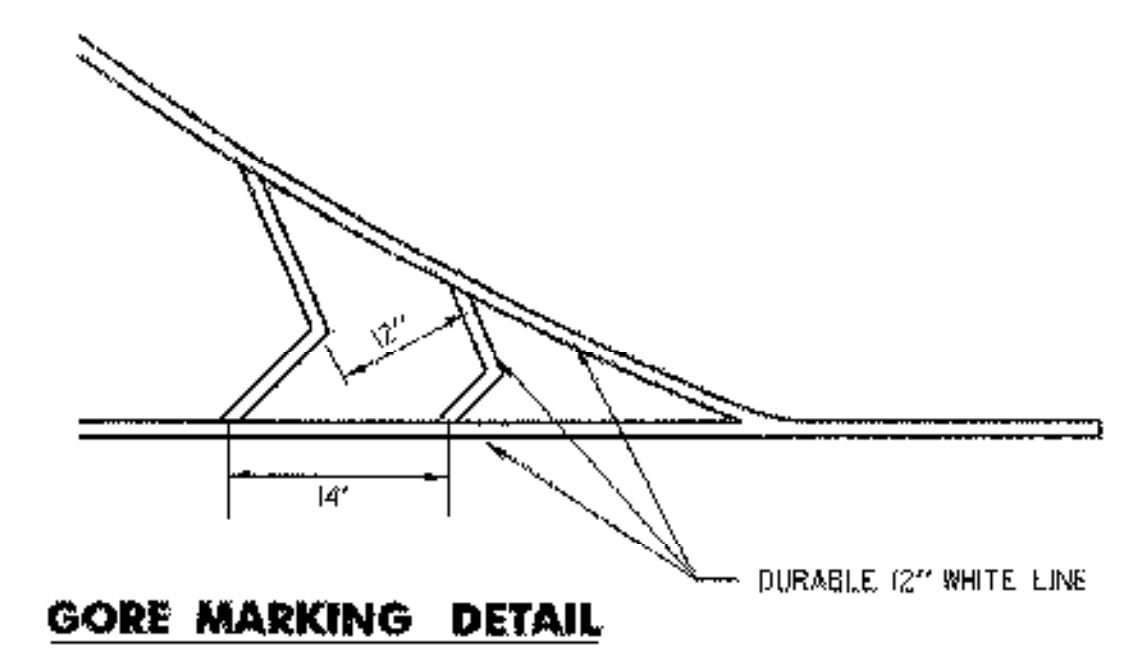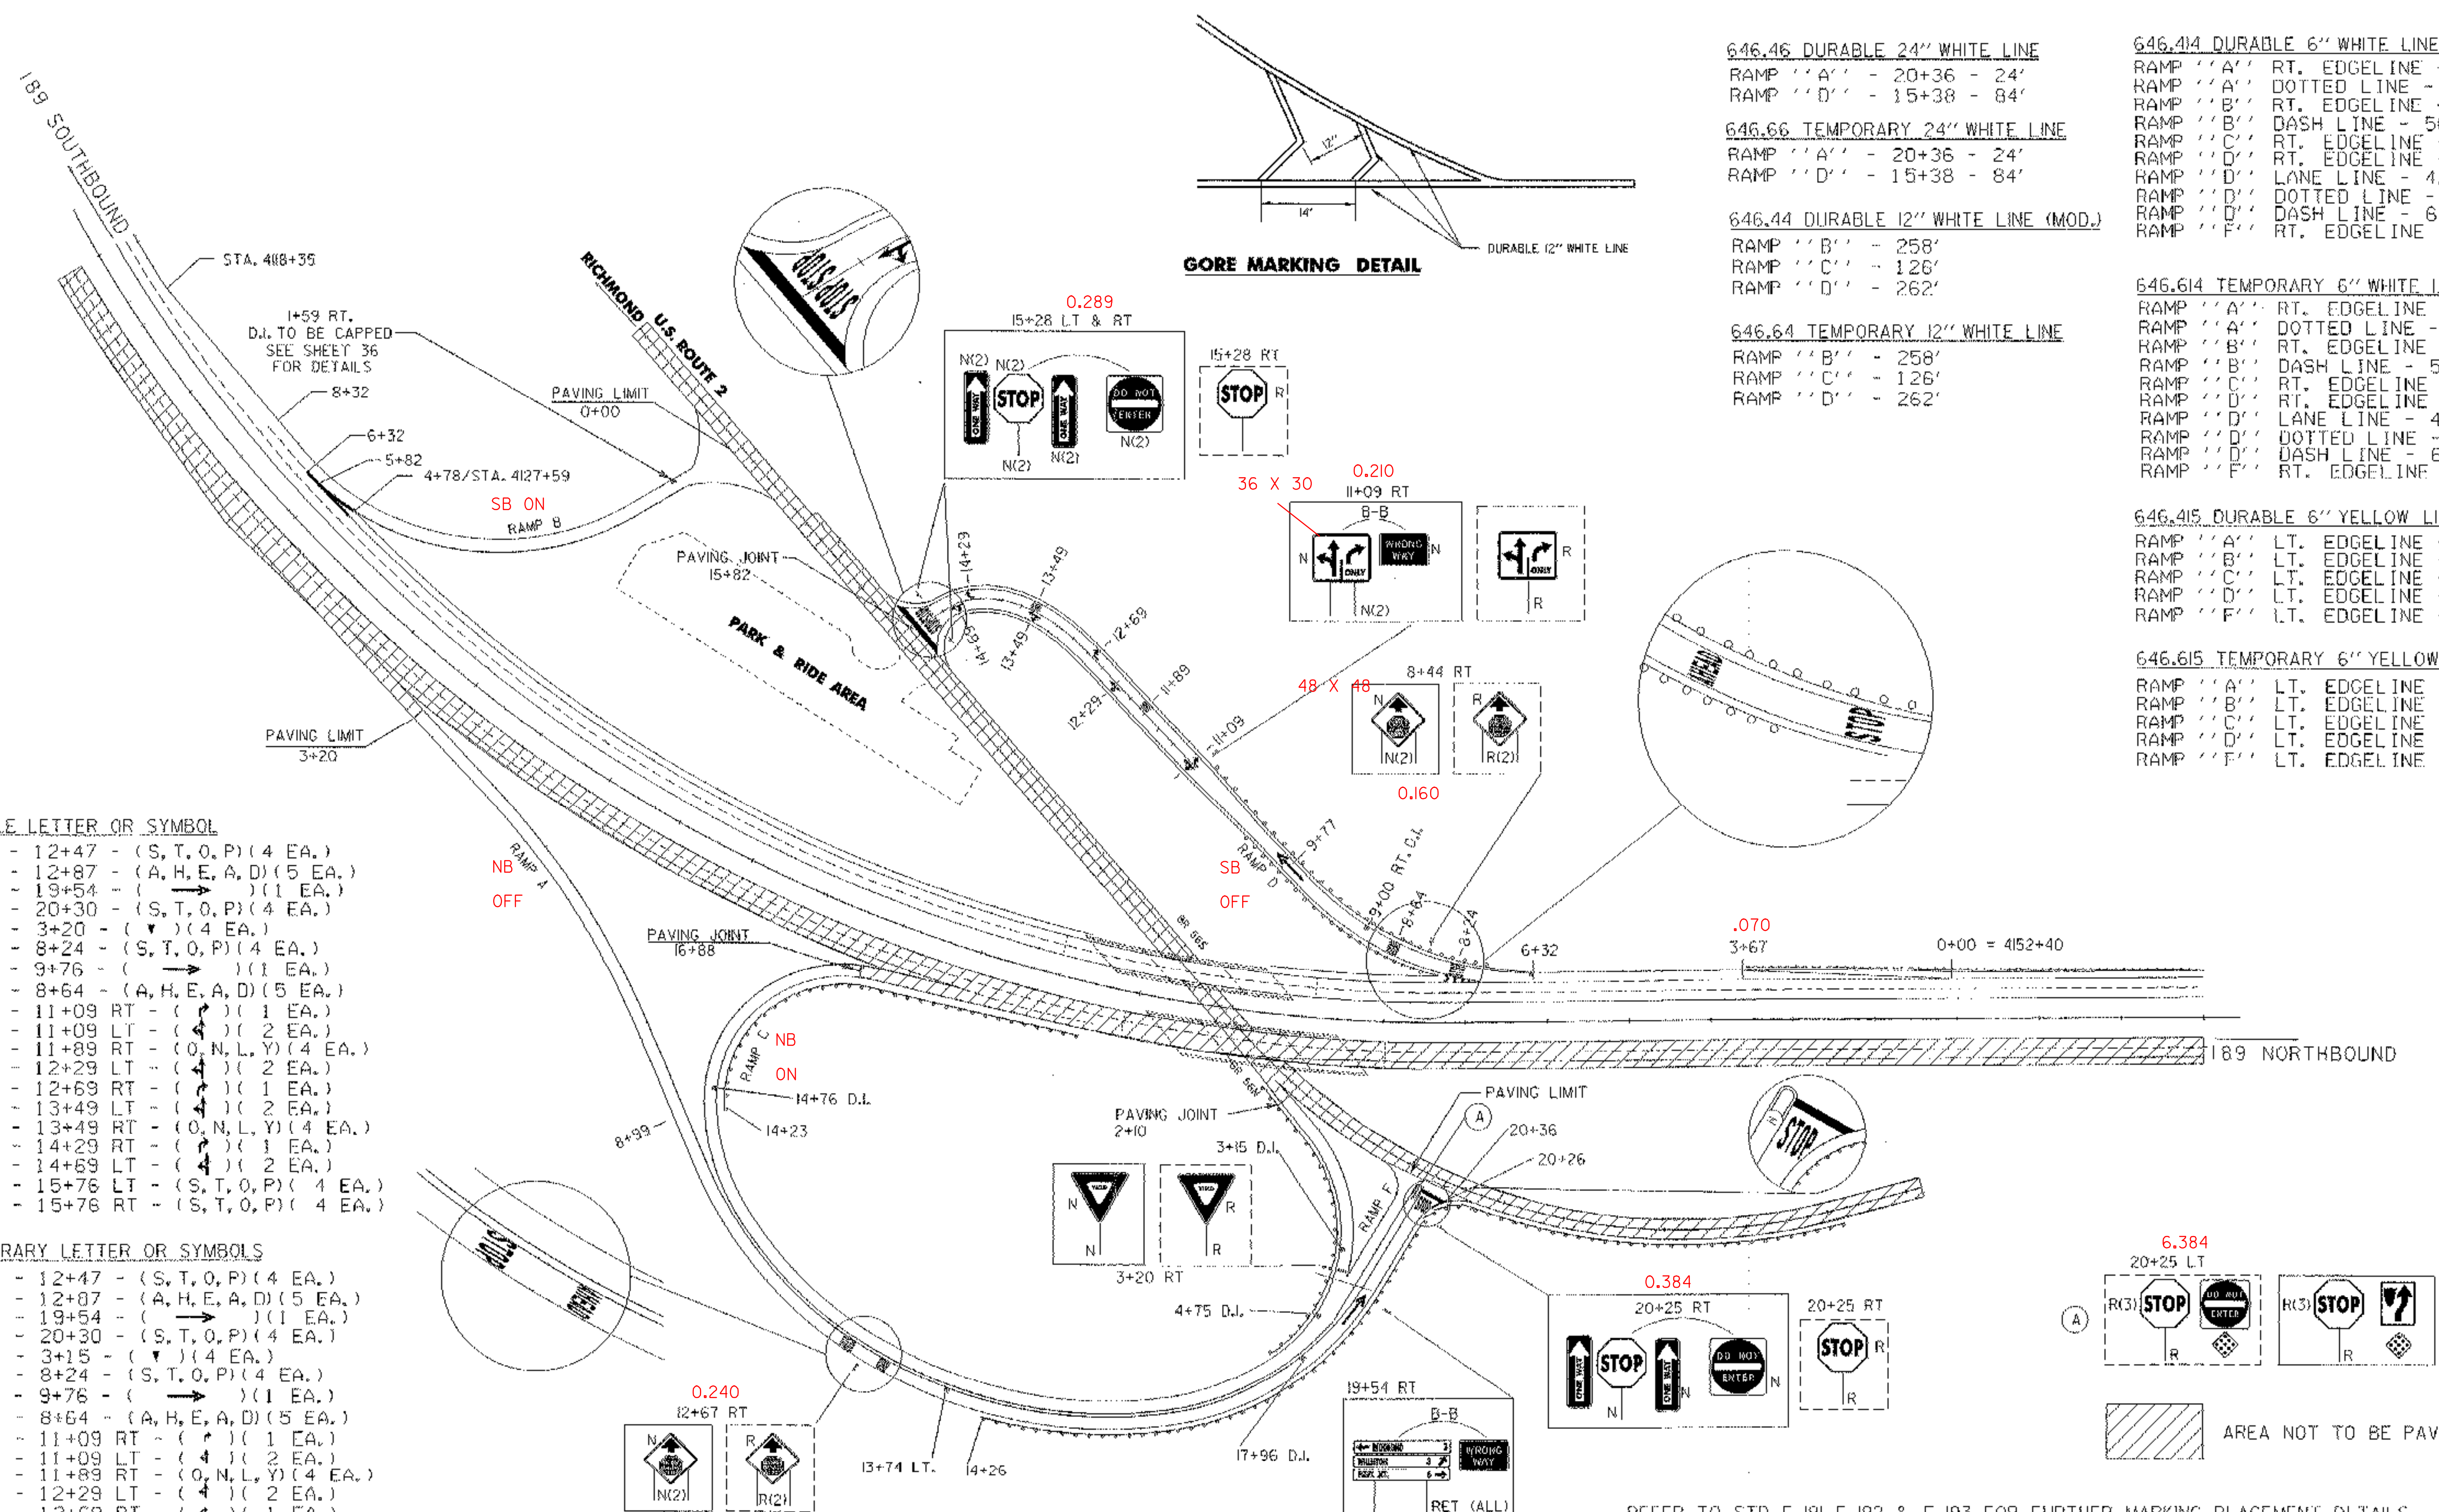

646.46 DURABLE 24" WHITE LINE
RAMP "A" - 20+36 - 24'
RAMP "D" - 15+38 - 84'

646.66 TEMPORARY 24" WHITE LINE
RAMP "A" - 20+36 - 24'
RAMP "D" - 15+38 - 84'

646.44 DURABLE 12" WHITE LINE (MOD.)
RAMP "B" - 258'
RAMP "C" - 126'
RAMP "D" - 262'

646.64 TEMPORARY 12" WHITE LINE
RAMP "B" - 258'
RAMP "C" - 126'
RAMP "D" - 262'

646.414 DURABLE 6" WHITE LINE (MOD.)
RAMP "A" RT. EDGELINE - 1716'
RAMP "A" DOTTED LINE - 14'
RAMP "B" RT. EDGELINE - 557'
RAMP "B" DASH LINE - 50'
RAMP "C" RT. EDGELINE - 1478'
RAMP "D" RT. EDGELINE - 1582'
RAMP "D" LANE LINE - 421'
RAMP "D" DOTTED LINE - 92'
RAMP "D" DASH LINE - 67'
RAMP "F" RT. EDGELINE - 150'

646.614 TEMPORARY 6" WHITE LINE
RAMP "A" RT. EDGELINE - 1716'
RAMP "A" DOTTED LINE - 14'
RAMP "B" RT. EDGELINE - 557'
RAMP "B" DASH LINE - 50'
RAMP "C" RT. EDGELINE - 1478'
RAMP "D" RT. EDGELINE - 1582'
RAMP "D" LANE LINE - 421'
RAMP "D" DOTTED LINE - 92'
RAMP "D" DASH LINE - 67'
RAMP "F" RT. EDGELINE - 150'

646.415 DURABLE 6" YELLOW LINE (MOD.)
RAMP "A" LT. EDGELINE - 1716'
RAMP "B" LT. EDGELINE - 478'
RAMP "C" LT. EDGELINE - 1478'
RAMP "D" LT. EDGELINE - 787'
RAMP "F" LT. EDGELINE - 150'

646.615 TEMPORARY 6" YELLOW LINE
RAMP "A" LT. EDGELINE - 1716'
RAMP "B" LT. EDGELINE - 478'
RAMP "C" LT. EDGELINE - 1478'
RAMP "D" LT. EDGELINE - 787'
RAMP "F" LT. EDGELINE - 150'



- 646.50 DURABLE LETTER OR SYMBOL**
- RAMP "A" - 12+47 - (S, T, O, P) (4 EA.)
 - RAMP "A" - 12+87 - (A, H, E, A, D) (5 EA.)
 - RAMP "A" - 19+54 - () (1 EA.)
 - RAMP "A" - 20+30 - (S, T, O, P) (4 EA.)
 - RAMP "C" - 3+20 - () (4 EA.)
 - RAMP "D" - 8+24 - (S, T, O, P) (4 EA.)
 - RAMP "D" - 9+76 - () (1 EA.)
 - RAMP "D" - 8+64 - (A, H, E, A, D) (5 EA.)
 - RAMP "D" - 11+09 RT - () (1 EA.)
 - RAMP "D" - 11+09 LT - () (2 EA.)
 - RAMP "D" - 11+89 RT - (O, N, L, Y) (4 EA.)
 - RAMP "D" - 12+29 LT - () (2 EA.)
 - RAMP "D" - 12+69 RT - () (1 EA.)
 - RAMP "D" - 13+49 LT - () (2 EA.)
 - RAMP "D" - 13+49 RT - (O, N, L, Y) (4 EA.)
 - RAMP "D" - 14+29 RT - () (3 EA.)
 - RAMP "D" - 14+69 LT - () (2 EA.)
 - RAMP "D" - 15+76 LT - (S, T, O, P) (4 EA.)
 - RAMP "D" - 15+76 RT - (S, T, O, P) (4 EA.)

- 646.70 TEMPORARY LETTER OR SYMBOLS**
- RAMP "A" - 12+47 - (S, T, O, P) (4 EA.)
 - RAMP "A" - 12+87 - (A, H, E, A, D) (5 EA.)
 - RAMP "A" - 19+54 - () (1 EA.)
 - RAMP "A" - 20+30 - (S, T, O, P) (4 EA.)
 - RAMP "C" - 3+15 - () (4 EA.)
 - RAMP "D" - 8+24 - (S, T, O, P) (4 EA.)
 - RAMP "D" - 9+76 - () (1 EA.)
 - RAMP "D" - 8+64 - (A, H, E, A, D) (5 EA.)
 - RAMP "D" - 11+09 RT - () (1 EA.)
 - RAMP "D" - 11+09 LT - () (2 EA.)
 - RAMP "D" - 11+89 RT - (O, N, L, Y) (4 EA.)
 - RAMP "D" - 12+29 LT - () (2 EA.)
 - RAMP "D" - 12+69 RT - () (1 EA.)
 - RAMP "D" - 13+49 LT - () (2 EA.)
 - RAMP "D" - 13+49 RT - (O, N, L, Y) (4 EA.)
 - RAMP "D" - 14+29 RT - () (1 EA.)
 - RAMP "D" - 14+69 LT - () (2 EA.)
 - RAMP "D" - 15+76 LT - (S, T, O, P) (4 EA.)
 - RAMP "D" - 15+76 RT - (S, T, O, P) (4 EA.)

REFER TO STD. E-191, E-192, & E-193 FOR FURTHER MARKING PLACEMENT DETAILS

INTERCHANGE # 11 PAVEMENT MARKINGS & SIGNS

| | | | | | |
|-----------------|-------------------------|-----------------|--------------------------|-------------|-------------|
| PROJECT NAME: | BOLTON - SO. BURLINGTON | FILE NAME: | /pave/04all4/p04all4.dgn | PLOT DATE: | 17-MAY-2005 |
| PROJECT NUMBER: | AC IM 089-2(36) | PROJECT LEADER: | | DRAWN BY: | |
| | | DESIGNED BY: | | CHECKED BY: | |
| | | IPARM NAME: | p04all4in.ttl | SHEET | 27 OF 76 |

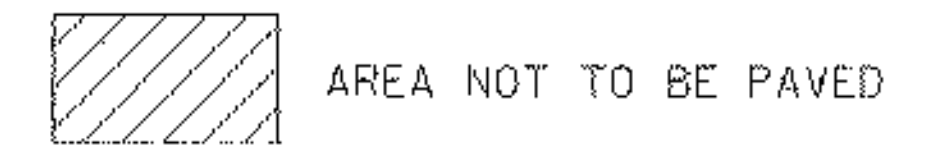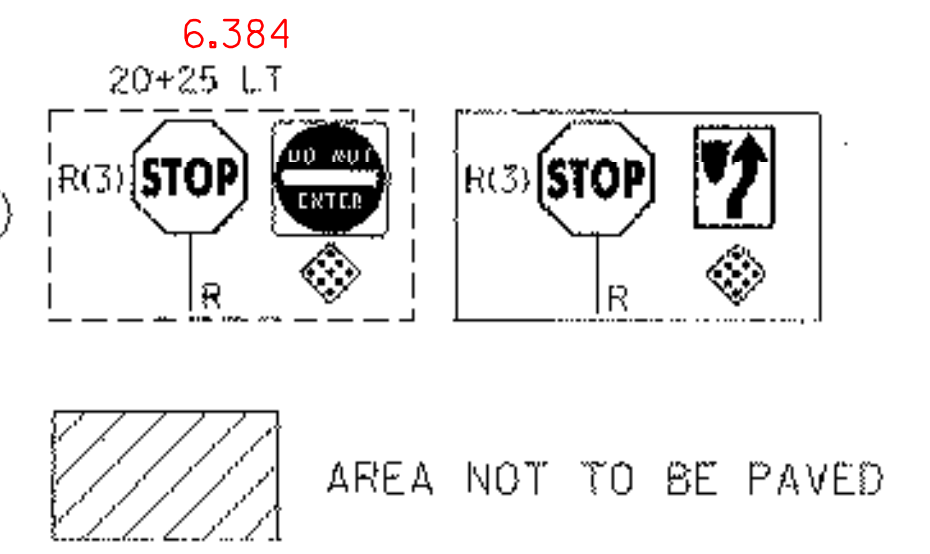

646.415 DURABLE 6" YELLOW LINE (MOD.)
RAMP "B" LT. EDGELINE - 1006'


646.615 TEMPORARY 6" YELLOW LINE
RAMP "B" LT. EDGELINE - 1006'

646.44 DURABLE 12" WHITE LINE (MOD.)
RAMP "B" - 468'


646.64 TEMPORARY 12" WHITE LINE
RAMP "B" - 468'

646.414 DURABLE 6" WHITE LINE (MOD.)
RAMP "B" RT. EDGELINE - 2247'
RAMP "B" DASH LINE - 50'

646.614 TEMPORARY 6" WHITE LINE
RAMP "B" RT. EDGELINE - 2247'
RAMP "B" DASH LINE - 50'

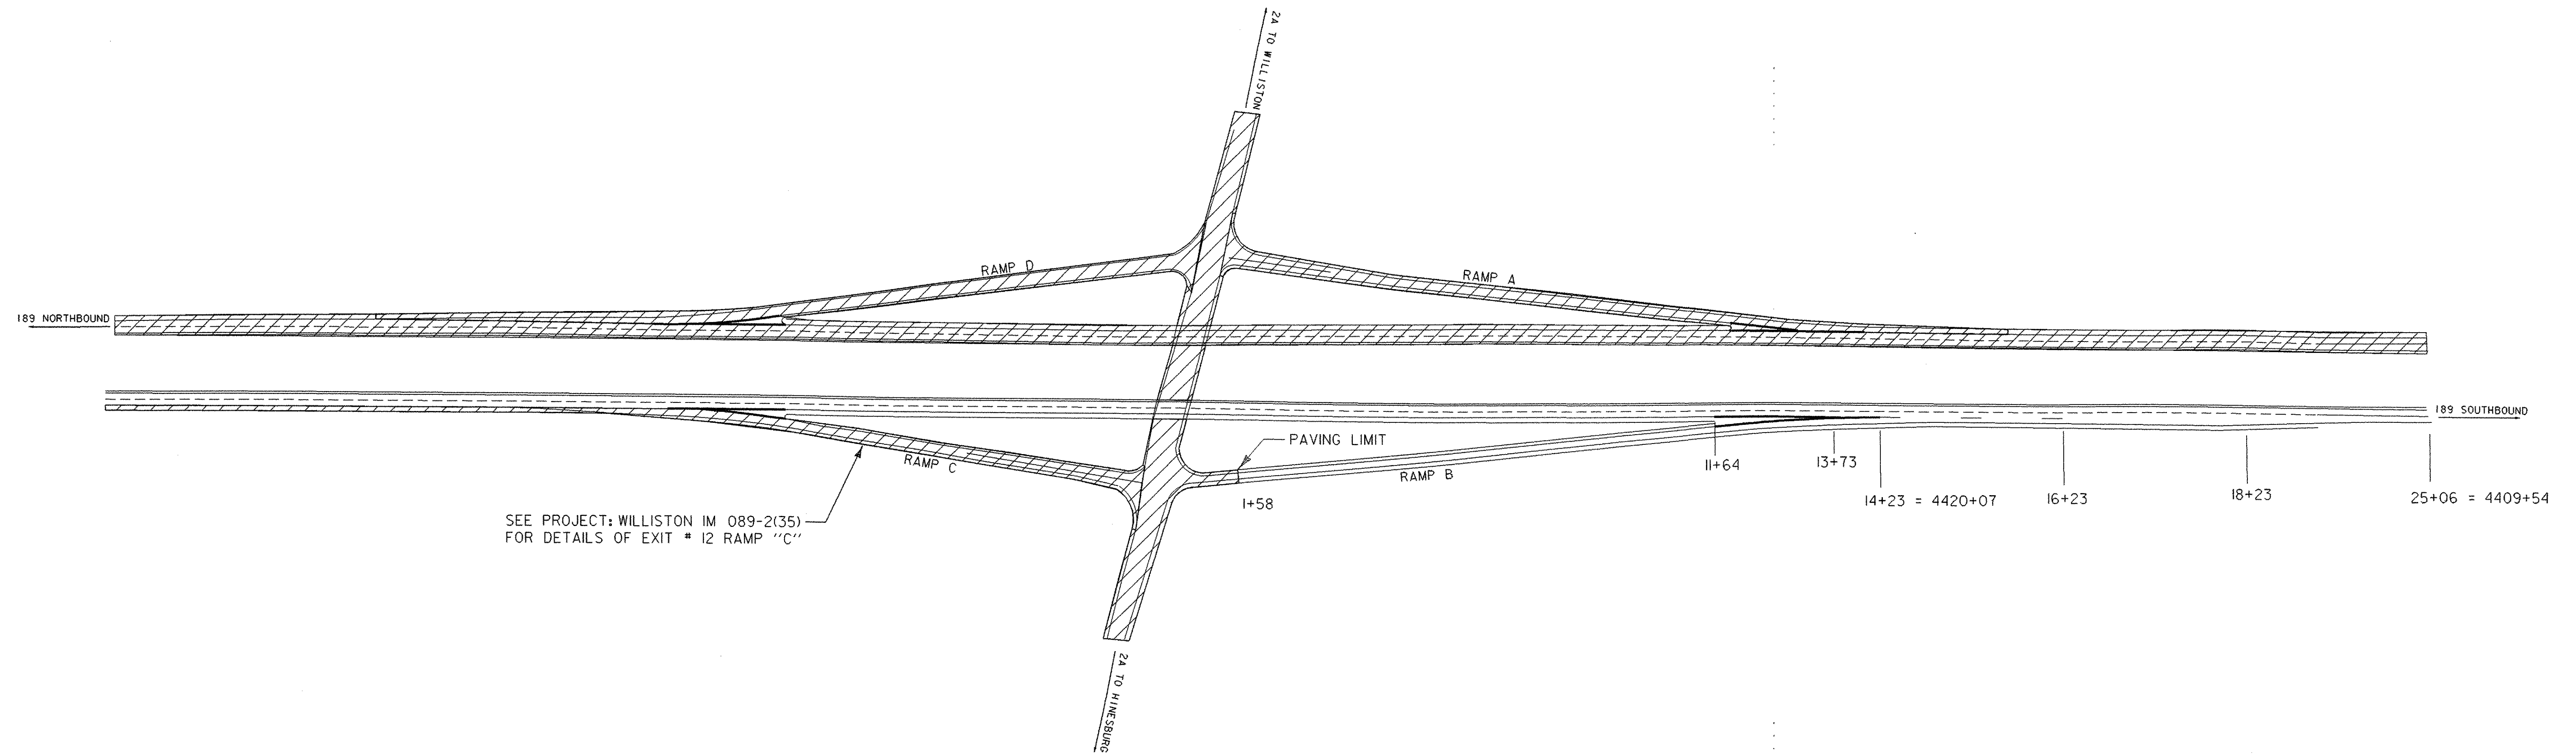

SEE PROJECT: WILLISTON IM 089-2(35)
FOR DETAILS OF EXIT # 12 RAMP "C"

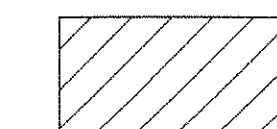 AREA NOT TO BE PAVED


REFER TO STD. E-191, E-192, & E-193 FOR FURTHER MARKING PLACEMENT DETAILS

**INTERCHANGE
12 PAVEMENT
MARKINGS
& SIGNS**



| | |
|---------------------------------------|------------------------|
| PROJECT NAME: BOLTON - SO. BURLINGTON | PLOT DATE: 17-MAY-2005 |
| PROJECT NUMBER: AC IM 089-2(36) | DRAWN BY: |
| FILE NAME: /pave/04all4/p04all4.dgn | DESIGNED BY: |
| DESIGNED BY: | CHECKED BY: |
| IPARM NAME: p04all4in+12.1 | SHEET 28 OF 76 |

62L505 MANUFACTURED TERMINAL SECTIONS (FLARED)
 RAMP "A" 13+25 RT. - 13+62.5 RT.

62L80 REMOVAL & DISP. OF GUARDRAIL
 RAMP "A" 13+25 RT. - 13+62.5 RT.

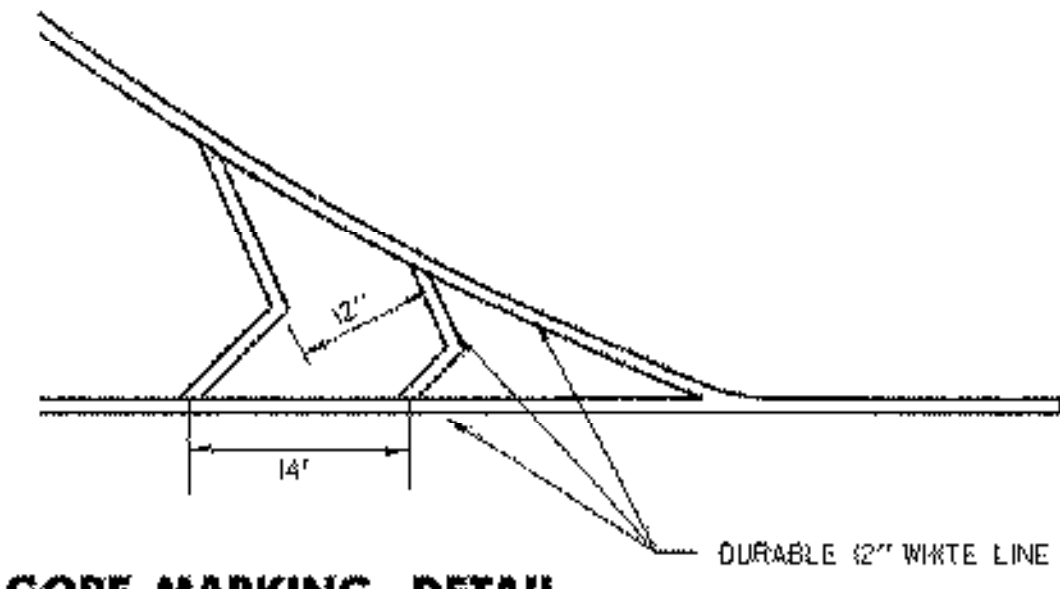


GORE MARKING DETAIL

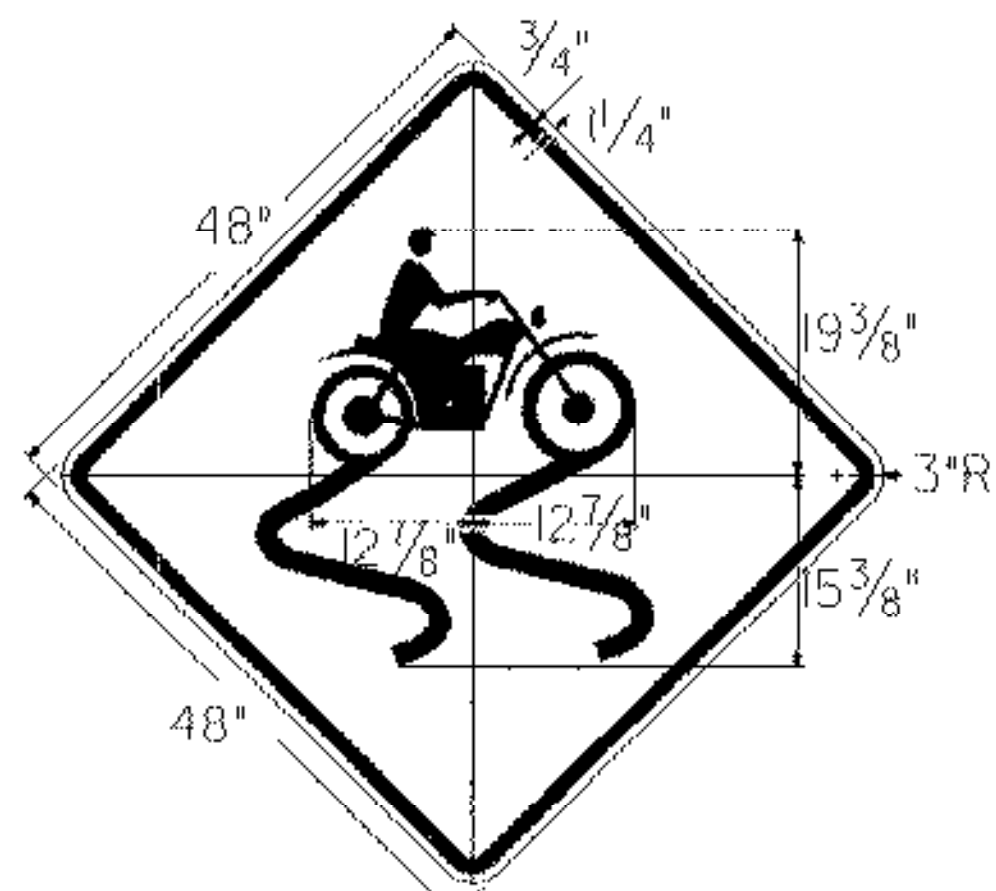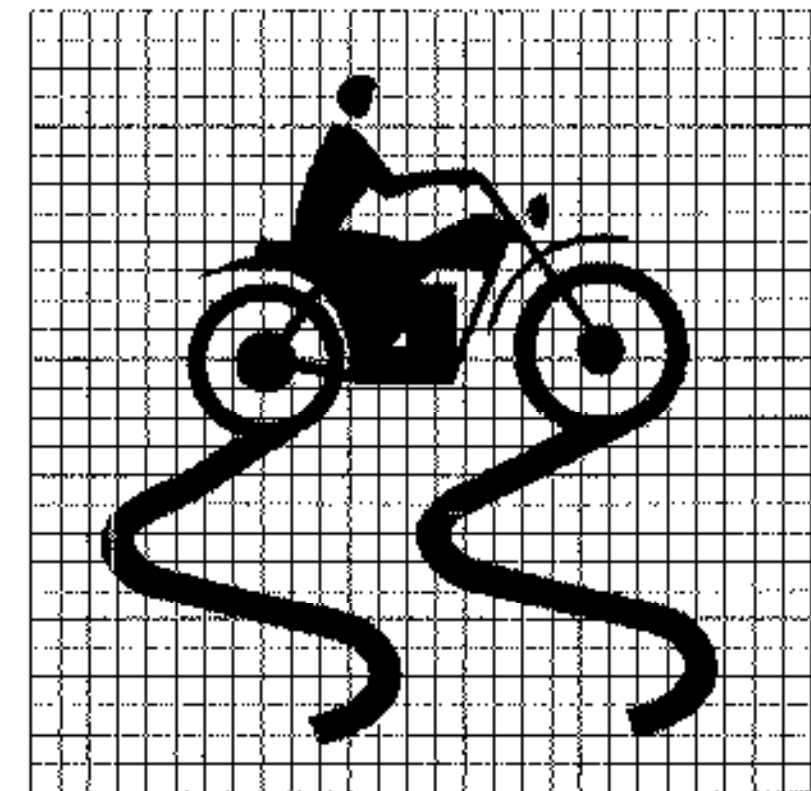

VW-397
 BLACK SYMBOL & BORDER
 WITH YELLOW BACKGROUND

REFER TO STD. E-191, E-192, & E-193 FOR FURTHER MARKING PLACEMENT DETAILS

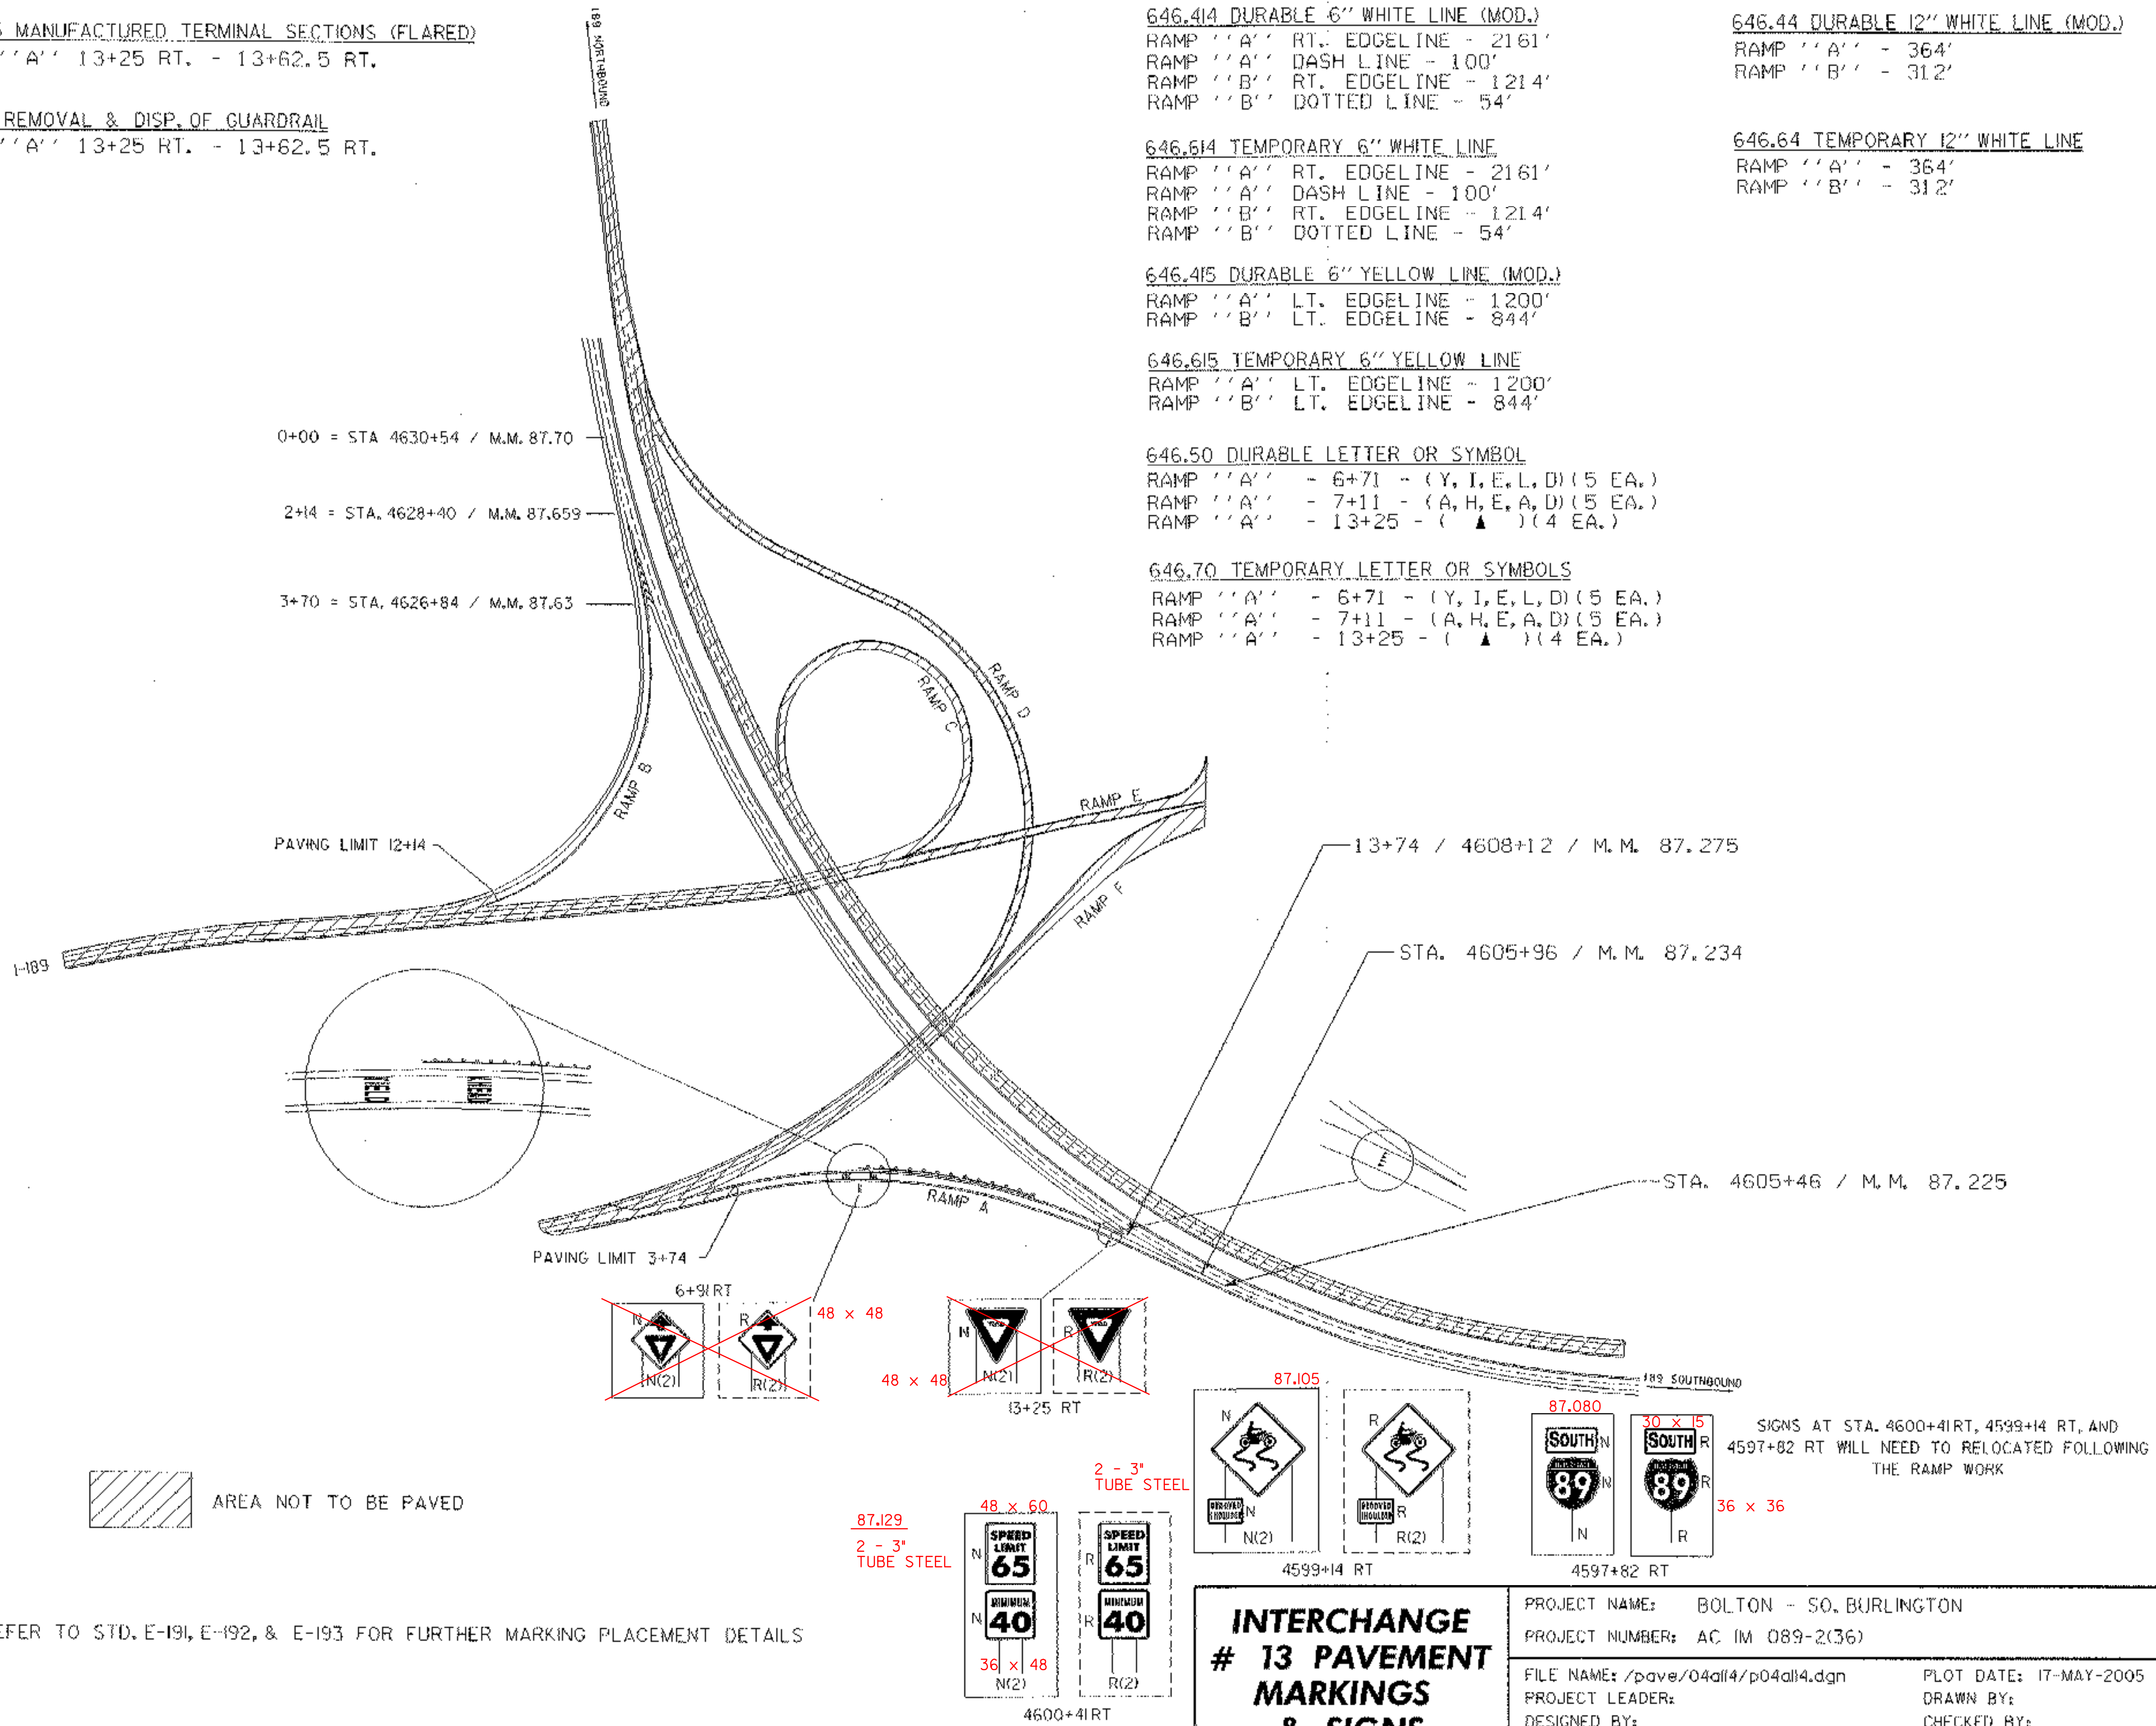

**INTERCHANGE
 # 13 PAVEMENT
 MARKINGS
 & SIGNS**



PROJECT NAME: BOLTON - SO. BURLINGTON
 PROJECT NUMBER: AC IM 089-2(36)
 FILE NAME: /pave/04all4/p04all4.dgn
 PROJECT LEADER:
 DESIGNED BY:
 #ARM NAME: p04all4int13.1
 PLOT DATE: 17-MAY-2005
 DRAWN BY:
 CHECKED BY:
 SHEET 29 OF 76

646.414 DURABLE 6" WHITE LINE (MOD.)
 OFF RAMP RT. EDGELINE - 761'
 OFF RAMP RT. DOTTED LINE - 92'
 OFF RAMP DASH LINE - 43'
 ON RAMP RT. EDGELINE - 1425'
 ON RAMP DASH LINE - 51'

646.44 DURABLE 12" WHITE LINE (MOD.)
 OFF RAMP - 410'
 ON RAMP - 436'


646.614 TEMPORARY 6" WHITE LINE
 OFF RAMP RT. EDGELINE - 761'
 OFF RAMP RT. DOTTED LINE - 92'
 OFF RAMP DASH LINE - 43'
 ON RAMP RT. EDGELINE - 1425'
 ON RAMP DASH LINE - 51'

646.64 TEMPORARY 12" WHITE LINE
 OFF RAMP - 410'
 ON RAMP - 436'

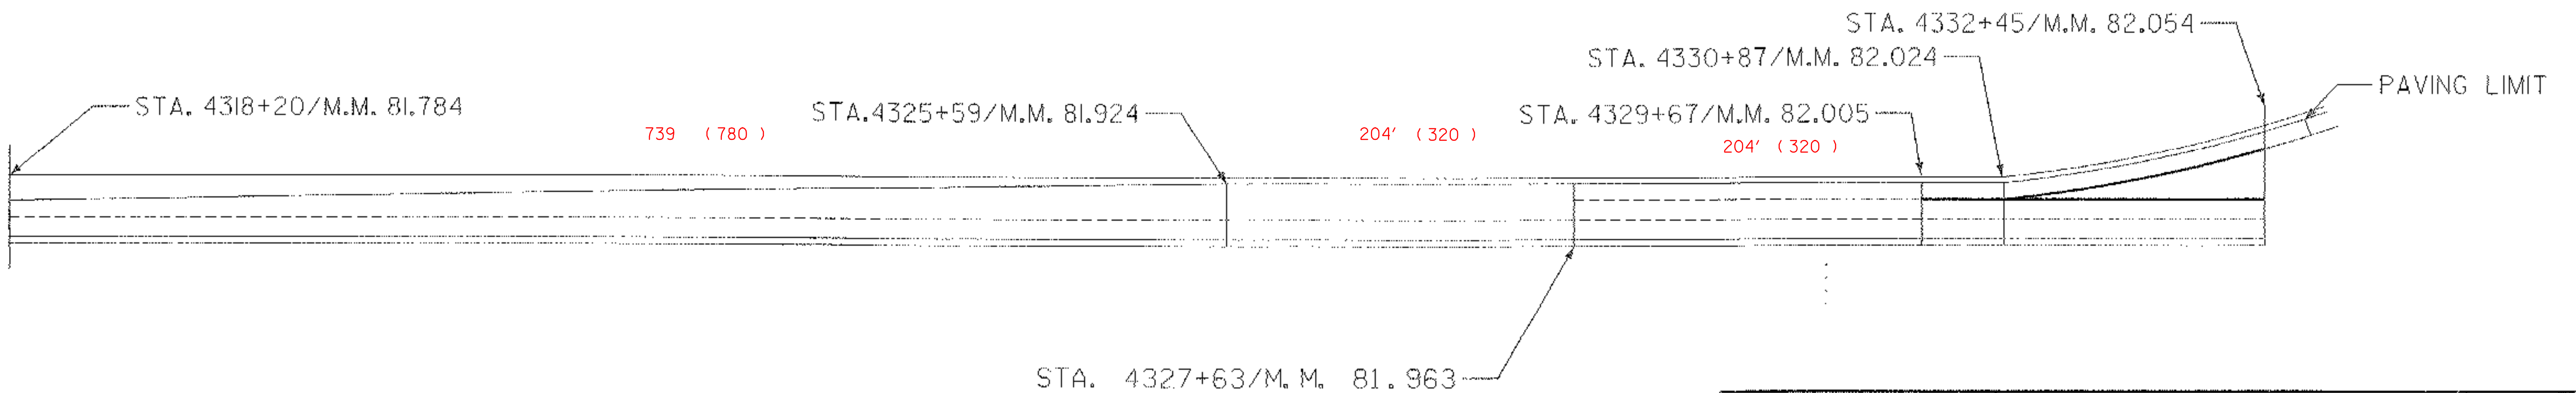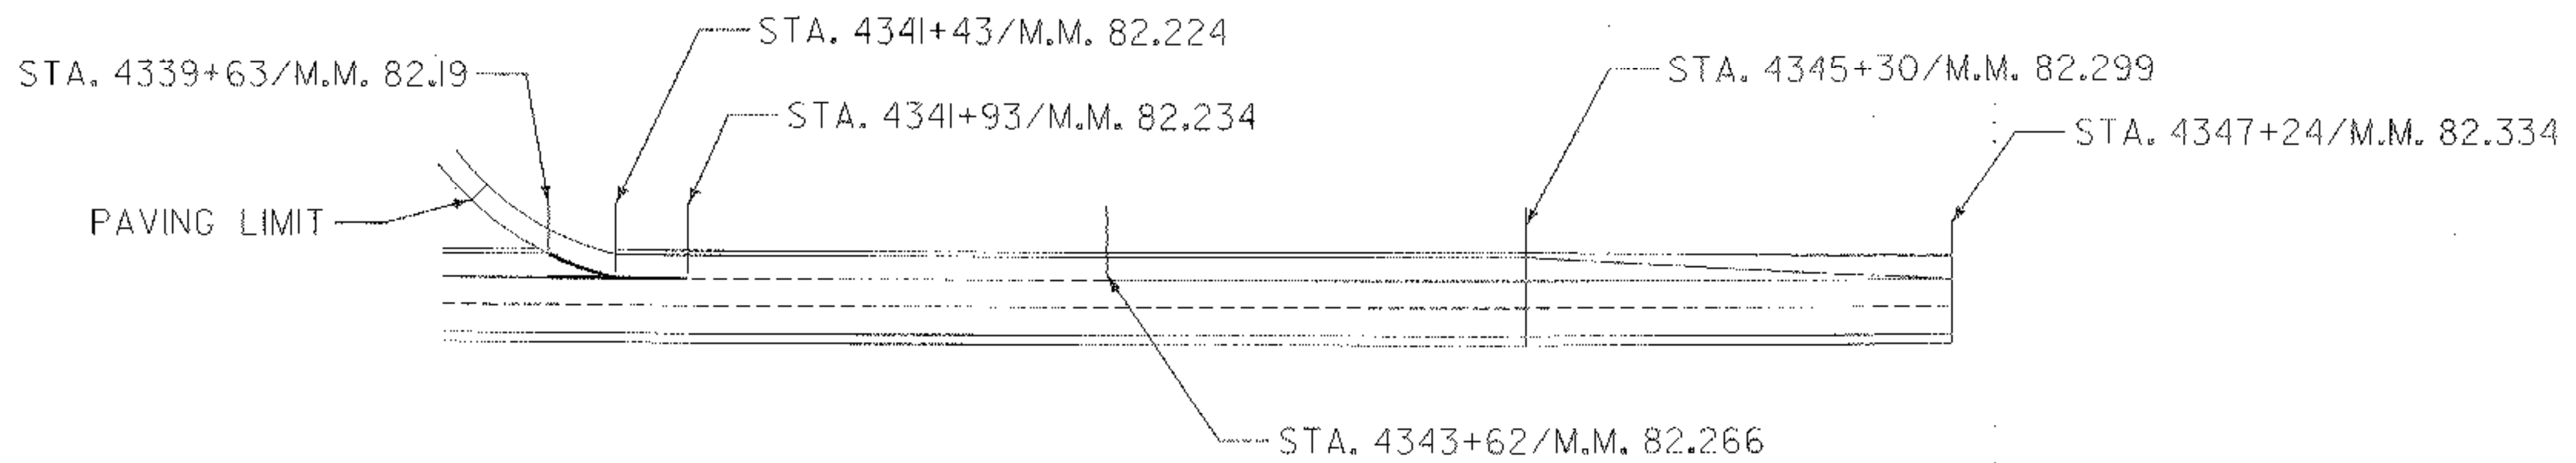


| | | | |
|--|---------------------------------------|------------------------------------|------------------------|
| SOUTHBOUND REST AREA PAVEMENT MARKING DETAILS & PAVING LIMITS | PROJECT NAME: BOLTON - SO. BURLINGTON | FILE NAME: /pave/p04dl4/p04dl4.dgn | PLOT DATE: 17-MAY-2005 |
| | PROJECT NUMBER: AC IM 089-2(36) | DESIGNED BY: | DRAWN BY: |
| | | CHECKED BY: | |
| | | IPARM FILE NAME: p04dl4sbr.dwg | CHECKED BY: |

TYPICAL MILLING DETAIL

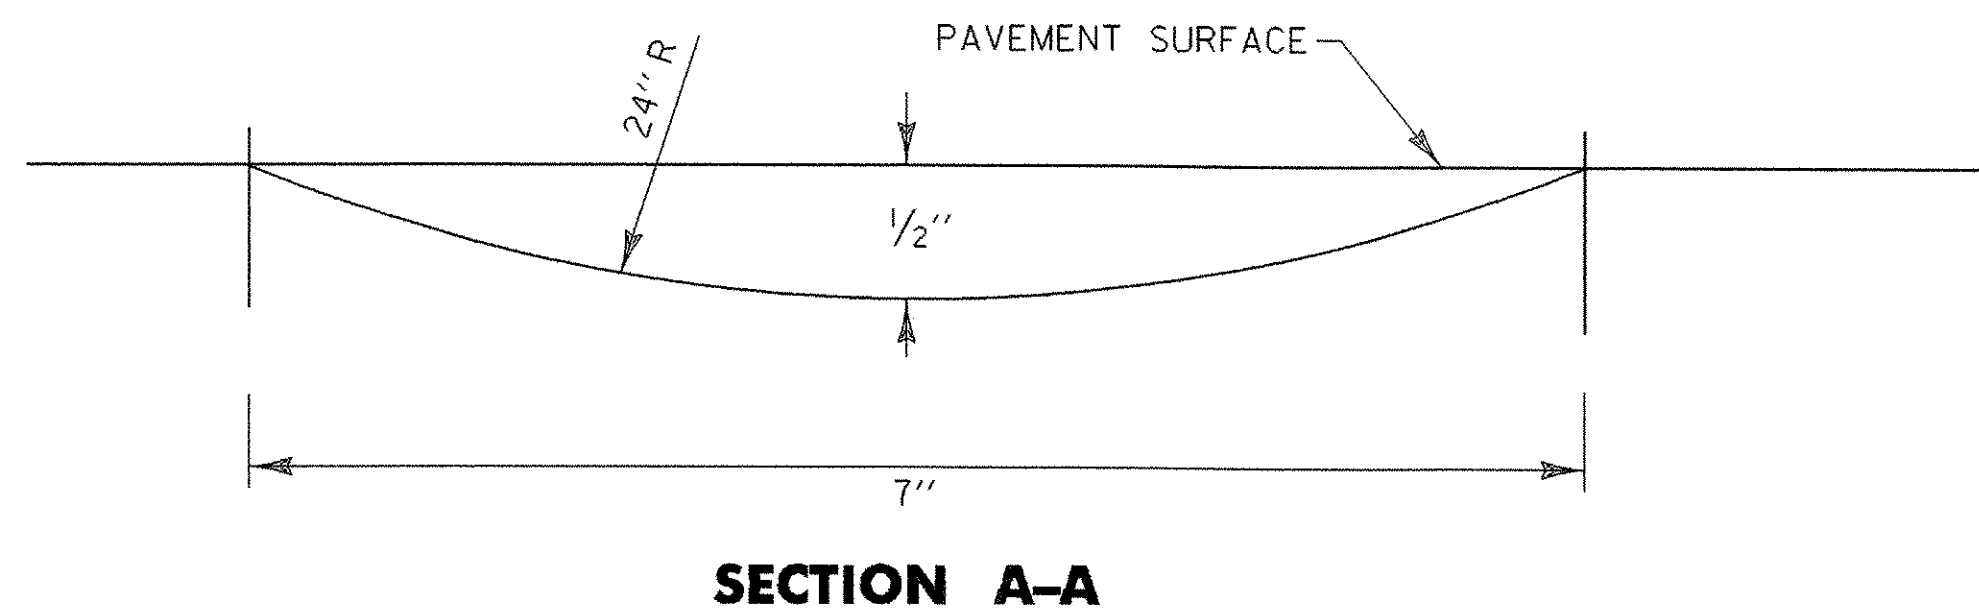


U TURN DETAIL

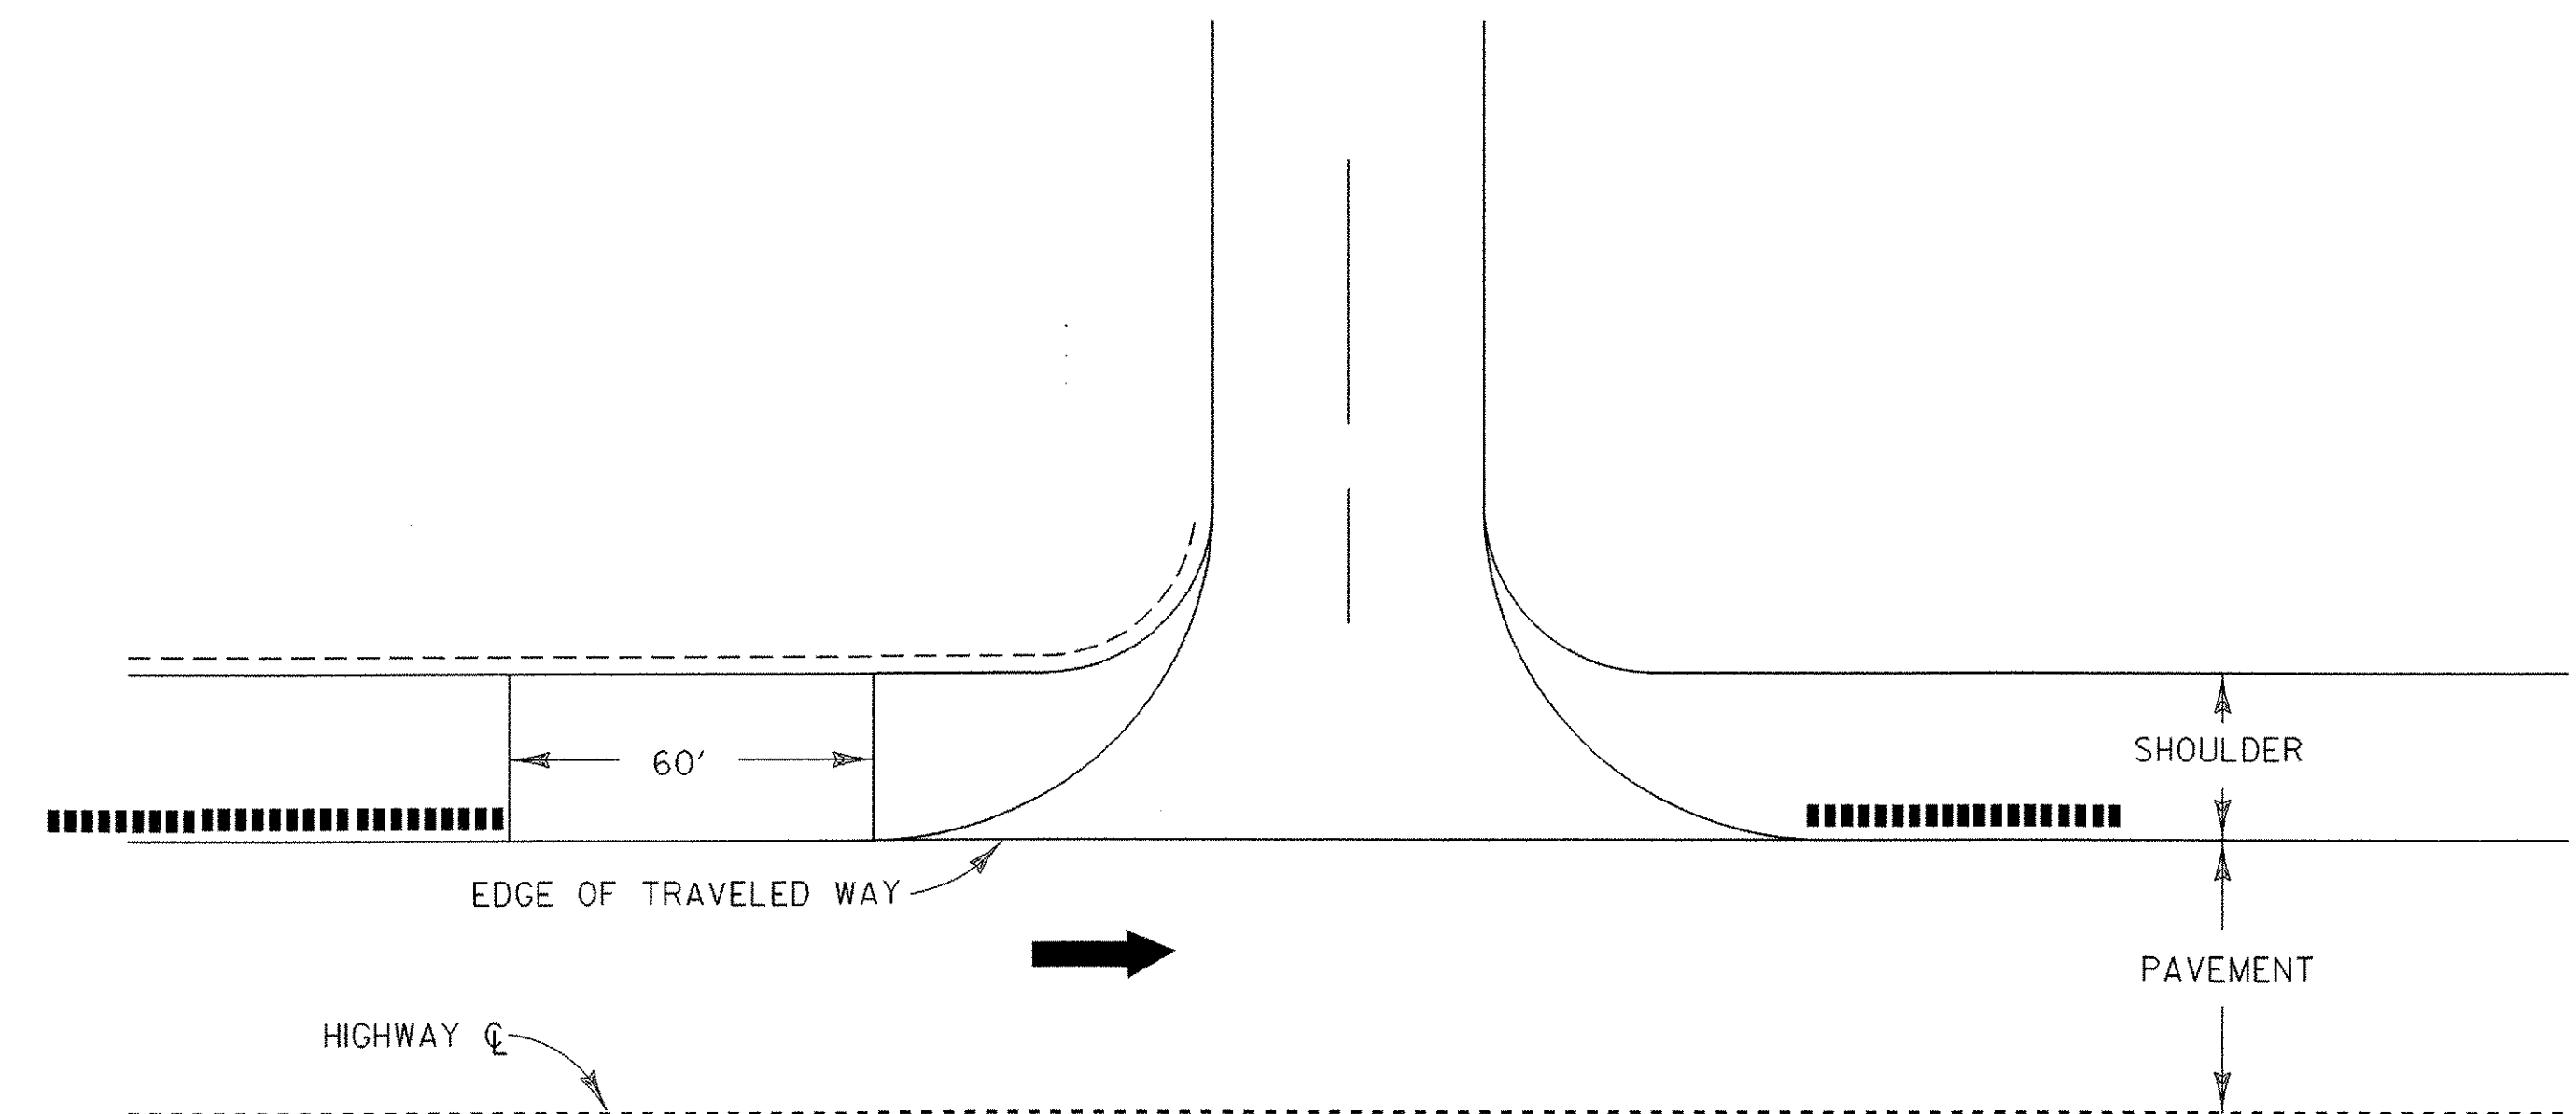


SECTION A-A

30" FOR ALL SHOULDERS 6' OR WIDER.
6" FOR ALL SHOULDERS LESS THEN 6'
WITH NO GUARD RAIL. MILLED RUMBLE STRIPS
WILL NOT BE REQUIRED IN GUARD RAIL AREAS
ADJACENT TO THE 4' SHOULDER.

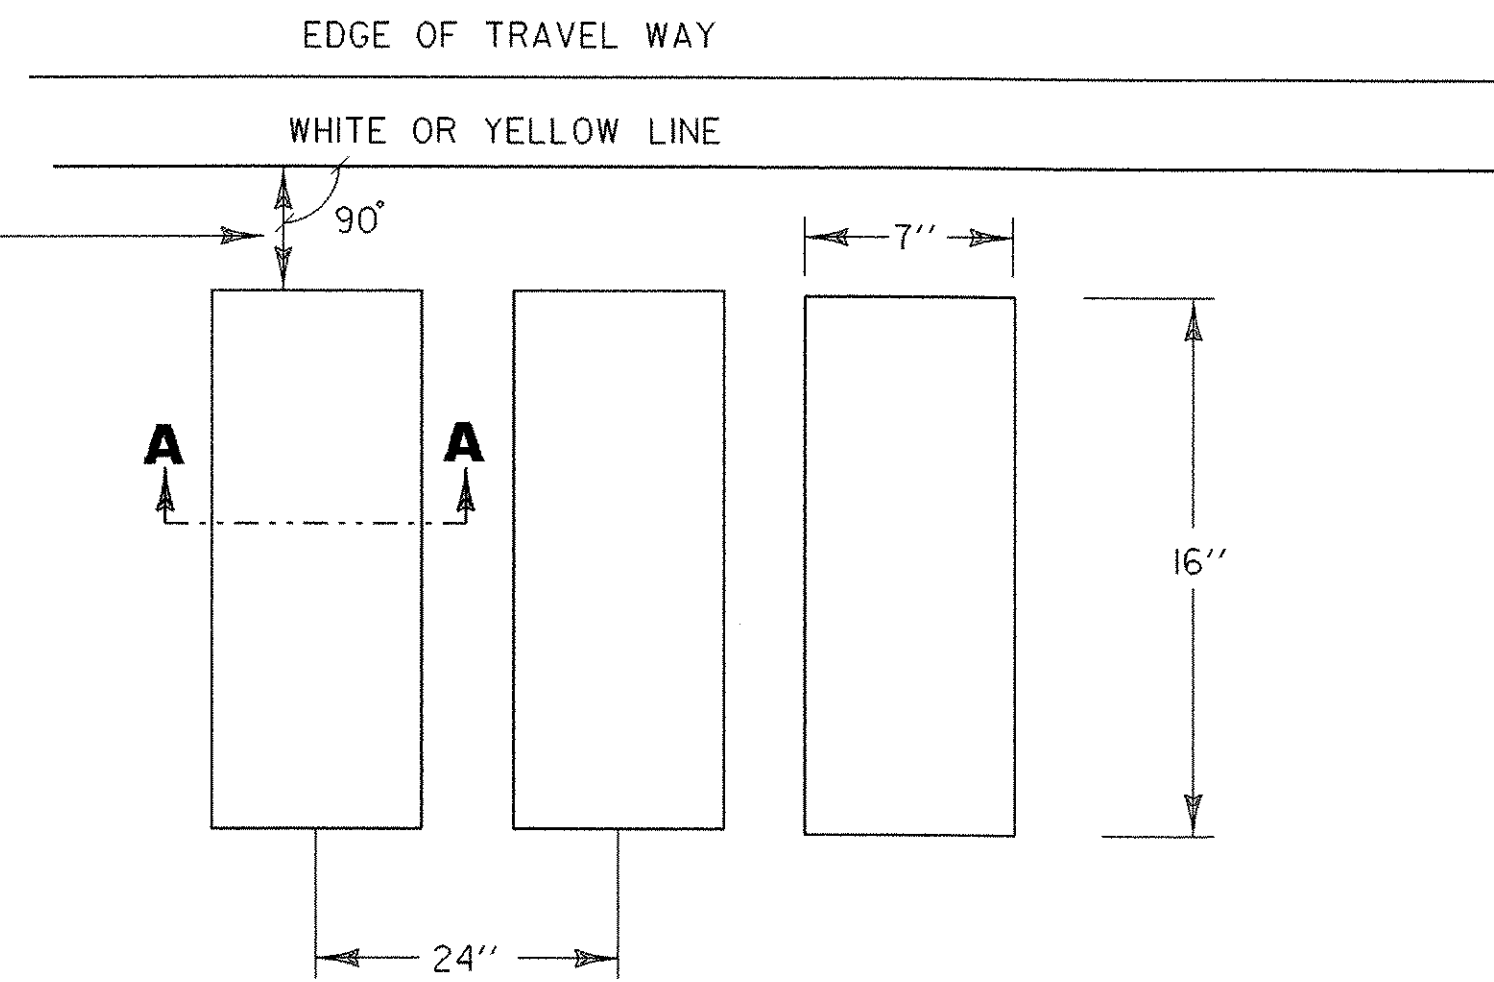

BRIDGE DETAIL

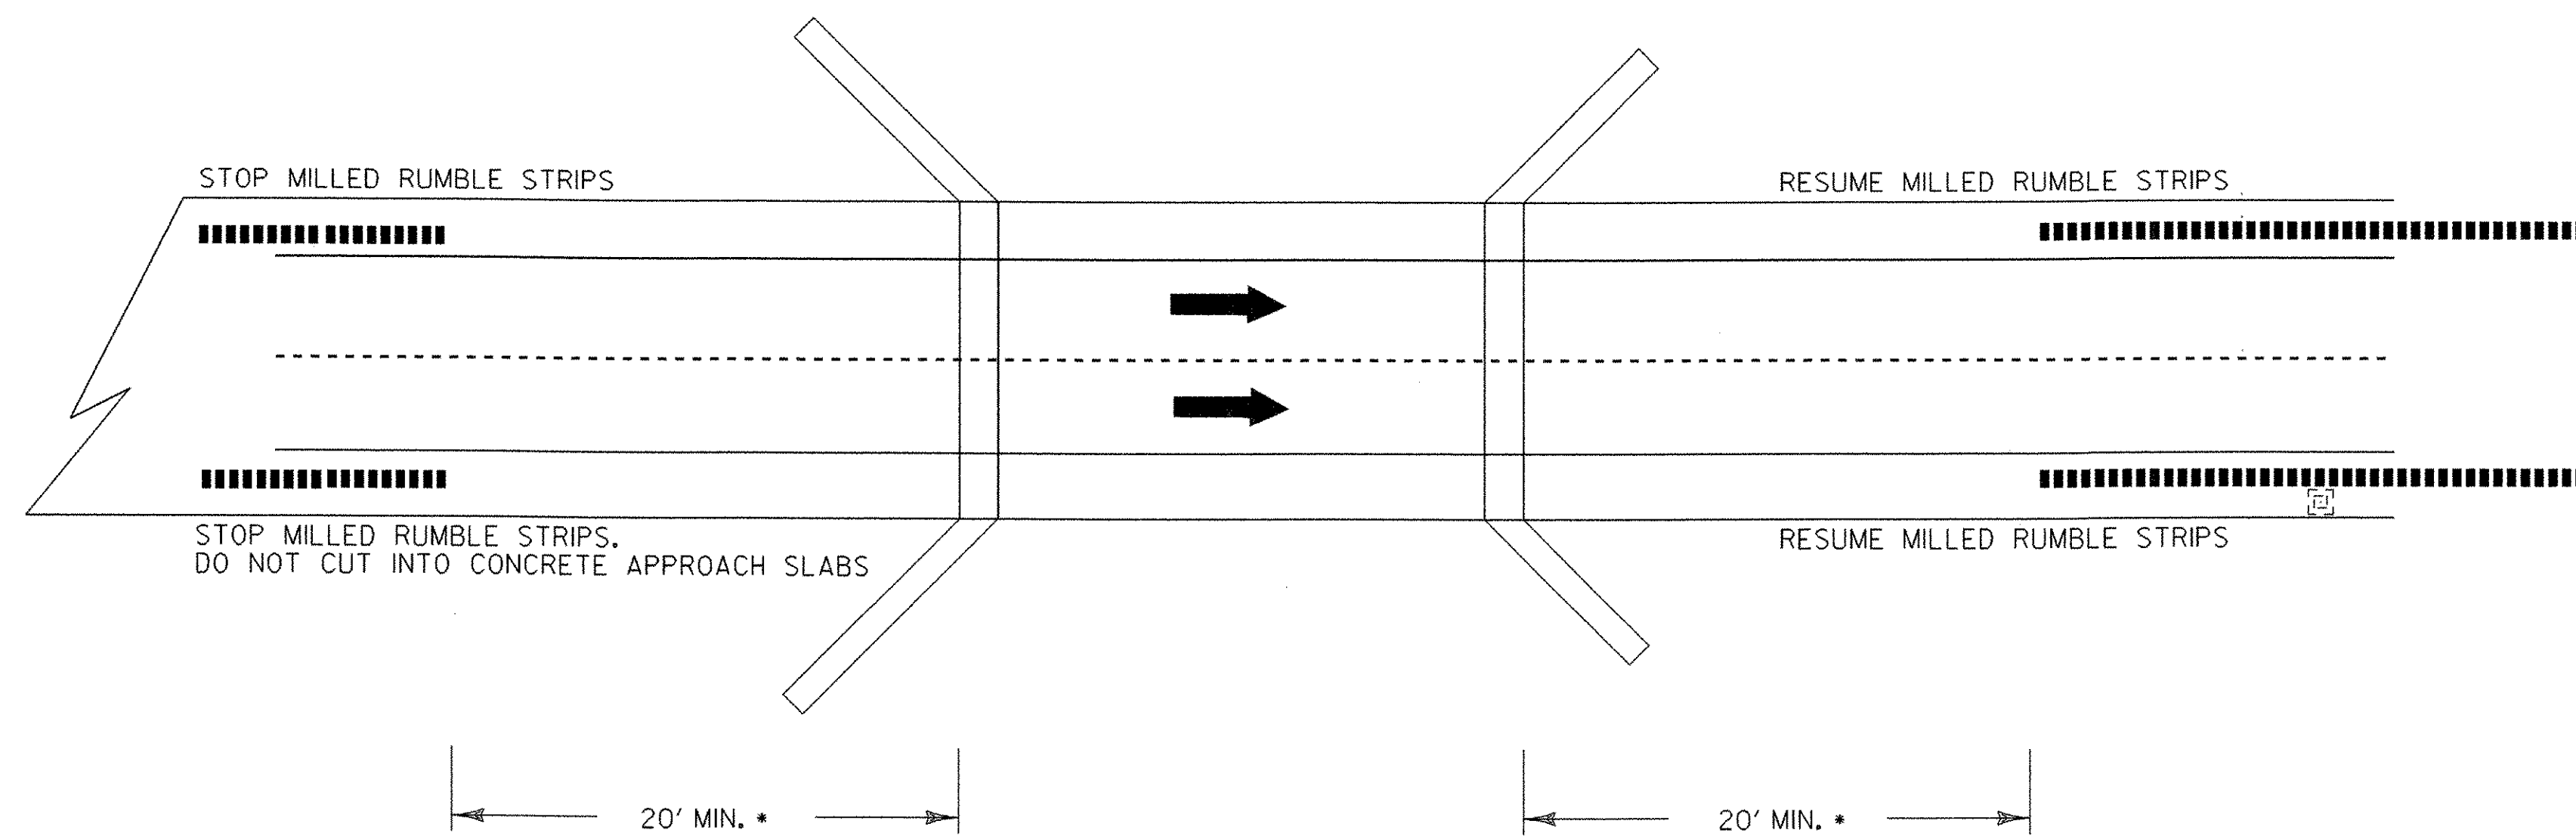

* NOTE: BRIDGE RAIL WILL DETERMINE MINIMUM DISTANCE IN SOME CASES.

LEGEND



- DIRECTION OF TRAFFIC FLOW
- MILLED RUMBLE STRIPS
- NOT TO SCALE

MILLED RUMBLE STRIPS DETAIL #1



PROJECT NAME: BOLTON - SO. BURLINGTON
PROJECT NUMBER: AC IM 089-2(36)

FILE NAME: /pave/04all4/p04all4.dgn PLOT DATE: 17-MAY-2005
PROJECT LEADER: DRAWN BY:
DESIGNED BY: CHECKED BY:
IPARM FILE NAME: p04all4mr1.i SHEET 31 OF 76

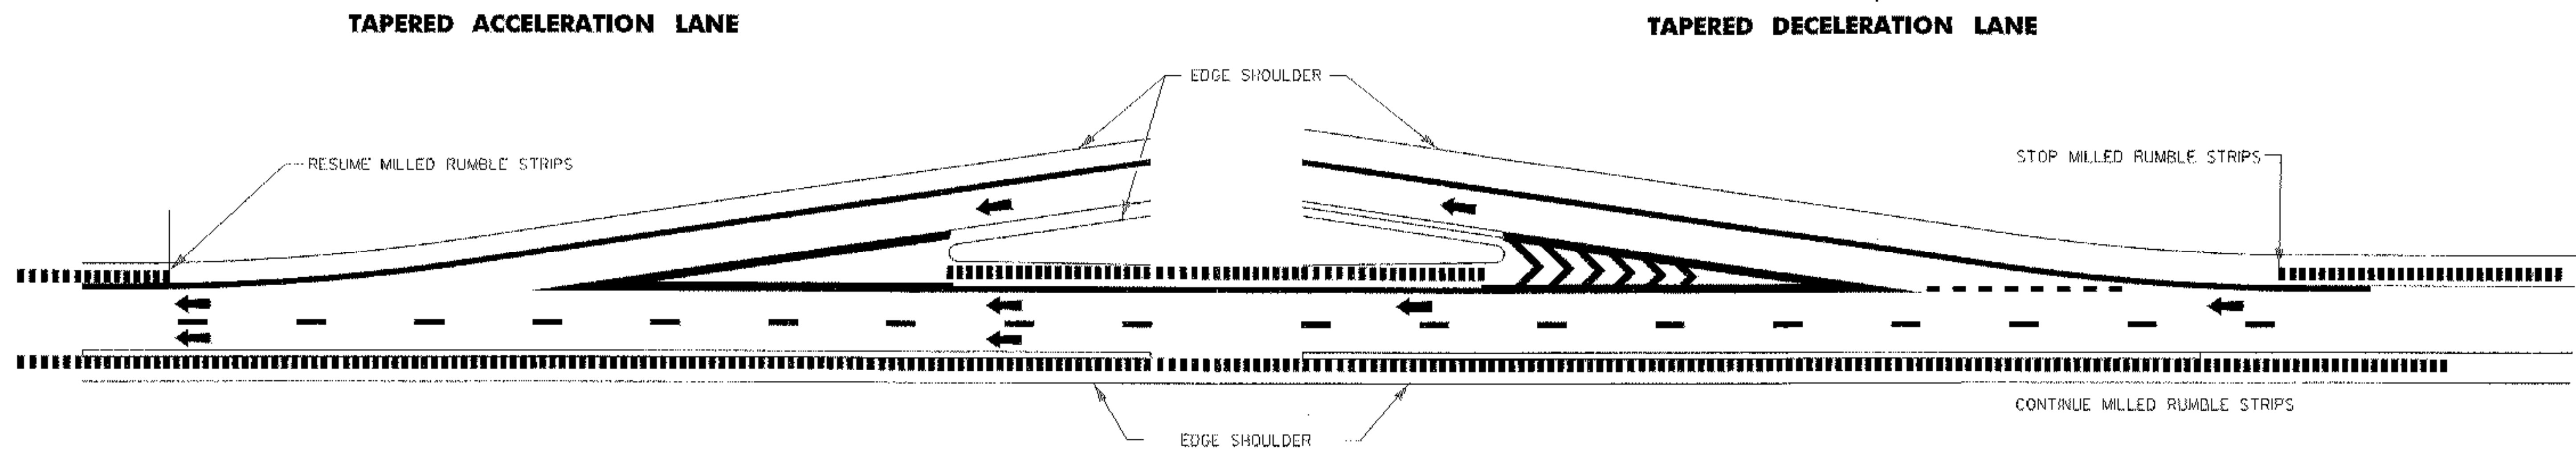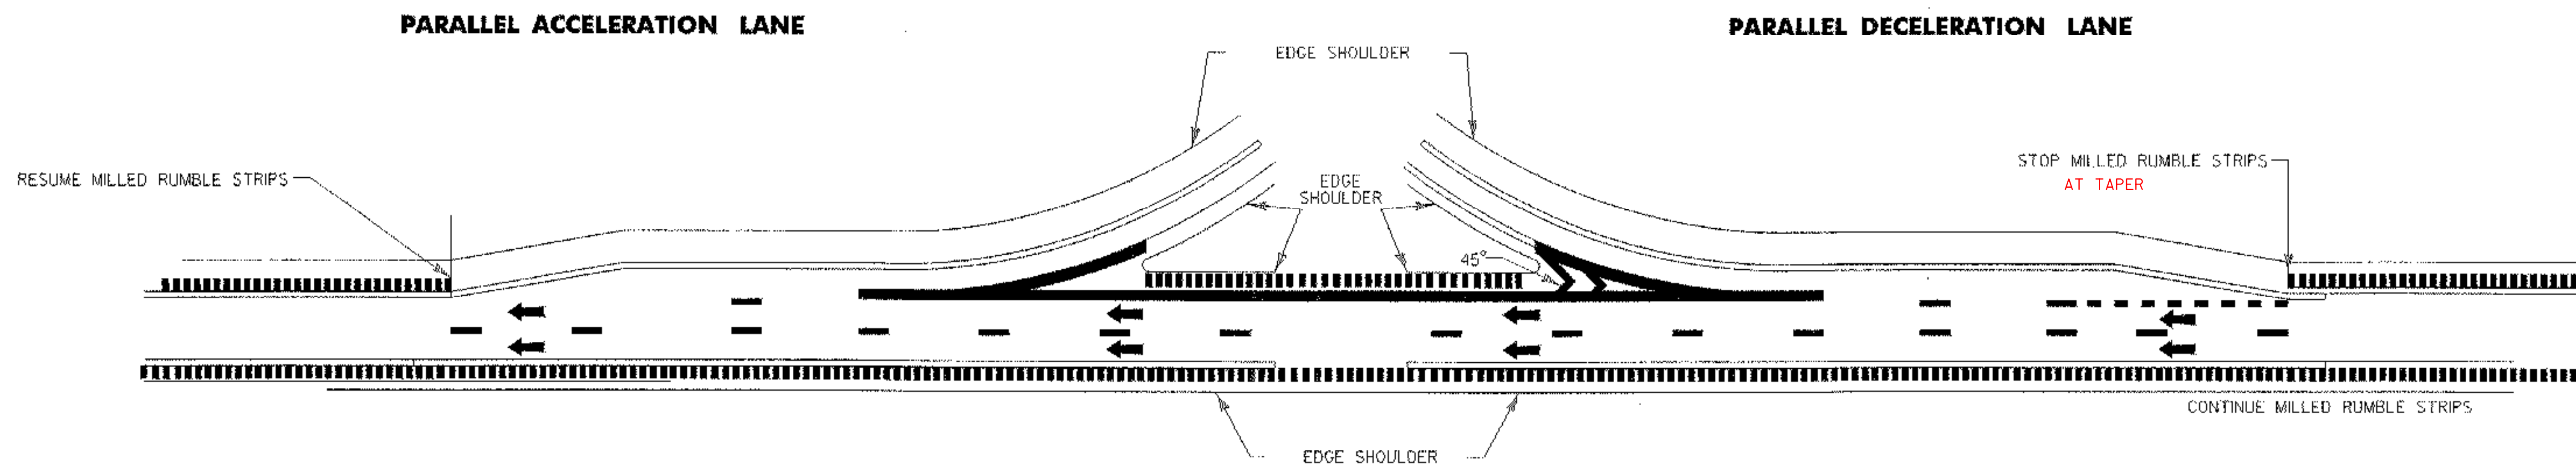TYPICAL MILLED RUMBLE STRIPS AT INTERCHANGES & REST AREAS





LEGEND

-  DIRECTION OF TRAFFIC FLOW
-  MILLED RUMBLE STRIPS
- NOT TO SCALE

NOTES:
 1) THIS TYPICAL MAYBE MODIFIED AT THE RESIDENT ENGINEER DISCRETION IF THE ACTUAL FIELD CONDITIONS NECESSITATE SUCH ACTIONS.

| | | |
|---------------------------------------|--|------------------------|
| MILLED RUMBLE STRIPS DETAIL #2 | PROJECT NAME: BOLTON -- SO. BURLINGTON | PLOT DATE: 17-MAY-2005 |
| | PROJECT NUMBER: AC IM 089-2(36) | DRAWN BY: |
| | FILE NAME: /pave/04all4/p04all4.dgn | CHECKED BY: |
| | DESIGNED BY: | SHEET 32 OF 76 |
| | IPARM FILE NAME: p04all4mr2.1 | |

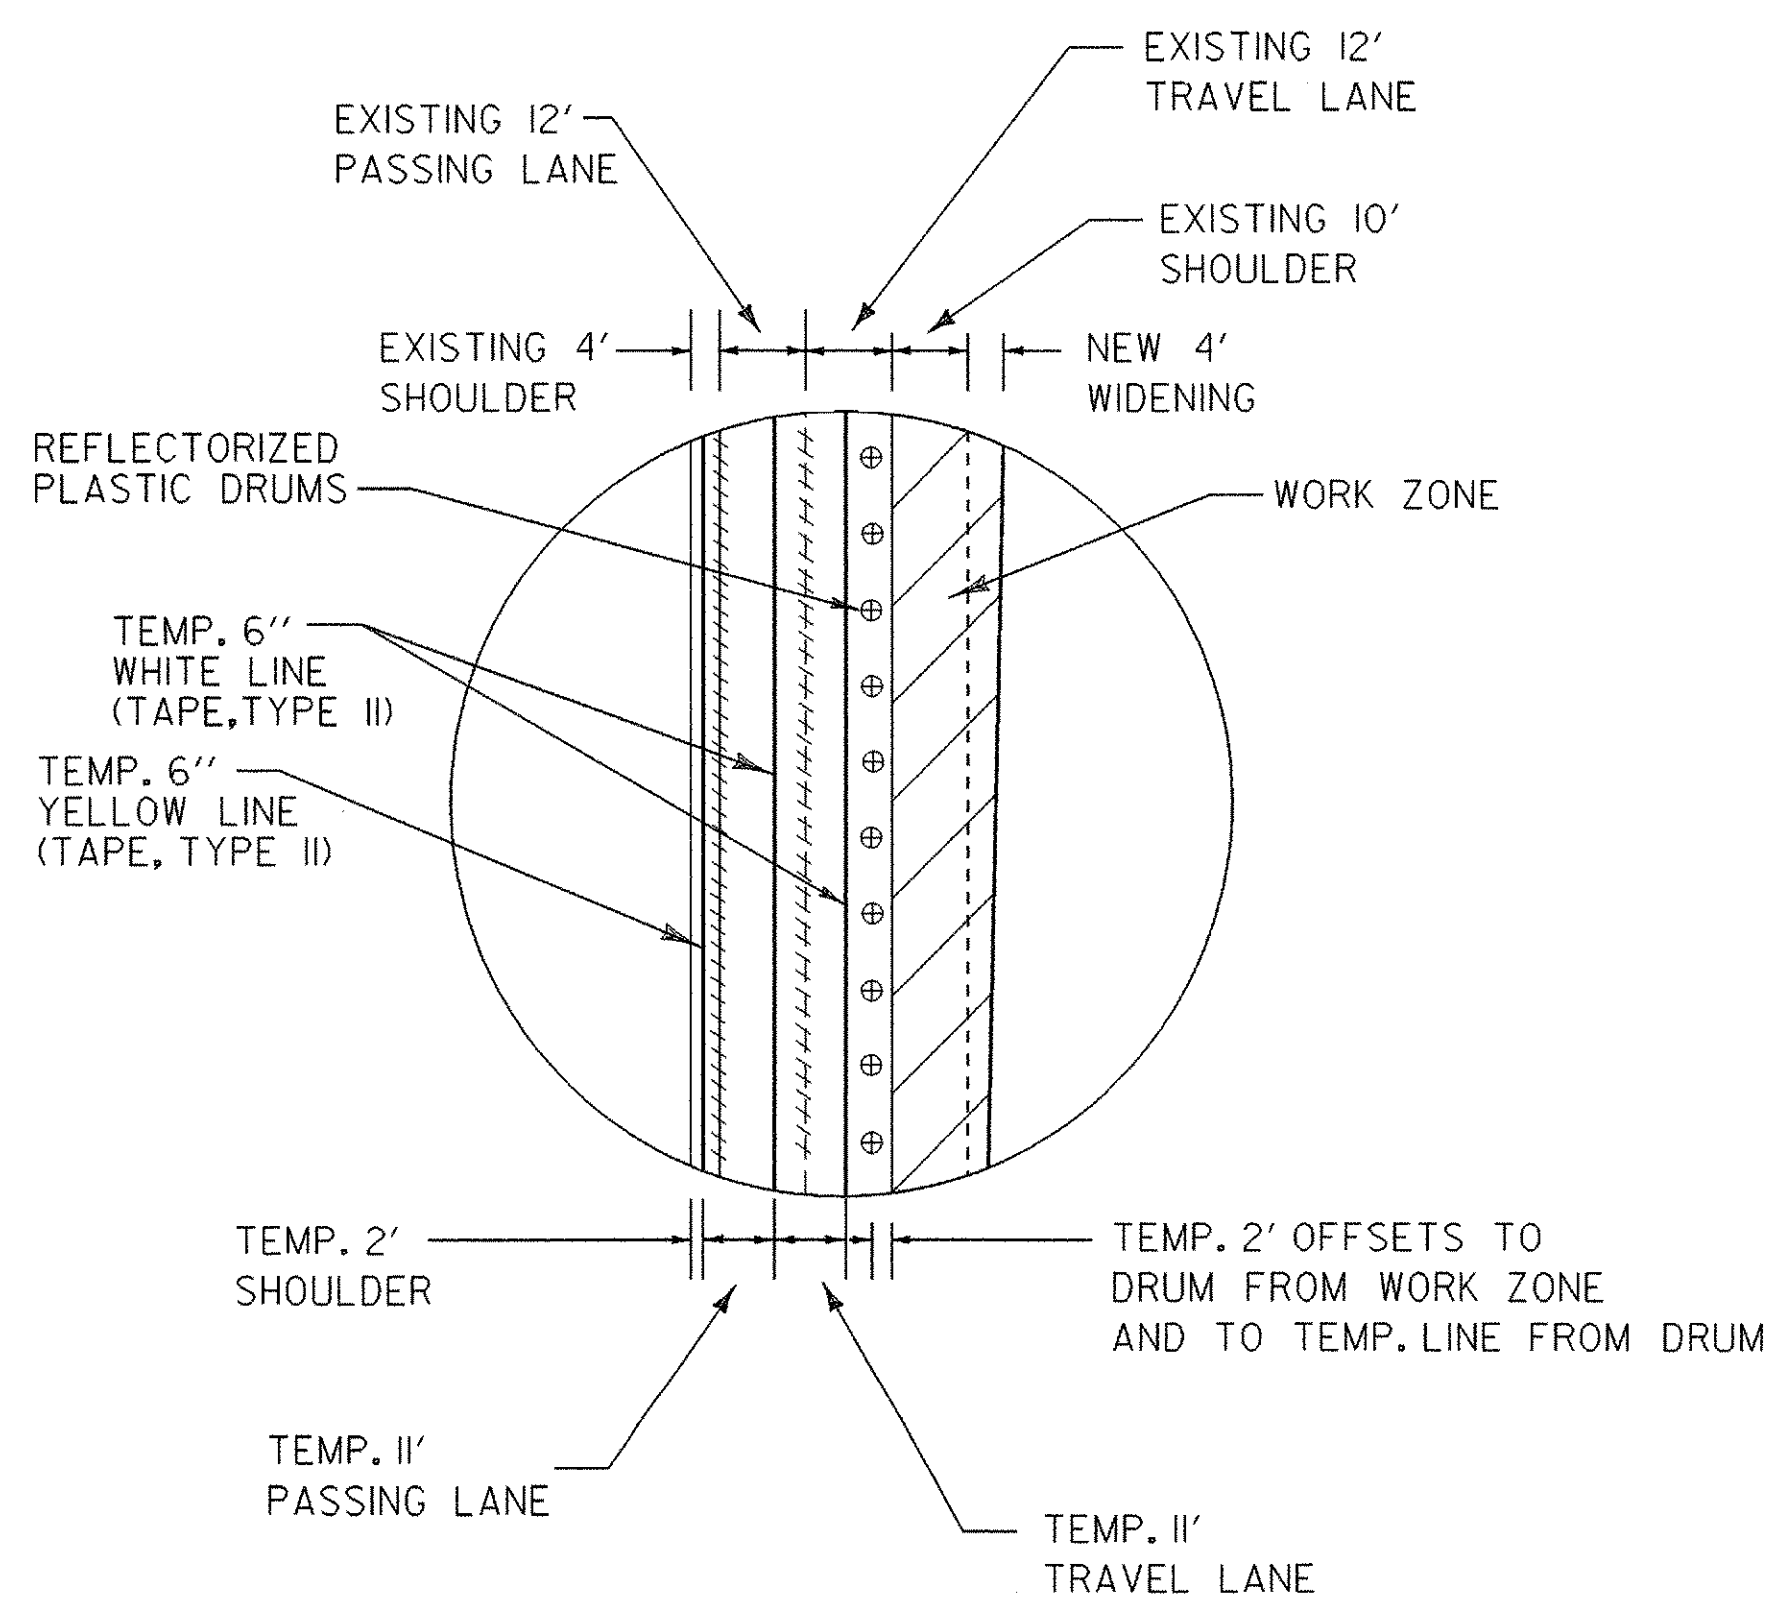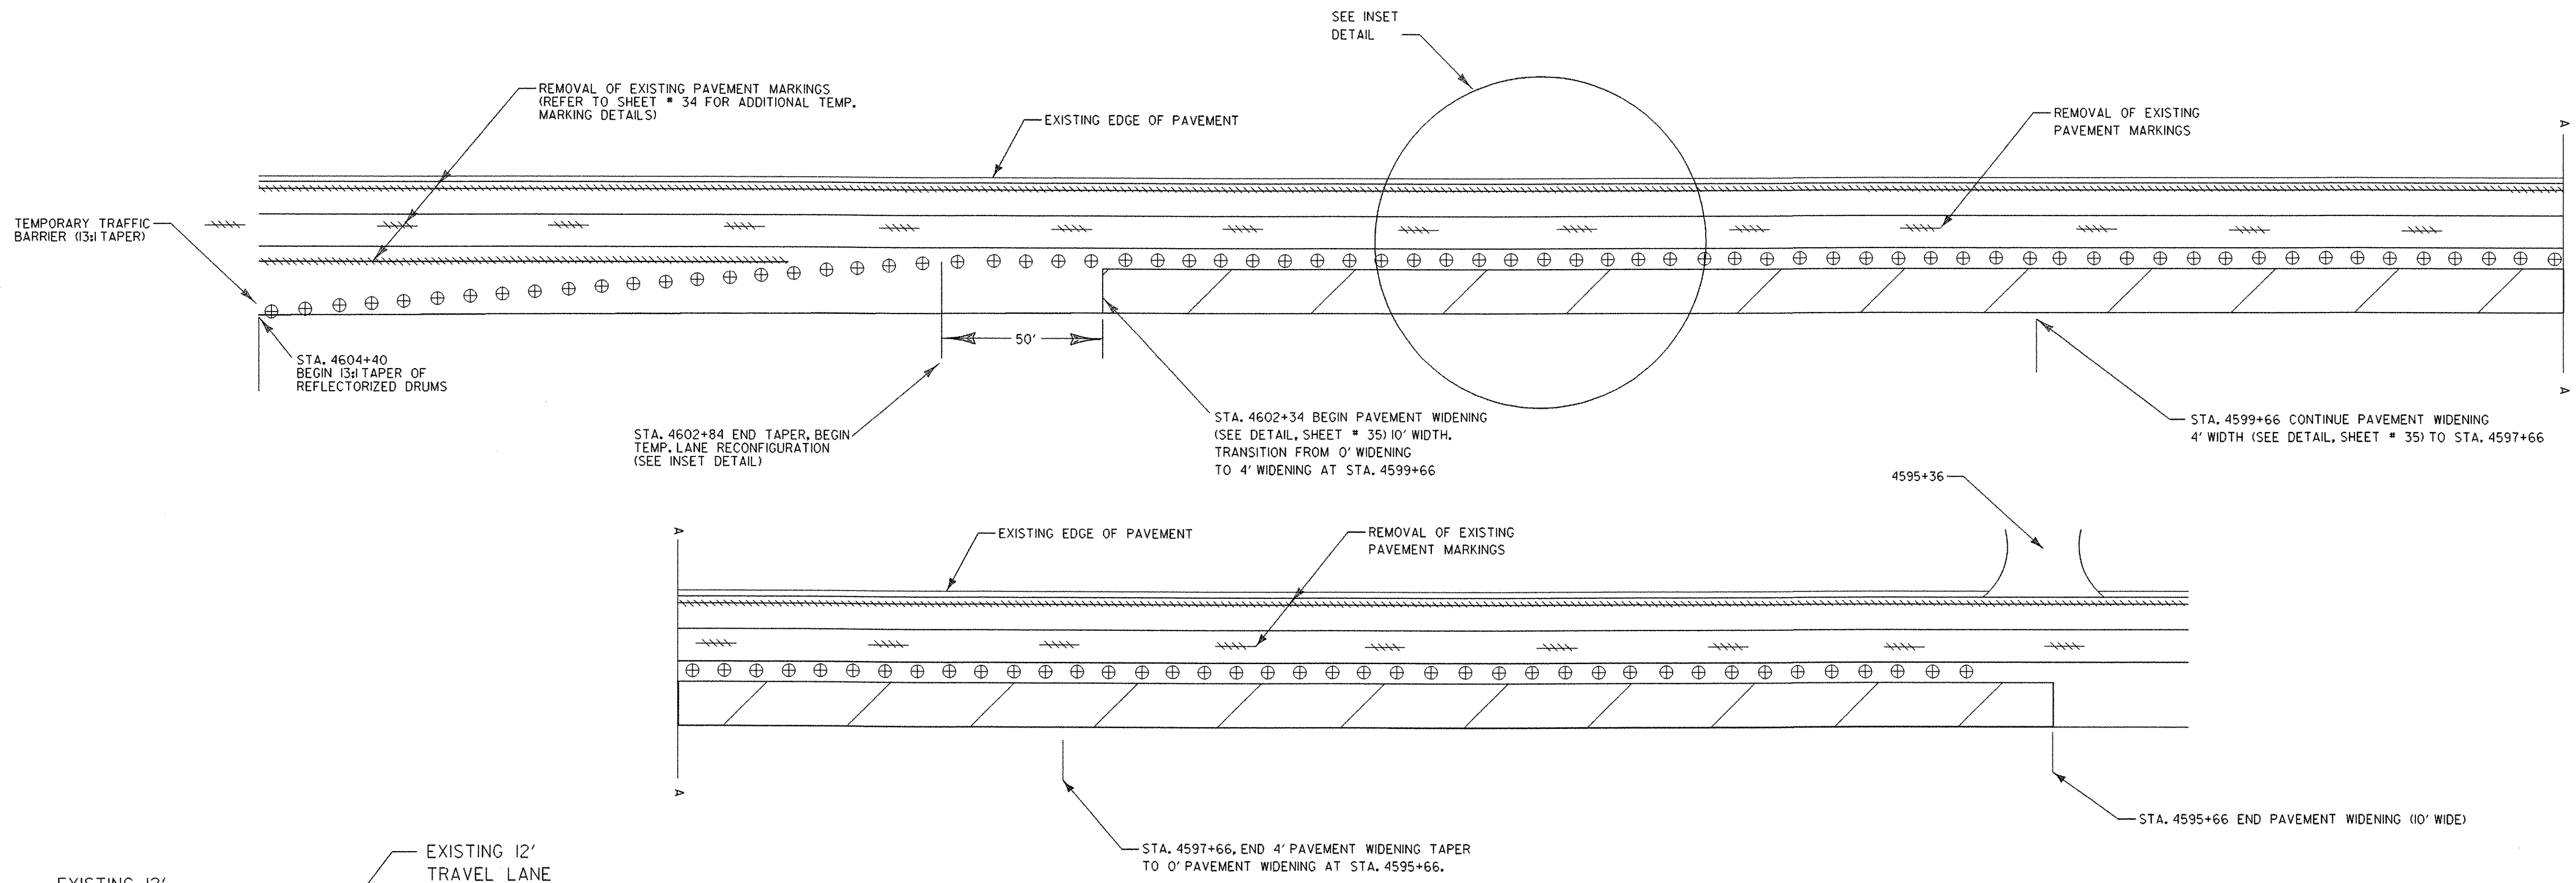


INSET DETAIL
N.T.S.

SEE STD. E-103 & E-106 FOR BARREL PLACEMENT AND TAPER LENGTHS

- LEGEND**
- ⊕ - REFLECTORIZED PLASTIC DRUMS
 - - REMOVAL OF EXISTING PAVEMENT MARKINGS

| | | | |
|--|--|---------------------------------------|------------------------|
| TRAFFIC CONTROL PLAN EXIT 13 RAMP "A" | | PROJECT NAME: BOLTON - SO. BURLINGTON | PLOT DATE: 17-MAY-2005 |
| | | PROJECT NUMBER: AC IM 089-2(36) | DRAWN BY: |
| | | FILE NAME: /pave/04all4/p04all4.dgn | CHECKED BY: |
| | | DESIGNED BY: | SHEET 33 OF 76 |
| | | IPARM NAME: p04all4+cp01.i | |

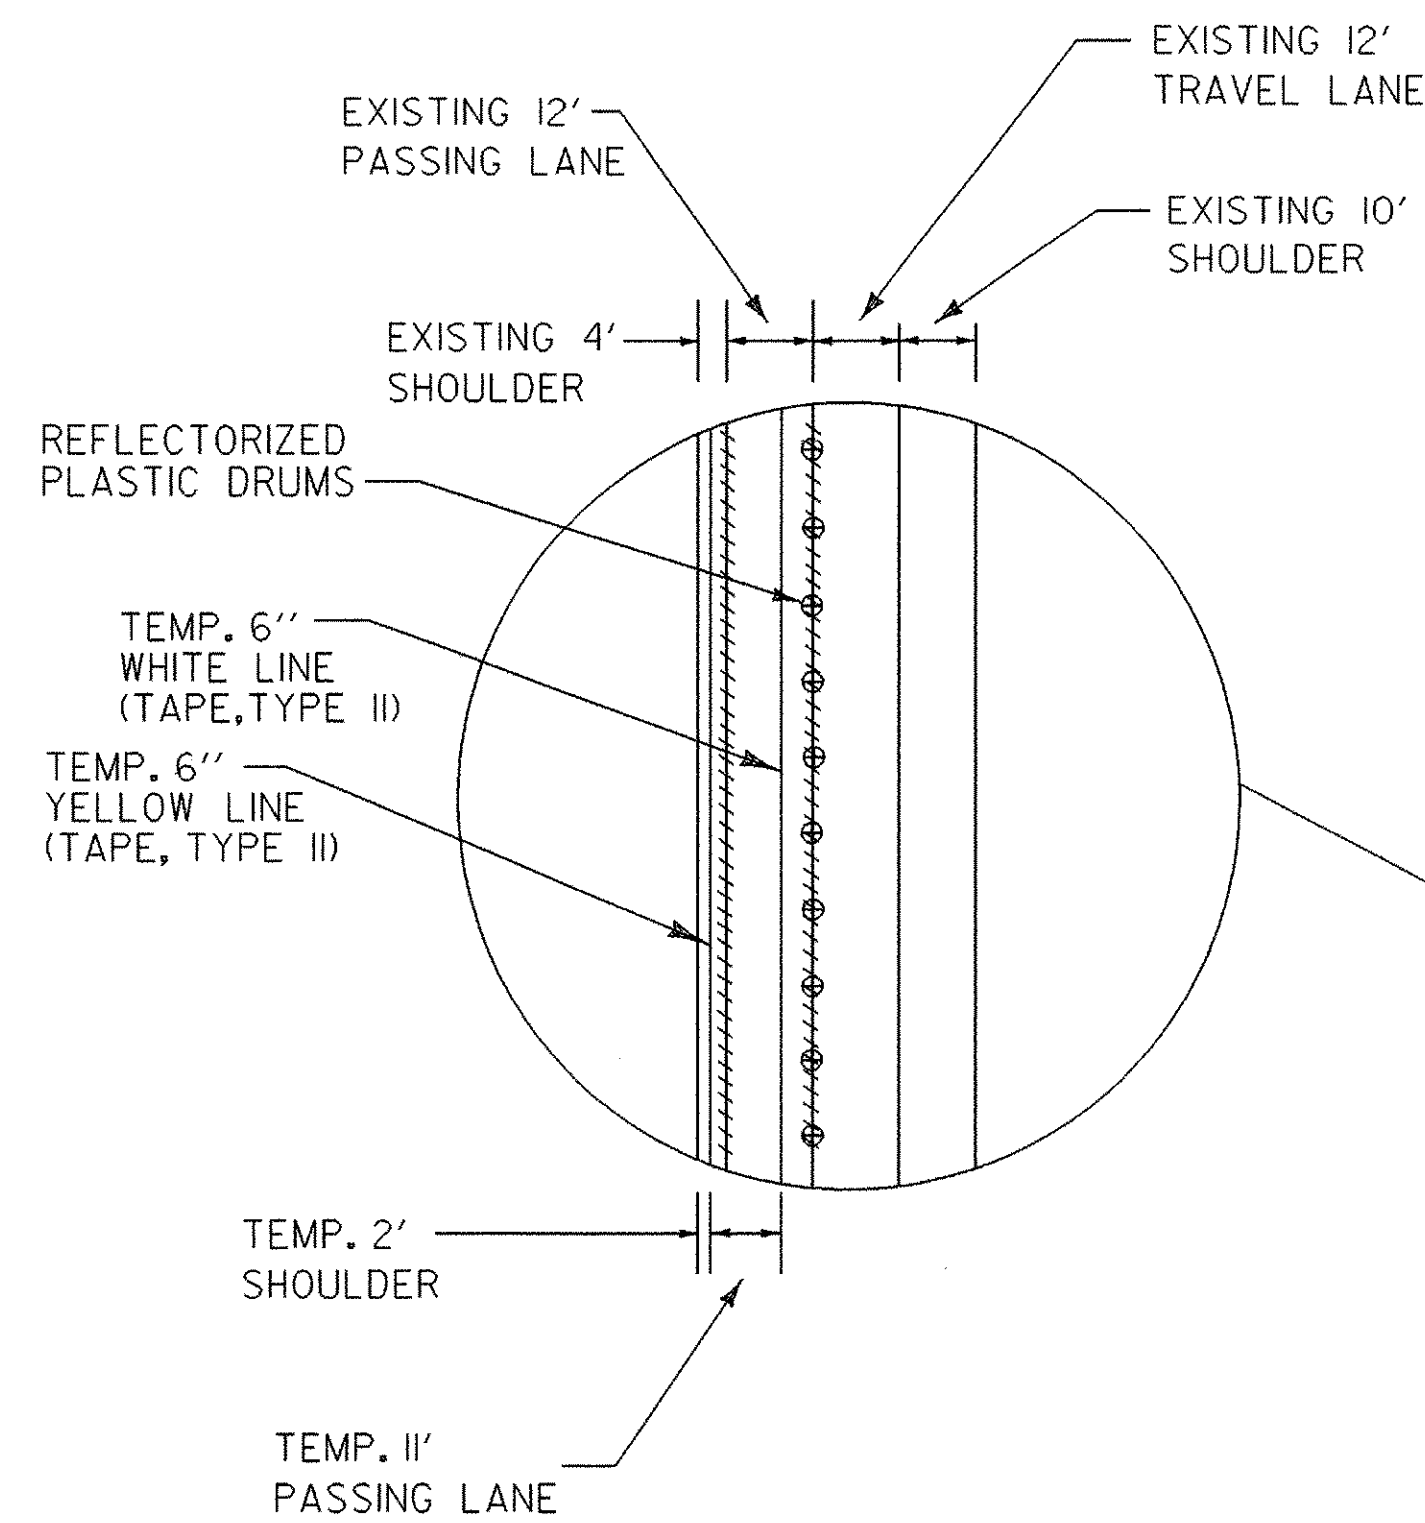

**INSET DETAIL
N.T.S.**


646.614 - TEMPORARY 6" WHITE LINE (TAPE, TYPE II)
2,400'

646.615 - TEMPORARY 8" YELLOW LINE (TAPE, TYPE II)
2,200'

646.64 - TEMPORARY 12" WHITE LINE (TAPE, TYPE II)
GORE AREA - 70'

646.85 - REMOVAL OF EXISTING PAVEMENT MARKINGS
MAINLINE DASHES - 271 SF, EDGELINE - 460 SF = TOTAL 731 SF

646.86 - BLACK PAVEMENT MARKING MASKING TAPE
12" GORE LINES - 500 SF

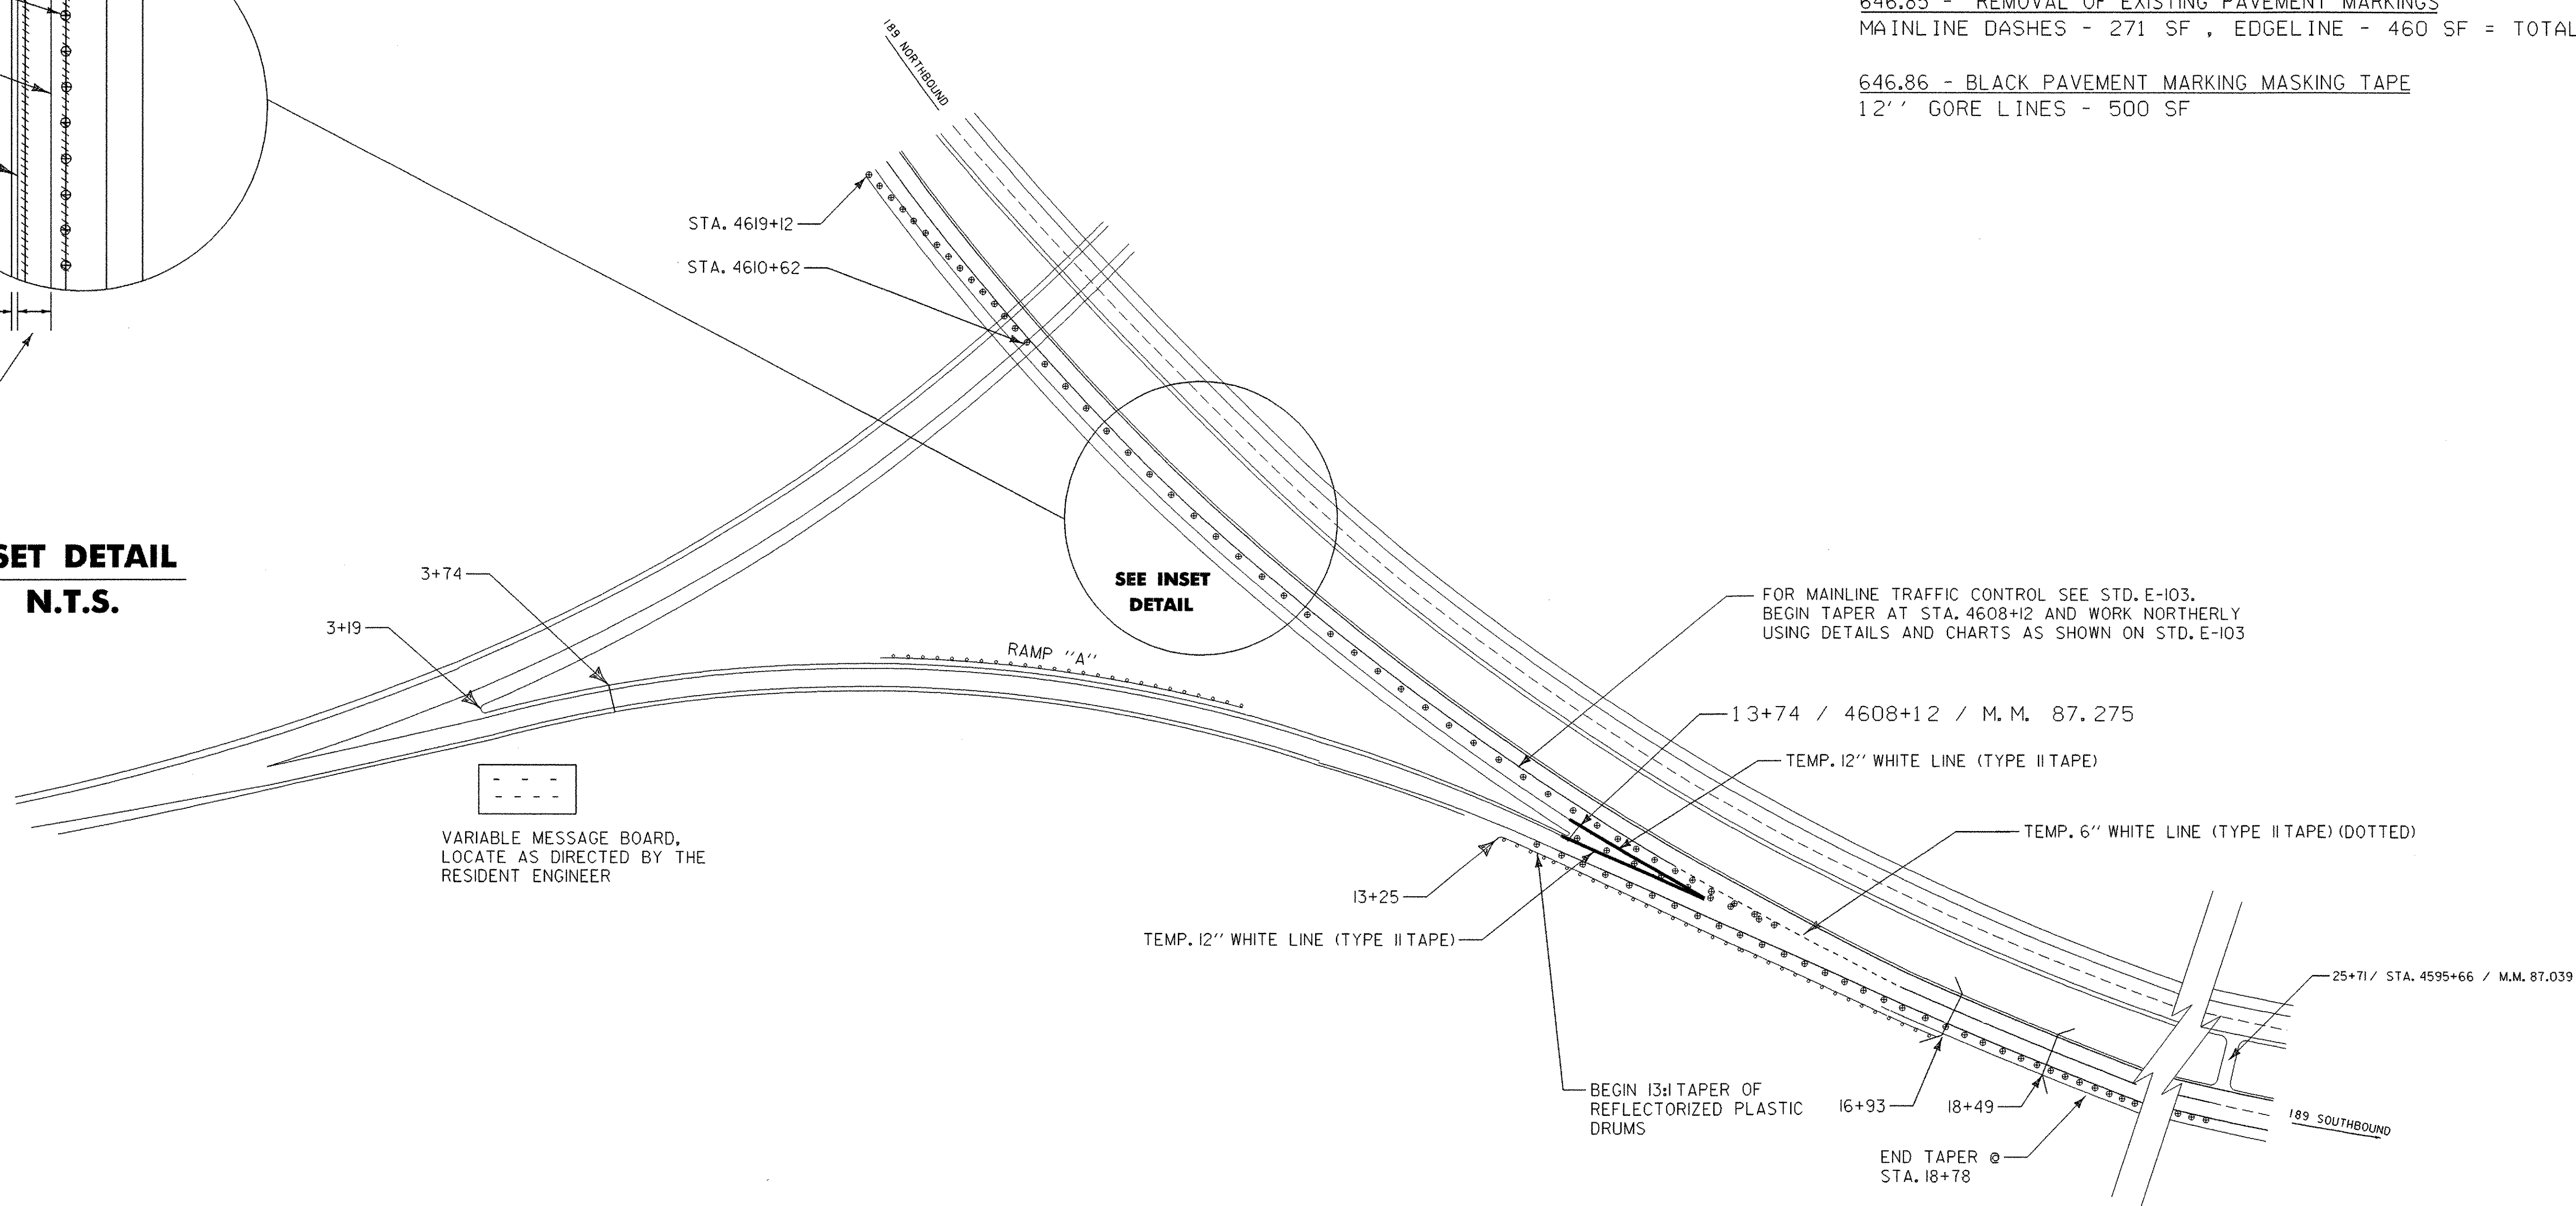

SEE INSET
DETAIL

FOR MAINLINE TRAFFIC CONTROL SEE STD. E-103.
BEGIN TAPER AT STA. 4608+12 AND WORK NORTHERLY
USING DETAILS AND CHARTS AS SHOWN ON STD. E-103

VARIABLE MESSAGE BOARD,
LOCATE AS DIRECTED BY THE
RESIDENT ENGINEER

NOTE: THIS DETAIL SHALL BE IMPLEMENTED ONLY DURING THE NON-PEAK
TRAFFIC FLOW PERIODS. DURING THE PERIODS OF 7:00 AM - 9:00 AM AND
3:00 PM - 7:00 PM, BOTH LANES OF TRAFFIC SHALL BE AVAILABLE FOR USE
AT ALL TIMES.


--- = VARIABLE MESSAGE BOARD
⊕ = REFLECTORIZED PLASTIC DRUM

| | | |
|---|---------------------------------------|------------------------|
| TRAFFIC CONTROL PLAN @ EXIT 13 | PROJECT NAME: BOLTON - SO. BURLINGTON | PLOT DATE: 17-MAY-2005 |
| | PROJECT NUMBER: AC IM 089-2(36) | DRAWN BY: |
| | FILE NAME: /pave/04all4/p04all4.dgn | DESIGNED BY: |
| | IPARM FILE NAME: p04all4+c13.i | CHECKED BY: |
| | | SHEET 34 OF 76 |

NOTES:

1. THE PAVEMENT WIDENING SHALL BE CONSTRUCTED USING TWO 3" LIFTS OF TYPE IIS BASE COURSE AND ONE 1 3/4" LIFT OF TYPE IIIS WEARING COURSE. THE SECOND BASE COURSE SHALL BE PLACED TO MATCH THE ELEVATION OF THE ADJOINING SURFACE OF THE I-89 SB TRAVEL LANE.
2. EMULSIFIED ASPHALT SHALL BE APPLIED ON ALL EXISTING PAVEMENT SURFACES AND BETWEEN ALL COURSES OF PAVEMENT AT THE RATE OF 0.015 GAL./SY OR AS DIRECTED BY THE RESIDENT ENGINEER.
3. EXISTING SHOULDER PAVEMENT SHALL BE REMOVED UNDER ITEM 203.I5, COMMON EXCAVATION . ALL EXCAVATION ASSOCIATED WITH THE PAVEMENT WIDENING SHALL BE PERFORMED UNDER ITEM 203.I5, COMMON EXCAVATION.
4. REFER TO STD. B-5 FOR CONSTRUCTING AN EMBANKMENT ON A EARTH SLOPE.
5. FINE GRADING HAS BEEN INCLUDED ADDED FOR WORK IN THE AREA OF WIDENING.
6. THE CONTRACTOR SHALL SAW CUT THE PAVEMENT AT THE EDGE OF THE SB SHOULDER PRIOR TO EXCAVATING. THE PAYMENT FOR SAW CUTTING SHALL BE CONSIDERED INCLUDED UNDER ITEM 203.I5.
7. RUMBLE STRIPS SHALL BE PAVED PRIOR TO IMPLEMENTING TRAFFIC CONTROL PACKAGE, PAYMENT SHALL BE INCLUDED UNDER ITEM 64I.I0, TRAFFIC CONTROL.

STATION 4595+58 TO 4602+58

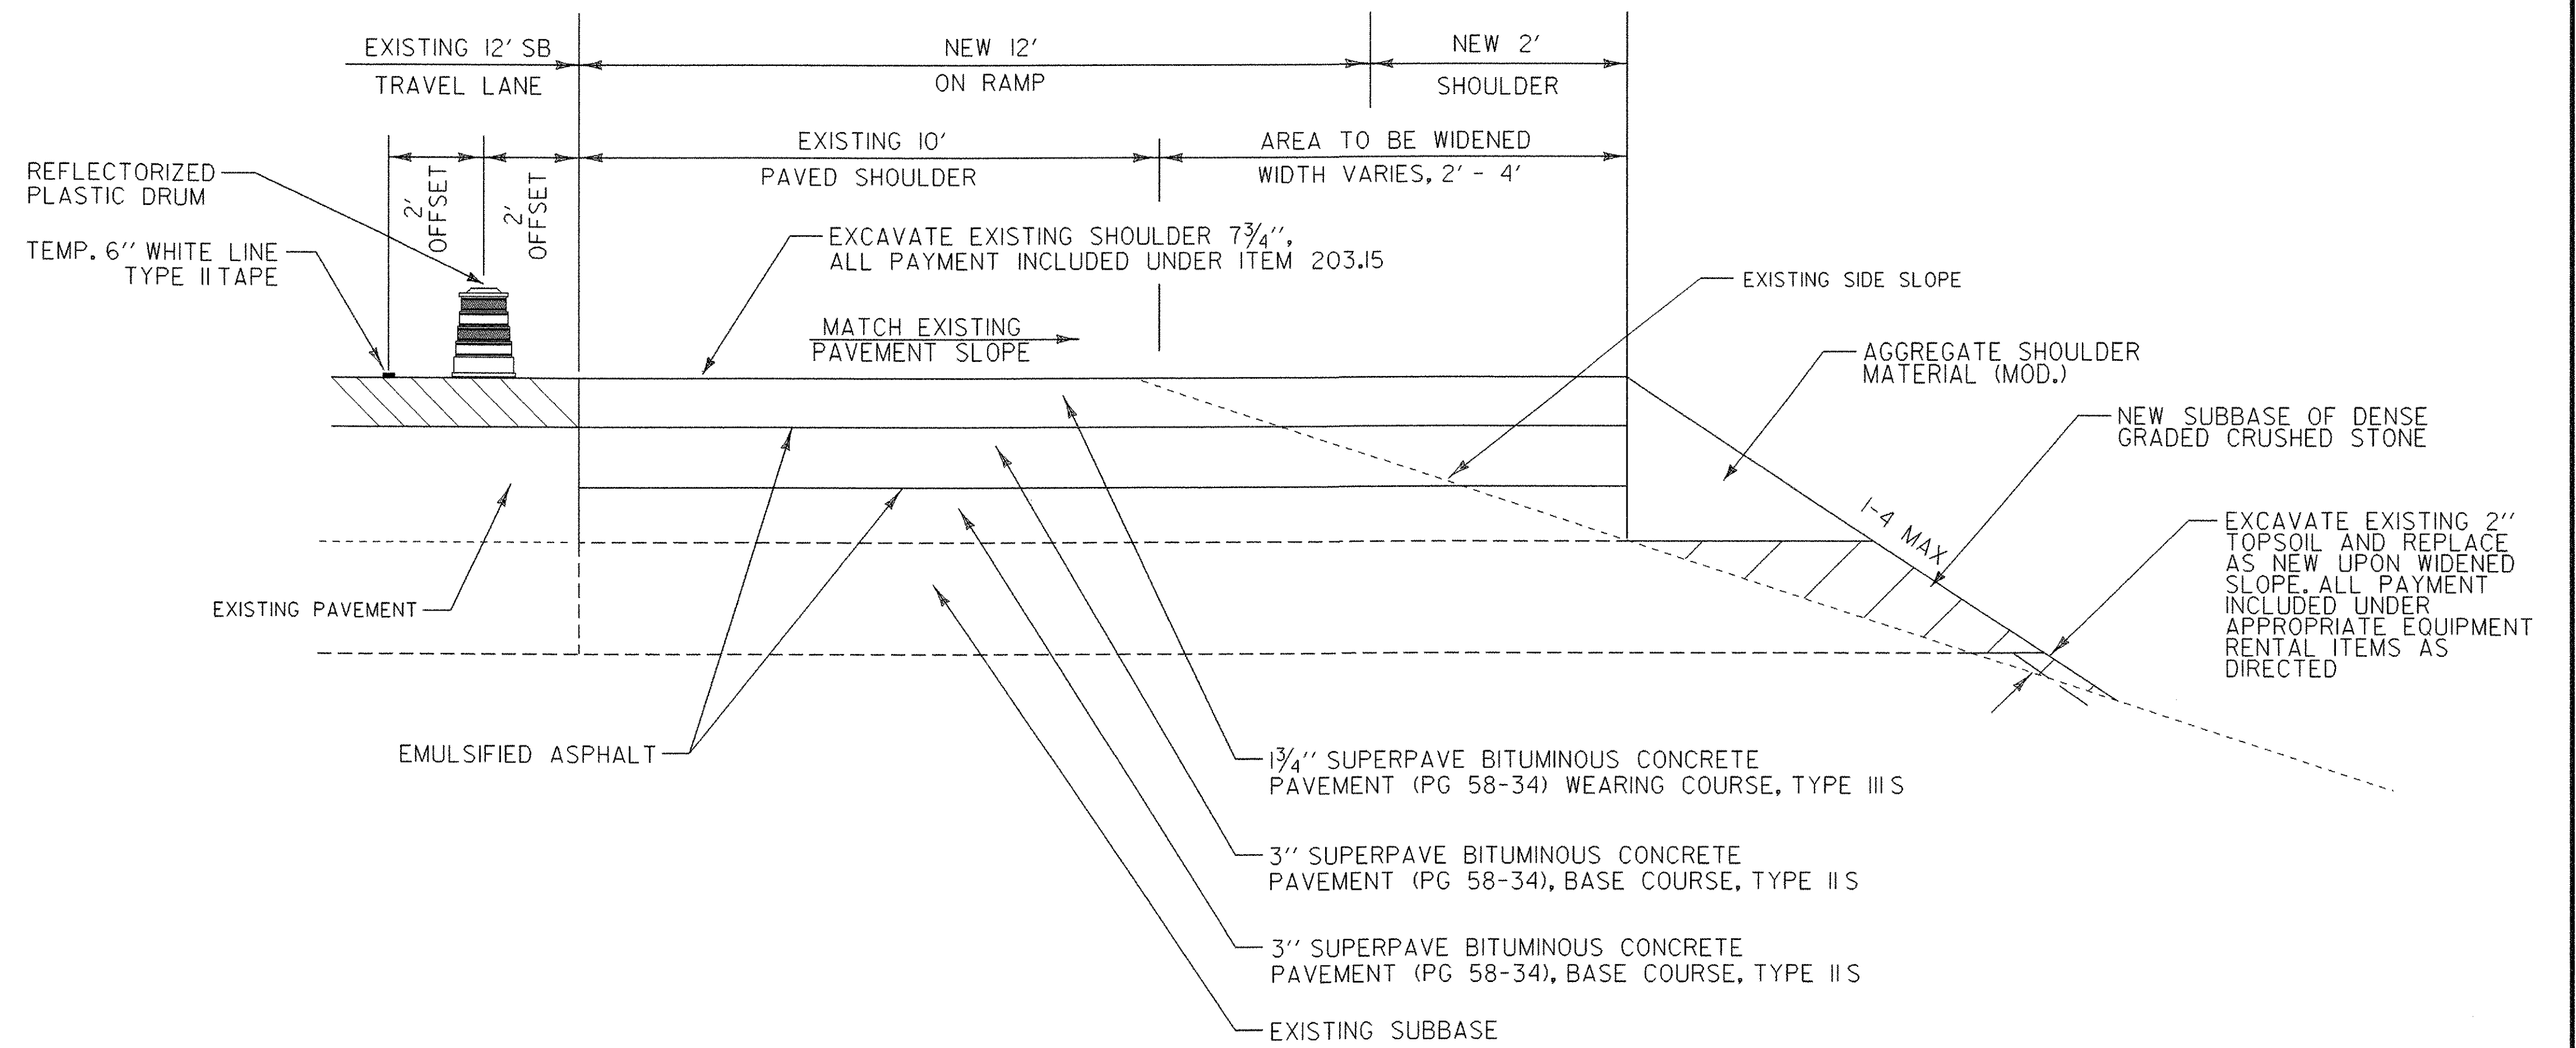


**PAVEMENT WIDENING DETAIL
N.T.S.**

EXISTING U-TURN--REMOVE PAVEMENT AND SUBBASE TO MATCH THE GRADE OF THE EXISTING MEDIAN DITCH.

PAYMENT TO REMOVE THE EXISTING PAVEMENT AND SUBBASE SHALL BE MADE UNDER ITEM 203.I5, COMMON EXCAVATION.

THE CONTRACTOR SHALL SAW CUT THE PAVEMENT AT THE EDGE OF THE NB AND SB SHOULDERS PRIOR TO EXCAVATING. THE COST OF SAW CUTTING SHALL BE INCIDENTAL TO ITEM 203.I5. EXISTING MATERIAL DEEMED SUITABLE BY THE RESIDENT ENGINEER SHALL BE USED AS SUBBSAE MATERIAL TO CONSTRUCT THE NEW U-TURN AT STA. 4179+38. PAYMENT FOR THE USE OF ANY REMOVED MATERIAL FOR THE PURPOSE OF CONSTRUCTING THE NEW U-TURN WILL BE THE AMOUNT OF IN-PLACE MATERIAL REMOVED AND USED MULTIPLIED BY A FACTOR OF 1.15.

ITEM 65I.35 - TOPSOIL, WILL BE SPREAD 6" THICK AFTER U-TURN IS EXCAVATED

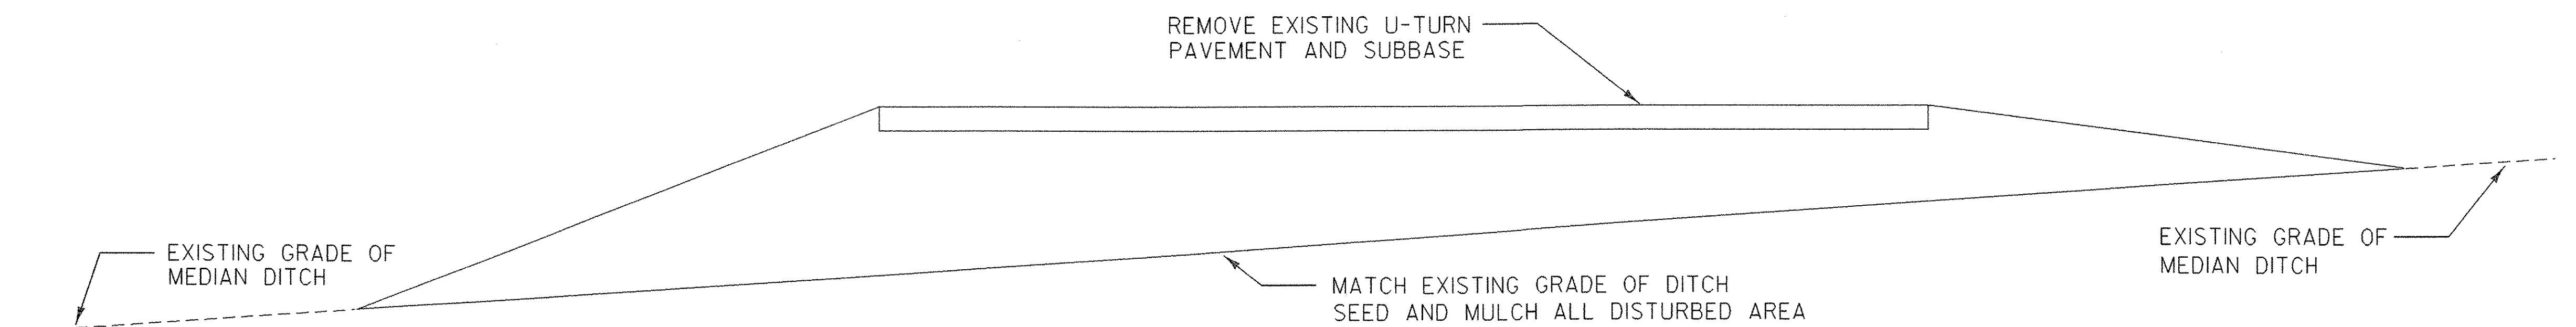


U-TURN REMOVAL DETAIL (SB MM 78.579 /4148 + 97)


DETAIL SHEET # 1

PROJECT NAME: BOLTON - SO. BURLINGTON
PROJECT NUMBER: AC IM 089-2(36)

FILE NAME: /pave/04all4/p04all4.dgn PLOT DATE: 17-MAY-2005
PROJECT LEADER: DRAWN BY:
DESIGNED BY: CHECKED BY:
IPARM NAME: p04all4dsl1 SHEET 35 OF 76

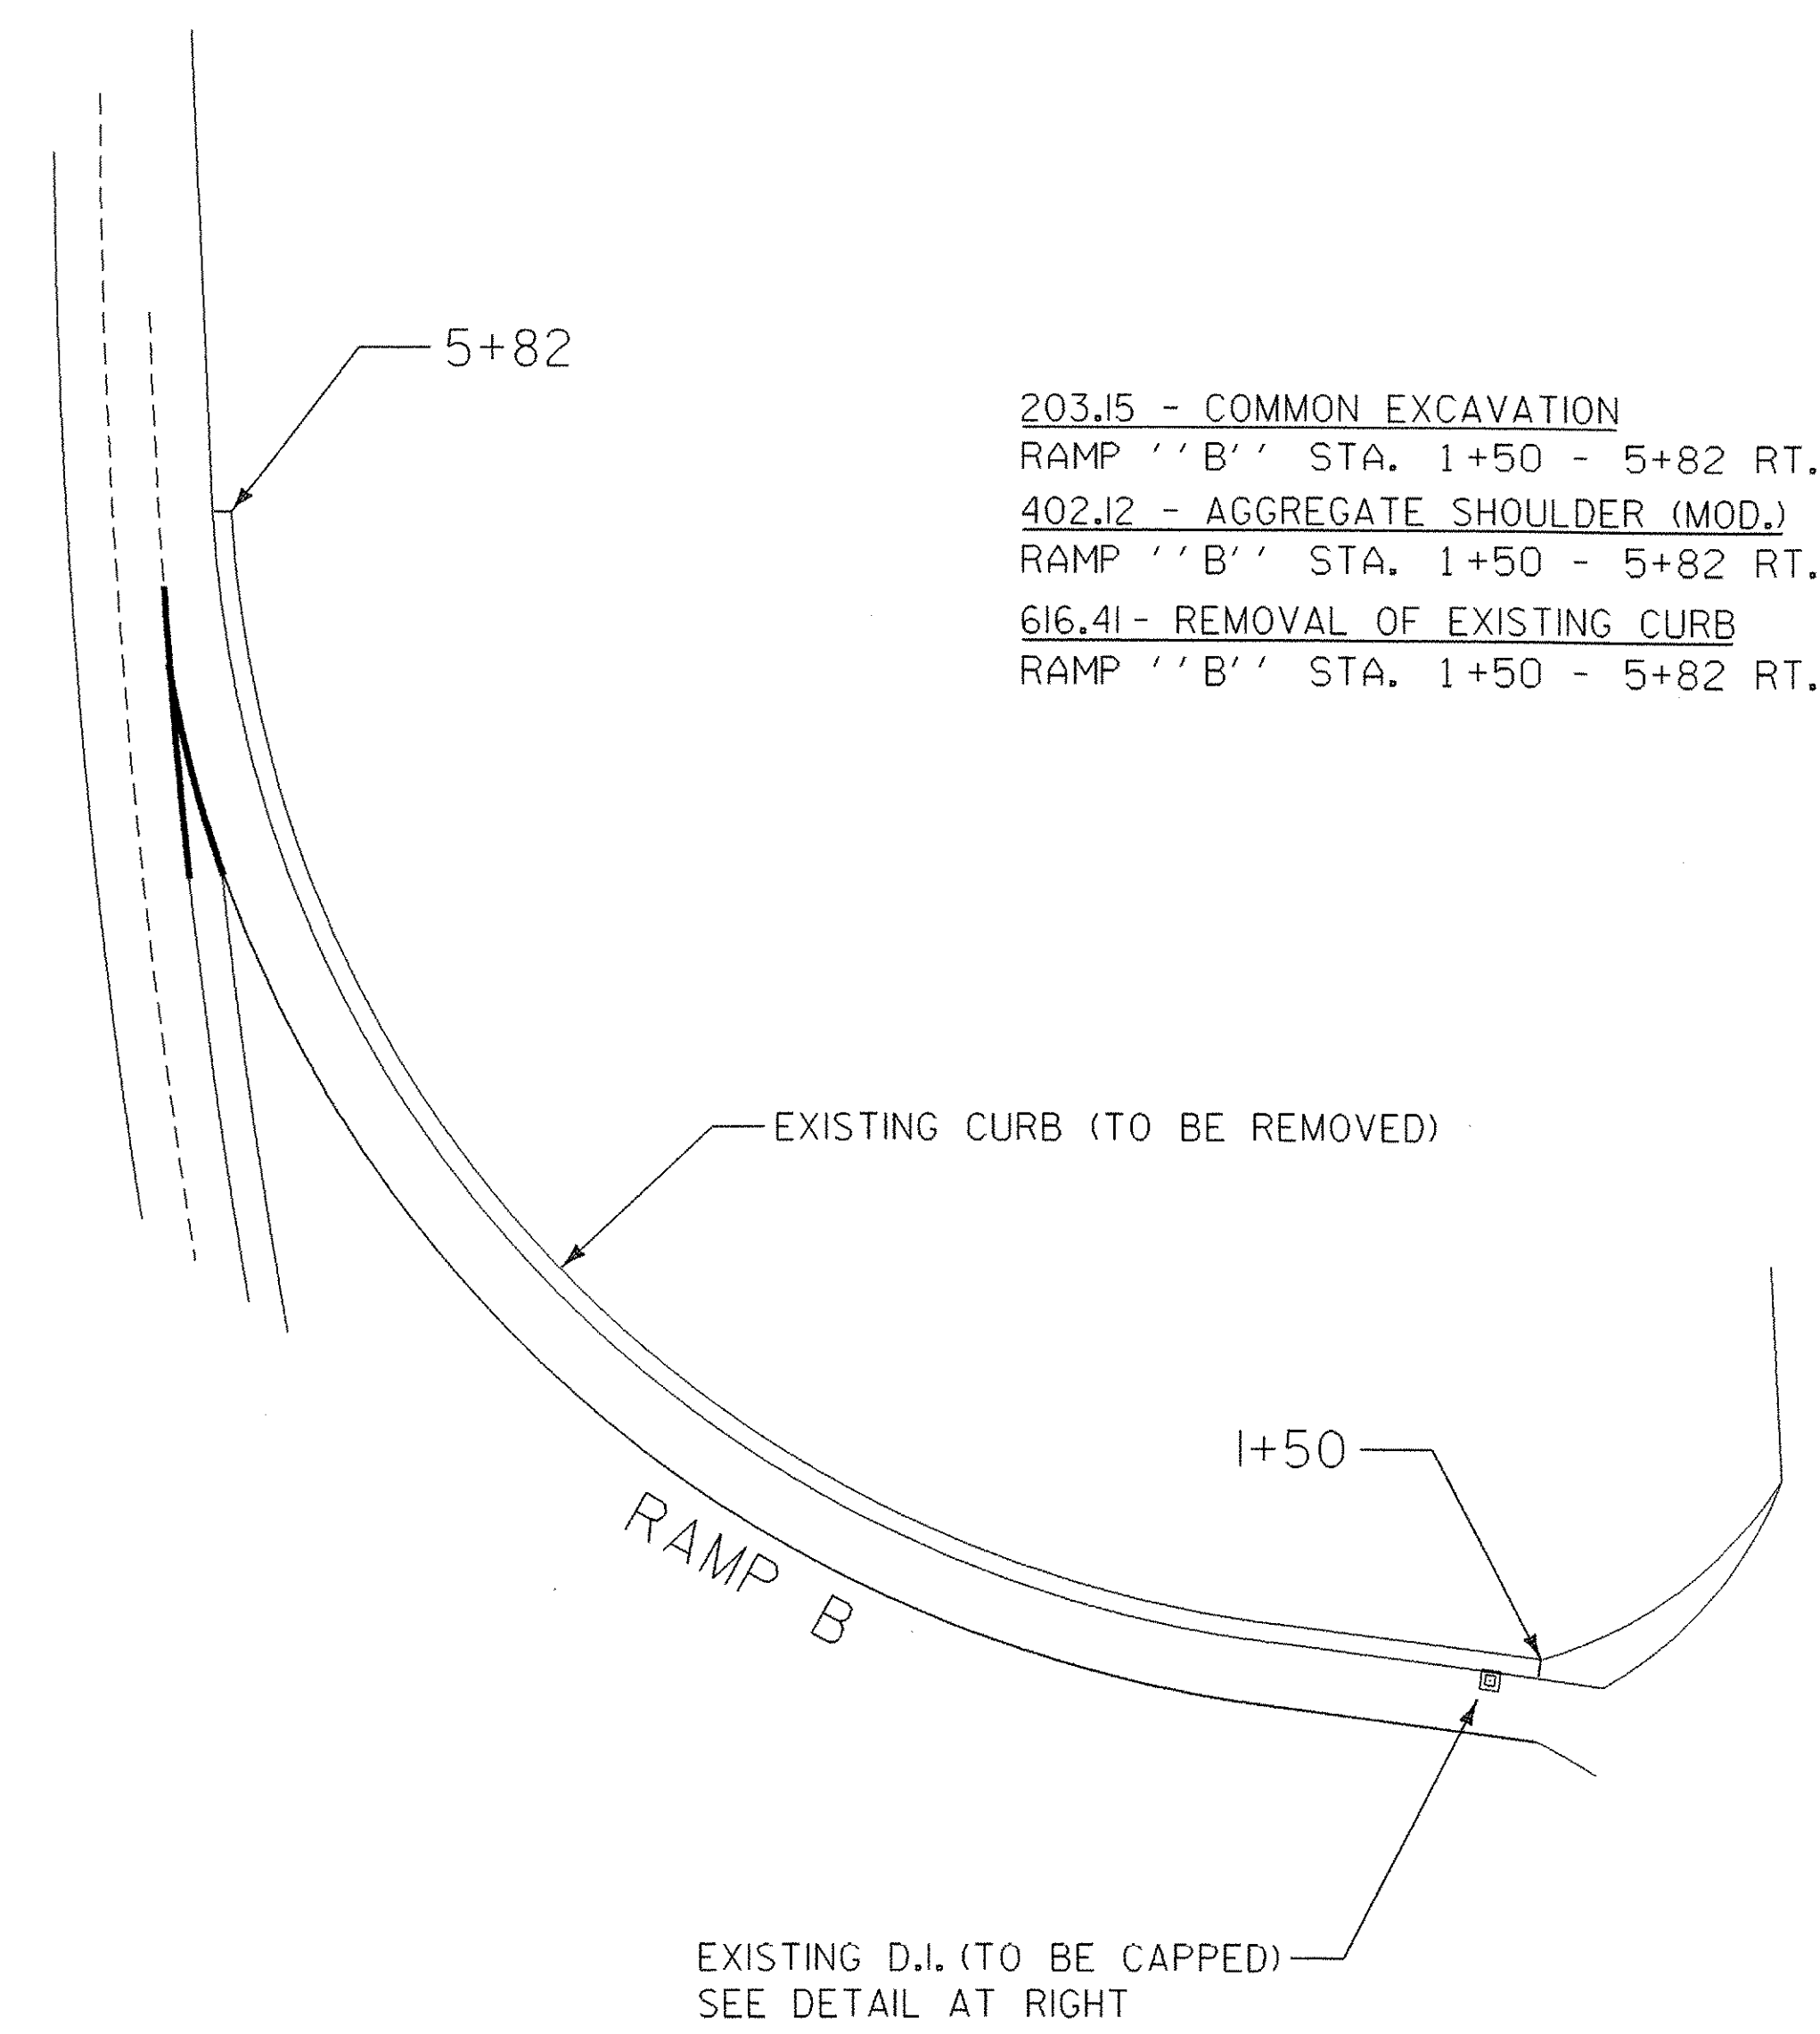


- 203.15 - COMMON EXCAVATION
RAMP "B" STA. 1+50 - 5+82 RT.
- 402.12 - AGGREGATE SHOULDER (MOD.)
RAMP "B" STA. 1+50 - 5+82 RT.
- 616.41 - REMOVAL OF EXISTING CURB
RAMP "B" STA. 1+50 - 5+82 RT.

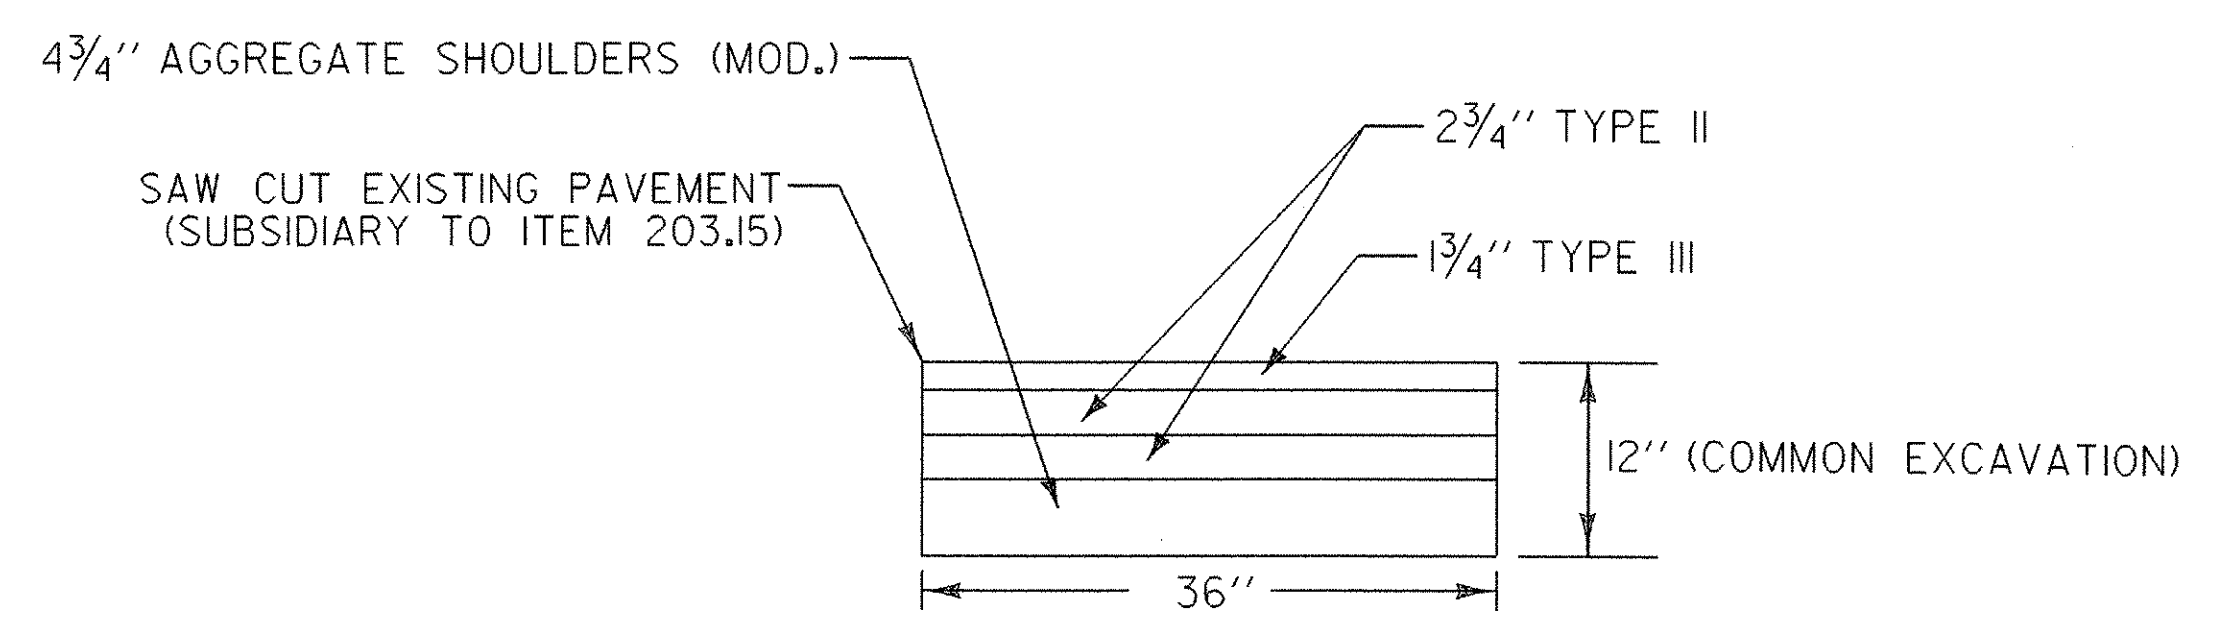


RAMP "B" STA. 1+50 - 5+82 RT.

**CURB REMOVAL & SHOULDER WIDENING
@ EXIT 11 RAMP "B" RT.**

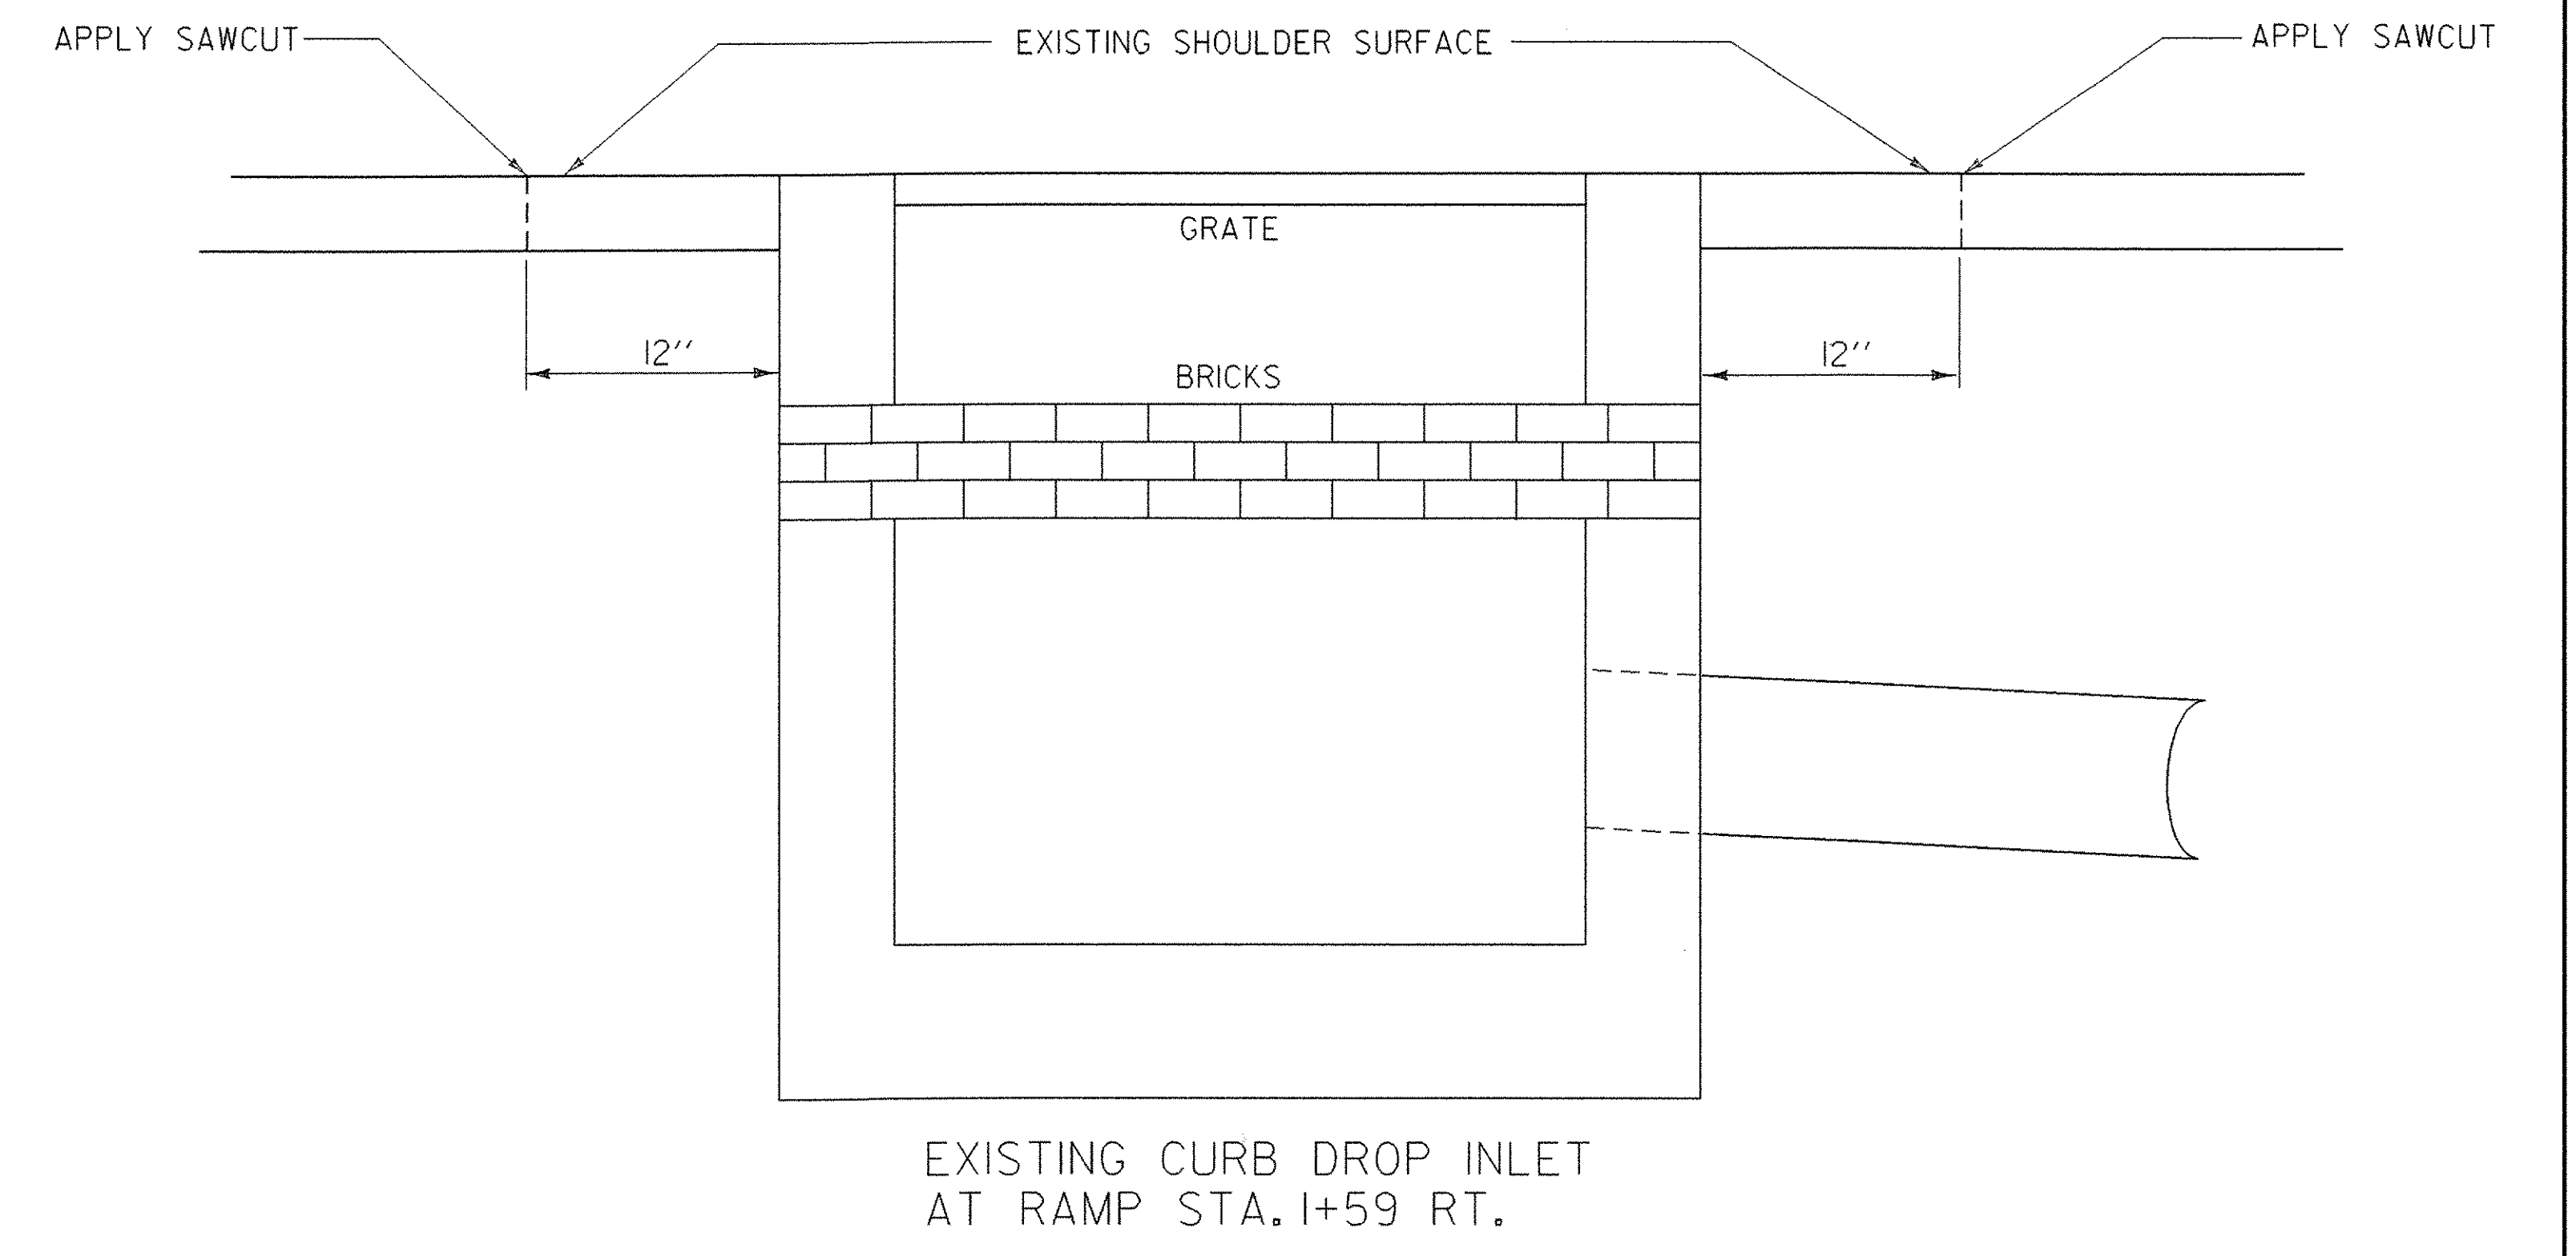

1

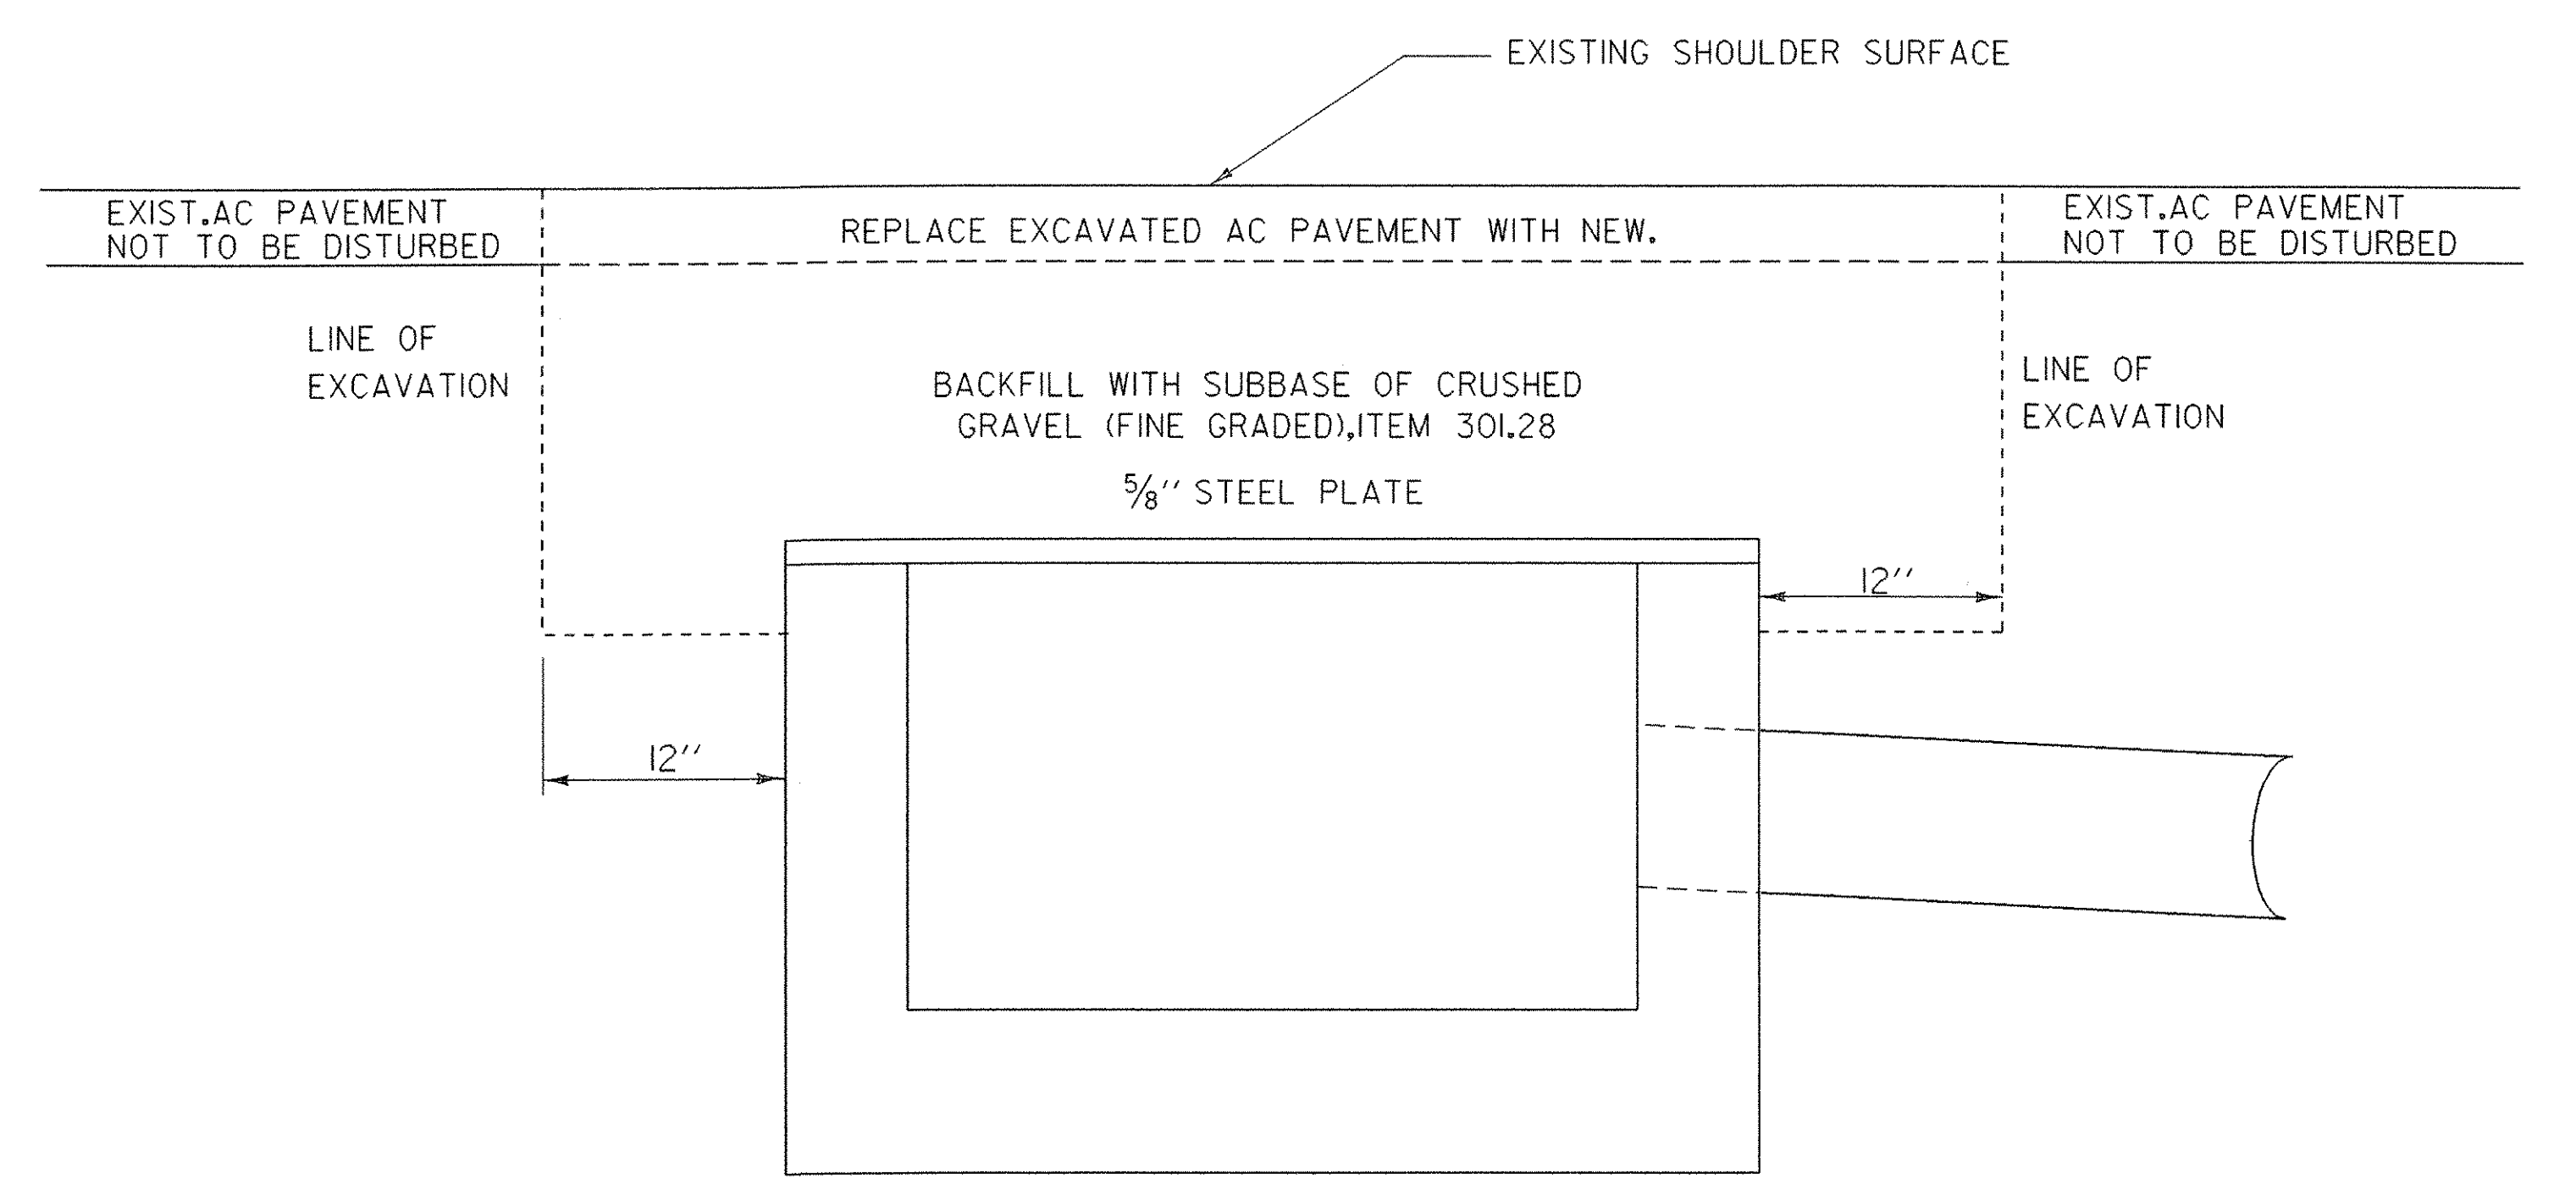

PROPOSED TREATMENT OF CURB DROP INLET

2

| | | |
|-------------------------|---------------------------------------|------------------------|
| DETAIL SHEET # 2 | PROJECT NAME: BOLTON - SO. BURLINGTON | PLOT DATE: 17-MAY-2005 |
| | PROJECT NUMBER: AC IM 089-2(36) | DRAWN BY: |
| | FILE NAME: /pave/04all4/p04all4.dgn | CHECKED BY: |
| | DESIGNED BY: | SHEET 36 OF 76 |
| | IPARM NAME: p04all4ds2.1 | |

TRAFFIC SIGN SUMMARY SHEET

| MILEMARKER, STATION, OR SIGN NUMBER | SIGN LEGEND | SIGN DIMENSIONS | | NEW & SALVAGED SIGNS | | | | EXISTING POSTS | | NEW SIGN POSTS | | | | | | | | | | | | REMARKS | SIGN DETAIL | | | | | |
|--|-------------|-----------------|---------------------|----------------------|-------------------------|-----|-----------|----------------|--------------|-----------------|-----|-----|--------------|-----|-----|------------------|-----|----------|---------------|-----|-----|---------|---------------|-----|--|------------------------------|----------|----------------|
| | | EA | WIDTH (In) | HEIGHT (In) | "A" | "B" | SALV SIGN | SALV TIS | NO. OF POSTS | FLANGED CHANNEL | | | SQUARE STEEL | | | TUBULAR ALUMINUM | | | TUBULAR STEEL | | | | W-SHAPE STEEL | | DETAIL ON SHEET NUMBER | STD. SHEET NUMBER | | |
| | | | | | | | | | | 1.12 | 2.0 | 3.0 | 1.75 | 2.0 | 2.5 | 3.0 | 4.0 | 4.0 MOD. | 3.0 | 3.5 | 4.0 | | 5.0 | 24" | | | 30" | WEIGHT |
| MM 74.35 STA. 3925+68 | | 2 | 36 | 36 | 18 | | | 2 | 4 | | | | | | | | | | | | | | | | 2 REMOVE | | E-143 | |
| MM 74.45 STA. 3930+96 | | 2 | 36 | 36 | 18 | | | 2 | 4 | | | | | | | | | | | | | | | | 2 REMOVE | | E-143 | |
| 76.04 STA. 4015+12 | | 2 | 36 | 36 | 18 | | | 2 | 4 | | | | | | | | | | | | | | | | 2 REMOVE | | E-143 | |
| 78.07 STA. 4122+10 | | 2 | 36 | 36 | 18 | | | 2 | 4 | | | | | | | | | | | | | | | | 2 REMOVE | | E-143 | |
| 79.15 STA. 4179+38 | | 2 | 36 | 36 | 18 | | | 2 | 4 | | | | | | | | | | | | | | | | 2 REMOVE | | E-143 | |
| 81.30 STA. 4293+12 | | 2 | 36 | 36 | 18 | | | 2 | 4 | | | | | | | | | | | | | | | | 2 REMOVE | | E-143 | |
| 83.53 STA. 4410+65 | | 2 | 36 | 36 | 18 | | | 2 | 4 | | | | | | | | | | | | | | | | 2 REMOVE | | E-143 | |
| 84.42 STA. 4179+38 4457+38 | | 2 | 36 | 36 | 18 | | | 2 | 4 | | | | | | | | | | | | | | | | 2 REMOVE | | E-143 | |
| STA. 4293+12 | | 2 | 36 | 36 | 18 | | | | 4 | | | | | | | | | | | | | | | | | | | E-143 |
| 87.04 STA. 4595+66 | | 2 | 36 | 36 | 18 | | | 2 | 4 | | | | | | | | | | | | | | | | 2 REMOVE | | E-143 | |
| EXIT II RAMP "A" OFF RAMP RT | | 1 | 36 48 | 36 48 | 9 16 | | | | -2 | | | | | | | | | | | | | | | | USED EXISTING POSTS * | | 1 REMOVE | E-150 |
| EXIT II RAMP "A" OFF RAMP RT | | 2 | 30 | 30 | 12.50 | | | | + | | | | | | | | | | | | | | | | USED EXISTING POSTS * | 3NN05 USED EXISTING POSTS | 2 REMOVE | E-143 |
| | | 2 | 36 | 12 | 6 | | | | | | | | | | | | | | | | | | | | 3NN05 | 2 REMOVE | E-142 | |
| EXIT II RAMP "A" OFF RAMP LT | | 1 | 30 24 | 30 30 | 6.25 5.00 | | | | + | | | | | | | | | | | | | | | | USED EXISTING SIGNS USED EXISTING POSTS | AOT 04 INSTALLED 3NN05 | | E-143 E-144 |
| | | 1 | 18 | 18 | 2.25 | | | | | | | | | | | | | | | | | | | | NEW SIGN 3NN05 | 1 REMOVE | E-150 | |
| EXIT II RAMP "C" OFF RAMP RT | | | 36 | 36 | 5 | | | | + | | | | | | | | | | | | | | | | USED EXISTING SIGN & POSTS * | USED EXISTING SIGN 3NN05 | | E-146 |

FINAL POST LENGTHS ARE TO BE DETERMINED IN THE FIELD. POST SIZES ARE COMPUTED BASED ON INFORMATION FURNISHED ON THE STANDARD SHEETS AND THE TRAFFIC & SAFETY DIVISION'S "SIGN POST DESIGN GUIDELINE."

| | | | | | | | | | | | | | | | | | | | |
|-------------------|----|----|-----|----|--|-------|----|----|----|----|----|----|----|----|----|----|-----|-----|----|
| TOTALS SHEET 1 | SF | SF | EA. | SF | | FT | FT | FT | FT | FT | FT | EA | LB | LB | LB | LB | EA. | EA. | LB |
| | | | | | | 514.5 | | | | | | | | | | | | | |

REMOVAL 24

| | |
|---------------------------------------|------------------------|
| PROJECT NAME: BOLTON - SO. BURLINGTON | PLOT DATE: 17-MAY-2005 |
| PROJECT NUMBER: AC IM 089-2(36) | DRAWN BY: |
| FILE NAME: /pave/04all4/p04all4.dgn | CHECKED BY: |
| DESIGNED BY: | SHEET 37 OF 76 |
| IPARM FILE NAME: p04all4ssl1 | |


TRAFFIC SIGN SUMMARY SHEET

| MILEMARKER, STATION, OR SIGN NUMBER | SIGN LEGEND | SIGN DIMENSIONS | | NEW & SALVAGED SIGNS | | | | EXIST POST NO. OF POSTS | NEW SIGN POSTS | | | | | | | | | | | | | | | | REMARKS | SIGN DETAIL | | | |
|--|----------------|--------------------|---------------|----------------------|-------|-----|--------------|-------------------------------------|----------------|-----------------|-----|-----|----------------------|-----|-------|----------------------------|-----|-----|---------------------------|-----|--------------|--------------|---------------|-----------|---------|--|------------------------------|-------------------------|--------|
| | | EA | WIDTH (In) | HEIGHT (In) | "A" | "B" | SALV SIGN | | SALV TIS | FLANGED CHANNEL | | | SQUARE STEEL (In) | | | TUBULAR ALUMINUM Ø (In) | | | TUBULAR STEEL Ø (In) | | | | W-SHAPE STEEL | | | REQ'D ITEM NUMBER | DETAIL ON SHEET NUMBER | STD. SHEET NUMBER | |
| | | | | | | | | | | 1.2 | 2.0 | 3.0 | 1.75 | 2.0 | 2.5 | 3.0 | 4.0 | 4.0 | 675.43 FOUND- ATION | 3.0 | 3.5 | 4.0 | 5.0 | FTG. SIZE | | | | | WEIGHT |
| EXIT II RAMP "A" OFF RAMP RT | | 1 | 36 | 36 | 9 | | | | 2 | 12-6 13-0 | X | | X | | | | | | | | | | | | | | I REMOVAL | | E-150 |
| EXIT II RAMP "D" OFF RAMP RT 9 LT | | 1 | 36 | 30 | 7.5 | | | RT | 2 | 13-6 14-0 | X | | X | | | | | | | | | | | | | WRONG WAY DOUBLE POSTED RT & LT SIDE 3NN05 | I REMOVAL | | E-145A |
| EXIT II RAMP "D" OFF RAMP LT & RT | | 4 | 30 | 30 | 25 | | | RT + | 1 | 12-0 | X | | X | | | | | | | | | | | | | 3NN05 | 2 REMOVE RT 2 REMOVE RT | | E-143 |
| | | 4 | 36 | 12 | 12 | | | | | | | | | | | | | | | | | | | | | | 2 REMOVE RT 2 REMOVE RT | | E-142 |
| EXIT 13 RAMP "A" ON RAMP RT | | 1 | 48 | 48 | 16 | | | | 2 | 16-0 16-0 | X | | X | | | | | | | | | | | | | INSTALLED REMOVE NEW SIGN | I REMOVAL I REMOVAL | | E-150 |
| EXIT 13 RAMP "A" ON RAMP RT | | 1 | 48 | 48 | 16 | | | | 2 | 16-0 14-6 | X | | X | | | | | | | | | | | | | INSTALLED REMOVE NEW SIGN | I REMOVAL I REMOVAL | | E-146 |
| EXIT 13 RAMP "A" ON RAMP RT | | 1 | 48 | 60 | 20 | | | | | | | | | | | | | | | | | | | | | | I REMOVAL | | |
| | | 1 | 36 | 48 | 12 | | | | 2 | | | | | | | | | | 2 | X | 17' 17-6 | 129.2 133 | | | | | I REMOVAL | | |
| EXIT 13 RAMP "A" ON RAMP RT | | | 48 | 48 | 16 | | | | | | | | | | | | | | | | | | | | | | I REMOVAL | | 29 |
| | | | 24 | 18 | 3 | | | | 2 | | | | | | | | | | 2 | X | 13-3 12-6 | 100.7 95 | | | | | I REMOVAL | | E-153B |
| EXIT 13 RAMP "A" ON RAMP RT | | | 30 | 15 | 3.125 | | | | | | | | | | | | | | | | | | | | | | I REMOVAL | | |
| | | 1 | 36 | 36 | 9 | | | | 1 | | | | | X | 16-6' | 21.45* | | | | | | | | | | | I REMOVAL | | |
| EXIT II OFF RAMP D | 13+47 RT | | | | | | | | | | | | | | | | | | | | | | | | | | I REMOVAL | | |

FINAL POST LENGTHS ARE TO BE DETERMINED IN THE FIELD. POST SIZES ARE COMPUTED BASED ON INFORMATION FURNISHED ON THE STANDARD SHEETS AND THE TRAFFIC & SAFETY DIVISION'S "SIGN POST DESIGN GUIDELINE."

| | | | | | | | | | | | | | | | | | | | | | | |
|---------------|----|----|----|----|--|---------|---------|-------|-----|-----|-----|-------|-----|-------|-------|-------|-----|-----------|-----|-----|-----|-----|
| TOTALS | SF | SF | EA | SF | | FT | FT | FT | FT | FT | FT | | EA | LB | LB | LB | LB | LB | LB | EA | EA | LB |
| | | | | | | 121.125 | 160.625 | 163.5 | 210 | 210 | 210 | 21.45 | 4 | 402.8 | 457.9 | 402.8 | 4 | 21 REMOVE | | | | |
| | | | | | | 210 | 210 | 210 | 210 | 210 | 210 | 210 | 210 | 210 | 210 | 210 | 210 | 210 | 210 | 210 | 210 | 210 |

PROJECT NAME: BOLTON - SO. BURLINGTON
PROJECT NUMBER: AC IM 089-2(36)
FILE NAME: /pave/04q14/p04q14.dgn PLOT DATE: 17-MAY-2005
PROJECT LEADER: DRAWN BY:
DESIGNED BY: CHECKED BY:
IPARM FILE NAME: p04q14ss1.I SHEET 38 OF 76

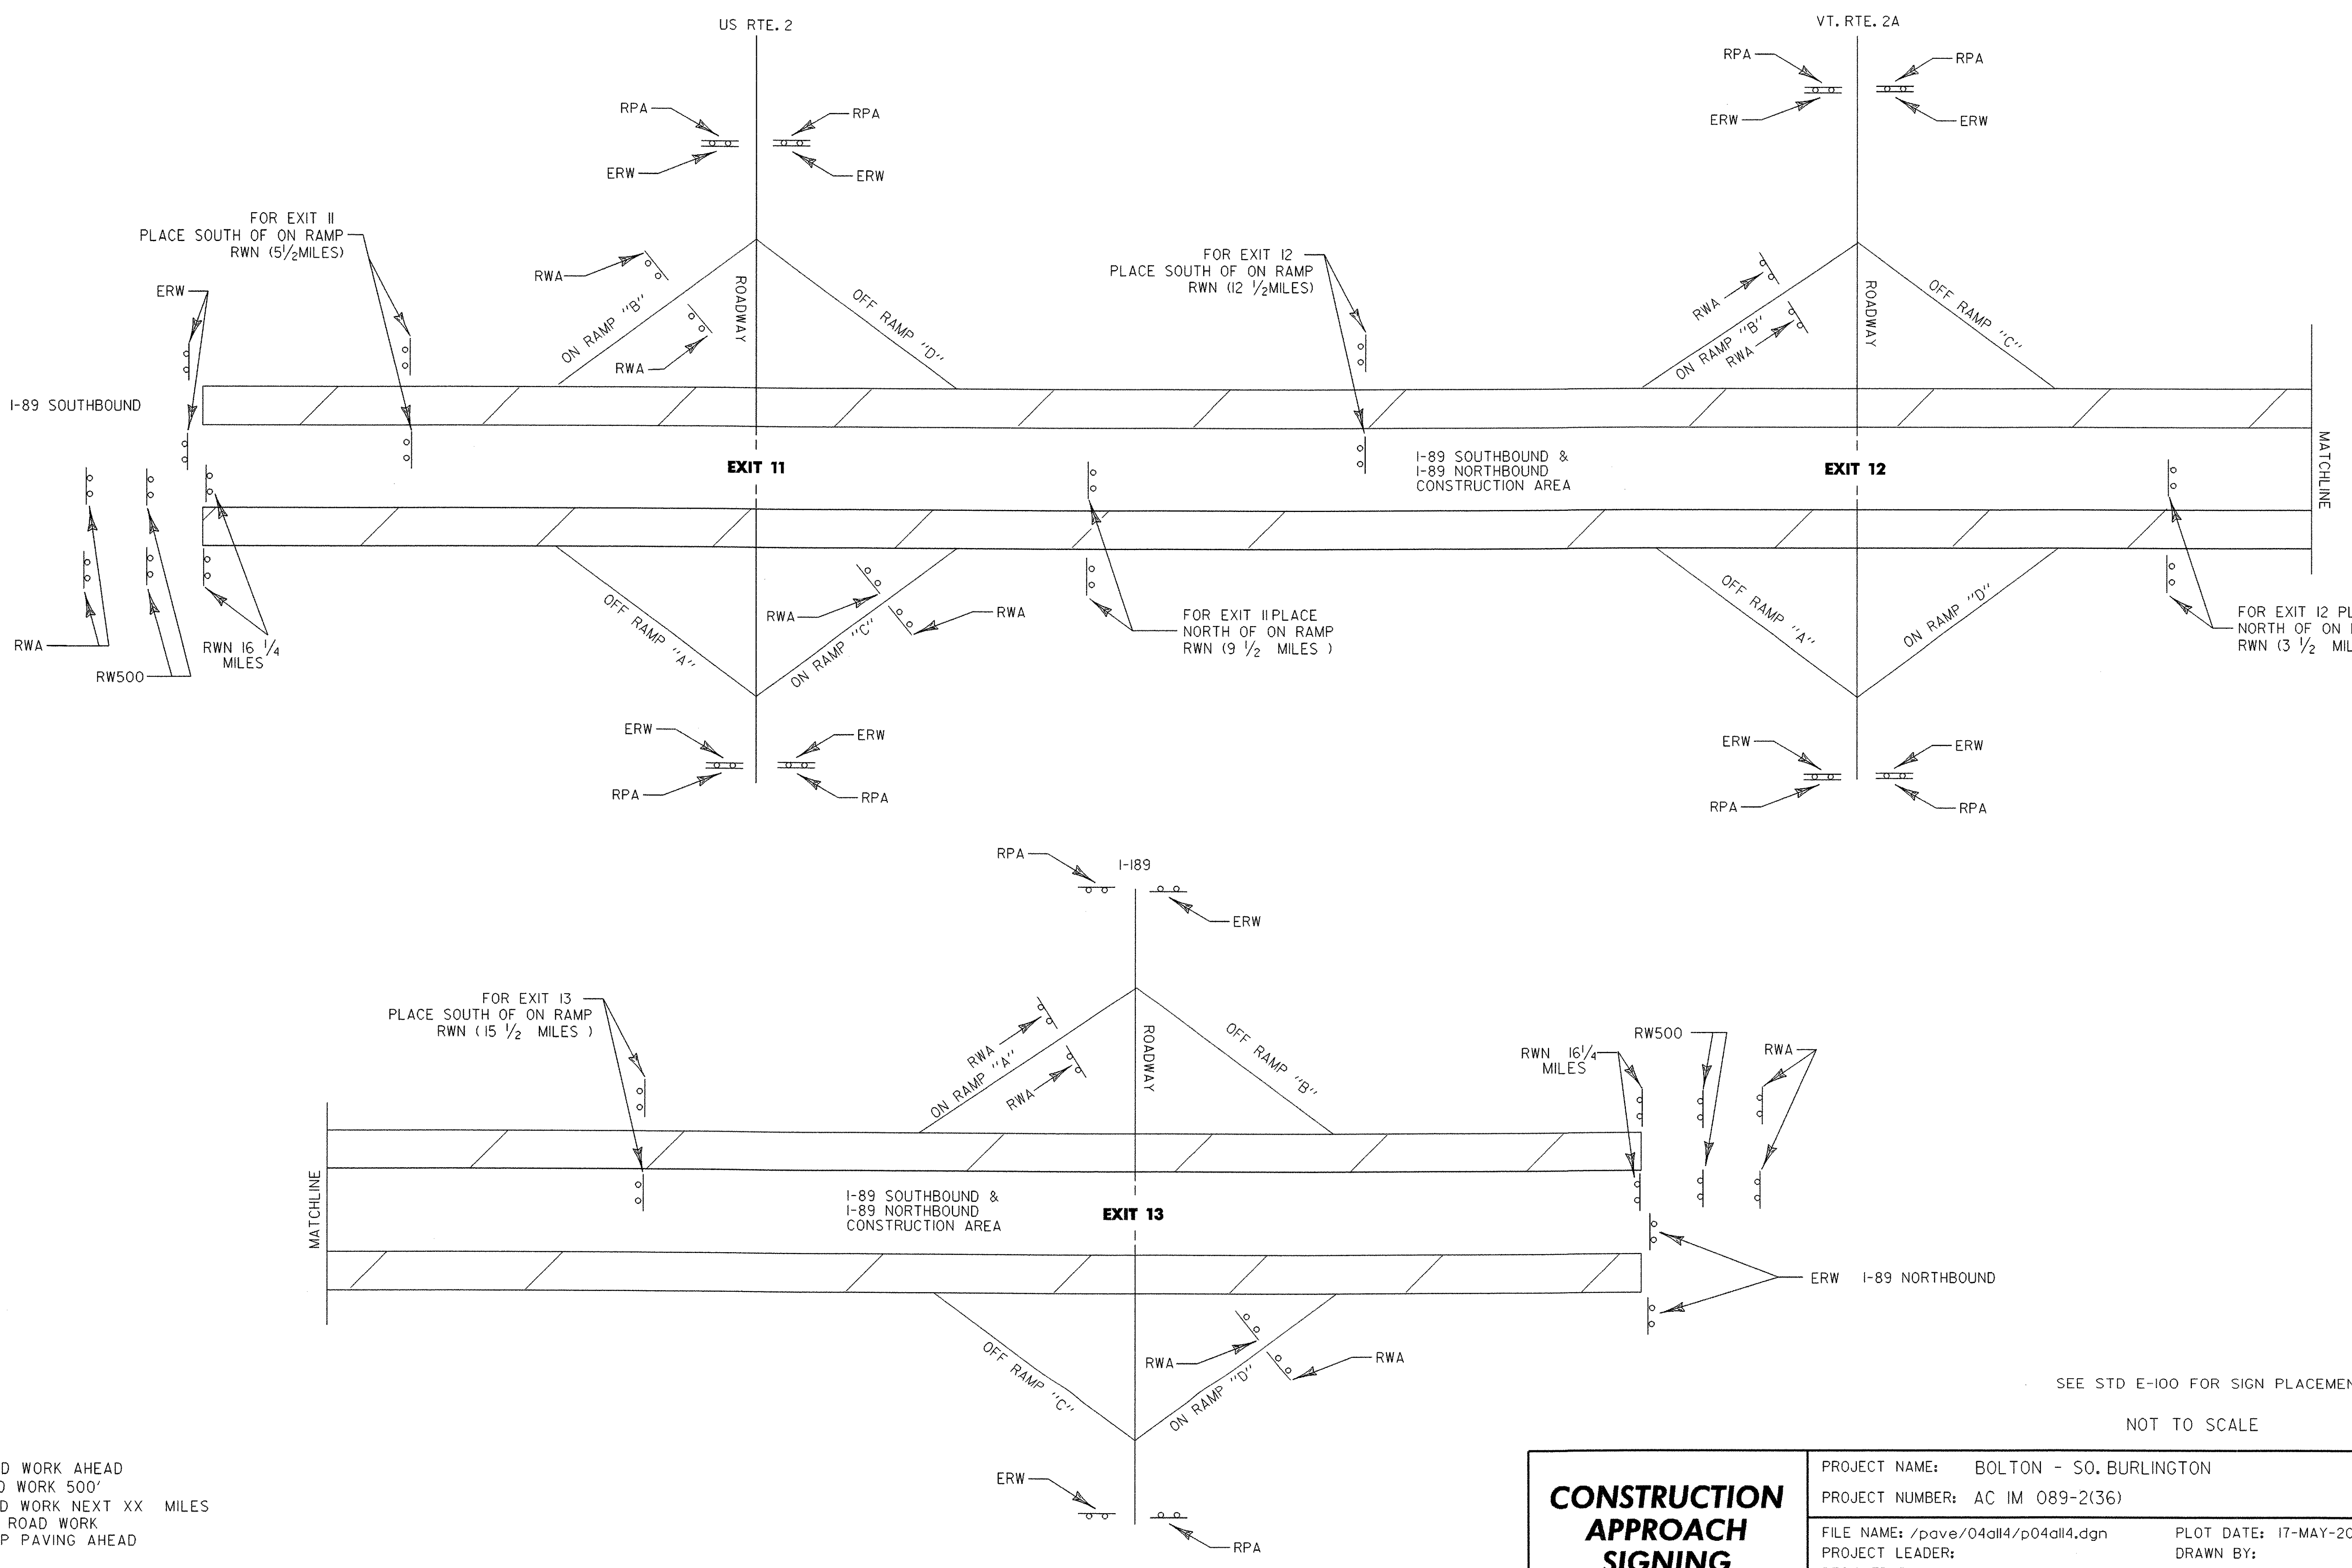

LEGEND
 RWA = ROAD WORK AHEAD
 RW500 = ROAD WORK 500'
 RWN = ROAD WORK NEXT XX MILES
 ERW = END ROAD WORK
 RPA = RAMP PAVING AHEAD


SEE STD E-100 FOR SIGN PLACEMENT
 NOT TO SCALE

| | |
|--|---------------------------------------|
| CONSTRUCTION APPROACH SIGNING | PROJECT NAME: BOLTON - SO. BURLINGTON |
| | PROJECT NUMBER: AC IM 089-2(36) |
| | FILE NAME: /pave/04all4/p04all4.dgn |
| DESIGNED BY: | PLOT DATE: 17-MAY-2005 |
| IPARM NAME: p04all4casl.i | DRAWN BY: |
| | CHECKED BY: |
| | SHEET 39 OF 76 |

NOTES:

1. ADDITIONAL RAMP SIGNING MAY BE REQUIRED AS DIRECTED BY THE RESIDENT ENGINEER.
2. THE BID PRICE FOR TRAFFIC CONTROL - ITEM 641.10, SHALL INCLUDE ALL APPROACH AND ON-PROJECT CONSTRUCTION SIGNING, BARRIERS, BARRELS, CONES, BARRICADES, TEMPORARY REGULATORY AND WARNING SIGNS, POSTS AS DETAILED IN STANDARD E-103. ALL ADJUSTING, RELOCATING AND REMOVING OF THESE DEVICES AS DIRECTED BY THE RESIDENT ENGINEER, SHALL BE INCLUDED. THE FOLLOWING ITEMS WILL BE PAID UNDER THEIR SPECIFIC BID PRICES:
 646.614, 646.615, AND 646.70 - TEMPORARY MARKINGS
 630.10, 630.15 - UNIFORMED TRAFFIC OFFICERS AND FLAGGERS
3. SIX (6) PORTABLE CHANGEABLE MESSAGE SIGNS WILL BE PROVIDED FOR USE ALONG THE NORTHBOUND AND SOUTHBOUND LANES AND ON - RAMP OF INTERSTATE 89. THE PLACEMENT OF THESE MESSAGE SIGNS AS WELL AS THEIR MESSAGES WILL BE AS APPROVED BY THE RESIDENT ENGINEER. THIS QUANTITY IS PAID FOR AS PART OF ITEM 641.15 - PORTABLE CHANGEABLE MESSAGE SIGN.

| TOWN/STATE HIGHWAY NAME | ROAD WORK AHEAD | END ROAD WORK | ROAD WORK 500' | ROAD WORK NEXT 7 1/2 MILES | ROAD WORK NEXT 12 1/4 MILES | ROAD WORK NEXT 15 3/4 MILES | ROAD WORK NEXT 16 1/4 MILES | RAMP PAVING AHEAD |
|-------------------------|-----------------|---------------|----------------|----------------------------|-----------------------------|-----------------------------|-----------------------------|-------------------|
| SOUTH OF EXIT II | 2 | 2 | 2 | | | | | 1 |
| BEGINNING OF PROJECT SB | | 2 | | | | | | |
| RTE. 2 @ EXIT II | 4 | 2 | 4 | | | | | 2 |
| EXIT IISB MAINLINE | | | | 1 | | | | |
| RTE. 2A @ EXIT I2 | 2 | 2 | 2 | | | | | 2 |
| EXIT I2 RAMP "B" | | | | | 1 | | | |
| I-189 @ EXIT I3 | 2 | 1 | 2 | | | | | |
| EXIT I3 RAMP "A" | | 2 | | | | 1 | | |
| END OF PROJECT SB | 2 | | 2 | | | | | 1 |
| | | | | | | | | |
| | | | | | | | | |
| TOTAL | 12 | 11 | 12 | 1 | 1 | 1 | | 6 |

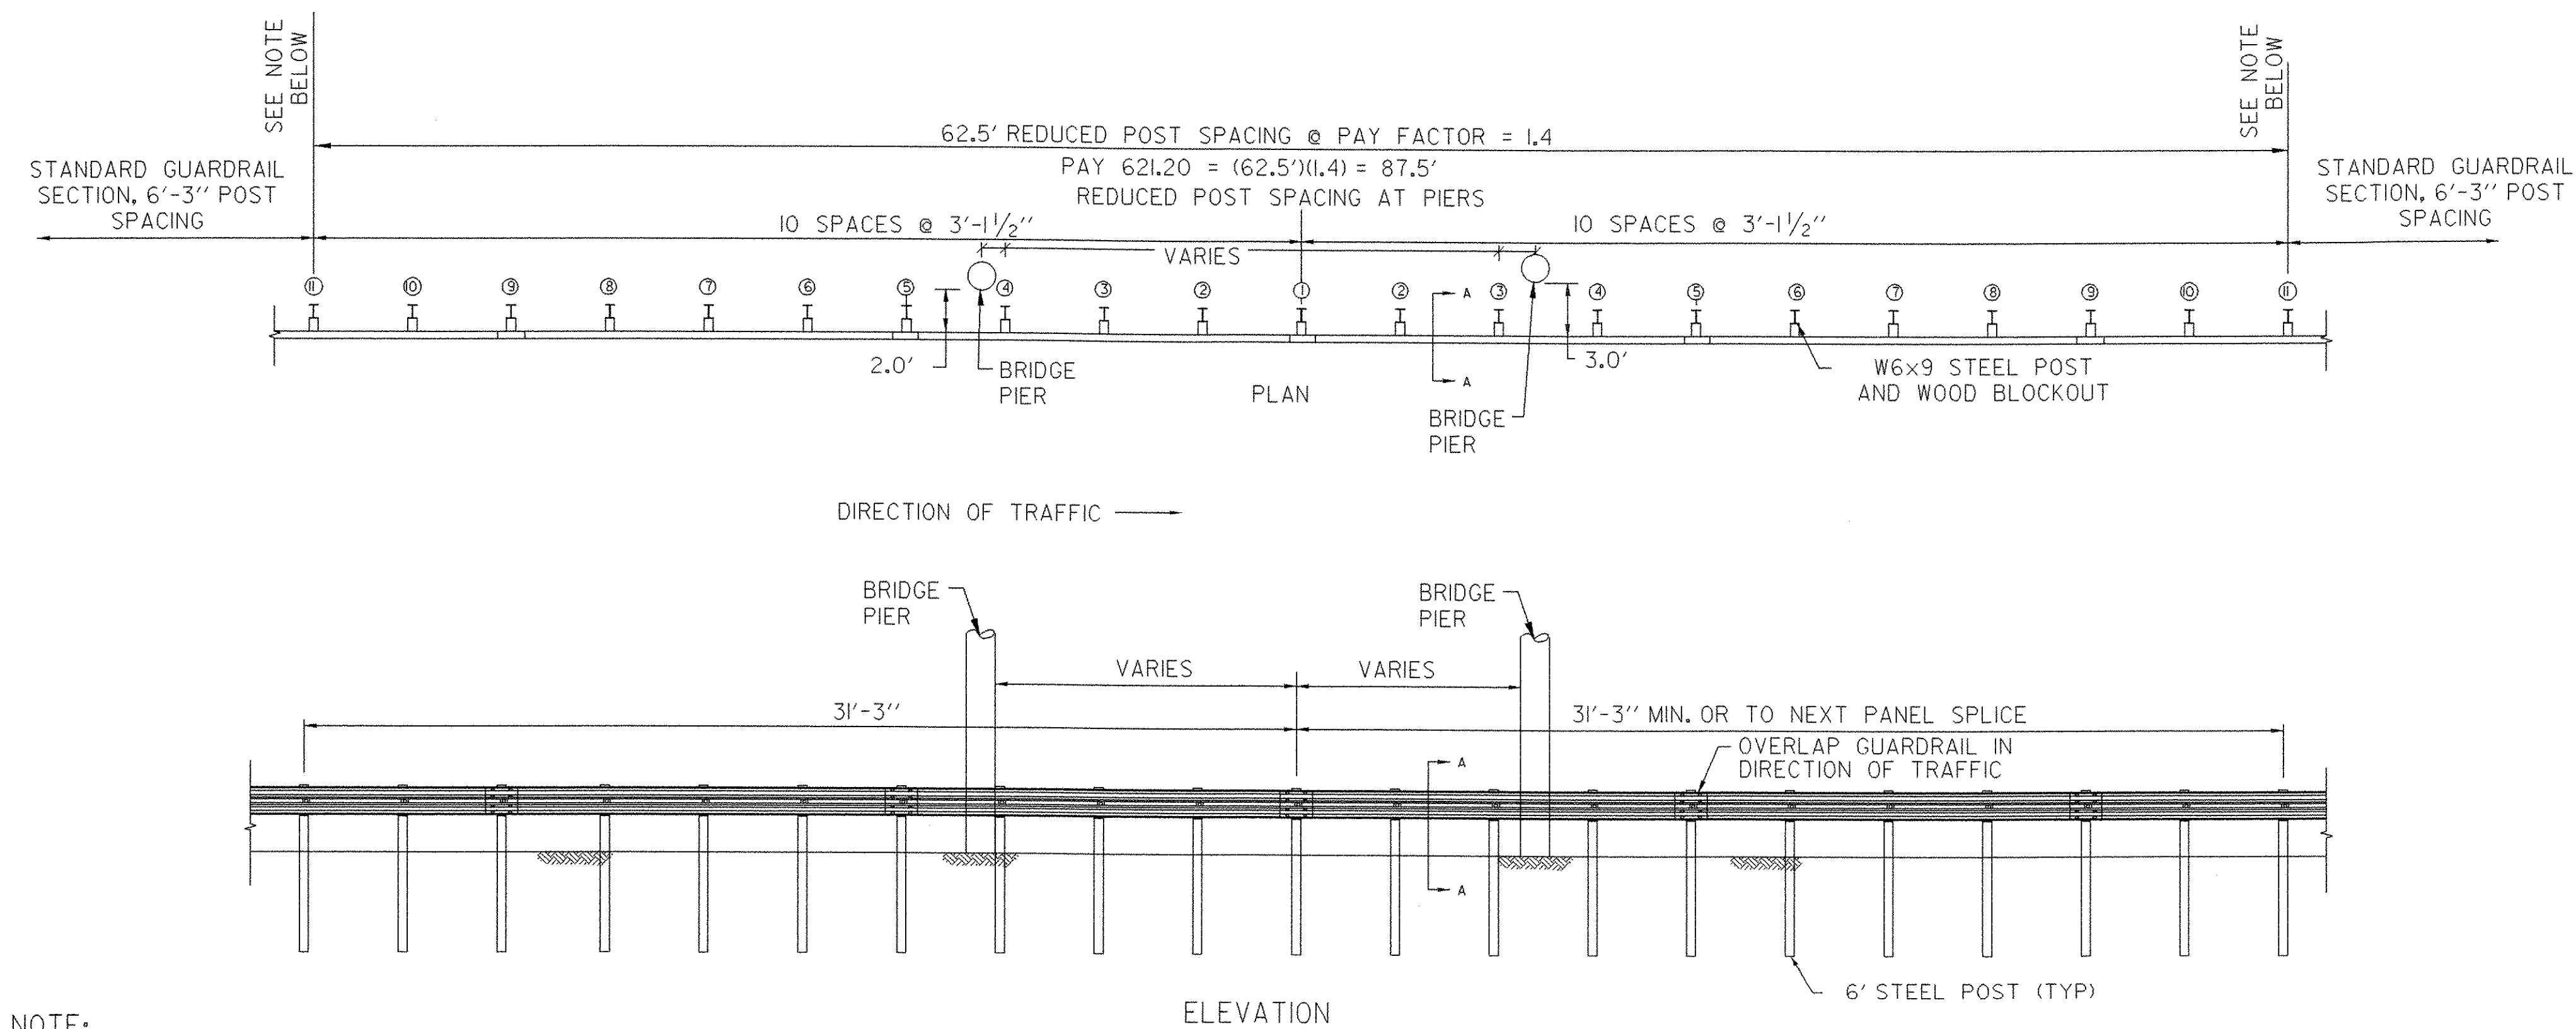

NOTE:
 TO BE PLACED AT THE FOLLOWING LOCATIONS:
 STA. 4025+68 ~ 4027+00 RT(SB)
 STA. 4023+62 ~ 4024+94 LT(NB)

NON-YIELDING OBJECT APPROACH DETAIL

**CONSTRUCTION
 APPROACH
 SIGNING
 SHEET # 2**

PROJECT NAME: BOLTON - SO. BURLINGTON
 PROJECT NUMBER: AC IM 089-2(36)
 FILE NAME: /pave/04all4/p04all4.dgn
 PROJECT LEADER:
 DESIGNED BY:
 IPARM NAME: p04all4cas2.i
 PLOT DATE: 17-MAY-2005
 DRAWN BY:
 CHECKED BY:
 SHEET 40 OF 76

EROSION CONTROL NARRATIVE

1.1 DESCRIPTION OF PROJECT

THIS PROJECT CONSISTS OF LENGTHENING THE EXISTING INTERSTATE 89 (I-89) SOUTHBOUND EXIT 13 ON-RAMP (RAMP A) ACCELERATION LANE AND ASSOCIATED SLOPE WORK. THIS PROJECT MAINTAINS THE EXISTING ALIGNMENT OF INTERSTATE 89 (I-89).

LENGTHENING OF THE ACCELERATION LANE BEGINS AT I-89 STATION 4602+34 (MM 87.17), AND CONTINUES 668 FEET SOUTHEASTERLY TO STATION 4595+66 (MM 87.04). PRIOR TO CONSTRUCTION, TRAFFIC CONTROL WILL INCLUDE BLOCKING OFF THE RIGHT TRAVEL LANE OF I-89 SOUTHBOUND PRIOR TO THE PROJECT AREA USING TEMPORARY TRAFFIC BARRIERS. THIS PROJECT IS EXPECTED TO LAST ONE CONSTRUCTION SEASON.

THE MATERIAL TO BE EXCAVATED FROM THE SITE WILL INCLUDE REMOVAL OF EXISTING PAVEMENT AND SUBBASE, TO A DEPTH OF 37.75-INCHES BELOW EXISTING GRADE. STOCKPILING OF ANY EXCAVATED MATERIAL TO BE REUSED IS EXPECTED TO TAKE PLACE WITHIN THE PROJECT LIMITS OF THE MAINLINE PAVEMENT RESURFACING PROJECT. LIKEWISE, STOCKPILING OF ANY NEW MATERIAL TO BE USED IS EXPECTED TO TAKE PLACE WITHIN THE PROJECT LIMITS. THE LIMIT OF CONSTRUCTION AND ASSOCIATED MAXIMUM SOIL DISTURBANCE AREA FOR THE LENGTHENED ACCELERATION LANE IS APPROXIMATELY 0.2 ACRES.

THERE ARE NO ENVIRONMENTAL RESOURCE ELEMENTS IN THE VICINITY OF THE LENGTHENED ACCELERATION LANE.

1.2 SITE INVENTORY AND ANALYSIS

1.2.1 OFFSITE DRAINAGE CHARACTERISTICS

THIS PROJECT SITE IS LOCATED IN AN URBAN, HIGHLY TRAVELED AREA IN THE CITY OF SOUTH BURLINGTON. THE AREA TO THE SOUTH OF THE PROJECT AREA IS MODERATELY SLOPED. TO THE NORTH OF THE SOUTHBOUND MAINLINE IS THE NORTHBOUND MAINLINE. RUNOFF FROM THE PROJECT AREA DRAINS INTO A DROP INLET ON THE SOUTH SIDE OF BRIDGE 655 OVER DORSET STREET.

1.2.2 DRAINAGE, WATERWAYS, BODIES OF WATER

THERE ARE NO WATERWAYS WITHIN THE PROJECT AREA. DRAINAGE STRUCTURES ARE LOCATED WITHIN THE PROJECT AREA TO COLLECT RUNOFF FROM I-89.

1.2.3 TOPOGRAPHY, EXISTING ROADS, BUILDINGS, UTILITIES

THE TOPOGRAPHY OF THE PROJECT AREA CONSISTS OF MODERATE SLOPES. THERE ARE NO BUILDINGS OR KNOWN UTILITIES WITHIN THE PROJECT AREA.

1.2.4 VEGETATION

THE PROJECT AREA OUTSIDE OF I-89 TRAVEL LANES CONSISTS OF GRASSED SIDE-SLOPES. THE DITCH ON THE SOUTH SIDE OF I-89 SOUTHBOUND CONTAINS CATTAILS. IMPACTS TO VEGETATED AREAS WILL BE LIMITED TO THE SIDE SLOPES OF THE ROAD. FOLLOWING THE COMPLETION OF CONSTRUCTION, THE GRASSY VEGETATION WILL BE RE-ESTABLISHED USING STANDARD SEED AND MULCH PRACTICES.

1.2.5 SOILS

THE NATURAL RESOURCES CONSERVATION SERVICE (NRCS) HAS MAPPED THE SOILS THROUGHOUT CHITTENDEN COUNTY. SOIL TYPES IDENTIFIED FOR THIS PROJECT INCLUDE TERRACE ESCARPMENTS, SILTY AND CLAYEY, HINESBURG FINE SANDY LOAM 8 TO 15 PERCENT SLOPES (POTENTIALLY HIGHLY ERODIBLE) AND HINESBURG FINE SANDY LOAM, 15 TO 25 PERCENT SLOPES (HIGHLY ERODIBLE). SOILS HAVE BEEN PREVIOUSLY DISTURBED WITH THE CONSTRUCTION OF THE INTERSTATE.

1.2.6 SENSITIVE RESOURCE AREAS

THERE ARE NO KNOWN ARCHEOLOGICAL OR HISTORICAL AREAS, THREATENED AND ENDANGERED SPECIES, OR OTHER CRITICAL HABITATS WITHIN THE PROJECT AREA FOR LENGTHENING OF THE ACCELERATION LANE. THERE IS A STATEWIDE PRIME SOIL IN THE PROJECT AREA (HINESBURG FINE SANDY LOAM 8 TO 15 PERCENT SLOPES). SOILS IN THE PROJECT AREA HAVE BEEN PREVIOUSLY DISTURBED WITH THE CONSTRUCTION OF I-89.

1.2.7 PROXIMITY TO NATURAL OR MAN-MADE WATER FEATURES

THE ONLY WATER FEATURES WITHIN THE PROJECT AREA INCLUDE DITCHES ALONG THE TOES OF SLOPE TO CARRY RUNOFF FROM I-89. THESE DITCHES CARRY WATER TO AN EXISTING DROP INLET SOUTH OF THE BRIDGE OVER DORSET STREET. THIS EROSION PREVENTION AND SEDIMENT CONTROL PLAN CONTAINS MEASURES TO PREVENT THE MOBILIZATION AND TRANSPORT OF SEDIMENT INTO DITCHES AND CATCH BASINS WITHIN THE PROJECT AREA.

1.3 TEMPORARY EROSION PREVENTION AND SEDIMENT CONTROL

PROJECT DEMARCATION FENCE SHALL BE INSTALLED TO DELINEATE THE LIMITS THE CONTRACTOR CAN ACCESS WITH CONSTRUCTION EQUIPMENT. THIS MEASURE LIMITS THE AREA THAT CAN BE DISTURBED AND EXPOSED TO EROSION.

TO MINIMIZE THE POTENTIAL FOR STORM WATER RUNOFF TO TRANSPORT SEDIMENT, SEVERAL KEY EROSION CONTROL DEVICES AND GENERAL PRACTICES WILL BE USED. DETAILS OF THE DEVICES AND THE LOCATION OF THEIR PLACEMENT CAN BE FOUND IN THE EROSION CONTROL PLANS AND DETAILS.

SILT FENCE, AS SHOWN ON THE EROSION AND SEDIMENT CONTROL PLAN, SHALL BE PLACED PARALLEL TO, OR ALONG, THE CONTOUR, SO THE STORM WATER WILL RUN PERPENDICULAR TO THE SILT FENCE. THE ENDS SHALL BE "J" HOOKED UP GRADIENT TO CREATE A PONDING EFFECT FOR WATER TRYING TO RUN ALONG THE FENCE AND AROUND THE ENDS.

THE CATCH BASIN WITHIN THE PROJECT AREA SHALL RECEIVE TEMPORARY SILT FENCE PROTECTION (UNPAVED AREAS). THE DROP INLET SHALL RECEIVE TEMPORARY ROCK BARRIER PROTECTION. THESE TEMPORARY MEASURES SHALL BE CONSTRUCTED IN ACCORDANCE WITH THE DETAILS IN THESE PLANS.

TEMPORARY STONE CHECK DAMS WILL BE PLACED ALONG THE DITCH TO THE SOUTH OF THE MAINLINE. THE TEMPORARY STONE CHECK DAMS WILL REDUCE THE VELOCITIES OF THE WATER, ALLOWING SEDIMENT TO SETTLE AND REDUCE THE POTENTIAL FOR EROSION.

EROSION MATTING IS NOT ANTICIPATED FOR THIS PROJECT. IF REQUIRED BY THE RESIDENT ENGINEER, THE CONTRACTOR SHALL USE SUCH MATTING ON SLOPES STEEPER THAN 3H:1V. MATTING WILL REDUCE SEDIMENT TRANSPORT FROM THE SIDE SLOPES, AS IT WILL SLOW DOWN THE RAIN PARTICLES AND ALLOW FOR RAIN TO DISSIPATE INTO THE SOIL, RATHER THAN FLOWING INTO THE CONSTRUCTION AREA. THESE TEMPORARY MEASURES SHALL BE CONSTRUCTED IN ACCORDANCE WITH THE DETAILS IN THESE PLANS. IF MATTING IS NEEDED, IT SHALL BE PAID FOR UNDER ITEM 652.10, "EROSION AND SEDIMENT CONTROL PLAN".

THE EROSION CONTROL MEASURES SHALL BE PERIODICALLY INSPECTED AND MAINTAINED ON A REGULAR BASIS. INSPECTION OF THE EROSION CONTROL MEASURES SHALL TAKE PLACE BEFORE AND AFTER MAJOR STORM EVENTS TO INSURE THEY ARE IN GOOD CONDITION AND TO REMOVE EXCESSIVE BUILDUP OF SILT AND DEBRIS AFTER THE STORM EVENTS. A REPORT ON THE EFFECTIVENESS OF THE EROSION CONTROL MEASURES SHALL BE PRESENTED TO THE RESIDENT ENGINEER AND ONSITE COORDINATOR UPON THE COMPLETION OF EACH INSPECTION. MODIFICATIONS OR IMPROVEMENTS TO THE EROSION CONTROL PLAN SHOULD BE COORDINATED WITH THE RESIDENT ENGINEER AND ON-SITE COORDINATOR.

ALL EROSION CONTROL MEASURES SHALL BE PLACED IN ACCORDANCE WITH THE EROSION CONTROL DETAILS IN THESE PLANS.

STAGING AND STOCKPILING AREAS WILL BE LOCATED ALONG THE I-89 MAINLINE RESURFACING PROJECT. THESE AREAS WILL BE COMPLETELY WITHIN THE PROJECT LIMITS AND WILL UTILIZE THE AFOREMENTIONED TEMPORARY EROSION CONTROL MEASURES. NO ADDITIONAL TEMPORARY EROSION CONTROL MEASURES WILL BE NEEDED.

IN THE EVENT THAT A SEPARATE OR TEMPORARY STOCKPILE AREA IS USED OUTSIDE THE LIMITS OF CONSTRUCTION, A STABILIZED CONSTRUCTION ENTRANCE SHALL BE CONSTRUCTED IN ACCORDANCE WITH THESE PLANS. THE CONSTRUCTION ENTRANCE SHALL BE APPROVED BY THE RESIDENT ENGINEER AND ONSITE COORDINATOR.

1.4 FINAL EROSION CONTROL MEASURES


ALL DISTURBED AREA OUTSIDE OF THE ROADWAY SHALL RECEIVE TOPSOIL, SEED AND MULCH TO REESTABLISH GRASS AND VEGETATION. TOPSOILING, SEEDING AND MULCHING SHALL BE IN ACCORDANCE WITH THE SEEDING FORMULA FOR RURAL AREAS AND ASSOCIATED NOTES AS SHOWN IN THE CONTRACT PLANS. THIS SHALL BE COMPLETED IMMEDIATELY FOLLOWING FINAL GRADING.

GENERAL EROSION CONTROL NOTES

1. THE CONTRACTOR SHALL SUBMIT AN EROSION PREVENTION & SEDIMENT CONTROL PLAN AT THE PRE-CONSTRUCTION CONFERENCE WITH A SCHEDULE OF EVENTS. THIS PLAN WILL BE SITE SPECIFIC.
2. THE CONTRACTOR SHALL DESIGNATE THE RESPONSIBILITIES FOR IMPLEMENTING THE EROSION PREVENTION & SEDIMENT CONTROL PLAN TO ONE INDIVIDUAL. THE CONTRACTOR SHALL ENSURE THAT ALL WORKERS UNDERSTAND THE MAJOR PROVISIONS OF THE EROSION PREVENTION & SEDIMENT CONTROL PLAN. PHYSICALLY MARK OFF LIMITS OF NECESSARY ON-SITE LAND DISTURBANCE WITH CONSTRUCTION BARRIER FENCING AND REVIEW WITH WORKERS AND SUBCONTRACTORS SO THAT ALL WORKERS CAN SEE THE AREAS TO BE PROTECTED.
3. TEMPORARY EROSION CONTROL MEASURES ARE REQUIRED THROUGHOUT THE CONSTRUCTION PERIOD AND UNTIL THE PROJECT HAS BEEN COMPLETED. INSTALL PERIMETER SILT FENCE PRIOR TO CLEARING AND GRUBBING AND INSTALL NECESSARY EROSION AND SEDIMENT CONTROL PRACTICES AS WORK TAKES PLACE.
4. EROSION CONTROL MEASURES SHALL BE PERIODICALLY INSPECTED TO ENSURE THEY ARE IN GOOD CONDITION AND THAT AN EXCESSIVE BUILDUP OF SILT AND DEBRIS HAS NOT OCCURRED.
5. THE CONTRACTOR SHALL MINIMIZE THE AMOUNT OF DISTURBED SOIL EXPOSED TO EROSION FROM WIND AND WATER BY USING VEGETATIVE AND STRUCTURAL CONTROLS AND PROPER TIMING AND SEQUENCING OF CONSTRUCTION ACTIVITIES.
6. IF NEEDED, DIVERT OFF-SITE STORMWATER RUNOFF FROM HIGHLY ERODIBLE AREAS AND STEEP SLOPES AND CONVEY OFF-SITE STORMWATER RUNOFF TO STABLE AREAS.
7. APPLY TEMPORARY OR PERMANENT SOIL STABILIZATION MEASURES IMMEDIATELY ON ALL DISTURBED AREAS WHERE WORK IS DELAYED OR COMPLETED.
8. ANY EARTH STOCKPILES SHALL BE PROTECTED BY A SILT FENCE AT THE PERIMETER AND COVERED WITH A BLANKET OF MULCH.
9. EROSION CHECKS SHALL BE INSTALLED AS INDICATED AND WHERE DESIGNATED ON THE DRAWINGS AND AS NECESSARY TO PREVENT EROSION DAMAGE FROM ANY CONSTRUCTION ACTIVITY.
10. TEMPORARY EROSION CONTROL MEASURES SHALL BE IMMEDIATELY INSPECTED BEFORE AND AFTER RAINFALL EVENTS TO INSURE THEY ARE IN GOOD CONDITION BEFORE RAINFALL AND TO REMOVE EXCESSIVE BUILDUP OF SILT AND DEBRIS AFTER THE STORM EVENT.
11. ALL EROSION CONTROL MEASURES SHALL COMPLY WITH STANDARD VERMONT AGENCY OF NATURAL RESOURCES PERMIT. THE "VERMONT HANDBOOK FOR EROSION PREVENTION AND SEDIMENT CONTROL" DATED 2003, SHALL BE UTILIZED AS A GUIDE FOR THE CONTROL OF EROSION ON THE SITE. THE CONTRACTOR SHALL BE FAMILIAR WITH THE STANDARDS AND SPECIFICATIONS IN THIS PUBLICATION.
12. EROSION MATTING SHALL BE INSTALLED IN PLACE OF MULCH FOR ANY AREAS NOT SEEDED AND MULCHED BY OCTOBER 10 OF THE CONSTRUCTION YEAR.
13. ANY EROSION CONTROL MEASURES THAT WILL BE NECESSARY DURING THE WINTER CONSTRUCTION PERIOD (OCTOBER 15 TO MAY 10) SHALL BE INSTALLED BEFORE THE GROUND FREEZES AND FREQUENTLY INSPECTED AND MAINTAINED THROUGHOUT THE WINTER.
14. EROSION MEASURES SHALL REMAIN IN PLACE UNTIL PERMANENT EROSION CONTROL MEASURES HAVE BEEN ESTABLISHED AND APPROVED BY THE RESIDENT ENGINEER.
15. UNLESS OTHERWISE NOTED IN THE PLANS, ALL MATERIALS, INSTALLATION, MAINTENANCE AND REMOVAL OF THOSE EROSION CONTROL MEASURES WHICH ARE ITEMS IN THE CONTRACT WILL BE PAID FOR AT THE APPROPRIATE CONTRACT UNIT PRICE BID. ALL MATERIALS, INSTALLATION, MAINTENANCE AND REMOVAL FOR ALL OTHER EROSION CONTROL ITEMS REQUIRED BY THE PLANS AND THE RESIDENT ENGINEER WILL BE PAID FOR UNDER ITEM 652.30.


PROJECT NAME: BOLTON - SO. BURLINGTON
PROJECT NUMBER: AC IM 089-2(36)

| | |
|-----------------------------|------------------------|
| FILE NAME: I8800F4ECP01.dgn | PLOT DATE: 17-MAY-2005 |
| PROJECT LEADER: EPD | DRAWN BY: JDA |
| DESIGNED BY: JDA | CHECKED BY: EPD |
| EROSION CONTROL NARRATIVE | SHEET 41 OF 76 |

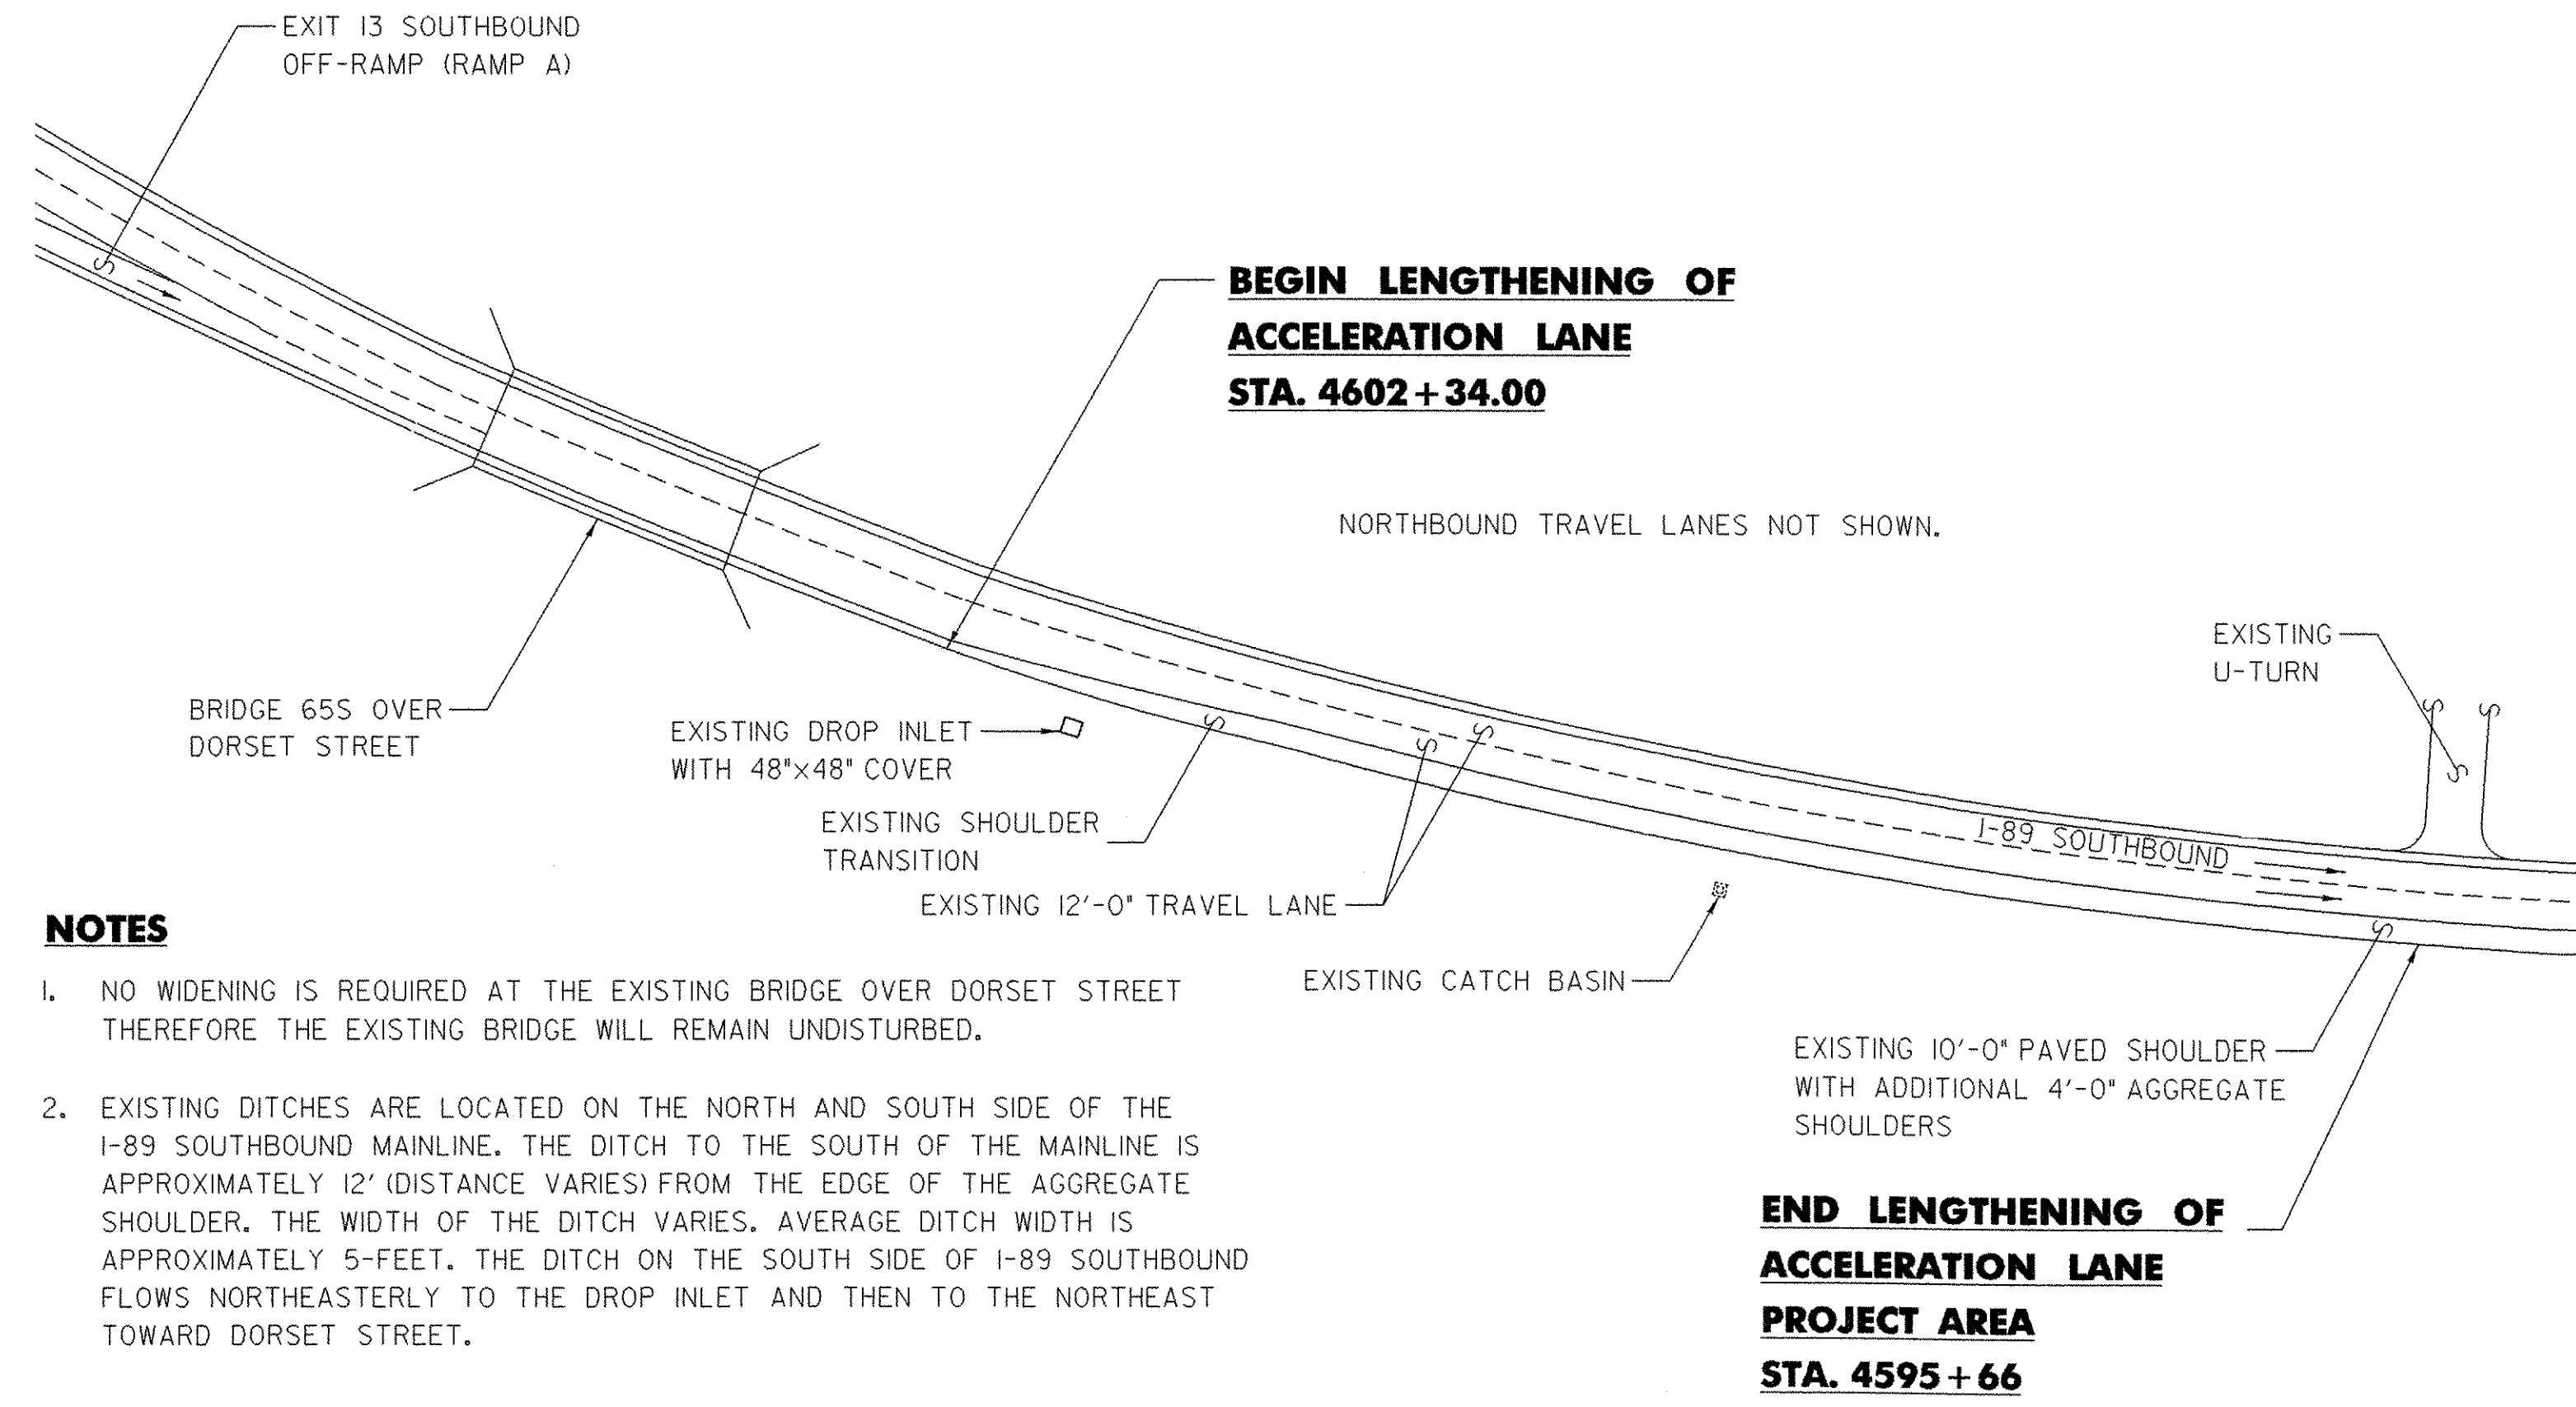

- NOTES**
1. NO WIDENING IS REQUIRED AT THE EXISTING BRIDGE OVER DORSET STREET THEREFORE THE EXISTING BRIDGE WILL REMAIN UNDISTURBED.
 2. EXISTING DITCHES ARE LOCATED ON THE NORTH AND SOUTH SIDE OF THE I-89 SOUTHBOUND MAINLINE. THE DITCH TO THE SOUTH OF THE MAINLINE IS APPROXIMATELY 12' (DISTANCE VARIES) FROM THE EDGE OF THE AGGREGATE SHOULDER. THE WIDTH OF THE DITCH VARIES. AVERAGE DITCH WIDTH IS APPROXIMATELY 5-FEET. THE DITCH ON THE SOUTH SIDE OF I-89 SOUTHBOUND FLOWS NORTHEASTERLY TO THE DROP INLET AND THEN TO THE NORTHEAST TOWARD DORSET STREET.


EROSION CONTROL EXISTING CONDITIONS
NOT TO SCALE

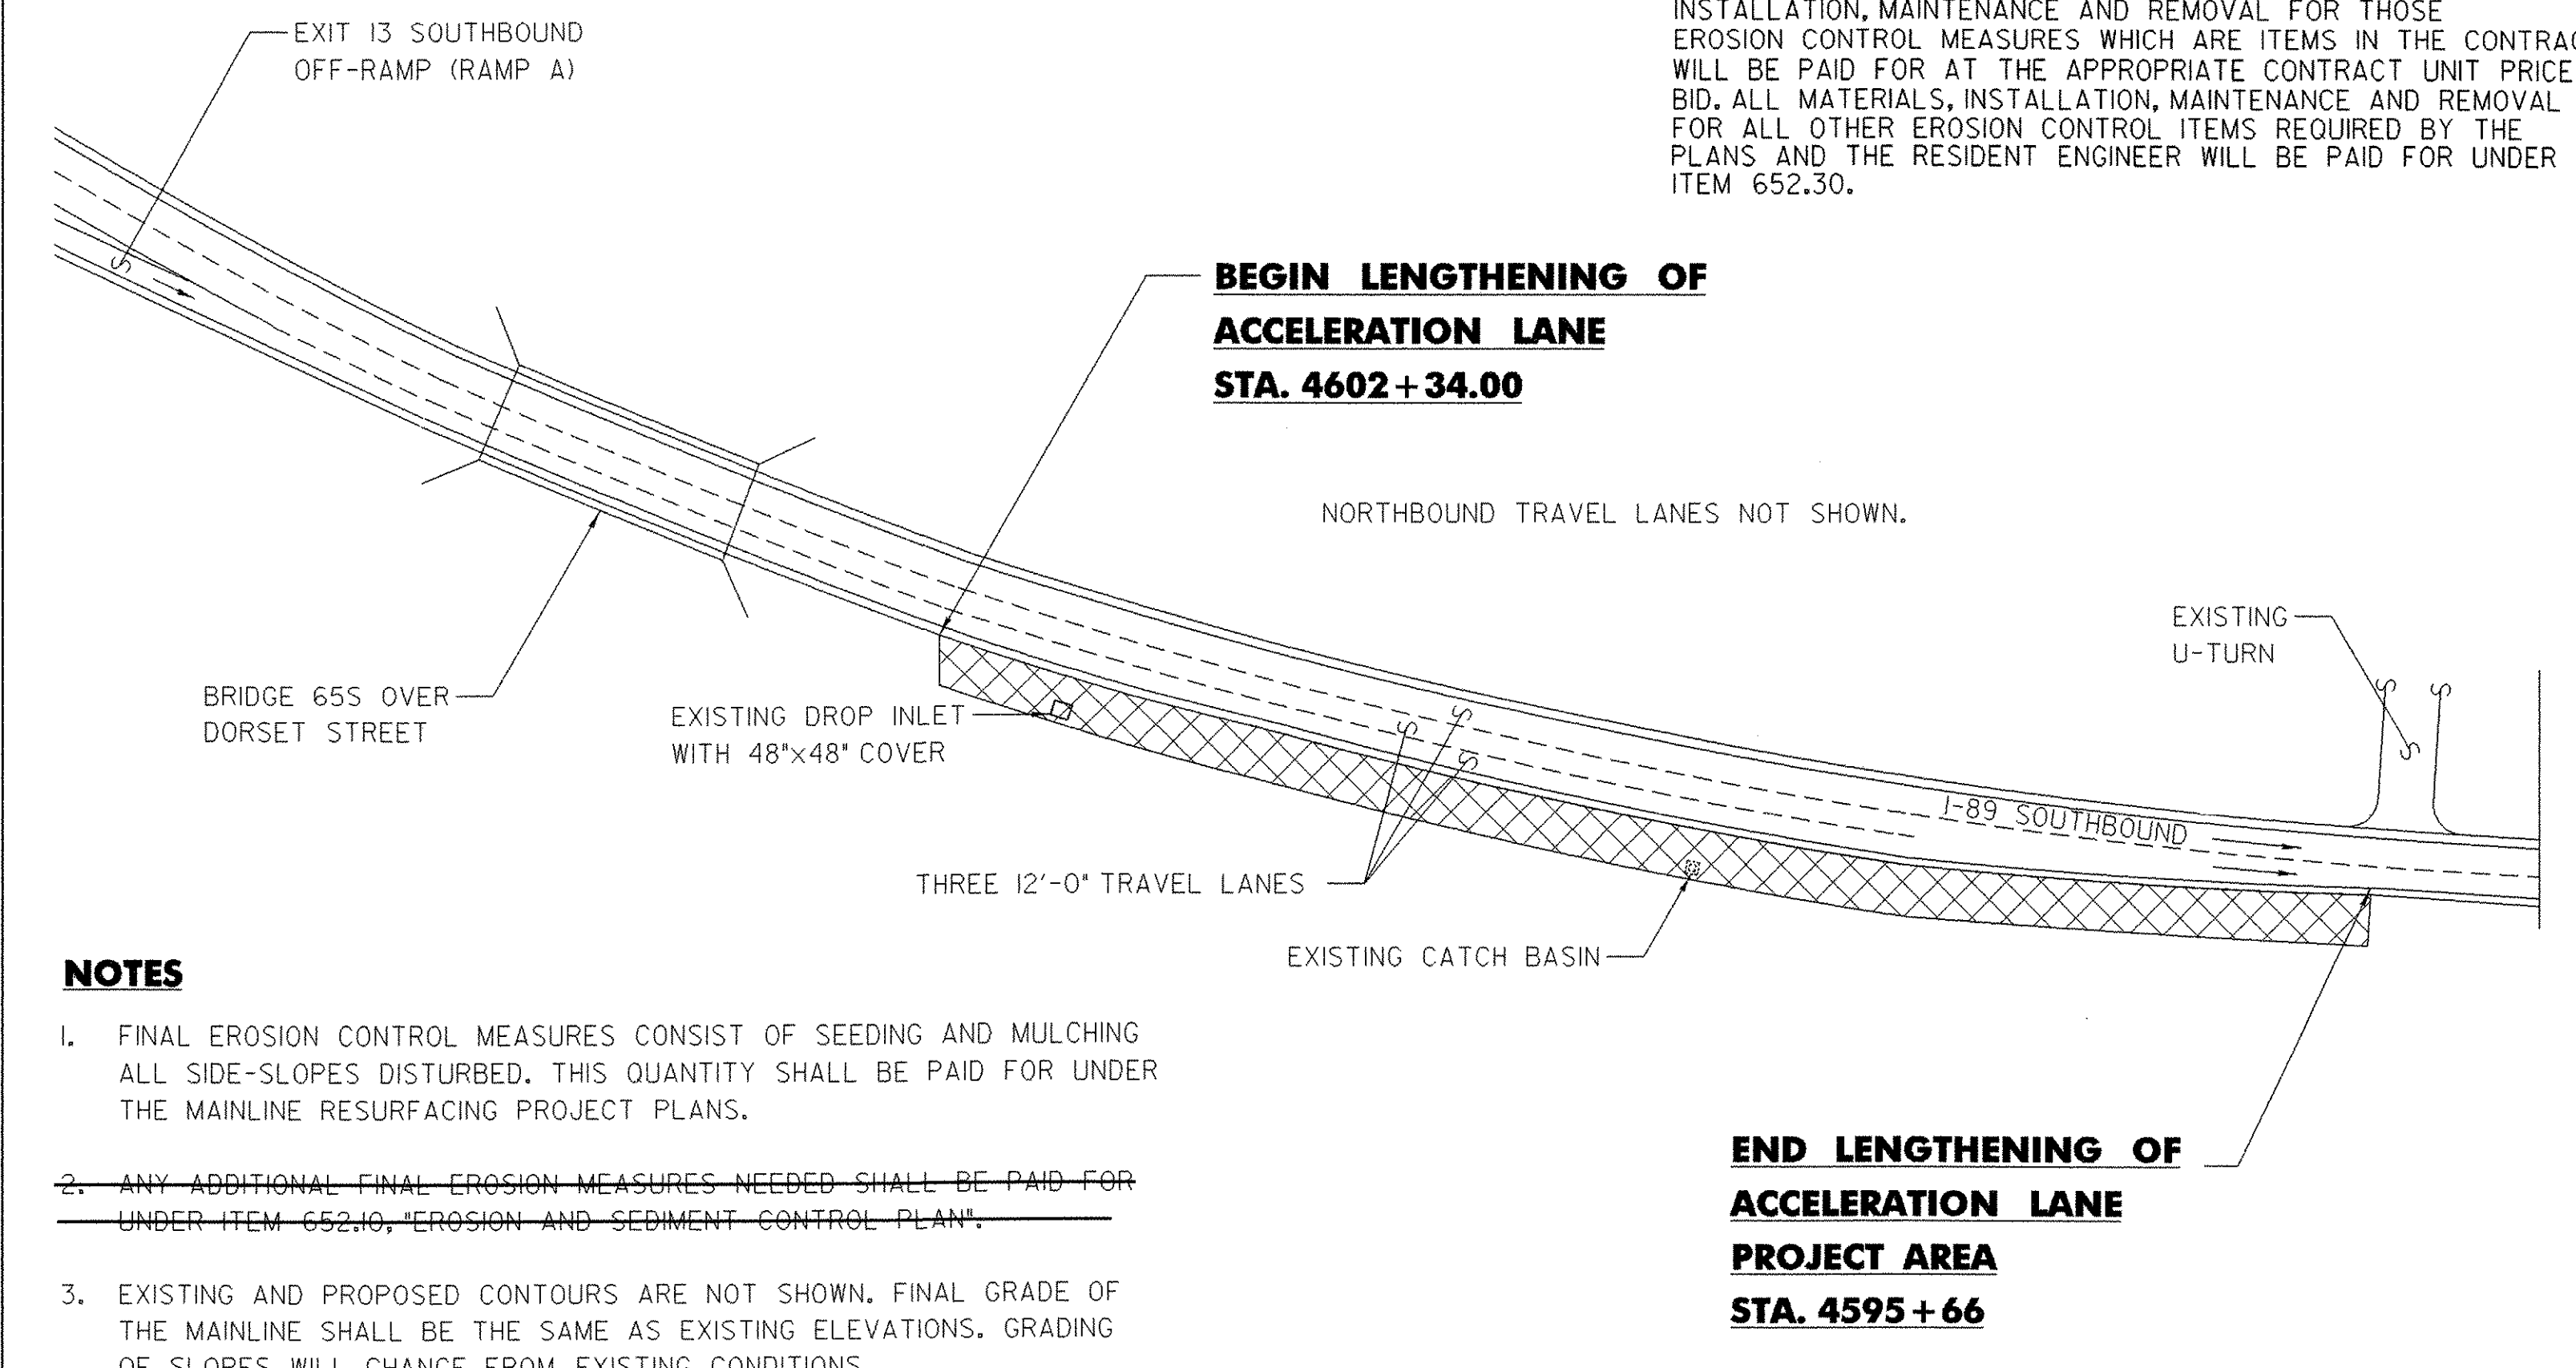

- NOTES**
1. FINAL EROSION CONTROL MEASURES CONSIST OF SEEDING AND MULCHING ALL SIDE-SLOPES DISTURBED. THIS QUANTITY SHALL BE PAID FOR UNDER THE MAINLINE RESURFACING PROJECT PLANS.
 2. ANY ADDITIONAL FINAL EROSION MEASURES NEEDED SHALL BE PAID FOR UNDER ITEM 652.10, "EROSION AND SEDIMENT CONTROL PLAN".
 3. EXISTING AND PROPOSED CONTOURS ARE NOT SHOWN. FINAL GRADE OF THE MAINLINE SHALL BE THE SAME AS EXISTING ELEVATIONS. GRADING OF SLOPES WILL CHANGE FROM EXISTING CONDITIONS.

EROSION CONTROL FINAL CONDITIONS
NOT TO SCALE


NOTE:
UNLESS OTHERWISE NOTED ON THE PLANS, ALL MATERIALS, INSTALLATION, MAINTENANCE AND REMOVAL FOR THOSE EROSION CONTROL MEASURES WHICH ARE ITEMS IN THE CONTRACT WILL BE PAID FOR AT THE APPROPRIATE CONTRACT UNIT PRICE BID. ALL MATERIALS, INSTALLATION, MAINTENANCE AND REMOVAL FOR ALL OTHER EROSION CONTROL ITEMS REQUIRED BY THE PLANS AND THE RESIDENT ENGINEER WILL BE PAID FOR UNDER ITEM 652.30.

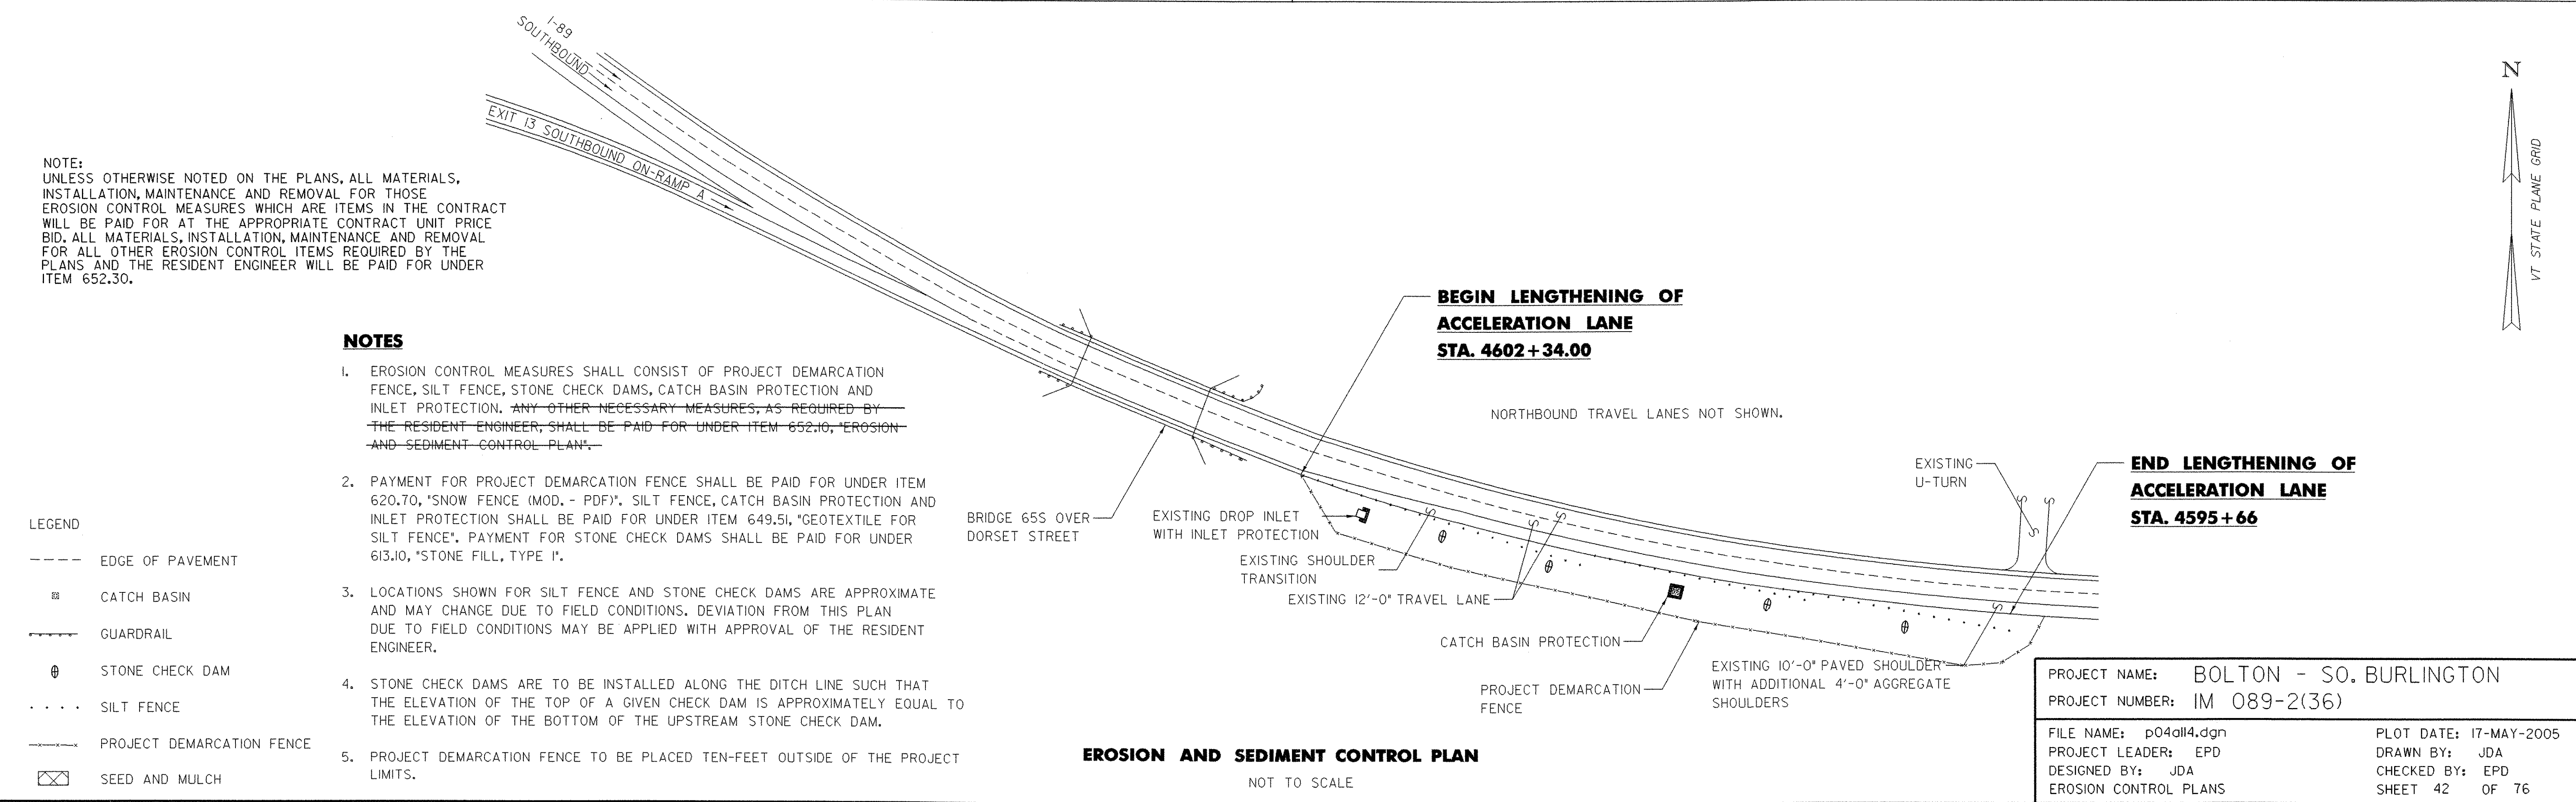

- NOTE:
UNLESS OTHERWISE NOTED ON THE PLANS, ALL MATERIALS, INSTALLATION, MAINTENANCE AND REMOVAL FOR THOSE EROSION CONTROL MEASURES WHICH ARE ITEMS IN THE CONTRACT WILL BE PAID FOR AT THE APPROPRIATE CONTRACT UNIT PRICE BID. ALL MATERIALS, INSTALLATION, MAINTENANCE AND REMOVAL FOR ALL OTHER EROSION CONTROL ITEMS REQUIRED BY THE PLANS AND THE RESIDENT ENGINEER WILL BE PAID FOR UNDER ITEM 652.30.
- NOTES**
1. EROSION CONTROL MEASURES SHALL CONSIST OF PROJECT DEMARCATION FENCE, SILT FENCE, STONE CHECK DAMS, CATCH BASIN PROTECTION AND INLET PROTECTION. ~~ANY OTHER NECESSARY MEASURES, AS REQUIRED BY THE RESIDENT ENGINEER, SHALL BE PAID FOR UNDER ITEM 652.10, "EROSION AND SEDIMENT CONTROL PLAN".~~
 2. PAYMENT FOR PROJECT DEMARCATION FENCE SHALL BE PAID FOR UNDER ITEM 620.70, "SNOW FENCE (MOD. - PDF)". SILT FENCE, CATCH BASIN PROTECTION AND INLET PROTECTION SHALL BE PAID FOR UNDER ITEM 649.51, "GEOTEXTILE FOR SILT FENCE". PAYMENT FOR STONE CHECK DAMS SHALL BE PAID FOR UNDER 613.10, "STONE FILL, TYPE 1".
 3. LOCATIONS SHOWN FOR SILT FENCE AND STONE CHECK DAMS ARE APPROXIMATE AND MAY CHANGE DUE TO FIELD CONDITIONS. DEVIATION FROM THIS PLAN DUE TO FIELD CONDITIONS MAY BE APPLIED WITH APPROVAL OF THE RESIDENT ENGINEER.
 4. STONE CHECK DAMS ARE TO BE INSTALLED ALONG THE DITCH LINE SUCH THAT THE ELEVATION OF THE TOP OF A GIVEN CHECK DAM IS APPROXIMATELY EQUAL TO THE ELEVATION OF THE BOTTOM OF THE UPSTREAM STONE CHECK DAM.
 5. PROJECT DEMARCATION FENCE TO BE PLACED TEN-FEET OUTSIDE OF THE PROJECT LIMITS.
- LEGEND**
- EDGE OF PAVEMENT
 - ⊗ CATCH BASIN
 - GUARDRAIL
 - ⊙ STONE CHECK DAM
 - ... SILT FENCE
 - PROJECT DEMARCATION FENCE
 - ⊠ SEED AND MULCH

EROSION AND SEDIMENT CONTROL PLAN
NOT TO SCALE

| | |
|---------------------------------------|------------------------|
| PROJECT NAME: BOLTON - SO. BURLINGTON | |
| PROJECT NUMBER: IM 089-2(36) | |
| FILE NAME: p04dl14.dgn | PLOT DATE: 17-MAY-2005 |
| PROJECT LEADER: EPD | DRAWN BY: JDA |
| DESIGNED BY: JDA | CHECKED BY: EPD |
| EROSION CONTROL PLANS | SHEET 42 OF 76 |

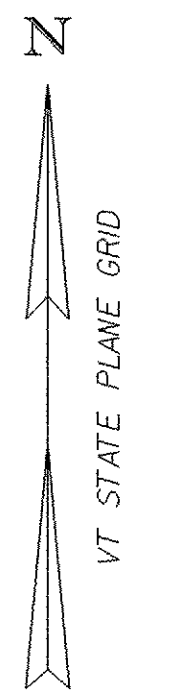

SILT FENCE

APPLICATION NOTES:


- THE PRIMARY PURPOSE OF SILT FENCE IS TO REDUCE RUNOFF VELOCITY AND TRAP SEDIMENT. VELOCITY IS REDUCED, WATER IS IMPOUNDED BEHIND THE MEASURE, AND SEDIMENT FALLS OUT OF SUSPENSION.
- SILT FENCE SHALL BE INSTALLED ON A LINE OF EQUAL ELEVATION (CONTOUR). IT MAY BE INSTALLED AT INTERMEDIATE POINTS UP SLOPES AS WELL AS AT THE BOTTOM, AS SHOWN IN THE DETAIL.
- SILT FENCE SHALL NOT BE USED ACROSS CONCENTRATED FLOW.

GENERAL NOTES:


- SILT FENCE SHALL GENERALLY BE PLACED A MINIMUM OF 5 FEET BEYOND TOE OF SLOPE, 10 FEET PREFERRED, TO PROVIDE ADEQUATE AREA FOR SEDIMENT STORAGE AND FACILITATE MAINTENANCE OF SEDIMENT CONTAINMENT AREA.
- ALL ENDS SHALL BE "J" HOOKED TO TRAP SEDIMENT.
- IN AREAS WITH TWO SLOPES, SILT FENCE SHALL BE USED TO ERECT A DAM AND TRAP SEDIMENT AT THE BASE OF THE STEEPER SLOPE.
- THE BOTTOM EDGE OF SILT FENCE SHALL BE BURIED A MINIMUM OF 6 INCHES BELOW GROUND, AND KEYED IN 4 INCHES. THE FENCE SHALL BE INSTALLED WITH THE POSTS ON THE DOWNSTREAM SIDE OF THE FABRIC.
- MAXIMUM DRAINAGE AREA TRIBUTARY TO 100 FEET OF SILT FENCE SHALL BE 0.25 ACRES.
- THE FOLLOWING ARE MAXIMUM SLOPE LENGTHS FOR THESE MEASURES:

| CONSTRUCTED SLOPE | SLOPE LENGTH (LS) FT | HORIZONTAL LENGTH (LH) FT |
|-------------------|----------------------|---------------------------|
| 3 : 1 | 80 | 75 |
| 4 : 1 | 130 | 125 |
| 5 : 1 | 200 | 200 |
| > 5 : 1 | 250 | 250 |


- MEASURES SHALL BE INSPECTED EVERY SEVEN (7) CALENDAR DAYS AND WITHIN 24 HOURS OF A STORM EVENT GREAT ENOUGH TO CAUSE WATER TO LEAVE THE CONSTRUCTION SITE.
- MEASURES SHALL BE CLEANED AND REPAIRED AS NEEDED. SEDIMENT SHALL BE REMOVED WHEN ACCUMULATION REACHES ONE-HALF OF THE MEASURE HEIGHT. SEDIMENT SHALL BE DISPOSED OF AS UNSUITABLE MATERIAL.
- SILT FENCE SHALL BE REMOVED WHEN THE AREA HAS BEEN STABILIZED. AT TIME OF REMOVAL OF THE SILT FENCE, THE DISTURBED AREA SHALL BE REPAIRED AND STABILIZED.
- PAYMENT FOR INSTALLATION AND REMOVAL OF SILT FENCE SHALL BE MADE UNDER THE GEOTEXTILE FOR SILT FENCE ITEM.
- PAYMENT FOR MONITORING SILT FENCE SHALL BE MADE UNDER THE MONITORING EROSION PREVENTION & SEDIMENT CONTROL PLAN ITEM.
- PAYMENT FOR MAINTAINING SILT FENCE SHALL BE MADE UNDER THE FIELD MAINTENANCE OF EROSION PREVENTION & SEDIMENT CONTROL PLAN ITEM, UNLESS IN THE OPINION OF THE RESIDENT ENGINEER MAINTENANCE IS REQUIRED DUE TO POOR INSTALLATION PRACTICES, WHEREAS IT WILL THEN BE REPAIRED AT THE CONTRACTORS SOLE EXPENSE.

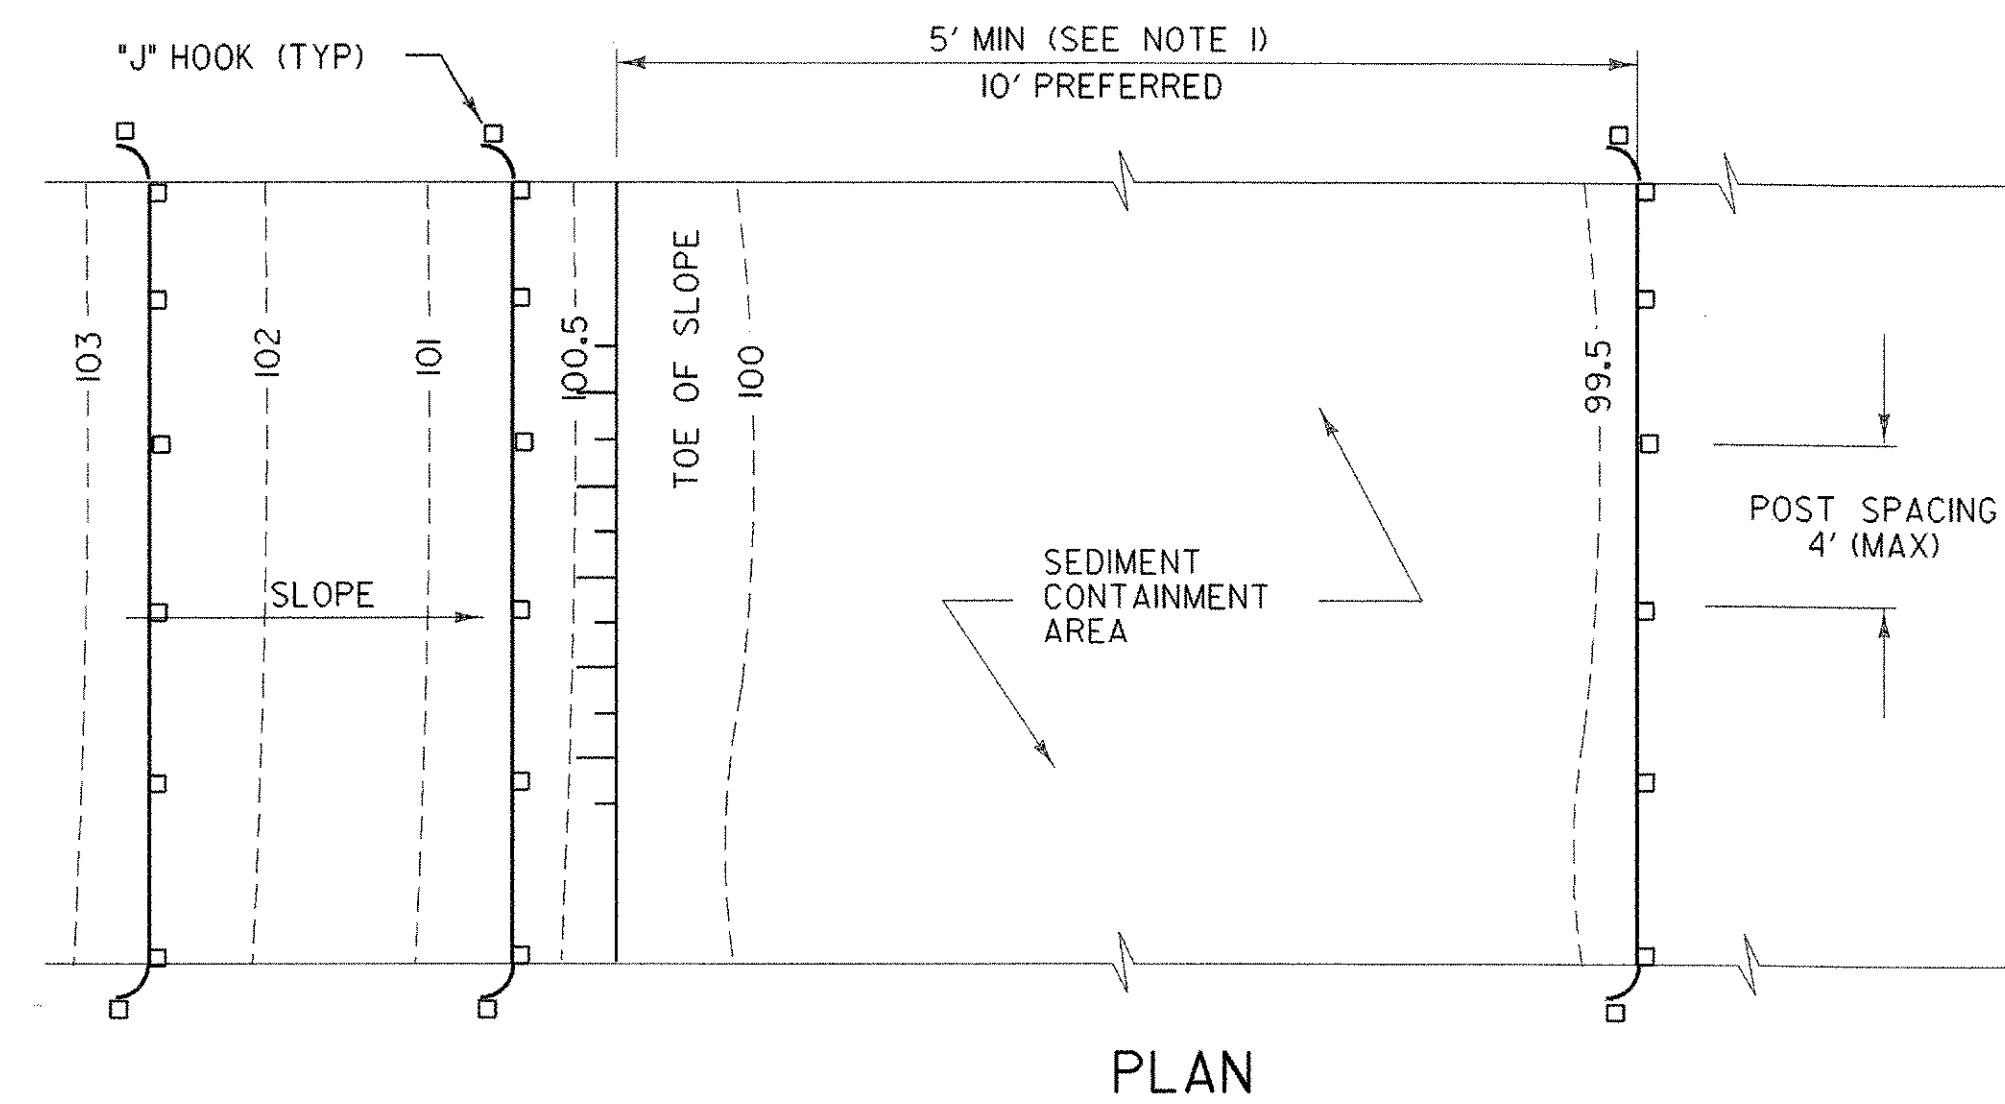

PLAN

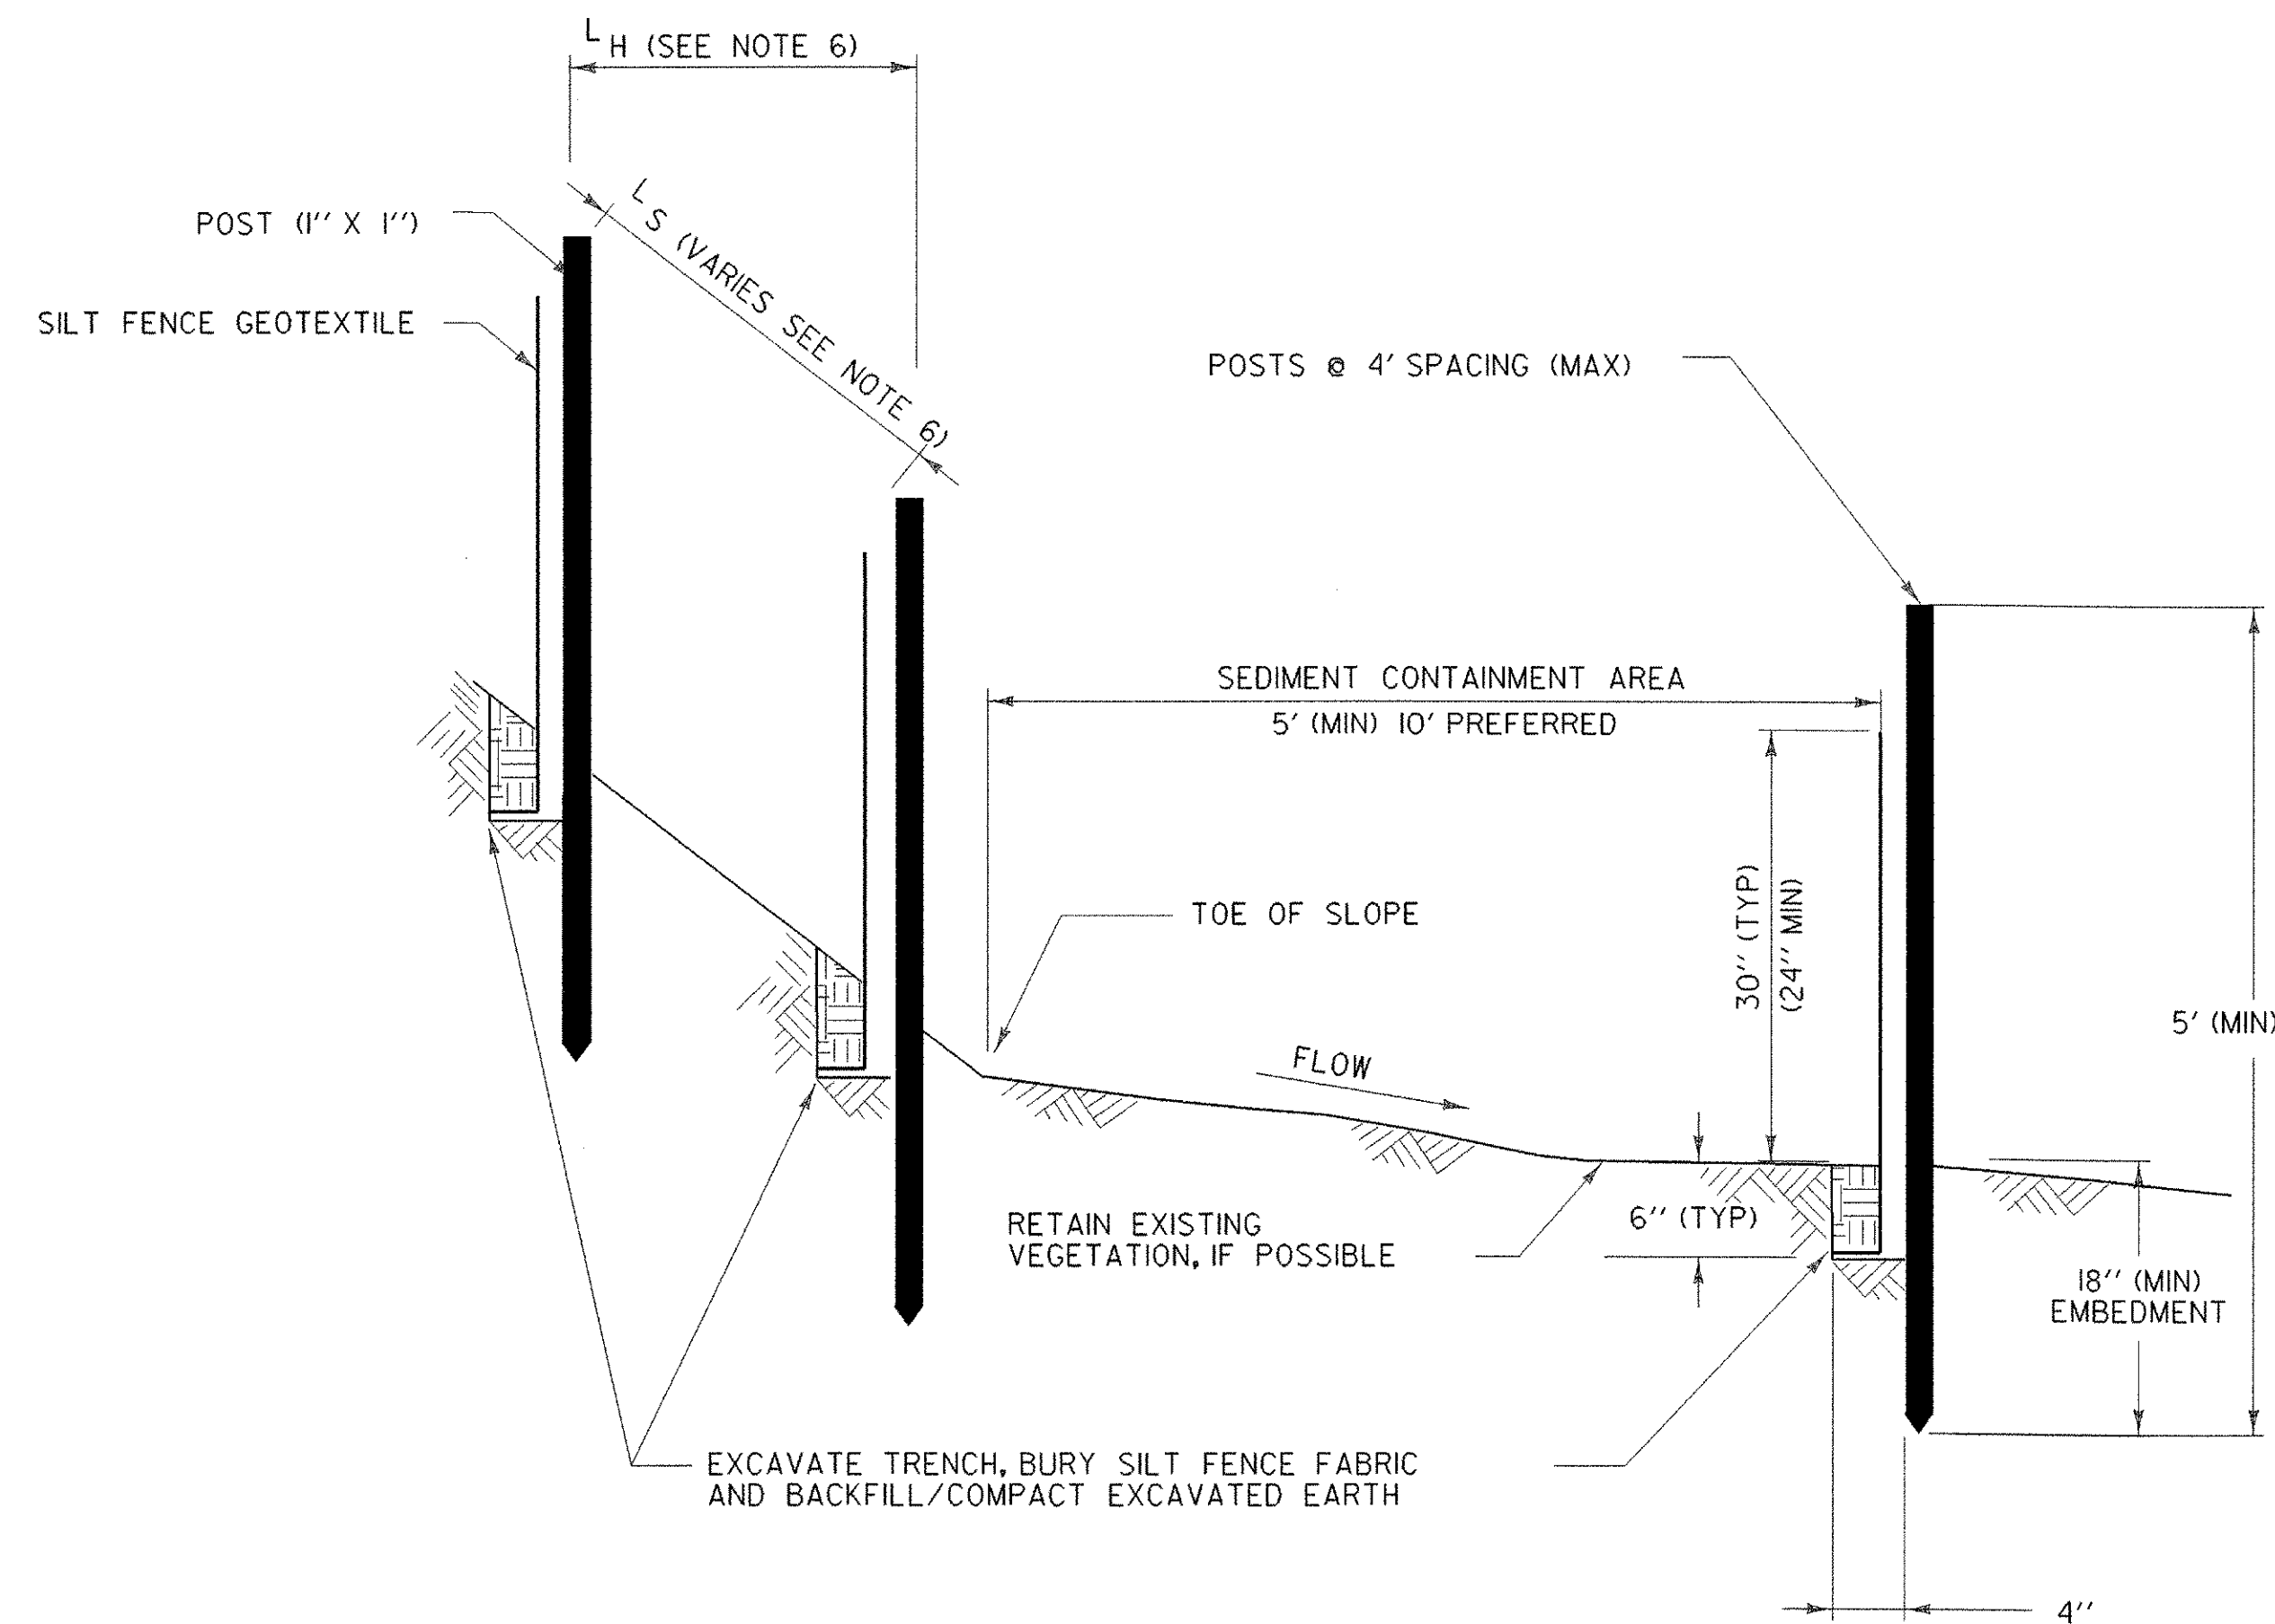

SECTION
SILT FENCE - TEMPORARY

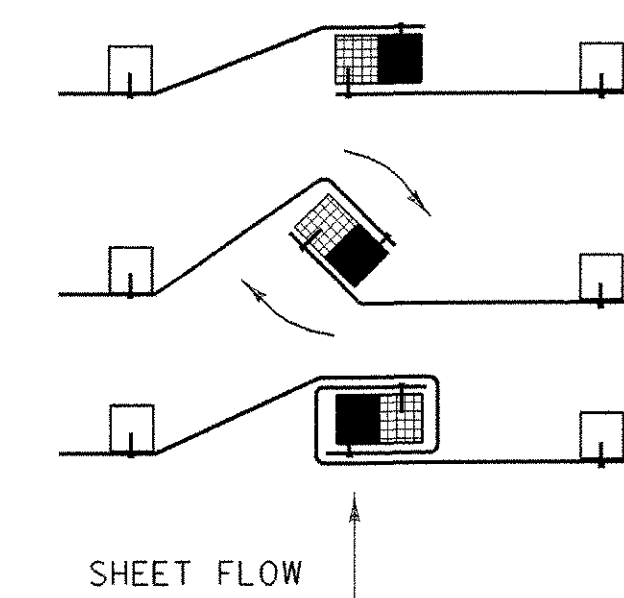



- PLACE THE END POST OF ONE FENCE INSIDE THE END POST OF THE OTHER FENCE.
- ROTATE BOTH POSTS AT LEAST 180 DEGREES IN A CLOCKWISE DIRECTION TO CREATE A TIGHT SEAL WITH THE FABRIC MATERIAL.
- DRIVE BOTH POSTS 18 INCHES INTO THE GROUND AND BURY THE FLAP IN THE TRENCH.

SPlicing DETAIL

PROJECT NAME: BOLTON - SO. BURLINGTON
PROJECT NUMBER: AC IM 089-2(36)

FILE NAME: I8800F4ECP03.dgn
PROJECT LEADER: EPD
DESIGNED BY: JDA
SILT FENCE DETAILS

PLOT DATE: 17-MAY-2005
DRAWN BY: JDA
CHECKED BY: EPD
SHEET 43 OF 76



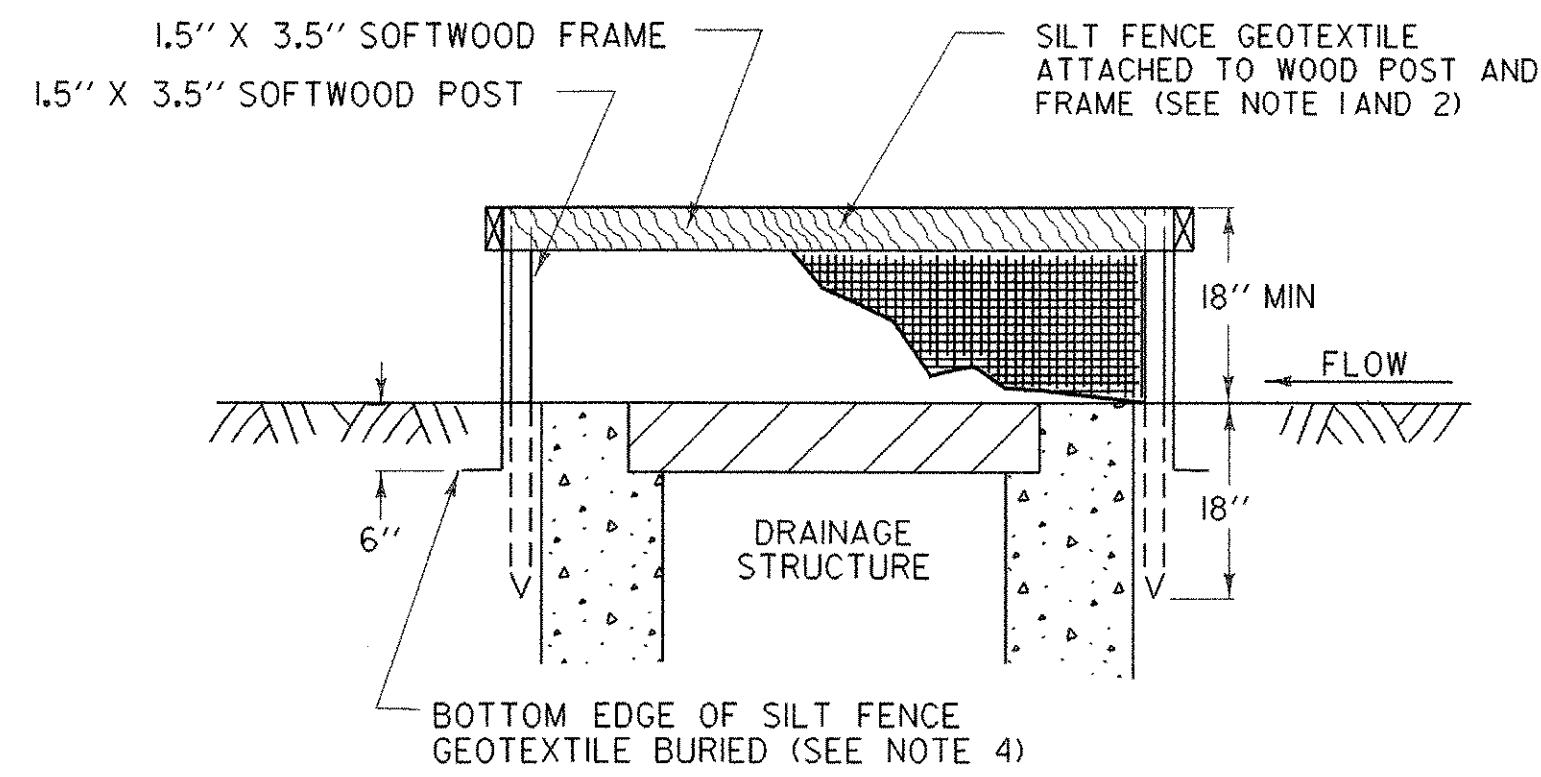
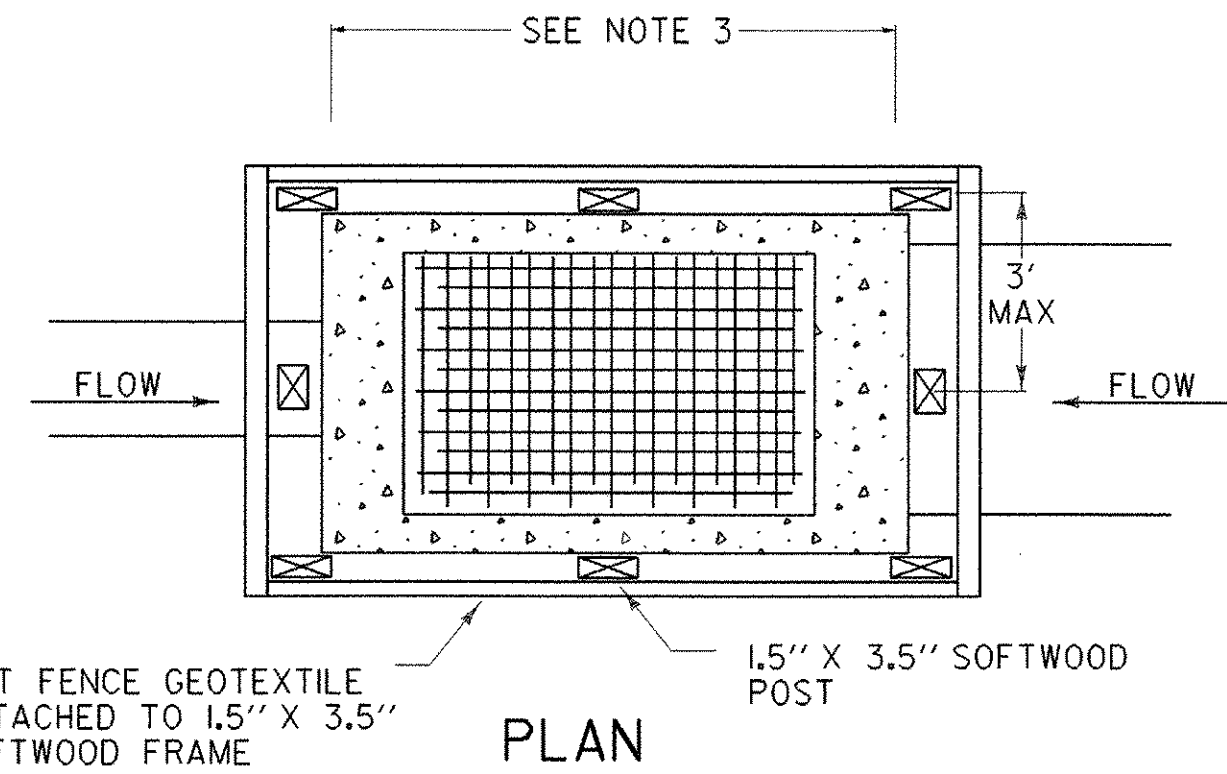


SILT FENCE DROP INLET PROTECTION

DROP INLET PROTECTION

GENERAL NOTES:

1. THE TOP OF THE INLET PROTECTION SHALL BE SET AT THE MAXIMUM DESIRED WATER LEVEL, BASED ON FIELD LOCATION AND CONDITIONS.
2. SILT FENCE GEOTEXTILE SHALL BE A SINGLE CONTINUOUS PIECE TO ELIMINATE JOINTS.
3. SPACE SILT FENCE POSTS EVENLY AROUND INLET WITH A MAXIMUM SPACING OF 3 FEET. DRIVE POSTS A MINIMUM OF 18 INCHES INTO GROUND. WIRE MESH MAY BE REQUIRED BEHIND GEOTEXTILE TO PROVIDE SUPPORT.
4. SILT FENCE GEOTEXTILE SHALL BE EMBEDDED A MINIMUM OF 6 INCHES AND BACKFILLED. GEOTEXTILE SHALL BE SECURELY FASTENED TO POSTS AND FRAME.
5. BLANK
6. BLANK
7. SECURE THE ENDS OF THE APRON FOR THE PREFABRICATED DRAINAGE STRUCTURE INLET PROTECTION WITH STAPLES AS DETAILED IN THE PLAN VIEW OR AS RECOMMENDED BY THE MANUFACTURERS LITERATURE.
8. MEASURES SHALL BE INSPECTED EVERY SEVEN (7) CALENDAR DAYS AND WITHIN 24 HOURS OF A STORM EVENT GREAT ENOUGH TO CAUSE WATER TO LEAVE THE CONSTRUCTION SITE.
9. MEASURES SHALL BE CLEANED AND REPAIRED AS NEEDED. SEDIMENT SHALL BE REMOVED WHEN ACCUMULATION REACHES ONE-HALF OF THE MEASURE HEIGHT. SEDIMENT SHALL BE DISPOSED OF AS UNSUITABLE MATERIAL.
10. PAYMENT OF INLET PROTECTION SHALL BE MADE UNDER APPLICABLE ITEMS INCLUDED IN THE CONTRACT PLANS.
11. PAYMENT FOR MONITORING INLET PROTECTION SHALL BE MADE UNDER THE MONITORING EROSION PREVENTION & SEDIMENT CONTROL PLAN ITEM.
12. PAYMENT FOR MAINTAINING INLET PROTECTION SHALL BE MADE UNDER THE FIELD MAINTENANCE OF EROSION PREVENTION & SEDIMENT CONTROL PLAN ITEM, UNLESS IN THE OPINION OF THE RESIDENT ENGINEER MAINTENANCE IS REQUIRED DUE TO POOR INSTALLATION PRACTICES, WHEREAS IT WILL BE REPAIRED AT THE CONTRACTORS SOLE EXPENSE.

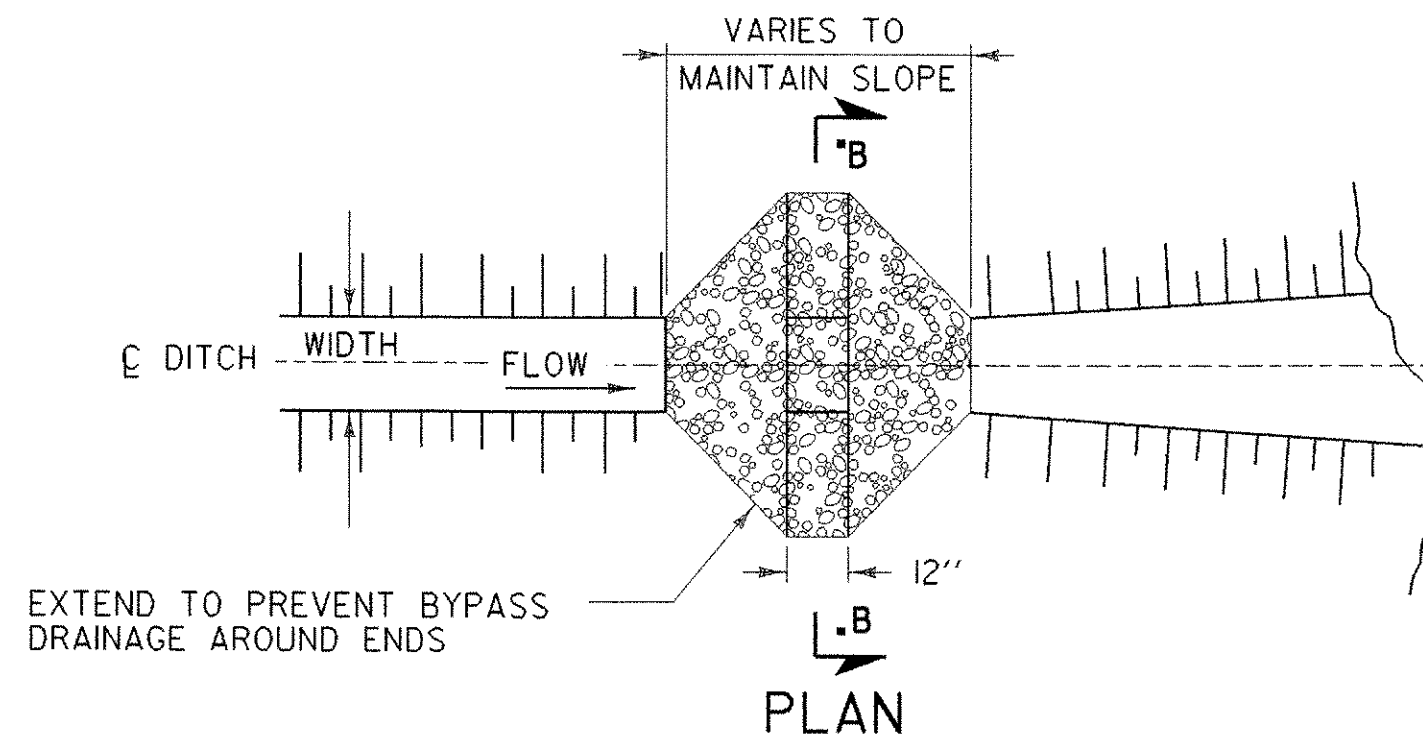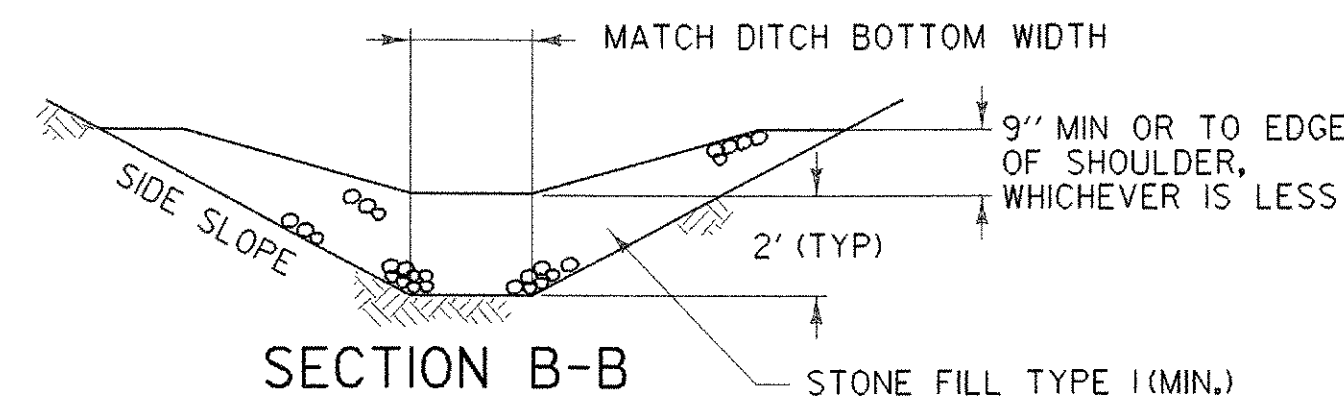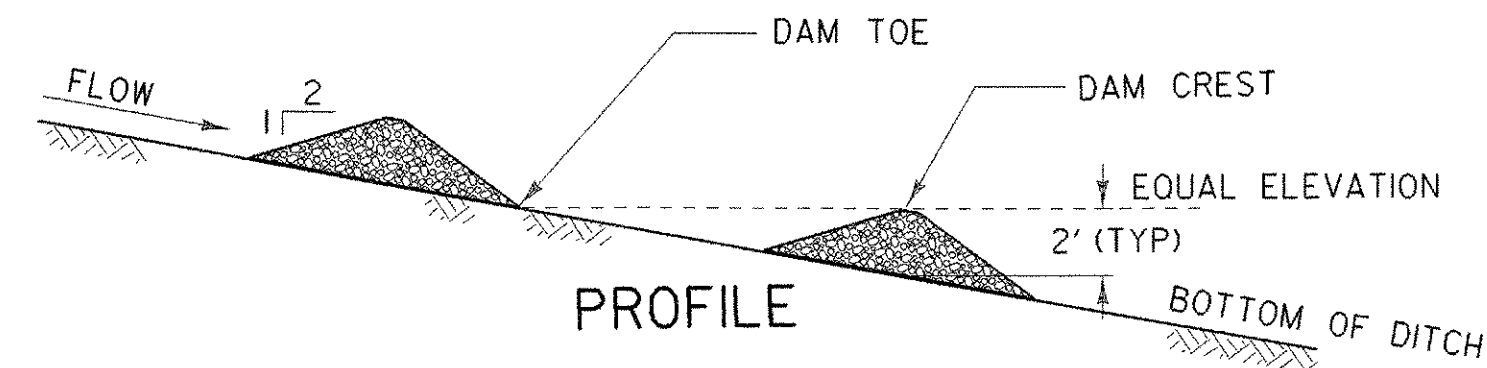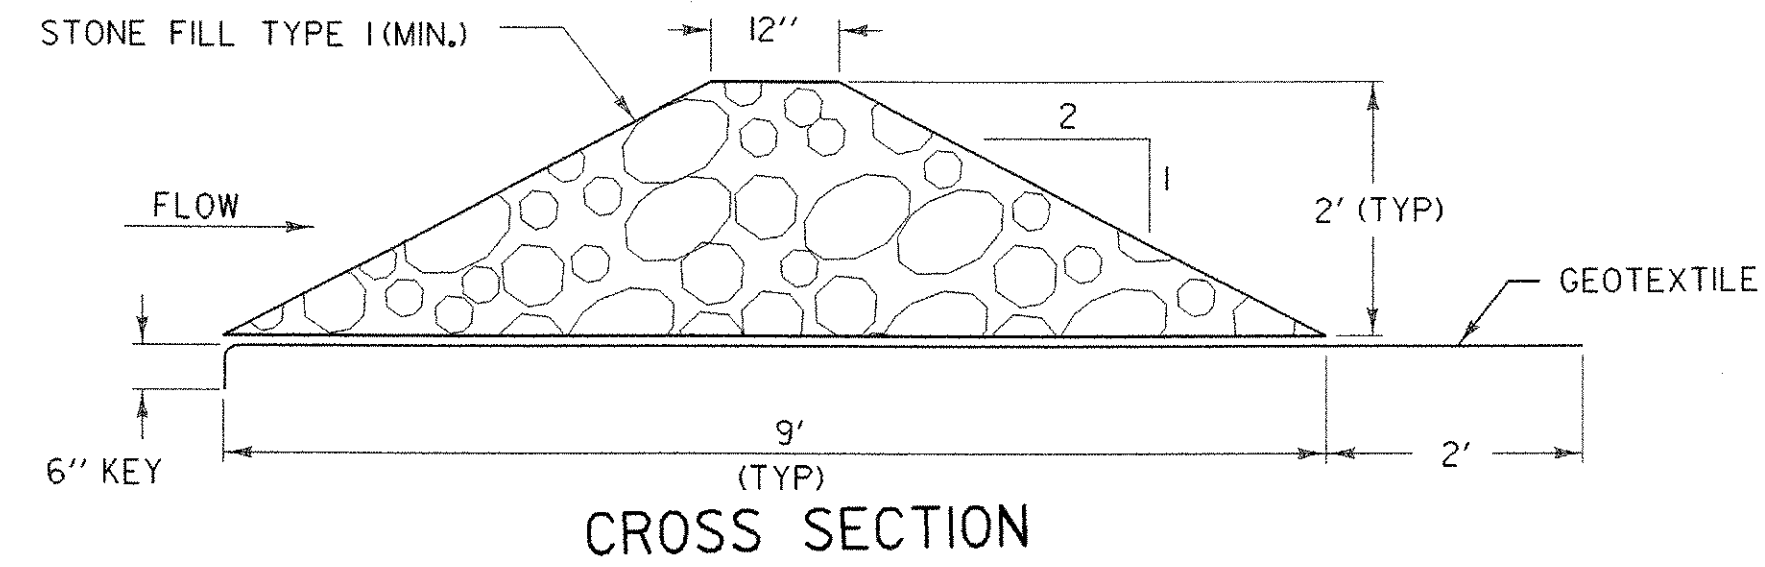

CHECK DAM - TEMPORARY (STONE)

CHECK DAMS


GENERAL NOTES:

1. GEOTEXTILE SHALL BE INSTALLED UNDER STONE FILL. IT SHALL BE KEYED IN ON THE UP HILL END AND SHALL EXTEND 2 FEET BEYOND THE STONE ON THE DOWN HILL END.
2. CORE MATERIAL FOR THE STONE CHECK DAM SHALL MEET THE GRADATION REQUIREMENTS OF STONE FILL TYPE 1 (MIN.). STONE SIZE SHOULD BE INCREASED WITH INCREASED SLOPE AND VELOCITY.
3. THE UPHILL END OF THE APRON FOR THE PREFABRICATED CHECK DAM SHALL BE STAPLED AND BURIED AS SHOWN IN DETAIL "A" OR AS RECOMMENDED BY THE MANUFACTURERS LITERATURE.
4. MEASURES SHALL BE INSPECTED EVERY SEVEN (7) CALENDAR DAYS AND WITHIN 24 HOURS OF A STORM EVENT GREAT ENOUGH TO CAUSE WATER TO LEAVE THE CONSTRUCTION SITE.
5. MEASURES SHALL BE CLEANED AND REPAIRED AS NEEDED. SEDIMENT SHALL BE REMOVED WHEN ACCUMULATION REACHES ONE-HALF OF THE MEASURE HEIGHT. SEDIMENT SHALL BE DISPOSED OF AS UNSUITABLE MATERIAL.
6. AT TIME OF REMOVAL OF THE CHECK DAMS, THE DISTURBED AREA SHALL BE REPAIRED AND STABILIZED.
7. PAYMENT FOR INSTALLATION AND REMOVAL OF CHECK DAMS SHALL BE MADE UNDER APPLICABLE ITEMS INCLUDED IN THE CONTRACT PLANS.
8. PAYMENT FOR MONITORING CHECK DAMS SHALL BE MADE UNDER THE MONITORING EROSION PREVENTION & SEDIMENT CONTROL PLAN ITEM.
9. PAYMENT FOR MAINTAINING CHECK DAMS SHALL BE MADE UNDER THE FIELD MAINTENANCE OF EROSION PREVENTION & SEDIMENT CONTROL PLAN ITEM, UNLESS IN THE OPINION OF THE RESIDENT ENGINEER MAINTENANCE IS REQUIRED DUE TO POOR INSTALLATION PRACTICES WHEREAS IT WILL BE REPAIRED AT THE CONTRACTORS SOLE EXPENSE.


| STONE CHECK DAM PLACEMENT INTERVAL | |
|------------------------------------|-----------------------|
| DITCH SLOPE | PLACEMENT INTERVAL ** |
| 1 % | 200 FT |
| 2 % | 100 FT |
| 3 % | 65 FT |
| 4 % | 50 FT |
| 5 % | 40 FT |
| 6 % | 30 FT |
| 8 % | 25 FT |
| 10 % | 20 FT |

** BASED ON 2' TYPICAL HEIGHT

| | |
|--|-------------------------|
| PROJECT NAME: | BOLTON - SO. BURLINGTON |
| PROJECT NUMBER: | AC IM 089-2(36) |
| FILE NAME: | I8800F4ECP04.dgn |
| PROJECT LEADER: | EPD |
| DESIGNED BY: | JDA |
| INLET PROTECTION AND CHECK DAM DETAILS | SHEET 44 OF 76 |
| PLOT DATE: | 17-MAY-2005 |
| DRAWN BY: | JDA |
| CHECKED BY: | EPD |

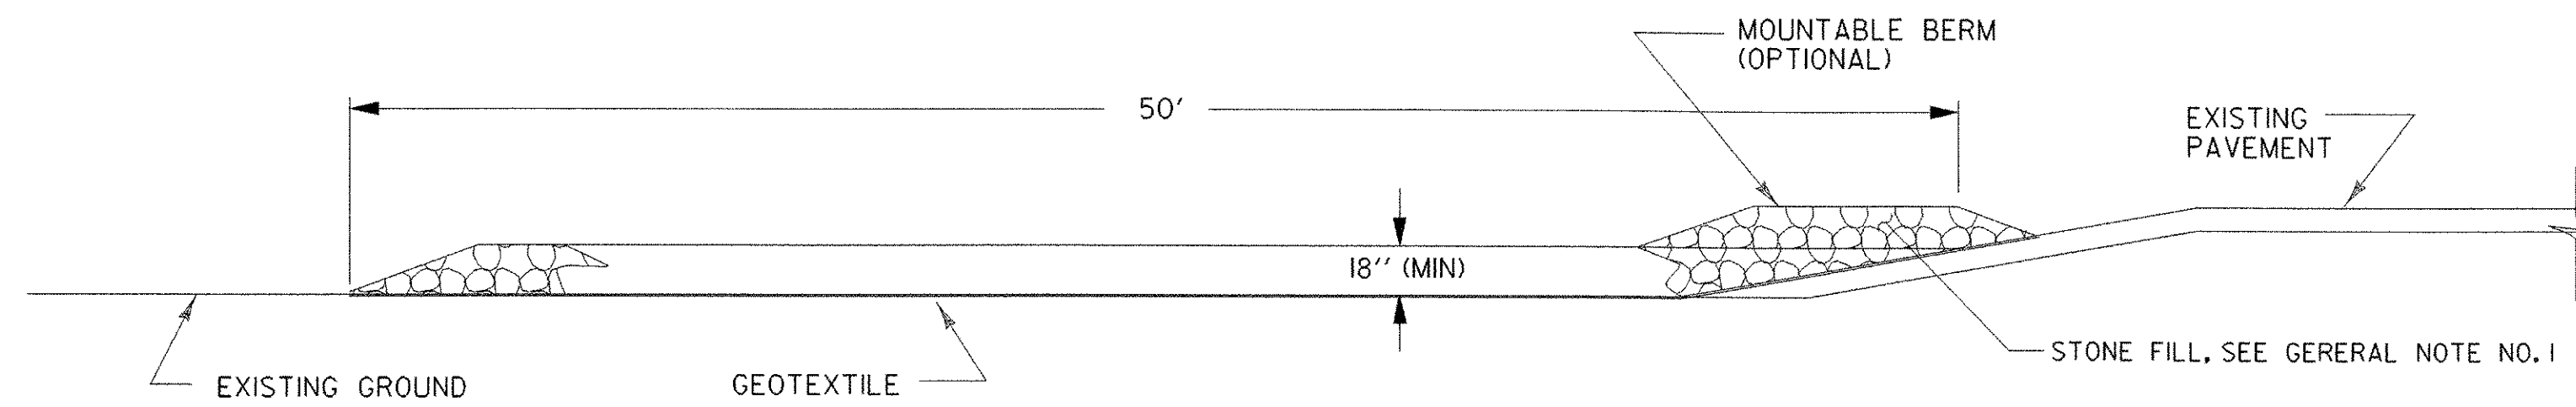

**TYPICAL CONSTRUCTION ENTRANCE PROFILE
(CUT AND DITCH SECTIONS)**

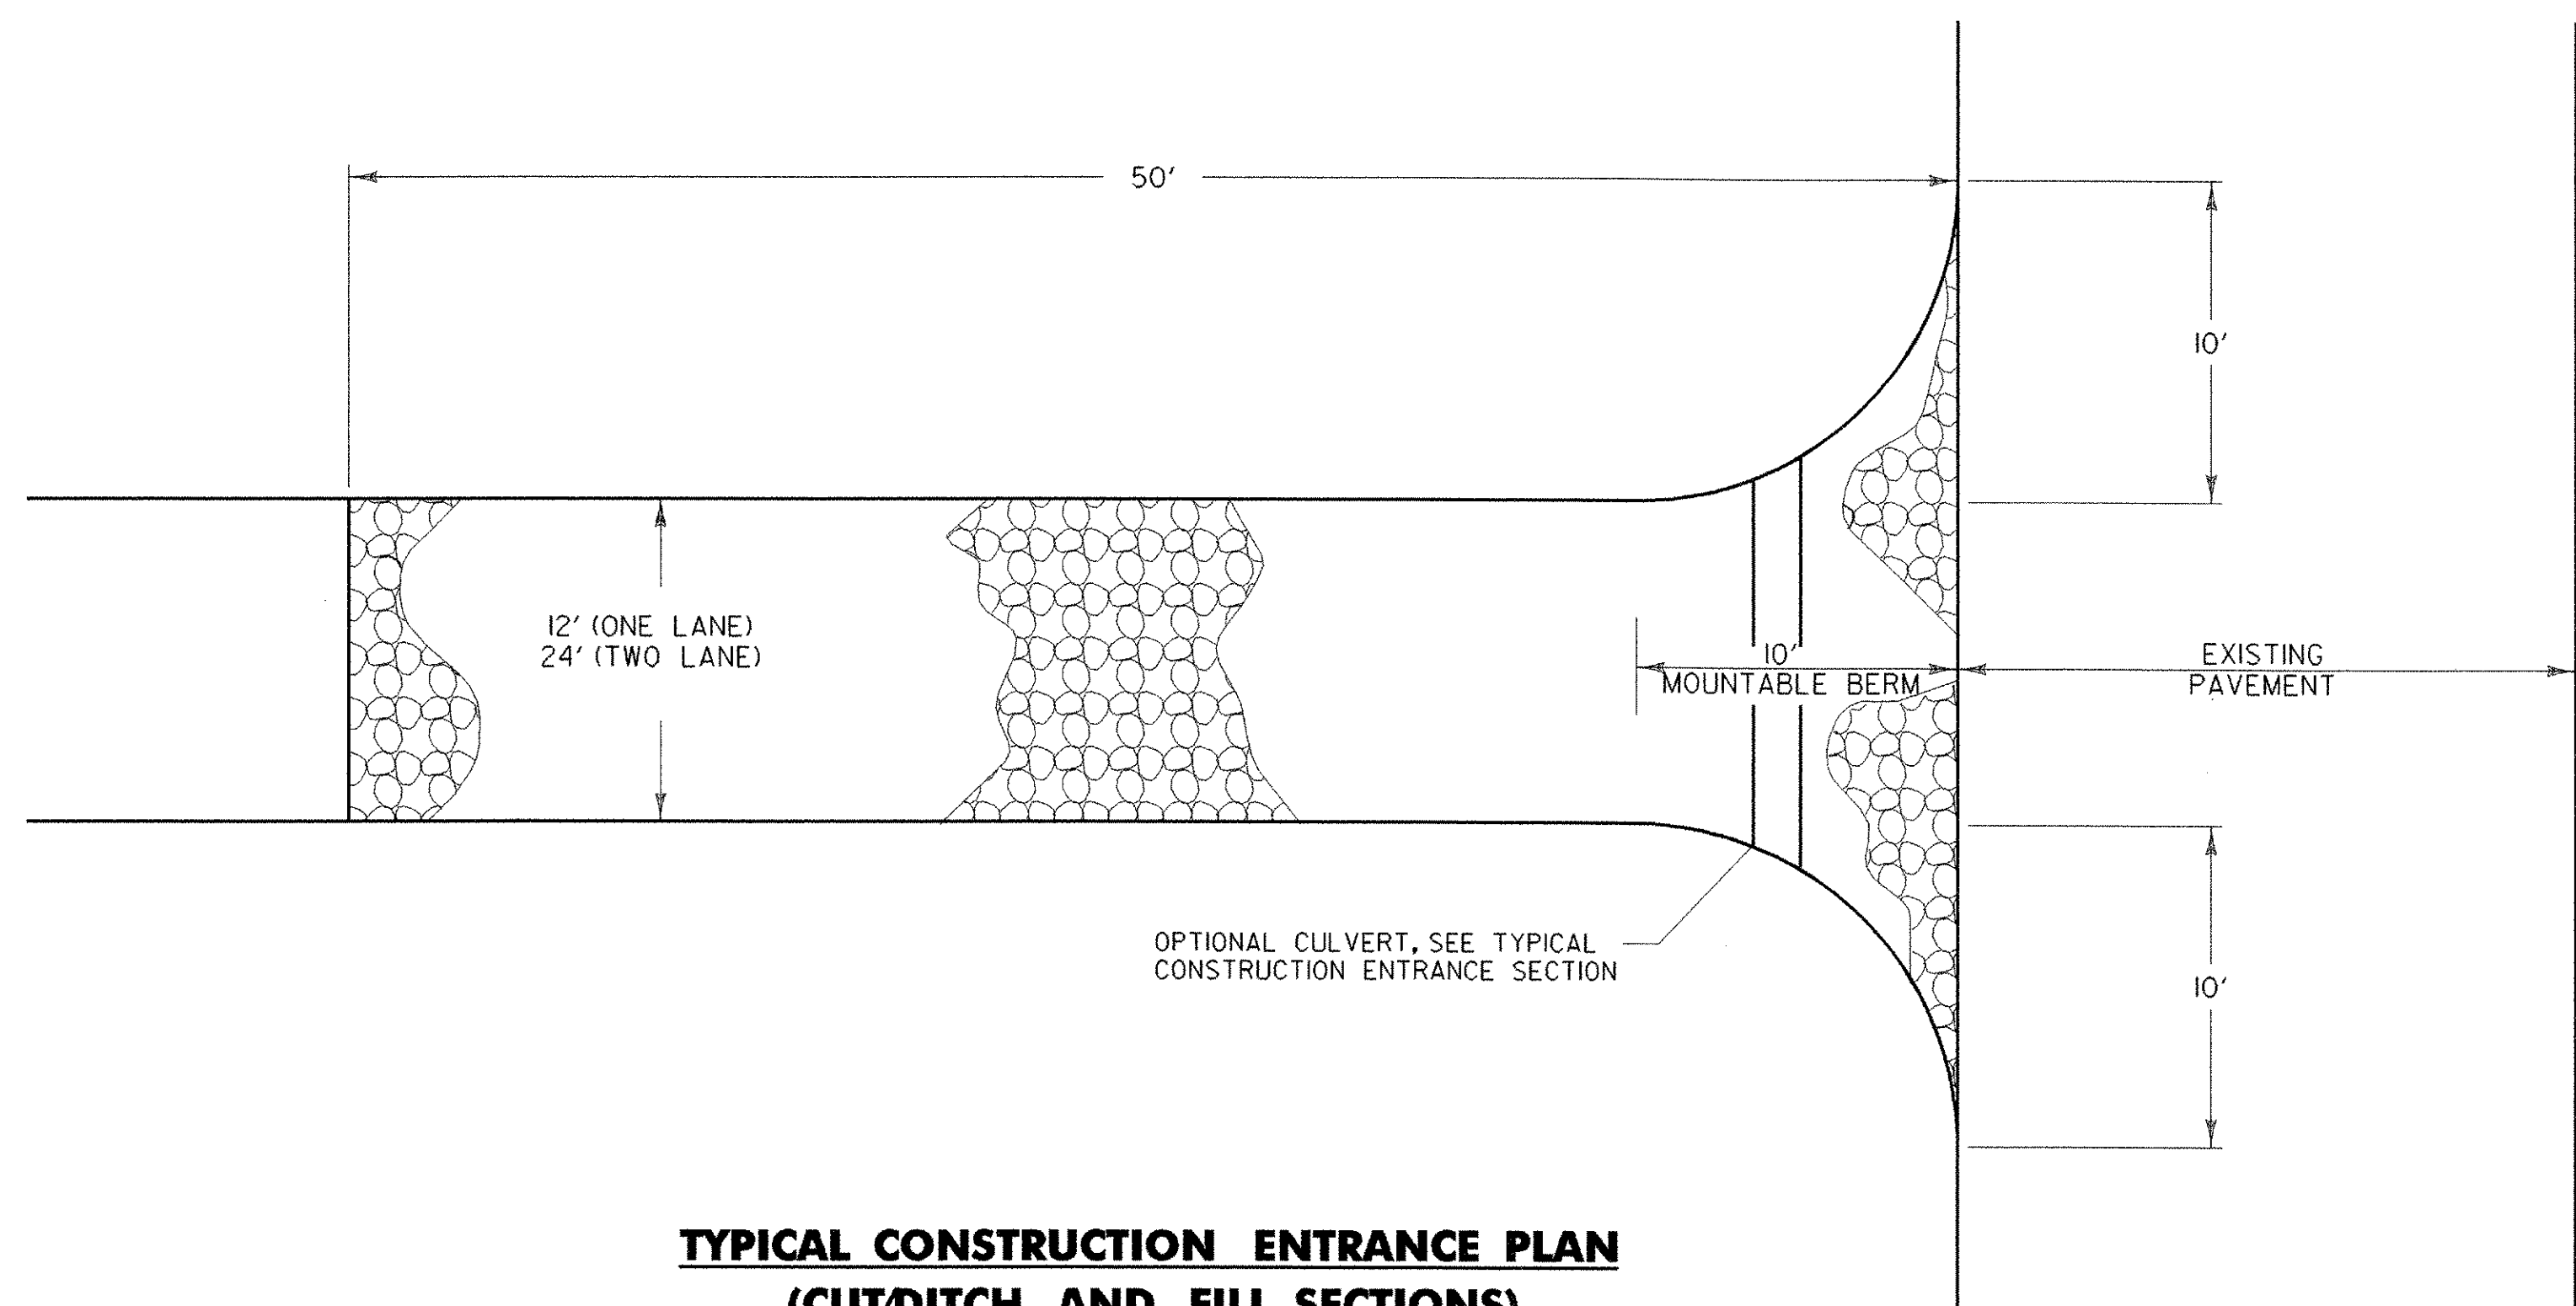

**TYPICAL CONSTRUCTION ENTRANCE PLAN
(CUT/DITCH AND FILL SECTIONS)**


STABILIZED CONSTRUCTION ENTRANCE

APPLICATION NOTES:

A. THE PURPOSE OF A STABILIZED CONSTRUCTION ENTRANCE IS TO REDUCE OR ELIMINATE THE TRACKING OF SEDIMENT ONTO PUBLIC RIGHTS OF WAY OR STREETS.

GENERAL NOTES:


1. STONE SIZE - USE CLEAN STONE WITH GRADATION BETWEEN 2 INCHES AND 4 INCHES.
2. LENGTH - 50 FEET (MIN)
3. THICKNESS - 18 INCHES (MIN)
4. WIDTH - 12 FEET (MIN)
5. GEOTEXTILE UNDER STONE WILL BE PLACED OVER THE ENTIRE AREA PRIOR TO PLACING OF STONE.
6. SURFACE WATER - ALL SURFACE WATER FLOWING OR DIVERTED TOWARD CONSTRUCTION ENTRANCES SHALL BE PIPED ACROSS THE ENTRANCE AS DIRECTED BY THE ENGINEER AND ON-SITE COORDINATOR. IF PIPING IS IMPRACTICAL, A MOUNTABLE BERM WITH 5:1 SLOPES WILL BE PERMITTED.
7. PROPOSED DRAINAGE PIPES SHALL BE SIZED WITH SUFFICIENT CAPACITY TO CARRY DITCH FLOWS. ALTERNATIVE WAYS OF TRANSPORTING DITCH DRAINAGE ACROSS CONSTRUCTION ENTRANCES MAY BE PROPOSED BY THE CONTRACTOR FOR APPROVAL BY THE ENGINEER AND ON-SITE COORDINATOR.
8. WHEN WASHING OF VEHICLE IS NECESSARY, IT SHALL BE DONE ON AN AREA STABILIZED WITH STONE WHICH DRAINS INTO AN APPROVED SEDIMENT TRAPPING DEVICE.
9. MEASURES SHALL BE INSPECTED EVERY SEVEN (7) CALENDAR DAYS AND WITHIN 24 HOURS OF A STORM EVENT GREAT ENOUGH TO CAUSE WATER TO LEAVE THE CONSTRUCTION SITE.
10. MAINTENANCE - THE ENTRANCE SHALL BE MAINTAINED IN A CONDITION WHICH WILL PREVENT TRACKING OR FLOWING OF SEDIMENT ONTO PUBLIC RIGHTS-OF-WAY. ALL SEDIMENT SPILLED, DROPPED, WASHED, OR TRACKED ONTO PUBLIC RIGHTS-OF-WAY MUST BE REMOVED IMMEDIATELY.
11. AT THE TIME OF REMOVAL OF THE STABILIZED CONSTRUCTION ENTRANCE THE DISTURBED AREA SHALL BE REPAIRED AND STABILIZED.
12. PAYMENT FOR CONSTRUCTING THE STABILIZED CONSTRUCTION ENTRANCE SHALL BE MADE UNDER ITEM 652.30, "FIELD MAINTENANCE OF EROSION PREVENTION & SEDIMENT CONTROL PLAN".
13. PAYMENT FOR MONITORING STABILIZED CONSTRUCTION ENTRANCES SHALL BE MADE UNDER THE MONITORING EROSION PREVENTION & SEDIMENT CONTROL PLAN ITEM.
14. PAYMENT FOR MAINTAINING THE CONSTRUCTION ENTRANCE SHALL BE MADE UNDER THE FIELD MAINTENANCE OF EROSION PREVENTION & SEDIMENT CONTROL PLAN ITEM, UNLESS MAINTENANCE IS REQUIRED DUE TO POOR INSTALLATION PRACTICES.

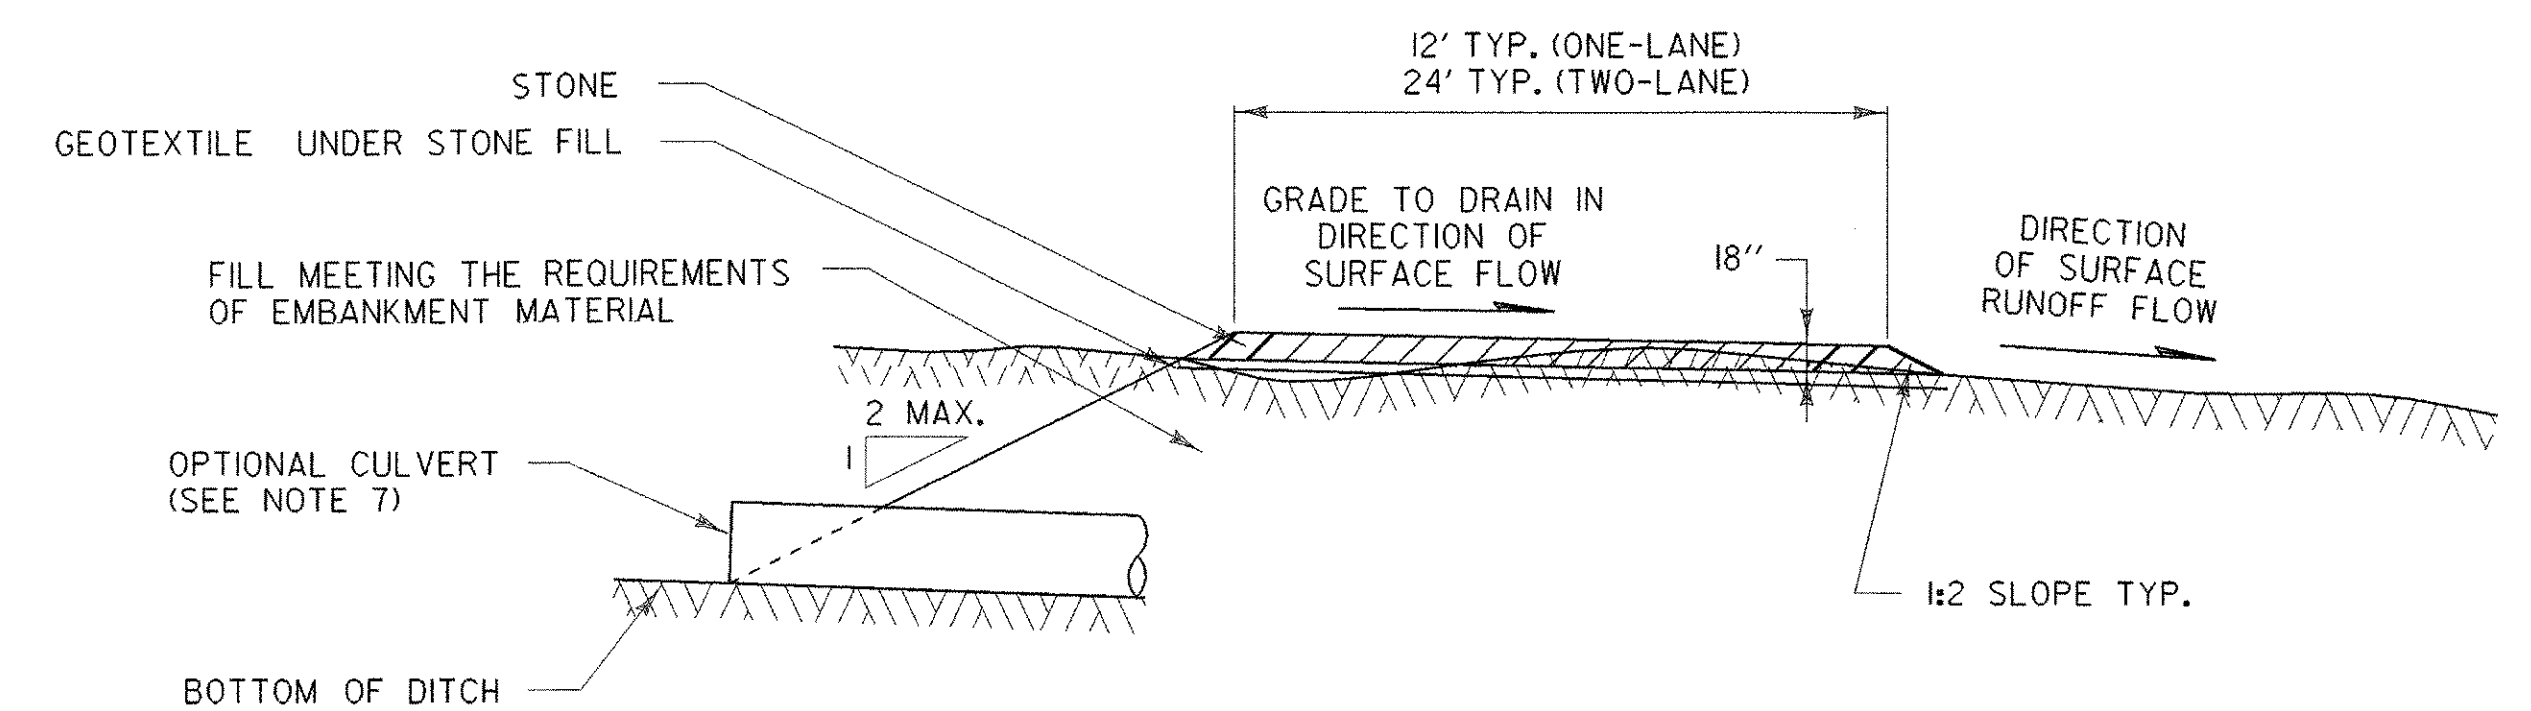

TYPICAL CONSTRUCTION ENTRANCE SECTION

| | |
|---------------------------------------|------------------------|
| PROJECT NAME: BOLTON - SO. BURLINGTON | PLOT DATE: 17-MAY-2005 |
| PROJECT NUMBER: AC IM 089-2(36) | DRAWN BY: JDA |
| FILE NAME: I8800F4ECP05.dgn | CHECKED BY: EPD |
| PROJECT LEADER: EPD | DESIGNED BY: JDA |
| CONSTRUCTION ENTRANCE DETAIL | SHEET 45 OF 76 |

STATE OF VERMONT AGENCY OF TRANSPORTATION

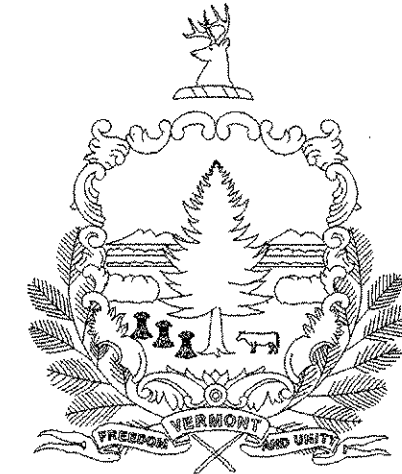



PROPOSED IMPROVEMENT TOWN OF WILLISTON COUNTY OF CHITTENDEN INTERSTATE ROUTE 89 SB EXIT 12

BEGINNING IN THE TOWN OF WILLISTON ON INTERSTATE I-89 IN THE SOUTHBOUND BARREL
AT STATION 4453+62, MM 84.349, (STA. 0+00.00 ON THESE PLANS) AND EXTENDING SOUTHEASTERLY
A DISTANCE OF 2,143 FEET (0.406 MILE) DOWN THE EXIT 12 SOUTHBOUND OFF-RAMP.

PROJECT DATA

LENGTH OF ROADWAY = 2,143 FEET (0.406 MILE)
LENGTH OF PROJECT = 2,143 FEET (0.406 MILE)

WORK TO BE PERFORMED UNDER THIS PROJECT INCLUDES COLD PLANING, LENGTHENING, WIDENING, &
RESURFACING OF THE EXISTING SOUTHBOUND INTERCHANGE OFF-RAMP WITH NEW PAVEMENT MARKINGS,
GUARDRAIL, SIGNS AND INCIDENTAL ITEMS AS SHOWN IN THE PROJECT QUANTITIES.

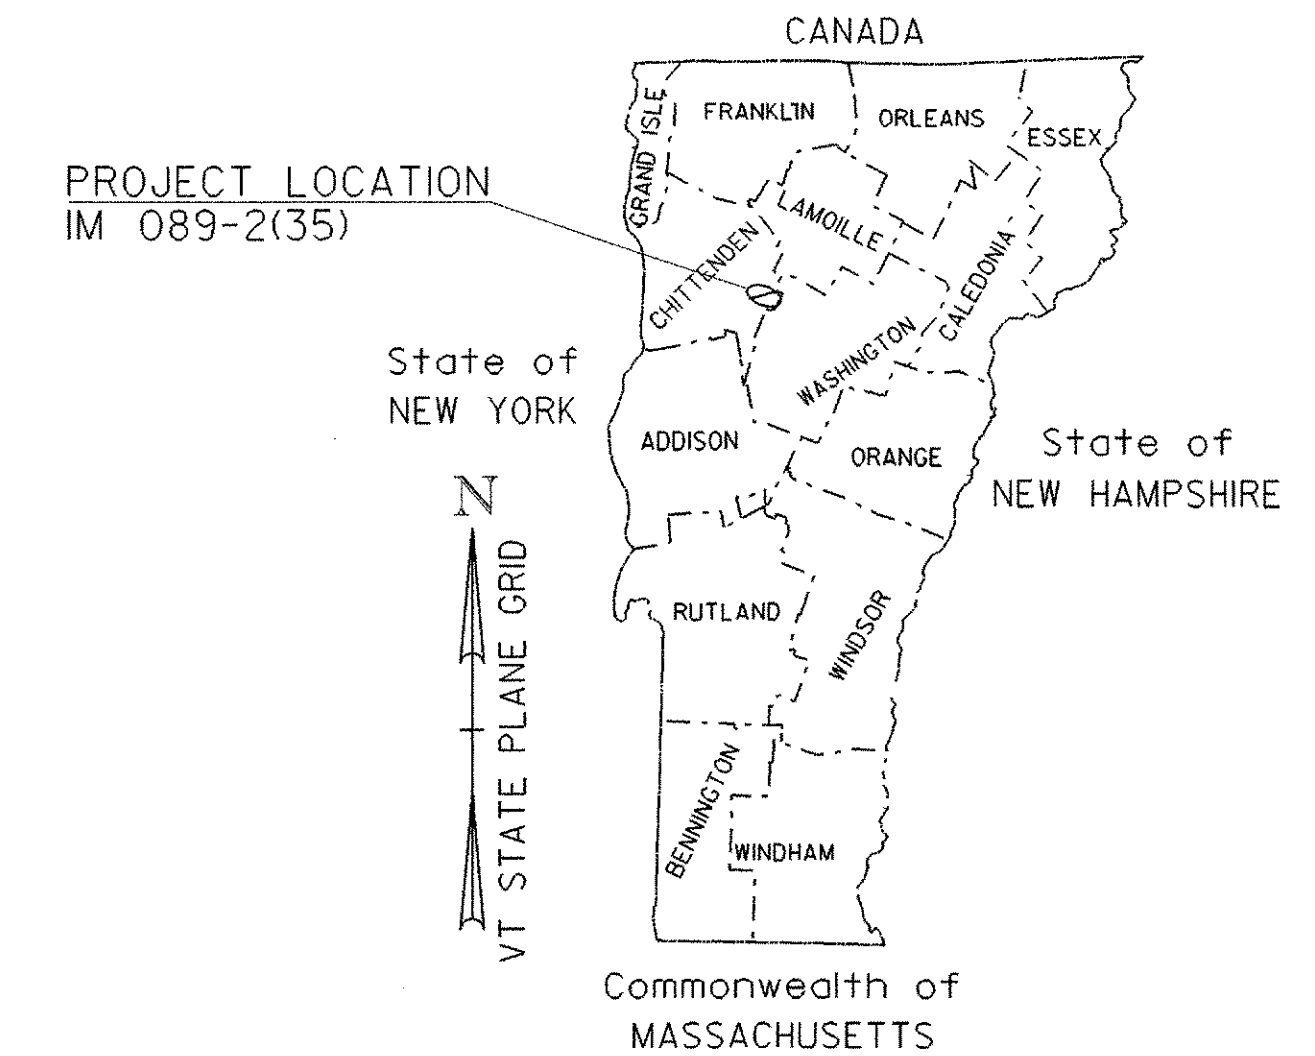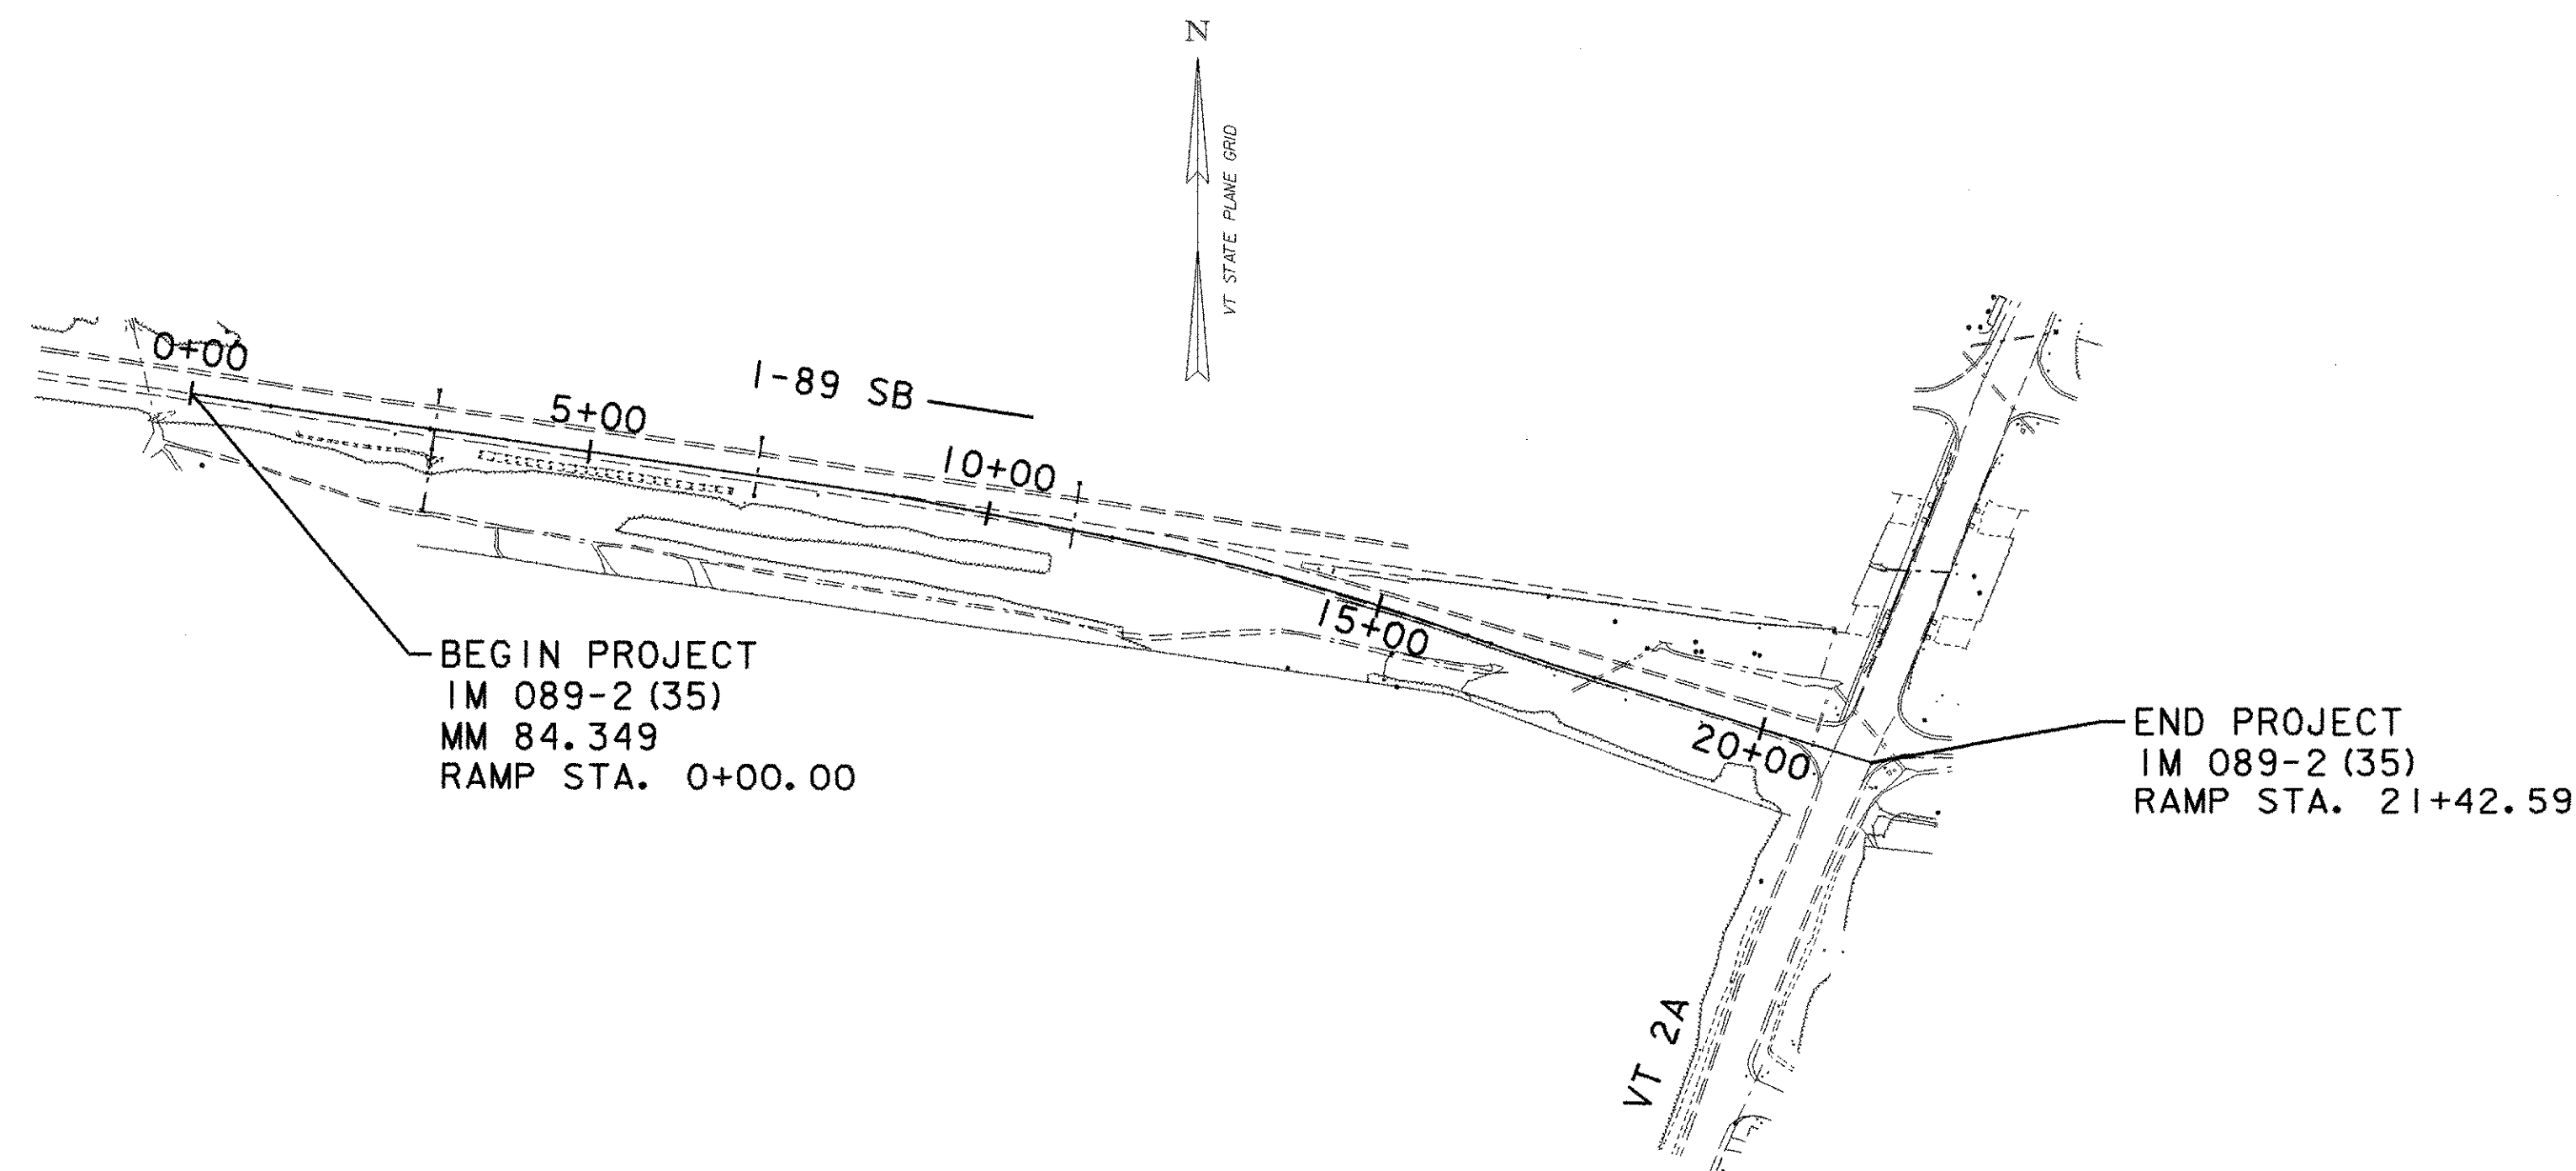

TRAFFIC DATA

EXIT # 12 SB RAMP

| | | | |
|------|-----|---|--------|
| 2005 | ADT | = | 10,000 |
| 2005 | DHV | = | 1,100 |
| 2015 | ADT | = | 12,200 |
| 2015 | DHV | = | 1,300 |

| BITUMINOUS CONCRETE PAVEMENT SUPERPAVE MIXTURE DESIGN CRITERIA | |
|---|------------|
| DESIGN LANE/DESIGN LIFE ESAL | 21,577,000 |
| DESIGN NUMBER OF GYRATIONS | 100 |
| PERFORMANCE GRADED ASPHALT BINDER | PG 64-28 |

RIGHT-OF-WAY LIMITS, IF APPLICABLE, ARE PROVIDED SOLELY FOR THE CONVENIENCE OF THE STATE AND ITS CONTRACTOR DURING THE COURSE OF THIS PAVING PROJECT. ANY REFERENCES TO OFFSETS ON THESE PLANS ARE APPROXIMATE AND SHOULD NOT BE RELIED UPON FOR ANY OTHER PURPOSES.

THESE PLANS ARE SUBJECT TO SUCH ENGINEERING CHANGES AS MAY BE REQUIRED BY THE FEDERAL HIGHWAY ADMINISTRATION OR THE DIRECTOR OF PROGRAM DEVELOPMENT.

CONSTRUCTION IS TO BE CARRIED ON IN ACCORDANCE WITH THESE PLANS AND THE STANDARD SPECIFICATIONS FOR CONSTRUCTION DATED 2001, AS APPROVED BY THE FEDERAL HIGHWAY ADMINISTRATION ON JANUARY 4, 2001 FOR USE ON THIS PROJECT, INCLUDING ALL SUBSEQUENT REVISIONS AND SUCH REVISED SPECIFICATIONS AND SPECIAL PROVISIONS AS ARE INCORPORATED IN THESE PLANS.

| INDEX OF SHEETS | |
|-----------------|--|
| 46 | TITLE SHEET |
| 47 | TYPICAL SECTION SHEET |
| 48-49 | QUANTITY SHEETS |
| 50 | SIGN SUMMARY SHEET |
| 51 | SIGN SUMMARY AND DETAIL SHEET |
| 52 | TIE SHEET |
| 53 | LAYOUT SHEET |
| 54 | SIGNS & PAVEMENT MARKINGS SHEET |
| 55 | TRAFFIC SIGNAL PLAN SHEET |
| 56 | SIGN ACTUATION NOTES AND DETAILS |
| | |
| 57 | EROSION CONTROL NARRATIVE |
| 58 | EROSION CONTROL EXISTING CONDITIONS |
| 59 | EROSION AND SEDIMENT CONTROL PLAN |
| 60 | EROSION CONTROL FINAL CONDITIONS |
| 61 | SILT FENCE DETAILS |
| 62 | CHECK DAM & CATCH BASIN PROTECTION DETAILS |
| 63 | EROSION MATTING DETAILS |
| 64 | CONSTRUCTION ENTRANCE DETAILS |
| 65 | CONCRETE PAD DETAILS |
| 66 | SIGN BRIDGE DETAILS |
| 67 | SIGN BRIDGE NOTES |
| 68 | TRAFFIC CONTROL SHEET |
| 69-76 | CROSS SECTION SHEETS |


STANDARDS

| | | |
|--------|---|----------|
| B-5 | SLOPE GRADING, EMBANKMENTS, MUCK | 06/01/94 |
| D-2 | C. R. M. HEADWALLS, UNDERDRAIN | 06/01/94 |
| D-20 | HIGHWAY CROSSING FOR UNDERGROUND UTILITIES | 03/03/03 |
| E-100 | CONSTRUCTION APPROACH SIGNS | 01/02/04 |
| E-101 | CONSTRUCTION SIGN DETAILS | 05/30/03 |
| E-102 | CONSTRUCTION SIGN DETAILS | 06/30/03 |
| E-102A | CONSTRUCTION SIGN DETAILS | 05/01/04 |
| E-103 | MAINLINE TRAFFIC CONTROL DIVIDED HIGHWAY ONE LANE CLOSED | 03/01/04 |
| E-105 | TRAFFIC CONTROL FOR CONSTRUCTION VEHICLE U-TURNS ON DIVIDED HIGHWAY | 05/01/04 |
| E-106 | TRAFFIC CONTROL - MISCELLANEOUS DETAILS | 03/01/04 |
| E-107A | BREAKAWAY BARRICADE DETAILS | 08/08/95 |
| E-108 | CONSTRUCTION ZONE LONGITUDINAL DROP-OFFS | 08/18/95 |
| E-110 | MAJOR MAINTENANCE OPERATION LANE CLOSURE | 08/08/95 |
| E-112 | TRAFFIC CONTROL FOR TYPICAL MOVING MAINTENANCE OPERATIONS | 01/23/97 |
| E-119 | UTILITY WORK ZONE | 03/01/04 |
| E-120 | STANDARD SIGN PLACEMENT - EXPRESSWAY & FREEWAY | 08/08/95 |
| E-121 | STANDARD SIGN PLACEMENT - CONVENTIONAL ROAD | 08/08/95 |
| E-123 | GUIDE SIGN PLACEMENT MISCELLANEOUS DETAILS | 03/16/04 |
| E-136A | U. S. ROUTE MARKER SIGN DETAILS | 08/08/95 |
| E-136B | STATE ROUTE MARKER SIGN DETAILS | 08/08/95 |
| E-142 | REGULATORY SIGN DETAILS | 09/20/95 |
| E-143 | REGULATORY SIGN DETAILS | 06/15/04 |
| E-150 | WARNING SIGN DETAILS | 05/01/04 |
| E-153 | WARNING SIGN DETAILS | 05/01/04 |
| E-160 | FLANGED CHANNEL STEEL SIGN POST DETAIL | 05/20/99 |
| E-163 | TUBULAR STEEL SIGN POST | 05/20/99 |
| E-164 | SQUARE STEEL SIGN POST | 05/20/99 |
| E-171A | TRAFFIC CONTROL SIGNALS GENERAL NOTES&DETAILS | 08/09/95 |
| E-171B | TRAFFIC CONTROL SIGNALS MISC. DETAILS | 08/09/95 |
| E-172 | VEHICLE DETECTOR LOOP DETAILS | 08/09/95 |
| E-191 | PAVEMENT MARKING DETAILS | 02/01/99 |
| E-192 | PAVEMENT MARKING DETAILS | 10/12/00 |
| E-193 | PAVEMENT MARKING DETAILS | 08/18/95 |
| E-197 | DELINEATOR PLACEMENT TYPICAL | 08/18/95 |
| E-198 | FREEWAY-EXPRESSWAY DELINEATORS AND MILEPOSTS | 04/14/97 |
| G-1 | STEEL BEAM GUARDRAIL WITH STEEL POSTS | 01/03/00 |
| G-1D | STEEL BEAM GUARDRAIL | 01/03/00 |
| G-19 | GENERIC GRADING PLANS FOR GUARDRAIL END TERMINALS | 11/15/02 |

PROJECT MANAGER : WOOLAVER

PROJECT NAME : WILLISTON
PROJECT NUMBER : IM 089-2(35)

SHEET 46 OF 76 SHEETS


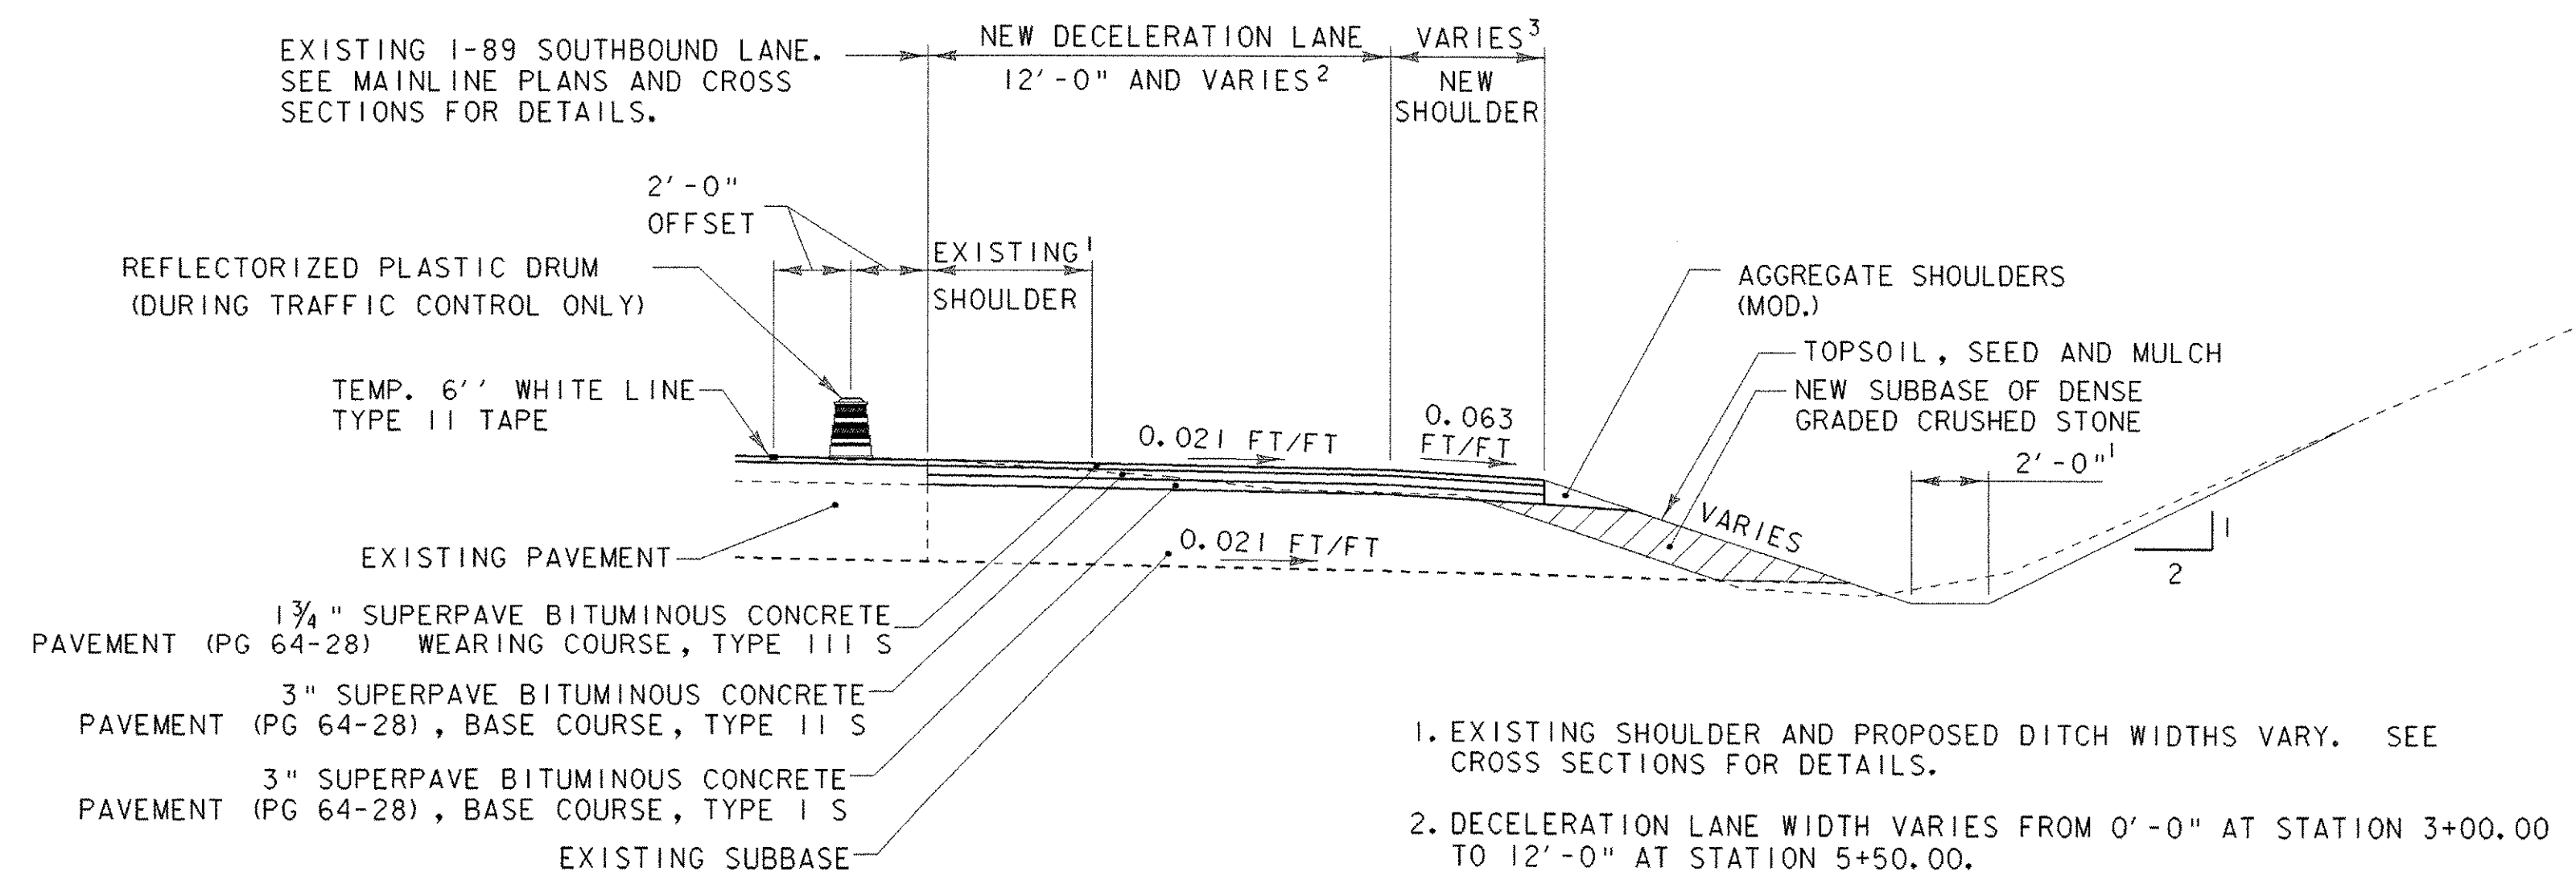


- EXISTING SHOULDER AND PROPOSED DITCH WIDTHS VARY. SEE CROSS SECTIONS FOR DETAILS.
- DECELERATION LANE WIDTH VARIES FROM 0'-0" AT STATION 3+00.00 TO 12'-0" AT STATION 5+50.00.
- SHOULDER VARIES FROM 2'-0" ON THE MAINLINE TO 4'-0" ON THE RAMP. SEE CROSS SECTIONS FOR DETAILS.
- EXCAVATE EXISTING SHOULDER 7 3/4". EXCAVATION TO BE PAID FOR UNDER ITEM 203.15, "COMMON EXCAVATION".

DECELERATION LANE TYPICAL SECTION

STA. 3+00.00 TO STA. 11+64.61

SCALE 1/4" = 1'-0"

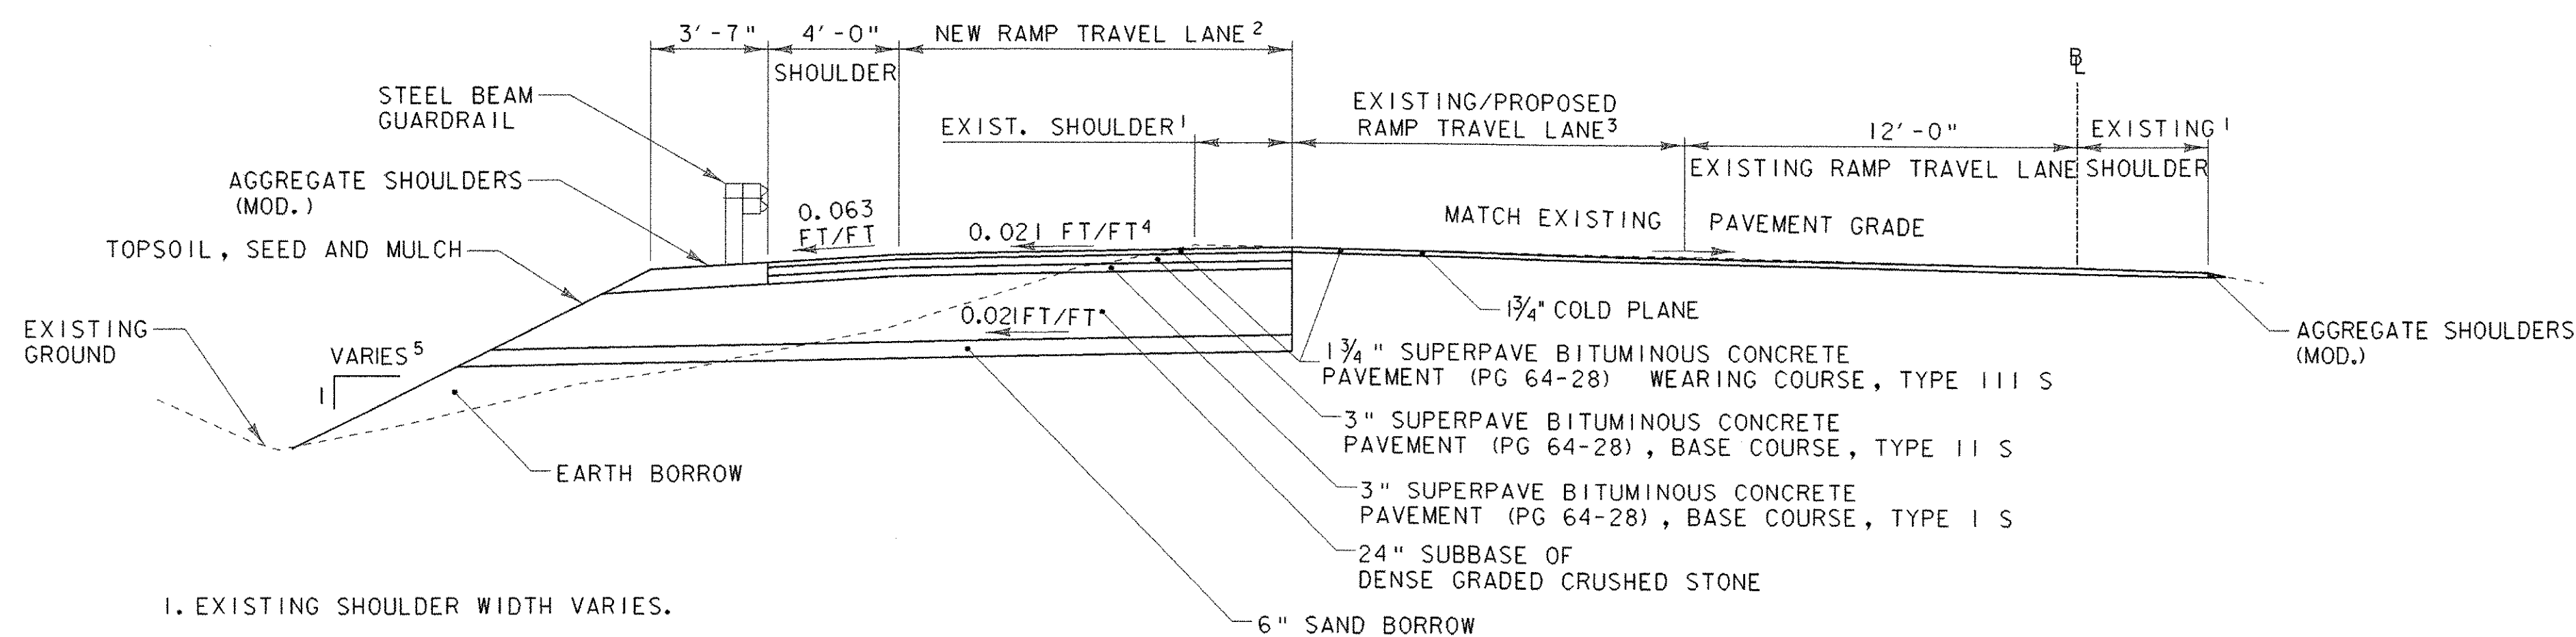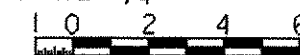

- EXISTING SHOULDER WIDTH VARIES.
- NEW RAMP TRAVEL LANE WIDTH VARIES FROM 0'-0" AT STATION 14+33.09 TO 12'-0" AT STATION 15+56.19.
- EXISTING RAMP TRAVEL LANE VARIES. PROPOSED RAMP TRAVEL LANE VARIES. SEE PLAN SHEETS AND CROSS SECTIONS FOR DETAILS.
- SLOPE OF NEW RAMP TRAVEL LANE VARIES IN THE GORE AREA. SEE CROSS SECTIONS FOR SLOPES AT THIS AREA.
- SLOPE VARIES. SEE CROSS SECTIONS FOR SLOPES.

RAMP WIDENING TYPICAL SECTION

STA. 11+64.61 TO STA. 21+42.59

SCALE 1/4" = 1'-0"



| MATERIAL ITEM | TOLERANCE |
|--------------------------|------------------------|
| PAVEMENT | ± 1/4" TOTAL THICKNESS |
| AGGREGATE SURFACE COURSE | ± 1/2" |
| BASE COURSE | ± 1/2" |
| SUBBASE | ± 1" |
| SAND BORROW | ± 1" |
| GRANULAR BORROW | ± 1" |

NOTES:

- THE CONTRACTOR SHALL SAW CUT THE PAVEMENT AT THE EDGE OF THE 1-89 SB SHOULDER PRIOR TO EXCAVATING. THE COST OF SAW CUTTING SHALL BE INCIDENTAL TO ITEM 203.15, "COMMON EXCAVATION".
- COLD PLANING SHALL BE COMPLETED ACCORDING TO TYPICAL OR AS DENOTED OTHERWISE ON THE PLANS. A FULL DEPTH BUTT JOINT SHALL BE CONSTRUCTED AT THE PROJECT END AND AT ALL RAMP APPROACHES AS SHOWN ON THE PROJECT PLANS OR AS OTHERWISE DIRECTED BY THE RESIDENT ENGINEER.
- PAVEMENT WIDENING SHALL BE CONSTRUCTED USING ONE 3" LIFT OF TYPE I S BASE COURSE, ONE 3" LIFT OF TYPE II S BASE COURSE AND ONE 1 3/4" LIFT OF TYPE III S WEARING COURSE. THE SECOND BASE COURSE SHALL BE PLACED TO MATCH THE ELEVATION OF THE ADJOINING SURFACE OF THE 1-89 SB TRAVEL LANE.
- SUPERPAVE BITUMINOUS CONCRETE PAVEMENT TOLERANCE = 1/4" +/- (TOTAL THICKNESS).
- EMULSIFIED ASPHALT SHALL BE APPLIED ON ALL EXISTING PAVEMENT SURFACES AND BETWEEN ALL COURSES OF PAVEMENT AT THE RATE OF 0.015 GAL/SY OR AS DIRECTED BY THE RESIDENT ENGINEER.
- ALL EXCAVATION ASSOCIATED WITH THE PAVEMENT WIDENING, INCLUDING REMOVAL OF EXISTING SHOULDER PAVEMENT, SHALL BE PAID FOR UNDER ITEM 203.15, "COMMON EXCAVATION".
- ALL EDGES OF PAVEMENT SHALL BE BACKED UP FULL HEIGHT WITH COLD PLANE GRINDINGS AS DIRECTED BY THE RESIDENT ENGINEER AND WILL BE PAID FOR UNDER ITEM 402.12, "AGGREGATE SHOULDERS (MOD.)".
- REFER TO STD. B-5 FOR CONSTRUCTING AN EMBANKMENT ON AN EARTH SLOPE.
- AN ESTIMATE FOR "FINE GRADING - SUBGRADE", ITEM 203.40, HAS BEEN INCLUDED IN THE QUANTITIES FOR WORK IN THE AREA OF WIDENING.

SEEDING FORMULA RURAL AREAS

| % WT. | LBS./A. | NAME | PUR % | GERM % |
|-------|---------|---------------------|-------|--------|
| 37.5 | 22.5 | CREeping RED FESCUE | 98 | 85 |
| 37.5 | 22.5 | TALL FESCUE | 95 | 90 |
| 5.0 | 3.0 | RED TOP | 98 | 90 |
| 15.0 | 9.0 | BIRDSFOOT TREFOLI | 98 | 85 |
| 5.0 | 3.0 | ANNUAL RYEGRASS | 95 | 85 |
| 100.0 | 60.0 | | | |

GENERAL NOTES

- SEED MIXTURE: SHALL NOT HAVE A WEED CONTENT EXCEEDING 0.40% BY WEIGHT AND SHALL BE FREE OF ALL NOXIOUS SEED.
- SEED: TO BE APPLIED PER SEEDING FORMULAS OR AS DIRECTED BY THE ENGINEER.
- FERTILIZER: FORMULA 10-20-10, TO BE USED WITH SEED, APPLIED AT THE RATE OF 500 LBS./ACRE. (HYDRO SEEDERS MAY USE 19-19-19 FORMULA).
- AGRICULTURAL LIMESTONE: TO BE APPLIED AT THE RATE OF 2 TONS/ACRE, OR AS DIRECTED BY THE ENGINEER.
- HAY MULCH: TO BE PLACED ON EARTH SLOPES AT THE RATE OF 2 TONS/ACRE, OR AS DIRECTED BY THE ENGINEER.
- TOPSOIL: TO BE USED WITH SEED AS INDICATED ON THE PLANS, OR AS DIRECTED BY THE ENGINEER.
- MARKER POSTS: TO BE PLACED AS INDICATED OR AS DIRECTED BY THE ENGINEER.
- SLOPE ROUNDING: ALL CUT SLOPES TO BE ROUNDED IN ACCORDANCE WITH STANDARD SHEET B - 5.
- PAY LIMITS OF SAND BORROW: WHEN USED IN CONJUNCTION WITH UNDERDRAIN - SEE STANDARD SHEET D - 2.

PROJECT NAME: 1-89 EXIT 12 SB OFF RAMP
PROJECT NUMBER: IM 089-2(35)

FILE NAME: I8800F4TY01.dgn PLOT DATE: 17-MAY-2005
PROJECT LEADER: EPD DRAWN BY: JDA / PGJ
DESIGNED BY: JDA CHECKED BY: EPD
TYPICAL SECTION SHEET SHEET 47 OF 76


TRAFFIC SIGN SUMMARY SHEET

REMOVE


| MILEMARKER, STATION, OR SIGN NUMBER | SIGN LEGEND | SIGN DIMENSIONS | | NEW & SALVAGED SIGNS | | | | EXIST POST | NO. OF POSTS | NEW SIGN POSTS | | | | | | | | | | | | | | | | | | | REMARKS | SIGN DETAIL | |
|-------------------------------------|-------------|-----------------|------------|----------------------|-----|-----|-----------|------------|--------------|----------------|-----------------|-------|-------|-------------------|-----|-----|-------------------------|-----|---------|----------------------|-----|-----|-----|---------------|--------|-----------|------------------------|-------------------|---------|-------------|-------|
| | | E A | WIDTH (in) | HEIGHT (in) | "A" | "B" | SALV SIGN | | | SALV TIS | FLANGED CHANNEL | | | SQUARE STEEL (in) | | | TUBULAR ALUMINUM Ø (in) | | | TUBULAR STEEL Ø (in) | | | | W-SHAPE STEEL | | | DETAIL ON SHEET NUMBER | STD. SHEET NUMBER | | | |
| | | | | | | | | | | | lb/ft | lb/ft | lb/ft | 1.75 | 2.0 | 2.5 | 3.0 | 4.0 | 4.0 MOD | 3.0 | 3.5 | 4.0 | 5.0 | FTG. SIZE | WEIGHT | POST SIZE | | | | | |
| STA. 20+67.38 LT | | 1 | 36 | 36 | 9.0 | | | 1 | 1 | 13-6 | | X | | | | | | | | | | | | | | | | R5-I | 1 | | E-143 |
| STA. 20+67.38 LT | | 2 | 36 | 12 | 6.0 | | | | | | | | | | | | | | | | | | | | | | | R6-IL, R6-IR | 2 | | E-142 |
| STA. 20+68.38 RT | | 1 | 36 | 36 | 9.0 | | | 1 | 1 | 12-6 | | X | | | | | | | | | | | | | | | | R5-I | 1 | | E-143 |
| STA. 20+68.38 RT | | 2 | 36 | 12 | 6.0 | | | | | | | | | | | | | | | | | | | | | | | R6-IL, R6-IR | 2 | | E-142 |
| TOTALS | | | | SF 30.0 | SF | EA. | SF | | | FT 20 | | FT 26 | | | EA. | LB | LB | LB | EA. | LB | EA. | EA. | LB | | | | | | | | |

ADVANCED EXIT 12 TYPE B SIGN NOTES

- THE PROPOSED LOCATION FOR THE TYPE B ADVANCE SIGN FOR EXIT 12 IS LOCATED AT MAINLINE STATION 4455+62 (M.M. 84.39), 500 FEET BEFORE THE BEGINNING OF THE DECELERATION LANE TAPER. ACTUAL FIELD PLACEMENT MAY VARY SLIGHTLY DUE TO FIELD CONDITIONS. VARIATION IN PLACEMENT MUST BE APPROVED BY THE RESIDENT ENGINEER.
- EXISTING "EXIT 12" AND TYPE B SIGN AND POSTS AT STA. 6+99.01 TO BE RELOCATED TO THE PROPOSED LOCATION. A NEW "VT ROUTE 2A" SHIELD WILL BE ATTACHED AT THE SAME LOCATION AS THE EXISTING VT ROUTE 2A SHIELD. EXISTING SERVICE SYMBOLS MOUNTED UNDER THE GUIDE SIGN SHALL BE REMOVED.
- PAYMENT FOR NEW FOUNDATIONS FOR THIS SIGN TO BE PAID FOR UNDER 675.41, "FOUNDATION FOR W-SHAPE STEEL POSTS, 24" DIAMETER". PLACEMENT OF THE NEW SHIELD WILL BE PAID FOR UNDER ITEM 675.20, "TRAFFIC SIGNS, TYPE A".

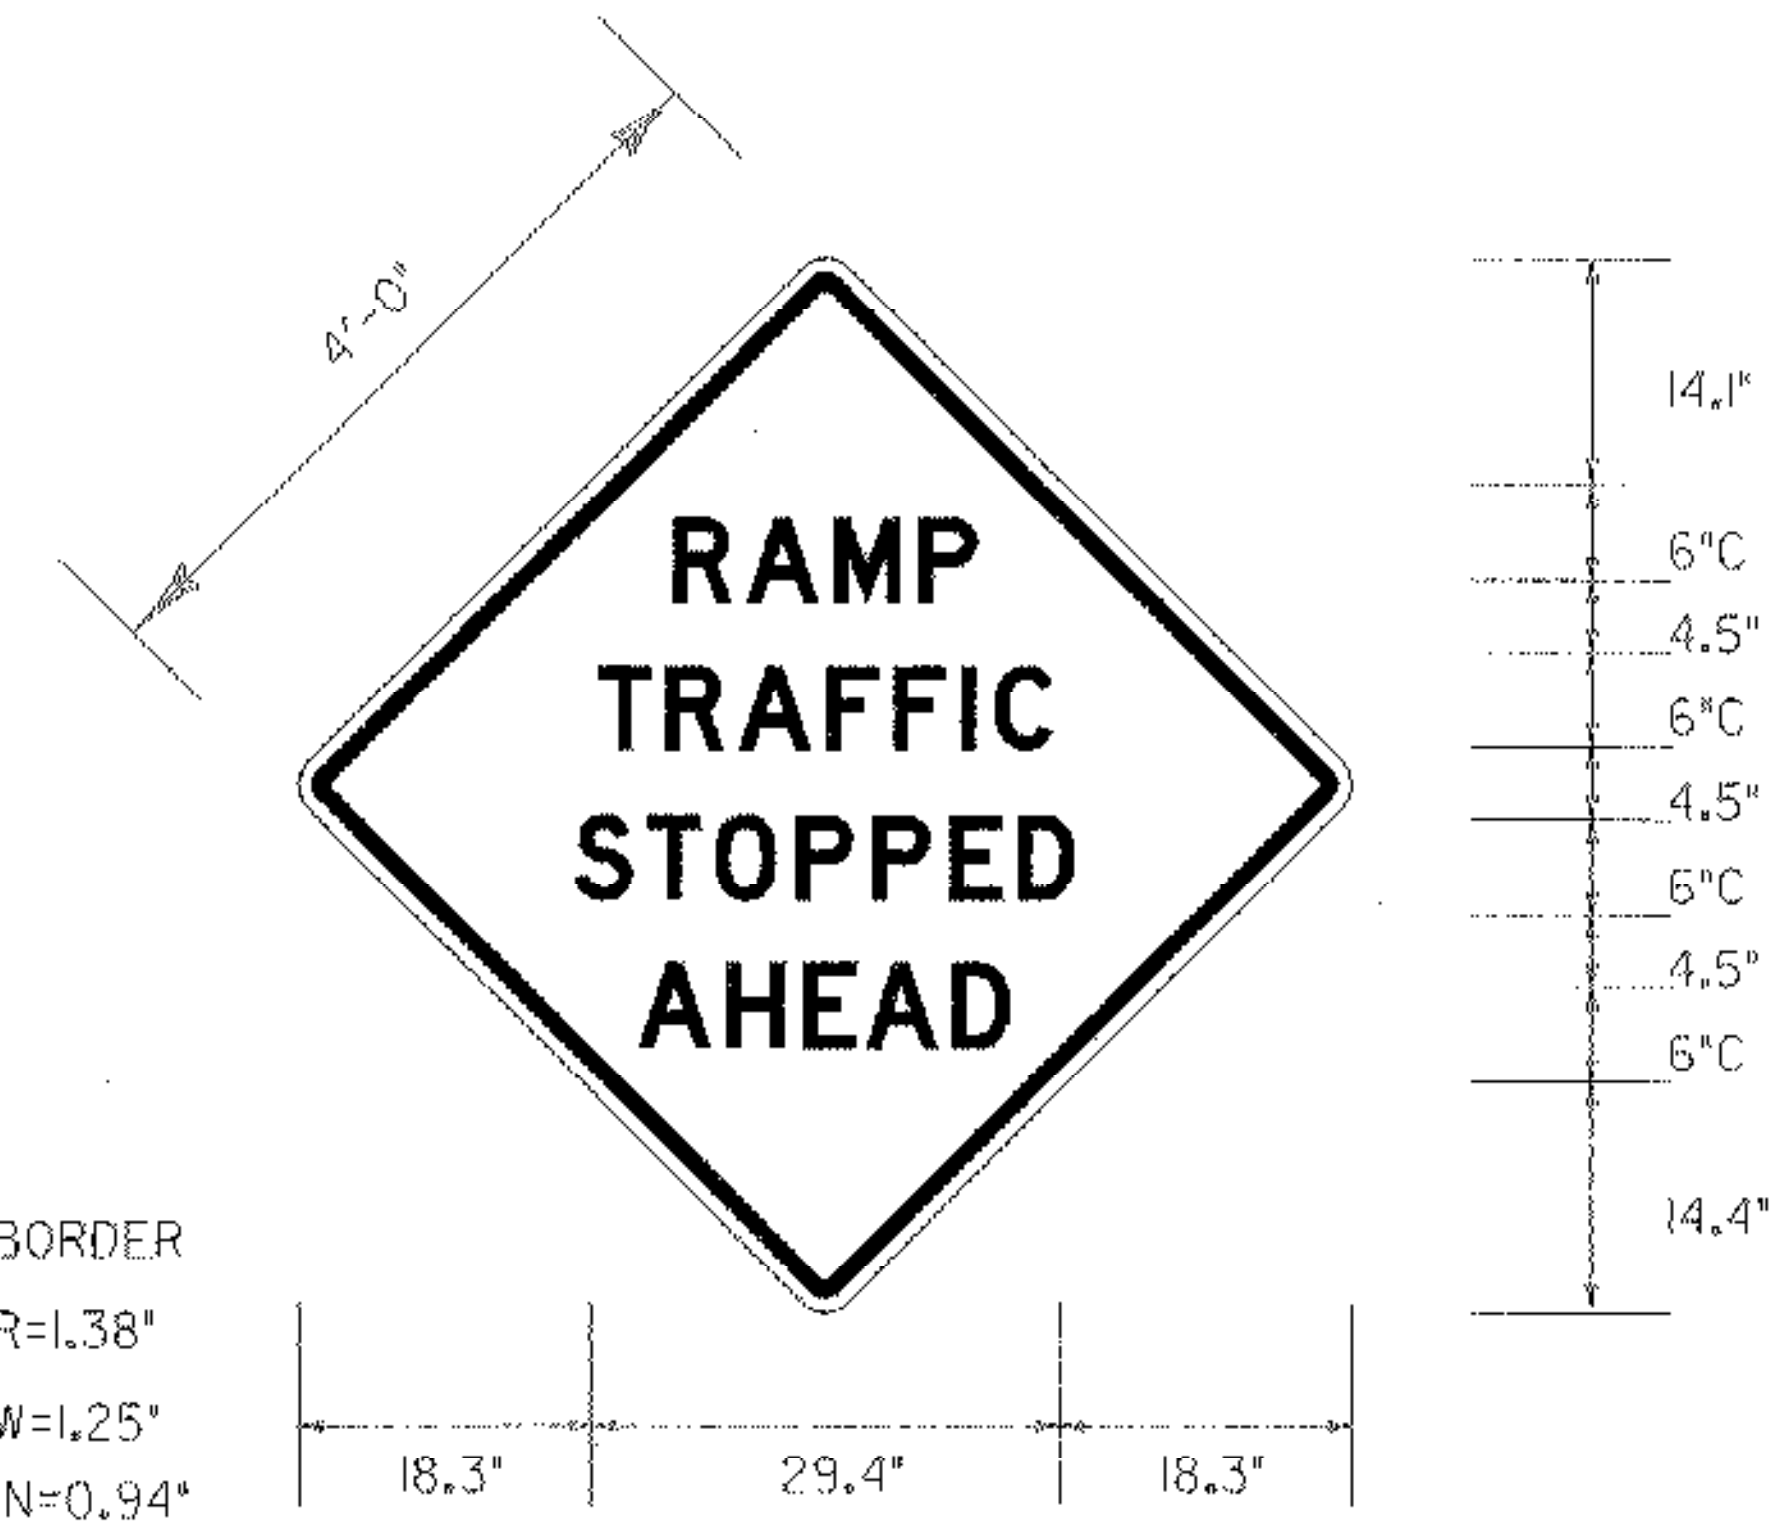

REPLACE EXISTING SHIELD WITH NEW VT ROUTE 2A SHIELD, AS SHOWN BELOW.

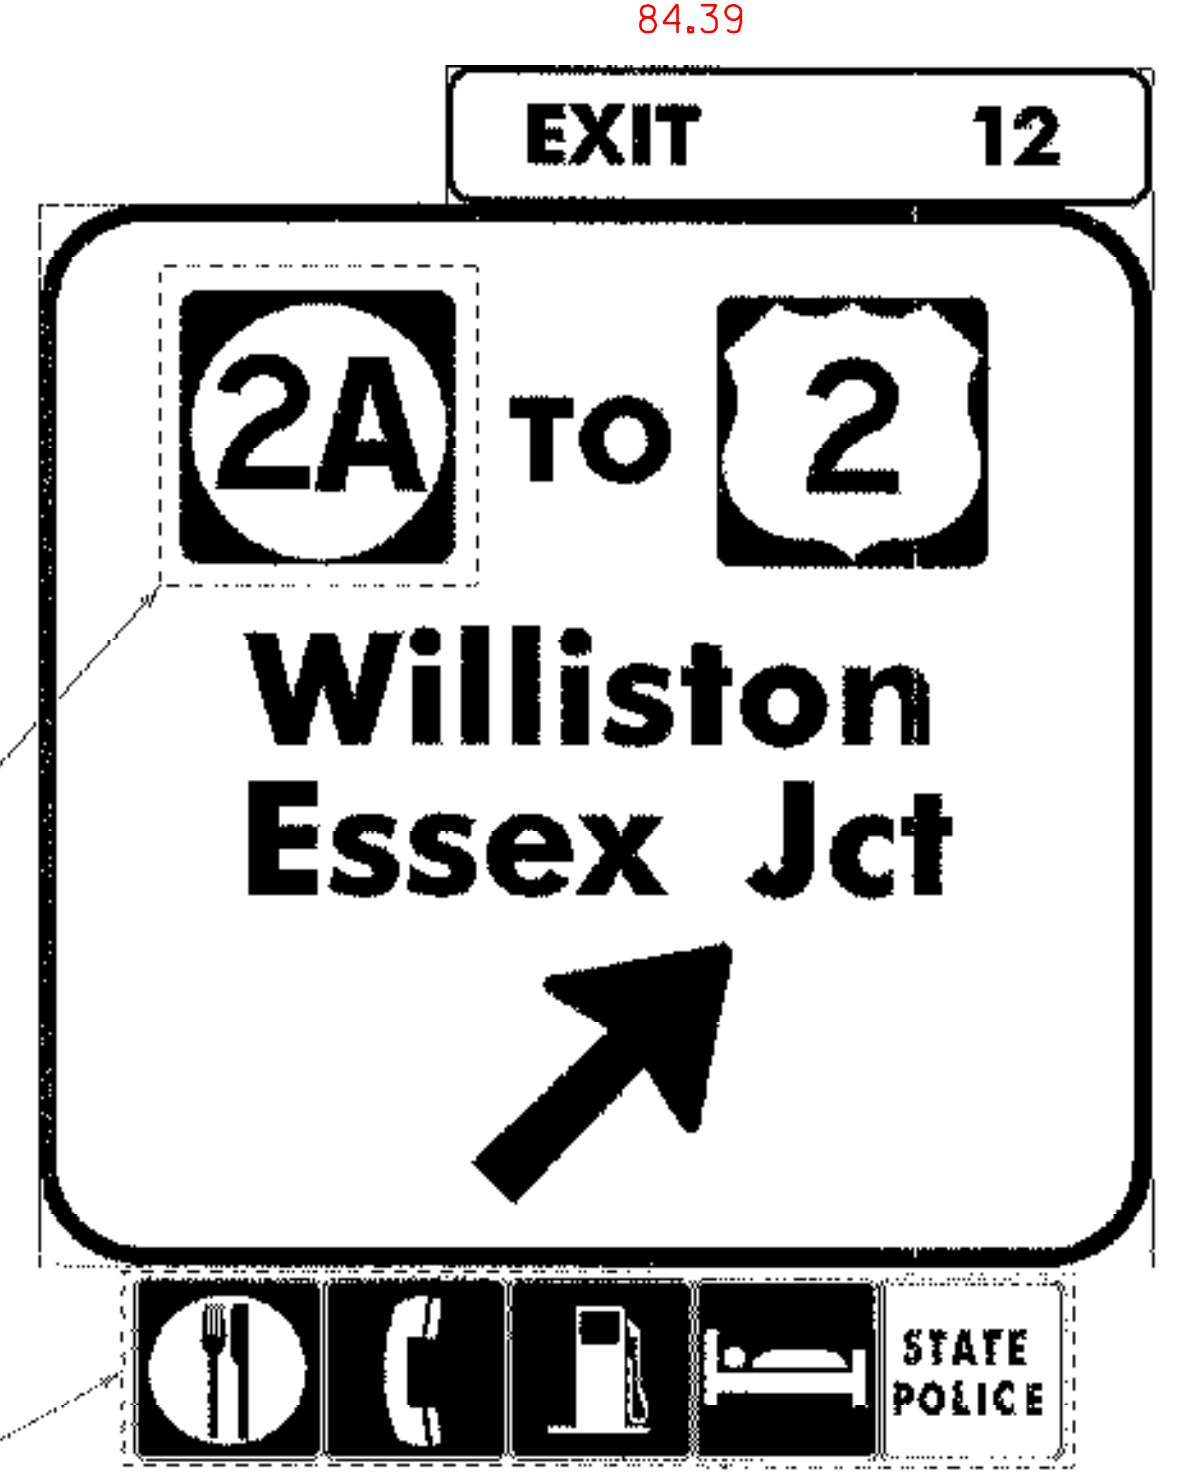

SIGN DETAIL NOTE (STA. 0+00)
THE "RAMP TRAFFIC STOPPED AHEAD" AND "WHEN FLASHING" SIGNS SHALL BE FABRICATED ON ASTM TYPE III YELLOW SHEETING.

| | | | | | | | | | | | | | | | | | | | | | | | | | | | | | | | | |
|---|-------|--------|-----|----|--|--|--|--|--|----|----|-----|----|----|-----|-----|----|----|-----|-----|----|-----|-----|----|--|--|--|--|--|--|--|--|
| FINAL POST LENGTHS ARE TO BE DETERMINED IN THE FIELD. POST SIZES ARE COMPUTED BASED ON INFORMATION FURNISHED ON THE STANDARD SHEETS AND THE TRAFFIC & SAFETY DIVISION'S "SIGN POST DESIGN GUIDELINE." | | | | | | | | | | FT | FT | FT | FT | FT | FT | EA. | LB | LB | LB | EA. | LB | EA. | EA. | LB | | | | | | | | |
| GRAND TOTAL | SF | SF | EA. | SF | | | | | | FT | | FT | | | EA. | LB | LB | LB | EA. | EA. | LB | | | | | | | | | | | |
| | 175.7 | 177.95 | | | | | | | | 80 | | 113 | | | 2 | | | | | | | | | | | | | | | | | |

BK #1 P81

BK #1 P83

BK #1 P115

BK #1 P85

BK #1 P115

PROJECT NAME: I-89 EXIT 12 SB OFF RAMP
PROJECT NUMBER: IM 089-2(35)

FILE NAME: 18800F4TS03.dgn
PROJECT LEADER: EPD
DESIGNED BY: JDA
SIGN SUMMARY AND DETAIL SHEET

PLOT DATE: 17-MAY-2005
DRAWN BY: JDA / PGJ
CHECKED BY: EPD
SHEET 51 OF 76

GPS CONTROL POINTS

HVCTRL #1

STANDARD DISC STAMPED

"LONE PINE 1943"

** N = 713794.9995

E = 1469420.1680

ELEV. = 416.1100

GENERAL LOCATION, SOUTH BURLINGTON, VT. OWNERSHIP, LEO OBRIEN, JR., OLD FARM ROAD, SOUTH BURLINGTON, VT. 05403. PHONE 802-864-4677 OR 802-863-2773. TO REACH FROM THE NORTH END OF THE VT ROUTE 116 BRIDGE OVER I-89 GO NORTH ALONG VT ROUTE 116 FOR 0.1 MI (0.2 KM) TO THE INTERSECTION OF OLD FARM ROAD RIGHT. TURN RIGHT AND GO NORTH ALONG OLD FARM ROAD FOR 0.5 MI (0.8 KM) TO THE MARK ON THE RIGHT IN AN OLD PASTURE. TO REACH FROM THE INTERSECTION OF U.S. ROUTE 2 (WILLISTON ROAD) AND VT ROUTE 116 IN SOUTH BURLINGTON GO EAST ALONG U.S. ROUTE 2 FOR 0.9 MI (1.4 KM) TO THE INTERSECTION OF KENNEDY DRIVE RIGHT. TURN RIGHT AND GO SOUTH ALONG KENNEDY DRIVE FOR 0.15 MI (0.24 KM) TO THE INTERSECTION OF KIMBALL AVENUE LEFT. TURN LEFT AND GO SOUTHEAST ALONG KIMBALL AVENUE FOR 0.05 MI (0.08 KM) TO THE INTERSECTION OF OLD FARM ROAD RIGHT. TURN RIGHT AND GO SOUTH ALONG OLD FARM ROAD FOR 0.25 MI (0.40 KM) TO THE MARK ON THE LEFT. THE MARK IS SET FLUSH WITH GROUND SURFACE IN THE TOP OF A NORTH SOUTH ROCK LEDGE. IT IS 49.4 M (162.1 FT) EAST OF AND ABOUT 3 M (9.8 FT) HIGHER THAN THE CENTERLINE OF OLD FARM ROAD, 56.1 M (184.1 FT) SOUTHWEST OF A 30 CM CHERRY, 13.6 M (44.6 FT) NORTHEAST OF A LONE DOUBLE TRUNK APPLE, AND 2.0 M (6.6 FT) NORTHWEST OF A FIBERGLASS WITNESS POST IN A STONE PILE.

HVCTRL #2

STANDARD DISC STAMPED

"EXIT 12-189 1995"

** N = 707578.2862





E = 1479708.0570

ELEV. = 453.9200

GENERAL LOCATION, WILLISTON, VT. AT THE NORTHWEST QUADRANT OF THE INTERSECTION OF I-89 AND VT ROUTE 2A AT EXIT 12. THE MARK IS SET FLUSH WITH GROUND SURFACE IN THE TOP OF A 30 CM DIAMETER CONCRETE MONUMENT. IT IS 22.4 M (73.5 FT) WEST OF AND ABOUT 6 M (19.7 FT) HIGHER THAN THE WEST EDGE OF PAVEMENT OF VT ROUTE 2A, 1.9 M (6.2 FT) NORTH OF THE NORTH EDGE OF PAVEMENT OF I-89 NORTHBOUND, 4.8 M (15.7) WEST OF THE NORTHWEST CORNER OF THE WEST ABUTMENT OF THE I-89 NORTHBOUND BRIDGE OVER VT ROUTE 2A, AND 1.4 M (4.6 FT) SOUTH OF A FIBERGLASS WITNESS POST.



* DESCRIPTION PROVIDED BY VERMONT AGENCY OF TRANSPORTATION GEODETIC SURVEY UNIT

TRAVERSE TIES

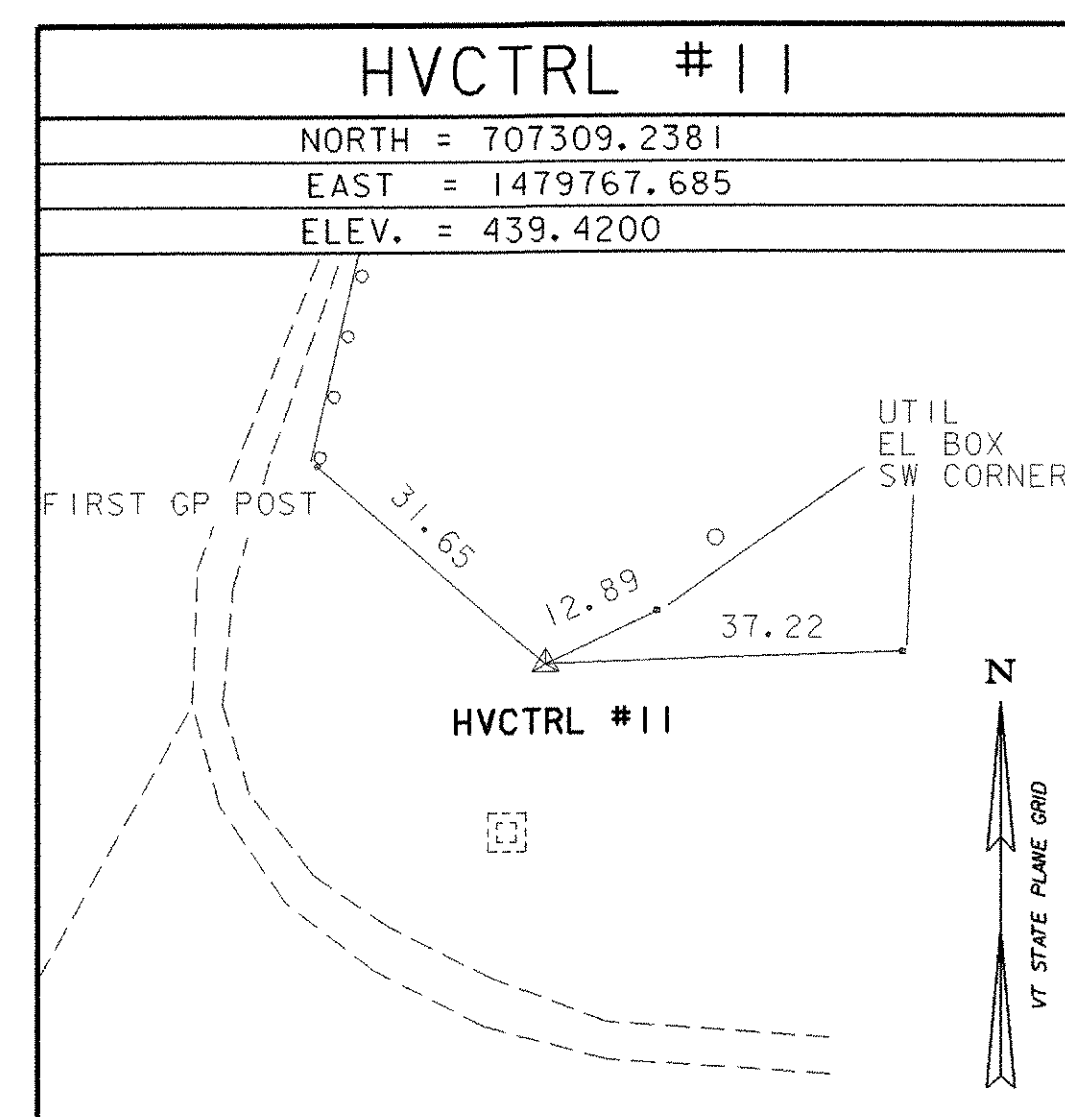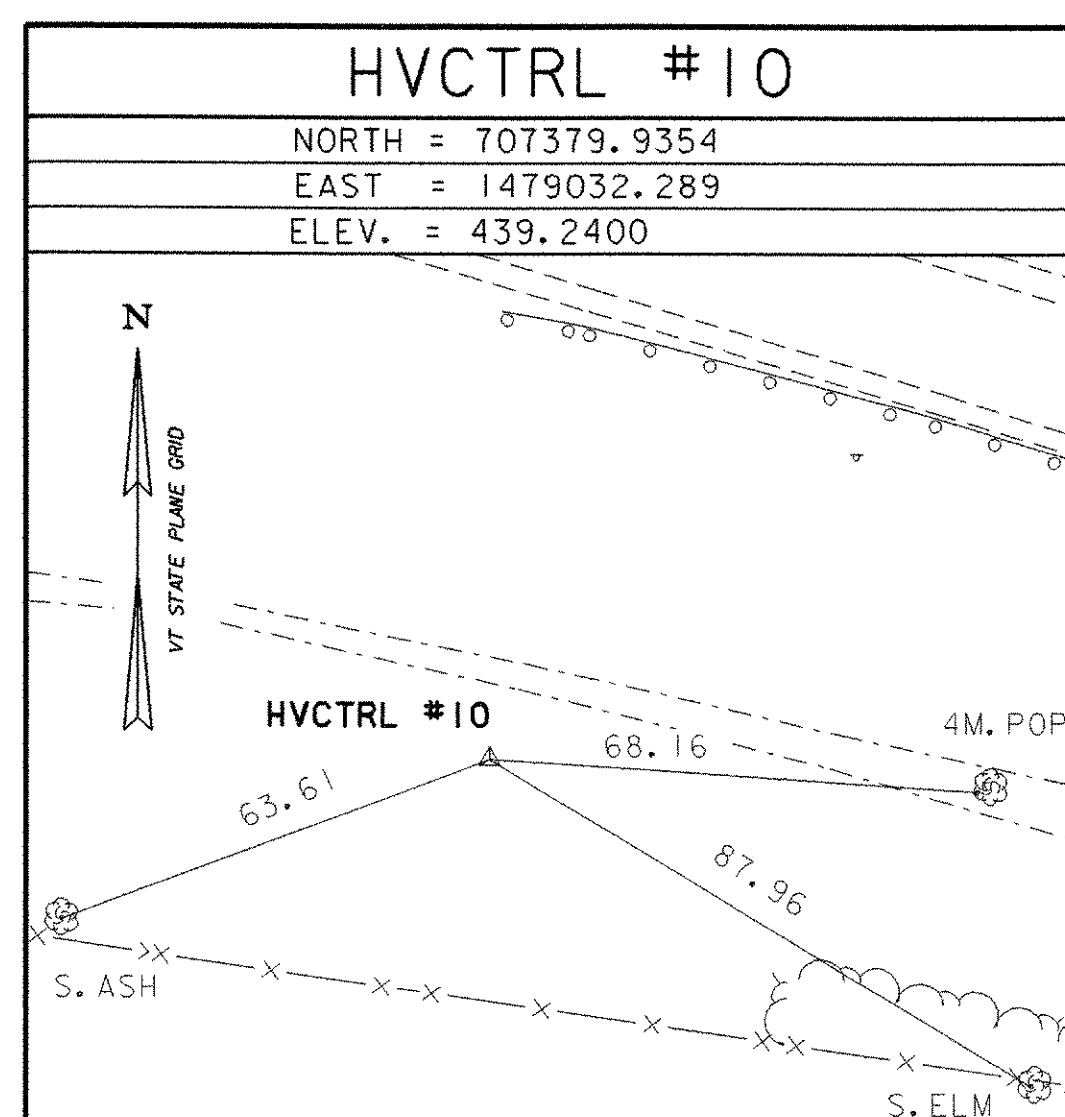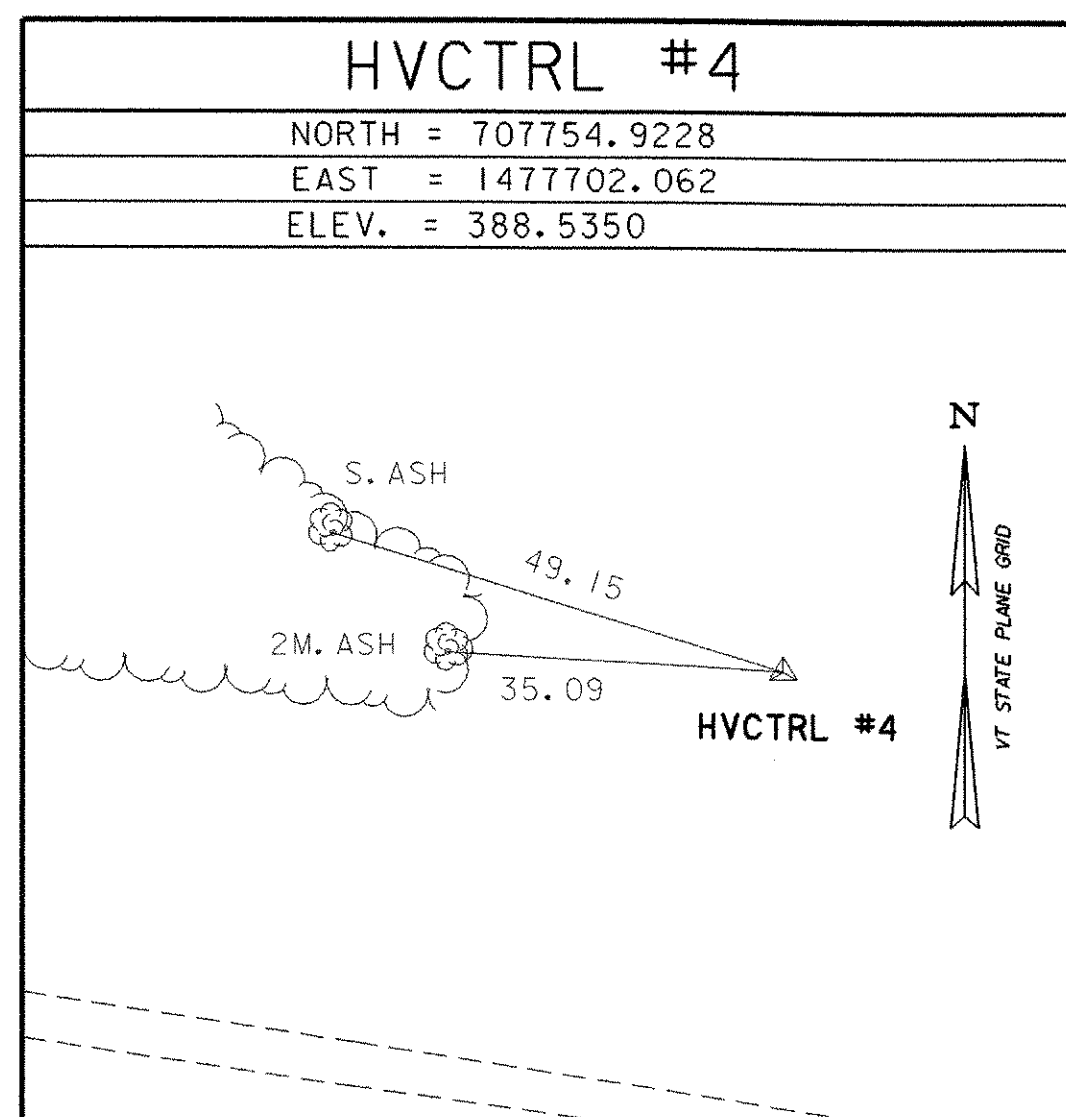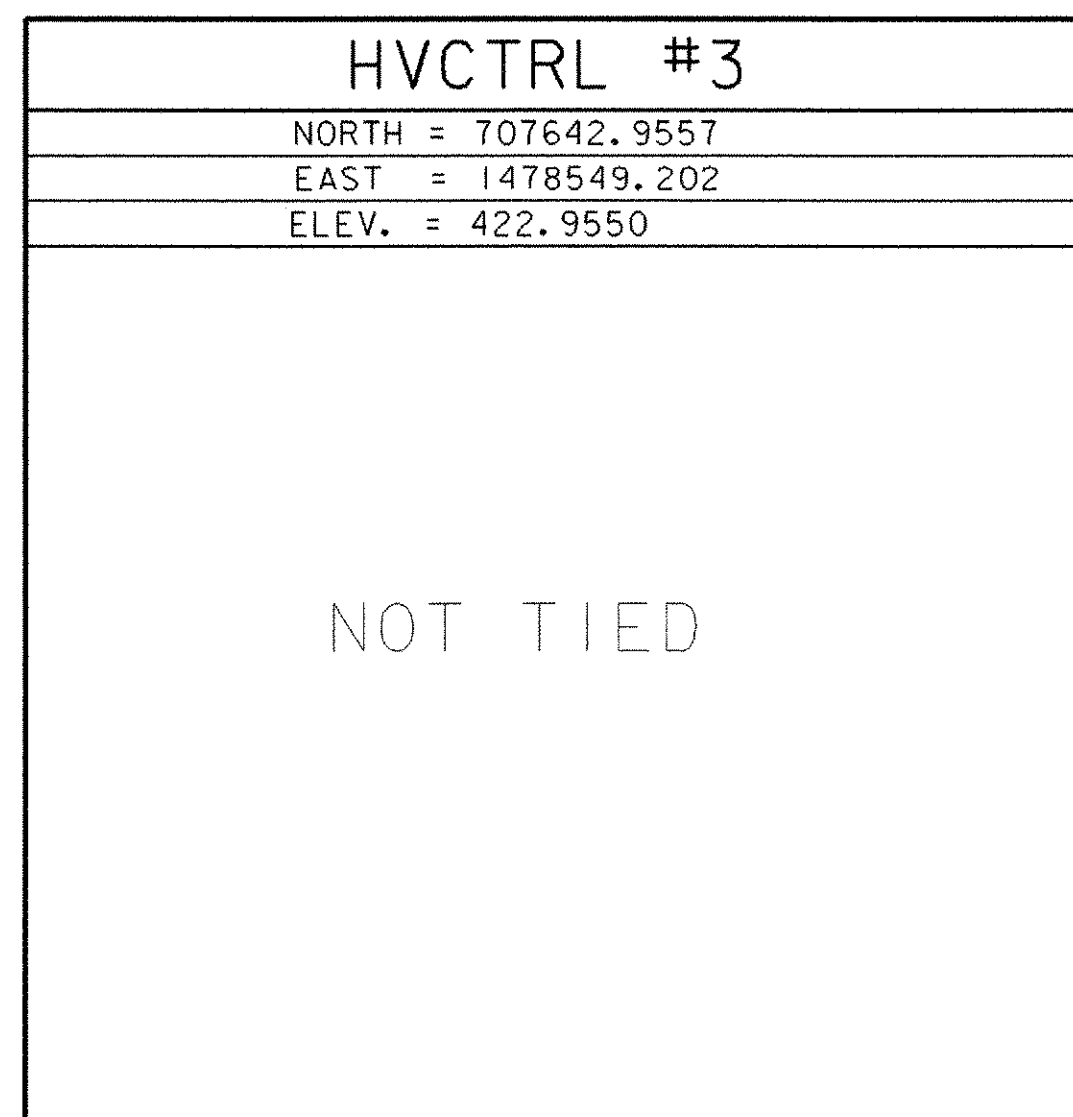

* MAIN TRAVERSE COMPLETED: MAY 5, 2004 BY L.ORVIS PC/ J.HULETT

ALIGNMENT TIES

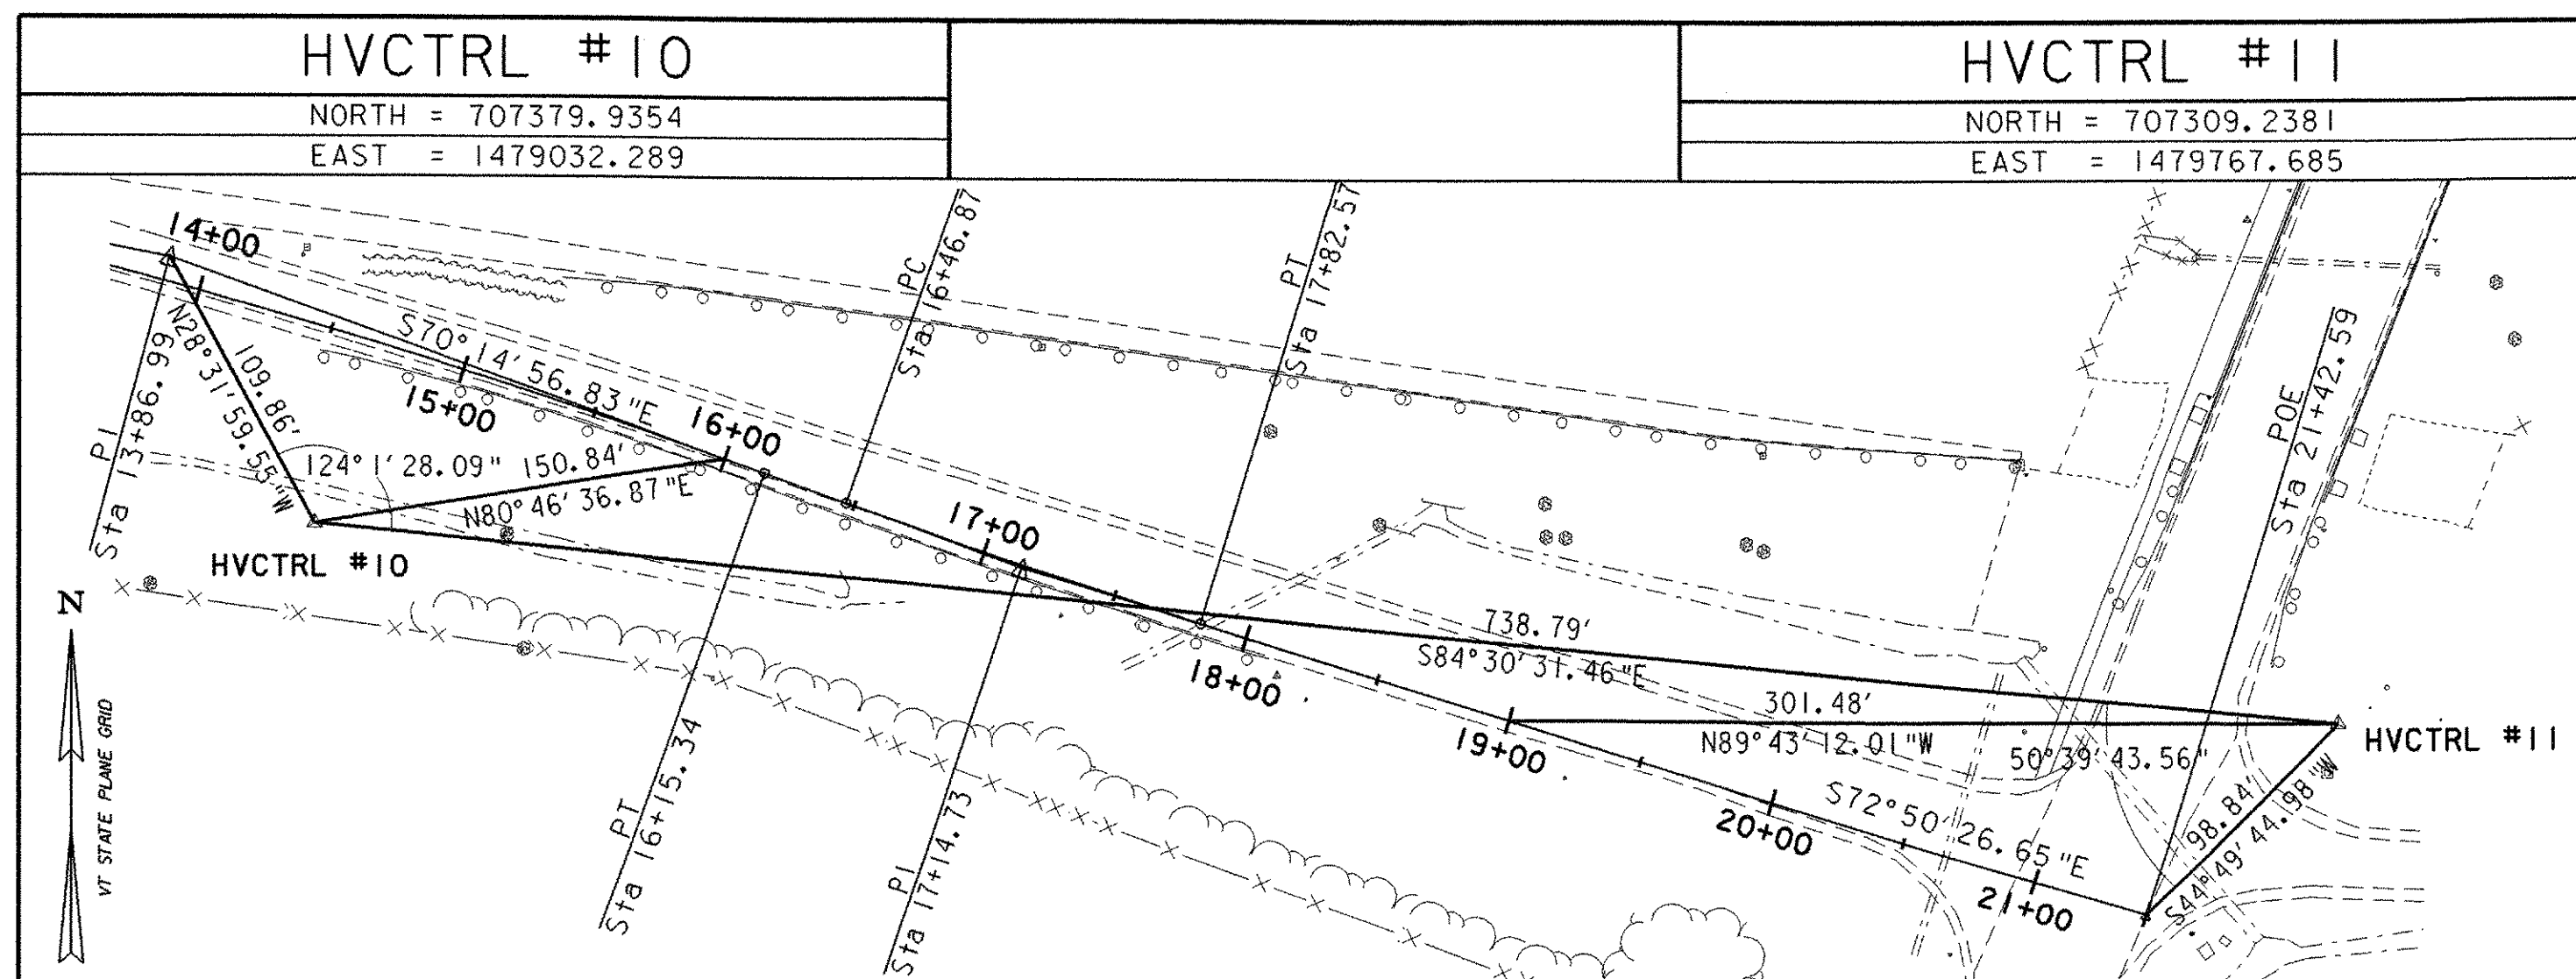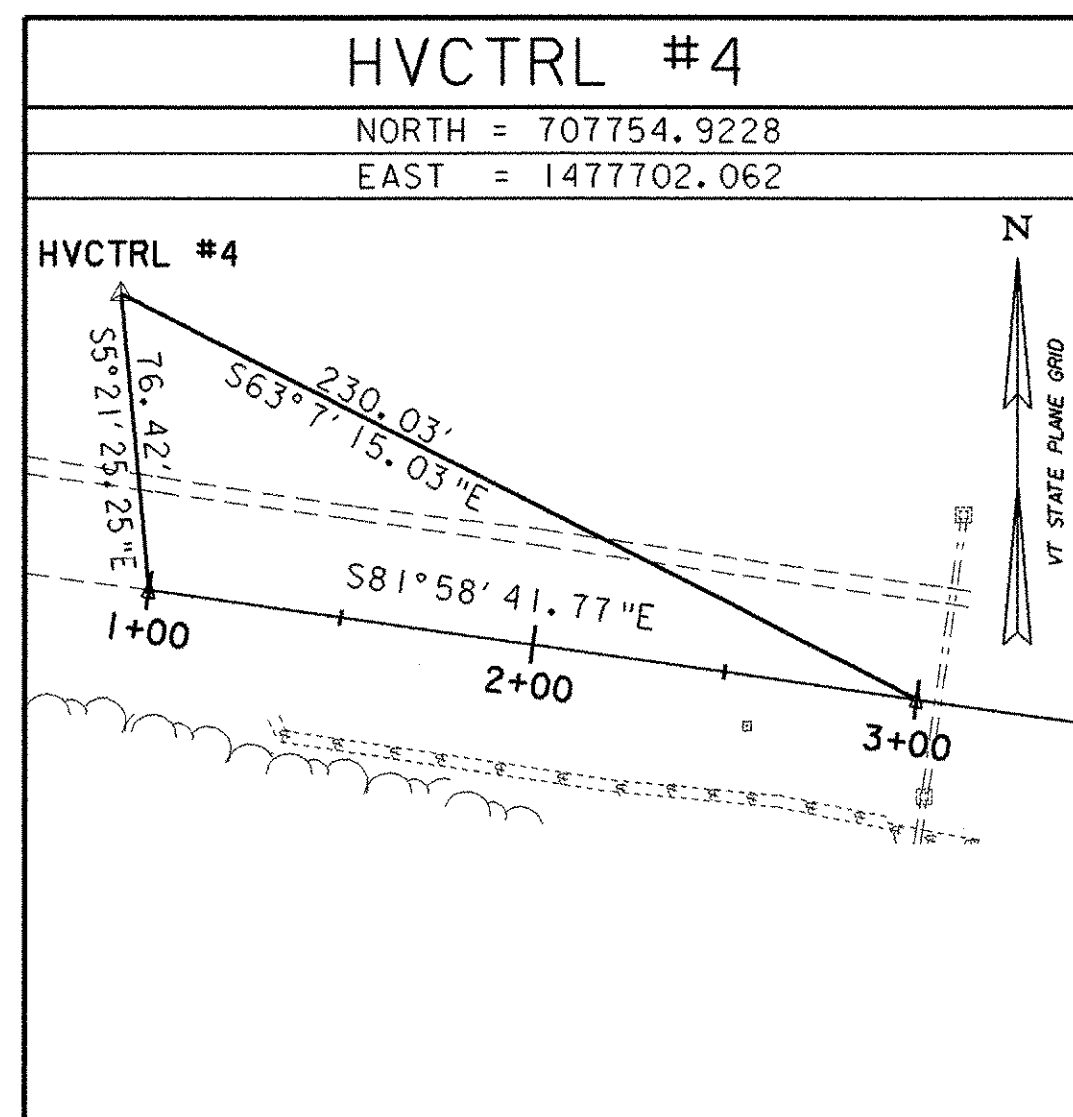

| Type | Station | Northing (Y) | Easting (X) |
|------|------------|------------------|--------------|
| POB | 1+00.00 | 707678.8336 | 1477709.1973 |
| PI | 200.0000 | | |
| | 3+00.00 | 707650.9239 | 1477907.2403 |
| PI | 580.7494 | S 82°03'10.02" E | 707570.6290 |
| | 8+80.75 | 707570.6290 | 1478482.4121 |
| PC | 276.9288 | S 79°16'43.87" E | 707519.1122 |
| | 11+57.68 | 707519.1122 | 1478754.5068 |
| LC= | 457.6663 | CD= 9°01'47.04" | |
| RC= | 2904.0000 | DC= 1°58'22.78" | |
| PI | 13+86.99 | 707476.4542 | 1478979.8120 |
| PT | 16+15.34 | 707398.9639 | 1479195.6300 |
| | 31.5304 | S 70°14'56.83" E | |
| PC | 16+46.87 | 707388.3087 | 1479225.3055 |
| LC= | 135.6967 | CD= 2°35'29.82" | |
| RC= | -3000.0000 | DC= 1°54'35.49" | |
| PI | 17+14.73 | 707365.3768 | 1479289.1733 |
| PT | 17+82.57 | 707345.3561 | 1479354.0127 |
| | 360.0167 | S 72°50'26.65" E | |
| POE | 21+42.59 | 707239.1408 | 1479698.0045 |

DATUM

| | |
|------------|------------|
| VERTICAL | NAVD 88 |
| HORIZONTAL | NAD-83(96) |
| ADJUSTMENT | COMPASS |

PROJECT NAME: I-89 EXIT 12 SB OFF RAMP
PROJECT NUMBER: IM 089-2(35)

| | |
|---------------------------|------------------------|
| FILE NAME: I8800F4TIE.dgn | PLOT DATE: 17-MAY-2005 |
| PROJECT LEADER: EPD | DRAWN BY: JDA / PGJ |
| DESIGNED BY: JDA | CHECKED BY: EPD |
| TIE SHEET | SHEET 52 OF 76 |

MANUFACTURED TERMINAL SECTION (FLARED)

STA. 15+38.96, 45.60 LT - STA. 15+75.33, 55.21 LT
 STA. 16+54.42, 43.93 LT - STA. 16+92.66, 33.90 LT

STEEL BEAM GUARDRAIL

STA. 16+92.66, 33.90 LT - STA. 20+72.70, 40.00 LT 437.5

REMOVAL AND DISPOSAL OF GUARDRAIL

STA. 15+23.84, LT 42.74 - STA. 15+75.33, 55.21 LT 521


TRAILING END TERMINAL

STA. 20+72.70, 40.00 LT

NOTES

- STATIONS AND OFFSETS OF RELOCATED, REMOVED AND NEW SIGNS, IN ADDITION TO NEW PAVEMENT MARKINGS, ARE SHOWN ON THE SIGNS & PAVEMENT MARKINGS SHEET.
- GUARDRAIL TO BE PAID FOR UNDER ITEM 621.20, "STEEL BEAM GUARDRAIL". MANUFACTURED TERMINAL SECTION (M.T.S.) TO BE PAID FOR UNDER ITEM 621.505, "MANUFACTURED TERMINAL SECTION (FLARED)". SEE VTRANS STANDARD C-19 FOR M.T.S. DETAILS.
- THE CONTRACTOR SHALL CONTACT DIG-SAFE AND REQUEST MARKING OF ALL BURIED UTILITIES WITHIN THE PROJECT LIMITS PRIOR TO ANY EXCAVATION. LOCATION OF EXISTING UTILITIES SHOWN ARE APPROXIMATE AND MAY NOT SHOW ALL EXISTING UTILITIES. THE CONTRACTOR SHALL BE RESPONSIBLE FOR LOCATING ALL UTILITIES PRIOR TO EXCAVATION.

- NO UTILITIES ARE TO BE DISTURBED WITHOUT PRIOR WRITTEN CONSENT FROM THE UTILITY OWNER. ANY DAMAGE TO EXISTING UTILITIES AS A RESULT OF CONTRACTOR'S OPERATIONS SHALL BE REPAIRED TO THE SATISFACTION OF THE OWNER AT THE SOLE COST OF THE CONTRACTOR.
- THE CONTRACTOR SHALL CONTACT THE TOWN OF MILLISTON AND APPROPRIATE UTILITY COMPANIES RELATIVE TO UTILITIES, ARRANGE AND ATTEND A PRE-CONSTRUCTION MEETING TO DISCUSS UTILITIES.
- THE CONTRACTOR IS RESPONSIBLE FOR THE INITIAL AND CONTINUED COORDINATION WITH UTILITY OWNERS TO ENSURE THAT THE SCHEDULING OF UTILITY WORK RESULTS IN THE SMOOTH PROGRESSION OF THE PROJECT.

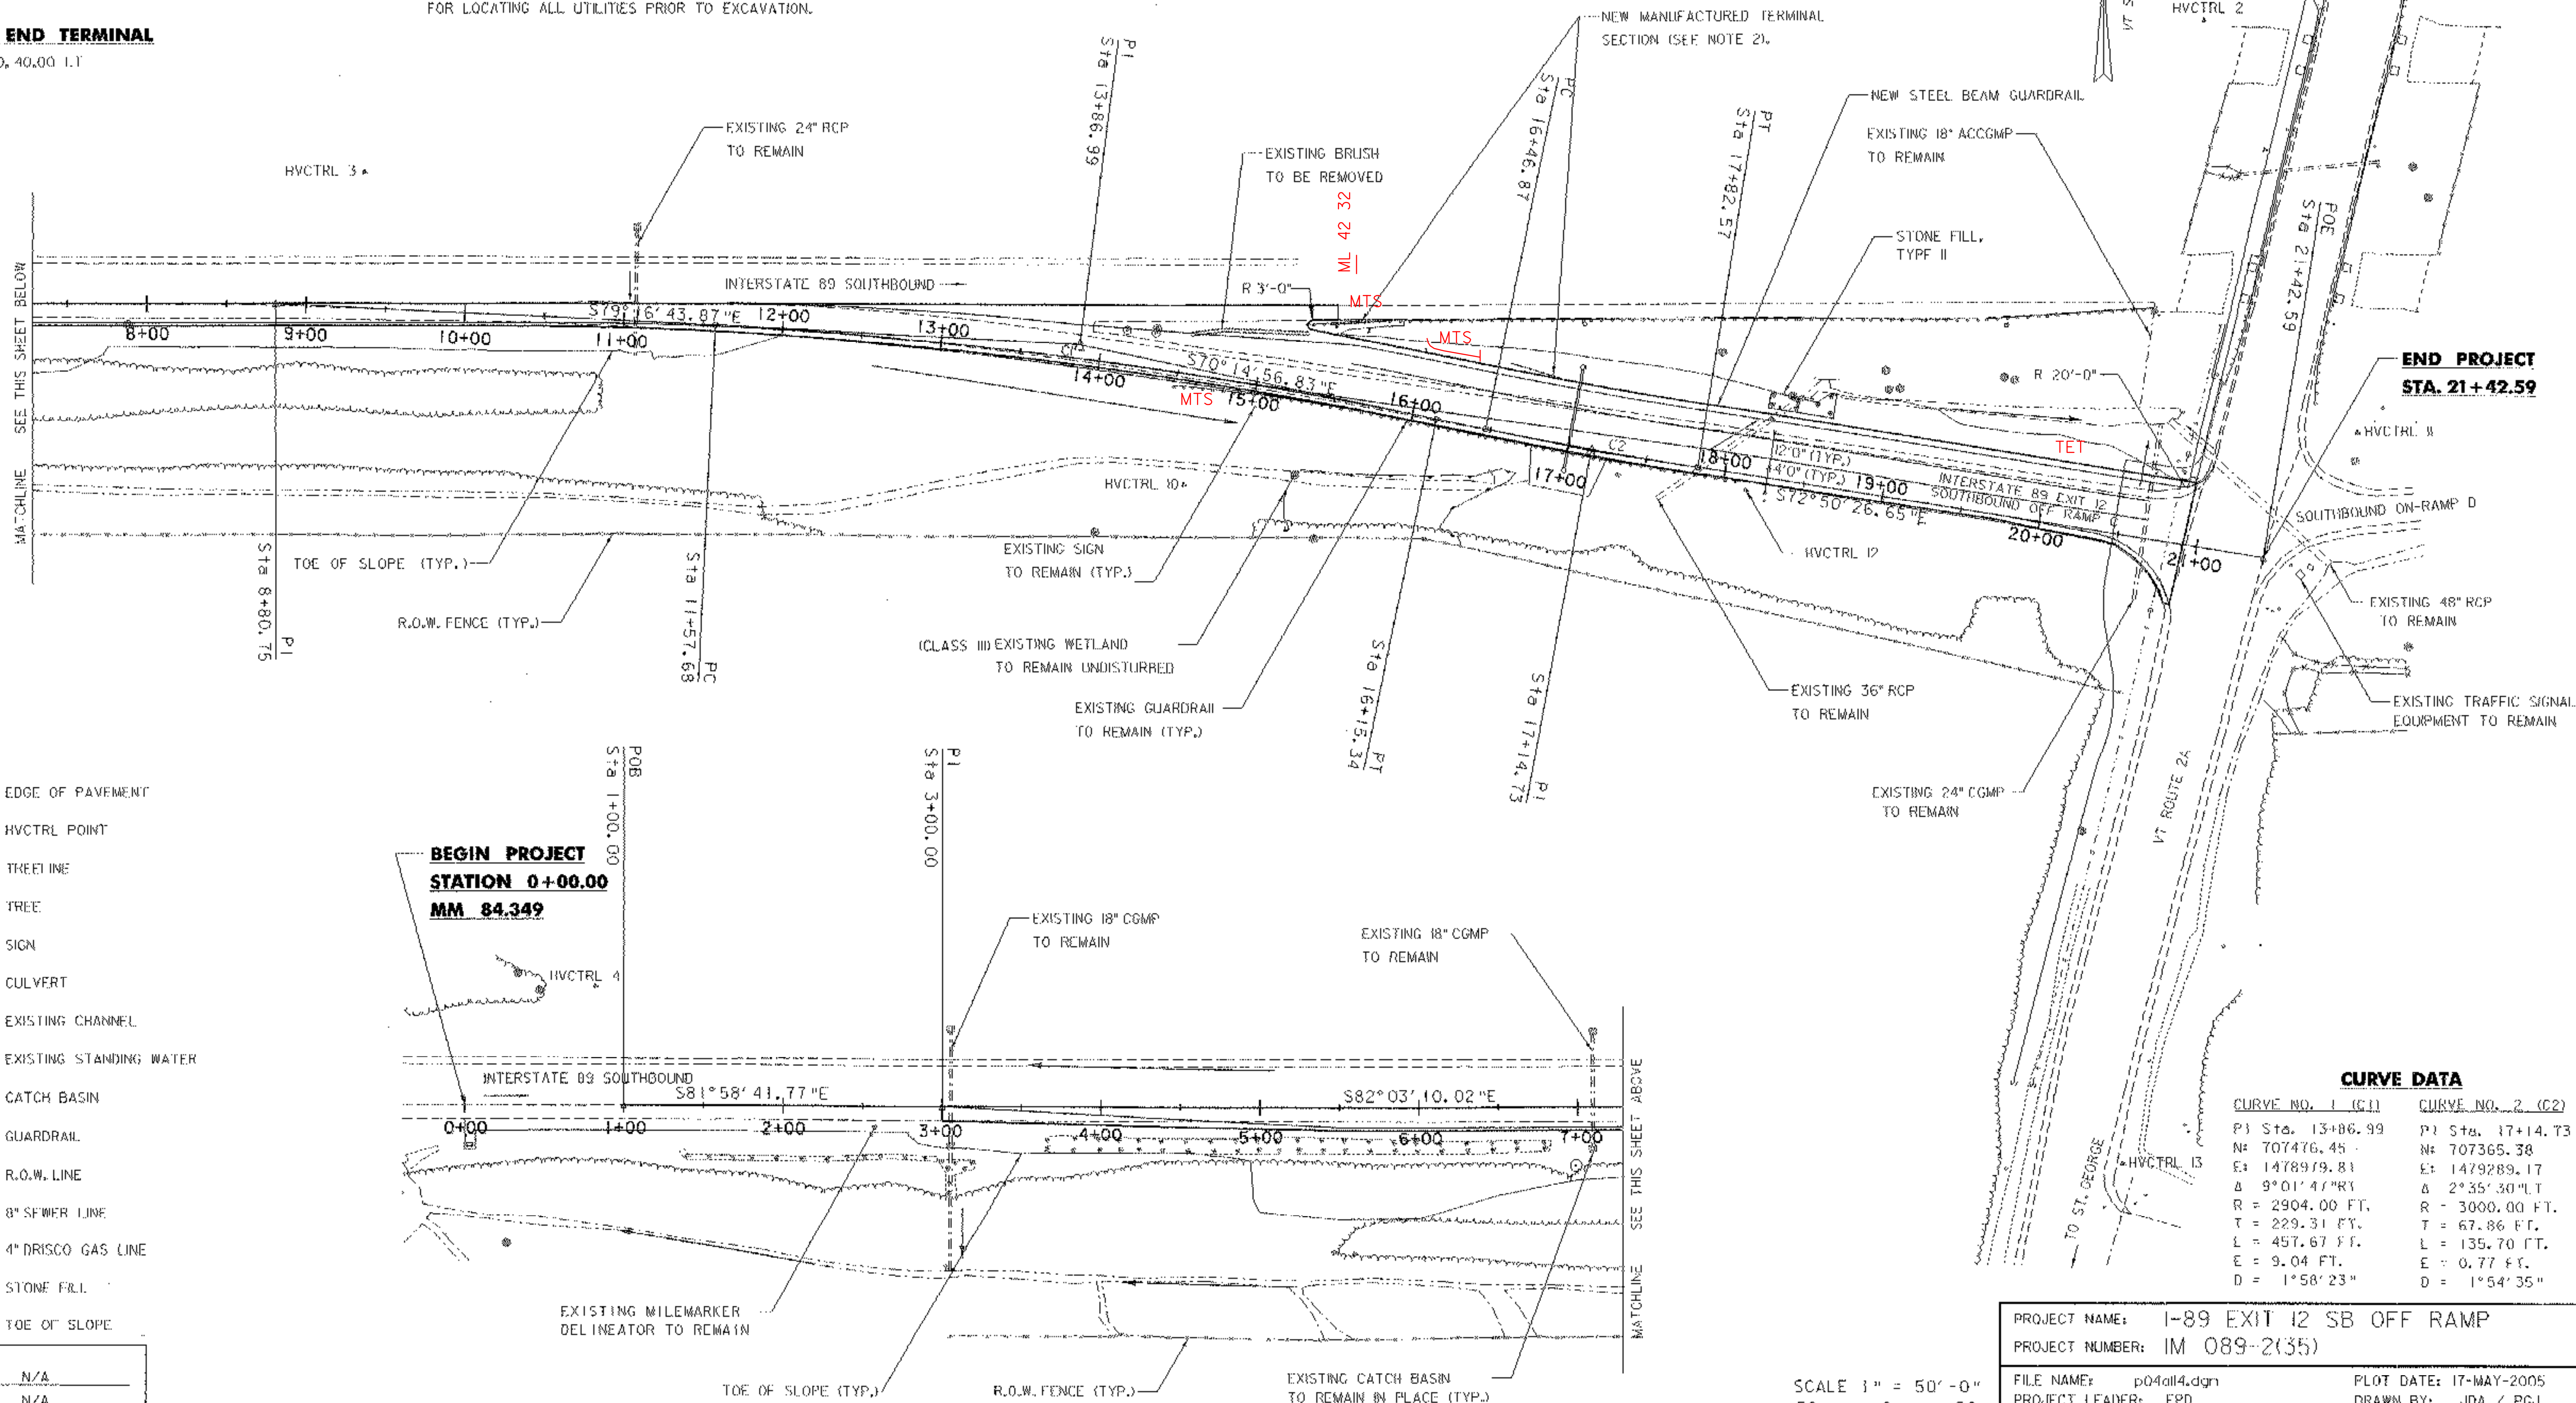

LEGEND

- EDGE OF PAVEMENT
- HVCTRL POINT
- TREE LINE
- TREE
- SIGN
- CULVERT
- EXISTING CHANNEL
- EXISTING STANDING WATER
- CATCH BASIN
- GUARDRAIL
- R.O.W. LINE
- 8" SFWER LINE
- 4" DRISCO GAS LINE
- STONE FILL
- TOE OF SLOPE

DATUM

VERTICAL: N/A
 HORIZONTAL: N/A

BEGIN PROJECT
STATION 0+00.00
MM 84.349


CURVE DATA

| CURVE NO. 1 (C1) | CURVE NO. 2 (C2) |
|---------------------|---------------------|
| PI Sta. 13+86.99 | PI Sta. 17+14.73 |
| N: 707476.45 | N: 707365.38 |
| E: 1478919.81 | E: 1479289.17 |
| Δ 9°01'47"RT | Δ 2°35'30"LT |
| R = 2904.00 FT. | R = 3000.00 FT. |
| T = 229.31 FT. | T = 67.86 FT. |
| L = 457.67 FT. | L = 135.70 FT. |
| E = 9.04 FT. | E = 0.77 FT. |
| D = 1°58'23" | D = 1°54'35" |

PROJECT NAME: I-89 EXIT 12 SB OFF RAMP
 PROJECT NUMBER: IM 089-2(35)

FILE NAME: p04all4.dgn
 PROJECT LEADER: EPD
 DESIGNED BY: JDA
 LAYOUT SHEET

PLOT DATE: 17-MAY-2005
 DRAWN BY: JDA / PCJ
 CHECKED BY: EPD
 SHEET 53 OF 76

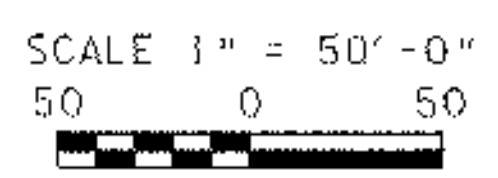

- NOTES**
- LOCATION OF EXISTING STRIPING ON VT ROUTE 2A SHOWN IS APPROXIMATE. ALL CONFLICTING EXISTING MARKINGS SHALL BE REMOVED BY GRINDING OR BURNING. REMOVAL OF EXISTING MARKINGS SHALL BE PAID FOR UNDER ITEM 646.85, "REMOVAL OF EXISTING PAVEMENT MARKINGS".
 - TEMPORARY LINES, SYMBOLS AND LETTERS ARE TO BE USED AT THE SAME LOCATIONS AS DURABLE LINES. SEE QUANTITY SHEETS FOR ITEM NUMBERS USED FOR PAYMENT OF ALL LINE TYPES.
 - PLACEMENT OF RELOCATED SIGNS SHALL FOLLOW VTRANS AND 2003 MUTCD STANDARDS. SIGNS ON THIS SHEET ARE NOT DRAWN TO SCALE.
 - NEW DELINEATORS WITH REFLECTORS SHALL BE PLACED ALONG BOTH SIDES OF THE RAMP. REFLECTORS ON LEFT SIDE SHALL BE YELLOW WITH RED ON BACK. ON THE RIGHT SIDE THE REFLECTORS SHALL BE SILVER WITH RED ON THE BACK. SEE VTRANS STANDARDS E-197 AND E-198 FOR PLACEMENT AND DETAILS OF DELINEATORS. TO BE PAID FOR UNDER ITEM 676.10, "DELINEATORS WITH STEEL POSTS".
 - NEW "RAMP TRAFFIC STOPPED AHEAD" SIGN SHALL INCLUDE DUAL ALTERNATING FLASHING BEACONS ON TOP OF THE SIGN. SEE VTRANS STANDARD E-106 FOR DETAILS ON ATTACHING BEACONS.
 - SEE SIGN ACTUATION NOTES AND DETAILS SHEET FOR INFORMATION ON THE CONDUIT AND LOOP FOR THE SIGN ACTUATION. LOOP DETECTORS ARE PAID UNDER ITEM 678.22, "VEHICLE LOOP DETECTOR".

DURABLE 6" WHITE LINE (MOD.)


STA. 3+00.00, 0.00 LT - STA. 8+22.20, 0.00 LT (DOTTED)
 STA. 3+00.00, 0.00 RT - STA. 20+90.59, 67.81 RT
 STA. 8+22.20, 0.00 LT - STA. 10+91.14, 10.34 LT (DASHED)
 STA. 15+56.19, 24.00 LT - STA. 20+66.38, 24.00 LT
 STA. 17+82.48, 12.00 LT - STA. 20+66.38, 12.00 LT

DURABLE 12" WHITE LINE (MOD.)

STA. 10+94.14, 10.34 LT - STA. 15+14.56, 53.11 LT
 STA. 10+94.14, 10.34 LT - STA. 15+17.27, 32.76 LT
 STA. 11+64.61, 14.27 LT - STA. 15+17.27, 53.11 LT (GORE AREA)
DURABLE 4" WHITE LINE (MOD.)
 STA. 14+75.00, 0.00 LT - STA. 17+82.48, 12.00 LT (DASHED)

DURABLE 6" YELLOW LINE (MOD.)

STA. 15+35.36, 33.65 LT - STA. 21+04.39, 67.34 LT
DURABLE 24" STOP BAR
 STA. 20+67.38, 36.00 LT - STA. 20+67.38, 12.51 RT
 STA. 21+09.11, 128.68 LT - STA. 21+31.48, 127.06 LT

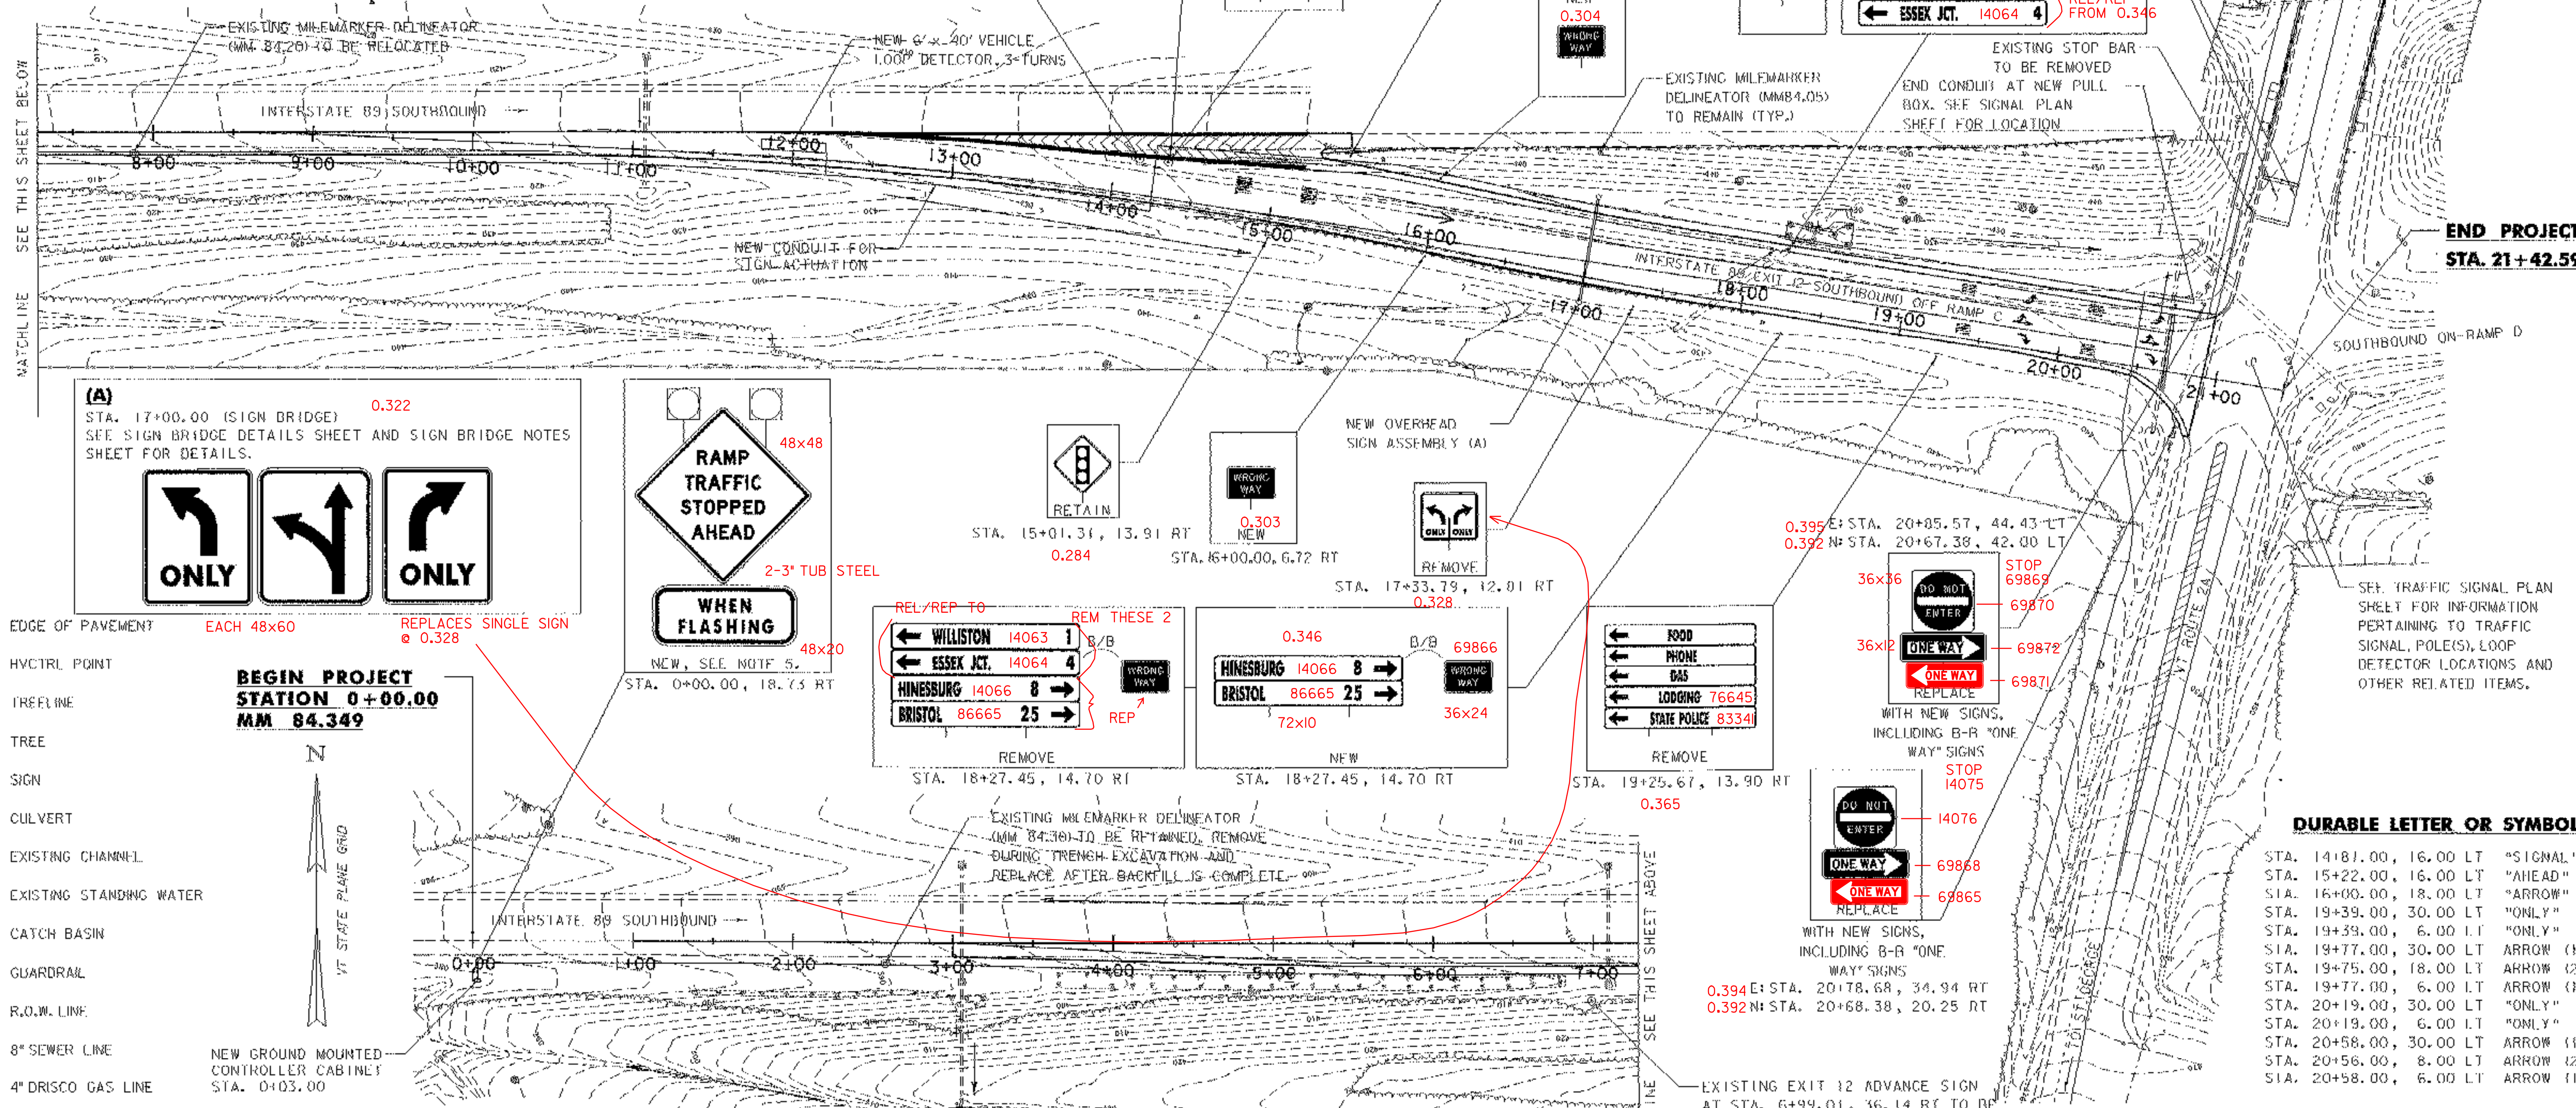

(A)
 STA. 17+00.00 (SIGN BRIDGE) 0.322
 SEE SIGN BRIDGE DETAILS SHEET AND SIGN BRIDGE NOTES SHEET FOR DETAILS.

RAMP TRAFFIC STOPPED AHEAD 48x48
 2-3" TUB STEEL
WHEN FLASHING 48x20
 NEW, SEE MUTCD 5.
 STA. 0+00.00, 18.73 RT

REL/REP TO
 ← WILLISTON 14063 1
 ← ESSEX JCT. 14064 4
 ← HINESBURG 14066 8
 ← BRISTOL 86665 25 →
 REMOVE
 STA. 18+27.45, 14.70 RT

0.346
 ← HINESBURG 14066 8 →
 ← BRISTOL 86665 25 →
 NEW
 STA. 18+27.45, 14.70 RT

0.365
 ← FOOD
 ← PHONE
 ← GAS
 ← LODGING 76645
 ← STATE POLICE 8334
 REMOVE
 STA. 19+25.67, 13.90 RT

36x36 STOP 69869
 36x12 ONE WAY 69872
 36x12 ONE WAY 69871
 WITH NEW SIGNS, INCLUDING B-R "ONE WAY" SIGNS
 STOP 14075
 14076
 69868
 69865
 WITH NEW SIGNS, INCLUDING B-R "ONE WAY" SIGNS

- LEGEND**
- EDGE OF PAVEMENT? EACH 48x60 REPLACES SINGLE SIGN @ 0.328
 - HYCTRL POINT
 - TREELINE
 - TREE
 - SIGN
 - CULVERT
 - EXISTING CHANNEL
 - EXISTING STANDING WATER
 - CATCH BASIN
 - GUARDRAIL
 - R.O.W. LINE
 - 8" SEWER LINE
 - 4" DRISCO GAS LINE
 - STONE FILL
 - TOE OF SLOPE

ITEM 678.16 - FLASHING BEACON - GROUND MOUNTED (MOD. - ACTUATED SIGN) MAJOR EQUIPMENT LIST


| | |
|---|---|
| FLASHING BEACONS | 2 |
| GROUND MOUNTED CONTROLLER CABINET | 1 |
| POWER DROP STANCHION | 1 |
| ALL OTHER MISCELLANEOUS HARDWARE NECESSARY TO COMPLETE INSTALLATION | |

DURABLE LETTER OR SYMBOL

| | |
|-------------------------|-----------|
| STA. 14+81.00, 16.00 LT | "SIGNAL" |
| STA. 15+22.00, 16.00 LT | "AHEAD" |
| STA. 16+00.00, 18.00 LT | "ARROW" |
| STA. 19+39.00, 30.00 LT | "ONLY" |
| STA. 19+39.00, 6.00 LT | "ONLY" |
| STA. 19+77.00, 30.00 LT | ARROW (1) |
| STA. 19+75.00, 18.00 LT | ARROW (2) |
| STA. 19+77.00, 6.00 LT | ARROW (1) |
| STA. 20+19.00, 30.00 LT | "ONLY" |
| STA. 20+19.00, 6.00 LT | "ONLY" |
| STA. 20+58.00, 30.00 LT | ARROW (1) |
| STA. 20+56.00, 8.00 LT | ARROW (2) |
| STA. 20+58.00, 6.00 LT | ARROW (1) |



PROJECT NAME: I-89 EXIT 12 SB OFF RAMP
 PROJECT NUMBER: IM 089-2(35)
 FILE NAME: p04014.dgn
 PROJECT LEADER: EPI2
 DESIGNED BY: JDA
 SIGNS & PAVEMENT MARKINGS SHEET

PLOT DATE: 17-MAY-2005
 DRAWN BY: JDA / PGJ
 CHECKED BY: EPD
 SHEET 54 OF 76

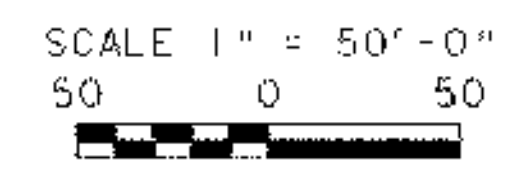

GENERAL NOTES

- LOCATIONS OF ALL UNDERGROUND UTILITIES ARE APPROXIMATE. THE CONTRACTOR SHALL DETERMINE THE EXACT LOCATIONS AND VERIFY ALL CONDITIONS ON THE JOB SITE.
- ALL POLES, CONDUITS, JUNCTION BOXES, STRIPING, AND LOOP DETECTOR LOCATIONS SHOWN ON PLANS ARE APPROXIMATE. ACTUAL LOCATIONS SHALL BE DETERMINED BY FIELD CONDITIONS AT THE TIME OF CONSTRUCTION AND AS DIRECTED BY THE RESIDENT ENGINEER OR TOWN OF WILLISTON.
- THE CONTRACTOR SHALL ACQUIRE ALL NECESSARY LOCAL PERMITS AND MAKE ALL NECESSARY ARRANGEMENTS PRIOR TO THE COMMENCEMENT OF WORK.
- ALL TRAFFIC SIGNAL CONDUIT SHALL BE 2" PVC UNLESS OTHERWISE SPECIFIED.
- JUNCTION BOXES SHALL COMPLY WITH VTRANS STANDARD E-173. MINIMUM BOX SIZE SHALL BE 18" X 12" X 12".
- THE LOGO ON JUNCTION BOXES SHALL BE "SIGNAL".
- VEHICLE DETECTOR LOOPS SHALL COMPLY WITH VTRANS STANDARD E-172.
- EXISTING TIMINGS WILL BE USED. NECESSARY ADJUSTMENTS TO TIMINGS WILL BE MADE AFTER COMPLETION OF THE PROJECT.
- SIGNAL OPERATION:
SWITCH-OVER FROM EXISTING TO REPLACEMENT SIGNALS SHALL NOT BE DONE DURING PEAK TRAFFIC PERIODS. UNIFORMED TRAFFIC OFFICERS SHALL CONTROL TRAFFIC DURING SWITCH-OVER. THE VT 2A PHASE SHALL BE USED FOR THE START-UP PHASE FOLLOWING FLASHING OPERATION.
- WORK IMPROVEMENTS CONSISTING OF THOSE SHOWN ON PLANS SHALL BE PERFORMED ACCORDING TO SPECIFICATIONS AND STANDARD DRAWINGS OF VERMONT AGENCY OF TRANSPORTATION.
- INSTALLATION OF THE SIGNAL HEAD TO THE EXISTING POLE SHALL BE PAID FOR UNDER ITEM 678.15, "TRAFFIC CONTROL SIGNAL SYSTEM - INTERSECTION (MOD.)". INSTALLATION PROCEDURE FOR ATTACHING THE NEW SIGNAL HEAD TO THE EXISTING POLE AND WIRING OF THE NEW SIGNAL HEAD SHALL BE APPROVED BY VTRANS PRIOR TO INSTALLATION. THE CONTRACTOR SHALL COORDINATE WITH VTRANS ON SUCH PROCEDURES. ONCE INSTALLATION OF THE NEW SIGNAL HEAD AND WIRING IS COMPLETE, THE EXISTING POLE AND NEW SIGNAL HEAD SHALL BE INSPECTED AND FOUND SATISFACTORY BY THE RESIDENT ENGINEER.

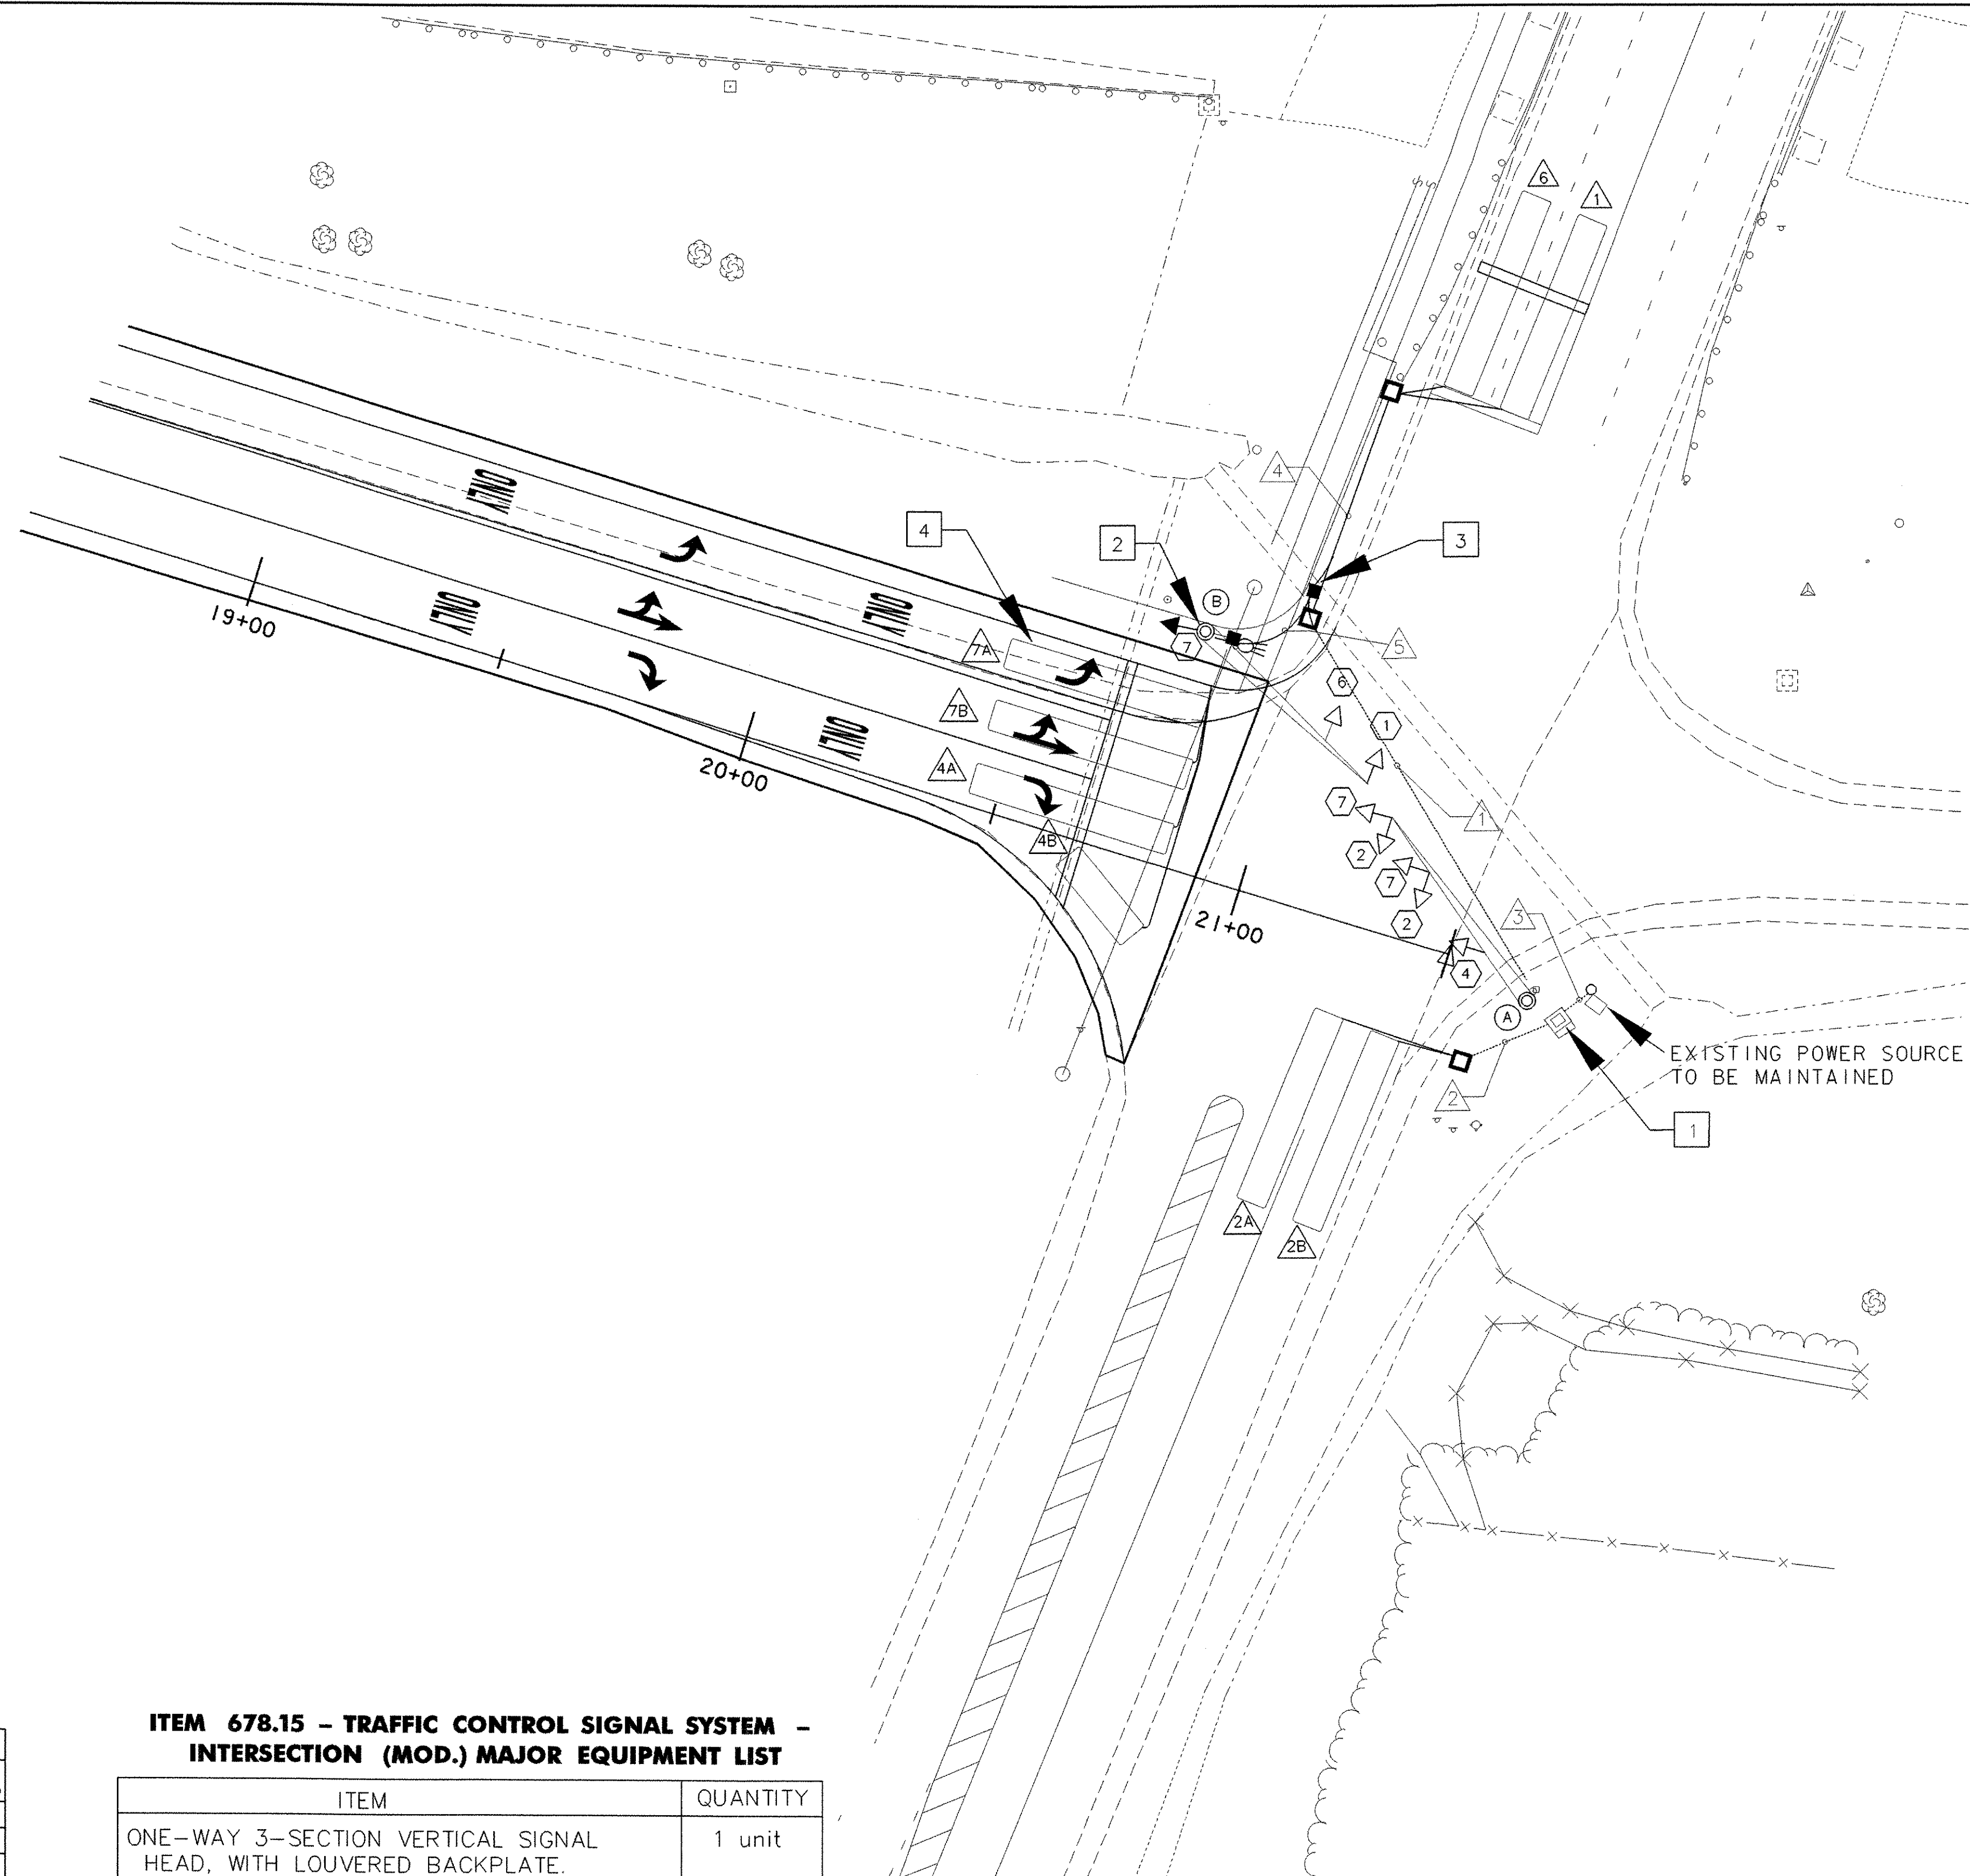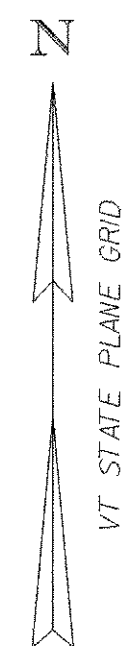

CONSTRUCTION NOTES:

- RETAIN EXISTING CONTROLLER IN EXISTING CABINET. INSTALL LOOP DETECTOR.
- NEW CONDUIT AND SWEEPS INTO EXISTING CONDUIT RUN. EXISTING CONDUCTORS SHALL BE USED. INSTALL NEW SIGNAL HEAD ON POST OF EXISTING MAST ARM. RETAIN ALL CONDUCTORS AND SIGNAL HEADS. CONDUIT RUNS AND SIGNAL HEAD LOCATION SHALL COMPLY WITH VTRANS STANDARDS E-170, E-171A, E-171B, AND E-171C.
- RELOCATE EXISTING JUNCTION BOX INTO EXISTING CONDUIT RUN. INSTALLATION SHOULD FOLLOW VTRANS STANDARD DRAWING E-173. NEW SWEEPS FROM EXISTING CONDUIT RUN INTO PULL BOX.
- INSTALL DETECTOR LOOP PER VTRANS STANDARD DRAWING E-172. LOOP SHALL BE IN CENTER OF LANE.

| EXISTING | NEW | LEGEND |
|----------|-----|--------------------|
| | | UTILITY POLE |
| | | LUMINAIRE |
| | | LIGHT OR WOOD POLE |
| | | STRAIN POLE |
| | | CONTROLLER CABINET |
| | | JUNCTION BOX |
| | | SIGNAL HEAD |
| | | CONDUIT |
| | | VEHICLE LOOPS |
| | | PEDESTAL POST |
| | | STANCHION |
| | | SWEEP |

ITEM 678.15 - TRAFFIC CONTROL SIGNAL SYSTEM - INTERSECTION (MOD.) MAJOR EQUIPMENT LIST

| ITEM | QUANTITY |
|--|----------|
| ONE-WAY 3-SECTION VERTICAL SIGNAL HEAD, WITH LOUVERED BACKPLATE. | 1 unit |
| 12" LED LENSES | |
| 1-GREEN ARROW | 1 unit |
| 1-YELLOW ARROW | 1 unit |
| 1-RED ARROW | 1 unit |

| VEHICLE DETECTOR LOOPS | | | | | | | | |
|------------------------|---------|--------|------|------------------|-------------------|-----------------------|-----------------------|-------------------|
| LOOP NO. | LANE | CALL Ø | SIZE | TYPE & NO. TURNS | DELAY OR PRESENCE | INDUCTANCE CALC. ACT. | RESISTANCE CALC. ACT. | LEAKAGE TO GROUND |
| 1A | SB LT | 1&6 | 6x40 | QUAD 2 | PRESENCE | 395 | 1.30 | |
| 2A | NB TH | 2&6 | 6x40 | QUAD 2 | PRESENCE | 351 | 0.73 | |
| 3A | NB THRT | 2&6 | 6x40 | QUAD 2 | PRESENCE | 348 | 0.69 | |
| 4A | EB RT | 4&7 | 6x40 | QUAD 2 | 5 SEC. DELAY | 388 | 1.21 | |
| 5A | EB RT | 4&7 | 6x20 | QUAD 2 | 5 SEC. DELAY | 234 | 1.02 | |
| 6A | SB TH | 2&6 | 6x40 | QUAD 2 | PRESENCE | 392 | 1.26 | |
| 7A | EB LT | 4&7 | 6x40 | QUAD 3 | PRESENCE | 323 | 0.376 | |
| 8A | EB LT | 4&7 | 6x40 | QUAD 2 | PRESENCE | 384 | 1.15 | |

DATUM
 VERTICAL N/A
 HORIZONTAL N/A

SCALE 1" = 20'-0"


PROJECT NAME: WILLISTON
 PROJECT NUMBER: IM 089-2(35)

FILE NAME: 618800F4RSQTS.dgn
 PROJECT LEADER: EPD
 DESIGNED BY: JDA
 TRAFFIC SIGNAL PLAN SHEET

PLOT DATE: 17-MAY-2005
 DRAWN BY: JLS
 CHECKED BY: RMC
 SHEET 55 OF 76

SIGN ACTUATION NOTES

1. NEW GROUND MOUNTED CONTROLLER CABINET TO BE PAID FOR UNDER ITEM 678.16, "FLASHING BEACON - GROUND MOUNTED (MOD. - ACTUATED SIGN)". SEE VTRANS STANDARD DETAIL E-171B FOR DETAILS ON THE CABINET. CABINET AND ALL EQUIPMENT MUST BE COMPATIBLE WITH EXISTING ECONOLITE SIGNAL EQUIPMENT AND WIRING AT THE INTERSECTION WITH VT ROUTE 2A.
2. ALL EQUIPMENT MUST COMPLY WITH VTRANS STANDARD SPECIFICATIONS FOR CONSTRUCTION, 2001, INCLUDING SECTION 752.06, "TRAFFIC SIGNAL CONTROLLERS", SECTION 752.07, "FLASHING BEACONS", AND ANY OTHER SECTIONS THAT MAY APPLY.
3. GENERAL NOTES ON THE TRAFFIC SIGNAL PLAN SHEET APPLY TO THE ENTIRE LENGTH OF CONDUIT, FROM THE CABINET AT STA. 0+03.00 TO THE LOOP DETECTOR AT STATION 12+00 AND TO THE SIGNAL SYSTEM AT THE EXIT 12 INTERSECTION WITH VT ROUTE 2A.
4. REFER TO SIGNS & PAVEMENT MARKINGS SHEET AND TRAFFIC SIGNAL PLAN SHEET FOR LOCATION OF CONDUIT. REFER TO TRAFFIC SIGNAL PLAN SHEET FOR SIZE OF CONDUIT.
5. PAYMENT FOR WARNING TAPE IN THE TRENCH TO BE PAID SUBSIDIARY TO ITEM 678.23, "WIRED CONDUIT (6" DIA.)".
6. PAYMENT FOR WIRING SHALL BE PAID SUBSIDIARY TO ITEM 678.16, "FLASHING BEACON - GROUND MOUNTED", (MOD. - ACTUATED SIGN)."
7. THE POWER SOURCE FOR THE ACTUATED SIGN SHALL BE AT THE OFF-RAMP INTERSECTION WITH VT 2A.
8. CONDUIT FOR THE LOOP SYSTEM SHALL BE ON THE LEFT SIDE OF THE CONDUIT TO THE POWER SOURCE FROM STA. 0+00 TO STA. 14+25. FROM STA. 14+25 TO THE INTERSECTION WITH VT 2A, THE CONDUIT FOR THE LOOP SYSTEM SHALL BE ON THE RIGHT SIDE OF THE CONDUIT FOR THE POWER.
9. THE LOOP AT STA. 12+00.00 SHALL HAVE THE SAME PARAMETERS AS LOOP 7A THAT ARE LISTED IN THE "VEHICLE DETECTOR LOOPS" TABLE ON THE TRAFFIC SIGNAL PLAN SHEET, EXCEPT THE LOOP AT STA. 12+00.00 SHALL HAVE A 5 SEC. DELAY.

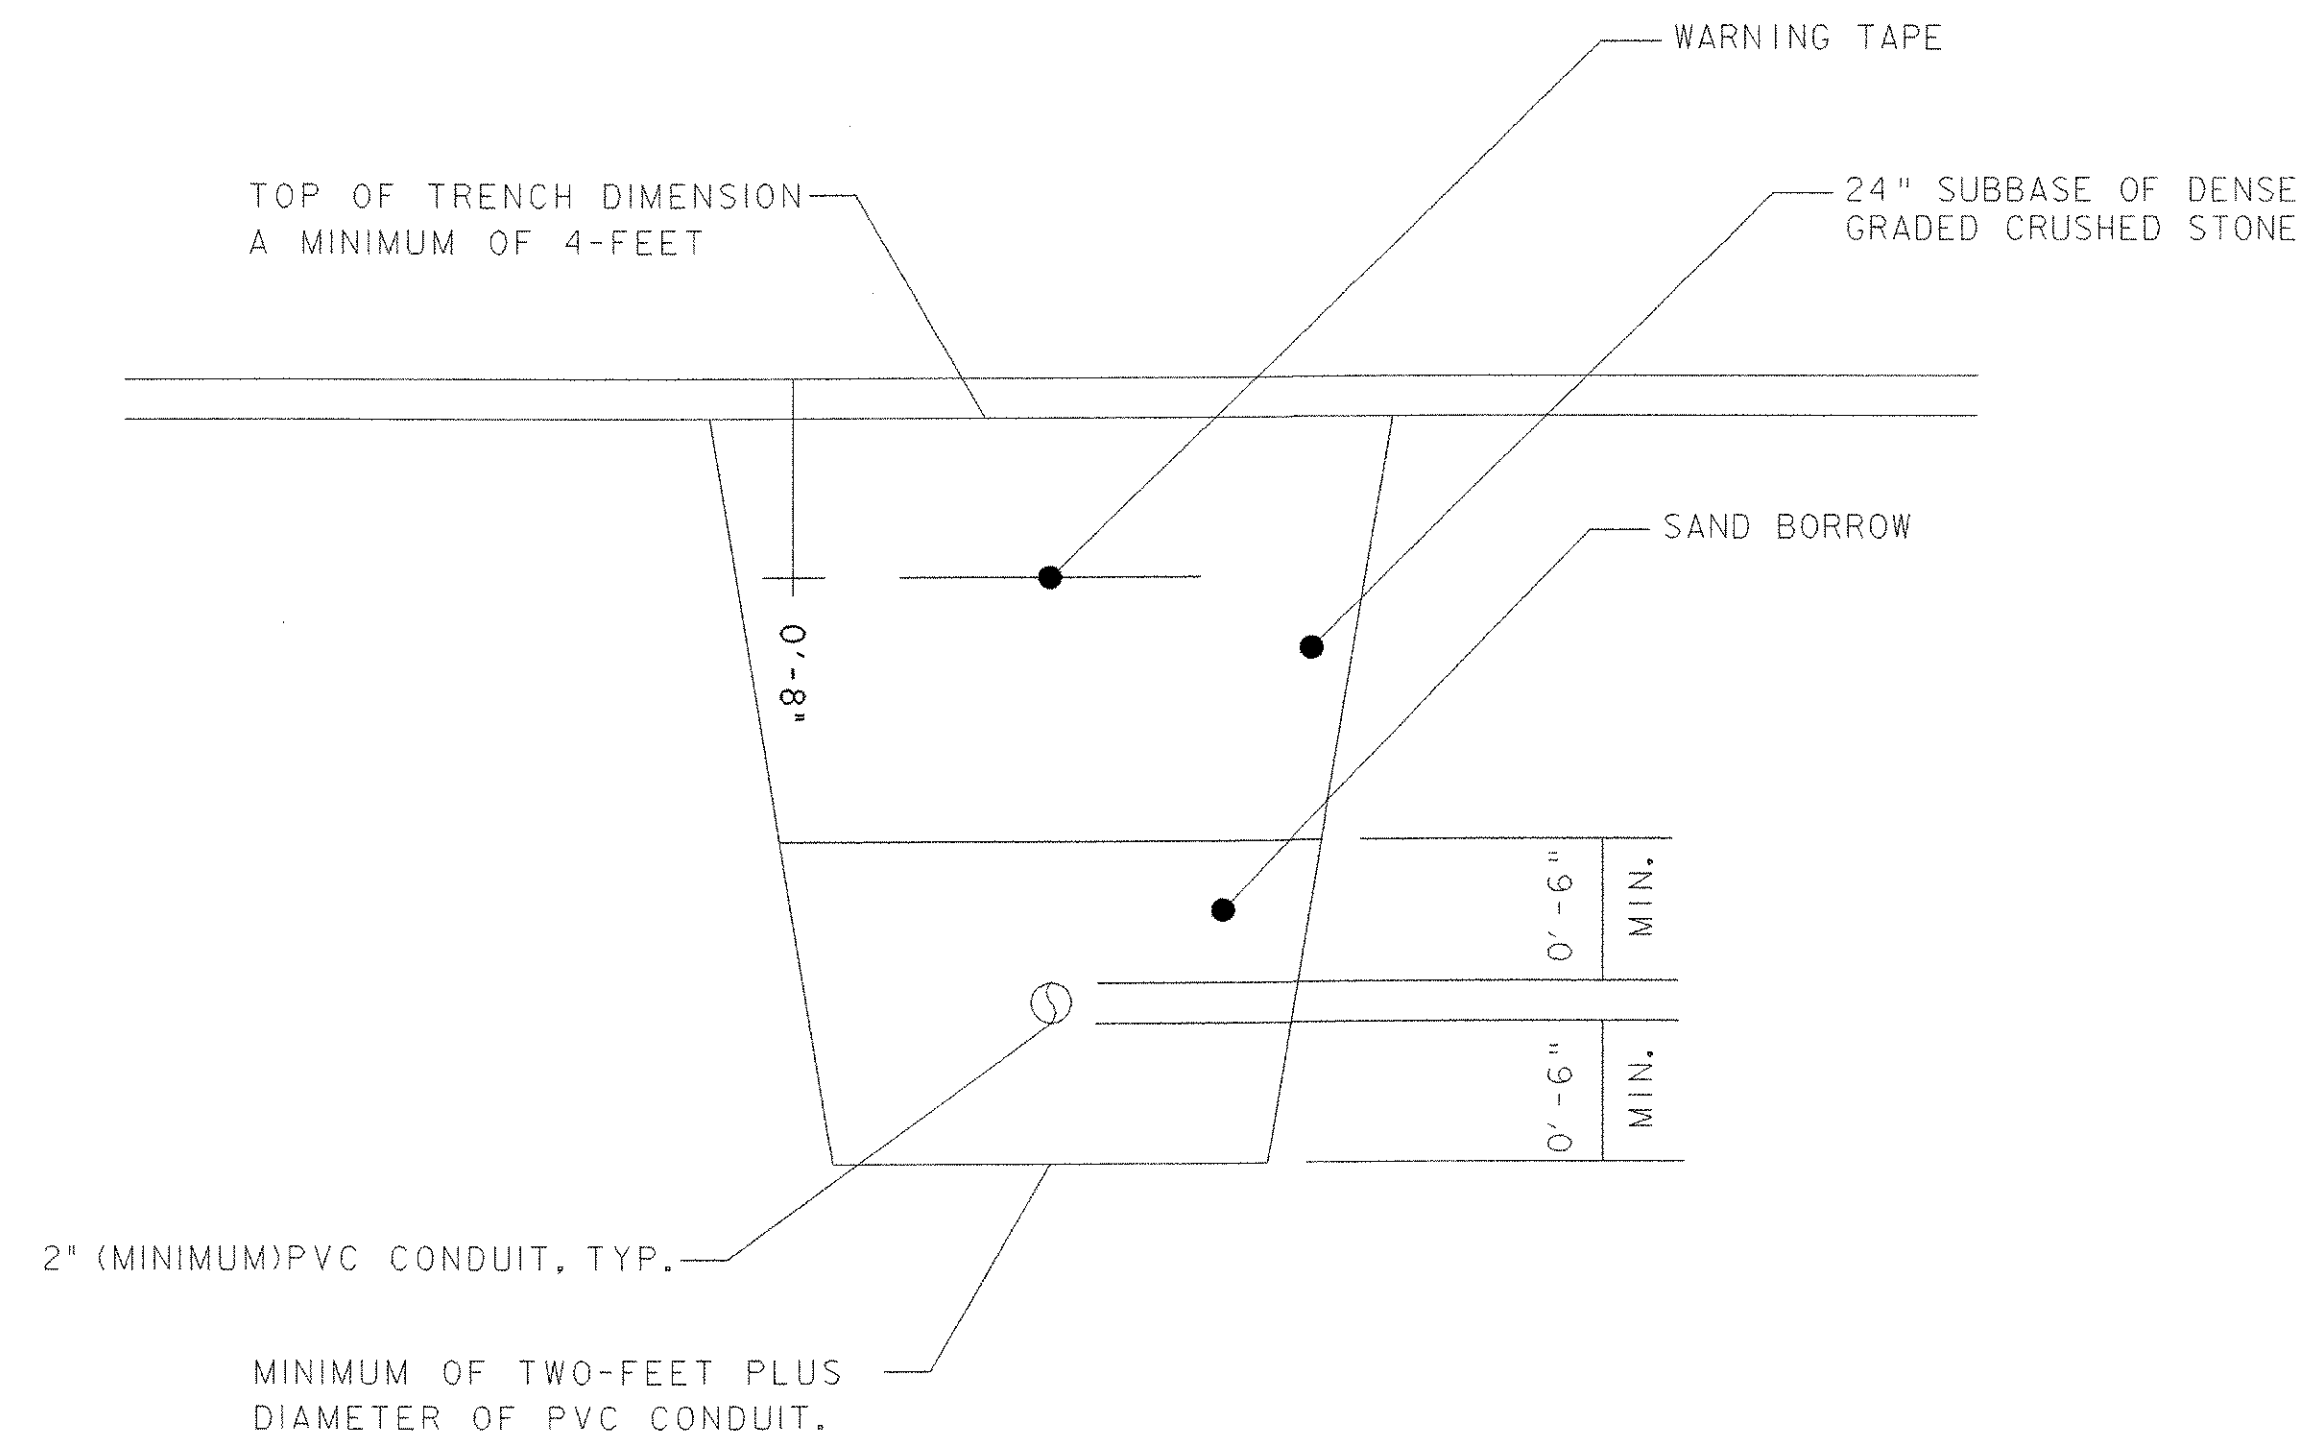

CONDUIT TRENCH DETAIL

NOT TO SCALE

| | |
|----------------------------------|------------------------|
| PROJECT NAME: WILLISTON | |
| PROJECT NUMBER: IM 089-2(35) | |
| FILE NAME: I8800F4TS03.dgn | PLOT DATE: 14-JUN-2005 |
| PROJECT LEADER: EPD | DRAWN BY: JDA / PGJ |
| DESIGNED BY: JDA | CHECKED BY: EPD |
| SIGN ACTUATION NOTES AND DETAILS | SHEET 56 OF 76 |

EROSION CONTROL NARRATIVE

1.1 DESCRIPTION OF PROJECT

THIS PROJECT CONSISTS OF LENGTHENING THE EXISTING INTERSTATE 89 (I-89) SOUTHBOUND EXIT 12 OFF-RAMP (RAMP C) AND WIDENING THIS RAMP TO PROVIDE AN ADDITIONAL TRAVEL LANE. ADDITIONAL WORK INCLUDES NEW SIGNS, GUARDRAIL, AND ASSOCIATED SLOPE WORK. THIS PROJECT MAINTAINS THE EXISTING ALIGNMENT.

THE PROJECT IS LOCATED ON I-89 SOUTHBOUND AND BEGINS AT MILEMARKER 84.24. THE PROJECT EXTENDS SOUTHEASTERLY A DISTANCE OF 1,943 FEET DOWN THE EXIT 12 SOUTHBOUND RAMP. PRIOR TO CONSTRUCTION, TRAFFIC CONTROL WILL INCLUDE BLOCKING OFF THE RIGHT TRAVEL LANE OF I-89 SOUTHBOUND PRIOR TO THE PROJECT AREA USING TEMPORARY TRAFFIC BARRIERS. TEMPORARY TRAFFIC BARRIERS WILL ALSO BE PLACED ALONG THE LEFT SIDE OF THE EXISTING RAMP (NORTH SIDE) TO ALLOW FOR CONSTRUCTION ON THIS SIDE OF THE RAMP. THIS PROJECT IS EXPECTED TO LAST ONE CONSTRUCTION SEASON.

THE MATERIAL TO BE EXCAVATED FROM THE SITE WILL INCLUDE COLD PLANING OF EXISTING BITUMINOUS CONCRETE PAVEMENT SURFACE ALONG THE EXISTING RAMP AND FULL DEPTH CONSTRUCTION ALONG PORTIONS WHERE WIDENING OCCURS. STOCKPILING OF ANY EXCAVATED MATERIAL TO BE REUSED IS EXPECTED TO TAKE PLACE WITHIN THE PROJECT LIMITS OF THE PAVEMENT RESURFACING PROJECT FOR THE I-89 MAINLINE. LIKEWISE, STOCKPILING OF ANY NEW MATERIAL TO BE USED IS EXPECTED TO TAKE PLACE WITHIN THE PROJECT LIMITS. THE LIMIT OF CONSTRUCTION AND ASSOCIATED MAXIMUM SOIL DISTURBANCE AREA FOR THIS PROJECT IS APPROXIMATELY 2.0 ACRES.

THE ONLY EXISTING ENVIRONMENTAL RESOURCE ELEMENT IN THE VICINITY OF THE PROJECT IS A WETLAND ON THE RIGHT SIDE (SOUTH SIDE) OF THE OFF-RAMP. THIS WETLAND IS NOT BEING IMPACTED AS PART OF THIS PROJECT.

1.2 SITE INVENTORY AND ANALYSIS

1.2.1 OFFSITE DRAINAGE CHARACTERISTICS

THIS PROJECT SITE IS LOCATED IN AN URBAN, HIGHLY TRAVELED AREA IN THE TOWN OF WILLISTON. THE AREA TO THE SOUTH OF THE PROJECT AREA IS MODERATELY SLOPED AND DEVELOPED TO THE NORTH. ESTABLISHED VEGETATION AND TREE LINE EXISTS ON THE SOUTH SIDE OF THE PROJECT AREA. ON THE NORTH SIDE OF THE PROJECT AREA IS THE I-89 MAINLINE AND BRIDGE OVER VT ROUTE 2A. RUNOFF FROM THE PROJECT AREA DRAINS INTO A 48-INCH DIAMETER CULVERT UNDER THE I-89 MAINLINE.

1.2.2 DRAINAGE, WATERWAYS, BODIES OF WATER

THERE ARE NO WATERWAYS WITHIN THE PROJECT AREA. DRAINAGE STRUCTURES ARE LOCATED WITHIN THE PROJECT AREA TO COLLECT RUNOFF FROM I-89 AND THE I-89 EXIT 12 SOUTHBOUND OFF-RAMP.

1.2.3 TOPOGRAPHY, EXISTING ROADS, BUILDINGS, UTILITIES

THE TOPOGRAPHY OF THE PROJECT AREA CONSISTS OF MODERATE SLOPES. THERE ARE NO BUILDINGS WITHIN THE PROJECT AREA. SIGNAL EQUIPMENT, INCLUDING MAST ARMS, PULL BOX AND OTHER SIGNAL EQUIPMENT IS LOCATED AT THE INTERSECTION WITH VT ROUTE 2A. THERE ARE NO OTHER KNOWN UTILITIES WITHIN THE PROJECT AREA.

1.2.4 VEGETATION

THE PROJECT AREA OUTSIDE OF I-89 TRAVEL LANES CONSISTS OF GRASSED SIDE-SLOPES WITH TREES NEAR THE RIGHT-OF-WAY FENCE. IMPACTS TO VEGETATED AREAS WILL BE LIMITED TO THE SIDE SLOPES OF THE ROAD AND SLOPE WORK ON THE OUTSIDE OF DITCHES ALONG THE SOUTH SIDE OF THE INTERSTATE AND THE NORTH SIDE OF THE OFF-RAMP. FOLLOWING THE COMPLETION OF CONSTRUCTION, THE GRASSY VEGETATION WILL BE RE-ESTABLISHED USING STANDARD SEED AND MULCH PRACTICES.

1.2.5 SOILS

THE NATURAL RESOURCES CONSERVATION SERVICE (NRCS) HAS MAPPED THE SOILS THROUGHOUT CHITTENDEN COUNTY. SOIL TYPES IDENTIFIED FOR THIS PROJECT INCLUDE PERU EXTREMELY STONY LOAM, CABOT EXTREMELY STONY SILT LOAM, PERU STONY LOAM, SCANTIC SILT LOAM, AND MUNSON AND RAYNHAM SILT LOAMS. ALL OF THESE SOILS ARE POTENTIALLY HIGHLY ERODIBLE. SOILS HAVE BEEN PREVIOUSLY DISTURBED WITH THE CONSTRUCTION OF THE INTERSTATE AND OFF-RAMP.

1.2.6 SENSITIVE RESOURCE AREAS

THERE IS A WETLAND ON THE SOUTH SIDE OF THE OFF-RAMP. THIS WETLAND IS NOT BEING IMPACTED WITH THIS PROJECT. RESULTS OF AN ARCHEOLOGICAL ASSESSMENT INDICATED LIMITED CONCERNS FOR HISTORIC ARCHEOLOGICAL FEATURES ALONG THE RIGHT-OF-WAY FENCE AT THE OFF-RAMP. THIS ASSESSMENT INDICATED A BUFFER OF 16.4-FEET FROM THE FENCE LINE AT THE OFF-RAMP IS SUFFICIENT TO PROTECT ANY ARCHEOLOGICALLY SENSITIVE LOCATIONS ON THIS RAMP. THERE ARE THREE STATEWIDE (B) SOIL TYPES ALONG THE OFF-RAMP. SOILS IN THIS VICINITY HAVE BEEN PREVIOUSLY DISTURBED WITH THE CONSTRUCTION OF I-89 AND THE OFF-RAMP. THERE ARE NO OTHER CRITICAL HABITATS OR THREATENED AND ENDANGERED SPECIES WITHIN THE PROJECT AREA.

1.2.7 PROXIMITY TO NATURAL OR MAN-MADE WATER FEATURES

THE ONLY WATER FEATURES WITHIN THE PROJECT AREA INCLUDE DITCHES ALONG THE TOE OF SLOPE TO CARRY RUNOFF FROM I-89 AND THE OFF-RAMP. THESE DITCHES CARRY WATER TO AN EXISTING 48-INCH DIAMETER CULVERT UNDER I-89. THIS EROSION PREVENTION AND SEDIMENT CONTROL PLAN CONTAINS MEASURES TO PREVENT THE MOBILIZATION AND TRANSPORT OF SEDIMENT INTO DITCHES AND CULVERTS WITHIN THE PROJECT AREA.

1.3 TEMPORARY EROSION PREVENTION AND SEDIMENT CONTROL

PROJECT DEMARCATION FENCE SHALL BE INSTALLED TO DELINEATE THE LIMITS THE CONTRACTOR CAN ACCESS WITH CONSTRUCTION EQUIPMENT. THIS MEASURE LIMITS THE AREA THAT CAN BE DISTURBED AND EXPOSED TO EROSION.

TO MINIMIZE THE POTENTIAL FOR STORM WATER RUNOFF TO TRANSPORT SEDIMENT, SEVERAL KEY EROSION CONTROL DEVICES AND GENERAL PRACTICES WILL BE USED. DETAILS OF THE DEVICES AND THE LOCATION OF THEIR PLACEMENT CAN BE FOUND IN THE EROSION CONTROL PLANS AND DETAILS.

SILT FENCE, AS SHOWN ON THE EROSION AND SEDIMENT CONTROL PLAN, SHALL BE PLACED PARALLEL TO, OR ALONG, THE CONTOUR, SO THE STORM WATER WILL RUN PERPENDICULAR TO THE SILT FENCE. THE ENDS SHALL BE "J" HOOKED UP GRADIENT TO CREATE A PONDING EFFECT FOR WATER TRYING TO RUN ALONG THE FENCE AND AROUND THE ENDS.

EACH CATCH BASIN SHALL RECEIVE TEMPORARY SILT FENCE PROTECTION (UNPAVED AREAS). INLETS AND OUTLETS OF CULVERTS WITHIN THE PROJECT AREA SHALL RECEIVE TEMPORARY ROCK BARRIER PROTECTION. THESE TEMPORARY MEASURES SHALL BE CONSTRUCTED IN ACCORDANCE WITH THE DETAILS IN THESE PLANS.

TEMPORARY STONE CHECK DAMS WILL BE PLACED ALONG DITCHES IN THE VICINITY OF THE PROJECT AREA. THE TEMPORARY STONE CHECK DAMS WILL REDUCE THE VELOCITIES OF THE WATER, ALLOWING SEDIMENT TO SETTLE AND REDUCE THE POTENTIAL FOR EROSION.

EROSION MATTING WILL BE PLACED ON SLOPES STEEPER THAN 3H:1V. MATTING WILL REDUCE SEDIMENT TRANSPORT FROM THE SIDE SLOPES, AS IT WILL SLOW DOWN THE RAIN PARTICLES AND ALLOW FOR RAIN TO DISSIPATE INTO THE SOIL, RATHER THAN FLOWING INTO THE CONSTRUCTION AREA. THESE TEMPORARY MEASURES SHALL BE CONSTRUCTED IN ACCORDANCE WITH THE DETAILS IN THESE PLANS.

THE EROSION CONTROL MEASURES SHALL BE PERIODICALLY INSPECTED AND MAINTAINED ON A REGULAR BASIS. INSPECTION OF THE EROSION CONTROL MEASURES SHALL TAKE PLACE BEFORE AND AFTER MAJOR STORM EVENTS TO INSURE THEY ARE IN GOOD CONDITION AND TO REMOVE EXCESSIVE BUILDUP OF SILT AND DEBRIS AFTER THE STORM EVENTS. A REPORT ON THE EFFECTIVENESS OF THE EROSION CONTROL MEASURES SHALL BE PRESENTED TO THE RESIDENT ENGINEER AND ONSITE COORDINATOR UPON THE COMPLETION OF EACH INSPECTION. MODIFICATIONS OR IMPROVEMENTS TO THE EROSION CONTROL PLAN SHOULD BE COORDINATED WITH THE RESIDENT ENGINEER AND ONSITE COORDINATOR.

ALL EROSION CONTROL MEASURES SHALL BE PLACED IN ACCORDANCE WITH THE EROSION CONTROL DETAILS IN THESE PLANS.

STAGING AND STOCKPILING AREAS WILL BE LOCATED ALONG THE I-89 MAINLINE PROJECT, (M 089-2(36)). THESE AREAS WILL BE COMPLETELY WITHIN THE PROJECT LIMITS AND WILL UTILIZE THE AFOREMENTIONED TEMPORARY EROSION CONTROL MEASURES. NO ADDITIONAL TEMPORARY EROSION CONTROL MEASURES WILL BE NEEDED.

IN THE EVENT THAT A SEPARATE OR TEMPORARY STOCKPILE AREA IS USED OUTSIDE THE LIMITS OF CONSTRUCTION, A STABILIZED CONSTRUCTION ENTRANCE SHALL BE CONSTRUCTED IN ACCORDANCE WITH THESE PLANS. THE CONSTRUCTION ENTRANCE SHALL BE APPROVED BY THE RESIDENT ENGINEER AND ONSITE COORDINATOR.

SEE EROSION CONTROL DETAILS FOR PAY ITEMS OF TEMPORARY EROSION CONTROL MEASURES.

1.4 FINAL EROSION CONTROL MEASURES

STONE FILL, TYPE II, WILL BE PLACED ALONG ALL SLOPES STEEPER THAN 2H:1V.


ALL DISTURBED AREA OUTSIDE OF THE ROADWAY SHALL RECEIVE TOPSOIL, SEED AND MULCH TO REESTABLISH GRASS AND VEGETATION. TOPSOILING, SEEDING AND MULCHING SHALL BE IN ACCORDANCE WITH THE SEEDING FORMULA FOR RURAL AREAS AND ASSOCIATED NOTES AS SHOWN IN THE CONTRACT PLANS. THIS SHALL BE COMPLETED IMMEDIATELY FOLLOWING FINAL GRADING.

GENERAL EROSION CONTROL NOTES

1. THE CONTRACTOR SHALL SUBMIT AN EROSION PREVENTION & SEDIMENT CONTROL PLAN AT THE PRE-CONSTRUCTION CONFERENCE WITH A SCHEDULE OF EVENTS. THIS PLAN WILL BE SITE SPECIFIC.
2. THE CONTRACTOR SHALL DESIGNATE THE RESPONSIBILITIES FOR IMPLEMENTING THE EROSION PREVENTION & SEDIMENT CONTROL PLAN TO ONE INDIVIDUAL. THE CONTRACTOR SHALL ENSURE THAT ALL WORKERS UNDERSTAND THE MAJOR PROVISIONS OF THE EROSION PREVENTION & SEDIMENT CONTROL PLAN. PHYSICALLY MARK OFF LIMITS OF NECESSARY ON-SITE LAND DISTURBANCE WITH CONSTRUCTION BARRIER FENCING AND REVIEW WITH WORKERS AND SUBCONTRACTORS SO THAT ALL WORKERS CAN SEE THE AREAS TO BE PROTECTED.
3. TEMPORARY EROSION CONTROL MEASURES ARE REQUIRED THROUGHOUT THE CONSTRUCTION PERIOD AND UNTIL THE PROJECT HAS BEEN COMPLETED. INSTALL PERIMETER SILT FENCE PRIOR TO CLEARING AND GRUBBING AND INSTALL NECESSARY EROSION AND SEDIMENT CONTROL PRACTICES AS WORK TAKES PLACE.
4. EROSION CONTROL MEASURES SHALL BE PERIODICALLY INSPECTED TO ENSURE THEY ARE IN GOOD CONDITION AND THAT AN EXCESSIVE BUILDUP OF SILT AND DEBRIS HAS NOT OCCURRED.
5. THE CONTRACTOR SHALL MINIMIZE THE AMOUNT OF DISTURBED SOIL EXPOSED TO EROSION FROM WIND AND WATER BY USING VEGETATIVE AND STRUCTURAL CONTROLS AND PROPER TIMING AND SEQUENCING OF CONSTRUCTION ACTIVITIES.
6. IF NEEDED, DIVERT OFF-SITE STORMWATER RUNOFF FROM HIGHLY ERODIBLE AREAS AND STEEP SLOPES AND CONVEY OFF-SITE STORMWATER RUNOFF TO STABLE AREAS.
7. APPLY TEMPORARY OR PERMANENT SOIL STABILIZATION MEASURES IMMEDIATELY ON ALL DISTURBED AREAS WHERE WORK IS DELAYED OR COMPLETED.
8. ANY EARTH STOCKPILES SHALL BE PROTECTED BY A SILT FENCE AT THE PERIMETER AND COVERED WITH A BLANKET OF MULCH.
9. EROSION CHECKS SHALL BE INSTALLED AS INDICATED AND WHERE DESIGNATED ON THE DRAWINGS AND AS NECESSARY TO PREVENT EROSION DAMAGE FROM ANY CONSTRUCTION ACTIVITY.
10. TEMPORARY EROSION CONTROL MEASURES SHALL BE IMMEDIATELY INSPECTED BEFORE AND AFTER RAINFALL EVENTS TO INSURE THEY ARE IN GOOD CONDITION BEFORE RAINFALL AND TO REMOVE EXCESSIVE BUILDUP OF SILT AND DEBRIS AFTER THE STORM EVENT.
11. ALL EROSION CONTROL MEASURES SHALL COMPLY WITH STANDARD VERMONT AGENCY OF NATURAL RESOURCES PERMIT, THE "VERMONT HANDBOOK FOR EROSION PREVENTION AND SEDIMENT CONTROL" DATED 2003, SHALL BE UTILIZED AS A GUIDE FOR THE CONTROL OF EROSION ON THE SITE. THE CONTRACTOR SHALL BE FAMILIAR WITH THE STANDARDS AND SPECIFICATIONS IN THIS PUBLICATION.
12. EROSION MATTING SHALL BE INSTALLED IN PLACE OF MULCH FOR ANY AREAS NOT SEEDED AND MULCHED BY OCTOBER 1 OF THE CONSTRUCTION YEAR.
13. ANY EROSION CONTROL MEASURES THAT WILL BE NECESSARY DURING THE WINTER CONSTRUCTION PERIOD (OCTOBER 15 TO MAY 10) SHALL BE INSTALLED BEFORE THE GROUND FREEZES AND FREQUENTLY INSPECTED AND MAINTAINED THROUGHOUT THE WINTER.
14. EROSION MEASURES SHALL REMAIN IN PLACE UNTIL PERMANENT EROSION CONTROL MEASURES HAVE BEEN ESTABLISHED AND APPROVED BY THE RESIDENT ENGINEER.
15. UNLESS OTHERWISE NOTED IN THE PLANS, ALL MATERIALS, INSTALLATION, MAINTENANCE AND REMOVAL OF THOSE EROSION CONTROL MEASURES WHICH ARE ITEMS IN THE CONTRACT WILL BE PAID FOR AT THE APPROPRIATE CONTRACT UNIT PRICE BID. ALL MATERIALS, INSTALLATION, MAINTENANCE AND REMOVAL FOR ALL OTHER EROSION CONTROL ITEMS REQUIRED BY THE PLANS AND THE RESIDENT ENGINEER WILL BE PAID FOR UNDER ITEM 652.30.

PROJECT NAME: WILLISTON
PROJECT NUMBER: IM 089-2(35)

| | |
|-----------------------------|------------------------|
| FILE NAME: 18800F4ECP01.dgn | PLOT DATE: 17-MAY-2005 |
| PROJECT LEADER: EPD | DRAWN BY: JDA / PGJ |
| DESIGNED BY: JDA | CHECKED BY: EPD |
| EROSION CONTROL NARRATIVE | SHEET 57 OF 76 |

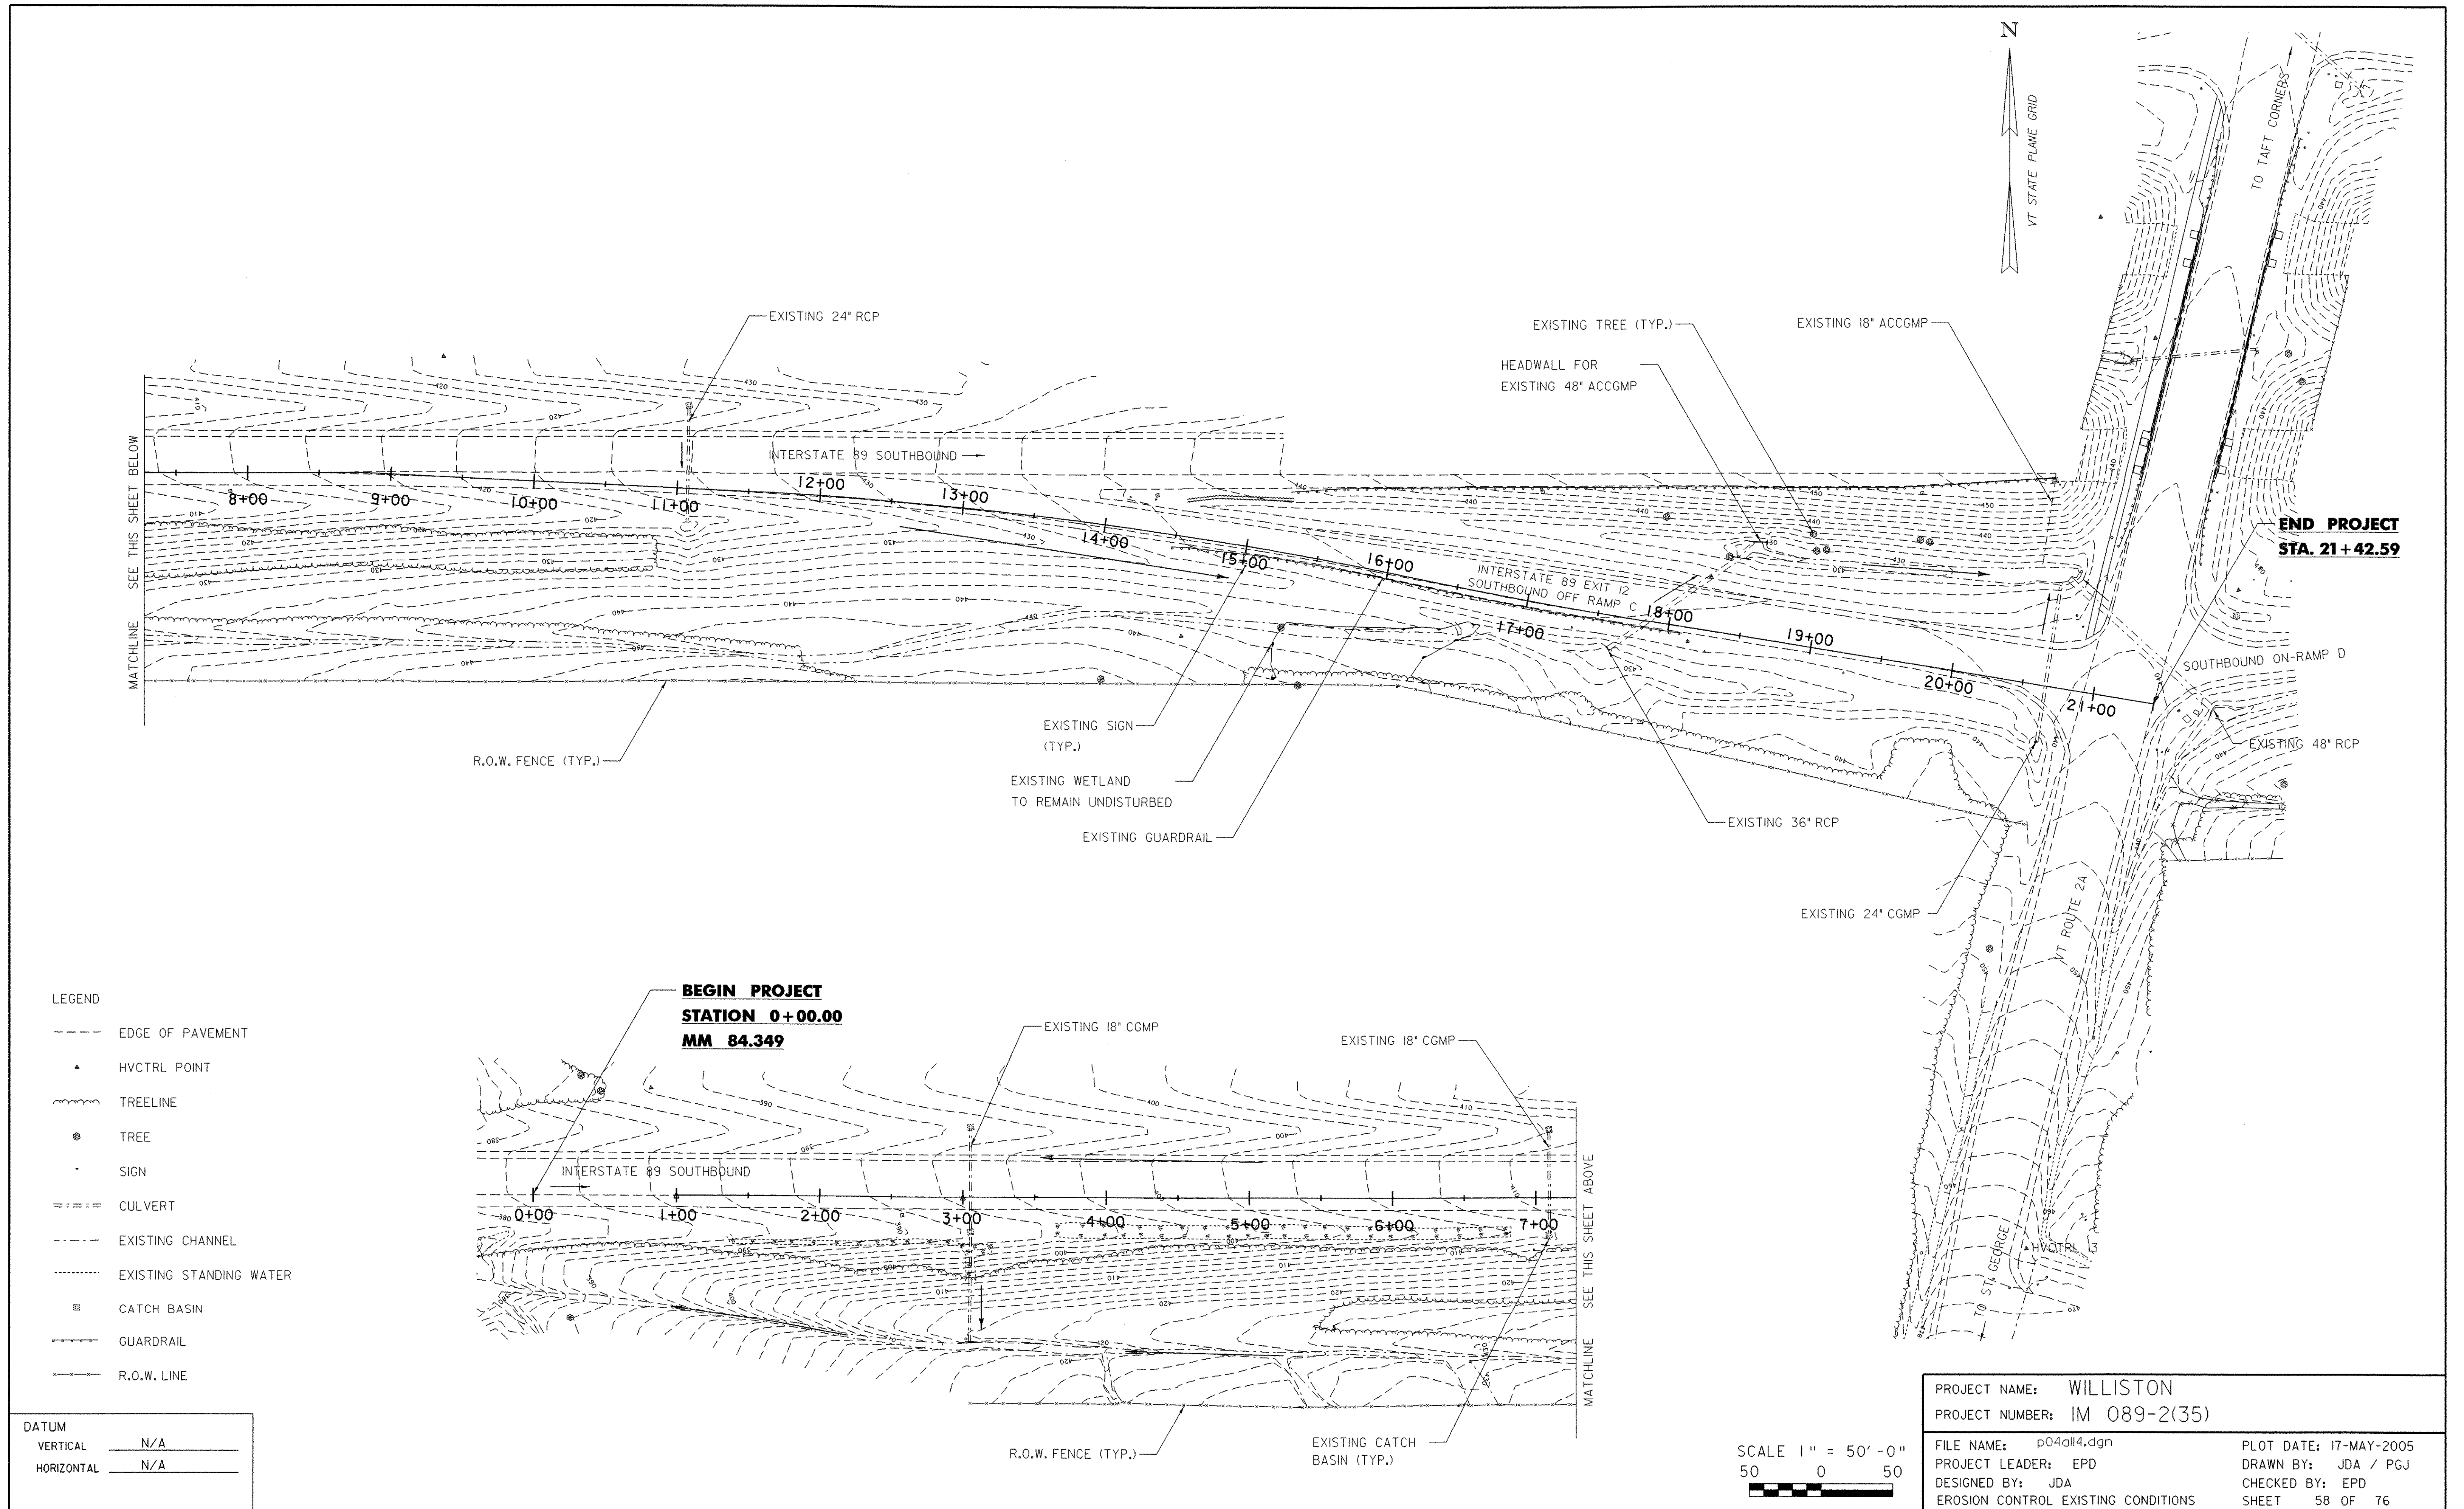

SEE THIS SHEET BELOW
MATCHLINE

MATCHLINE SEE THIS SHEET ABOVE


- LEGEND
- EDGE OF PAVEMENT
 - ▲ HVCTRL POINT
 - ~ TREELINE
 - ⊙ TREE
 - SIGN
 - === CULVERT
 - - - EXISTING CHANNEL
 - EXISTING STANDING WATER
 - ⊞ CATCH BASIN
 - GUARDRAIL
 - R.O.W. LINE


| | |
|------------|-----|
| DATUM | |
| VERTICAL | N/A |
| HORIZONTAL | N/A |

**BEGIN PROJECT
STATION 0+00.00
MM 84.349**

**END PROJECT
STA. 21+42.59**


| | | |
|-------------------------------------|--------------|------------------------|
| PROJECT NAME: | WILLISTON | |
| PROJECT NUMBER: | IM 089-2(35) | |
| FILE NAME: | p04d14.dgn | PLOT DATE: 17-MAY-2005 |
| PROJECT LEADER: | EPD | DRAWN BY: JDA / PGJ |
| DESIGNED BY: | JDA | CHECKED BY: EPD |
| EROSION CONTROL EXISTING CONDITIONS | | SHEET 58 OF 76 |

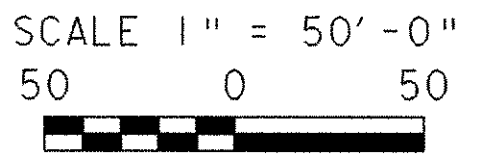

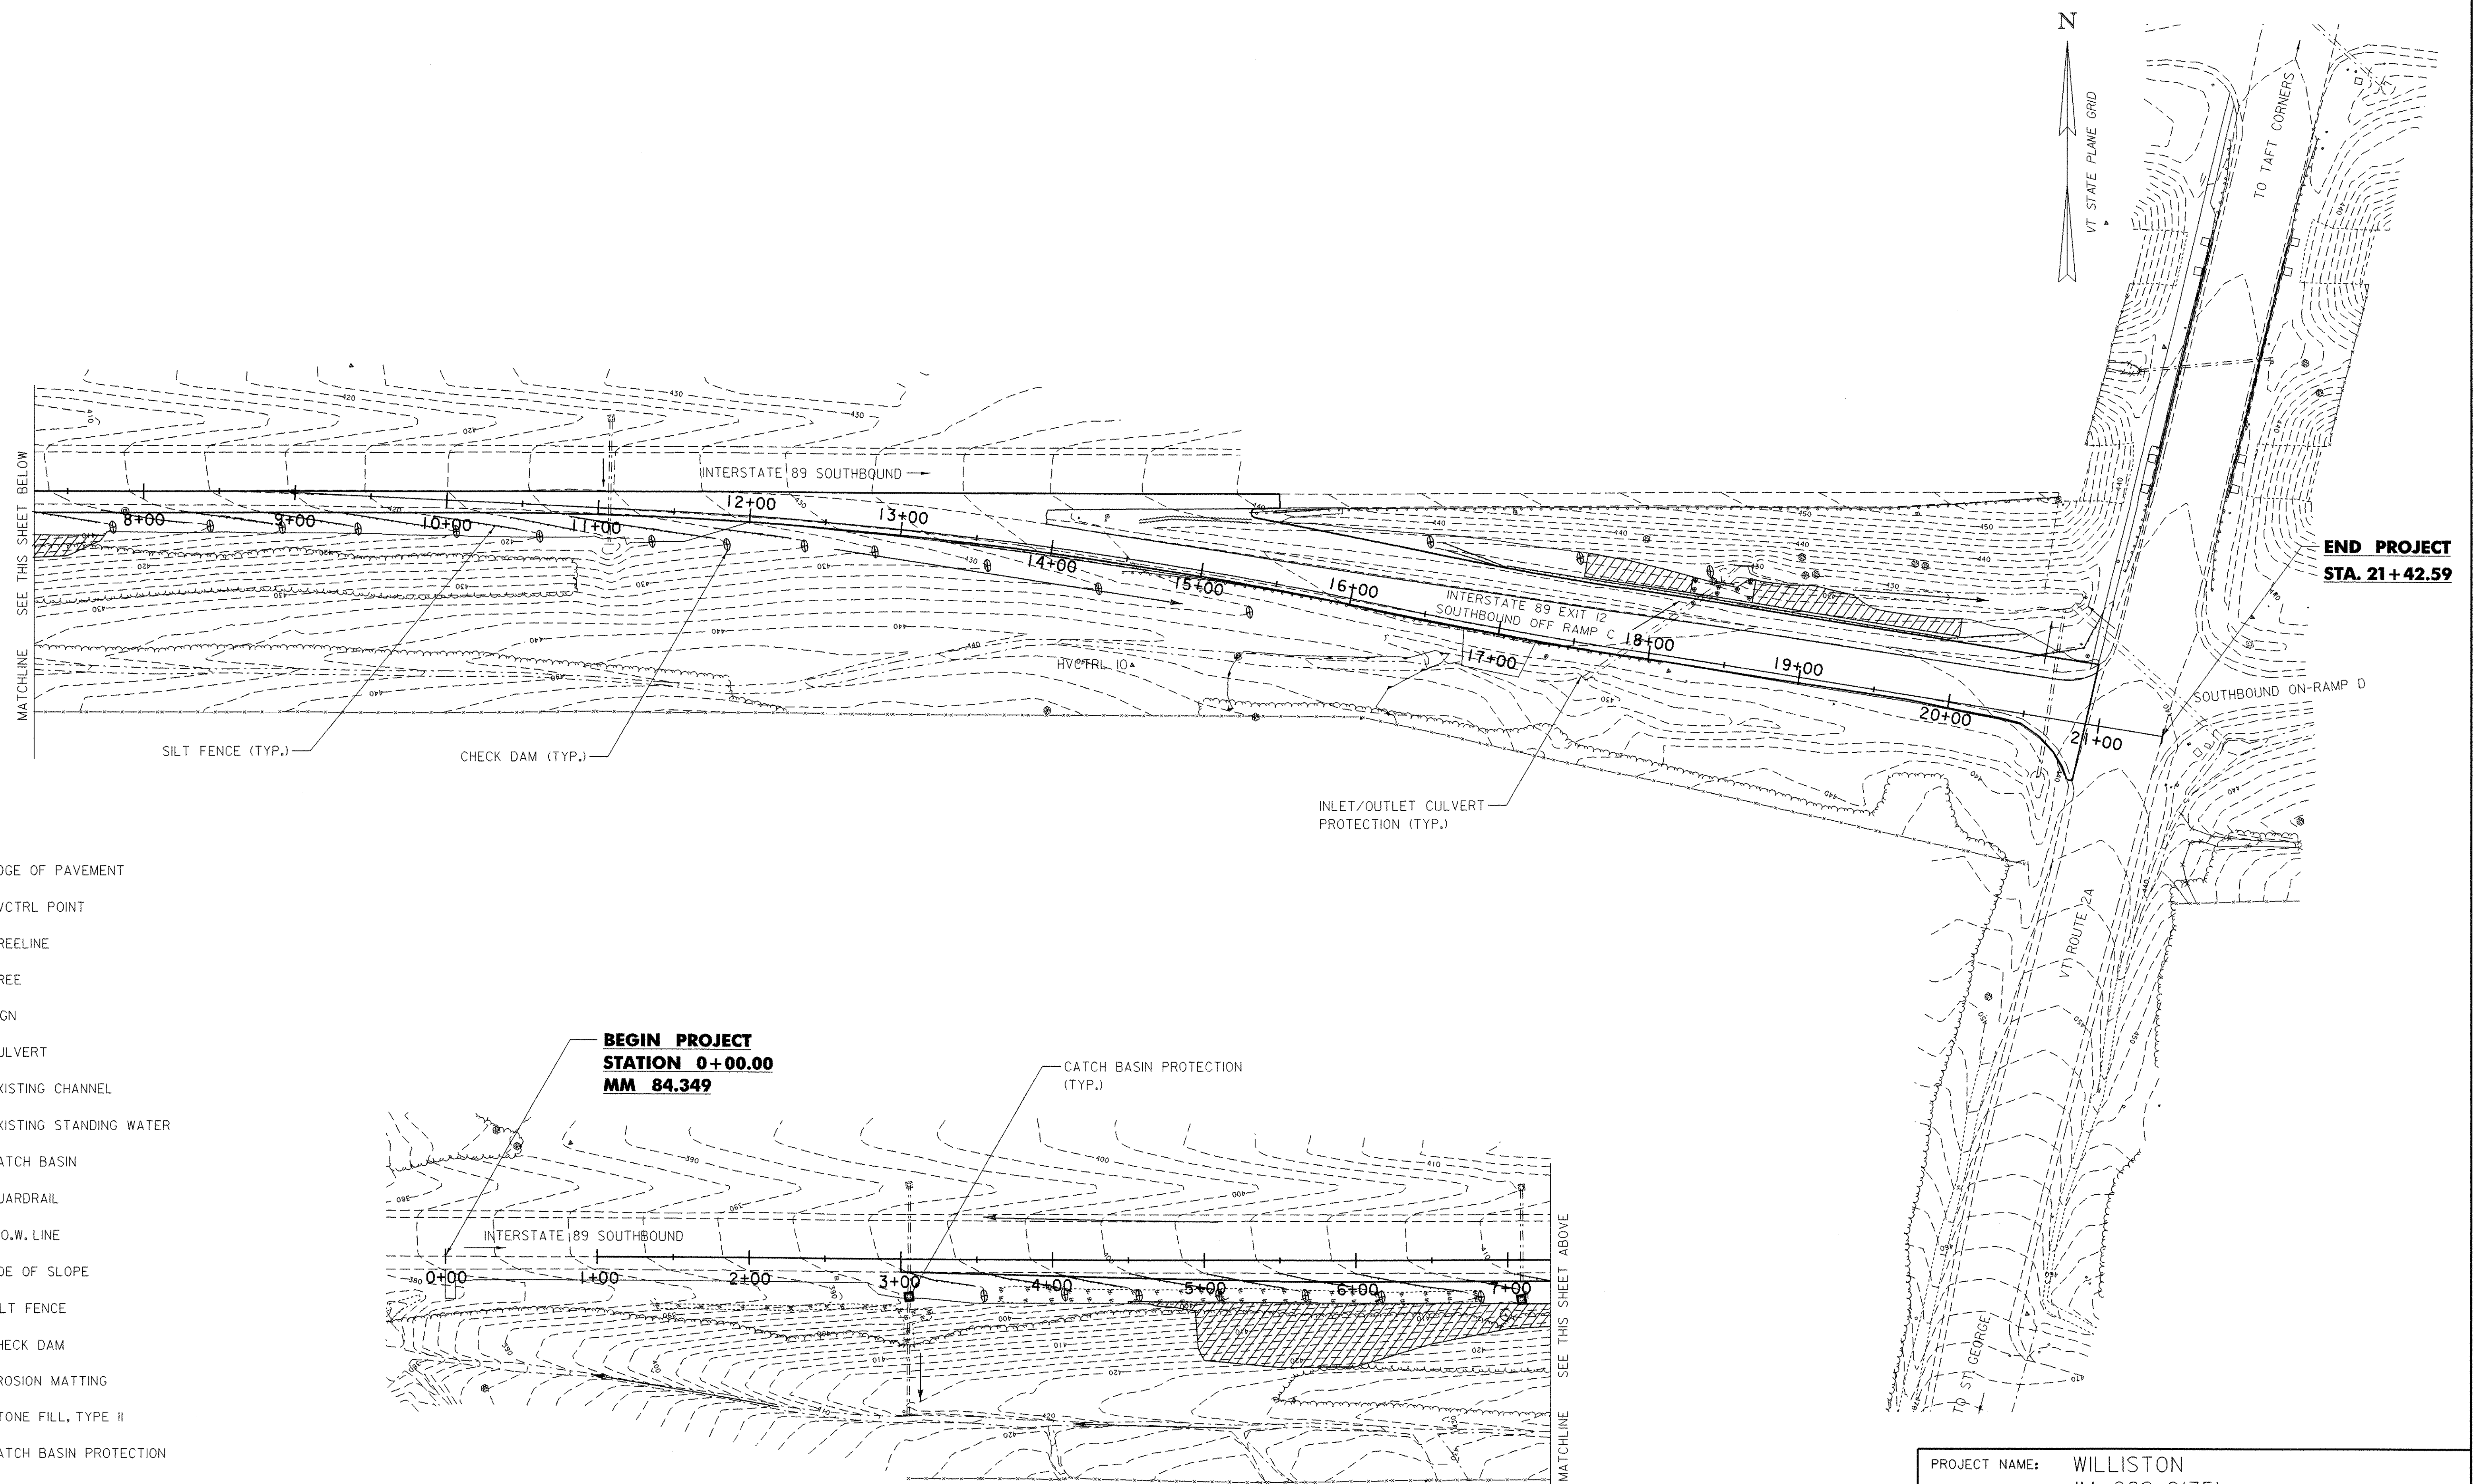


**END PROJECT
STA. 21+42.59**

**BEGIN PROJECT
STATION 0+00.00
MM 84.349**

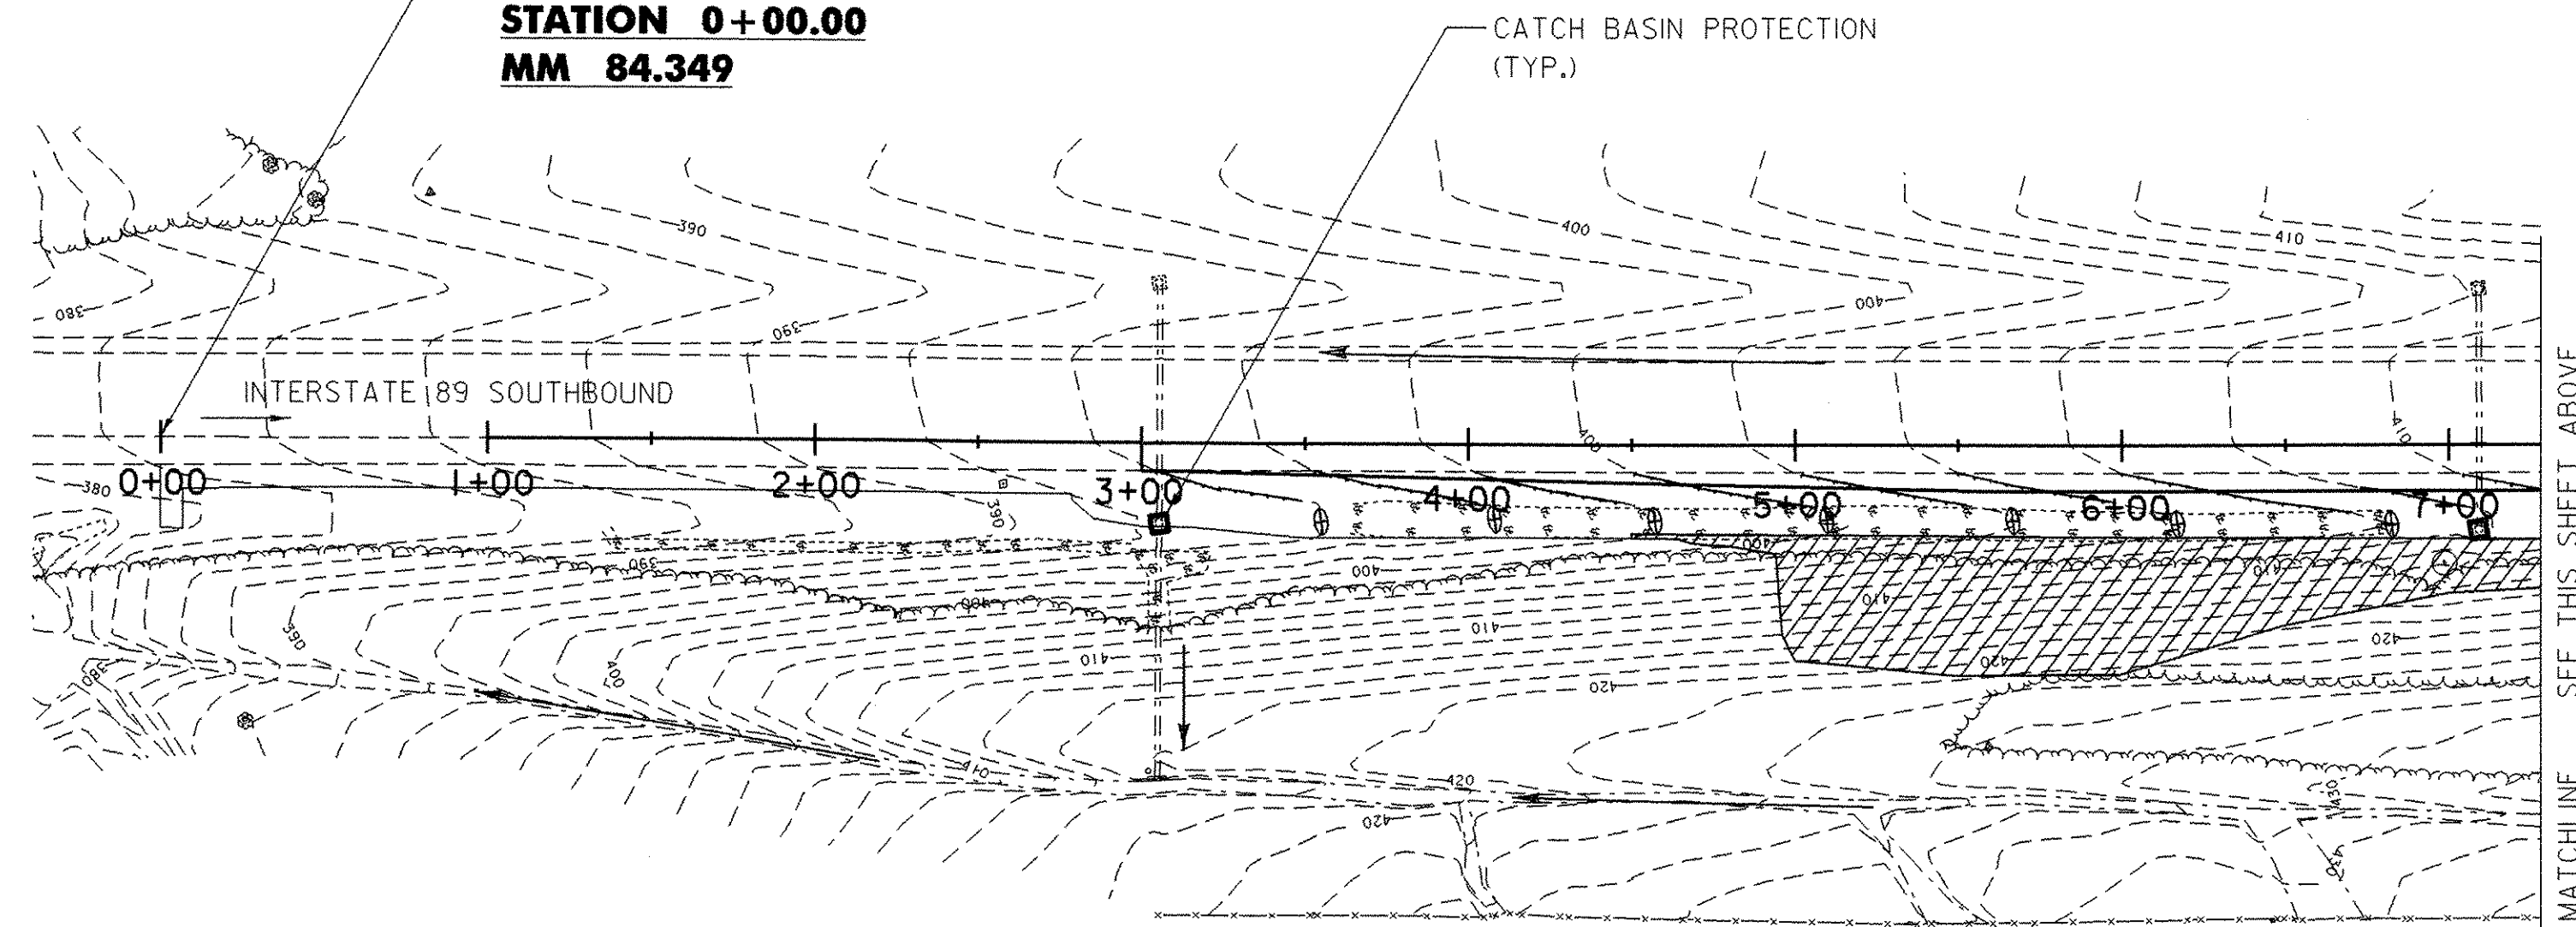

- LEGEND**
- EDGE OF PAVEMENT
 - ▲ HVCTRL POINT
 - TREELINE
 - TREE
 - SIGN
 - === CULVERT
 - EXISTING CHANNEL
 - EXISTING STANDING WATER
 - ▣ CATCH BASIN
 - GUARDRAIL
 - R.O.W. LINE
 - TOE OF SLOPE
 - ... SILT FENCE
 - ⊕ CHECK DAM
 - ▨ EROSION MATTING
 - ▨ STONE FILL, TYPE II
 - ▣ CATCH BASIN PROTECTION


| | |
|--------------|-----|
| DATUM | |
| VERTICAL | N/A |
| HORIZONTAL | N/A |

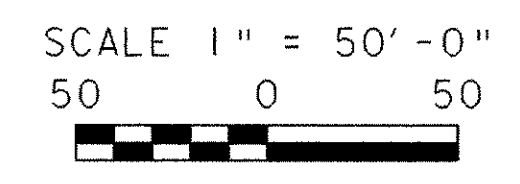

| | | | |
|-----------------|--------------|-----------------------------------|----------------|
| PROJECT NAME: | WILLISTON | PLOT DATE: | 17-MAY-2005 |
| PROJECT NUMBER: | IM 089-2(35) | DRAWN BY: | JDA / PGJ |
| FILE NAME: | p04all4.dgn | CHECKED BY: | EPD |
| PROJECT LEADER: | EPD | DESIGNED BY: | JDA |
| DESIGNED BY: | JDA | EROSION AND SEDIMENT CONTROL PLAN | SHEET 59 OF 78 |

NOTES

1. SEE CROSS SECTION SHEETS FOR DETAILS ON PROPOSED GRADING OF ROADWAYS AND SLOPES.
2. PROPERTY LINES, EXCEPT FOR I-89 RIGHT-OF-WAY FENCE, ARE NOT SHOWN. ALL WORK IS WITHIN I-89 AND VT ROUTE 2A RIGHT-OF-WAY.

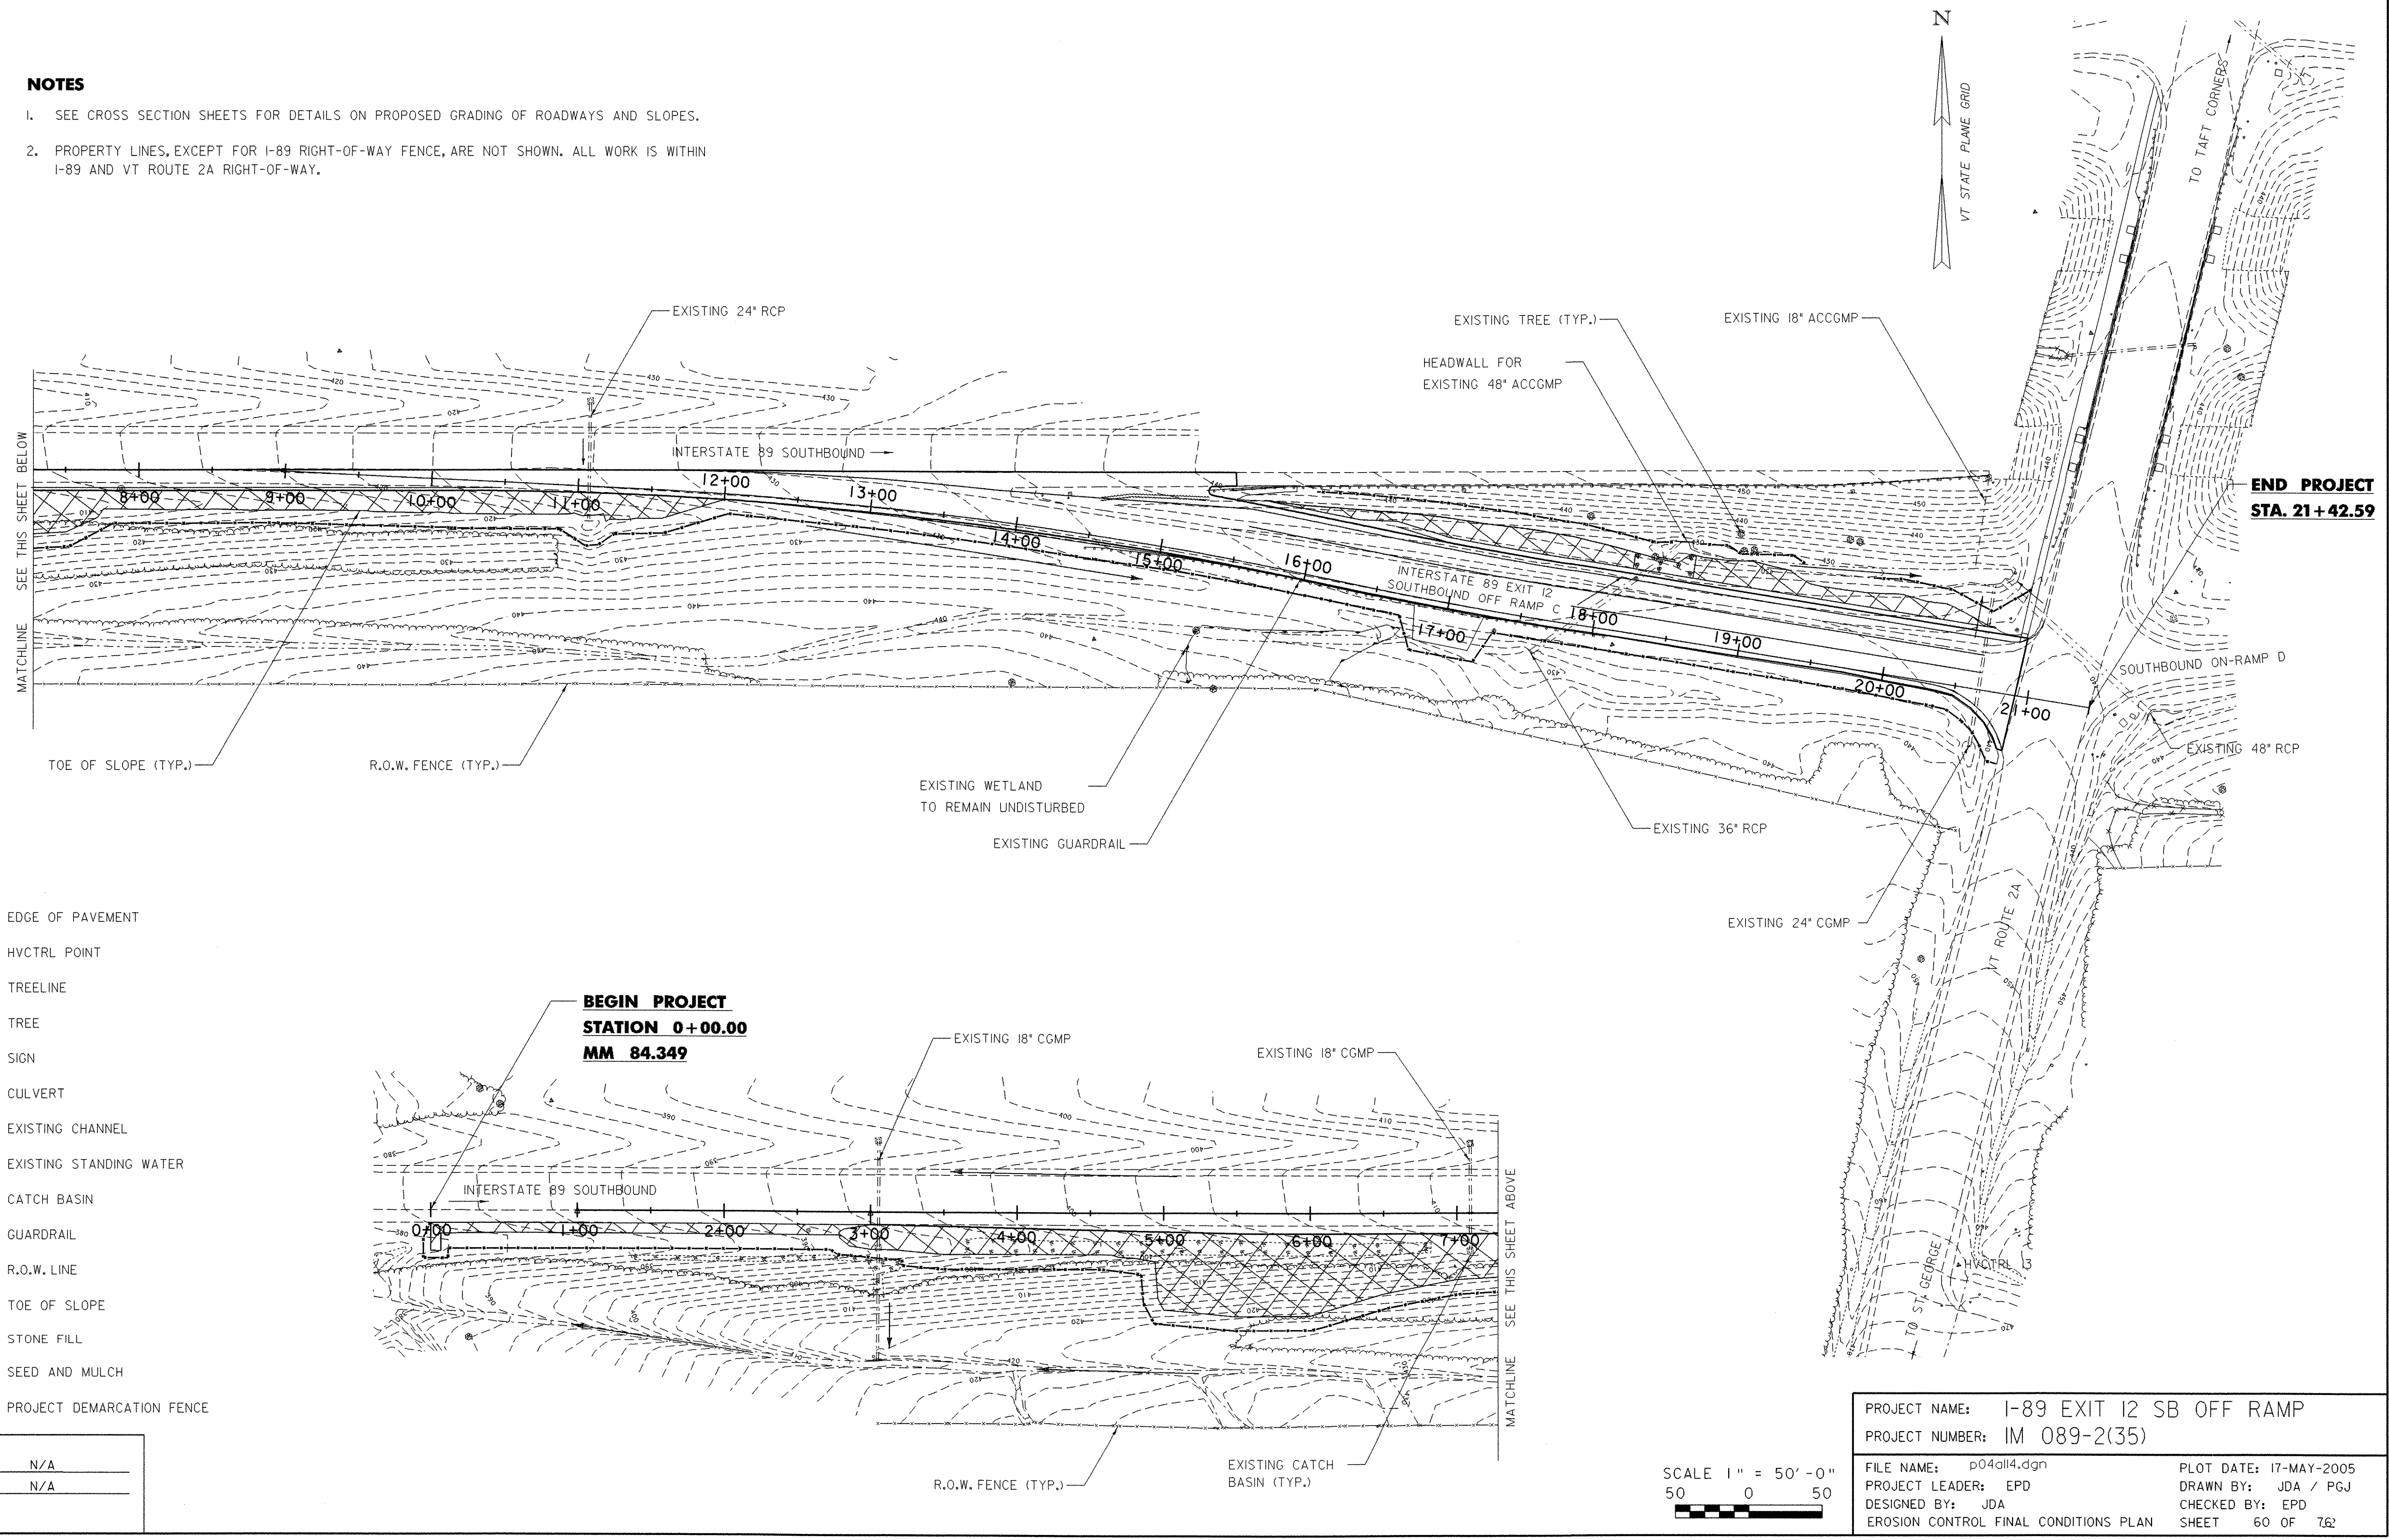


- LEGEND**
- EDGE OF PAVEMENT
 - ▲ HVCTRL POINT
 - TREELINE
 - TREE
 - SIGN
 - === CULVERT
 - - - EXISTING CHANNEL
 - EXISTING STANDING WATER
 - CATCH BASIN
 - GUARDRAIL
 - R.O.W. LINE
 - TOE OF SLOPE
 - STONE FILL
 - SEED AND MULCH
 - PROJECT DEMARCATION FENCE


| | |
|--------------|-----|
| DATUM | |
| VERTICAL | N/A |
| HORIZONTAL | N/A |

| | | | | | | | | |
|-------------------|--------------------------|------------|-------------|-----------------|-----|-----------------|-----|---------------------------------------|
| PROJECT NAME: | I-89 EXIT 12 SB OFF RAMP | FILE NAME: | p04all4.dgn | PROJECT LEADER: | EPD | DESIGNED BY: | JDA | EROSION CONTROL FINAL CONDITIONS PLAN |
| PROJECT NUMBER: | IM 089-2(35) | DRAWN BY: | JDA / PGJ | CHECKED BY: | EPD | SHEET 60 OF 762 | | |
| SCALE 1" = 50'-0" | | 50 0 50 | | PLOT DATE: | | 17-MAY-2005 | | |

SILT FENCE

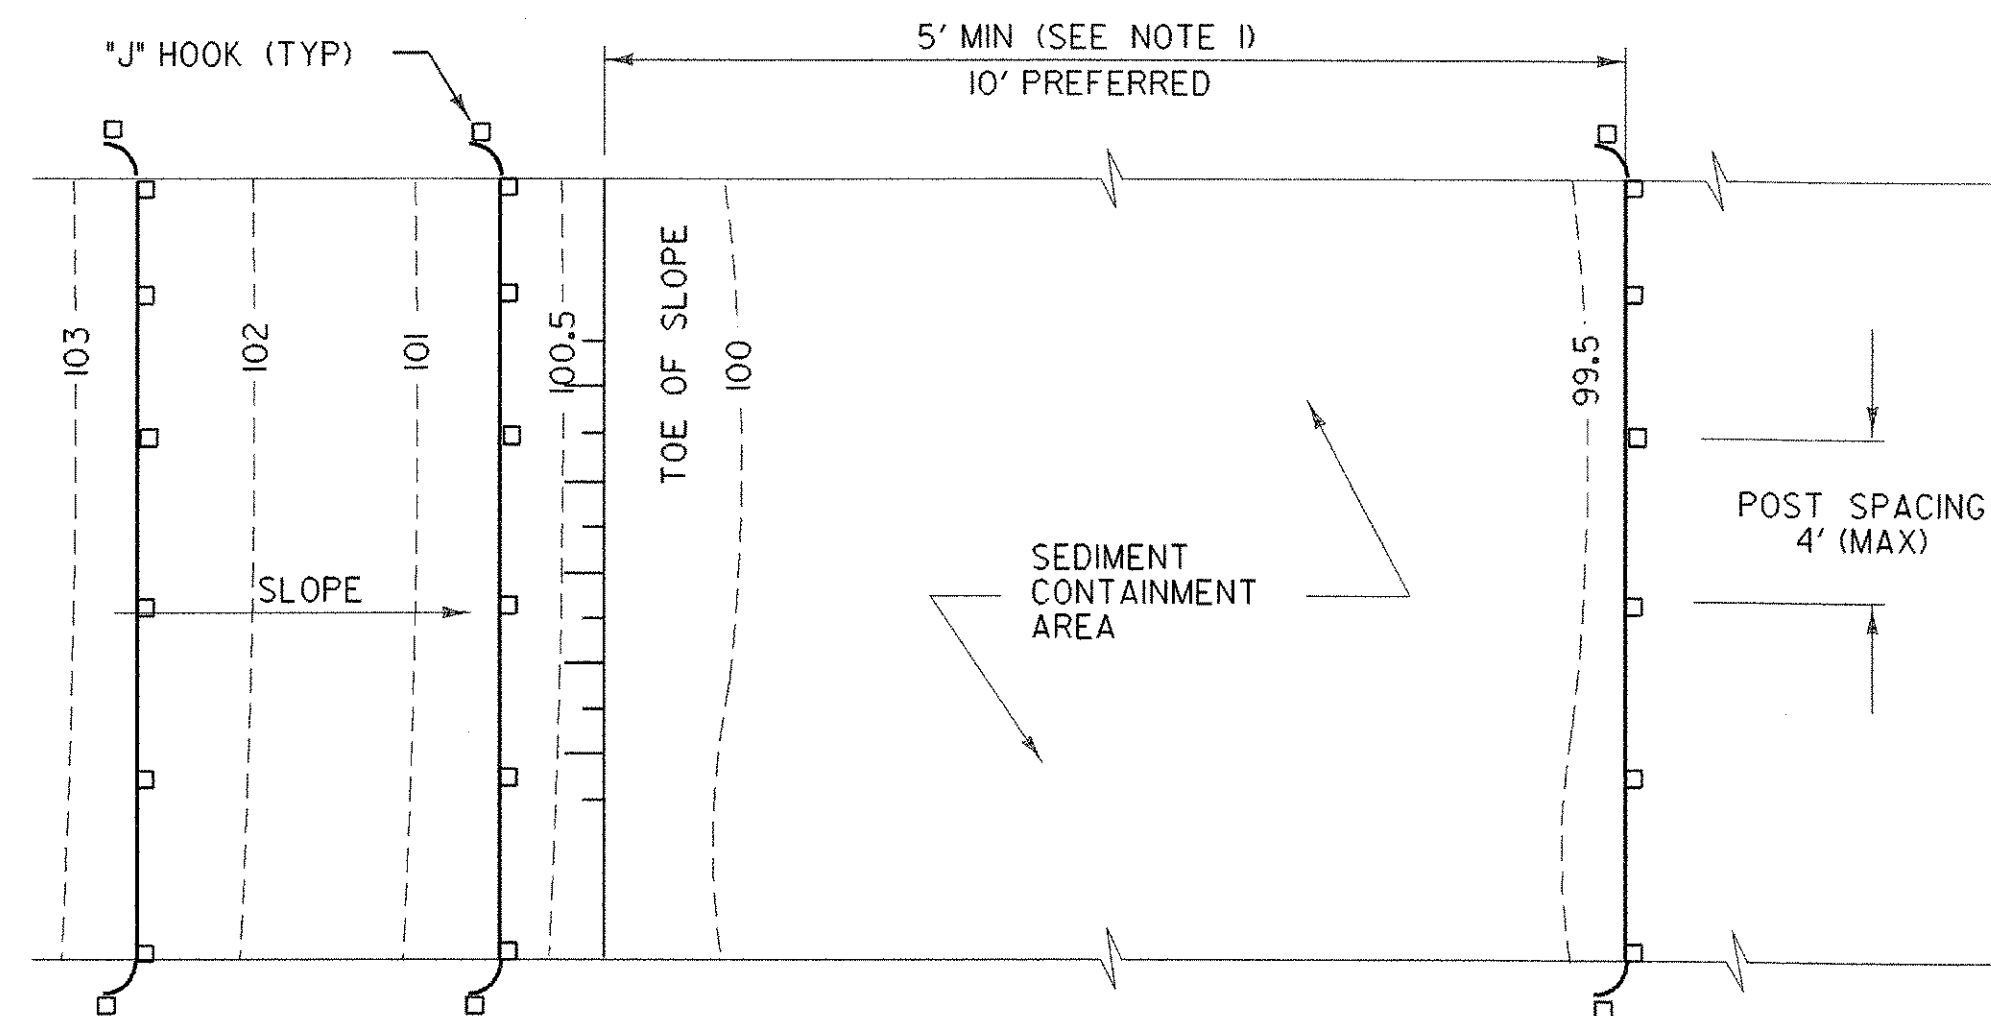

PLAN

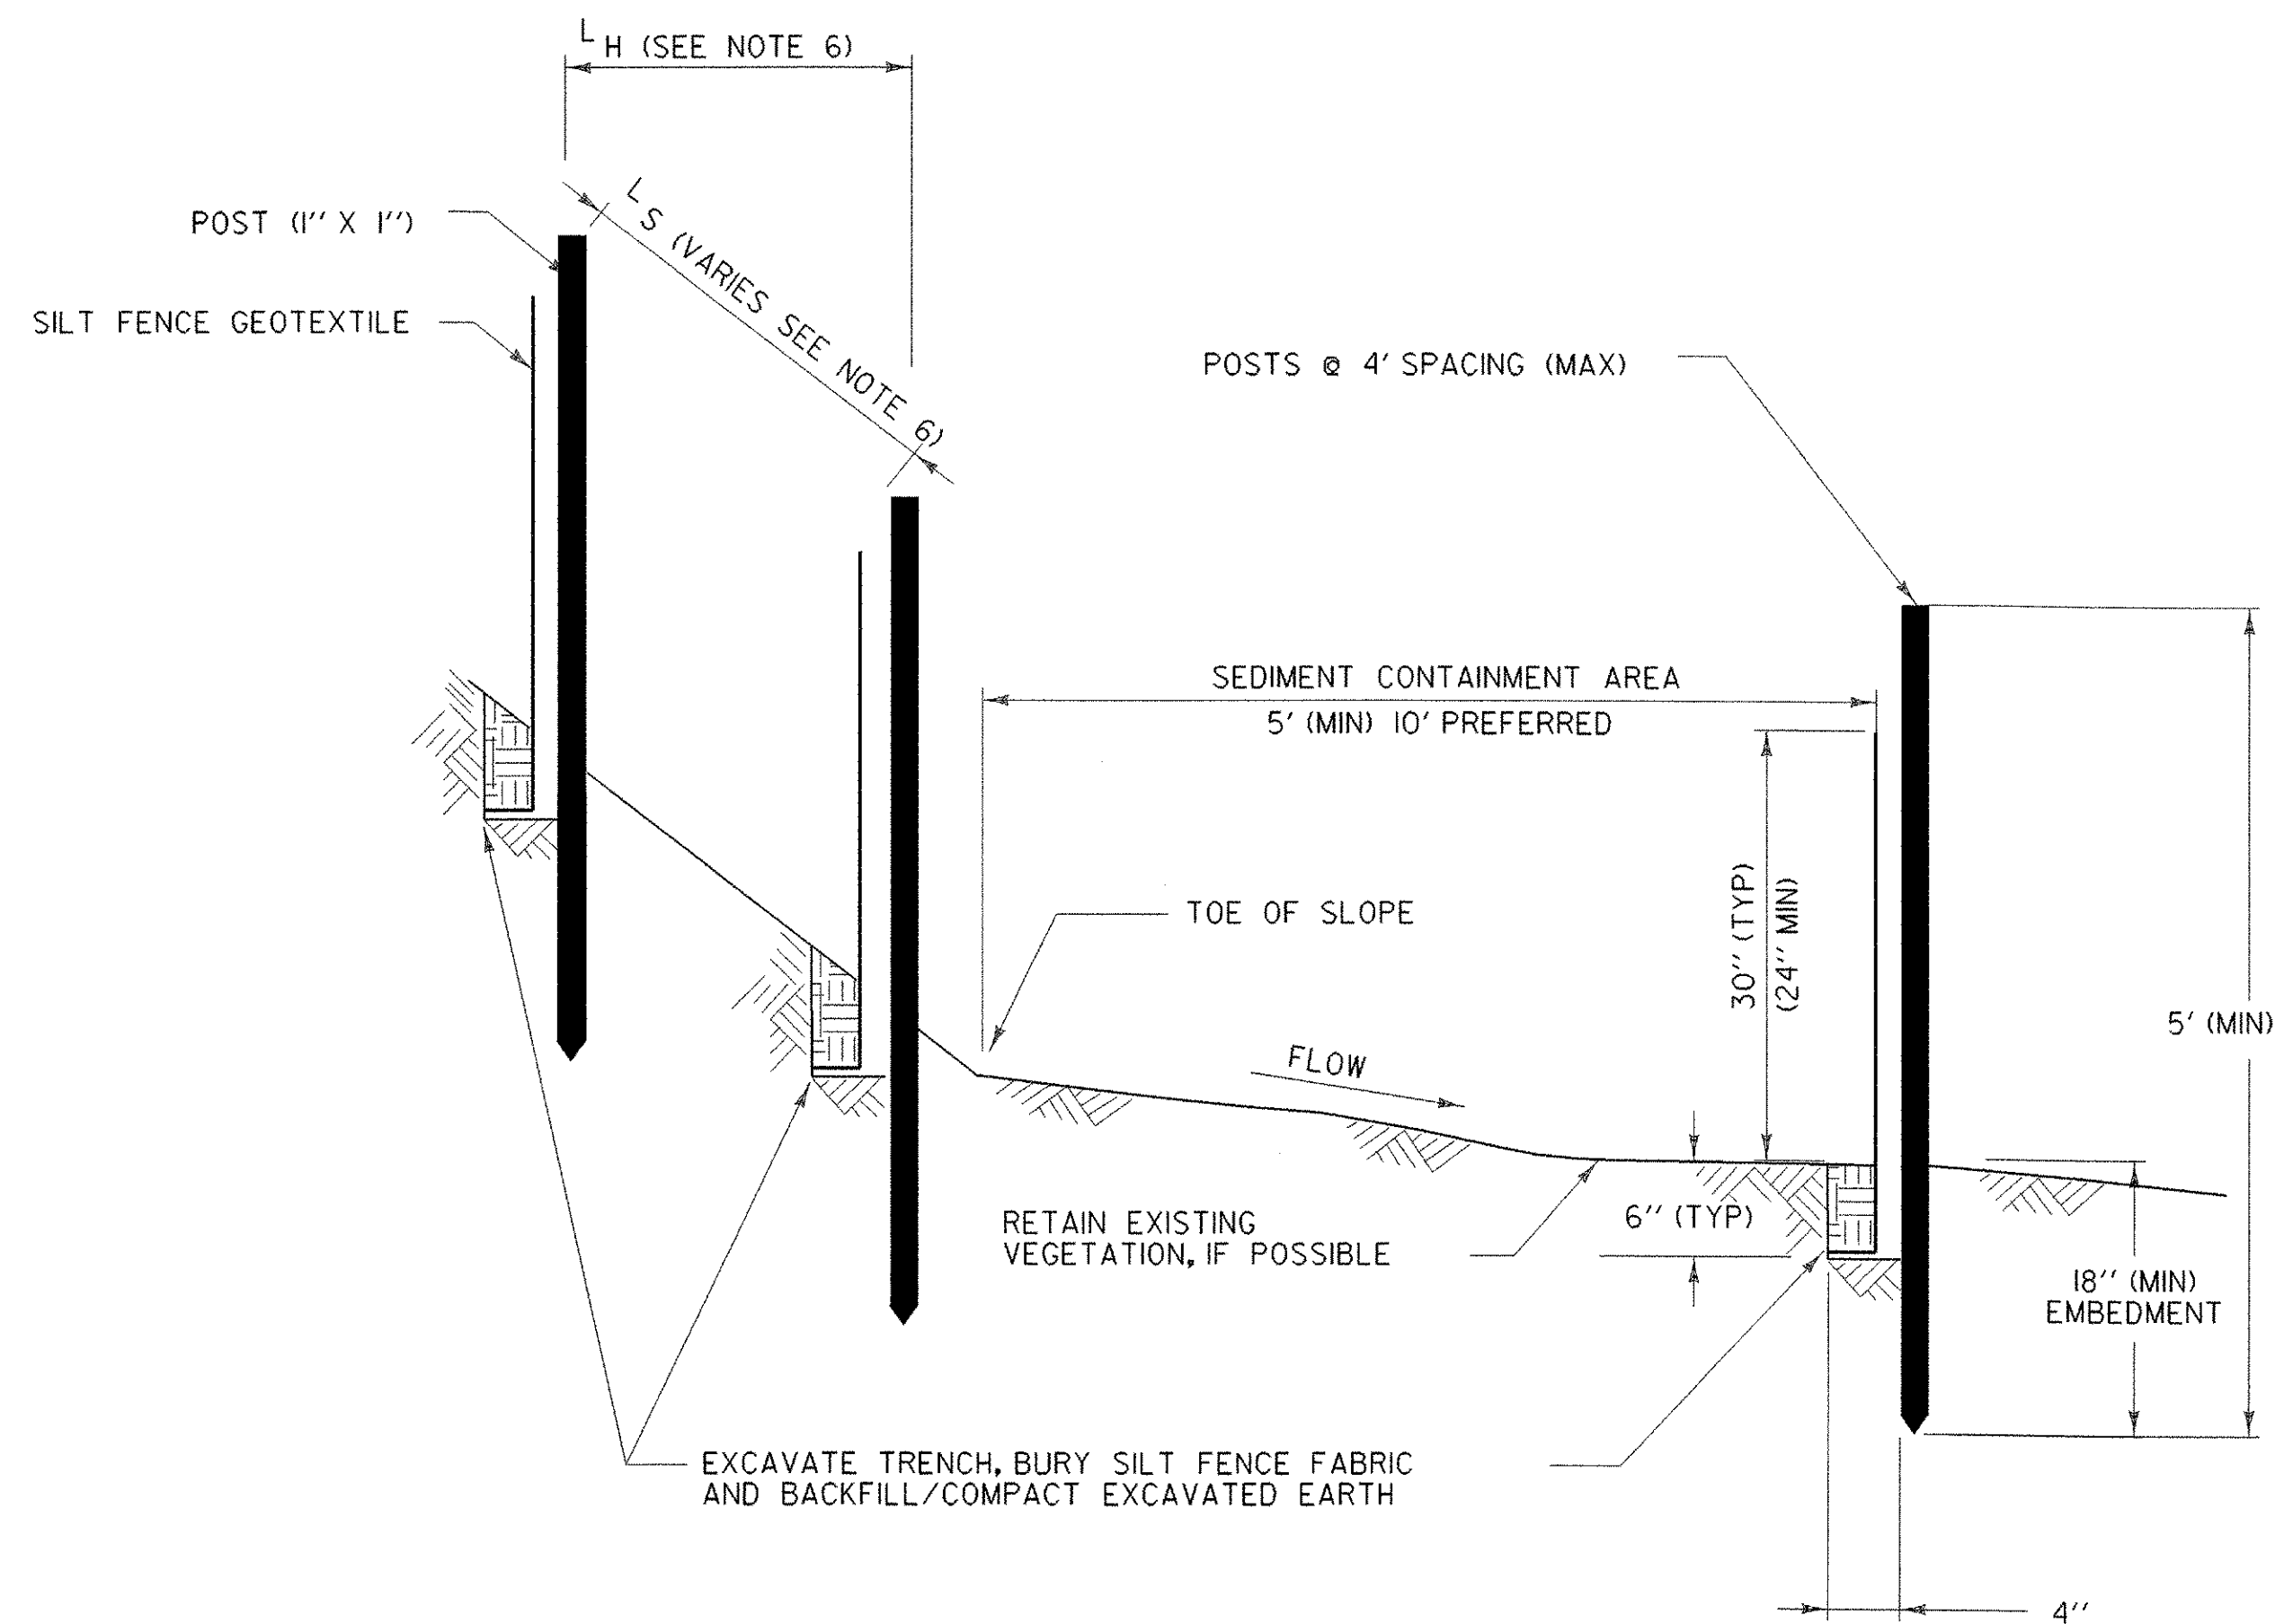

SECTION

SILT FENCE - TEMPORARY

APPLICATION NOTES


- A. THE PRIMARY PURPOSE OF SILT FENCE IS TO REDUCE RUNOFF VELOCITY AND TRAP SEDIMENT. VELOCITY IS REDUCED, WATER IS IMPOUNDED BEHIND THE MEASURE, AND SEDIMENT FALLS OUT OF SUSPENSION.
- B. SILT FENCE SHALL BE INSTALLED ON A LINE OF EQUAL ELEVATION (CONTOUR). IT MAY BE INSTALLED AT INTERMEDIATE POINTS UP SLOPES AS WELL AS AT THE BOTTOM, AS SHOWN IN THE DETAIL.
- C. SILT FENCE SHALL NOT BE USED ACROSS CONCENTRATED FLOW.

GENERAL NOTES

1. SILT FENCE SHALL GENERALLY BE PLACED A MINIMUM OF 5 FEET BEYOND TOE OF SLOPE, 10 FEET PREFERRED, TO PROVIDE ADEQUATE AREA FOR SEDIMENT STORAGE AND FACILITATE MAINTENANCE OF SEDIMENT CONTAINMENT AREA.
2. ALL ENDS SHALL BE "J" HOOKED TO TRAP SEDIMENT.
3. IN AREAS WITH TWO SLOPES, SILT FENCE SHALL BE USED TO ERECT A DAM AND TRAP SEDIMENT AT THE BASE OF THE STEEPER SLOPE.
4. THE BOTTOM EDGE OF SILT FENCE SHALL BE BURIED A MINIMUM OF 6 INCHES BELOW GROUND, AND KEYED IN 4 INCHES. THE FENCE SHALL BE INSTALLED WITH THE POSTS ON THE DOWNSTREAM SIDE OF THE FABRIC.
5. MAXIMUM DRAINAGE AREA TRIBUTARY TO 100 FEET OF SILT FENCE SHALL BE 0.25 ACRES.
6. THE FOLLOWING ARE MAXIMUM SLOPE LENGTHS FOR THESE MEASURES:

| CONSTRUCTED SLOPE | SLOPE LENGTH (LS) FT | HORIZONTAL LENGTH (LH) FT |
|-------------------|----------------------|---------------------------|
| 3 : 1 | 80 | 75 |
| 4 : 1 | 130 | 125 |
| 5 : 1 | 200 | 200 |
| > 5 : 1 | 250 | 250 |

7. MEASURES SHALL BE INSPECTED EVERY SEVEN (7) CALENDAR DAYS AND WITHIN 24 HOURS OF A STORM EVENT GREAT ENOUGH TO CAUSE WATER TO LEAVE THE CONSTRUCTION SITE.
8. MEASURES SHALL BE CLEANED AND REPAIRED AS NEEDED. SEDIMENT SHALL BE REMOVED WHEN ACCUMULATION REACHES ONE-HALF OF THE MEASURE HEIGHT. SEDIMENT SHALL BE DISPOSED OF AS UNSUITABLE MATERIAL.
9. SILT FENCE SHALL BE REMOVED WHEN THE AREA HAS BEEN STABILIZED. AT TIME OF REMOVAL OF THE SILT FENCE, THE DISTURBED AREA SHALL BE REPAIRED AND STABILIZED.
10. PAYMENT FOR INSTALLATION AND REMOVAL OF SILT FENCE SHALL BE MADE UNDER THE GEOTEXTILE FOR SILT FENCE ITEM.
11. PAYMENT FOR MONITORING SILT FENCE SHALL BE MADE UNDER THE MONITORING EROSION PREVENTION & SEDIMENT CONTROL PLAN PAY ITEM.
12. PAYMENT FOR MAINTAINING SILT FENCE SHALL BE MADE UNDER THE FIELD MAINTENANCE OF EROSION PREVENTION & SEDIMENT CONTROL PLAN ITEM, UNLESS IN THE OPINION OF THE RESIDENT ENGINEER MAINTENANCE IS REQUIRED DUE TO POOR INSTALLATION PRACTICES, WHEREAS IT WILL THEN BE REPAIRED AT THE CONTRACTORS SOLE EXPENSE.

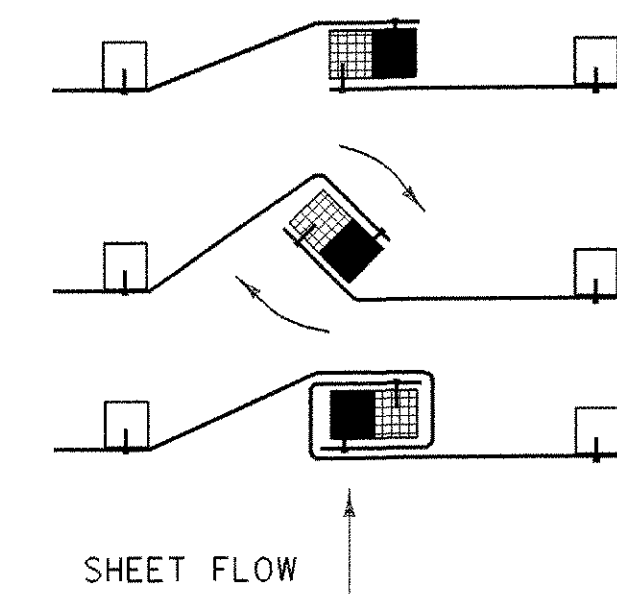


1. PLACE THE END POST OF ONE FENCE INSIDE THE END POST OF THE OTHER FENCE.
2. ROTATE BOTH POSTS AT LEAST 180 DEGREES IN A CLOCKWISE DIRECTION TO CREATE A TIGHT SEAL WITH THE FABRIC MATERIAL.
3. DRIVE BOTH POSTS 18 INCHES INTO THE GROUND AND BURY THE FLAP IN THE TRENCH.


SPLICING DETAIL

PROJECT NAME: I-89 EXIT 12 SB OFF RAMP
PROJECT NUMBER: IM 089-2(35)

FILE NAME: I8800F4ECP05.dgn PLOT DATE: 17-MAY-2005
PROJECT LEADER: EPD DRAWN BY: JDA / PGJ
DESIGNED BY: JDA CHECKED BY: EPD
SILT FENCE DETAILS SHEET 61 OF 76

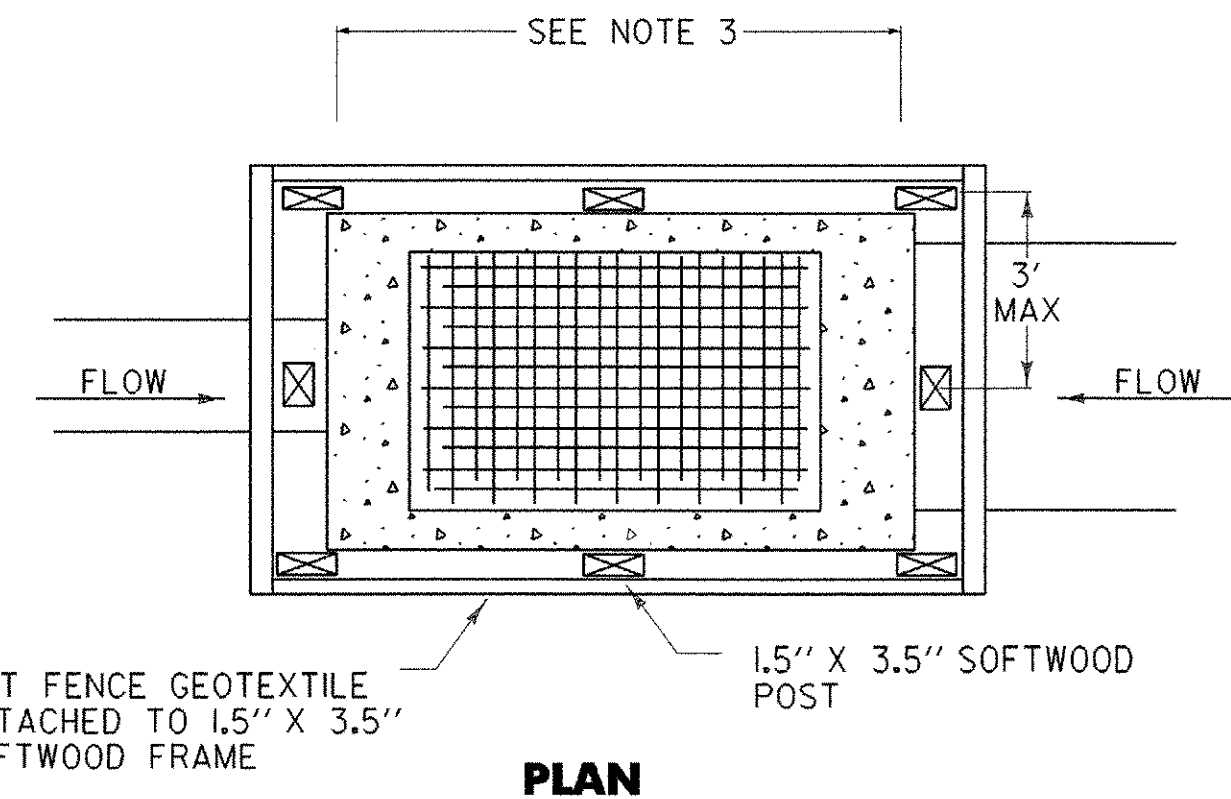

PLAN

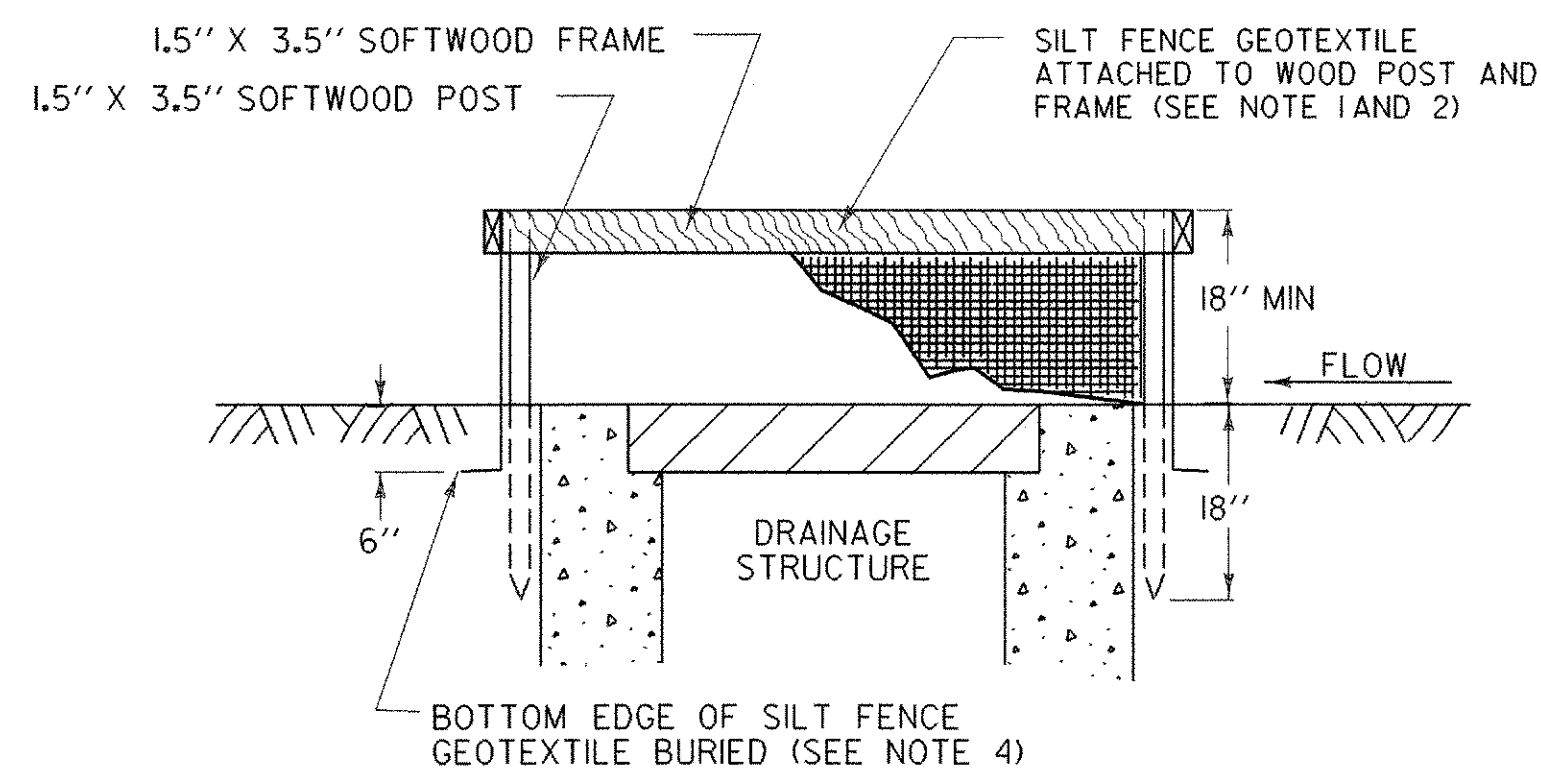


SECTION


SILT FENCE CATCH BASIN PROTECTION

CATCH BASIN PROTECTION GENERAL NOTES


1. THE TOP OF THE INLET PROTECTION SHALL BE SET AT THE MAXIMUM DESIRED WATER LEVEL, BASED ON FIELD LOCATION AND CONDITIONS.
2. SILT FENCE GEOTEXTILE SHALL BE A SINGLE CONTINUOUS PIECE TO ELIMINATE JOINTS.
3. SPACE SILT FENCE POSTS EVENLY AROUND INLET WITH A MAXIMUM SPACING OF 3 FEET. DRIVE POSTS A MINIMUM OF 18 INCHES INTO GROUND. WIRE MESH MAY BE REQUIRED BEHIND GEOTEXTILE TO PROVIDE SUPPORT.
4. SILT FENCE GEOTEXTILE SHALL BE EMBEDDED A MINIMUM OF 6 INCHES AND BACKFILLED. GEOTEXTILE SHALL BE SECURELY FASTENED TO POSTS AND FRAME.
5. SECURE THE ENDS OF THE APRON FOR THE PREFABRICATED DRAINAGE STRUCTURE INLET PROTECTION WITH STAPLES AS DETAILED IN THE PLAN VIEW OR AS RECOMMENDED BY THE MANUFACTURERS LITERATURE.
6. MEASURES SHALL BE INSPECTED EVERY SEVEN (7) CALENDAR DAYS AND WITHIN 24 HOURS OF A STORM EVENT GREAT ENOUGH TO CAUSE WATER TO LEAVE THE CONSTRUCTION SITE.
7. MEASURES SHALL BE CLEANED AND REPAIRED AS NEEDED. SEDIMENT SHALL BE REMOVED WHEN ACCUMULATION REACHES ONE-HALF OF THE MEASURE HEIGHT. SEDIMENT SHALL BE DISPOSED OF AS UNSUITABLE MATERIAL.
8. PAYMENT OF CATCH BASIN PROTECTION SHALL BE MADE UNDER ITEM 613.10, "STONE FILL, TYPE I".
9. PAYMENT FOR MONITORING INLET PROTECTION SHALL BE MADE UNDER THE MONITORING EROSION PREVENTION & SEDIMENT CONTROL PLAN ITEM.
10. PAYMENT FOR MAINTAINING INLET PROTECTION SHALL BE MADE UNDER THE FIELD MAINTENANCE OF EROSION PREVENTION & SEDIMENT CONTROL PLAN ITEM, UNLESS IN THE OPINION OF THE RESIDENT ENGINEER MAINTENANCE IS REQUIRED DUE TO POOR INSTALLATION PRACTICES, WHEREAS IT WILL BE REPAIRED AT THE CONTRACTORS SOLE EXPENSE.

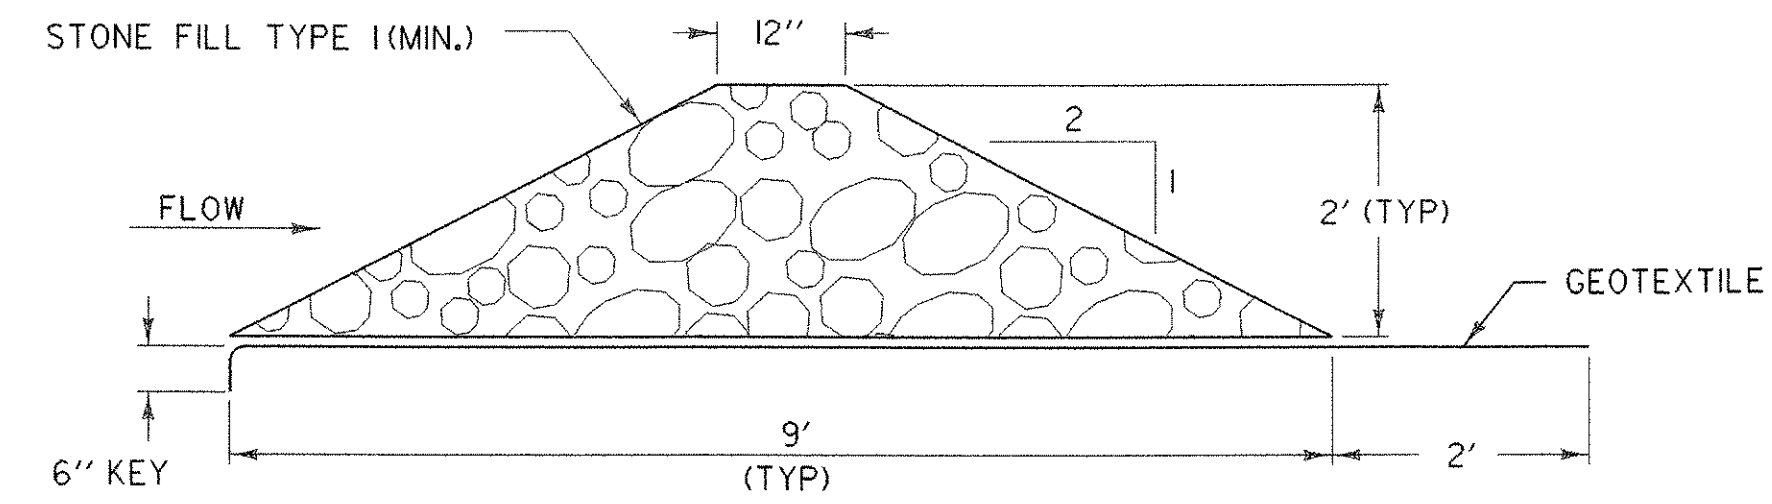


CROSS-SECTION

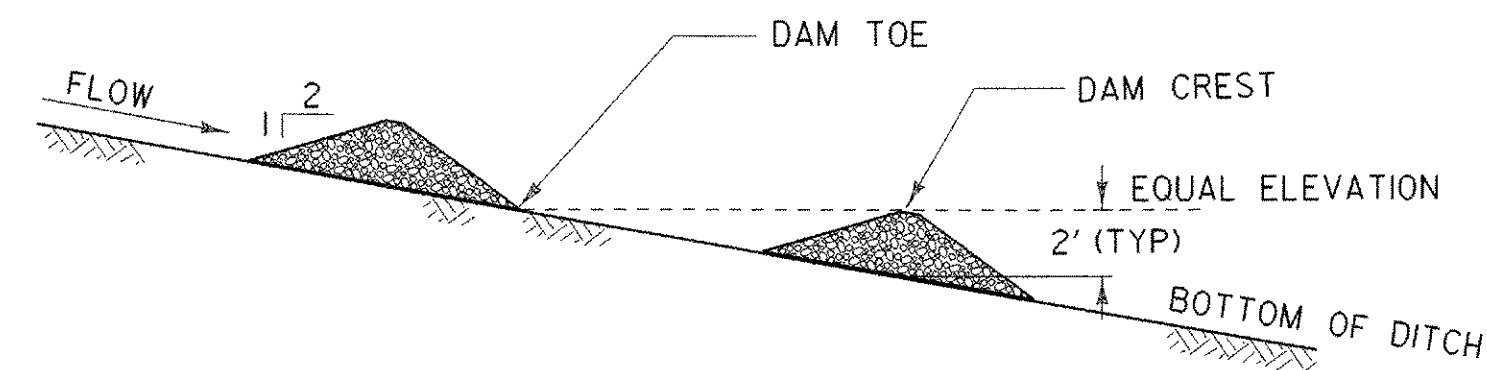

PROFILE

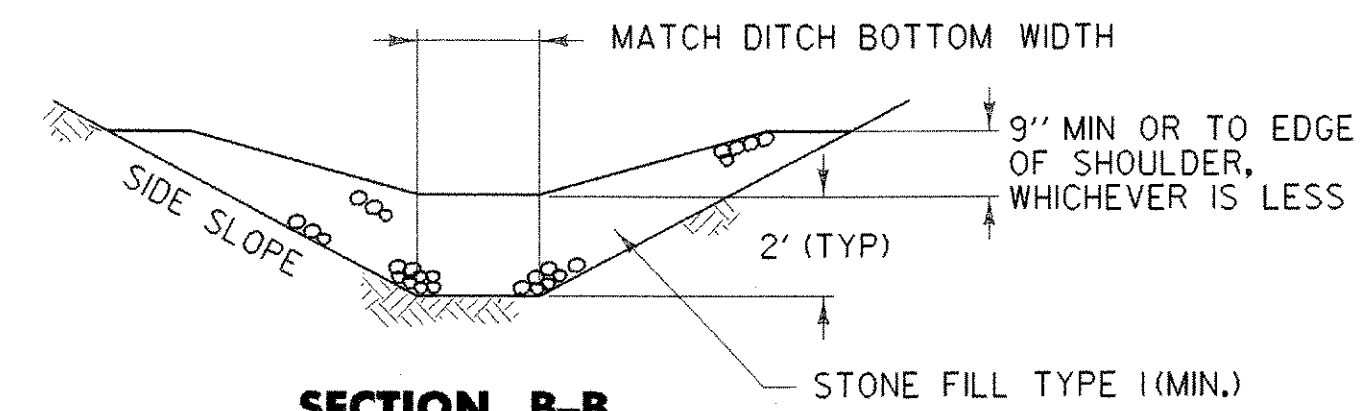

SECTION B-B

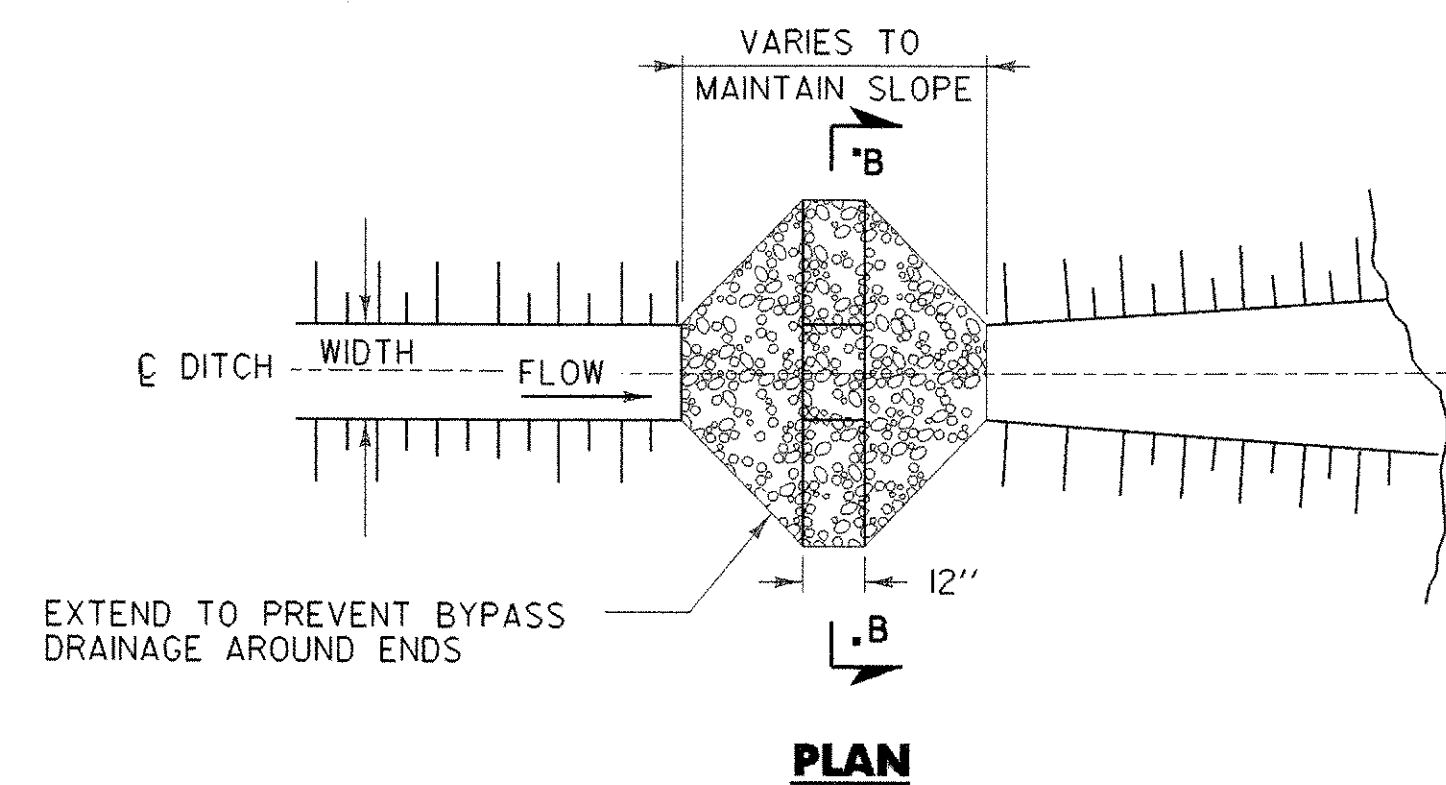

PLAN

CHECK DAM - TEMPORARY (STONE)

CHECK DAM GENERAL NOTES


1. GEOTEXTILE SHALL BE INSTALLED UNDER STONE FILL. IT SHALL BE KEYED IN ON THE UP HILL END AND SHALL EXTEND 2 FEET BEYOND THE STONE ON THE DOWN HILL END.
2. CORE MATERIAL FOR THE STONE CHECK DAM SHALL MEET THE GRADATION REQUIREMENTS OF STONE FILL TYPE I (MIN.). STONE SIZE SHOULD BE INCREASED WITH INCREASED SLOPE AND VELOCITY.
3. THE UPHILL END OF THE APRON FOR THE PREFABRICATED CHECK DAM SHALL BE STAPLED AND BURIED AS SHOWN IN DETAIL 'A' OR AS RECOMMENDED BY THE MANUFACTURERS LITERATURE.
4. MEASURES SHALL BE INSPECTED EVERY SEVEN (7) CALENDAR DAYS AND WITHIN 24 HOURS OF A STORM EVENT GREAT ENOUGH TO CAUSE WATER TO LEAVE THE CONSTRUCTION SITE.
5. MEASURES SHALL BE CLEANED AND REPAIRED AS NEEDED. SEDIMENT SHALL BE REMOVED WHEN ACCUMULATION REACHES ONE-HALF OF THE MEASURE HEIGHT. SEDIMENT SHALL BE DISPOSED OF AS UNSUITABLE MATERIAL.
6. AT TIME OF REMOVAL OF THE CHECK DAMS, THE DISTURBED AREA SHALL BE REPAIRED AND STABILIZED.
7. PAYMENT FOR INSTALLATION AND REMOVAL OF CHECK DAMS SHALL BE MADE UNDER PAY ITEM 613.10, "STONE FILL, TYPE I".
8. PAYMENT FOR MONITORING CHECK DAMS SHALL BE MADE UNDER THE MONITORING EROSION PREVENTION & SEDIMENT CONTROL PLAN ITEM.
9. PAYMENT FOR MAINTAINING CHECK DAMS SHALL BE MADE UNDER THE FIELD MAINTENANCE OF EROSION PREVENTION & SEDIMENT CONTROL PLAN ITEM, UNLESS IN THE OPINION OF THE RESIDENT ENGINEER MAINTENANCE IS REQUIRED DUE TO POOR INSTALLATION PRACTICES WHEREAS IT WILL BE REPAIRED AT THE CONTRACTORS SOLE EXPENSE.

| STONE CHECK DAM PLACEMENT INTERVAL | |
|------------------------------------|-----------------------|
| DITCH SLOPE | PLACEMENT INTERVAL ** |
| 1 % | 200 FT |
| 2 % | 100 FT |
| 3 % | 65 FT |
| 4 % | 50 FT |
| 5 % | 40 FT |
| 6 % | 30 FT |
| 8 % | 25 FT |
| 10 % | 20 FT |

** BASED ON 2' TYPICAL HEIGHT

PROJECT NAME: I-89 EXIT 12 SB OFF RAMP
PROJECT NUMBER: IM 089-2(35)

FILE NAME: I8800F4ECP05.dgn PLOT DATE: 17-MAY-2005
PROJECT LEADER: EPD DRAWN BY: JDA / PGJ
DESIGNED BY: JDA CHECKED BY: EPD
CHECK DAM & CATCH BASIN PROTECTION DETAILS SHEET 62 OF 76

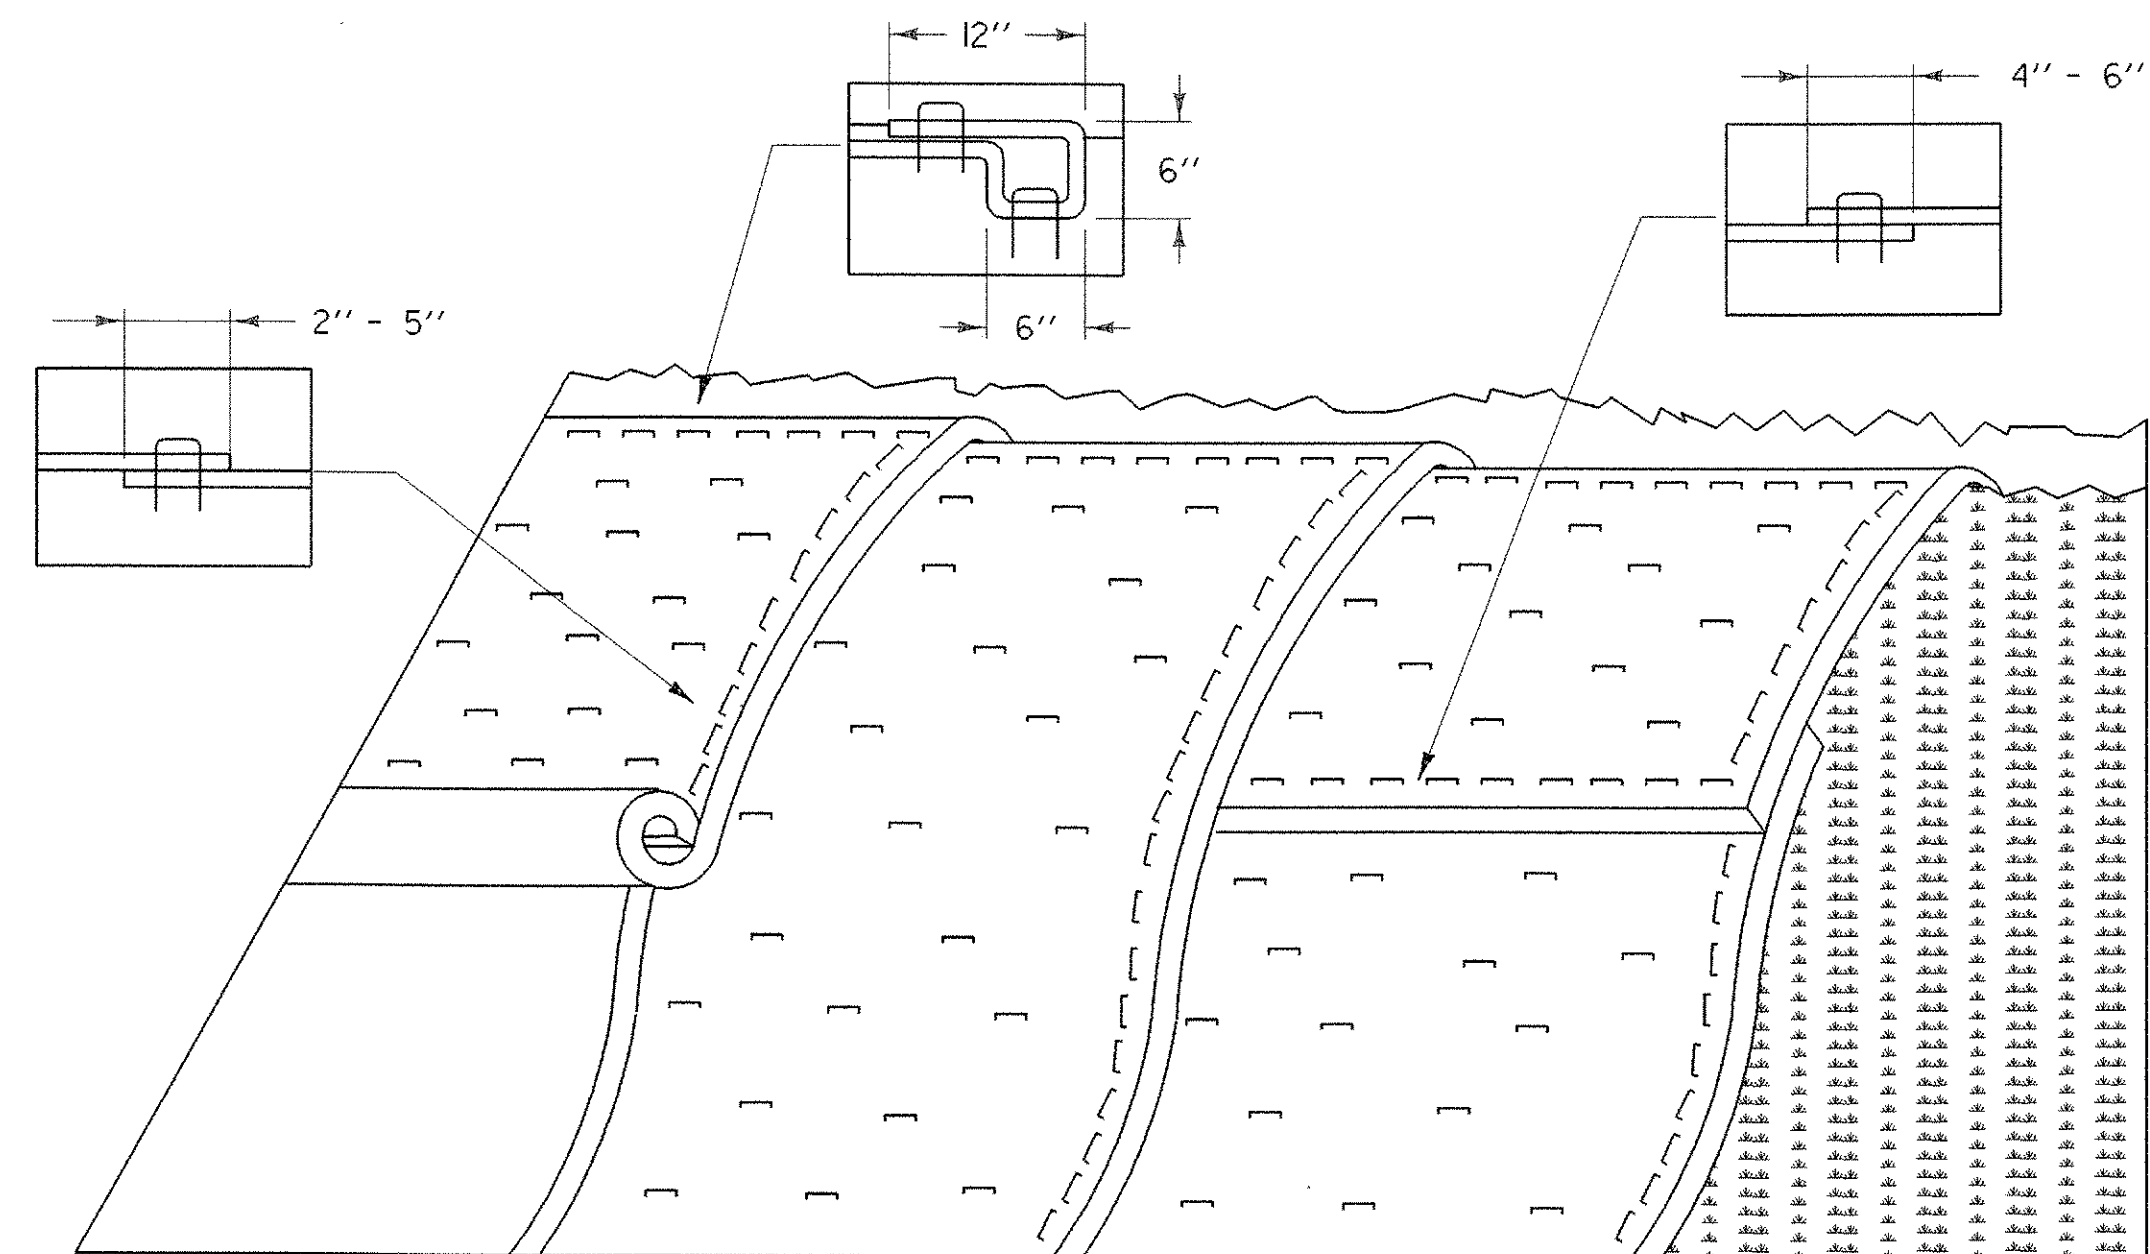

EROSION MATTING SIDE SLOPE APPLICATION


GENERAL NOTES:

1. GRADE AND SMOOTH THE SLOPE TO PROVIDE GOOD MATTING TO SOIL SURFACE CONTACT.
2. APPLY FERTILIZER, LIME, AND SEED PRIOR TO PLACING MATTING.
3. ANCHOR MATTING AS SHOWN, UTILIZING ANCHOR STAPLES. STAPLE PLACEMENT SHALL BE DETERMINED BY THE MANUFACTURER'S INSTALLATION INSTRUCTIONS.
4. UNROLL MATTING VERTICALLY DOWN SLOPE IN THE DIRECTION OF WATER FLOW.
5. OVERLAP UPPER MATTING OVER LOWER MATTING AS SHOWN.
6. OVERLAP ADJACENT MATTING AS SHOWN.
7. CUT EXCESS MATTING AT END OF SLOPE AND ANCHOR THE END.
8. MEASURES SHALL BE INSPECTED EVERY SEVEN (7) CALENDAR DAYS AND WITHIN 24 HOURS OF A STORM EVENT GREAT ENOUGH TO CAUSE WATER TO LEAVE THE CONSTRUCTION SITE.
9. MATTING SHALL BE REPAIRED AND RESTAPLED AS NECESSARY TO ENSURE PROPER FUNCTION.
10. PAYMENT FOR INSTALLATION OF MATTING SHALL BE MADE UNDER ITEM 654.10 "EROSION MATTING".
11. PAYMENT FOR MONITORING EROSION CONTROL MATTING SHALL BE MADE UNDER THE MONITORING EROSION PREVENTION & SEDIMENT CONTROL PLAN ITEM.
12. PAYMENT FOR MAINTAINING SLOPE PROTECTION SHALL BE MADE UNDER THE FIELD MAINTENANCE OF EROSION PREVENTION & SEDIMENT CONTROL PLAN ITEM, UNLESS IN THE OPINION OF THE RESIDENT ENGINEER MAINTENANCE IS REQUIRED DUE TO POOR INSTALLATION PRACTICES WHEREAS IT WILL BE REPAIRED AT THE CONTRACTORS SOLE EXPENSE.


PROJECT NAME: I-89 EXIT 12 SB OFF RAMP
PROJECT NUMBER: IM 089-2(35)

FILE NAME: I8800F4ECP05.dgn
PROJECT LEADER: EPD
DESIGNED BY: JDA
EROSION MATTING DETAILS

PLOT DATE: 17-MAY-2005
DRAWN BY: JDA / PGJ
CHECKED BY: EPD
SHEET 63 OF 76

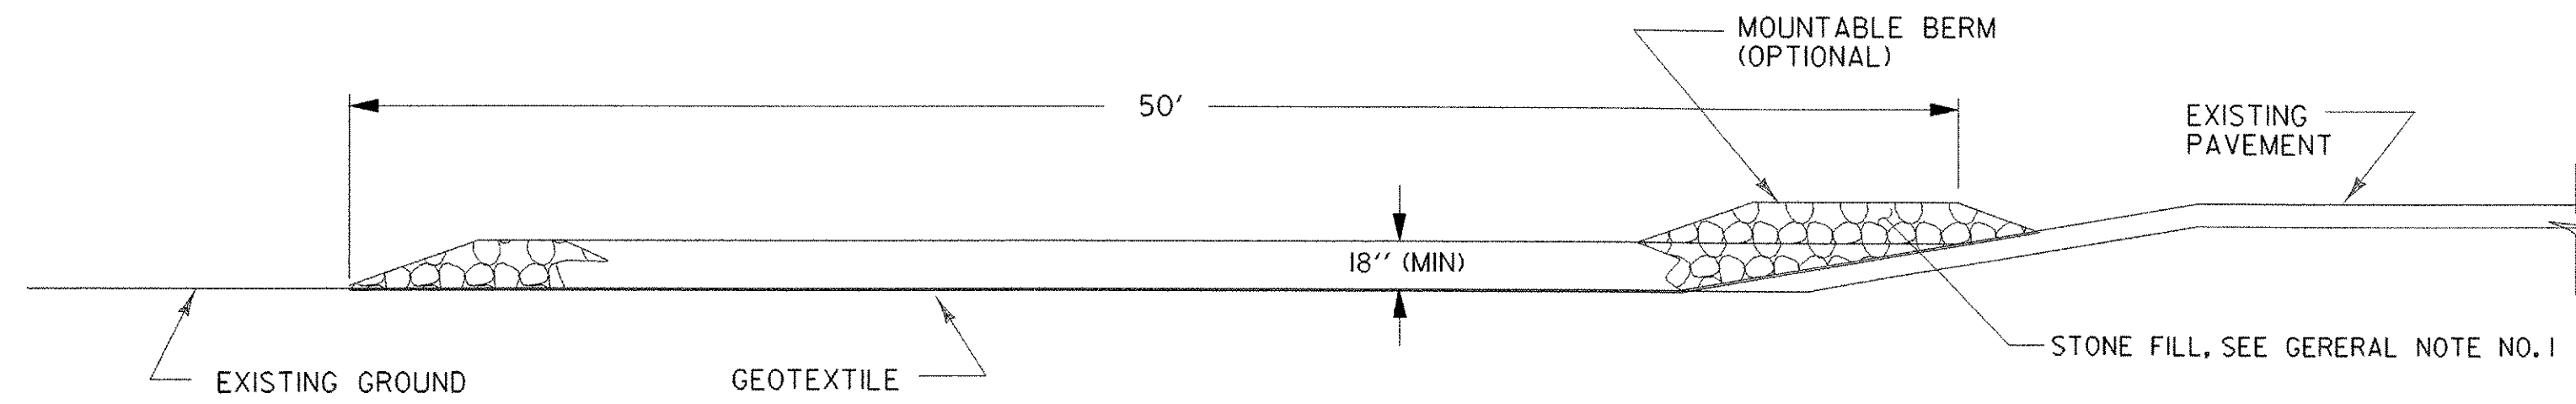

**TYPICAL CONSTRUCTION ENTRANCE PROFILE
(CUT AND DITCH SECTIONS)**

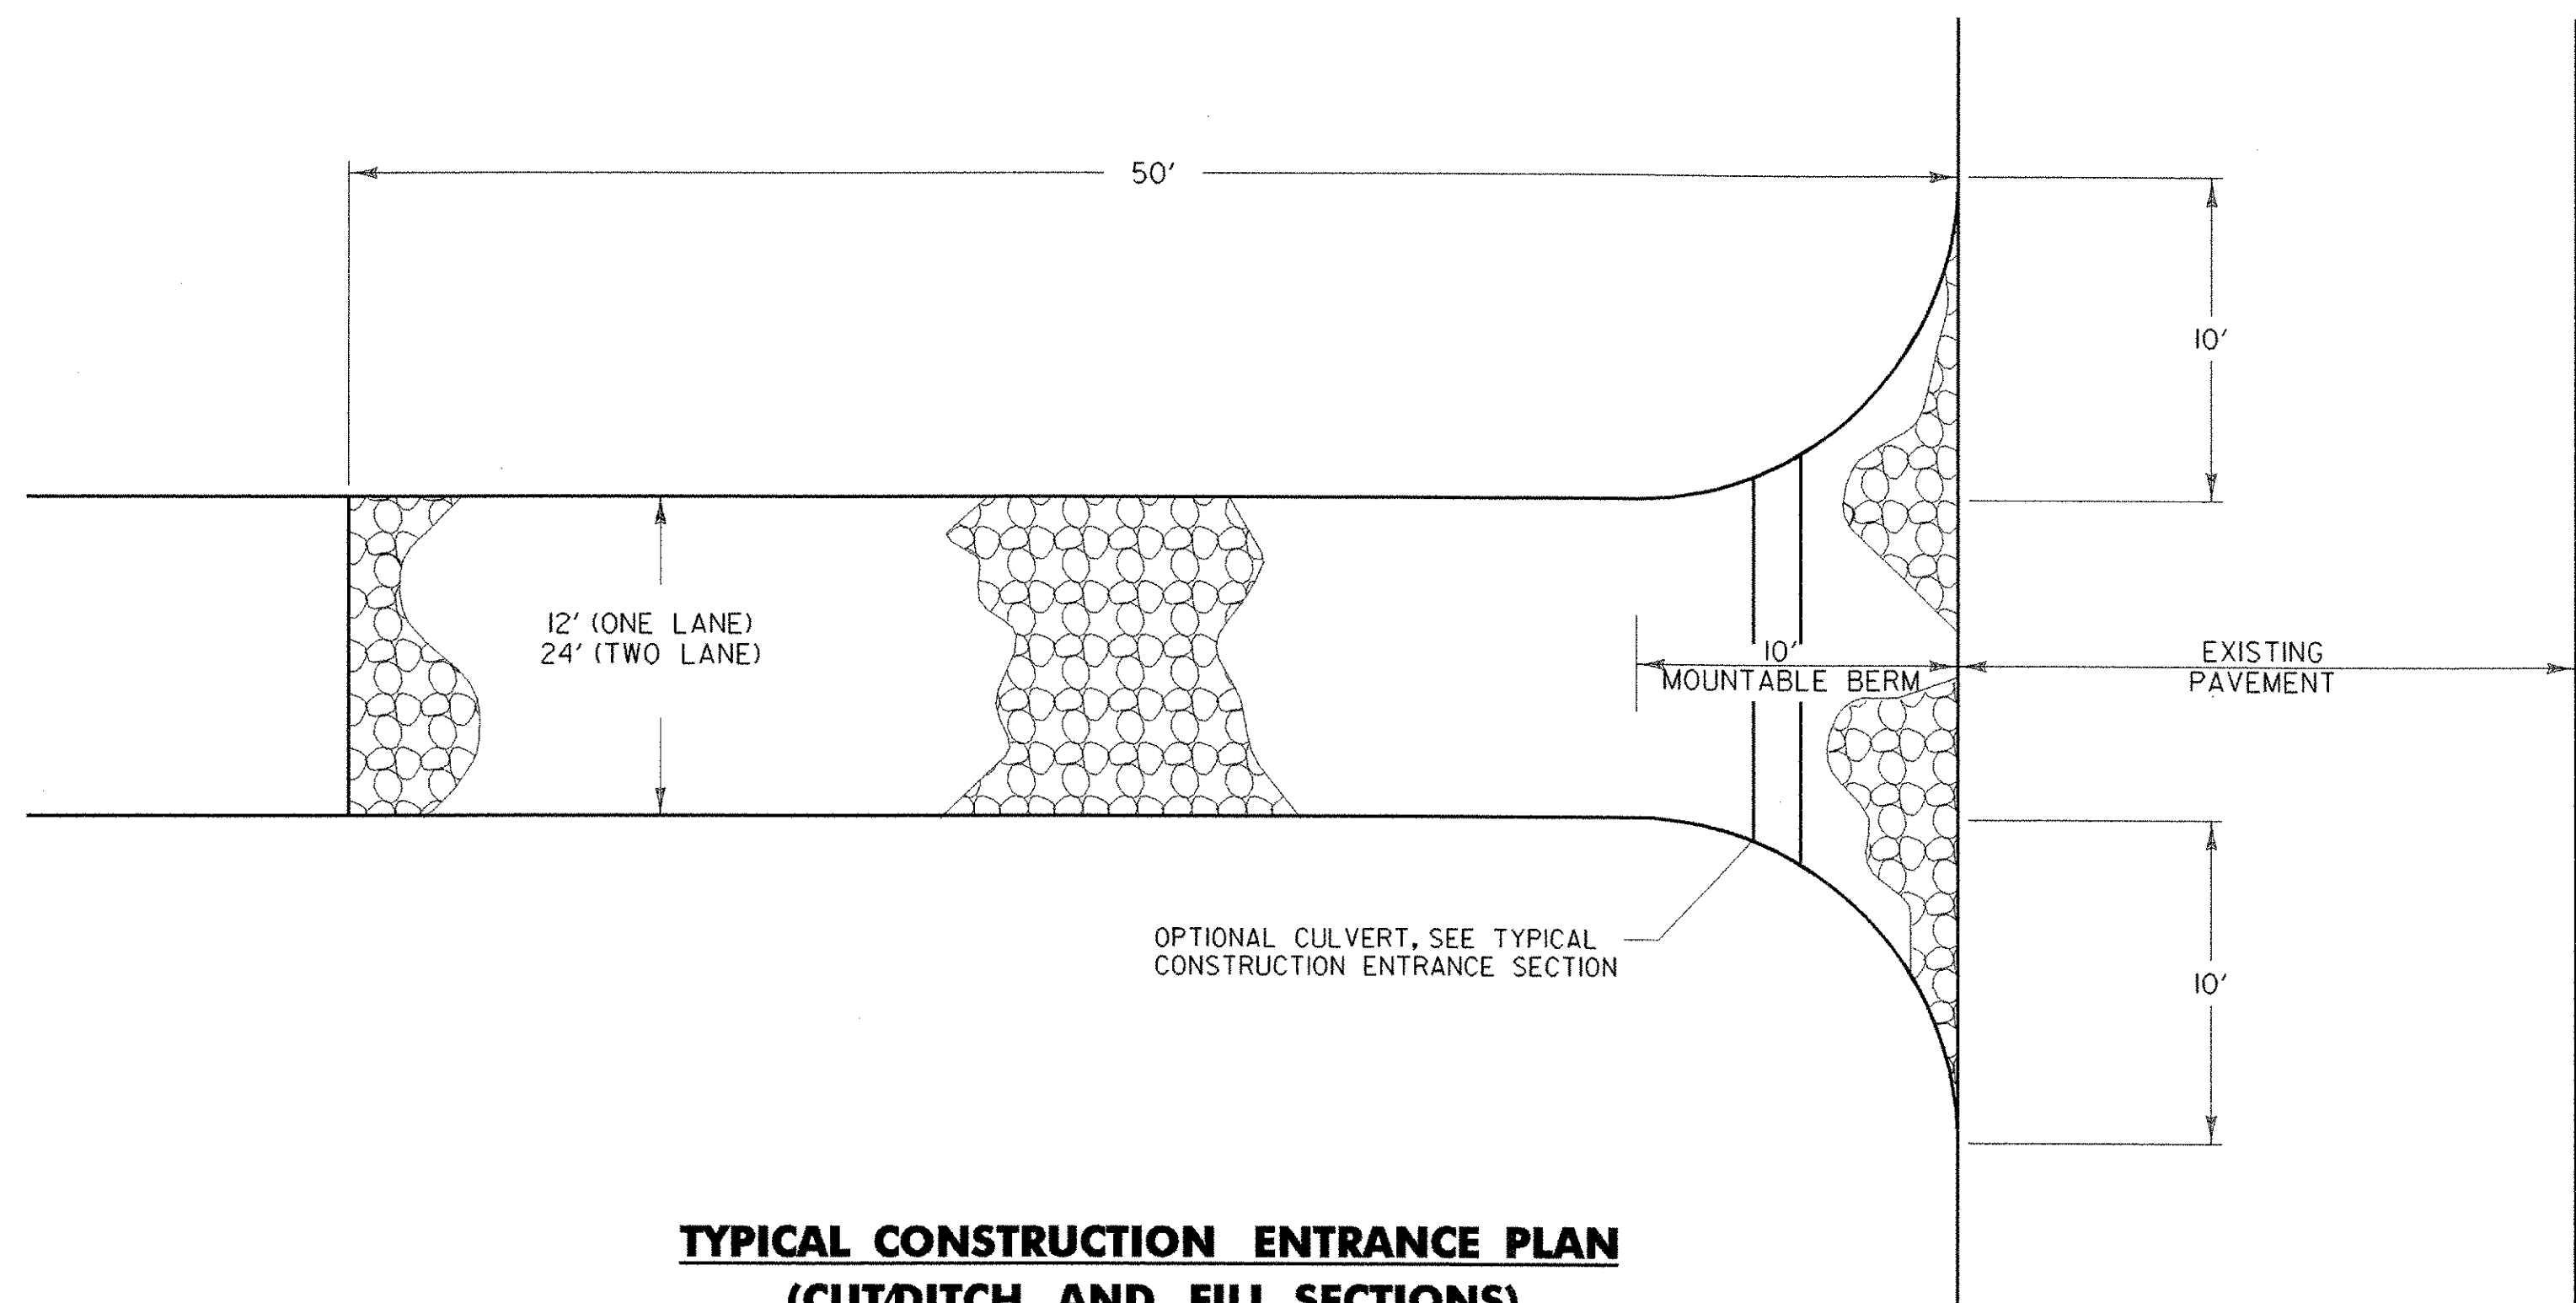

**TYPICAL CONSTRUCTION ENTRANCE PLAN
(CUT/DITCH AND FILL SECTIONS)**


STABILIZED CONSTRUCTION ENTRANCE

APPLICATION NOTES:

A. THE PURPOSE OF A STABILIZED CONSTRUCTION ENTRANCE IS TO REDUCE OR ELIMINATE THE TRACKING OF SEDIMENT ONTO PUBLIC RIGHTS OF WAY OR STREETS.


GENERAL NOTES:

1. STONE SIZE - USE CLEAN STONE WITH GRADATION BETWEEN 2 INCHES AND 4 INCHES.
2. LENGTH - 50 FEET (MIN)
3. THICKNESS - 18 INCHES (MIN)
4. WIDTH - 12 FEET (MIN)
5. GEOTEXTILE UNDER STONE WILL BE PLACED OVER THE ENTIRE AREA PRIOR TO PLACING OF STONE.
6. SURFACE WATER - ALL SURFACE WATER FLOWING OR DIVERTED TOWARD CONSTRUCTION ENTRANCES SHALL BE PIPED ACROSS THE ENTRANCE AS DIRECTED BY THE ENGINEER AND ON-SITE COORDINATOR. IF PIPING IS IMPRACTICAL, A MOUNTABLE BERM WITH 5:1 SLOPES WILL BE PERMITTED.
7. PROPOSED DRAINAGE PIPES SHALL BE SIZED WITH SUFFICIENT CAPACITY TO CARRY DITCH FLOWS. ALTERNATIVE WAYS OF TRANSPORTING DITCH DRAINAGE ACROSS CONSTRUCTION ENTRANCES MAY BE PROPOSED BY THE CONTRACTOR FOR APPROVAL BY THE ENGINEER AND ON-SITE COORDINATOR.
8. WHEN WASHING OF VEHICLE IS NECESSARY, IT SHALL BE DONE ON AN AREA STABILIZED WITH STONE WHICH DRAINS INTO AN APPROVED SEDIMENT TRAPPING DEVICE.
9. MEASURES SHALL BE INSPECTED EVERY SEVEN (7) CALENDAR DAYS AND WITHIN 24 HOURS OF A STORM EVENT GREAT ENOUGH TO CAUSE WATER TO LEAVE THE CONSTRUCTION SITE.
10. MAINTENANCE - THE ENTRANCE SHALL BE MAINTAINED IN A CONDITION WHICH WILL PREVENT TRACKING OR FLOWING OF SEDIMENT ONTO PUBLIC RIGHTS-OF-WAY. ALL SEDIMENT SPILLED, DROPPED, WASHED, OR TRACKED ONTO PUBLIC RIGHTS-OF-WAY MUST BE REMOVED IMMEDIATELY.
11. AT THE TIME OF REMOVAL OF THE STABILIZED CONSTRUCTION ENTRANCE THE DISTURBED AREA SHALL BE REPAIRED AND STABILIZED.
12. PAYMENT FOR CONSTRUCTING THE STABILIZED CONSTRUCTION ENTRANCE SHALL BE MADE UNDER ITEM 652.30, "FIELD MAINTENANCE OF EROSION PREVENTION & SEDIMENT CONTROL PLAN".
13. PAYMENT FOR MONITORING STABILIZED CONSTRUCTION ENTRANCES SHALL BE MADE UNDER THE MONITORING EROSION PREVENTION & SEDIMENT CONTROL PLAN ITEM.
14. PAYMENT FOR MAINTAINING THE CONSTRUCTION ENTRANCE SHALL BE MADE UNDER THE FIELD MAINTENANCE OF EROSION PREVENTION & SEDIMENT CONTROL PLAN ITEM, UNLESS MAINTENANCE IS REQUIRED DUE TO POOR INSTALLATION PRACTICES.

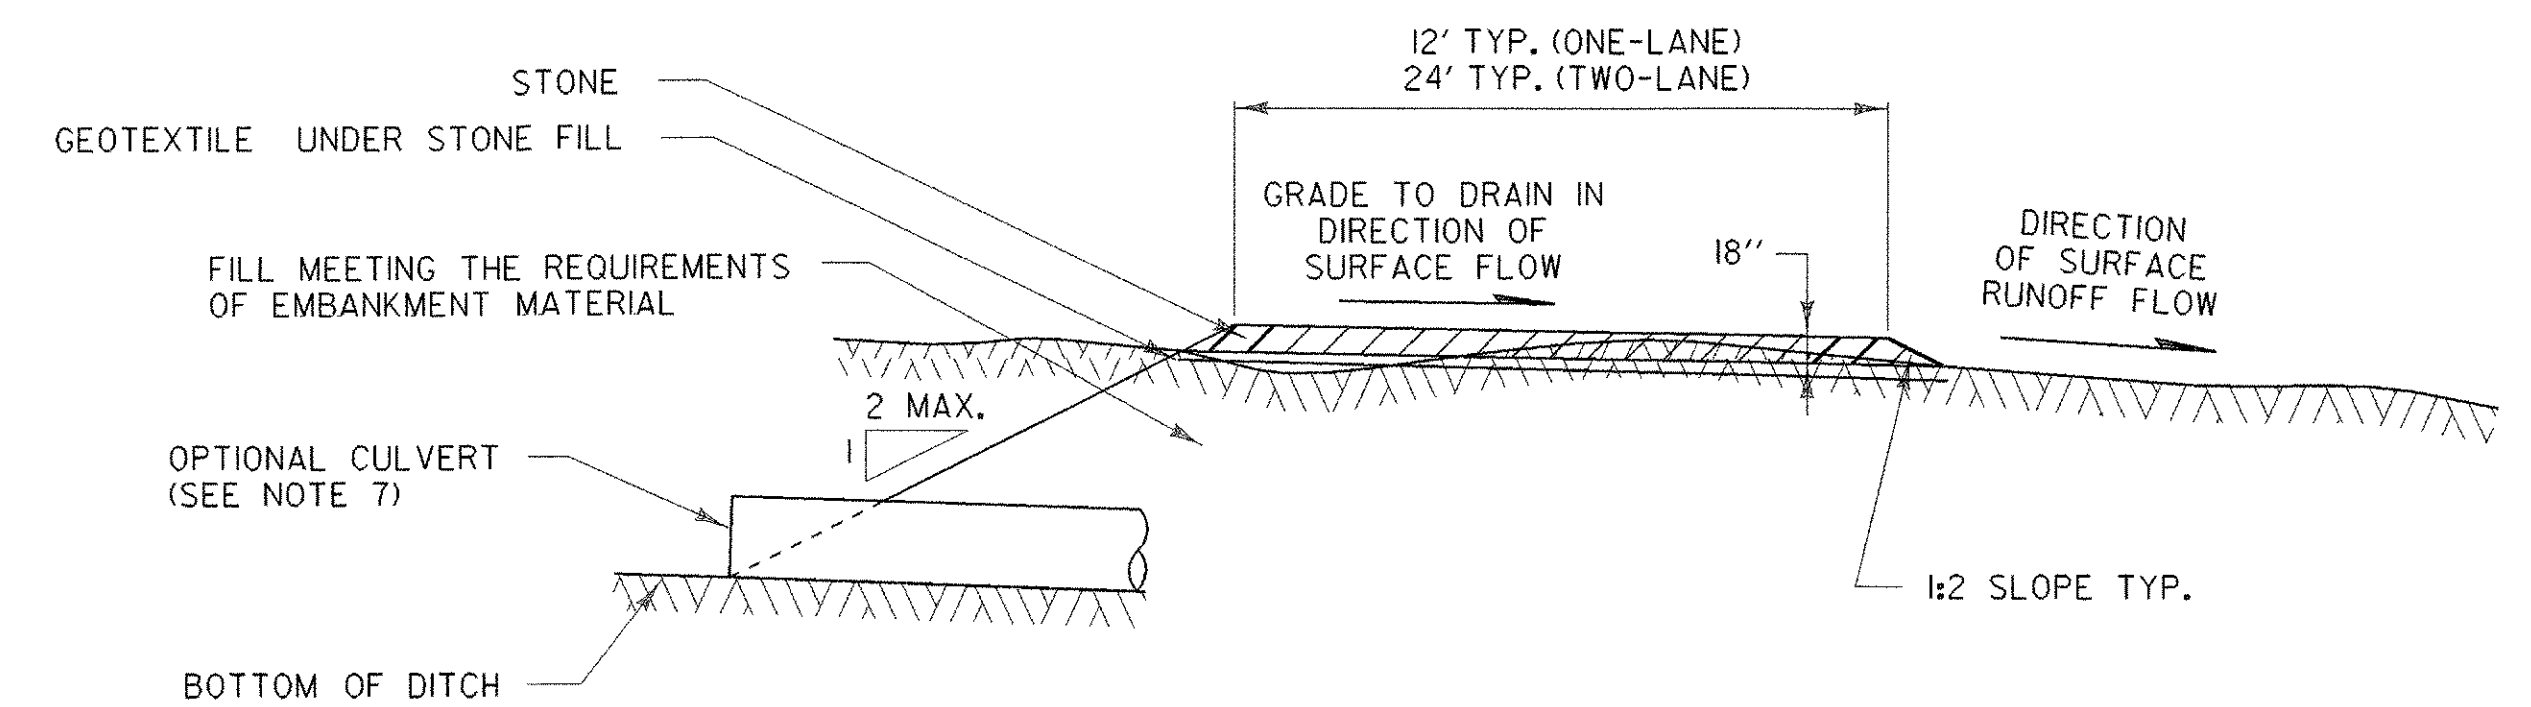


TYPICAL CONSTRUCTION ENTRANCE SECTION


| | |
|--|------------------------|
| PROJECT NAME: 1-89 EXIT 12 SB OFF RAMP | PLOT DATE: 17-MAY-2005 |
| PROJECT NUMBER: IM 089-2(35) | DRAWN BY: JDA / PGJ |
| FILE NAME: 18800F4ECP05.dgn | CHECKED BY: EPD |
| PROJECT LEADER: EPD | DESIGNED BY: JDA |
| CONSTRUCTION ENTRANCE DETAIL | SHEET 64 OF 76 |

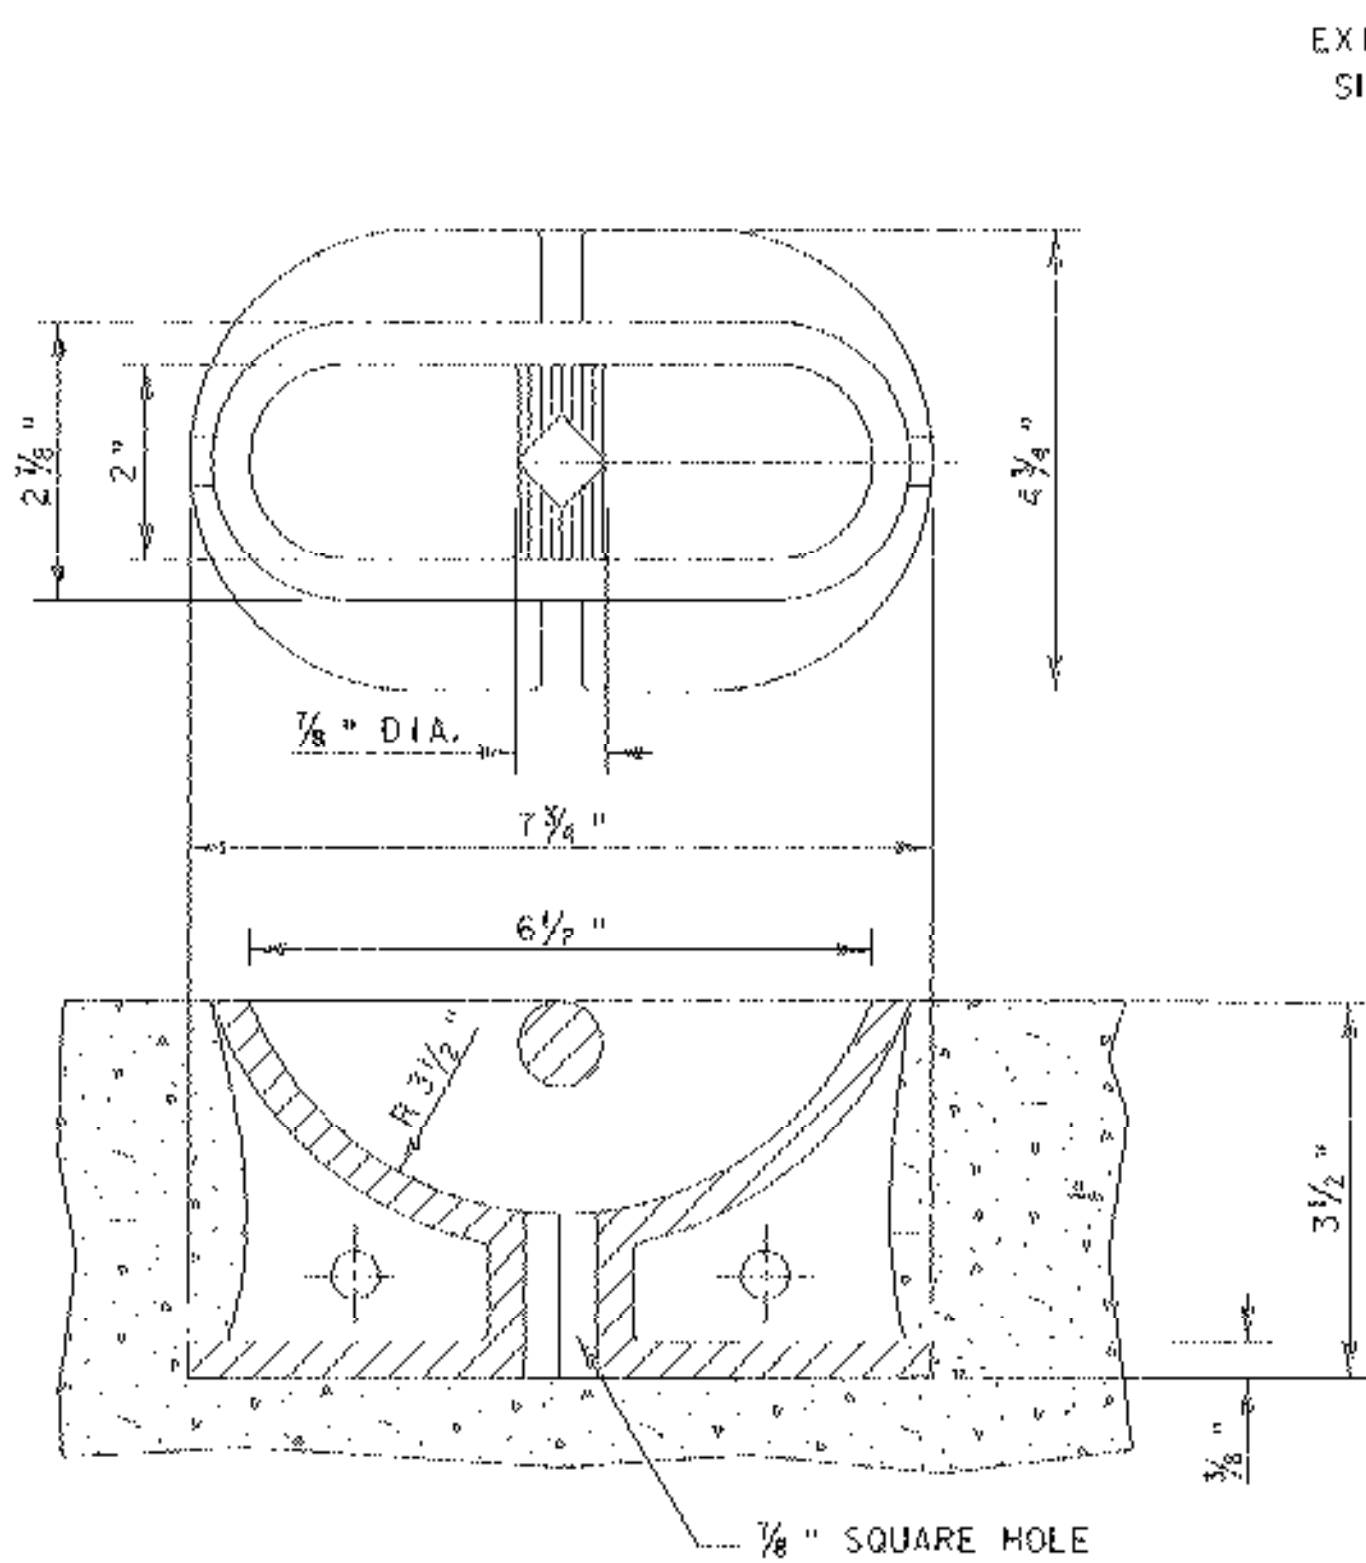


CONCRETE PAD - SIGN ANCHOR DETAIL
NOT TO SCALE

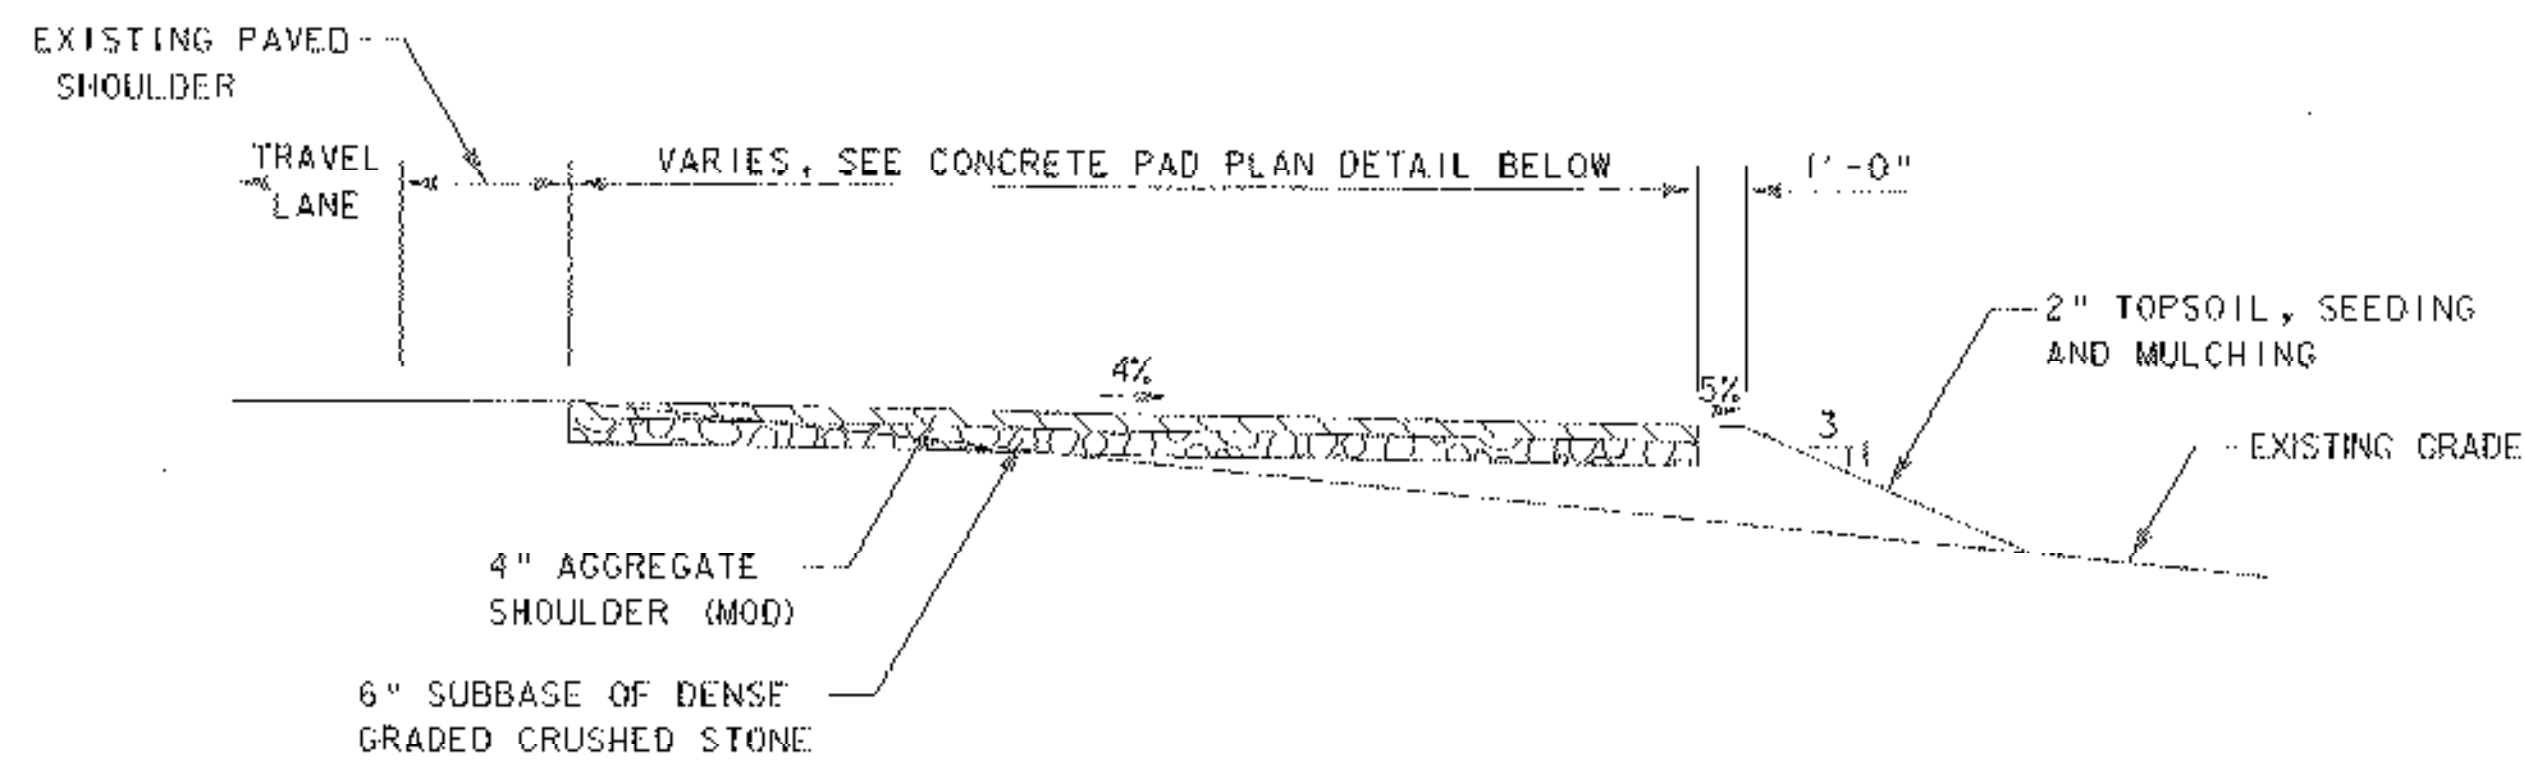


TYPICAL SECTION THROUGH APPROACH TO CONCRETE PAD
NOT TO SCALE

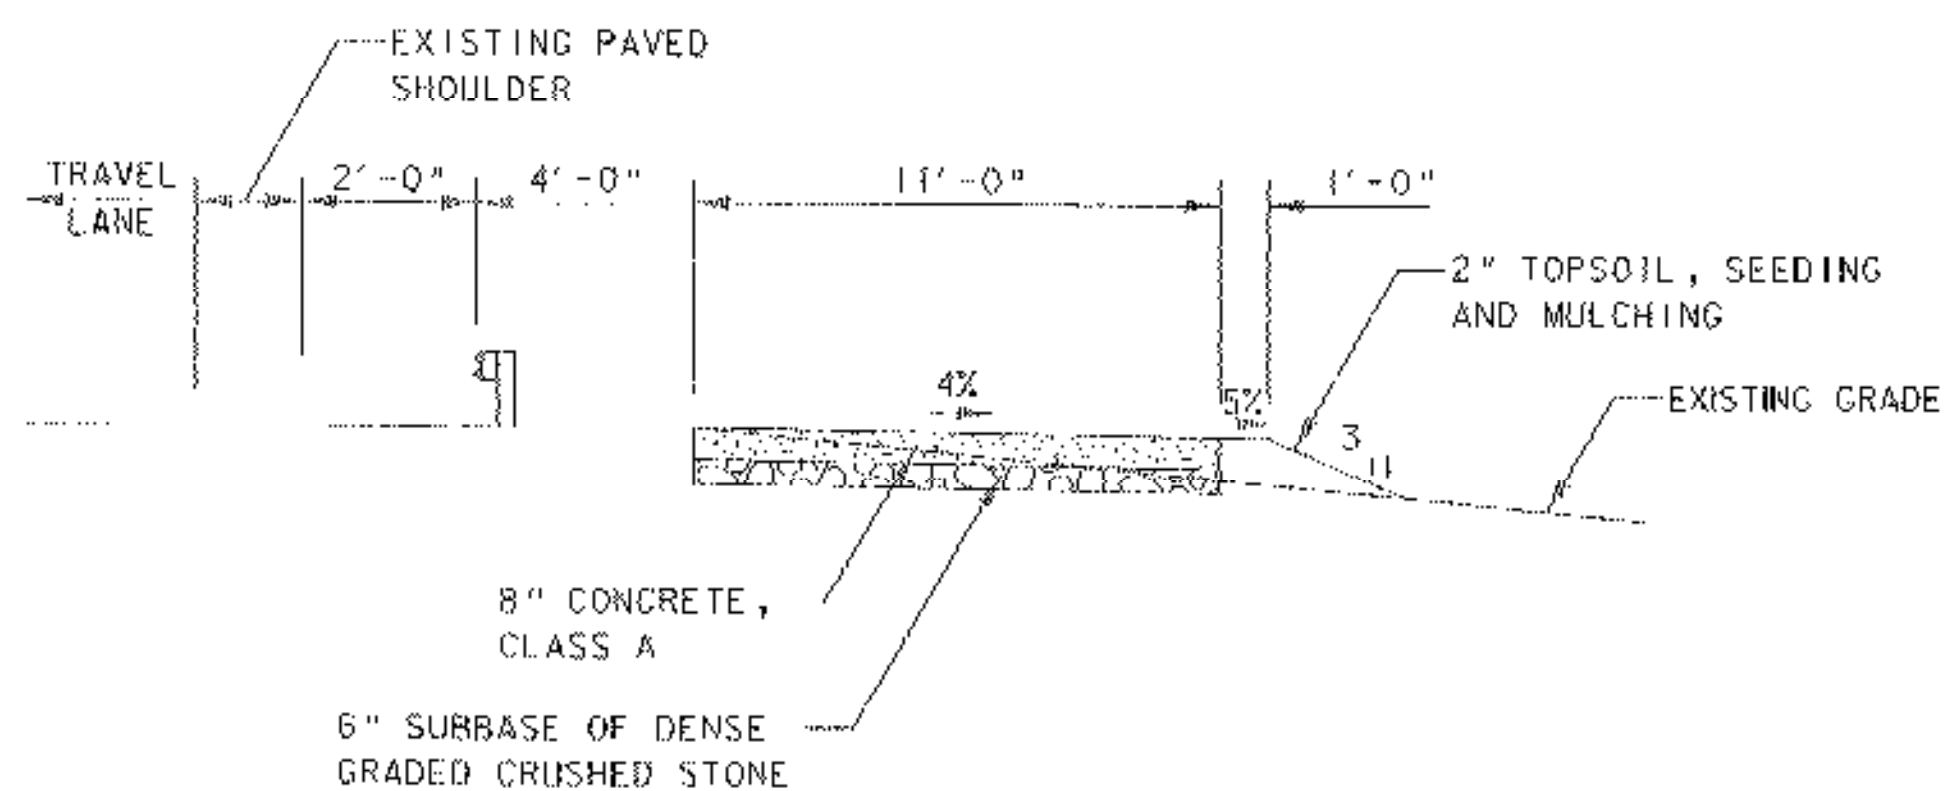


TYPICAL SECTION THROUGH CONCRETE SLAB
NOT TO SCALE

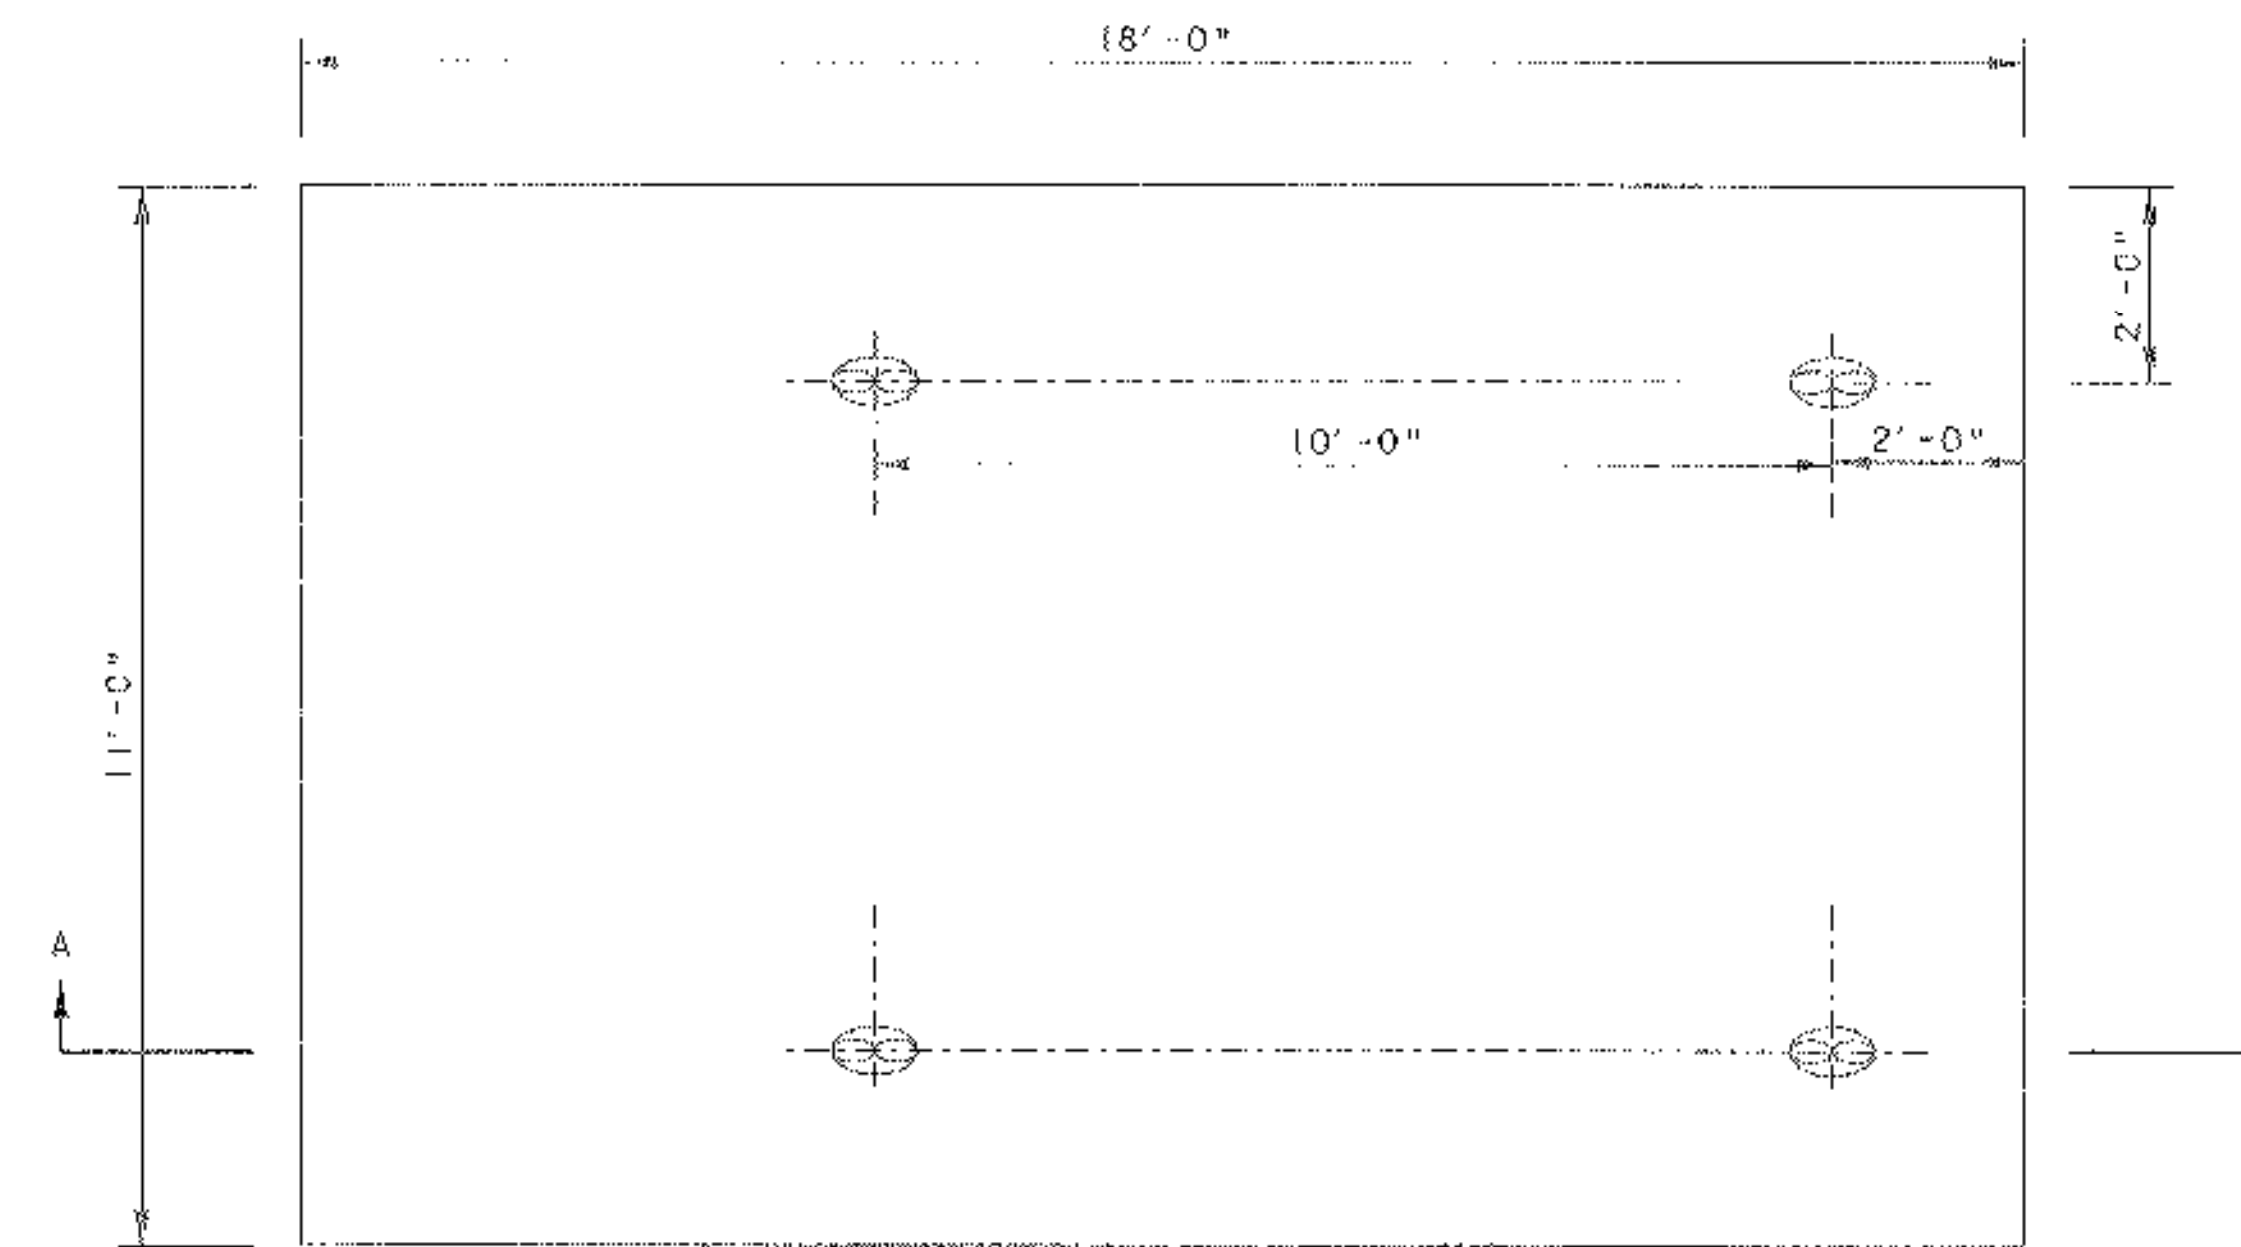

FOUNDATION FOR TUBULAR STEEL POSTS (MOD. - CONCRETE PAD)
NOT TO SCALE

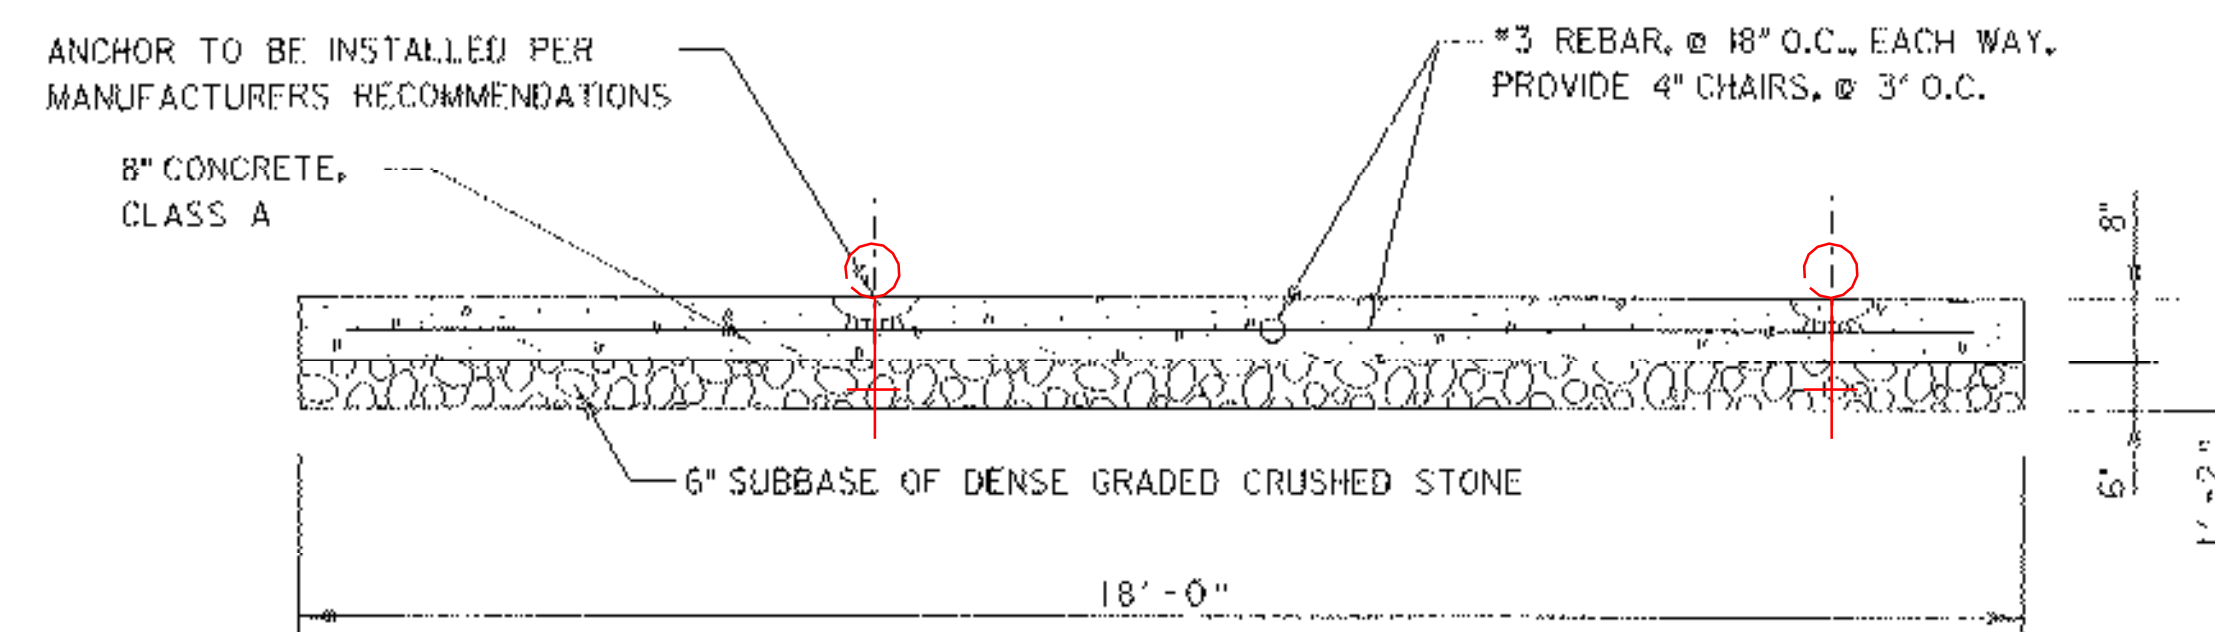

SECTION A-A
NOT TO SCALE

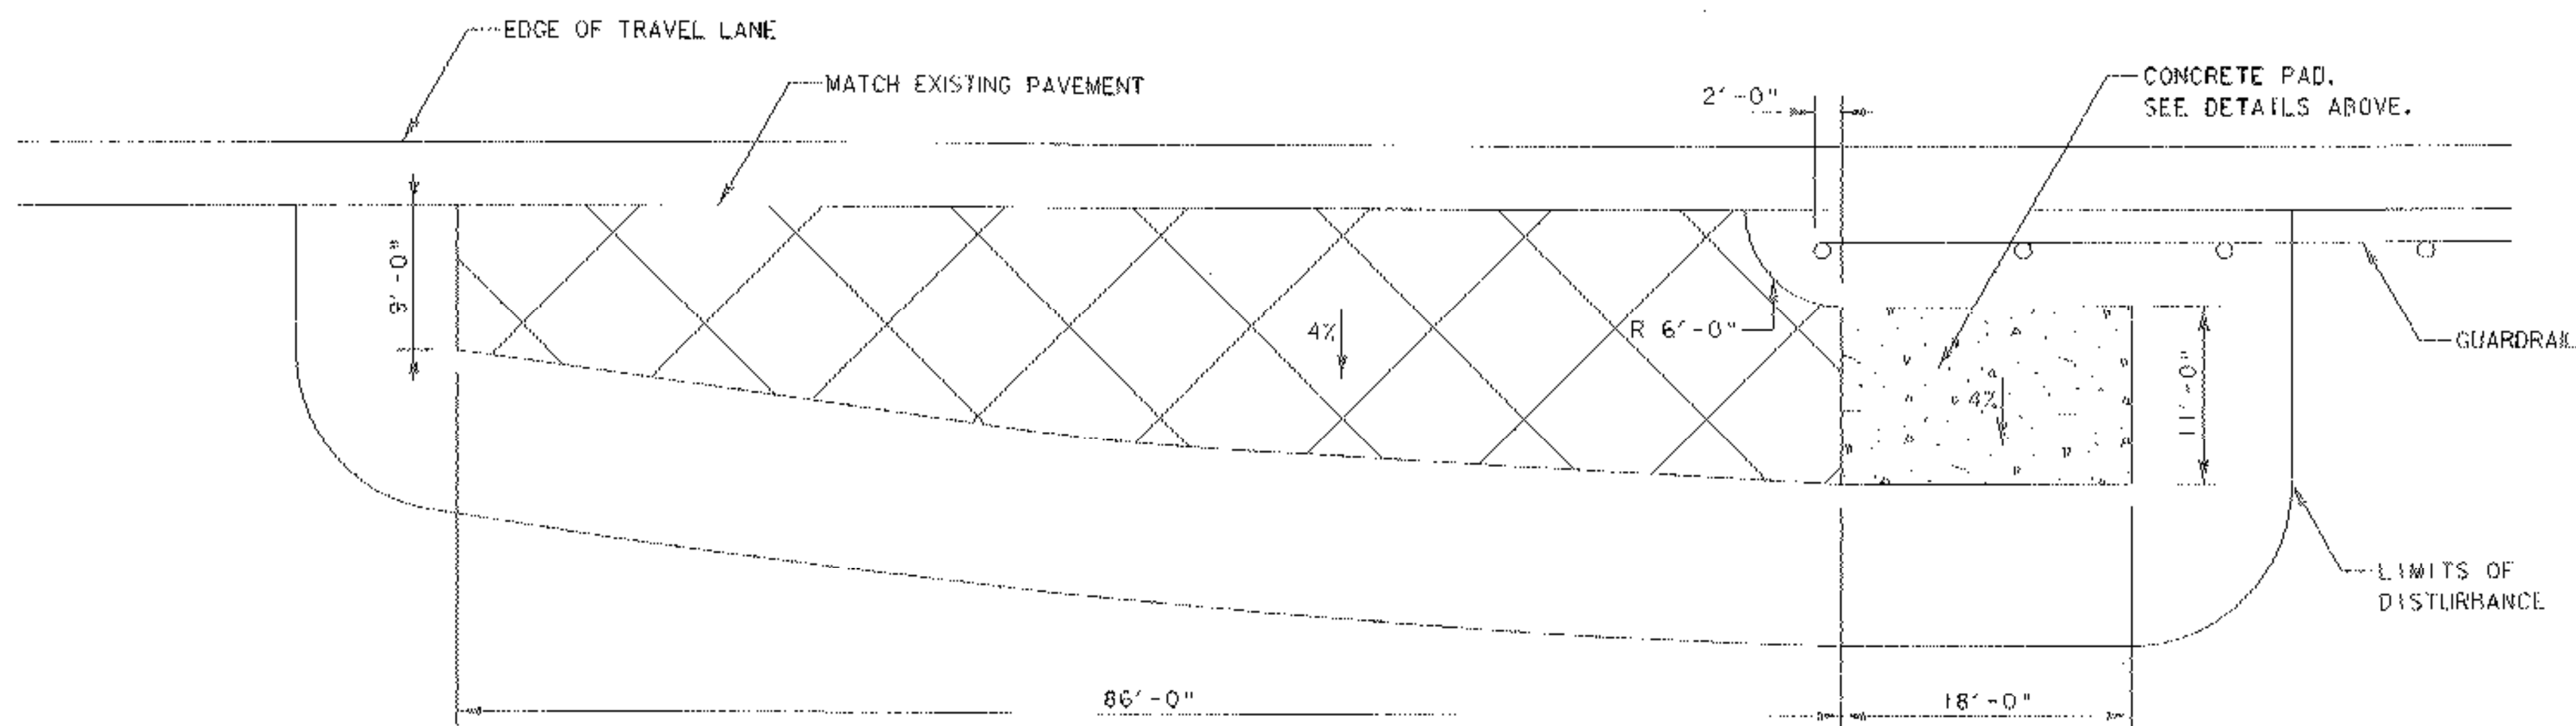


CONCRETE PAD PLAN
NOT TO SCALE

NOTES

1. CONCRETE PAD TO BE PLACED FOR THE NEW "AMBER ALERT" DYNAMIC MESSAGE SIGN LOCATED AT M.M. 86.220 (MAINLINE STATION 4552+41.6).
2. ANCHORS SHALL BE NEENAH R-3490 AIRPORT MOORING EYES OR APPROVED EQUAL.
3. COST OF CONCRETE, REBAR AND ANCHORS SHALL BE PAID FOR INCIDENTAL TO ITEM 675.43, "FOUNDATION FOR TUBULAR STEEL POSTS (MOD. - CONCRETE PAD)".


| | |
|--|------------------------|
| PROJECT NAME: I-89 EXIT 12 SB OFF RAMP | |
| PROJECT NUMBER: IM 089-2(35) | |
| FILE NAME: 18800F4D101.dgn | PLOT DATE: 14-JUN-2005 |
| PROJECT LEADER: EPD | DRAWN BY: JDA / PGJ |
| DESIGNED BY: JDA | CHECKED BY: EPD |
| CONCRETE PAD DETAILS | SHEET 65 OF 76 |

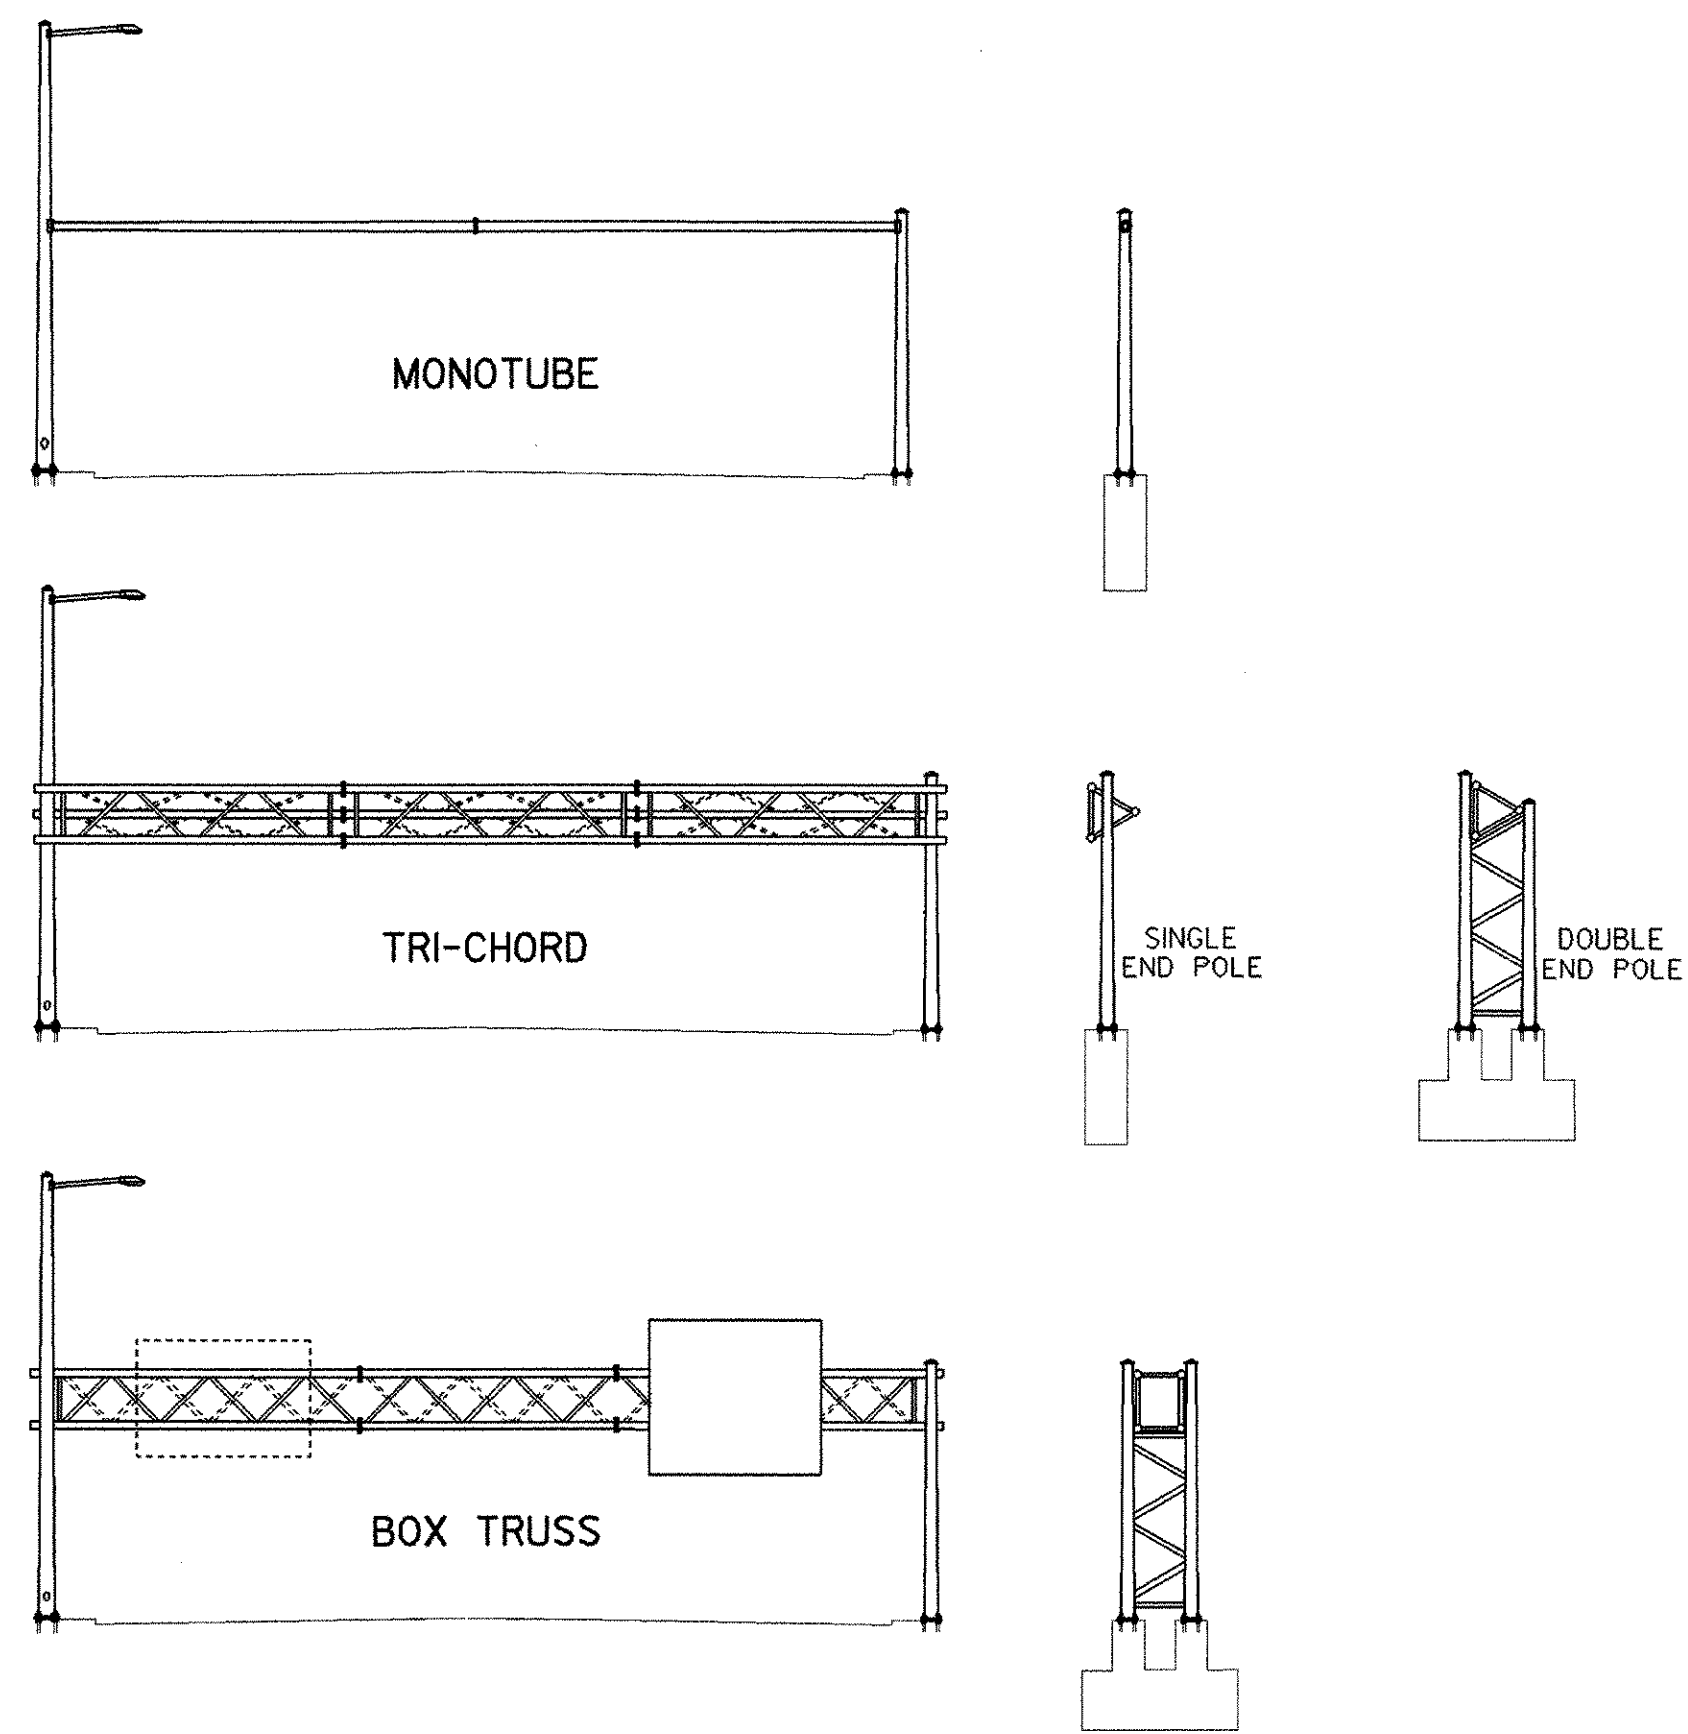


SIGN BRIDGE OPTIONS

NOTES:


1. MANUFACTURER TO DETERMINE TYPE OF STRUCTURE REQUIRED.
2. MONOTUBES SHALL NOT BE USED FOR SIGNS OVER 10' IN HEIGHT.
3. MINIMUM CLEARANCE FROM SIGNS TO ROADWAY IS 17'.

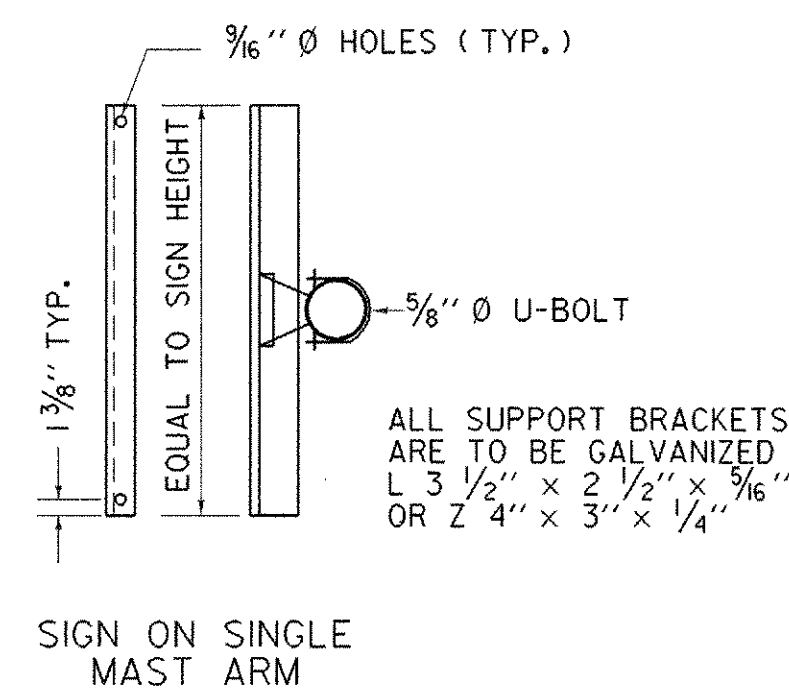


SIGN BRACKET DETAILS

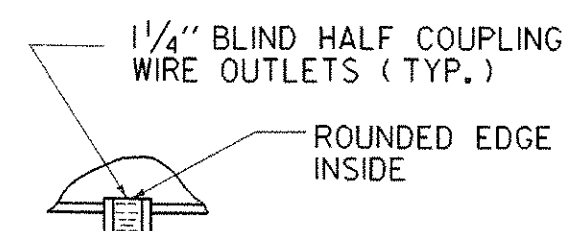


DETAIL A

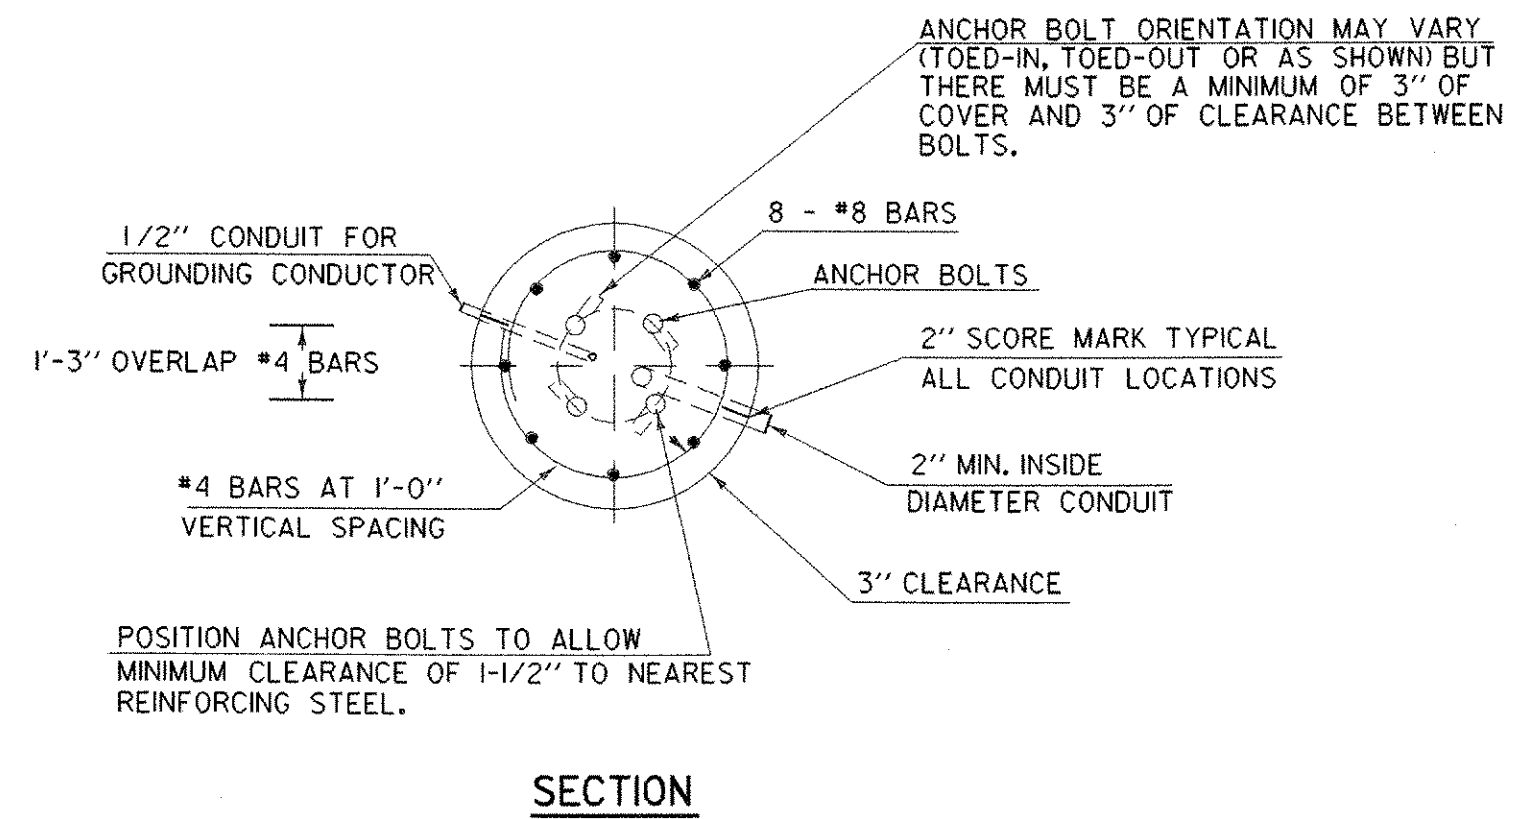

OVERHEAD TRAFFIC SIGN BRIDGE FOOTING DETAIL
(SPREAD FOOTINGS OR PILES ARE OPTIONAL)

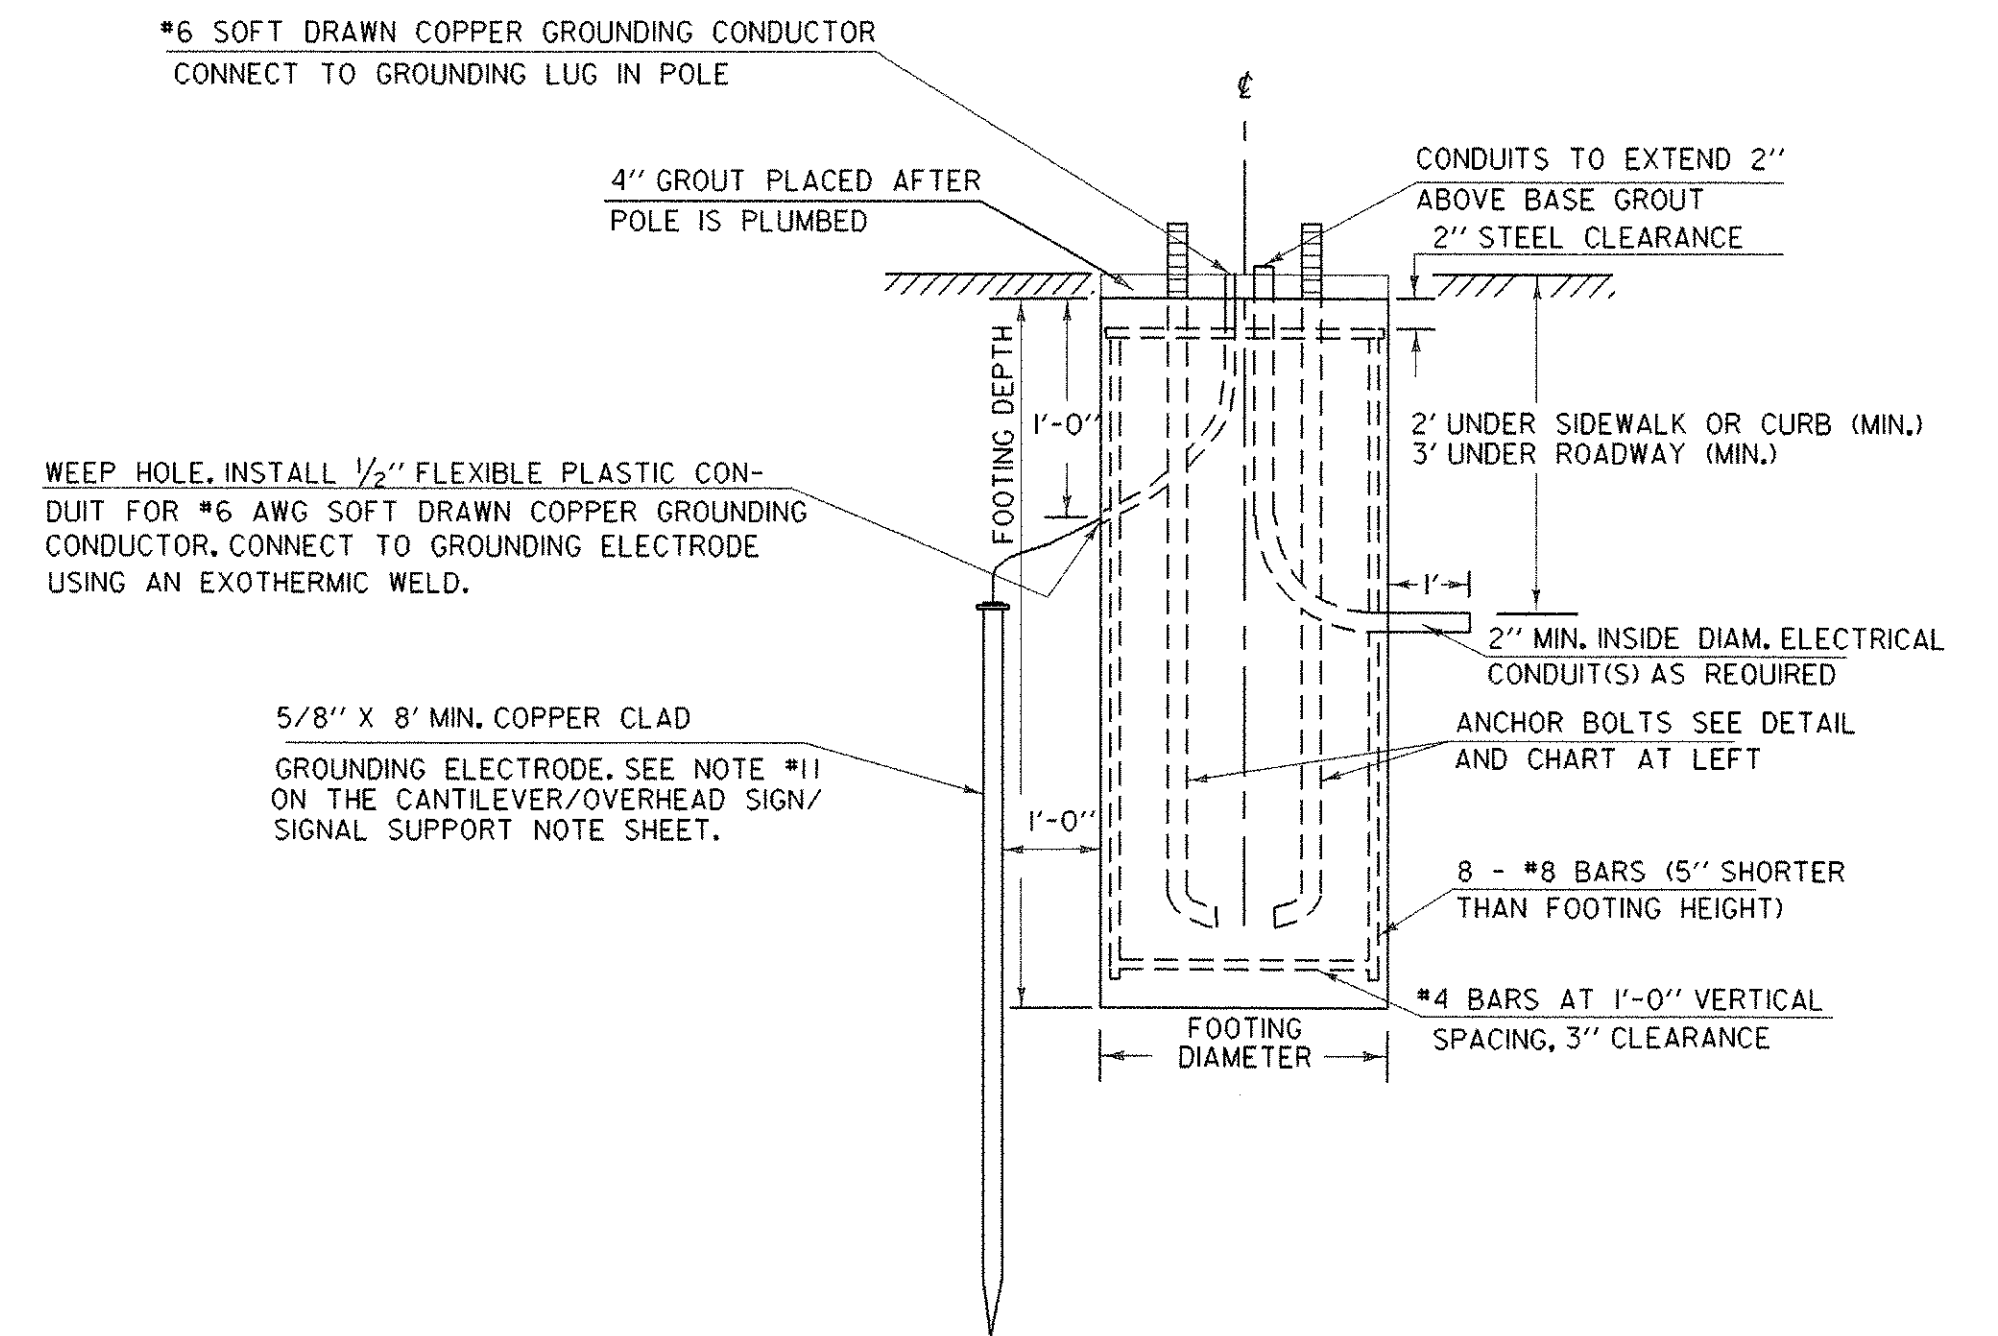


ELEVATION

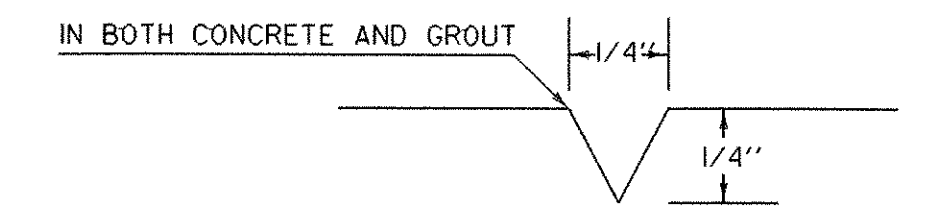


USED FOR CONDUIT LOCATION, SEE SECTION DETAIL AT LEFT

2" SCORE MARK DETAIL

| ANCHOR BOLT DETAIL | | |
|--------------------|--------|--------|
| SIZE | L (IN) | T (IN) |
| 1- 1/4" X 48" | 42 | 8 |
| 1- 1/2" X 60" | 54 | 9 |
| 1- 3/4" X 90" | 84 | 9 |
| 2" X 96" | 96 | 9 |

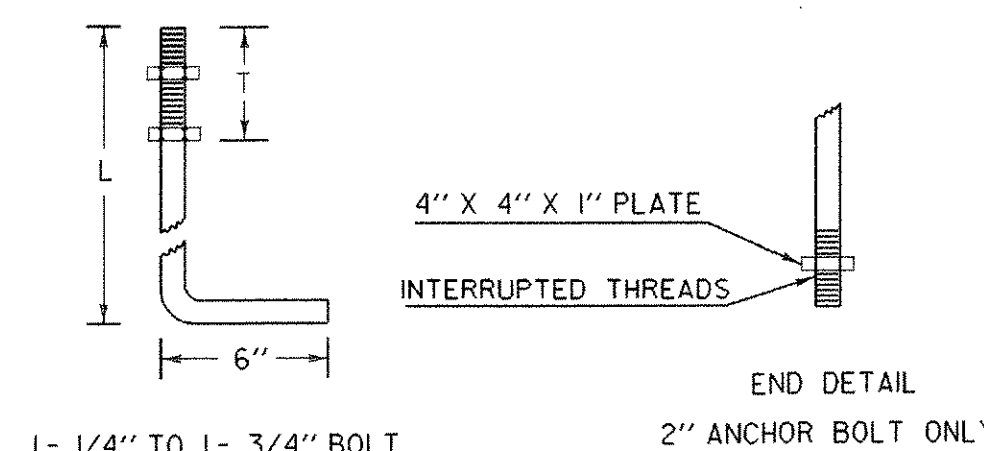

ANCHOR BOLT DETAIL

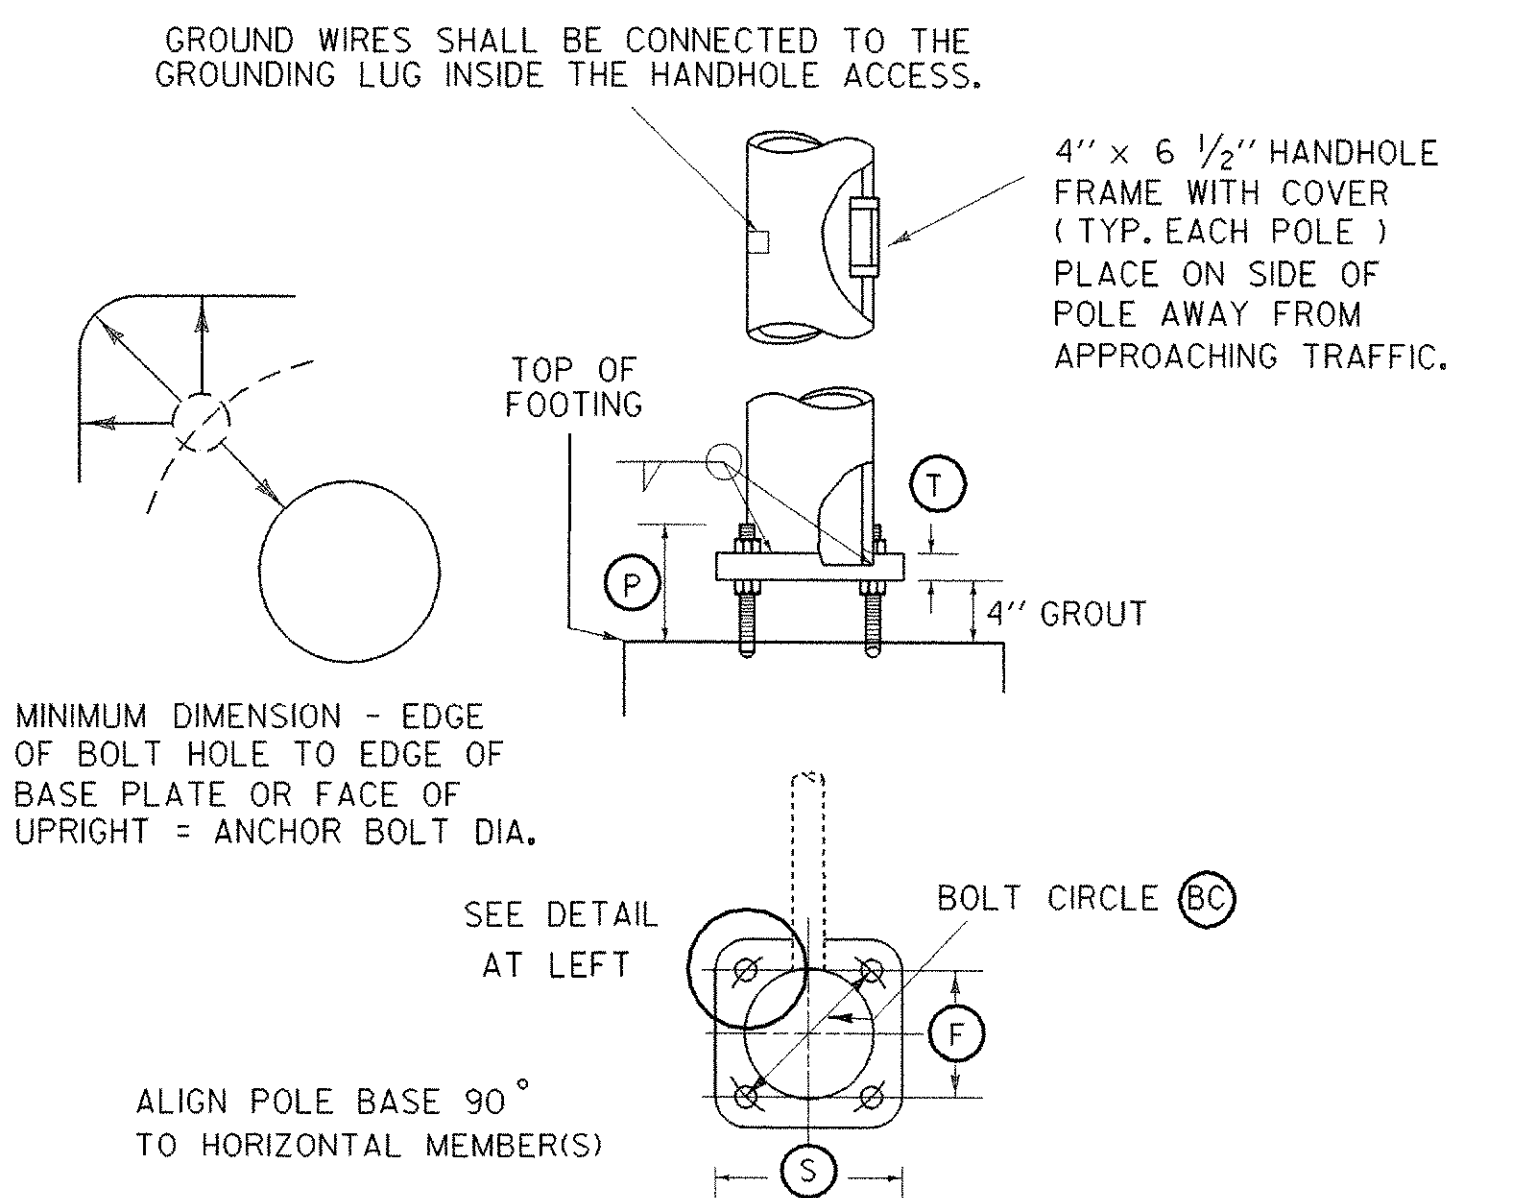

POLE BASE AND BASE PLATE DETAIL

PROJECT NAME: I-89 EXIT 12 SB OFF RAMP
PROJECT NUMBER: IM 089-2(35)

FILE NAME: 618800F4DT02.dgn
PROJECT LEADER: EPD
DESIGNED BY: JDA
SIGN BRIDGE DETAILS

PLOT DATE: 17-MAY-2005
DRAWN BY: JDA / PGJ
CHECKED BY: EPD
SHEET 66 OF 76

SIGN BRIDGE NOTES

1. ALL MATERIALS AND CONSTRUCTION SHALL CONFORM TO THE STATE OF VERMONT AGENCY OF TRANSPORTATION'S "STANDARD SPECIFICATIONS FOR CONSTRUCTION", DATED 2001, WITH CURRENT MODIFICATIONS.
2. OVERHEAD SIGN/SIGNAL SUPPORTS SHALL CONFORM TO AASHTO'S PUBLICATION ENTITLED "STANDARD SPECIFICATIONS FOR STRUCTURAL SUPPORTS FOR HIGHWAY SIGNS, LUMINAIRES, AND TRAFFIC SIGNALS", DATED 1985 OR ITS LATEST REVISION.
3. ADDITIONAL DESIGN CRITERIA ARE AS FOLLOWS:
 - CONCRETE $f_c = 1400$ PSI $f_c = 3500$ PSI
 - REINFORCING $f_s = 24000$ PSI (GRADE 60)
 - FOOTING SOIL PRESSURE : 3000 PSF (MAXIMUM)
 - WIND LOAD AND ICE LOAD PER AASHTO "STANDARD SPECIFICATIONS"
4. ANCHOR BOLTS

FOUR STAINLESS STEEL ANCHOR BOLTS WITH TWO HEXAGON NUTS, ONE WASHER AND ONE LOCK WASHER PER BOLT SHALL BE FURNISHED WITH EACH POLE. ANCHOR BOLT PLATES, WHEN USED, SHALL ALSO BE STAINLESS STEEL. SEE SUB-SECTION 714.09.
5. FLANGE BOLTS

ALL FLANGE BOLTS AND HEX NUTS SHALL BE HIGH STRENGTH STEEL AND SHALL CONFORM TO ASTM A325. THE FLANGE BOLTS SHALL BE CAPABLE OF RESISTING 133% OF THE FULL DESIGN STRESS OF THE TUBE AT ITS YIELD STRENGTH STRESS.
6. HORIZONTAL AND VERTICAL MEMBERS



STEEL TUBES SHALL BE FORMED AND WELDED WITH ONE CONTINUOUS LONGITUDINAL WELD ONLY. AFTER FORMING AND WELDING THEY SHALL BE COLD ROLLED TO ENSURE UNIFORMITY OF SIZE AND SMOOTHNESS OF WELD. THEY SHALL HAVE A MINIMUM YIELD STRENGTH OF 48,000 PSI. THERE SHALL BE NO TRANSVERSE WELDING EXCEPT AT THE FLANGE CONNECTIONS AND POLE BASE PLATES, WHERE THE TUBES SHALL TELESCOPE THE FLANGES AND PLATES AND BE CONTINUOUSLY WELDED BOTH SIDES INSIDE AND OUT TO WITHSTAND THE FULL TRANSFER OF THE BENDING STRENGTH TO THE BOLTS. OPTIONALLY, THE MEMBERS MAY BE A SERIES OF TWO OR THREE DIFFERENT DIAMETER PIPES WELDED TOGETHER.
7. GALVANIZING

ALL STEEL COMPONENTS, EXCEPT CONCRETE REINFORCING AND STAINLESS STEEL HARDWARE, ARE TO BE HOT DIPPED GALVANIZED AFTER FABRICATION. THE ASSEMBLIES SHALL BE DESIGNED AND FABRICATED TO PERMIT GALVANIZING ON ALL INTERIOR AND EXTERIOR SURFACES AND SHALL BE FREE OF POCKETS AND OTHER STRUCTURAL OBSTRUCTIONS THAT WILL NOT PERMIT PROPER DEPOSITION OF ZINC COATING. GALVANIZING SHALL BE IN ACCORDANCE WITH ASTM A123 AND A153.
8. WELDING
 - A. ALL DESIGN DETAILS, WORKMANSHIP, PROCEDURES AND INSPECTION SHALL CONFORM WITH SUB-SECTION 506.10.
 - B. ALL WELDS SHALL BE AT LEAST AS STRONG AS THE MATERIAL(S) BEING WELDED.
9. FOOTINGS
 - A. FOOTINGS SHALL BE DESIGNED TO RESIST LOADS EQUAL TO, OR GREATER THAN, THE MAXIMUM LOADS THAT THE POLE IS DESIGNED FOR.
 - B. THREE TYPES OF FOUNDATIONS, AS OUTLINED IN AASHTO STANDARD SPECIFICATIONS (SEE NOTE 2) SECTION 1.8.2 (C) SHALL BE ALLOWED.
 1. DRILLED SHAFTS
 2. SPREAD FOOTINGS
 3. PILES.
 - C. DRILLED SHAFT FOOTINGS SHALL BE POURED IN DRILLED SHAFTS AGAINST UNDISTURBED MATERIAL. THE TOP TWO FEET OF SOIL SHALL BE NEGLECTED FOR DESIGN PURPOSES. THE MAXIMUM FOOTING DIAMETER SHALL BE THREE FEET AND THE MAXIMUM DEPTH SHALL BE TWELVE FEET. IF THESE LIMITS ARE EXCEEDED OR IF THE SOIL IS NOT CAPABLE OF A BEARING PRESSURE OF 3000 PSF, A SPREAD FOOTING SHALL BE USED.
- D. AS AN ALTERNATIVE TO THE DRILLED HOLES, FOOTINGS MAY BE POURED IN EXCAVATED HOLES USING THE PROPER FORMS, WHICH MUST BE REMOVED. THE EXCAVATED HOLES SHALL BE AT LEAST TWO FEET CLEAR OF THE FOOTING SIDES AND ONE FOOT DEEPER THAN THE FOOTING. CARE SHALL BE TAKEN TO AVOID EXCAVATING AROUND THE TOP OF THE FOOTING. THE BACKFILL MATERIAL SHALL BE COMPACTED AS DESCRIBED IN SUB-SECTION 204.12. DESIGN LIMITS AS FOR AUGERED FOOTING APPLY.
- E. WHEN THE DESIGN DEPTH OF A FOOTING CANNOT BE OBTAINED DUE TO UNFORSEEN FIELD CONDITIONS, THE CONTRACTOR SHALL NOTIFY THE ENGINEER AND OBTAIN A REVISED FOOTING DETAIL FROM THE ENGINEER.
- F. ANY BACKFILL PLACED ADJACENT TO THE FOOTING SHALL BE GRANULAR MATERIAL MEETING THE REQUIREMENTS FOR GRANULAR BACKFILL FOR STRUCTURES, SUB-SECTION 704.08. CONCRETE FOR FOOTING SHALL CONFORM TO THE REQUIREMENTS OF CONCRETE, CLASS B, SECTION 501, STRUCTURAL CONCRETE. GROUT MATERIAL SHALL BE NON-SHRINKING MORTAR CONFORMING TO SUB-SECTION 707.03 (MORTAR TYPE IV).
- G. SIGNALS/SIGNS SHALL BE INSTALLED AND LEVELED AND POLES SHALL BE PLUMB PRIOR TO PLACING GROUT UNDER POLE BASE.
10. SHOP DRAWINGS (6 COPIES OF EACH) SHALL BE SUBMITTED TO THE STATE OF VERMONT, AGENCY OF TRANSPORTATION, STRUCTURES DIVISION FOR APPROVAL PRIOR TO FABRICATION. THE SHOP DRAWINGS SHALL INCLUDE THE FOLLOWING INFORMATION:
 - A. DETAILED DRAWING OF EACH COMPONENT OF THE STRUCTURE.
 - B. MATERIAL SPECIFICATION FOR EACH COMPONENT OF THE STRUCTURE, EITHER BY COMPLETE SPECIFICATION OR REFERENCE TO APPLICABLE ASTM STANDARDS.
 - C. NOTATION OF PROJECT NAME, PROJECT NUMBER, ROUTE NUMBER, AND STRUCTURE STATIONING (TO BE INCLUDED ON EACH SHEET).
 - D. DETAILS FOR LOCATION OF SIGNS/SIGNALS AND ATTACHMENT HARDWARE FOR THE SUPPORT STRUCTURE.
 - E. ALL ELEVATIONS AND DIMENSIONS NECESSARY TO PROVIDE A COMPLETE SET OF RECORD PLANS.
 - F. DEAD LOAD DEFLECTION AND CAMBER INFORMATION.
 - G. WELDING DETAILS AND PROCEDURES ARE REQUIRED FOR ALL WELDS. PROCEDURES SHALL BE SUBMITTED FOR APPROVAL WITH REFERENCE TO EACH WELD IDENTIFIED ON THE SHOP DRAWINGS. (SEE SUB-SECTION 506.10)
11. EACH OVERHEAD TRAFFIC SIGNAL/SIGN SUPPORT SHALL BE GROUNDED. THE GROUND SHALL CONSIST OF:
 - A) AN INTERNAL GROUND LUG OPPOSITE THE HAND HOLE.
 - B) A #6 (MIN.) SOFT DRAWN COPPER GROUNDING ELECTRODE CONDUCTOR,
 - C) A 5/8" X 8' (MIN.) COPPER CLAD GROUNDING ELECTRODE. THE RESISTANCE TO GROUND SHALL BE 25 OHMS OR LESS. ADDITIONAL GROUNDING ELECTRODES MAY BE REQUIRED (MINIMUM SPACING SHALL BE 6').


WHEN A POWER SERVICE, METER AND DISCONNECT ARE ATTACHED TO A POLE, THERE SHALL BE A CONTINUOUS GROUNDING ELECTRODE CONDUCTOR FROM THE METER AND DISCONNECT WHICH MAY RUN INTERNAL TO THE UPRIGHT, THROUGH THE 1/2" FLEXIBLE TUBING IN THE CONCRETE BASE TO THE REQUIRED GROUNDING ELECTRODE(S). THE GROUNDING ELECTRODE CONDUCTOR FROM THE POLE GROUNDING LUG, CONTROLLER CABINET AND/OR LUMINAIRE MAY ATTACH TO THIS CONTINUOUS GROUNDING ELECTRODE CONDUCTOR FROM THE SERVICE METER AND DISCONNECT. THE CONTRACTOR SHALL PERFORM A RESISTANCE TO GROUND TEST ON THE CONTINUOUS GROUNDING ELECTRODE CONDUCTOR FROM THE SERVICE METER AND DISCONNECT AND PROVIDE A WRITTEN STATEMENT TO THE AREA ELECTRICAL INSPECTOR THAT THE GROUNDING ELECTRODE CONDUCTOR IS CONTINUOUS FROM THE SERVICE METER AND DISCONNECT AND THE RESISTANCE TO GROUND IS 25 OHMS OR LESS.
12. THE COST OF SIGNAL/SIGN SUPPORTS, INCLUDING ALL HARDWARE, SIGN BRACKETS, FOOTINGS AND LUMINAIRE ARMS SHALL BE INCLUDED IN THE UNIT BID PRICE FOR ITEM 677.11, 677.12, 677.13 OR 678.15, WHICHEVER IS APPLICABLE. THESE COMPONENTS SHALL CONFORM TO ALL APPLICABLE PROVISIONS OF SECTIONS 677, 678, AND 679.
13. HORIZONTAL MEMBERS SHALL BE CAMBERED AND THE VERTICAL POLES BACKRACKED (WHERE APPLICABLE) TO THE ANTICIPATED DEAD LOAD DEFLECTION PLUS THE CAMBER, IF ANY, SPECIFIED ON THE PLANS.
14. AN EQUIVALENT ALTERNATE DESIGN MAY BE SUBSTITUTED FOR THE DETAILS AND MATERIALS SHOWN.
15. THE DETAILS OF DESIGN FOR THE STRUCTURE AND FOOTINGS ARE TO BE SUPPLIED BY THE CONTRACTOR AND/OR BY THE MANUFACTURER. THE STRUCTURE SHALL BE DESIGNED TO RESIST THE MAXIMUM LOADING AS OUTLINED IN THE AASHTO STANDARD SPECIFICATIONS (SEE NOTE 2). ALL DETAILS OF THE STRUCTURE AND THE FOOTING SHALL BE CHECKED AND STAMPED BY A STRUCTURAL ENGINEER REGISTERED IN THE STATE OF VERMONT PRIOR TO SUBMITTAL OF THE SHOP DRAWINGS TO THE VERMONT AGENCY OF TRANSPORTATION.
16. IN ADDITION TO THE SHOP DRAWINGS OUTLINED IN NOTE 10 THE CONTRACTOR SHALL SUBMIT ALL DESIGN CALCULATIONS TO THE VERMONT AGENCY OF TRANSPORTATION, STRUCTURES DIVISION, SHOWING THE FOLLOWING INFORMATION FOR EACH OF THE VERTICAL AND HORIZONTAL COMPONENTS OF THE STRUCTURE AND FOOTING:
 - A. THE DESIGN AXIAL AND SHEAR FORCES AND BENDING AND TORSIONAL MOMENTS.
 - B. THE DESIGN AXIAL, BENDING AND SHEAR STRESSES AND THE COMBINED STRESS RATIO.
 - C. VIBRATION AND FATIGUE CALCULATIONS AS SET FORTH IN SECTION 9 OF THE AASHTO PUBLICATION REFERENCED IN NOTE 2.
 - D. THE ALLOWABLE AXIAL, BENDING, AND SHEAR STRESSES.
 - E. ITEMS A, B, D - SHALL BE SHOWN FOR EACH OF THE GROUP LOADINGS (I, II, III) AND FOR THE BASIC WIND LOAD APPLIED TO THE TWO CASES OUTLINED IN THE AASHTO STANDARD SPECIFICATIONS (SEE NOTE 2) SECTION 1.2.5 (D)(4).
 - F. FAILURE TO SUPPLY THE PROPER DESIGN INFORMATION SHALL BE CAUSE FOR REJECTION OF THE STRUCTURE.
 - G. A MINIMUM OF FOUR (4) WEEKS SHALL BE REQUIRED FOR REVIEW BY THE VERMONT AGENCY OF TRANSPORTATION, STRUCTURES DIVISION.
17. THE CONTRACTOR/MANUFACTURER SHALL BE RESPONSIBLE FOR COMPLETION OF THE STRUCTURE AND FOOTING DATA ON THE DETAIL SHEET(S).
18. FOR INSTALLATIONS WHERE BOTH "EXISTING" AND "FUTURE" CONDITIONS ARE SHOWN, THE SUPPORTS SHALL BE DESIGNED FOR THE MORE SEVERE OF THE TWO LOADING CONDITIONS. THE INFORMATION OUTLINED IN NOTE 16 ABOVE SHALL BE PROVIDED FOR BOTH THE LOADING CONDITIONS.
19. THE TRAFFIC SIGNALS SHALL BE MOUNTED TO THE ARM OR POLE USING A FIXED MOUNT SYSTEM AS SHOWN ON STANDARD E-171C, UNLESS OTHERWISE NOTED ON THE CROSS SECTION SHEET.
20. BASE PLATES SHALL BE STAMPED WITH THE VERTICAL POLE DIAMETER, HEIGHT, YIELD STRENGTH, GAUGE AND THE HORIZONTAL MEMBER DIAMETER, LENGTH, YIELD STRENGTH, GAUGE, ALTERNATELY, THE INFORMATION MAY BE STAMPED ON A METAL TAG RIVETED TO THE POLE NEAR THE HANDHOLE.
21. SEE STANDARD E-171A FOR ADDITIONAL NOTES.
22. SEE LAYOUT SHEET FOR INTERSECTION LAYOUT.

PROJECT NAME: I-89 EXIT 12 SB OFF RAMP
PROJECT NUMBER: IM 089-2(35)


| | |
|-----------------------------|------------------------|
| FILE NAME: 618800F4DT03.dgn | PLOT DATE: 17-MAY-2005 |
| PROJECT LEADER: EPD | DRAWN BY: JDA / PGJ |
| DESIGNED BY: JDA | CHECKED BY: EPD |
| SIGN BRIDGE NOTES | SHEET 67 OF 76 |

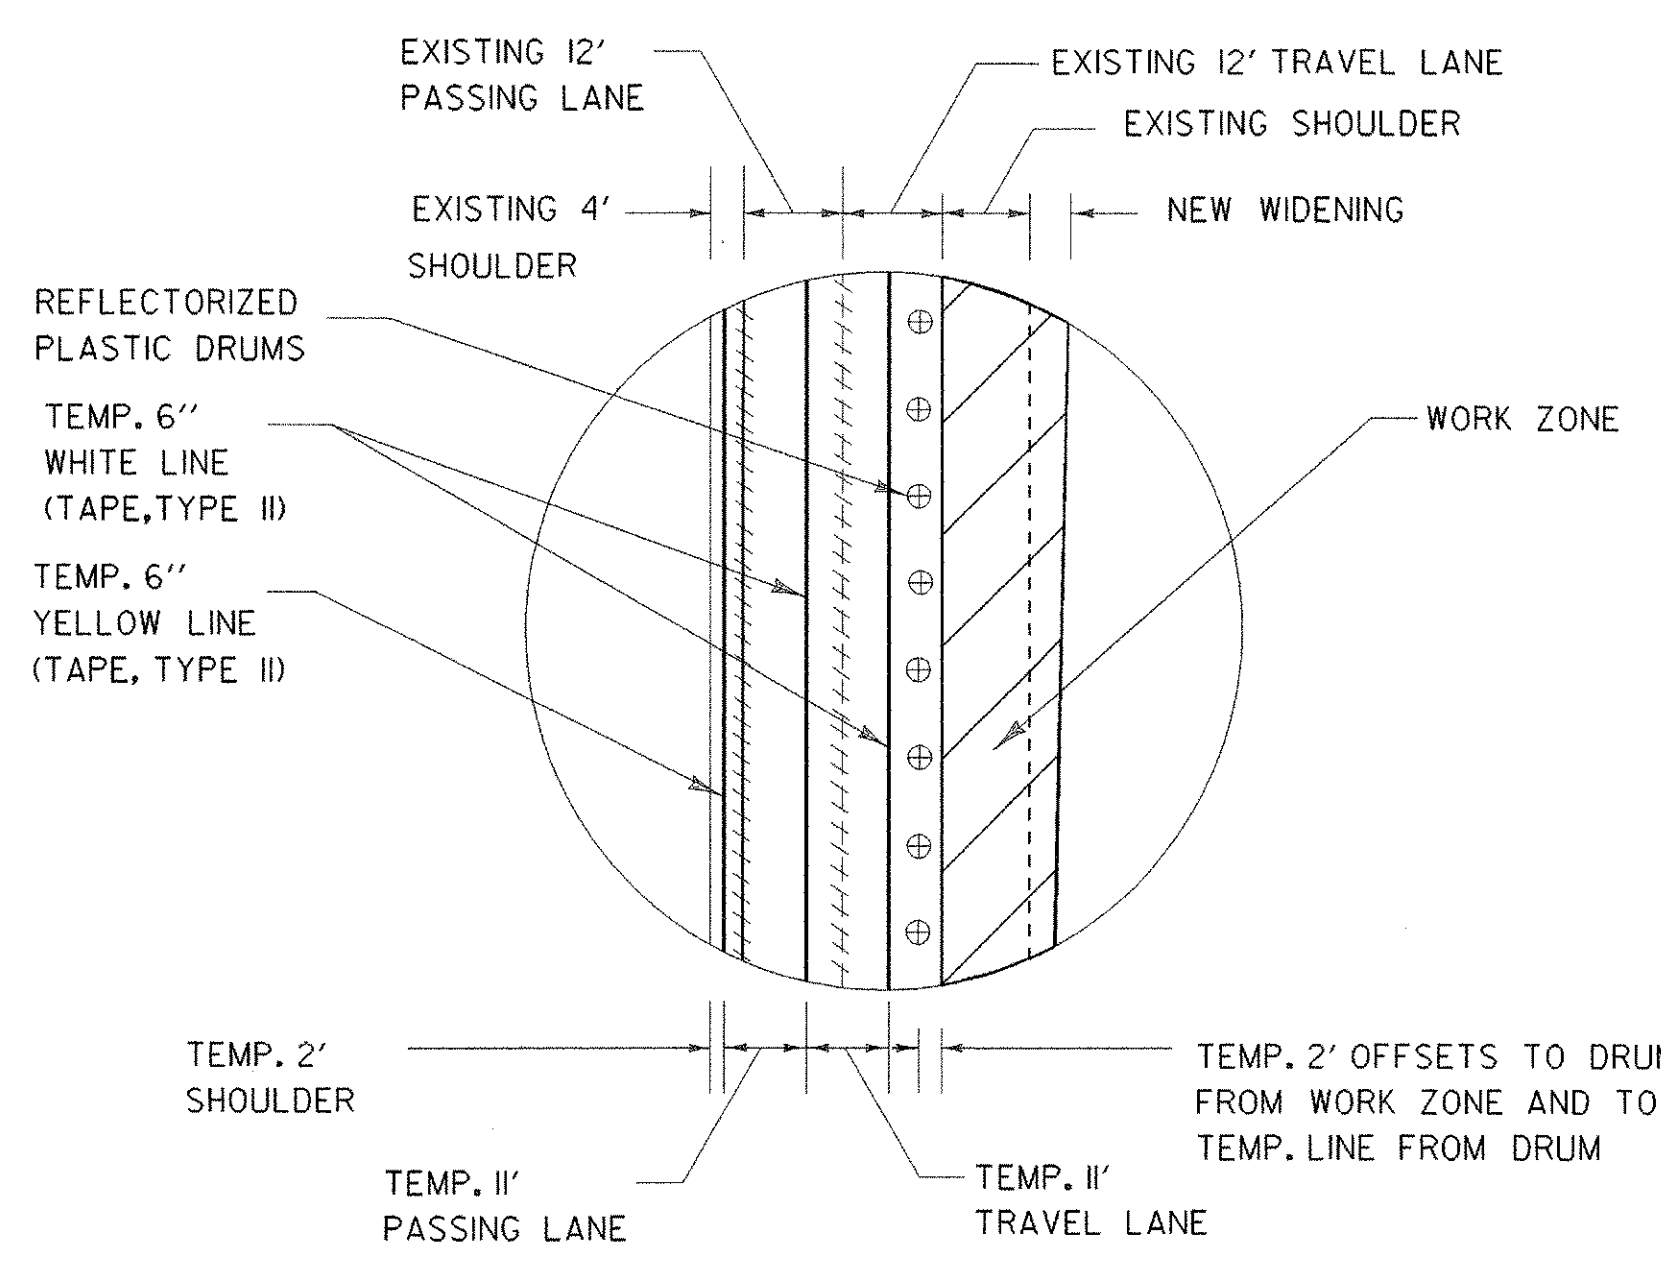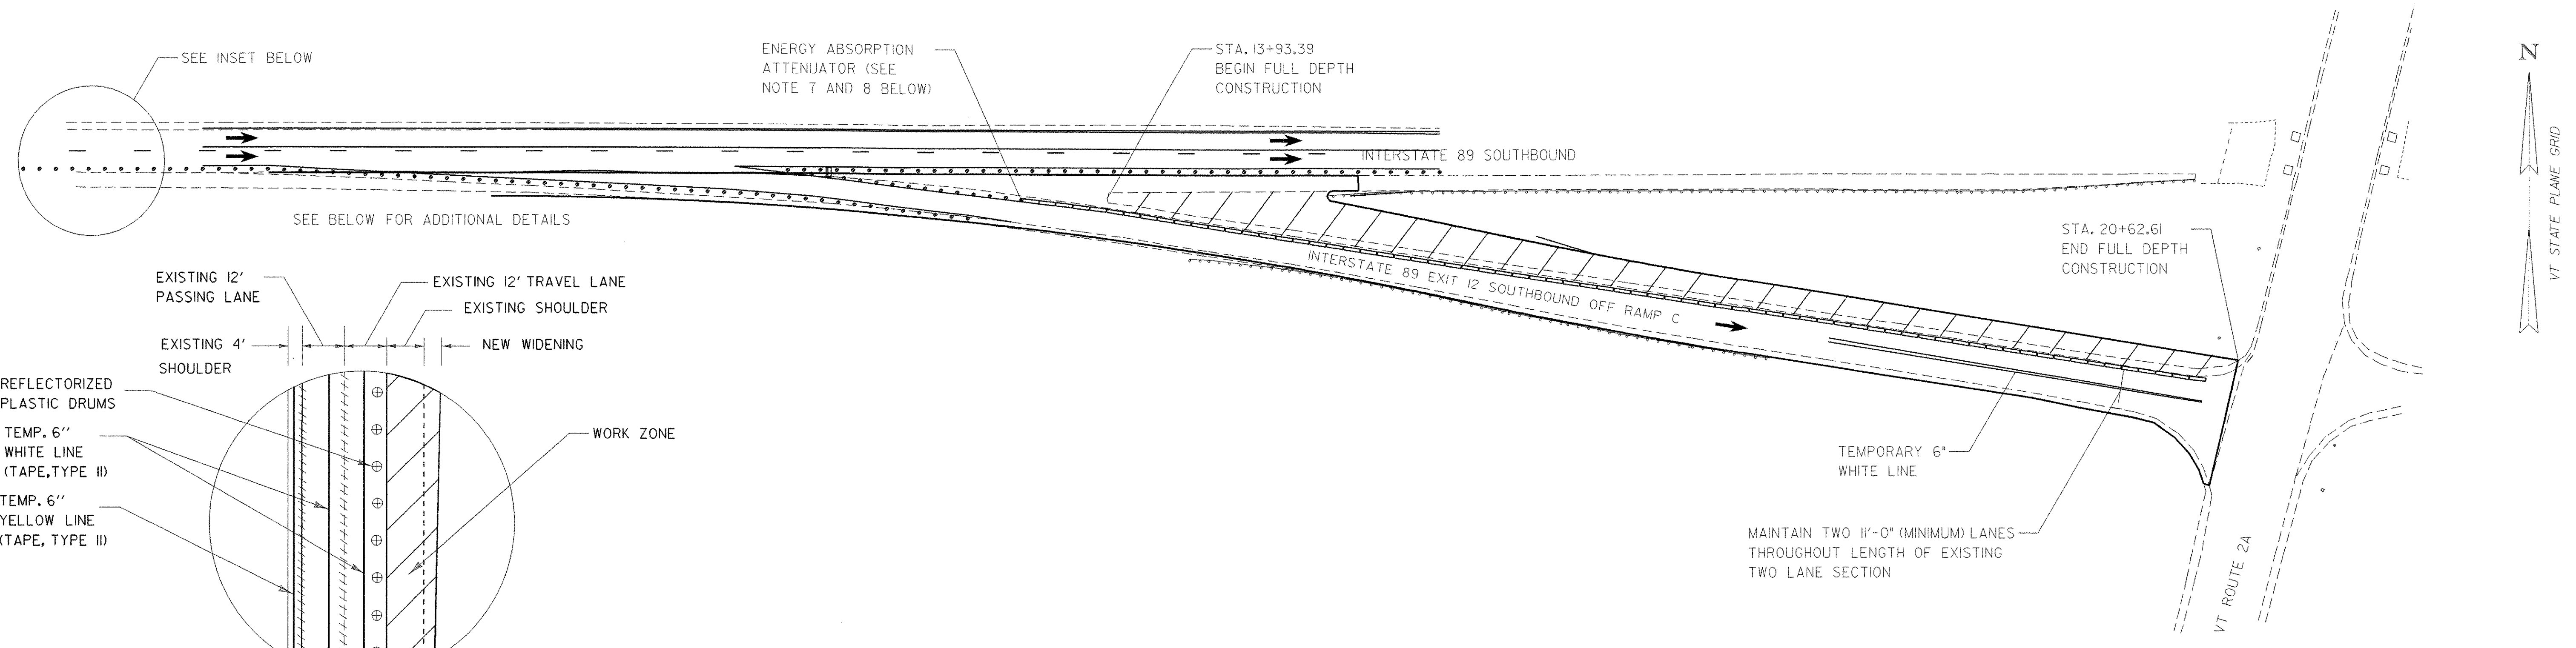



TRAFFIC CONTROL PLAN FOR I-89 EXIT 12 RAMP C

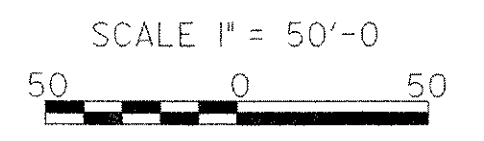

INSET DETAIL
NOT TO SCALE

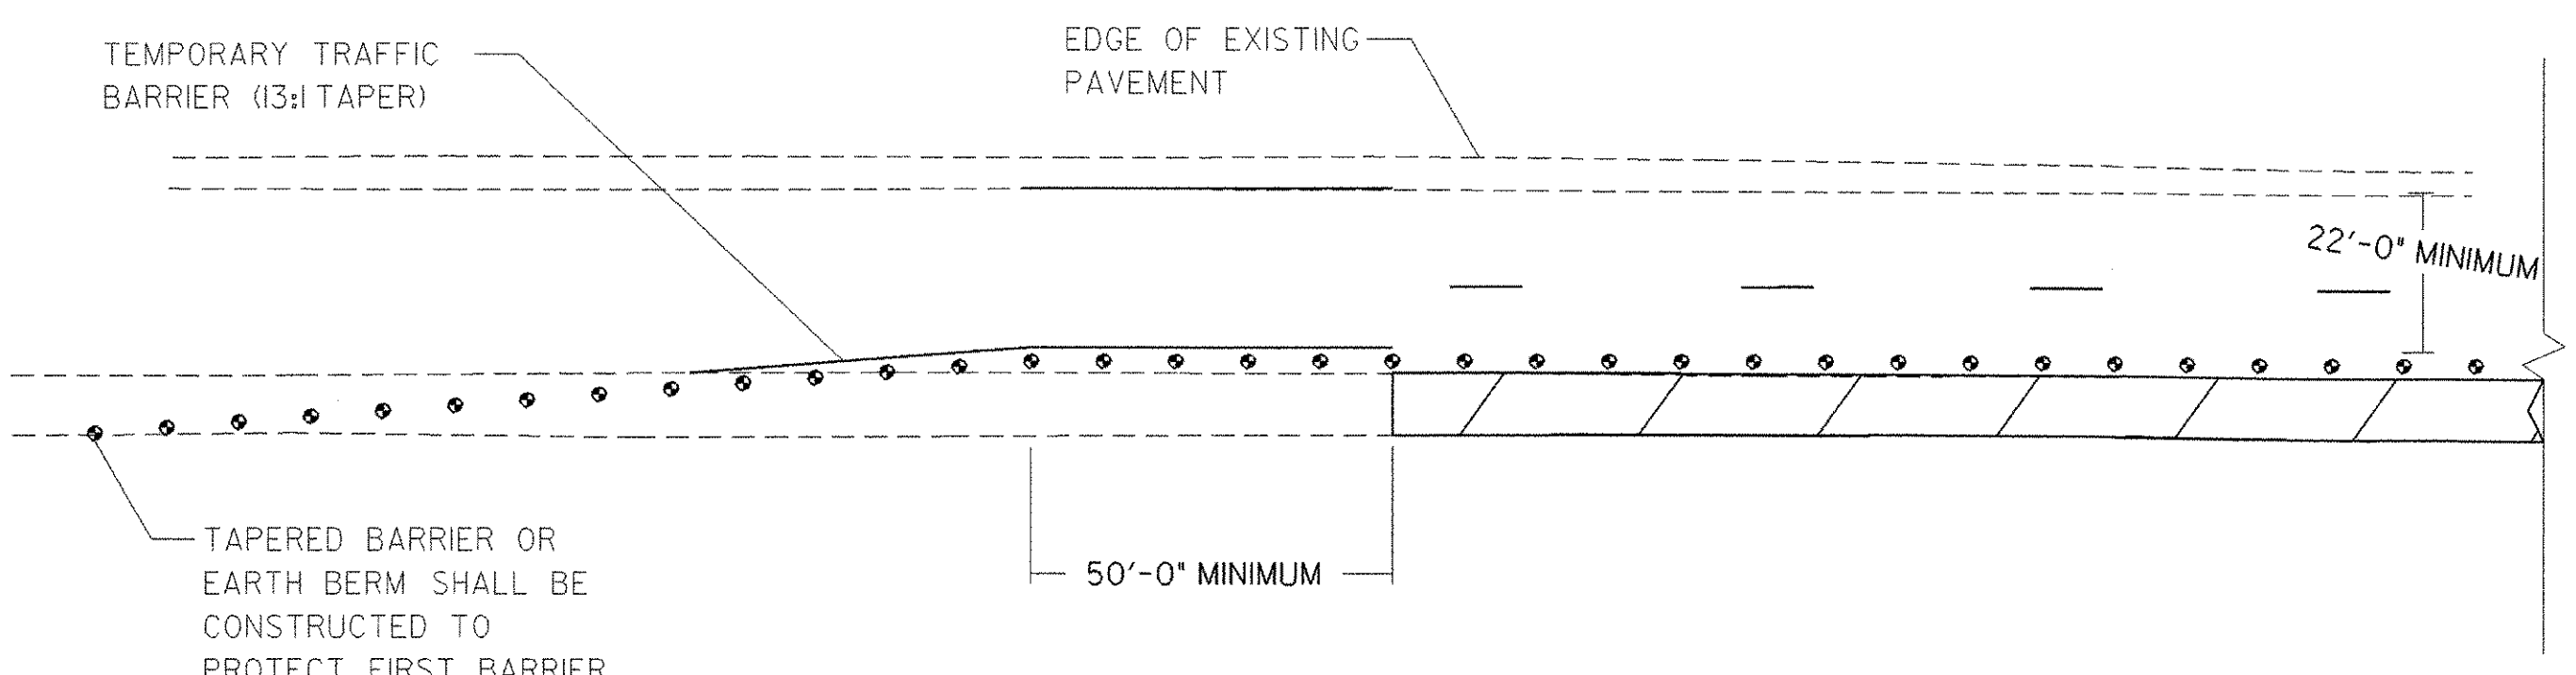

BEGINNING OF DECELERATION LANE

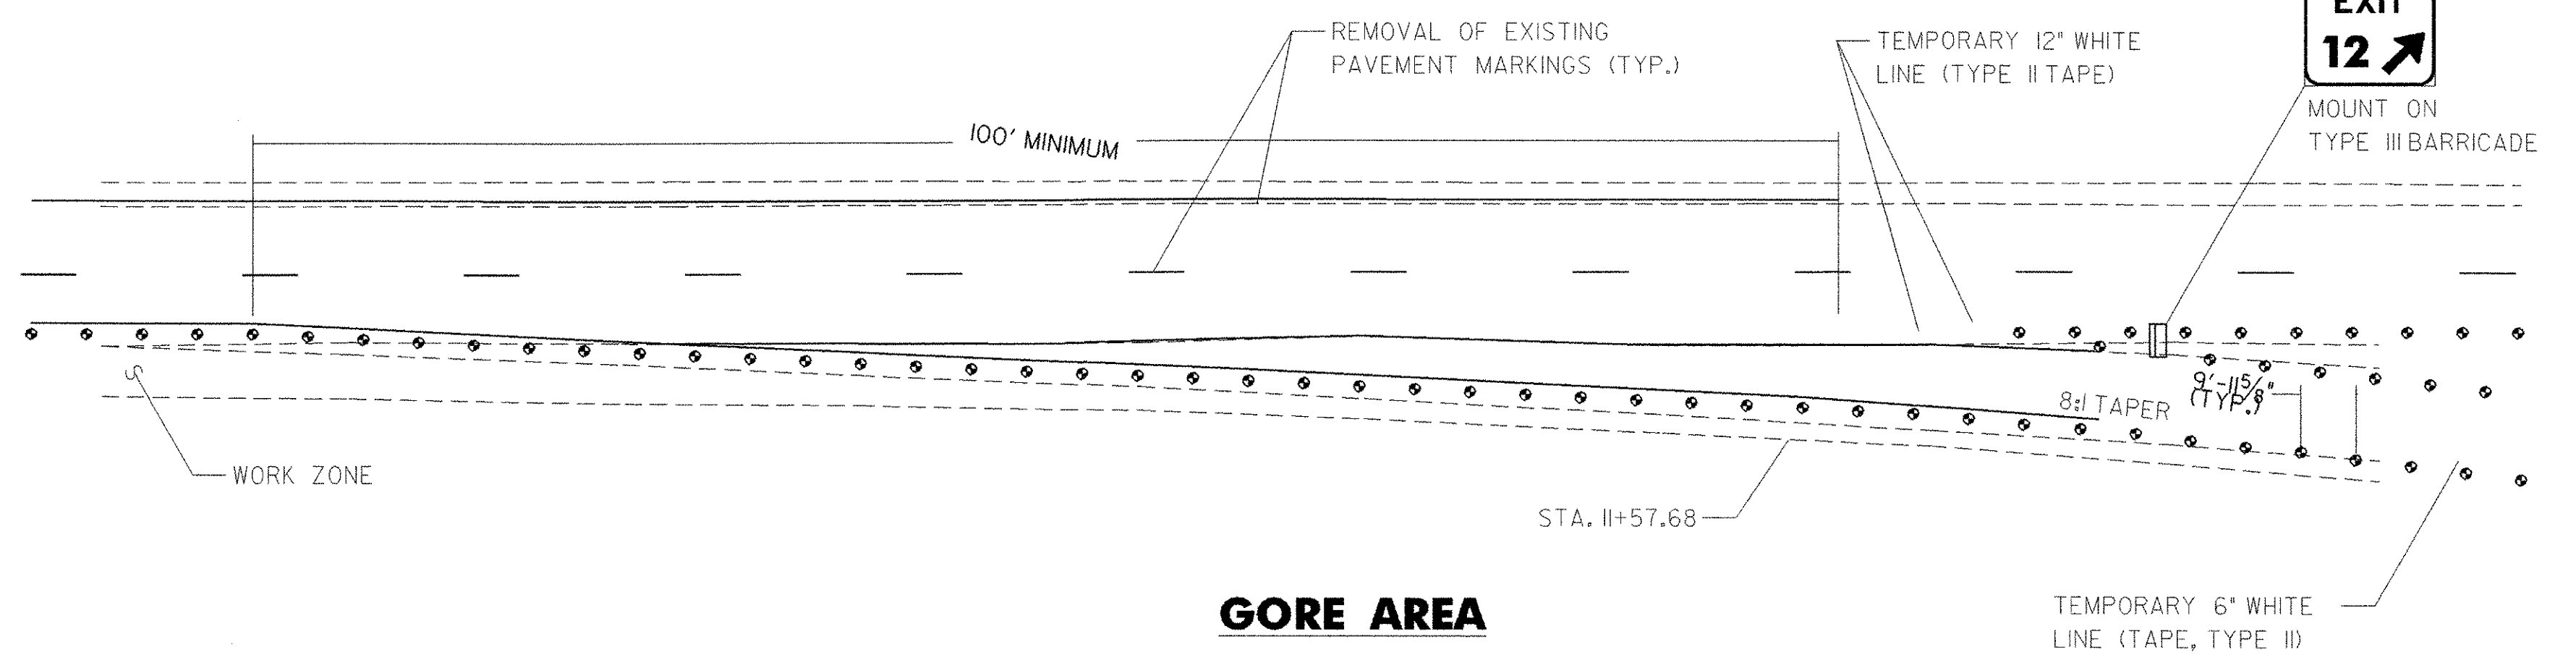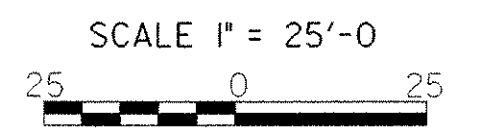

GORE AREA



- LEGEND**
- EDGE OF PAVEMENT
 - REFLECTIVE PLASTIC DRUMS
 - PAVEMENT MARKING REMOVAL
 - TRAFFIC FLOW
 - ▨ CONSTRUCTION AREA
 - ▬ TEMPORARY TRAFFIC BARRIER


- NOTES**
1. EXIT SIGN SHALL BE MOUNTED A MINIMUM OF THREE-FEET ABOVE THE GROUND AND HIGH ENOUGH TO BE SEEN ABOVE CHANNELIZING DEVICES.
 2. ALL DISTANCES ARE DESIRABLE MINIMUMS. FIELD CONDITIONS SHALL CONTROL THE ACTUAL PLACEMENT.
 3. SEE VTRANS STANDARDS E-103 AND E-106 FOR ADDITIONAL TRAFFIC CONTROL DETAILS, INCLUDING BARREL PLACEMENT AND TAPER LENGTHS.
 4. SEE I-89 MAINLINE PLANS FOR MAINLINE TRAFFIC CONTROL PLANS AND DETAILS.
 5. REFLECTIVE PLASTIC DRUMS ARE TO BE PAID FOR INCIDENTAL TO ITEM 64110, "TRAFFIC CONTROL".
 6. REMOVAL OF EXISTING AND PLACEMENT OF NEW TEMPORARY ARROW PAVEMENT MARKINGS MAY BE NECESSARY, AS DETERMINED BY THE RESIDENT ENGINEER. PAYMENT FOR SUCH SHALL BE INCLUDED UNDER ITEM 64110, "TRAFFIC CONTROL".

6. PAYMENT FOR TEMPORARY 6" WHITE AND 6" YELLOW LINES ON THE MAINLINE ARE INCLUDED AS PART OF THE MAINLINE PLANS. TEMPORARY LINES ON THE RAMP ARE PAID FOR UNDER THIS PROJECT. SEE QUANTITY SHEET FOR ITEM NUMBERS.
7. LOCATION OF TEMPORARY TRAFFIC BARRIERS AND ENERGY ABSORPTION ATTENUATORS SHALL BE PLACED AS SHOWN ON THIS SHEET, IN CONJUNCTION WITH APPLICABLE VAOT STANDARD DRAWINGS AND AT THE DISCRETION OF THE RESIDENT ENGINEER. ATTENUATORS AND BARRIER ENDS SHALL BE ADJUSTED AS NECESSARY AND WITH APPROVAL OF THE RESIDENT ENGINEER.
8. ENERGY ABSORPTION ATTENUATORS WILL BE PLACED AS SHOWN ON THIS SHEET AND PAID FOR UNDER ITEM 62156, "ENERGY ABSORPTION ATTENUATOR". THE ATTENUATORS SHALL MEET REQUIREMENTS OF THE 2002 AASHTO ROADSIDE DESIGN GUIDELINE.


DATUM

| | |
|------------|-----|
| VERTICAL | N/A |
| HORIZONTAL | N/A |


| | | |
|-----------------------|-----------------|------------------------|
| PROJECT NAME: | WILLISTON | |
| PROJECT NUMBER: | IM 089-2(35) | |
| FILE NAME: | I8800F4TC01.dgn | PLOT DATE: 17-MAY-2005 |
| PROJECT LEADER: | EPD | DRAWN BY: JDA / PGJ |
| DESIGNED BY: | JDA | CHECKED BY: EPD |
| TRAFFIC CONTROL SHEET | | SHEET 68 OF 76 |

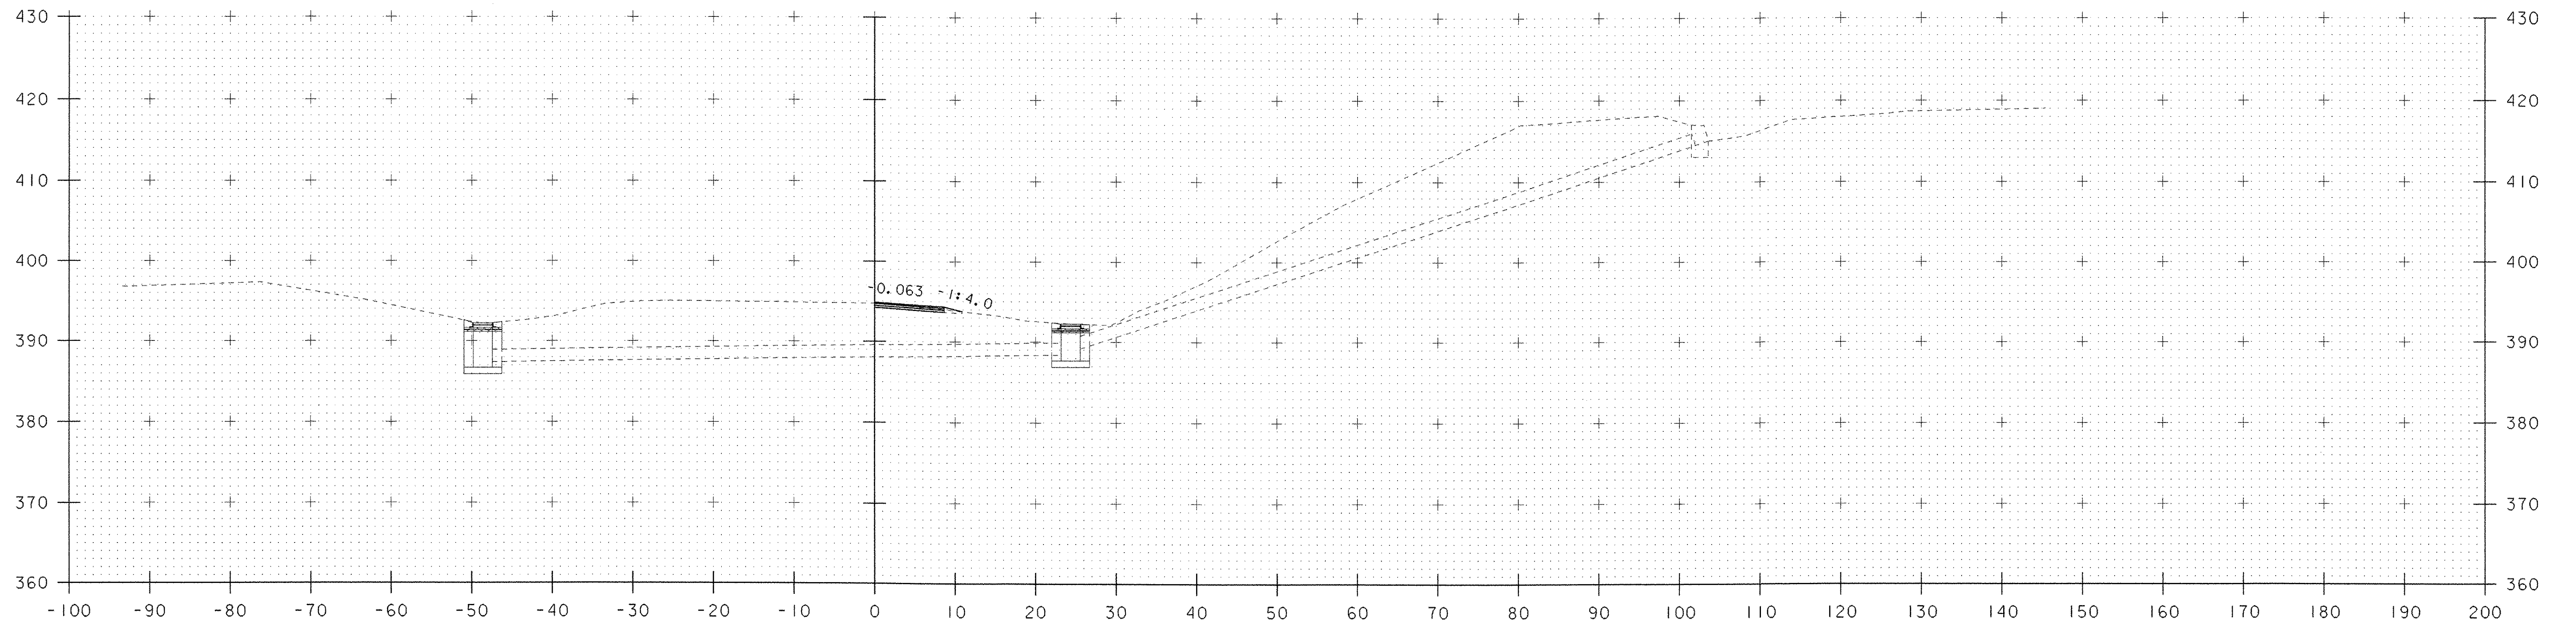

3+05

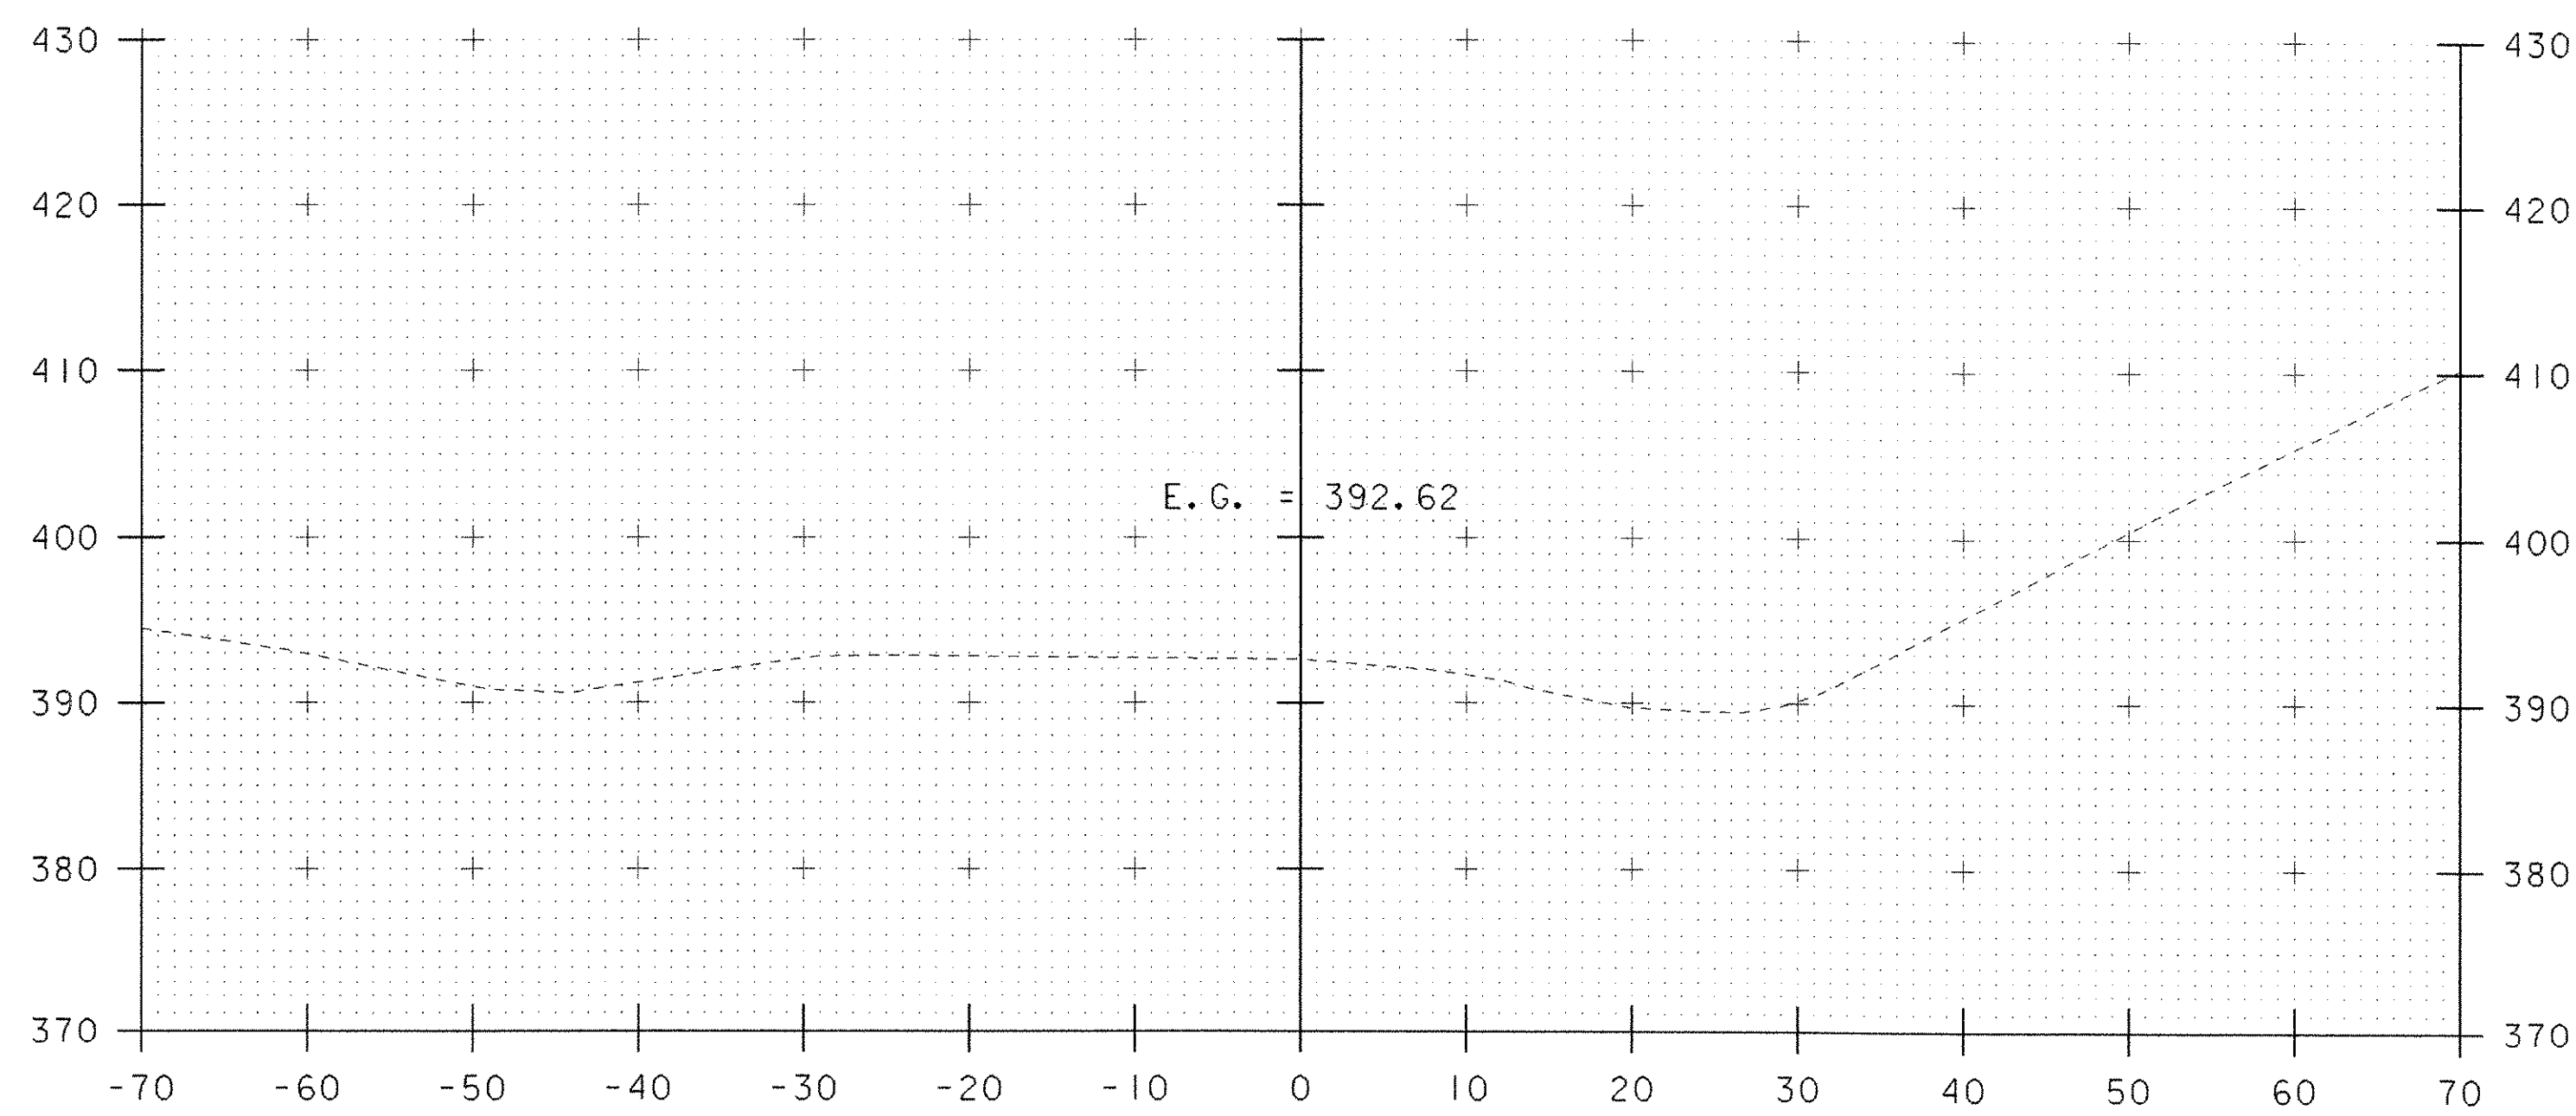

2+50

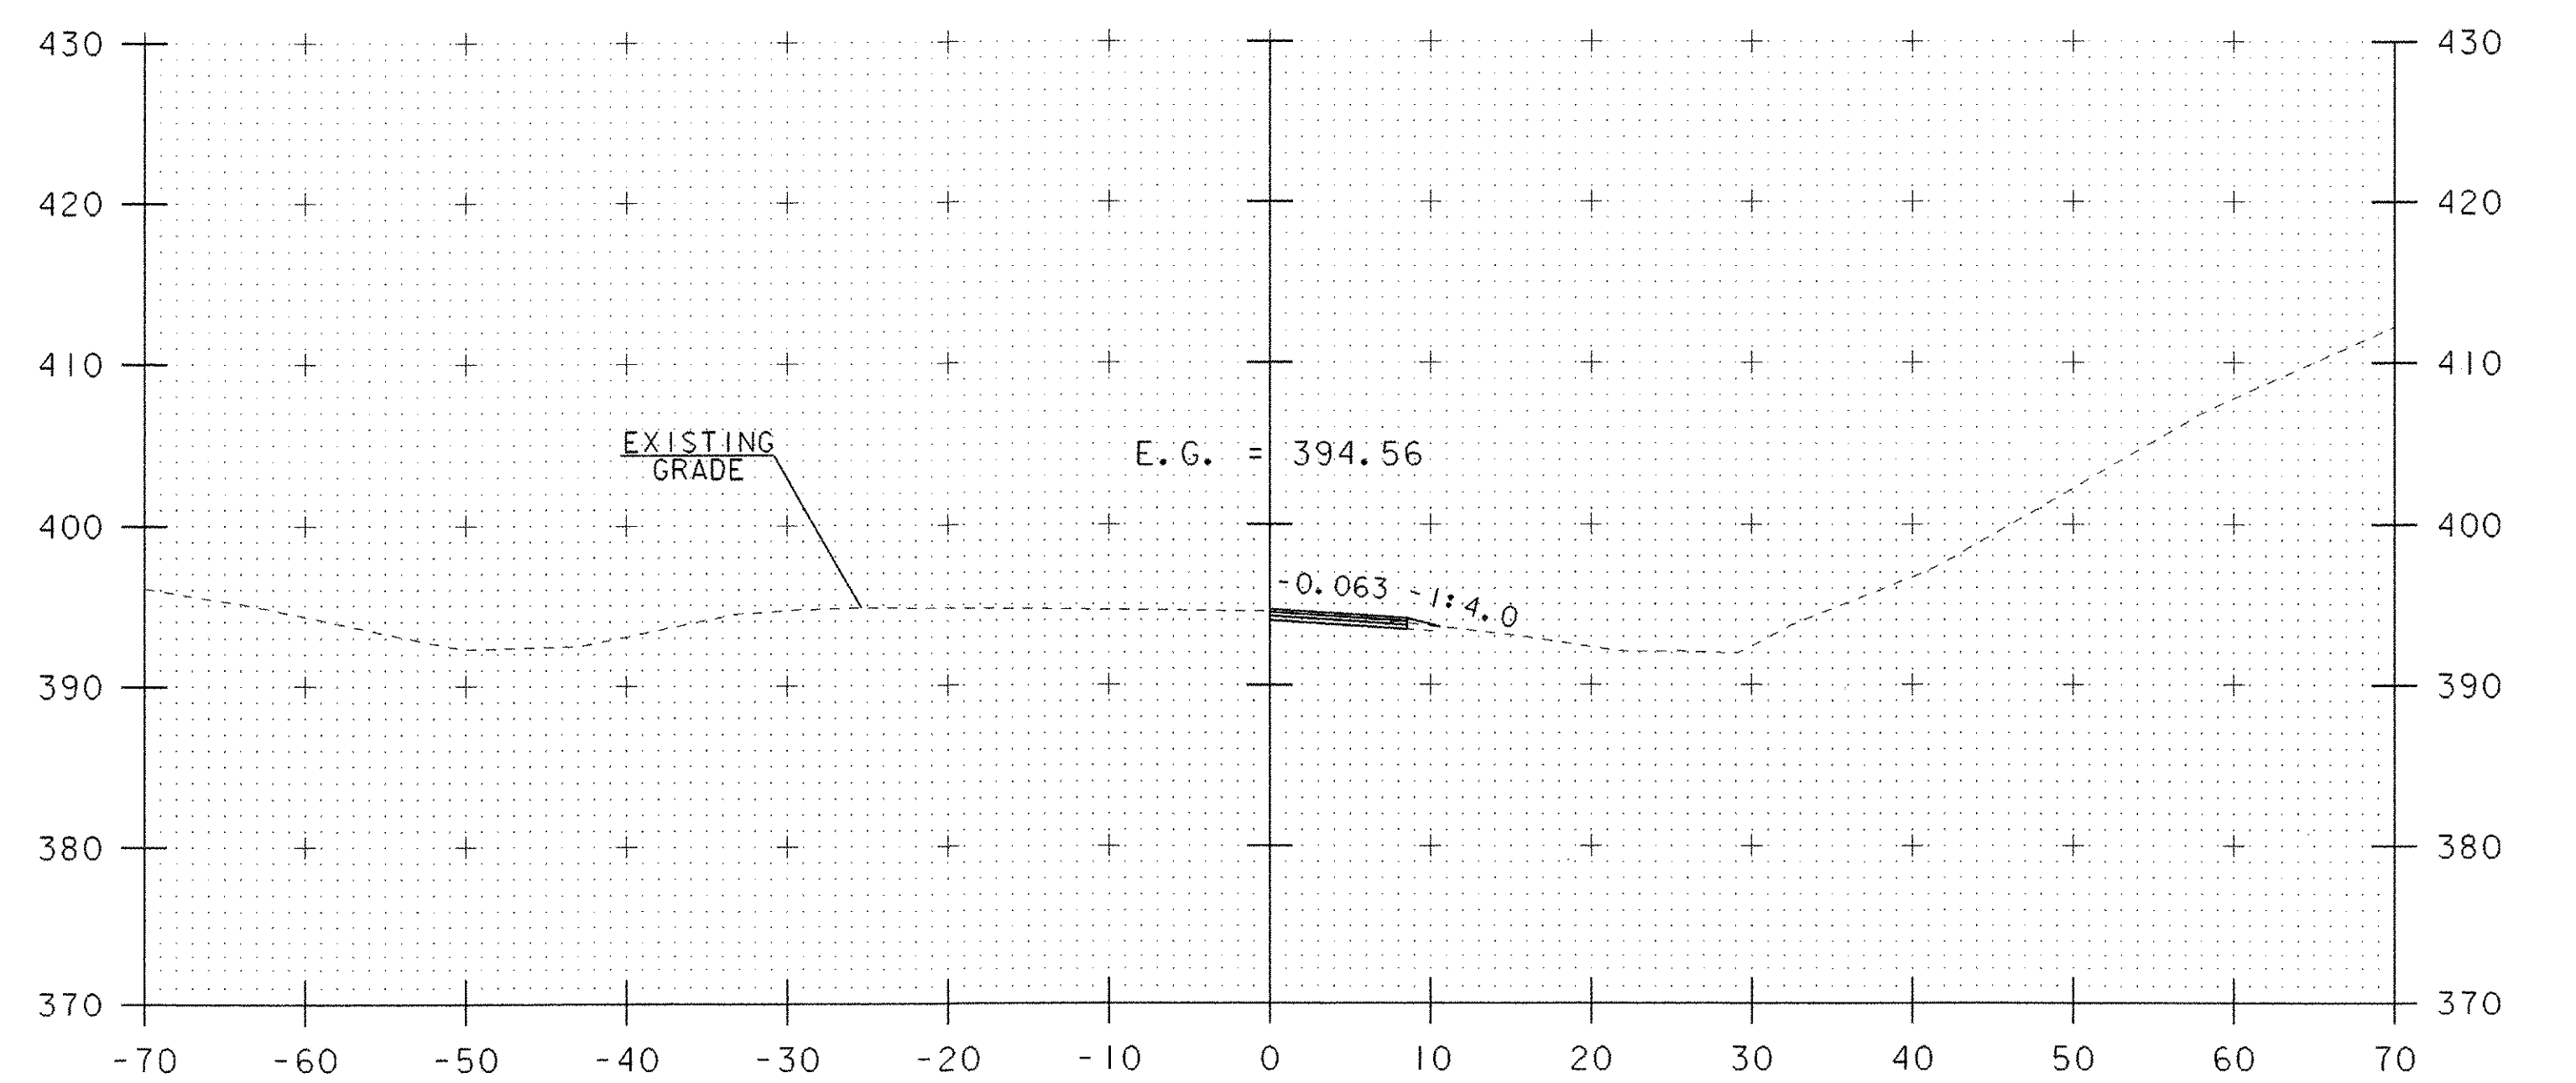


3+00

NOTE: STA. 2+50 - 3+00 RT - GRADE DITCH TO DRAIN

DATUM
 VERTICAL N/A
 HORIZONTAL N/A


NOTE: SEE LAYOUT SHEET AND TRENCH DETAIL ON SIGN ACTUATION NOTES AND DETAILS SHEET FOR PLACEMENT OF CONDUIT.

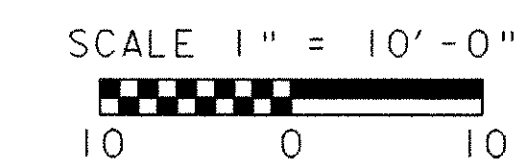


PROJECT NAME: I-89 EXIT 12 SB OFF RAMP
 PROJECT NUMBER: IM 089-2(35)

FILE NAME: 618800F4XS01.dgn
 PROJECT LEADER: EPD
 DESIGNED BY: JDA
 STA. 2+50 TO STA. 3+05


PLOT DATE: 17-MAY-2005
 DRAWN BY: JDA / PGJ
 CHECKED BY: EPD
 SHEET 69 OF 76

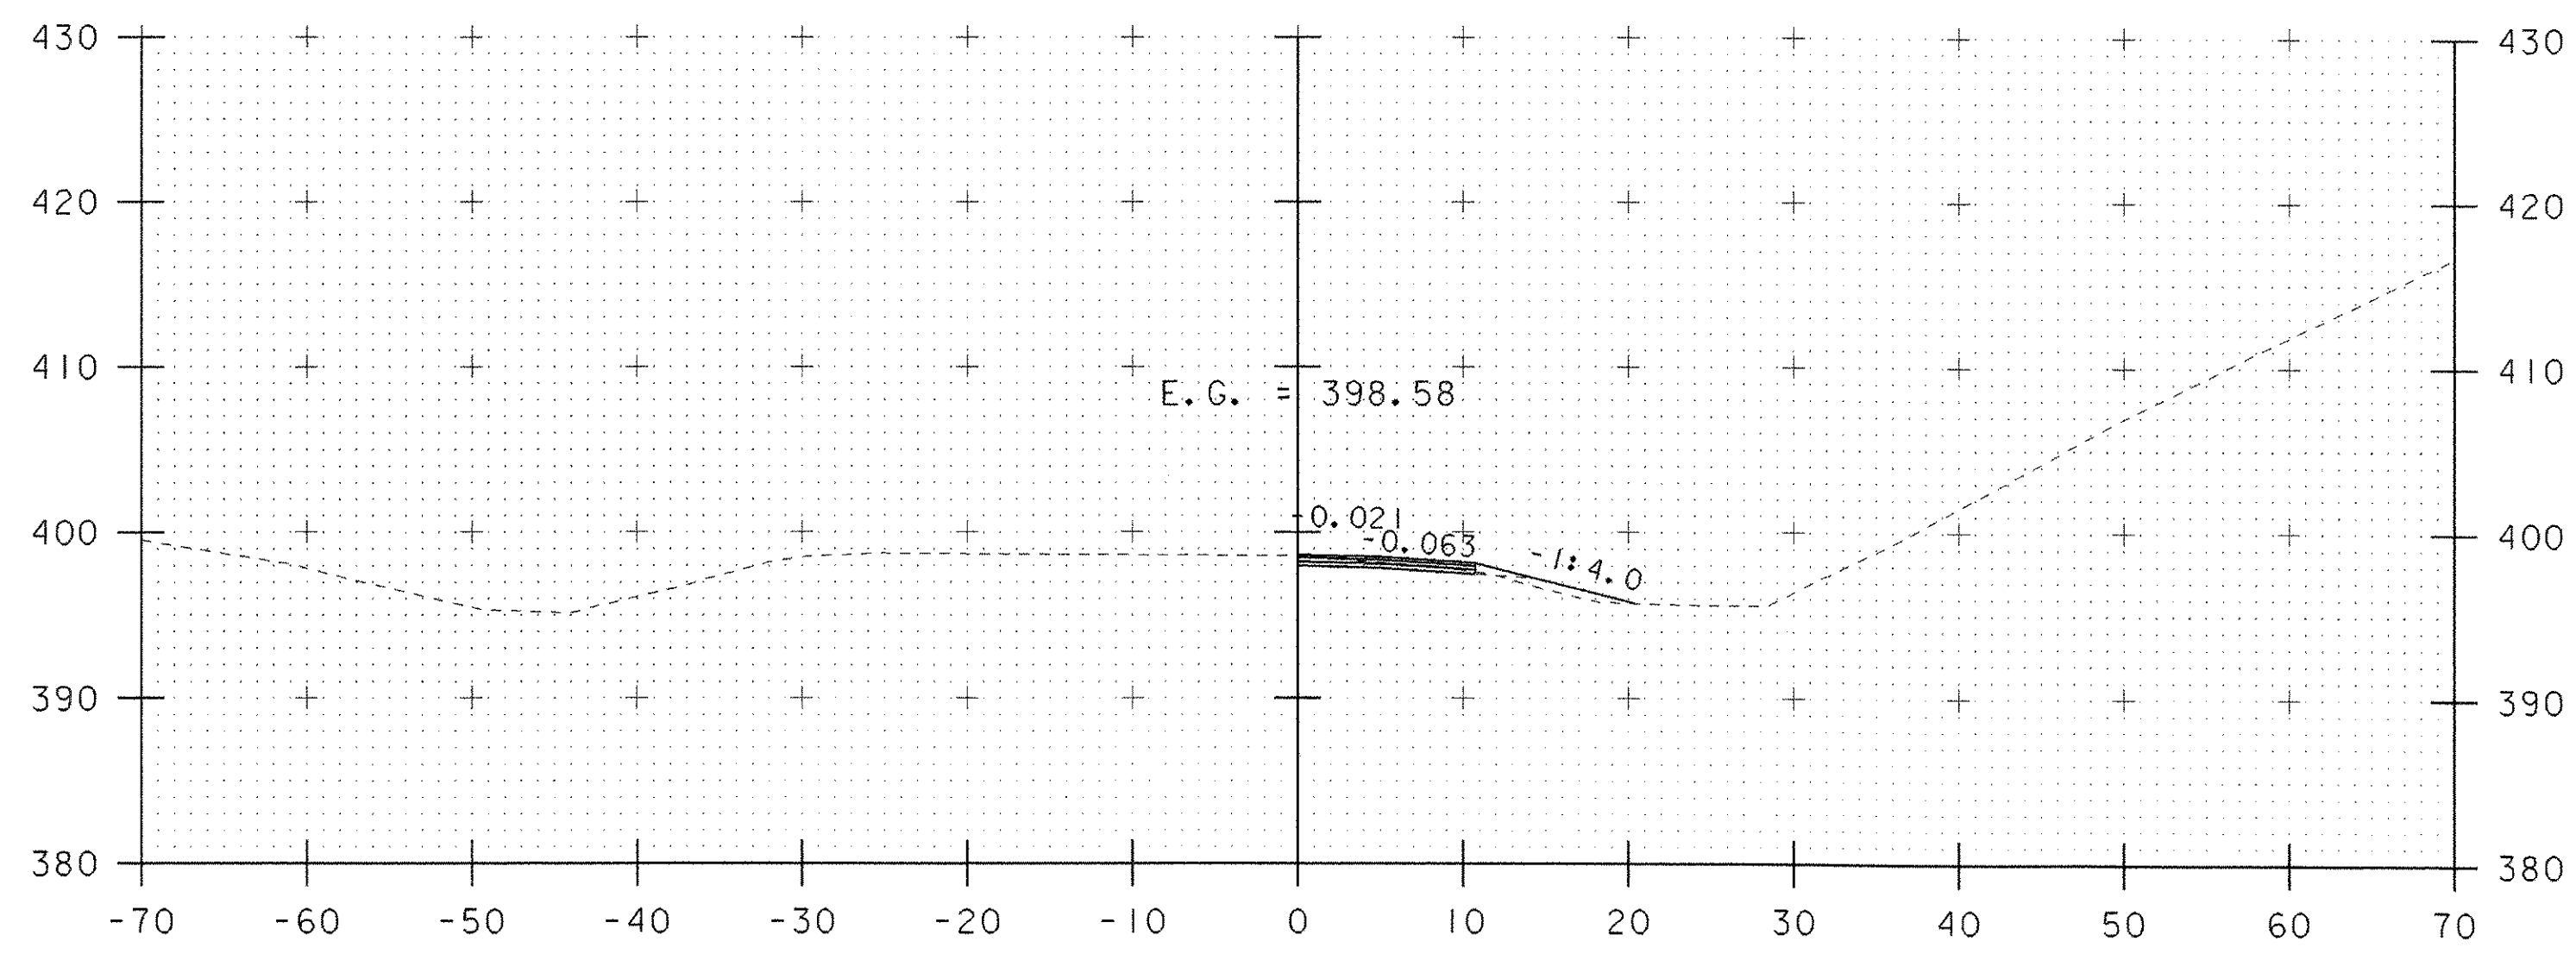


4+00

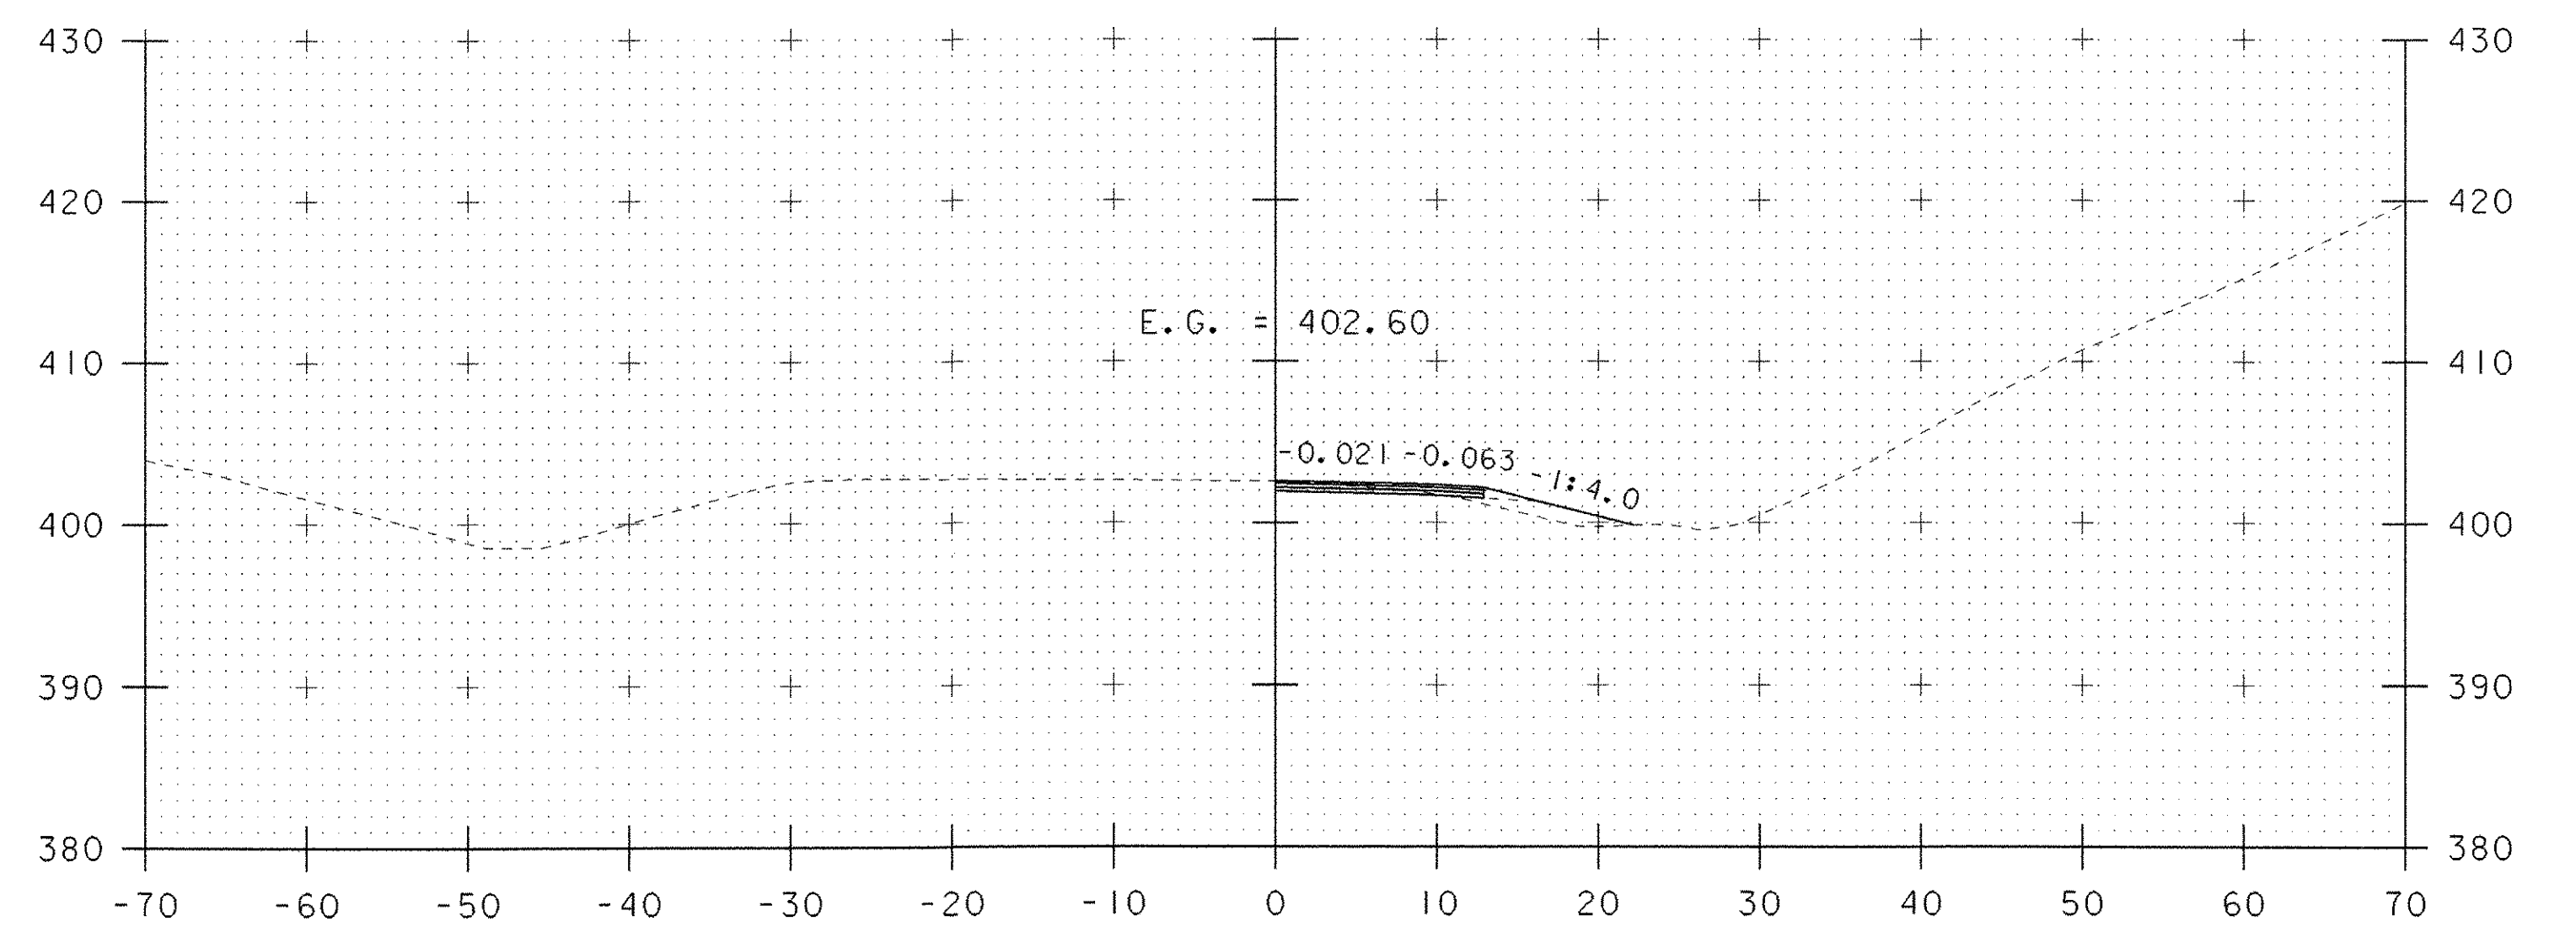

5+00

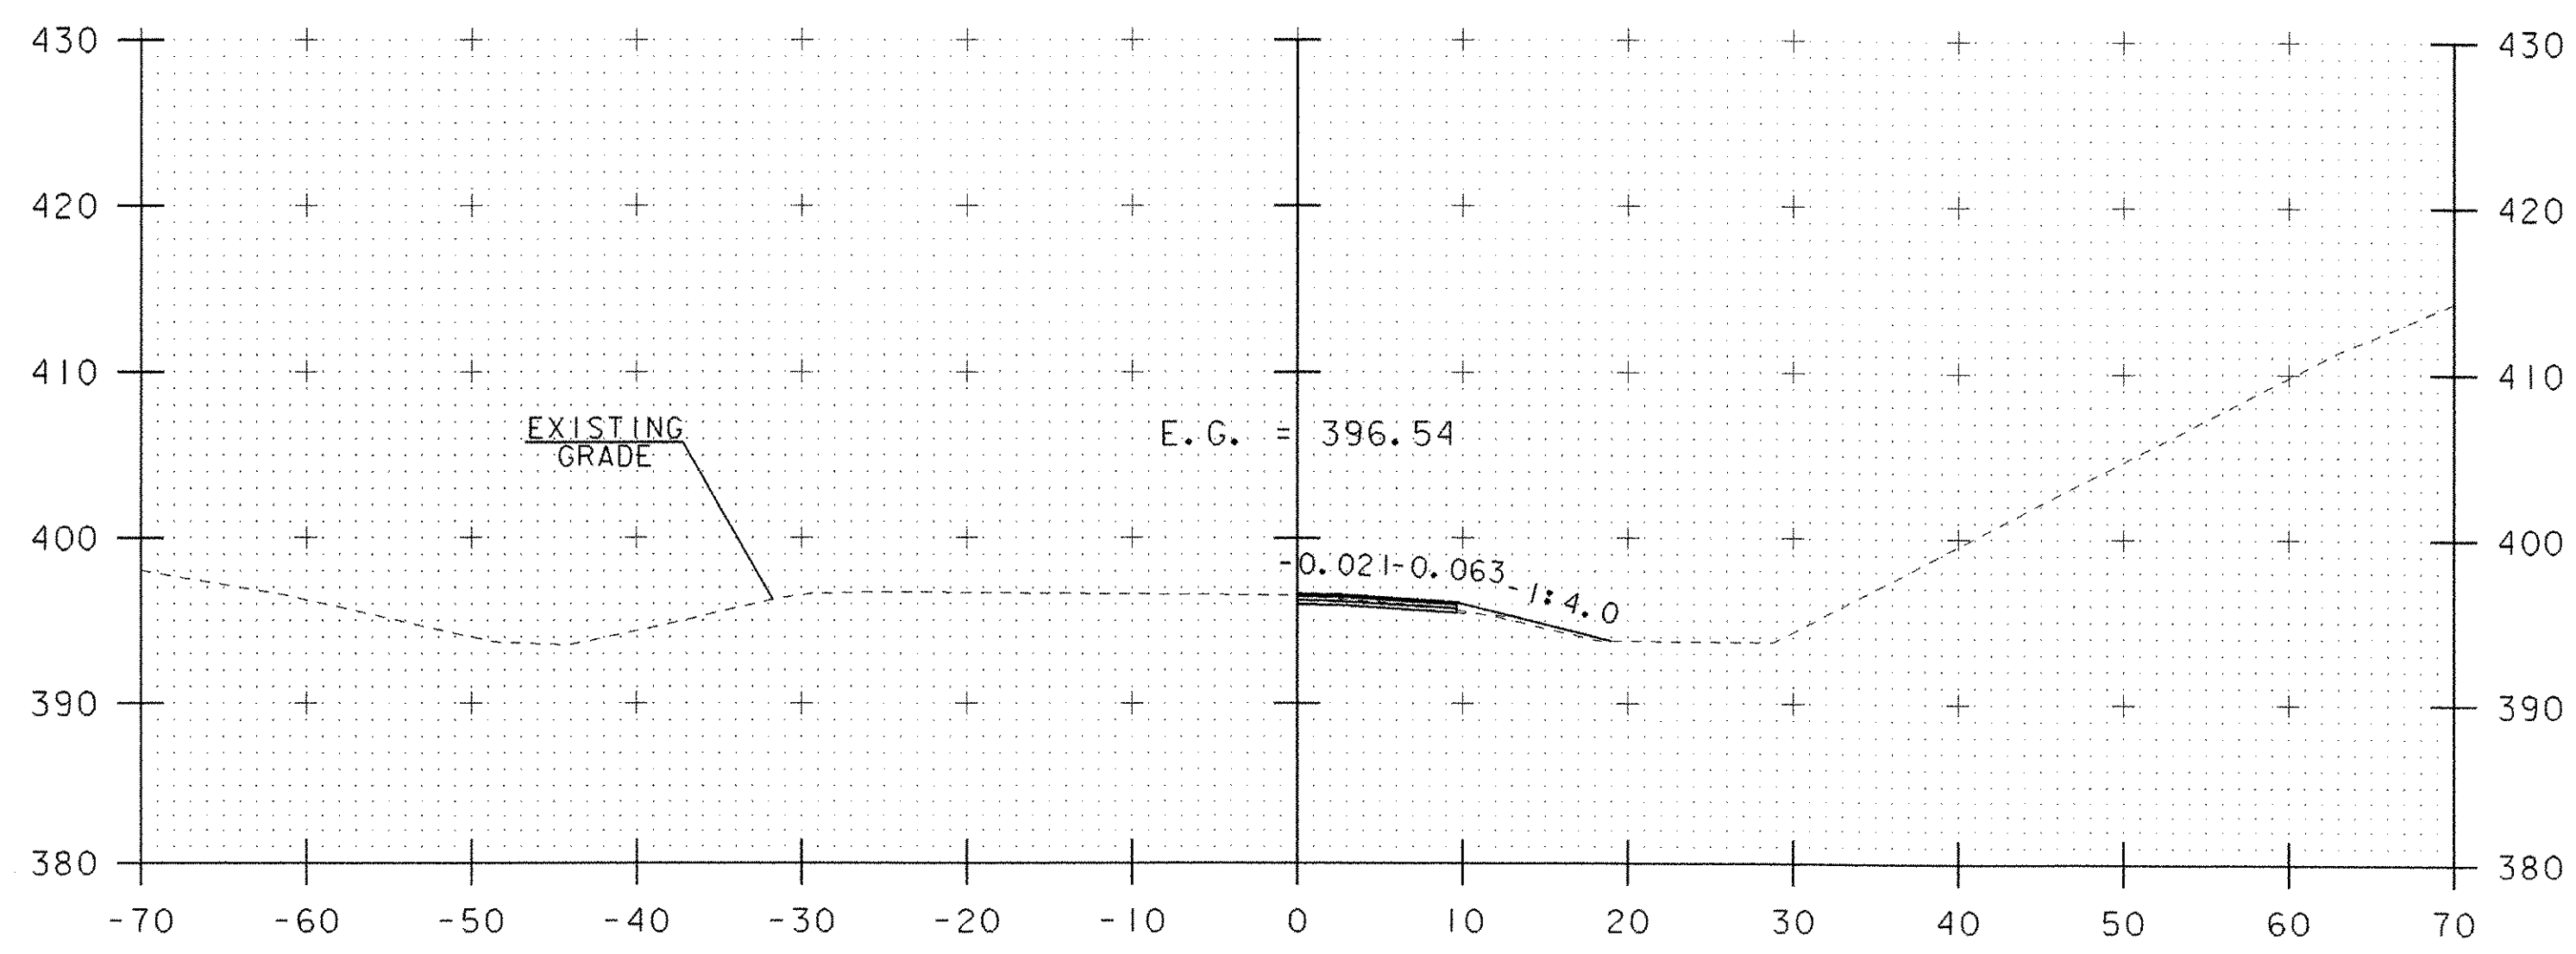


3+50

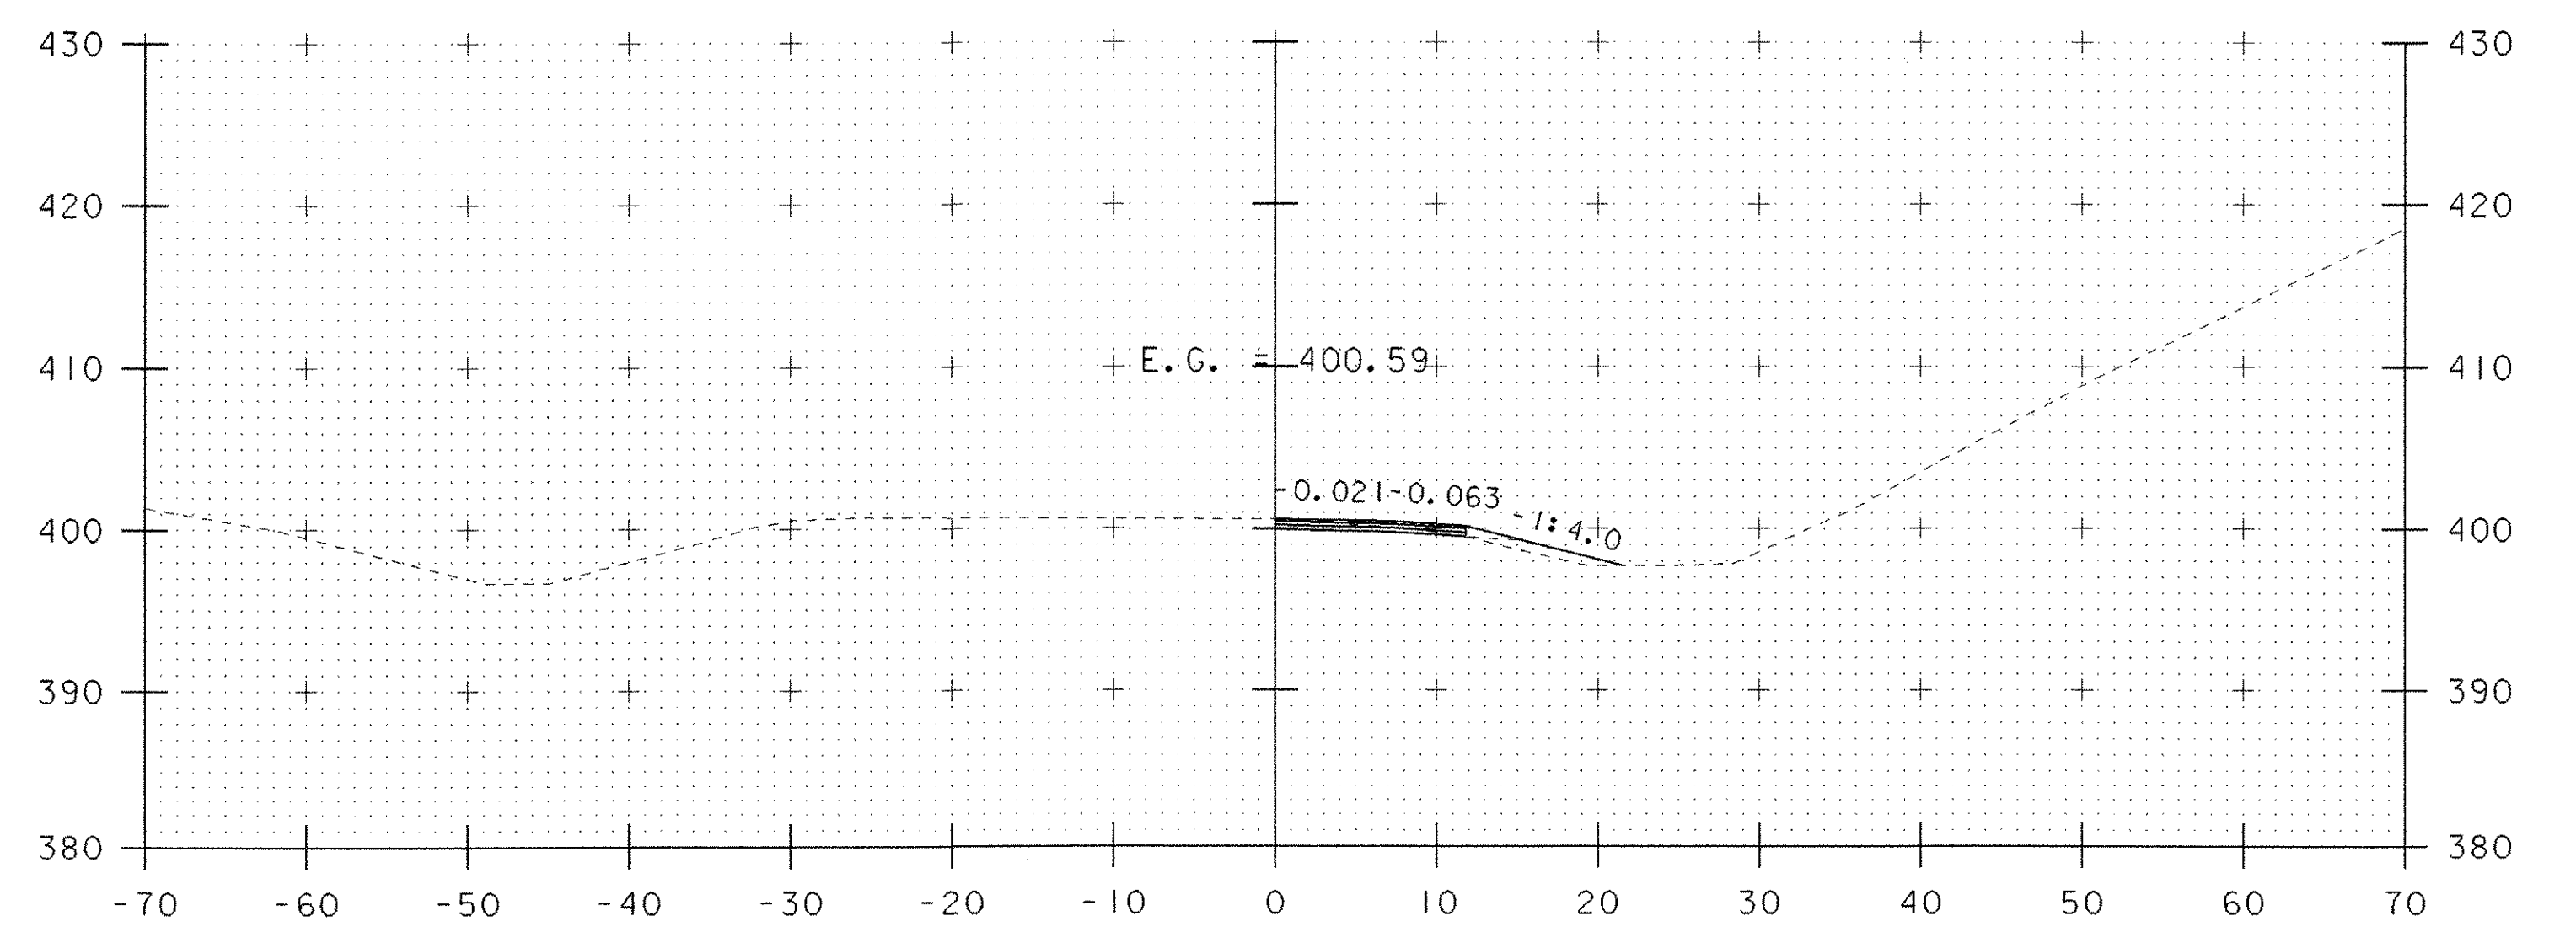


4+50


DATUM
 VERTICAL N/A
 HORIZONTAL N/A

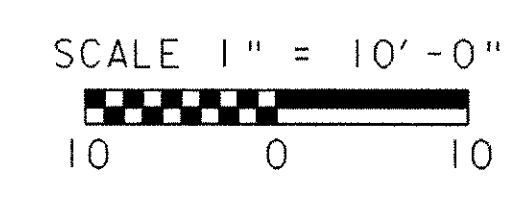


| | |
|--|------------------------|
| PROJECT NAME: I-89 EXIT 12 SB OFF RAMP | PLOT DATE: 17-MAY-2005 |
| PROJECT NUMBER: IM 089-2(35) | DRAWN BY: JDA / PGJ |
| FILE NAME: 618800F4XS01.dgn | CHECKED BY: EPD |
| PROJECT LEADER: EPD | DESIGNED BY: JDA |
| STA. 3+50 TO STA. 5+00 | SHEET 70 OF 76 |

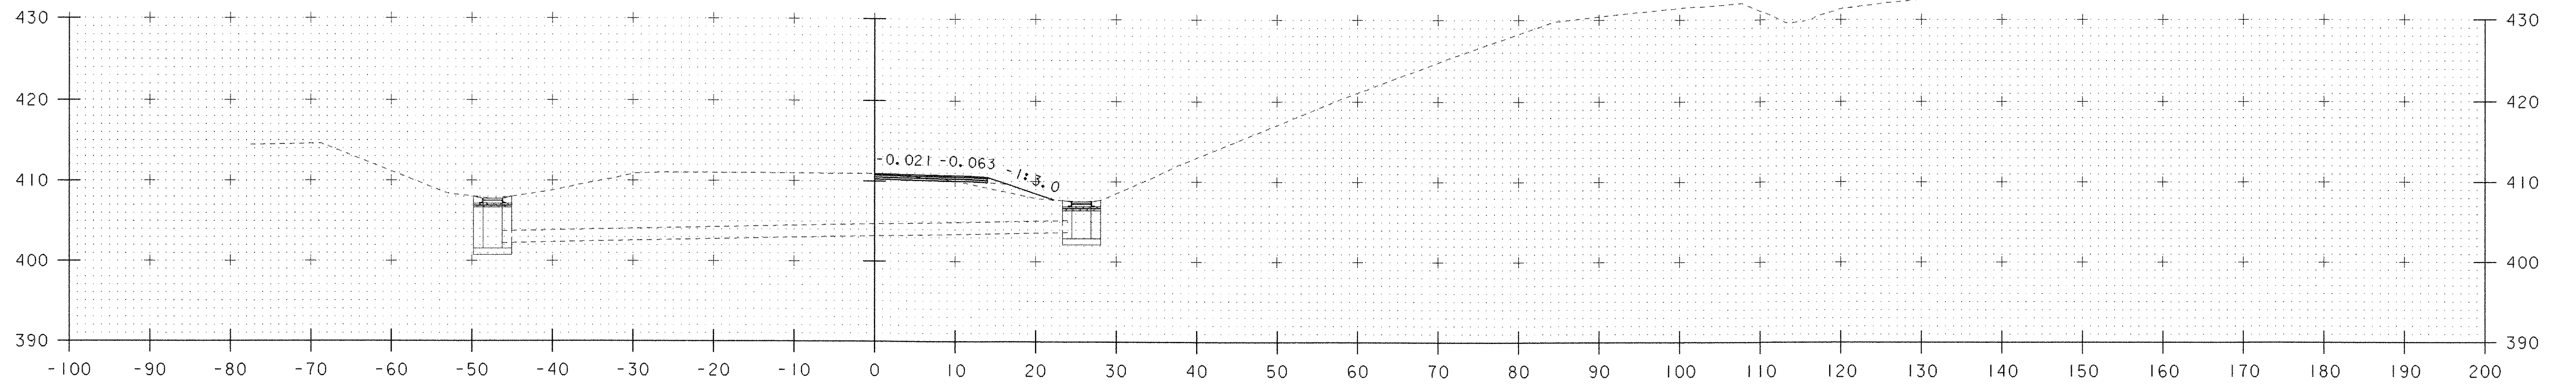


7+09

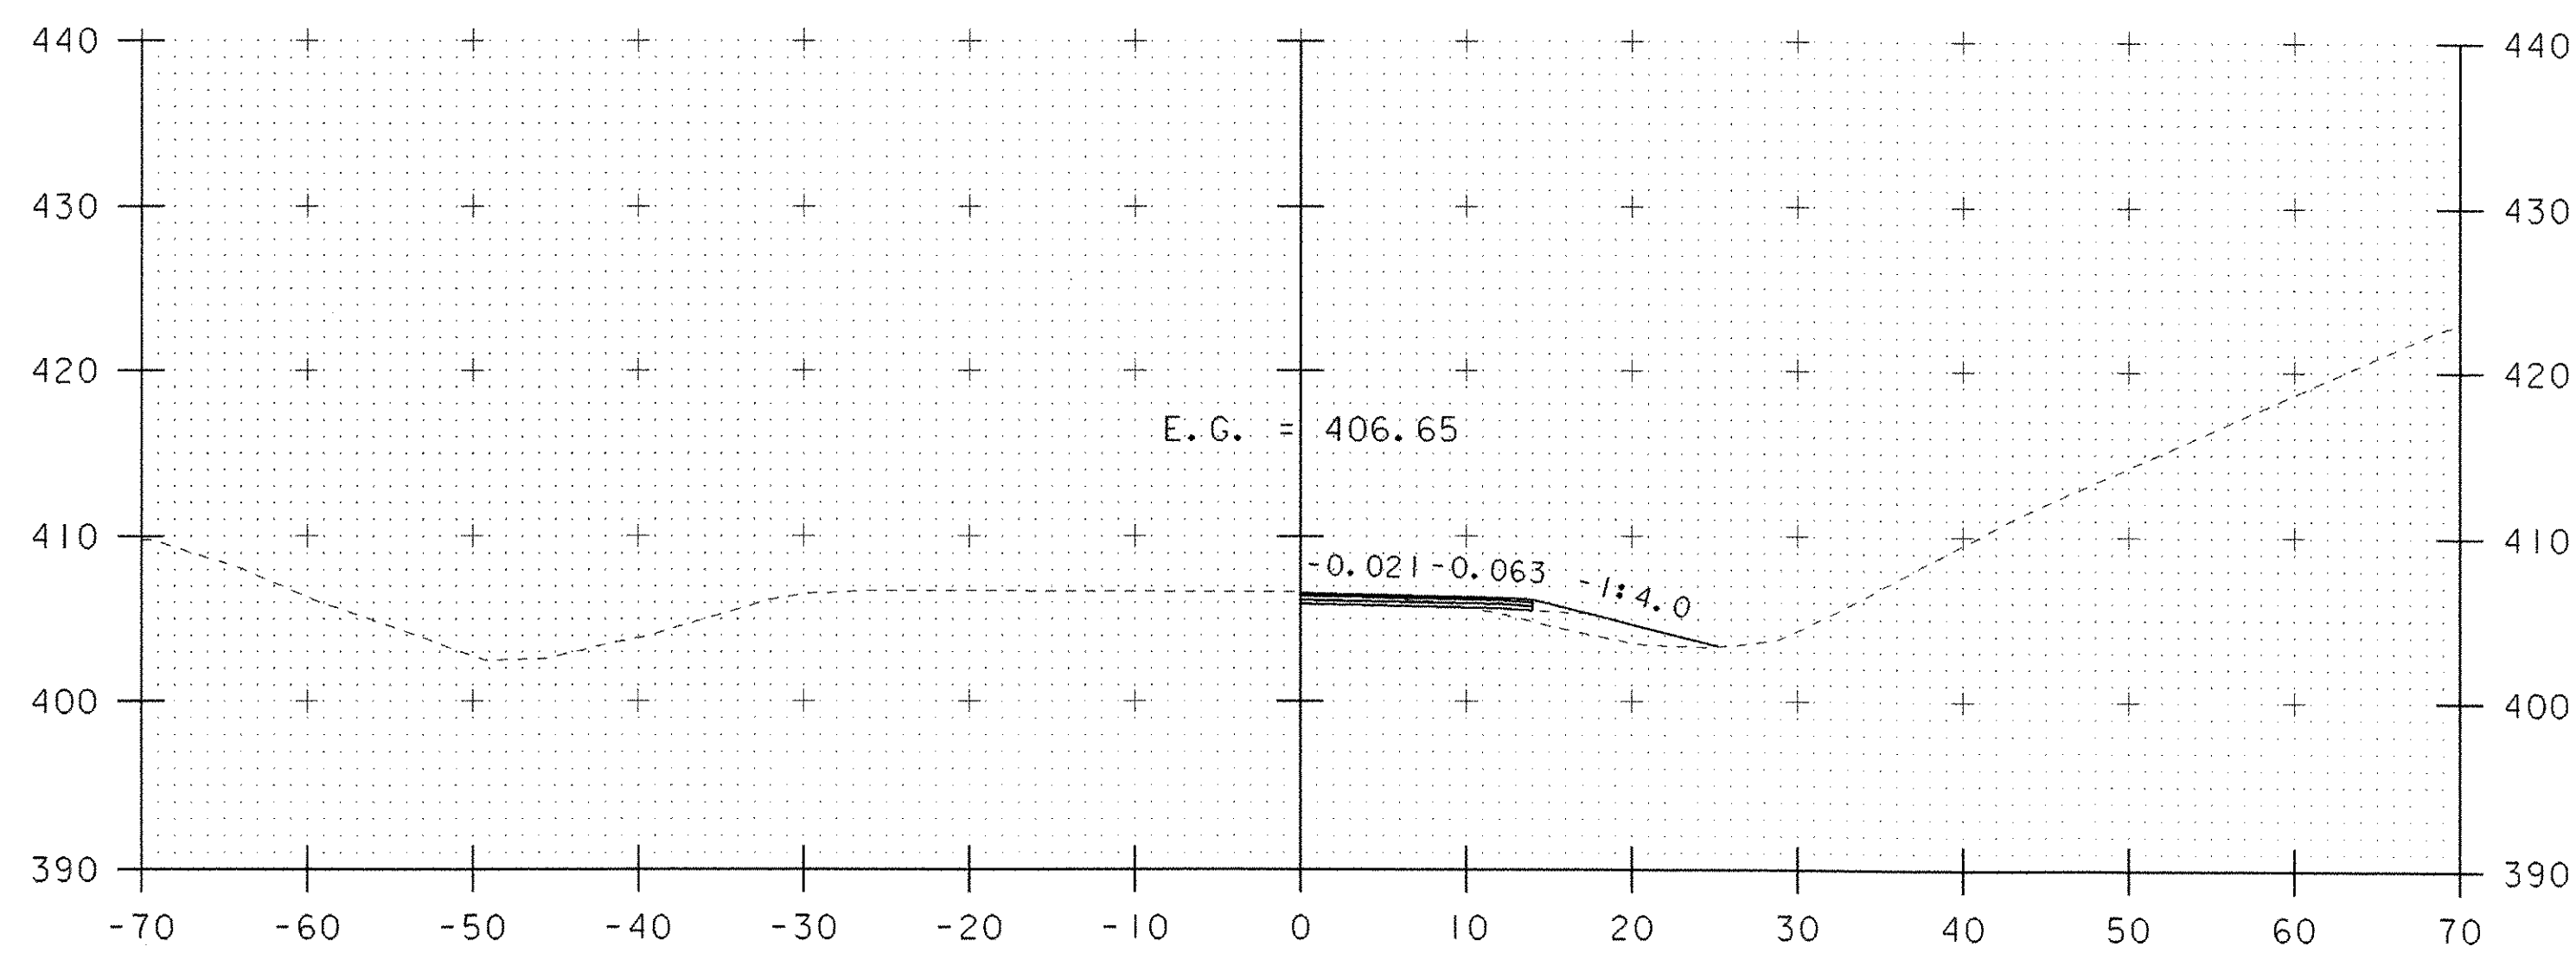


6+00

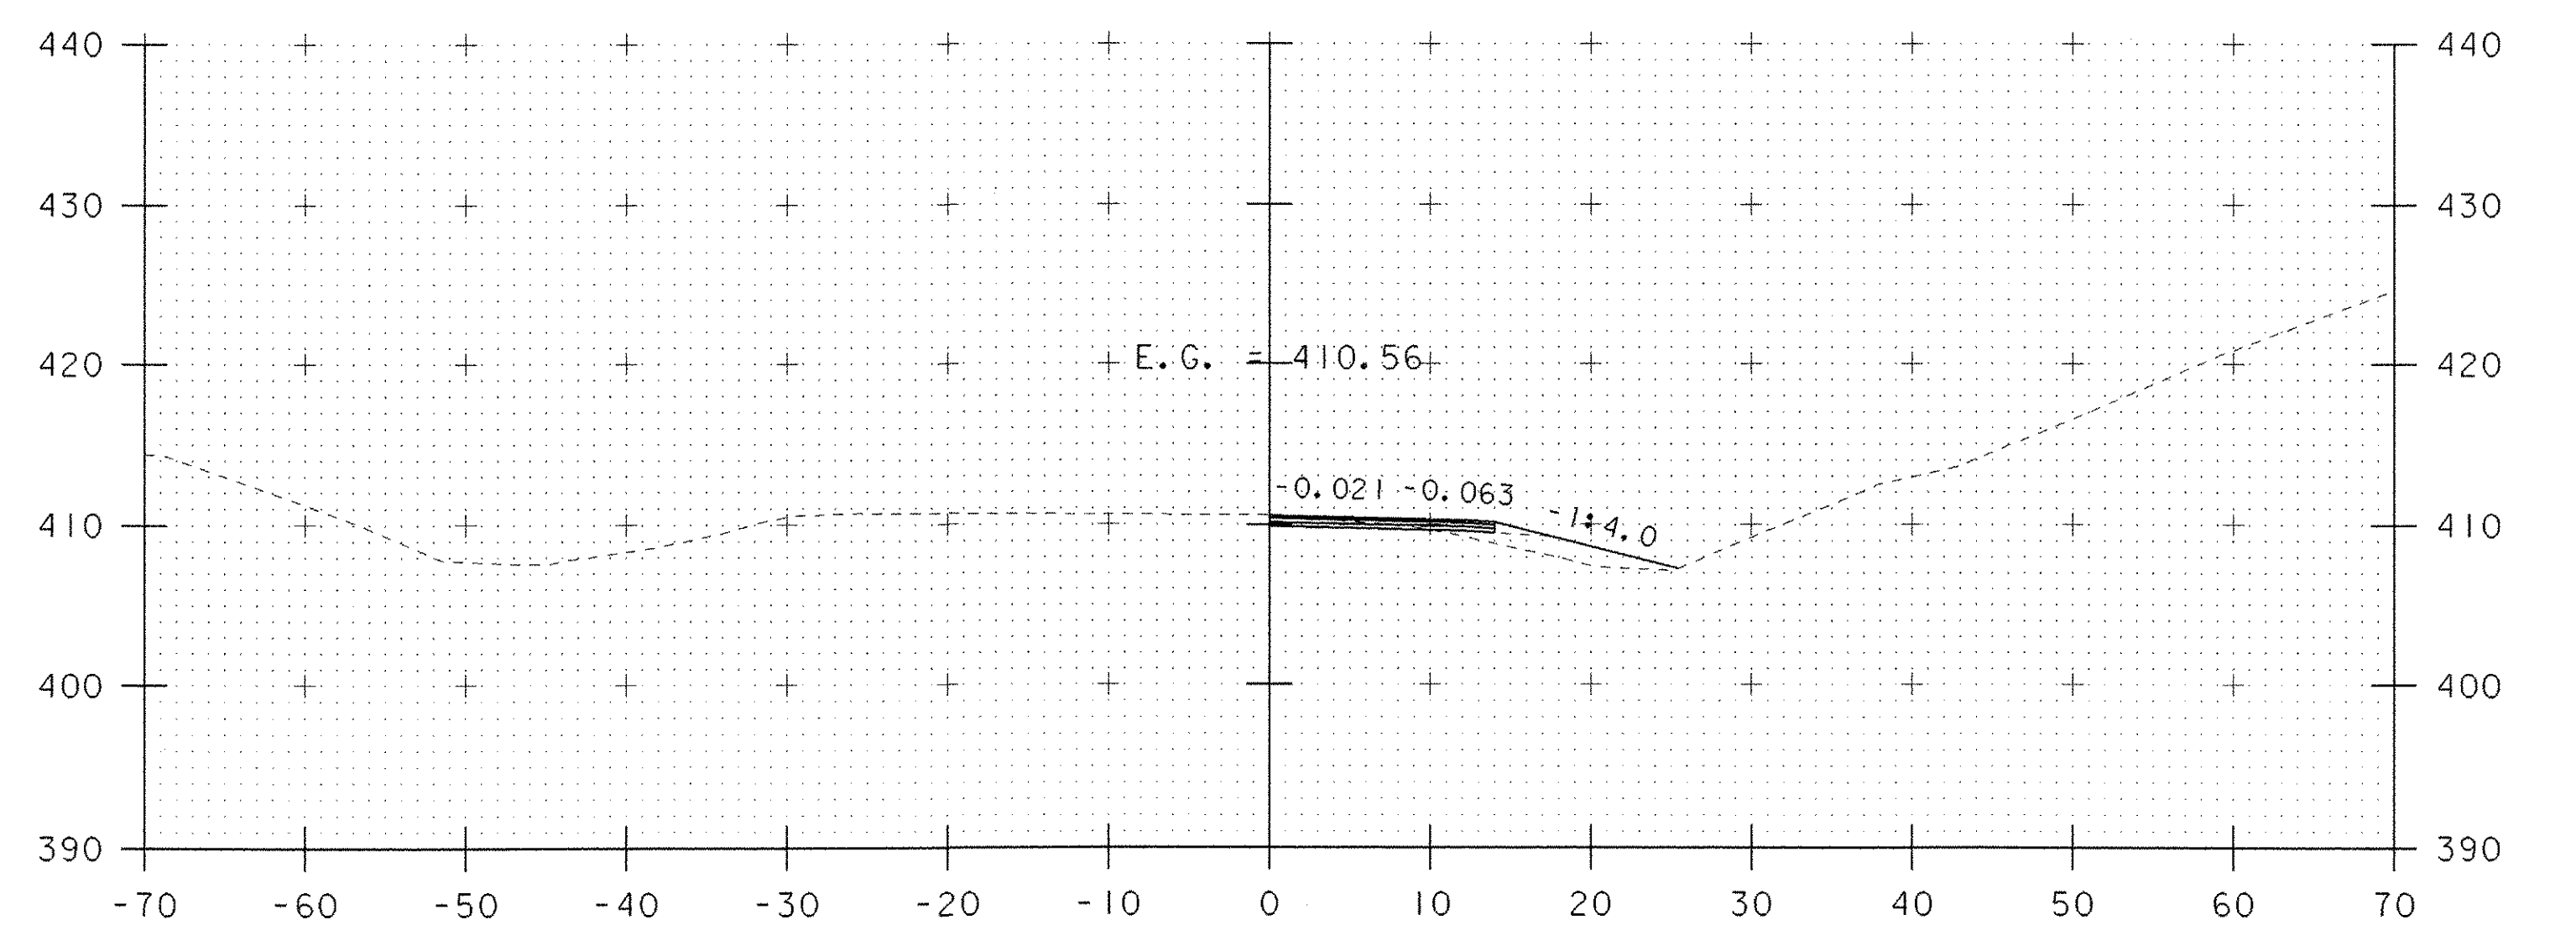

7+00

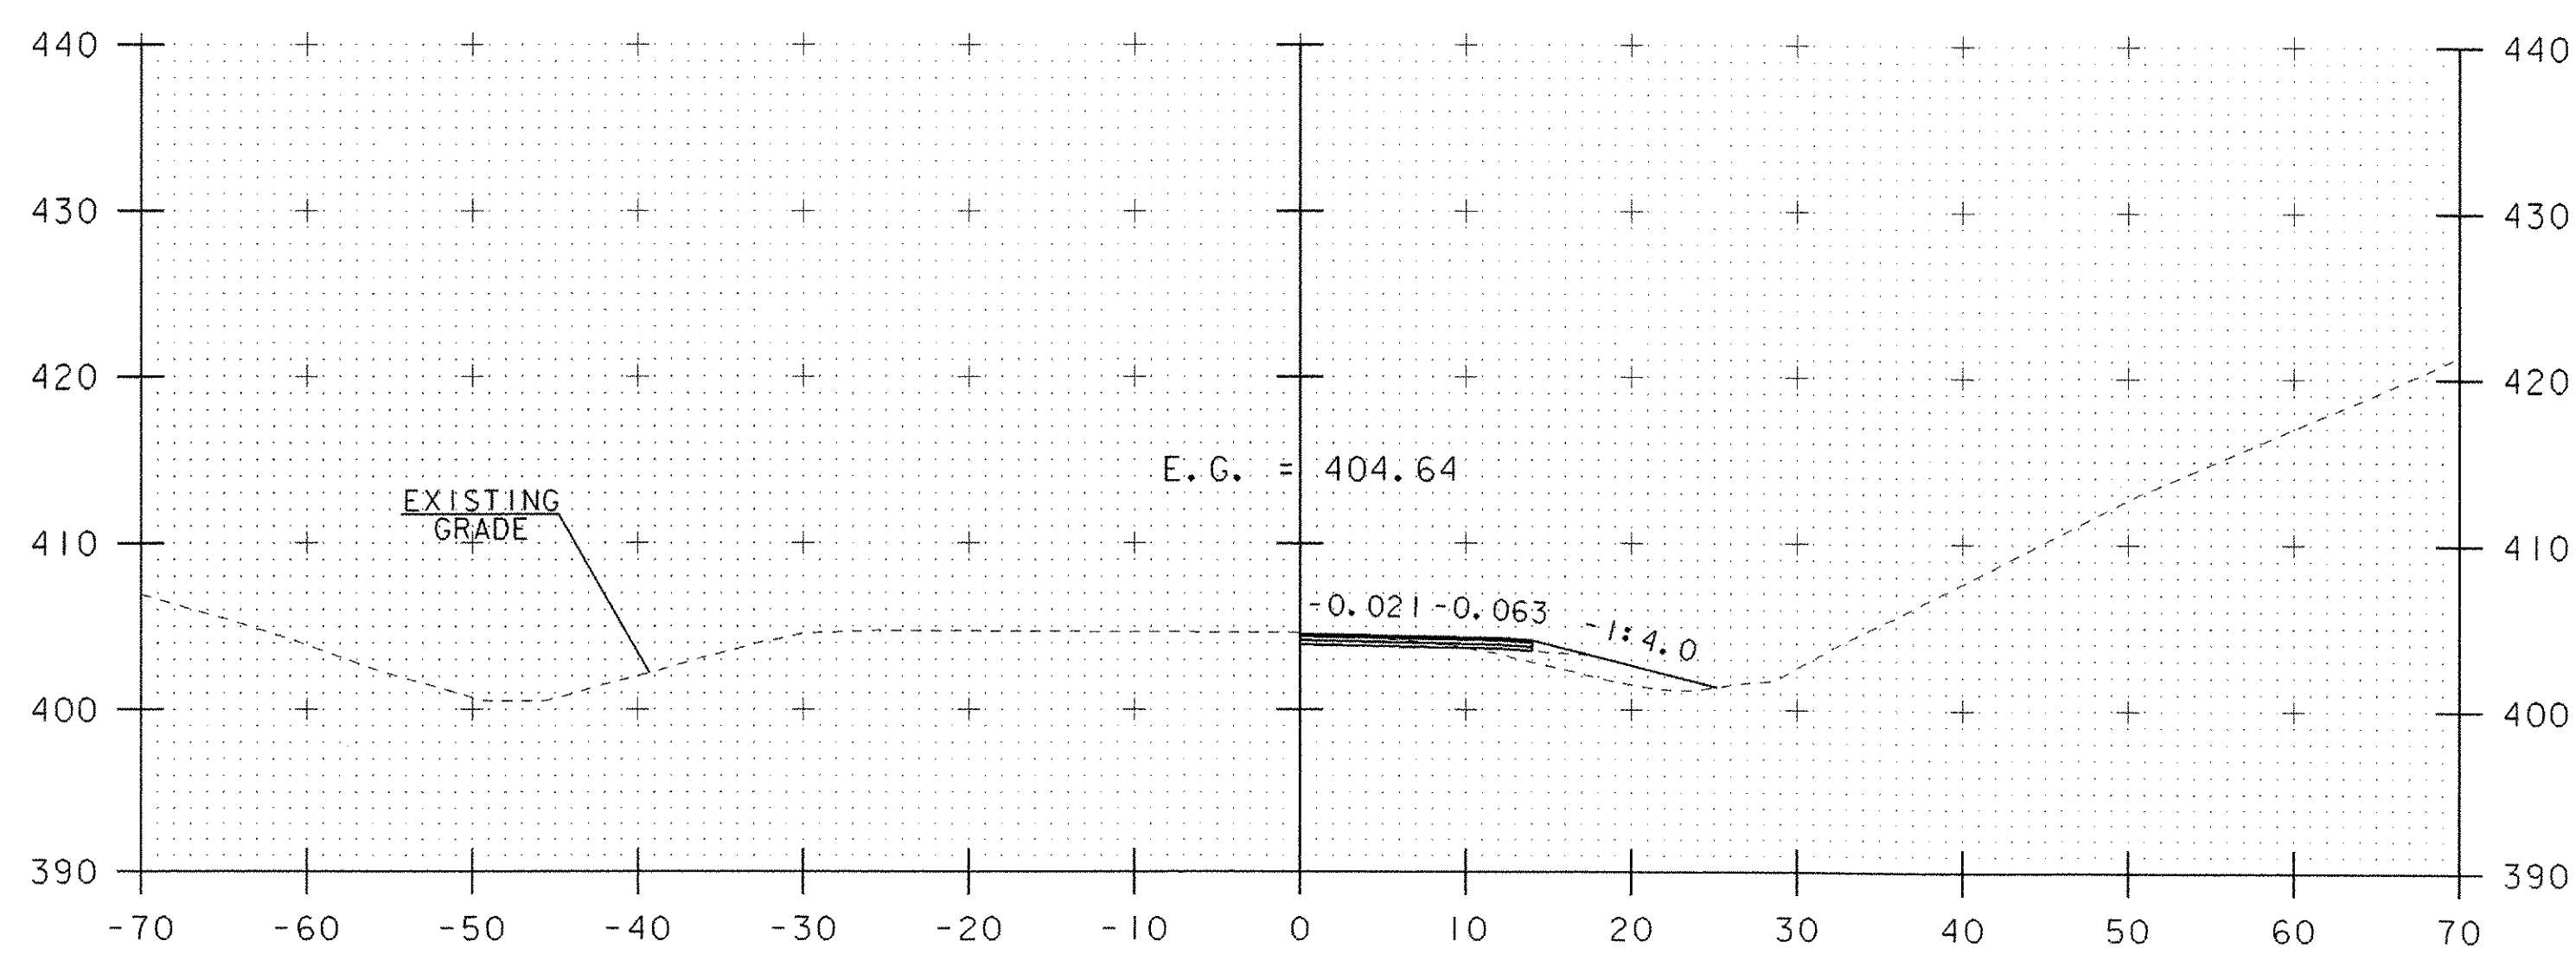


5+50

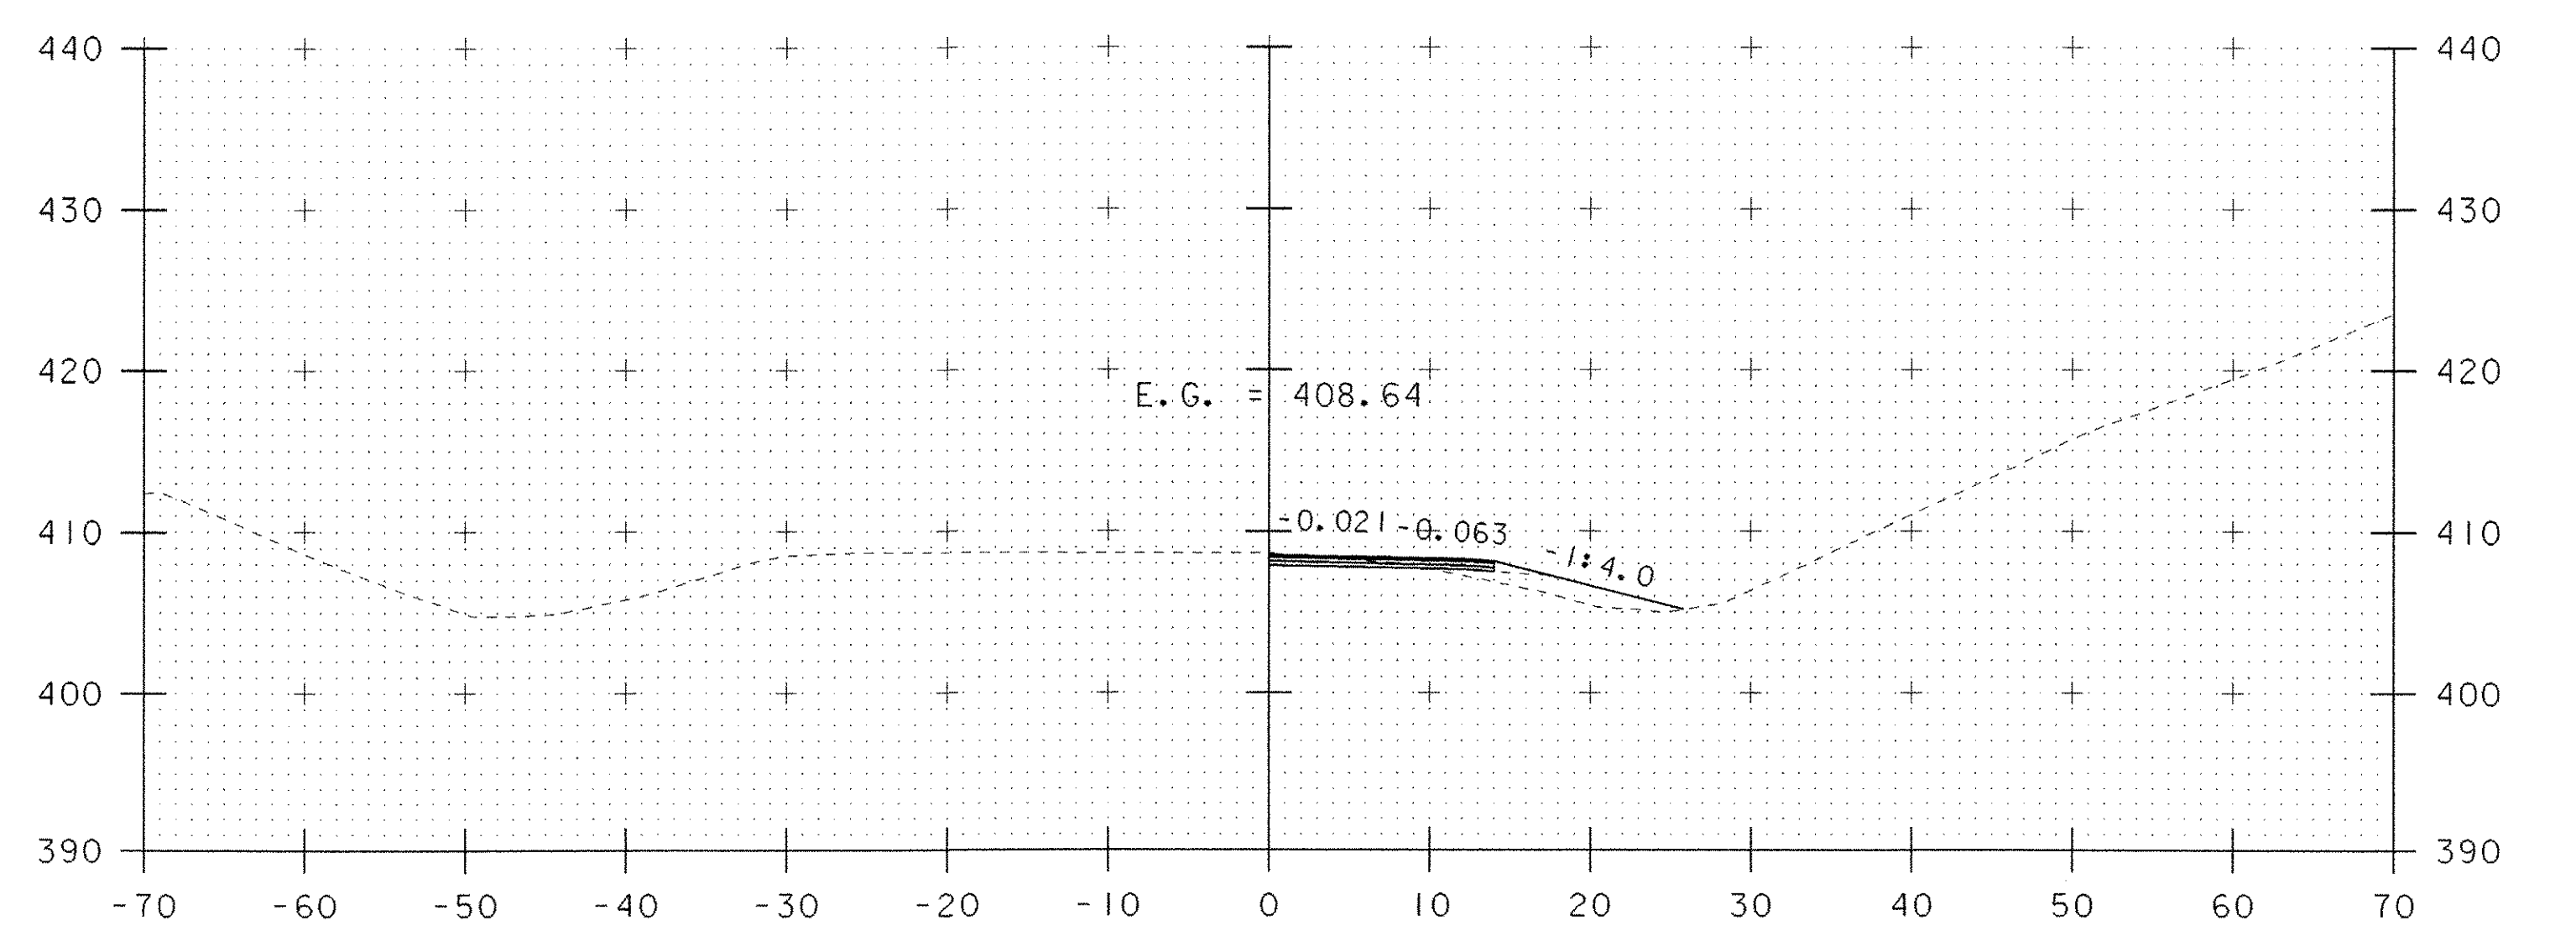


6+50


DATUM
 VERTICAL N/A
 HORIZONTAL N/A

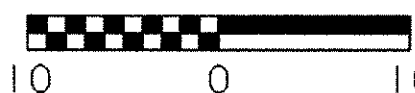SCALE 1" = 10'-0"


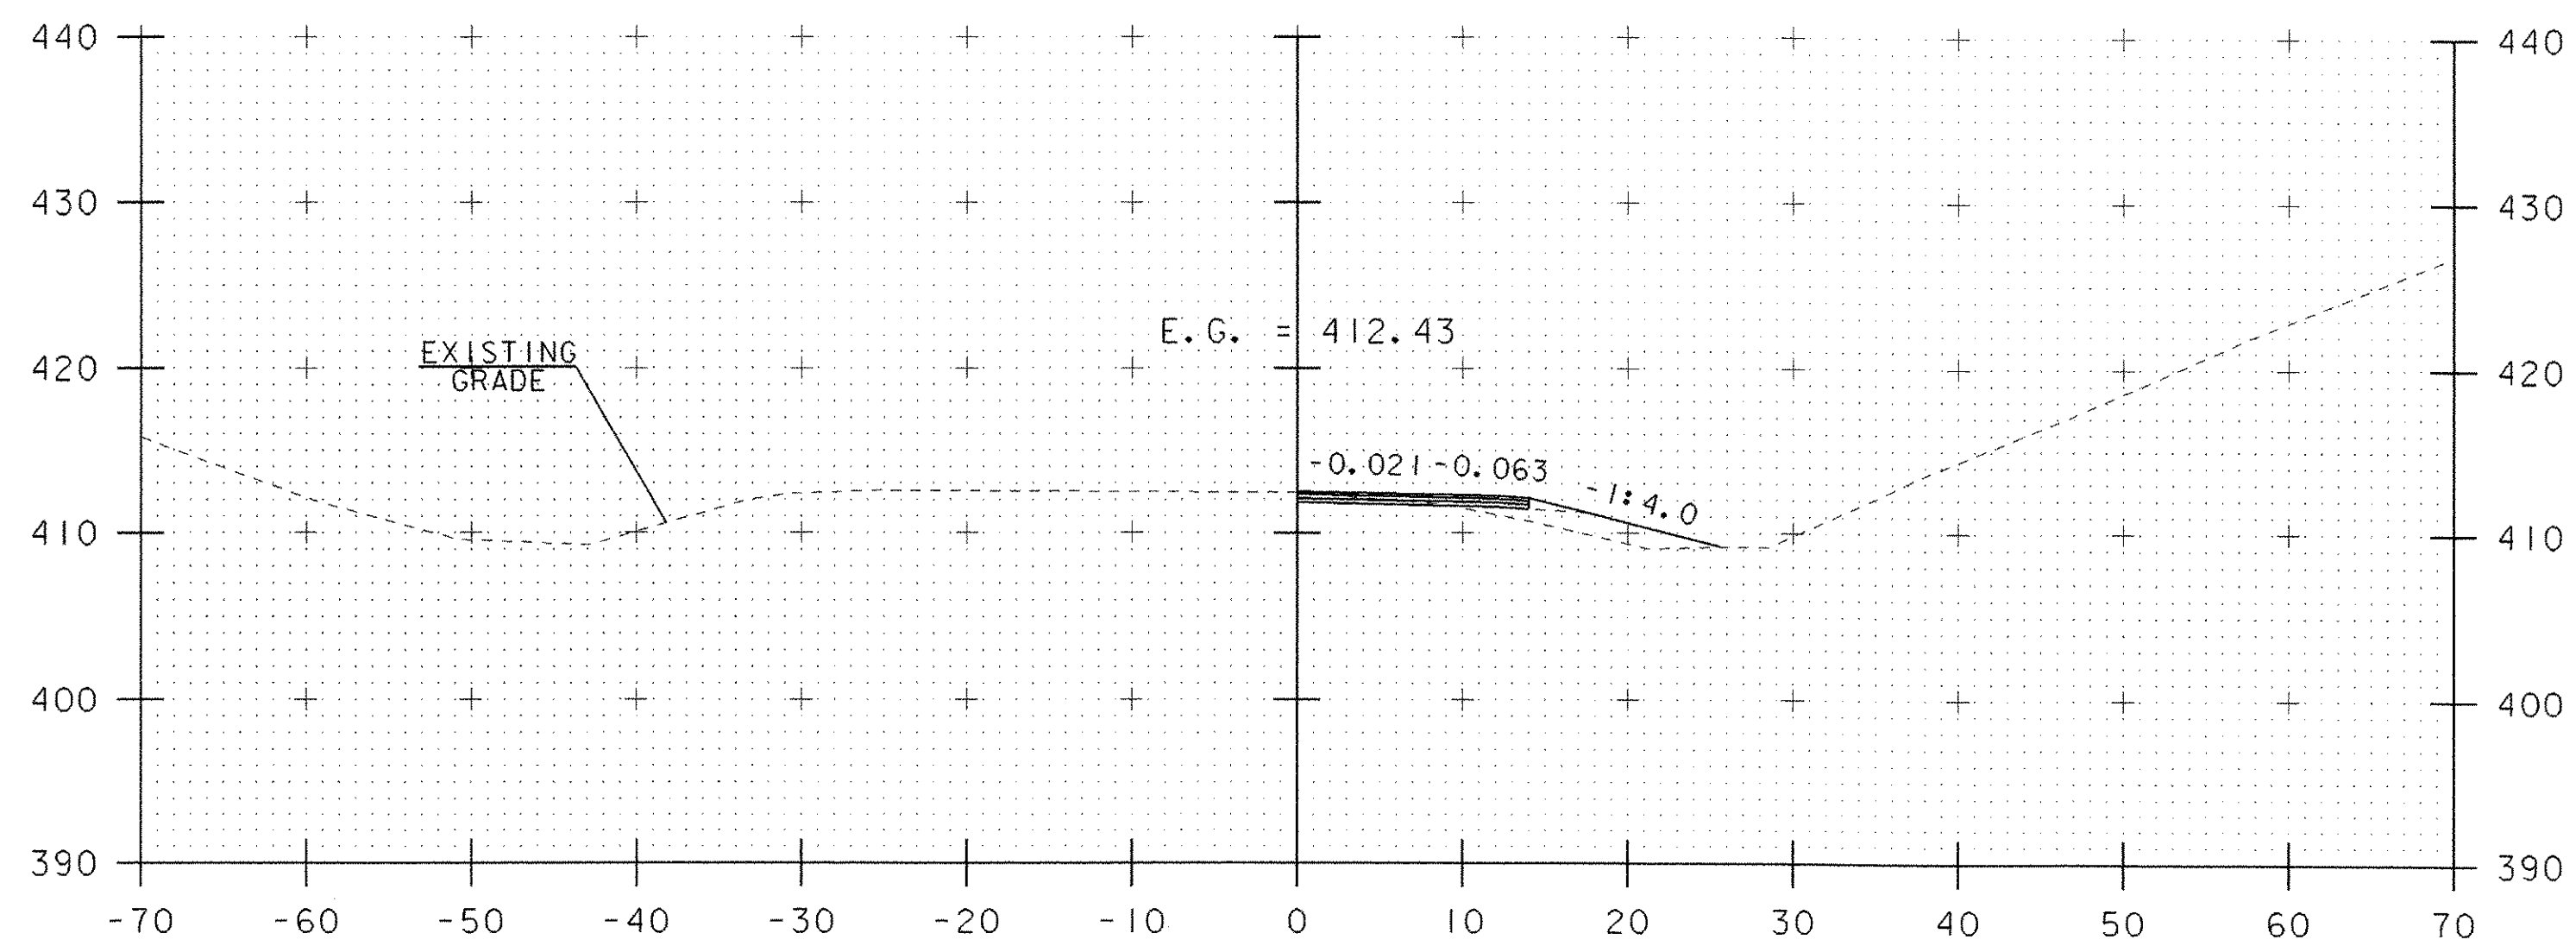
PROJECT NAME: I-89 EXIT 12 SB OFF RAMP
 PROJECT NUMBER: IM 089-2(35)
 FILE NAME: 618800F4XS01.dgn
 PROJECT LEADER: EPD
 DESIGNED BY: JDA
 STA. 5+50 TO STA. 7+00
 PLOT DATE: 17-MAY-2005
 DRAWN BY: JDA / PGJ
 CHECKED BY: EPD
 SHEET 71 OF 76

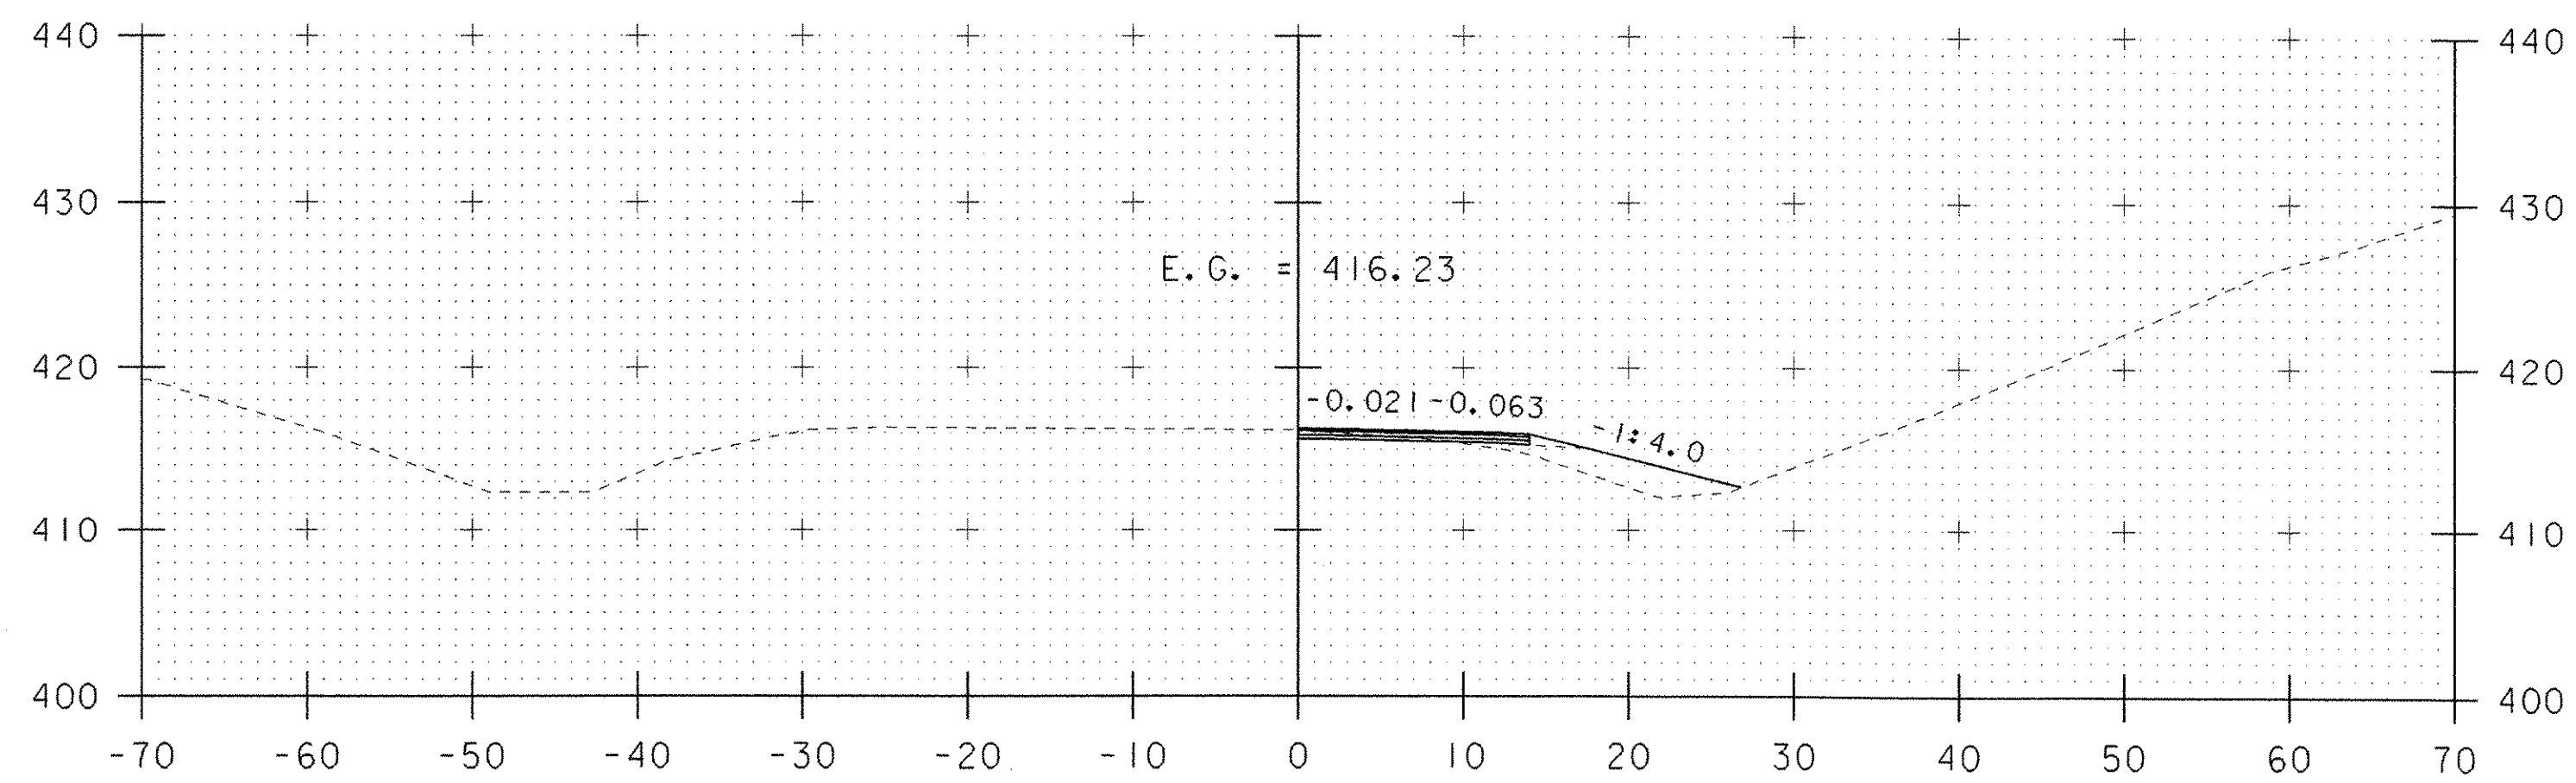


8+50

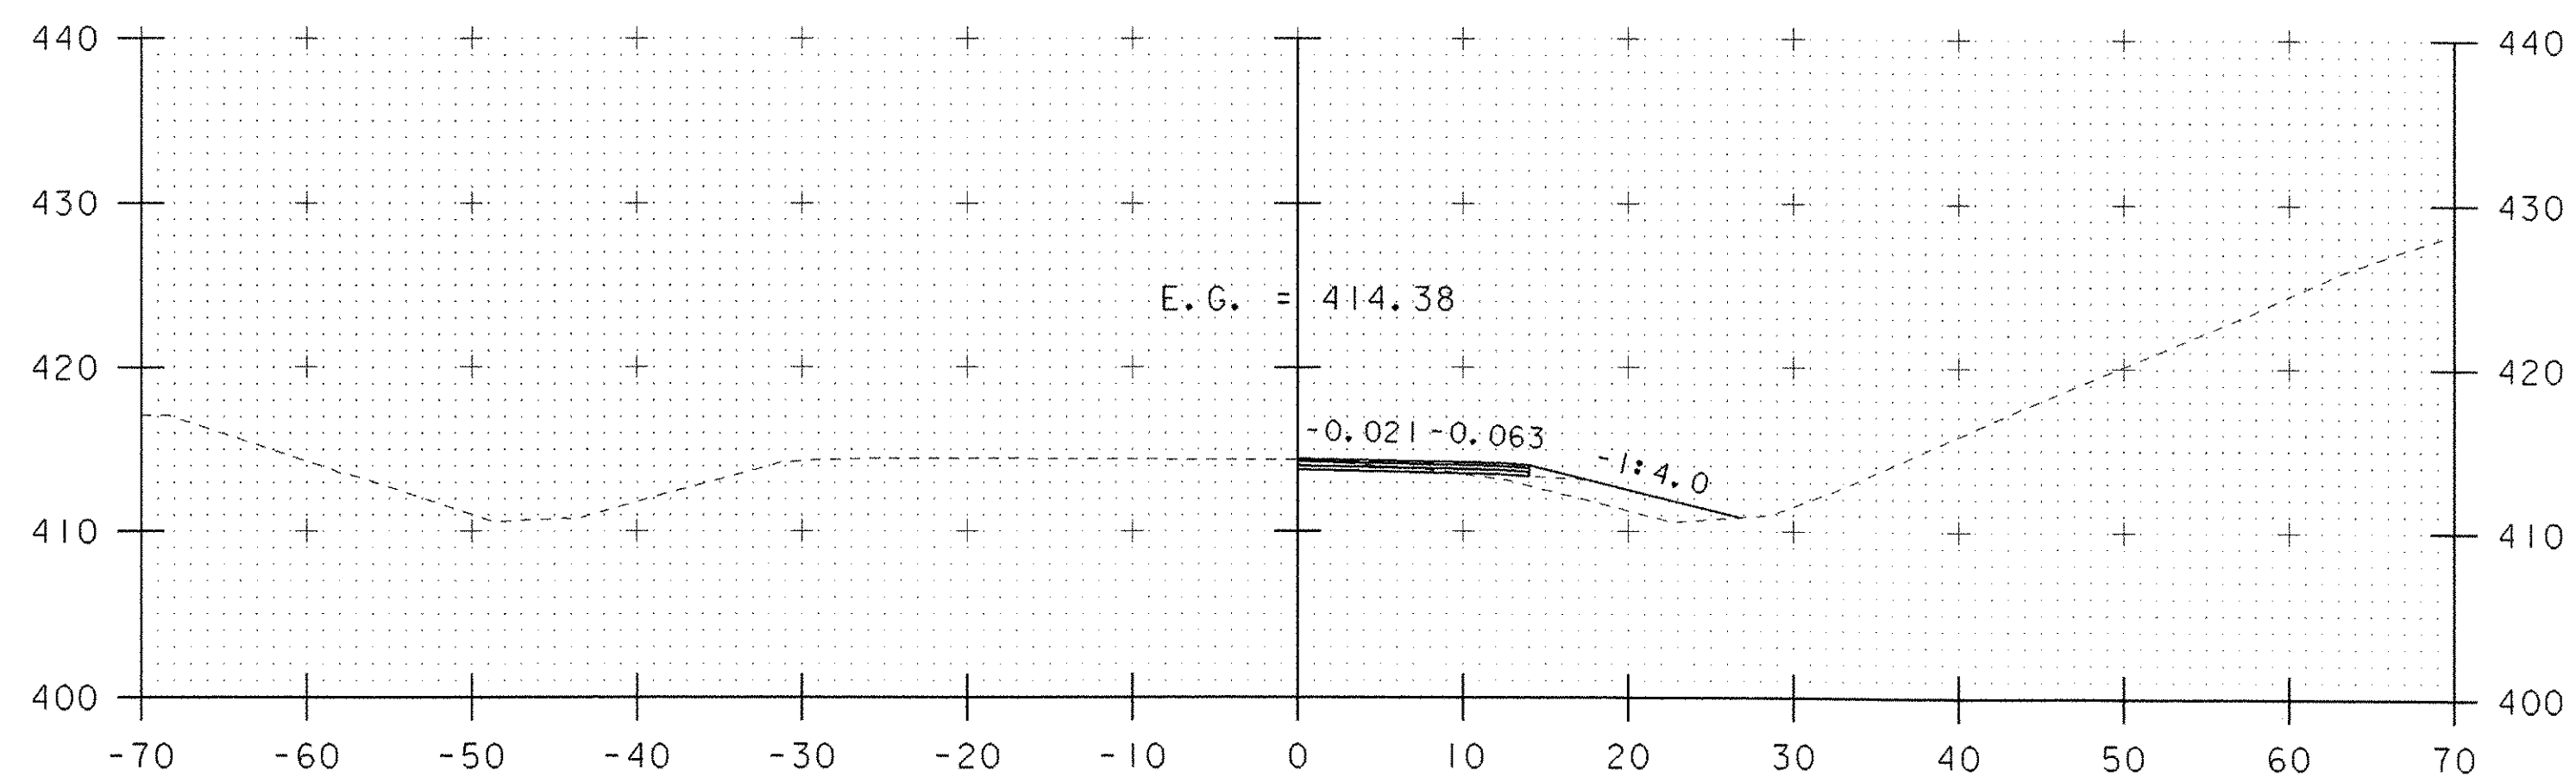


8+00



7+50

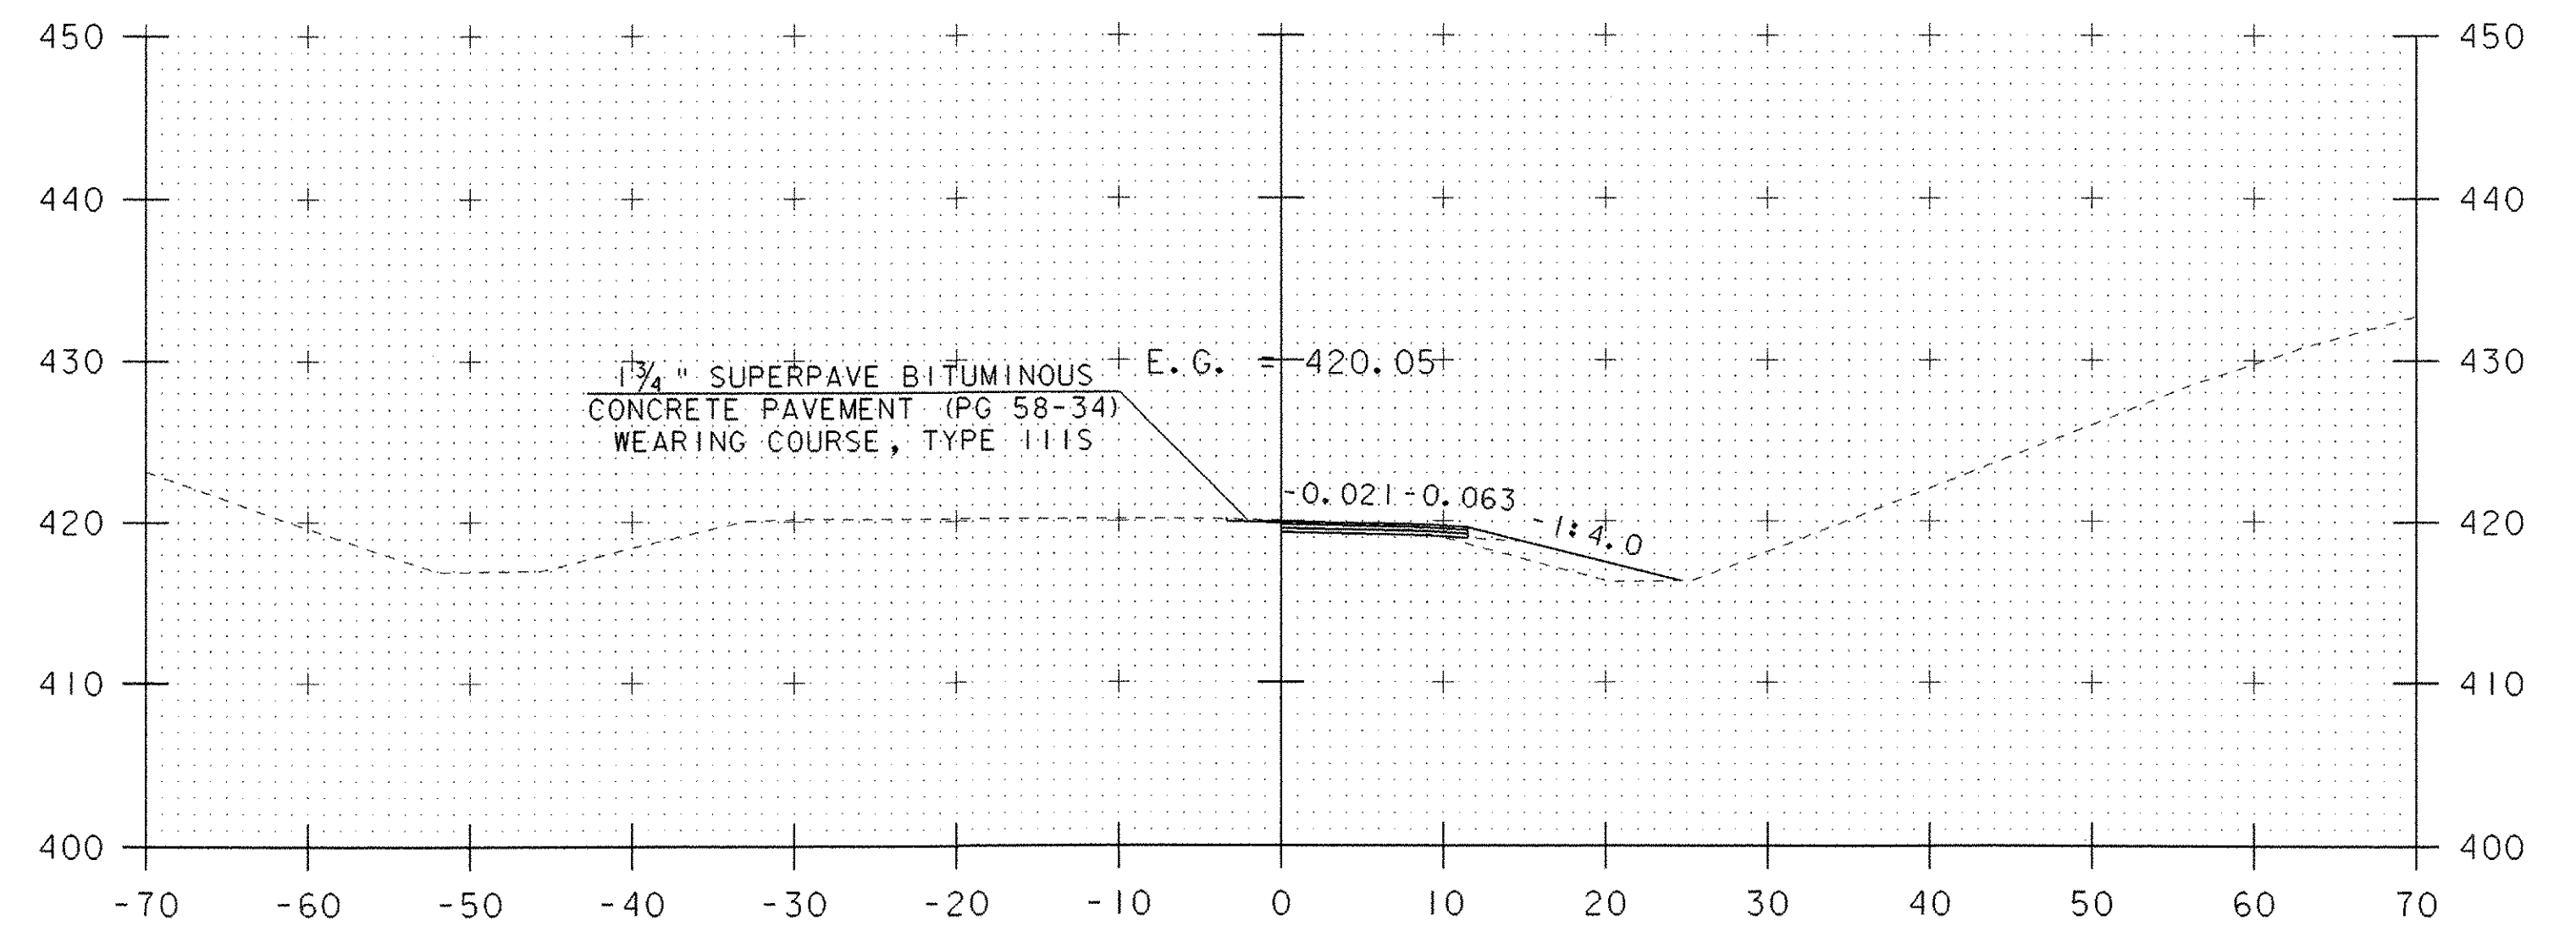


9+50

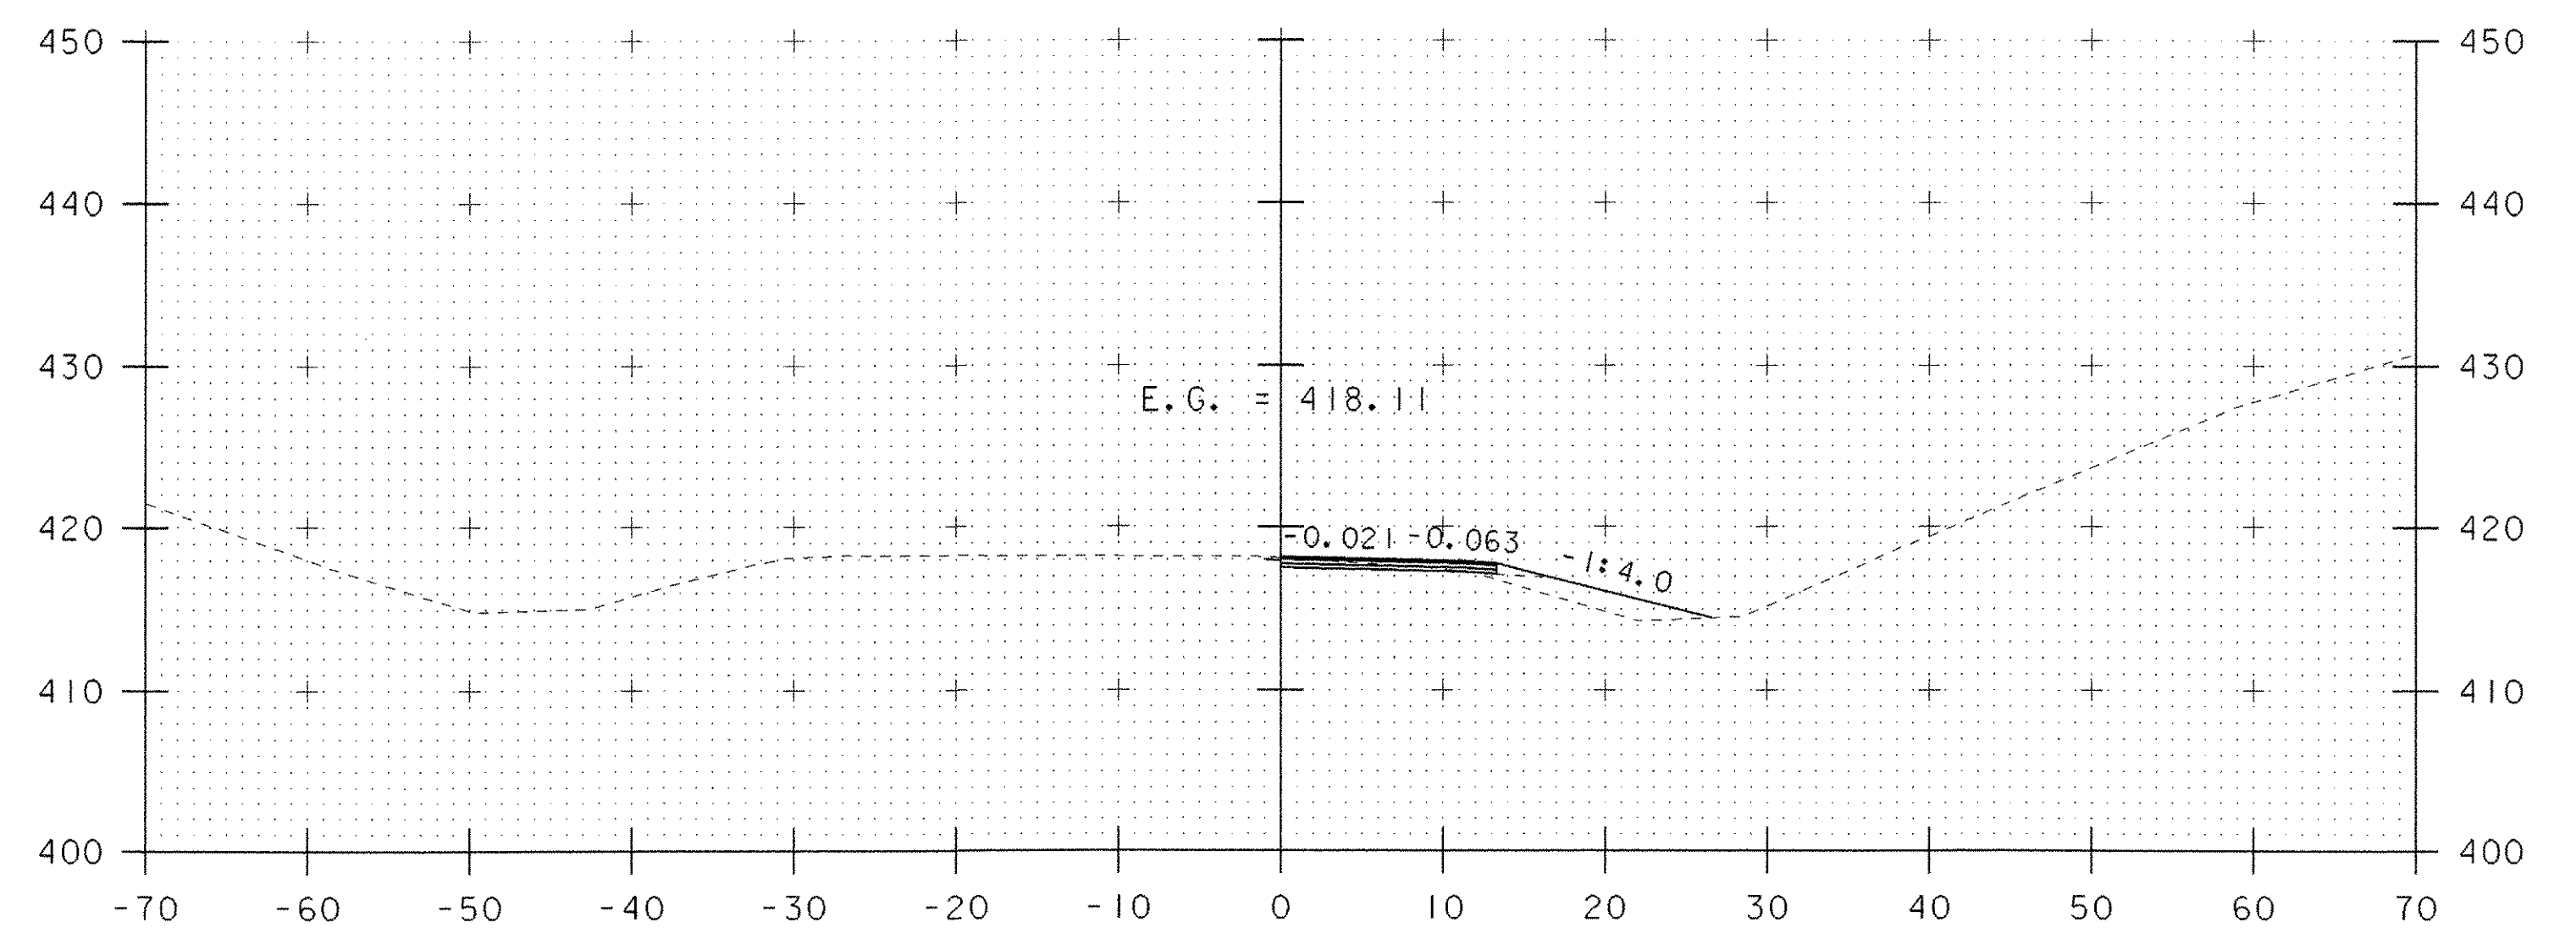

9+00


DATUM
 VERTICAL N/A
 HORIZONTAL N/A

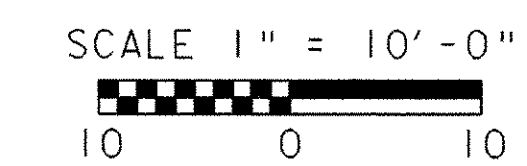


PROJECT NAME: I-89 EXIT 12 SB OFF RAMP
 PROJECT NUMBER: IM 089-2(35)

FILE NAME: 618800F4XS01.dgn
 PROJECT LEADER: EPD
 DESIGNED BY: JDA
 STA. 7+50 TO STA. 9+50


PLOT DATE: 17-MAY-2005
 DRAWN BY: JDA / PGJ
 CHECKED BY: EPD
 SHEET 72 OF 76

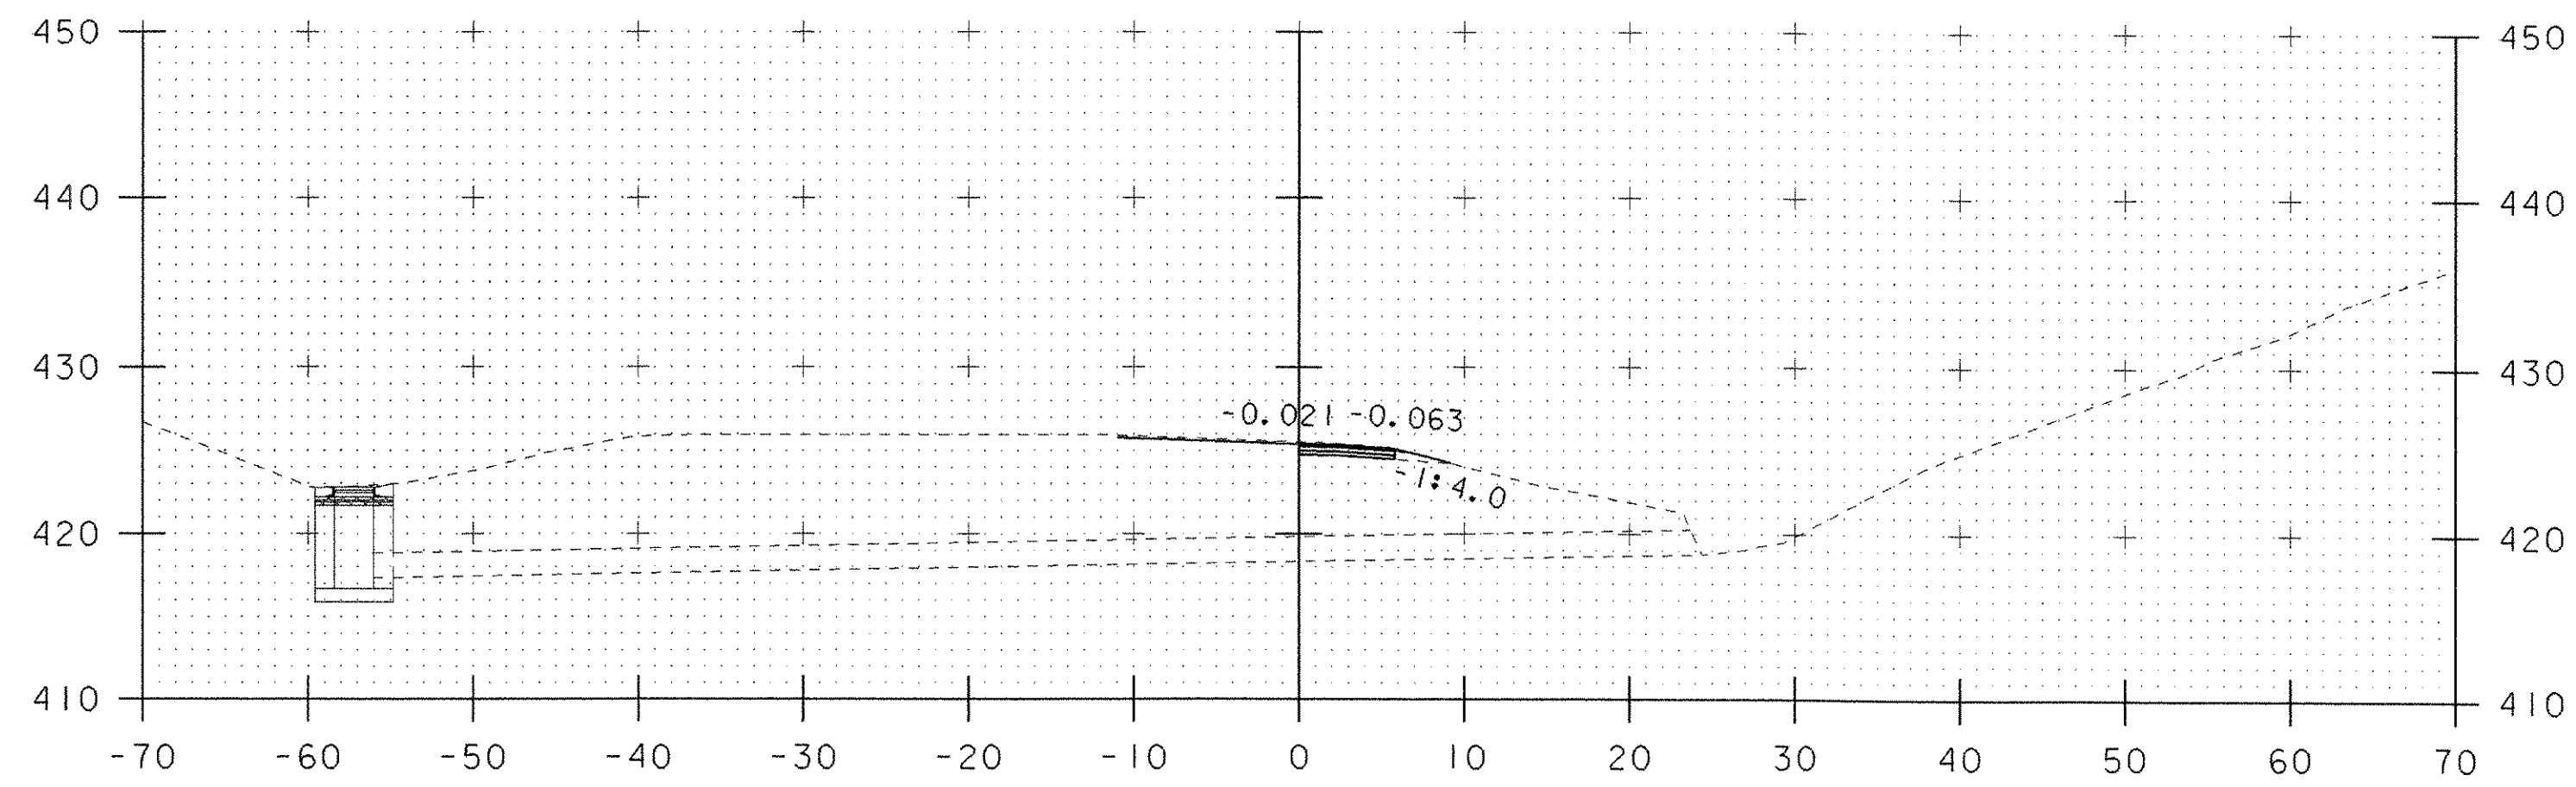


11+08

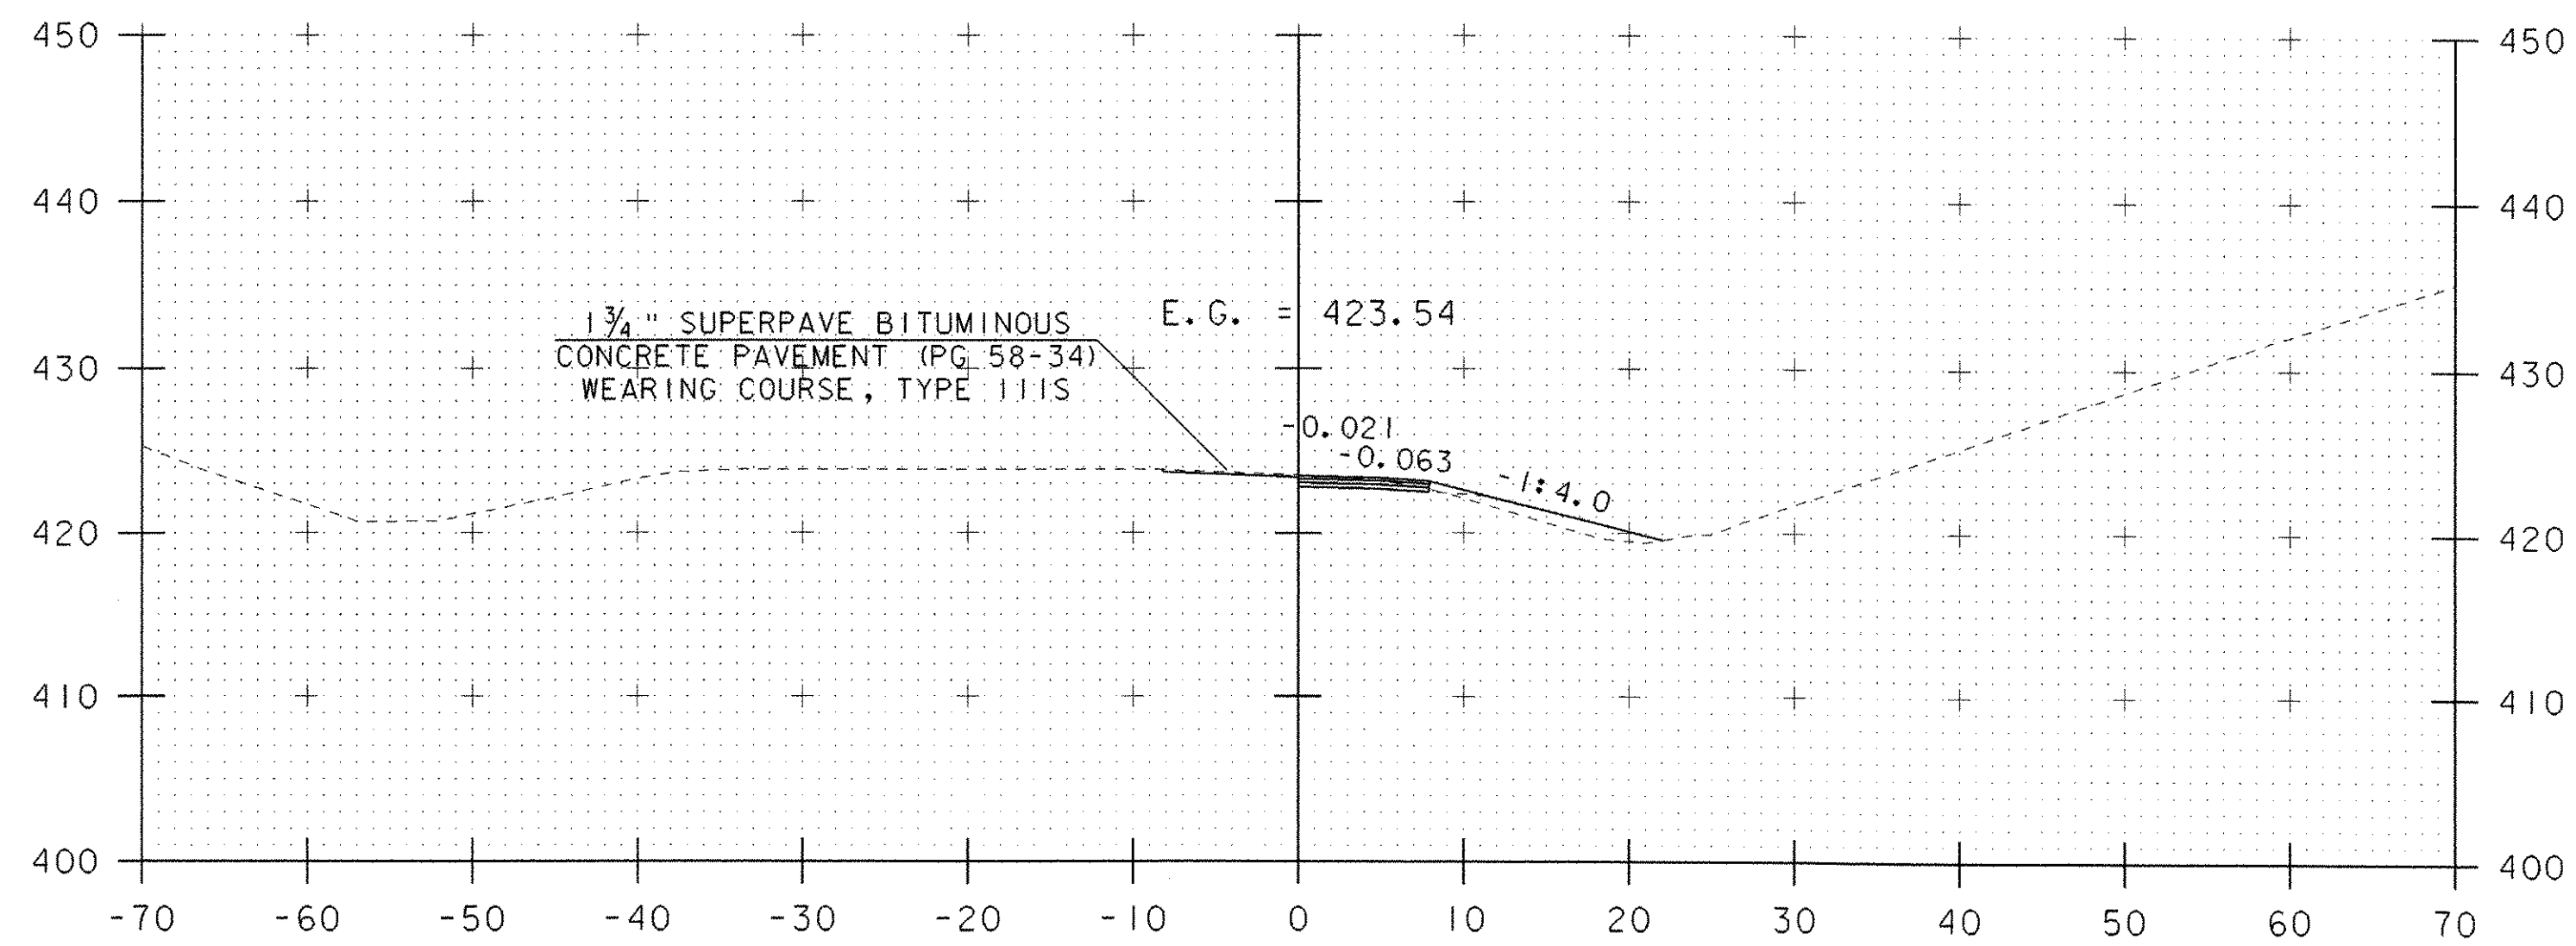


10+50

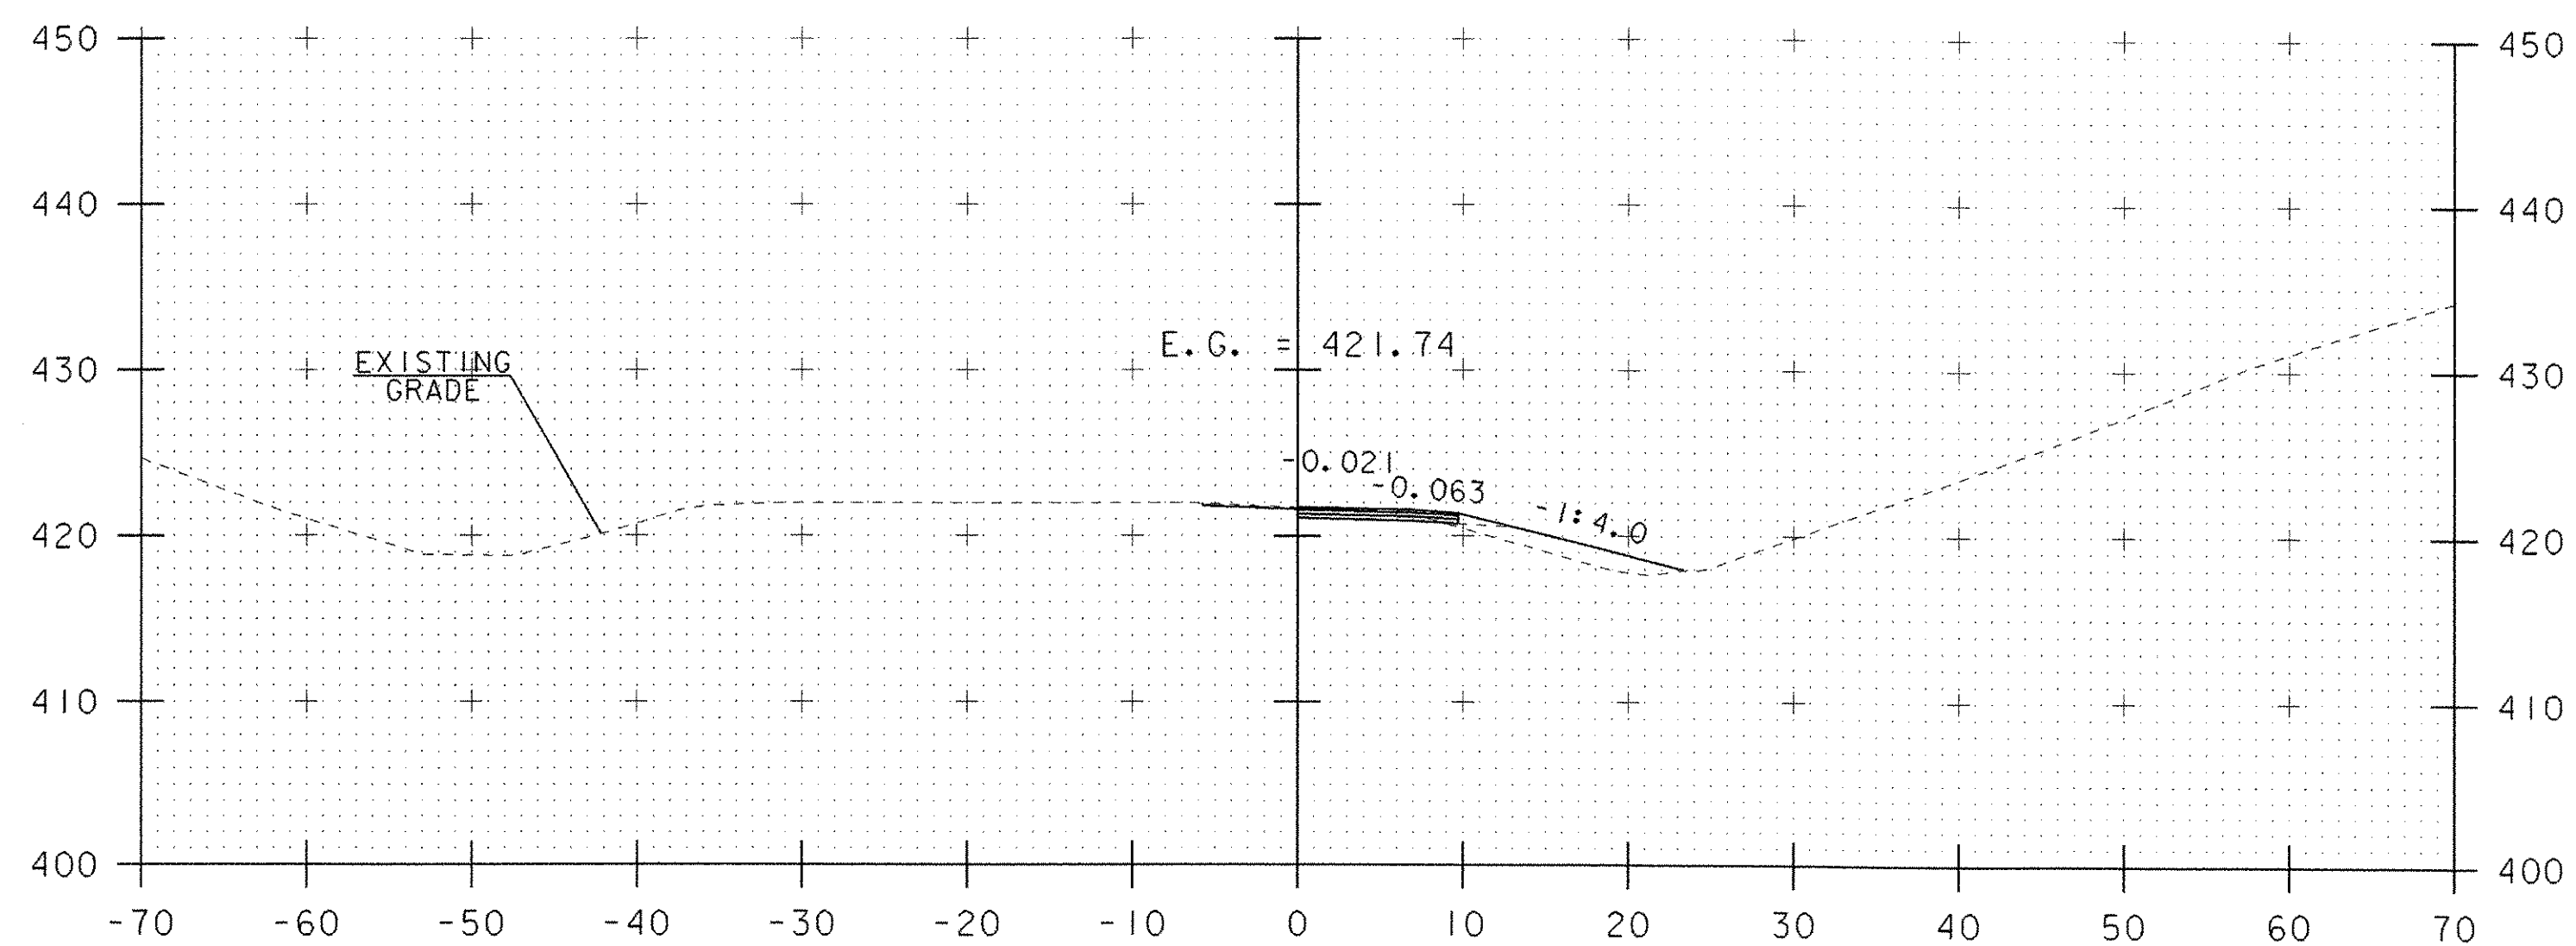


10+00

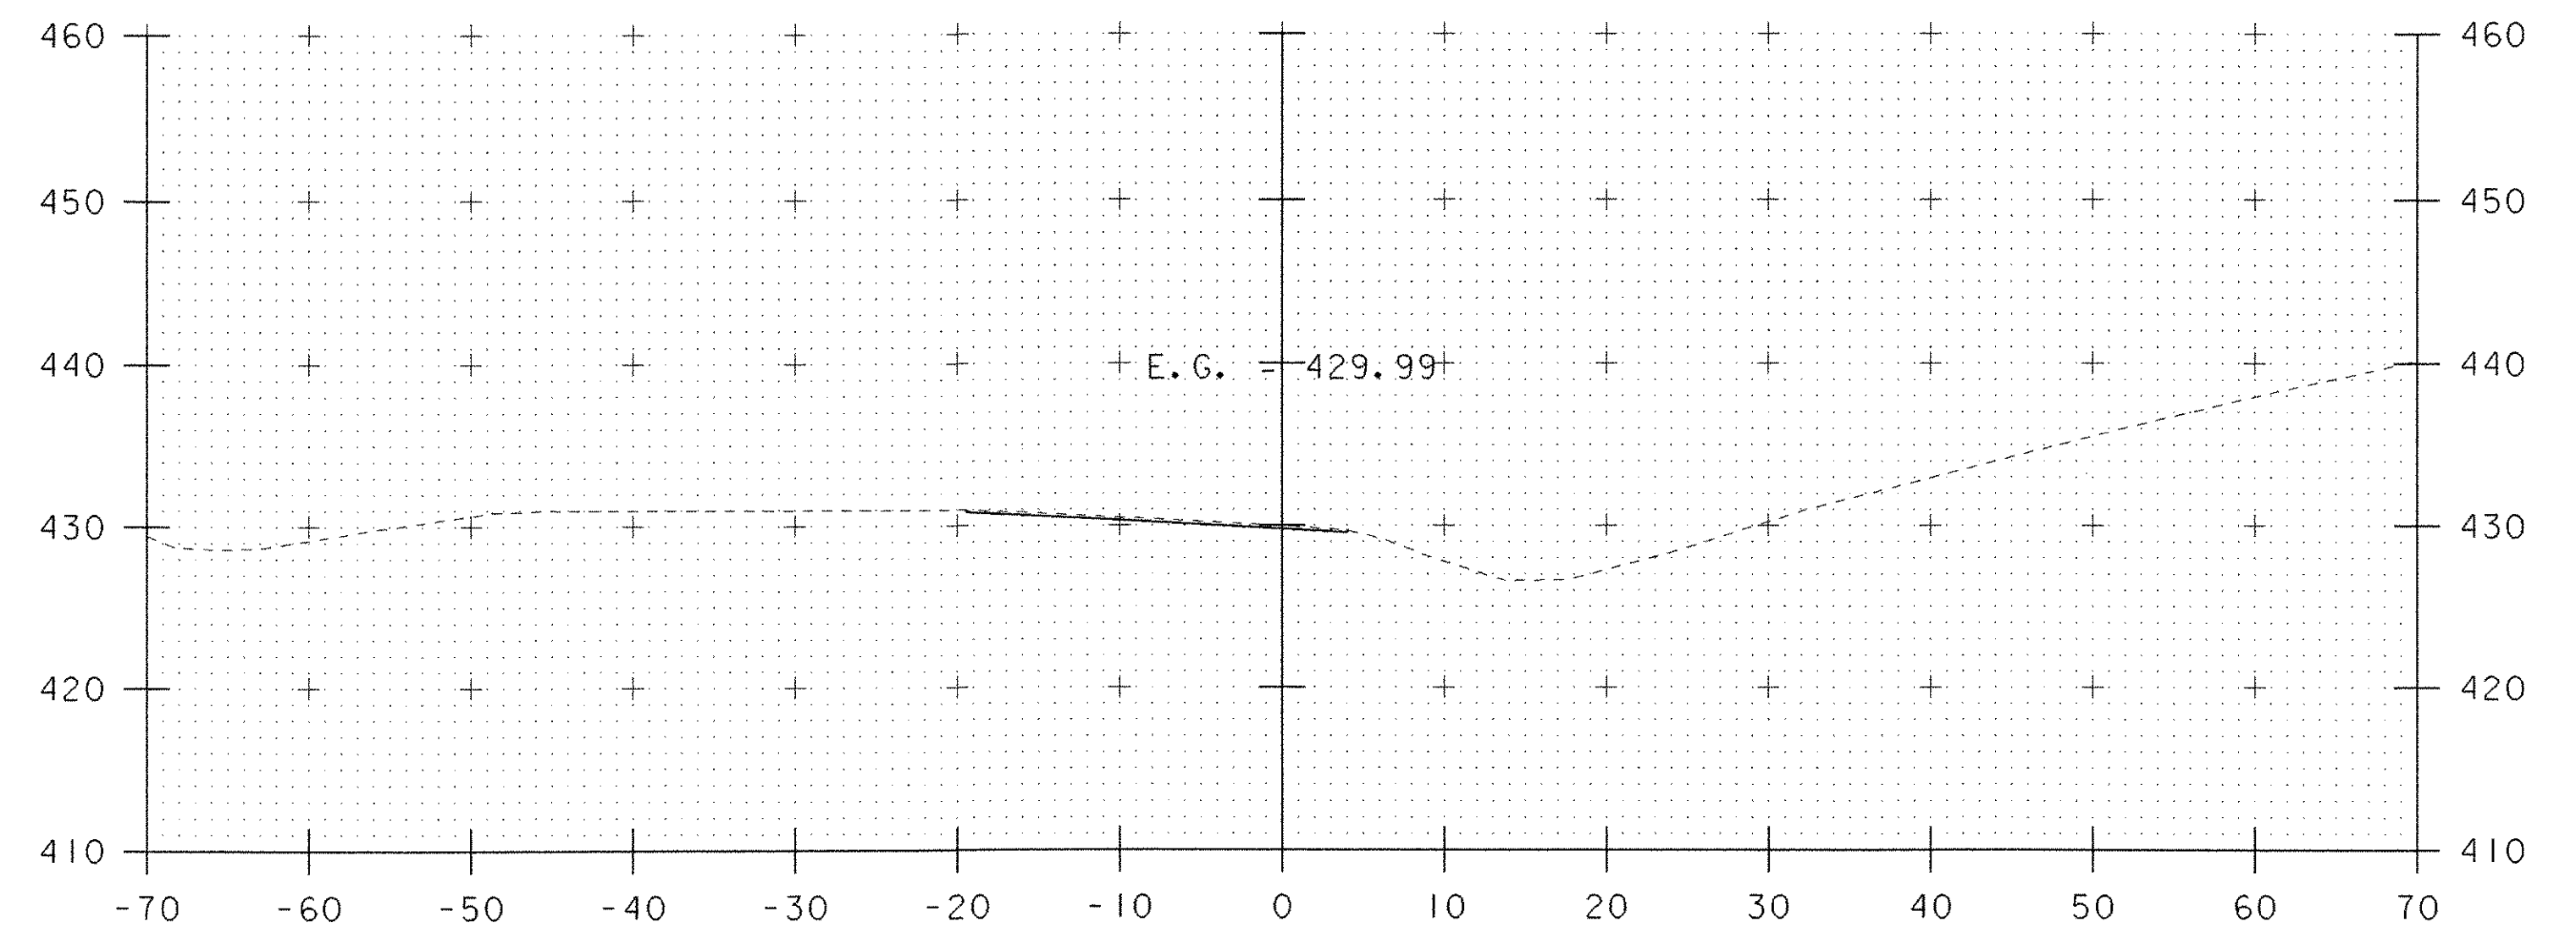

12+50

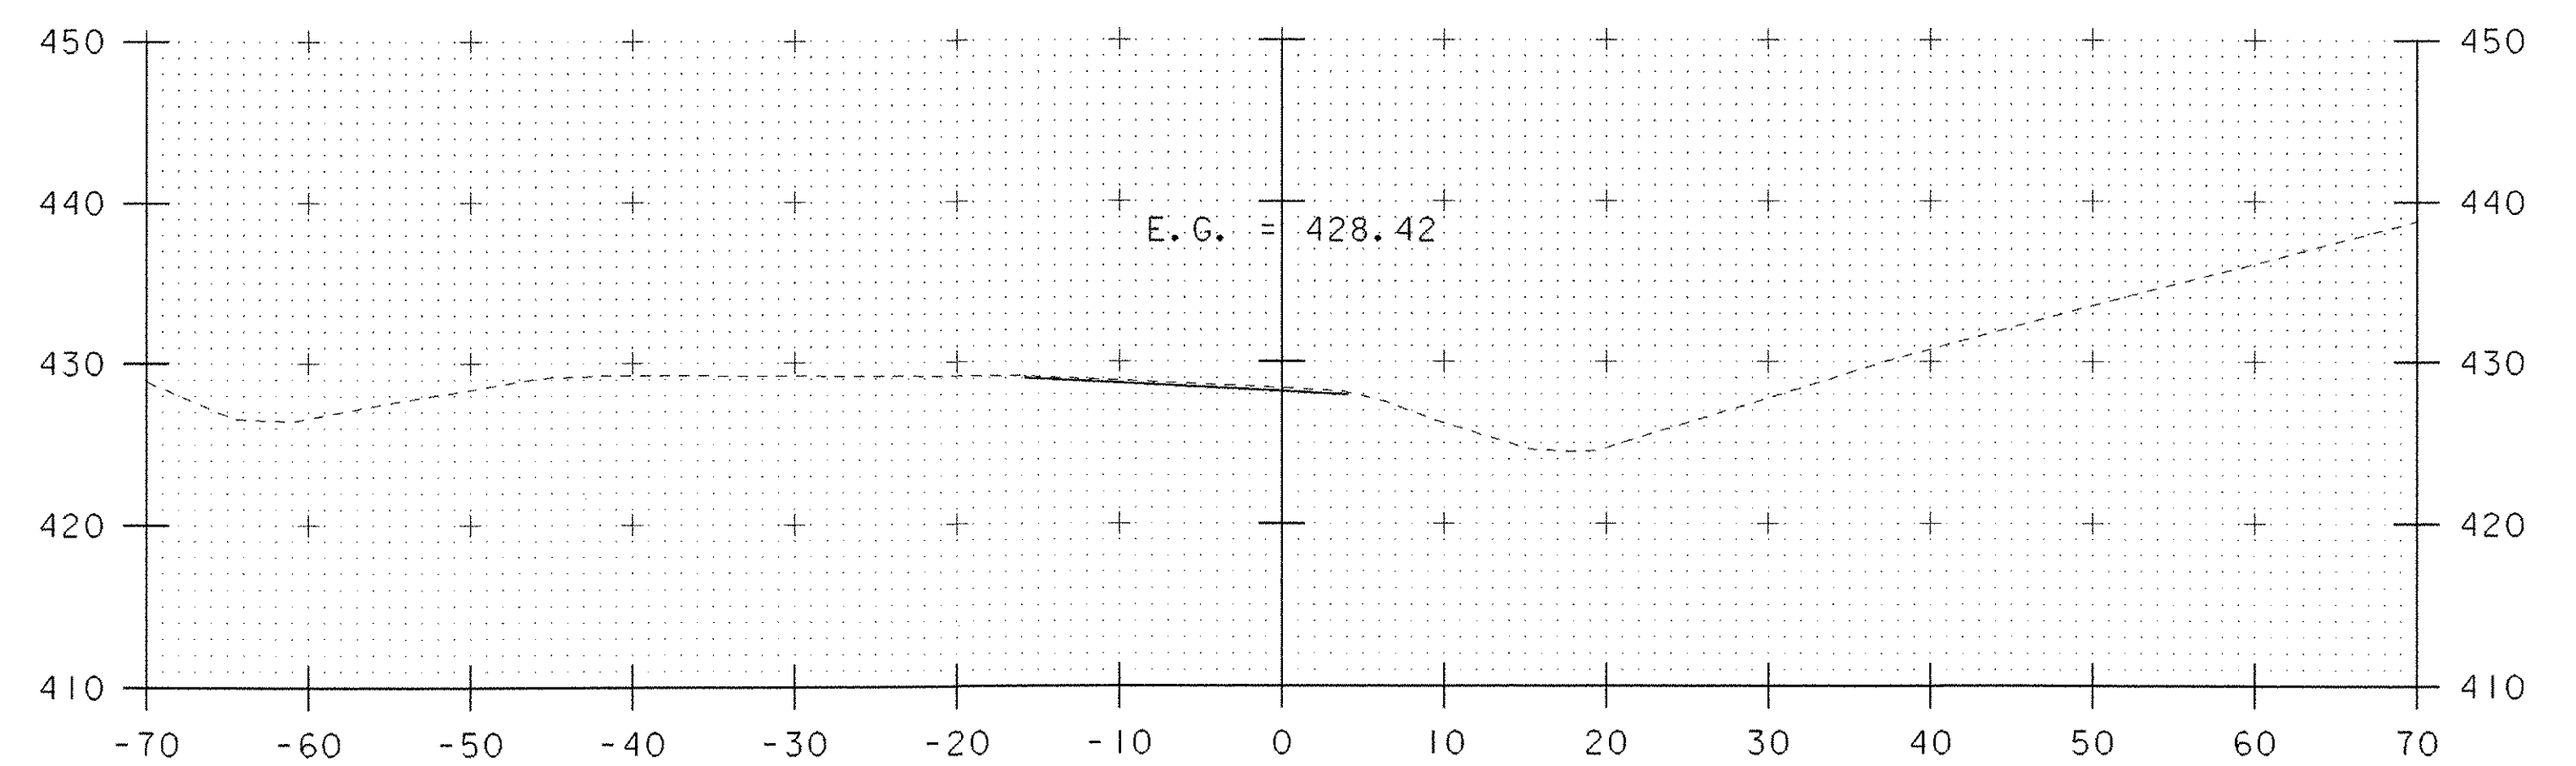


12+00

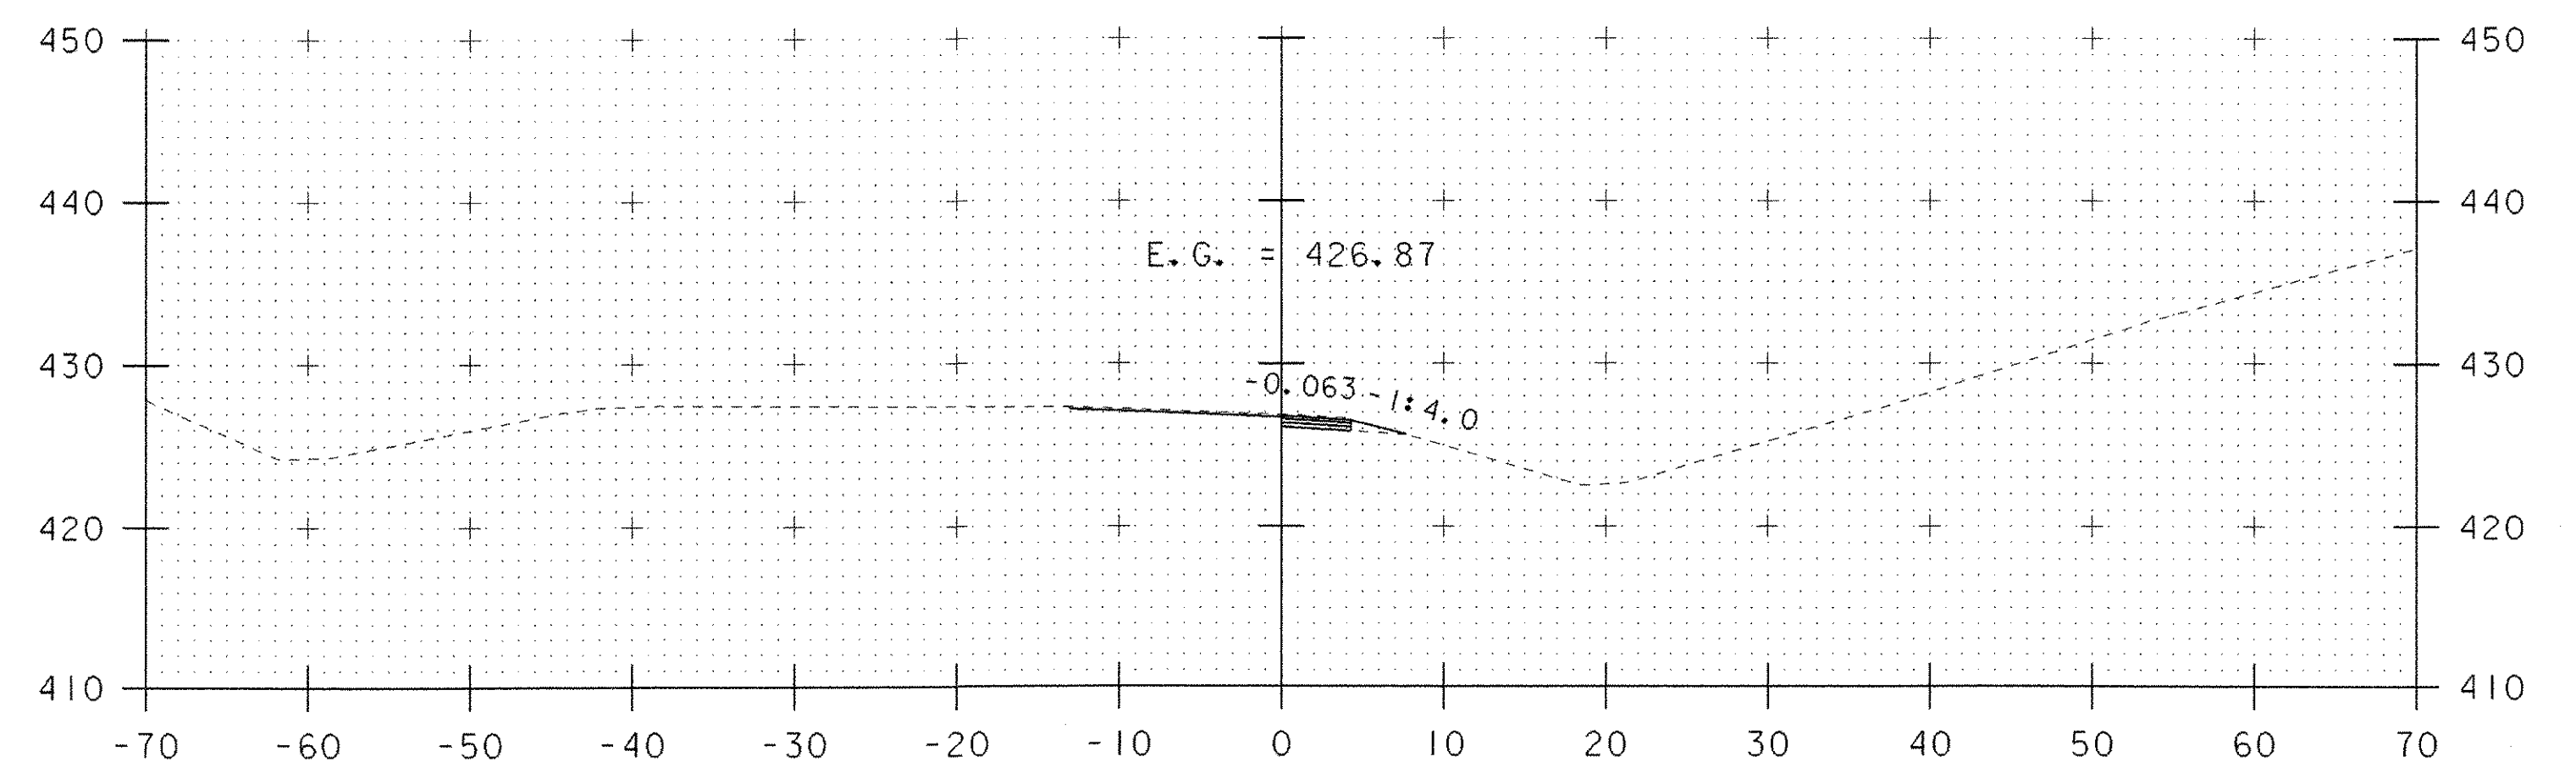


11+50


| | |
|------------|-----|
| DATUM | |
| VERTICAL | N/A |
| HORIZONTAL | N/A |

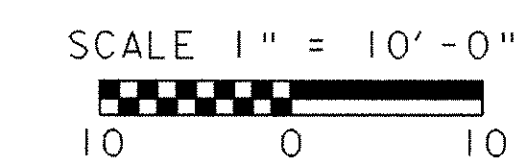


| | | |
|--------------------------|--------------------------|------------------------|
| PROJECT NAME: | I-89 EXIT 12 SB OFF RAMP | |
| PROJECT NUMBER: | IM 089-2(35) | |
| FILE NAME: | 618800F4XS01.dgn | PLOT DATE: 17-MAY-2005 |
| PROJECT LEADER: | EPD | DRAWN BY: JDA / PGJ |
| DESIGNED BY: | JDA | CHECKED BY: EPD |
| STA. 10+00 TO STA. 12+50 | | SHEET 73 OF 76 |

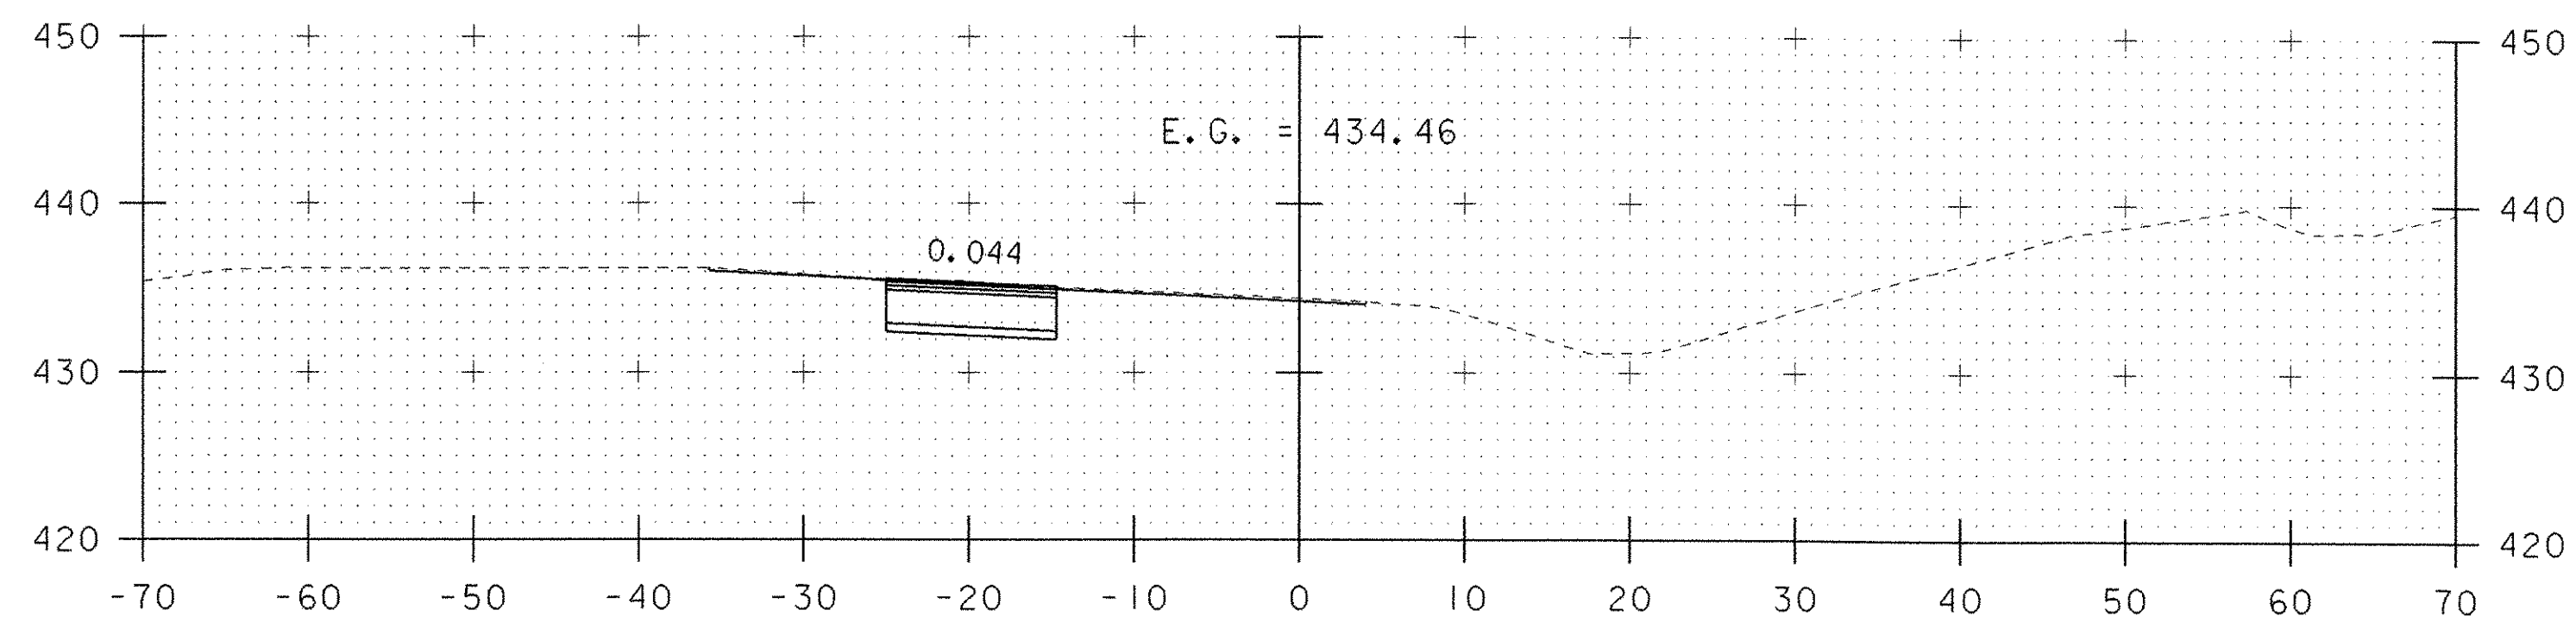


14+00

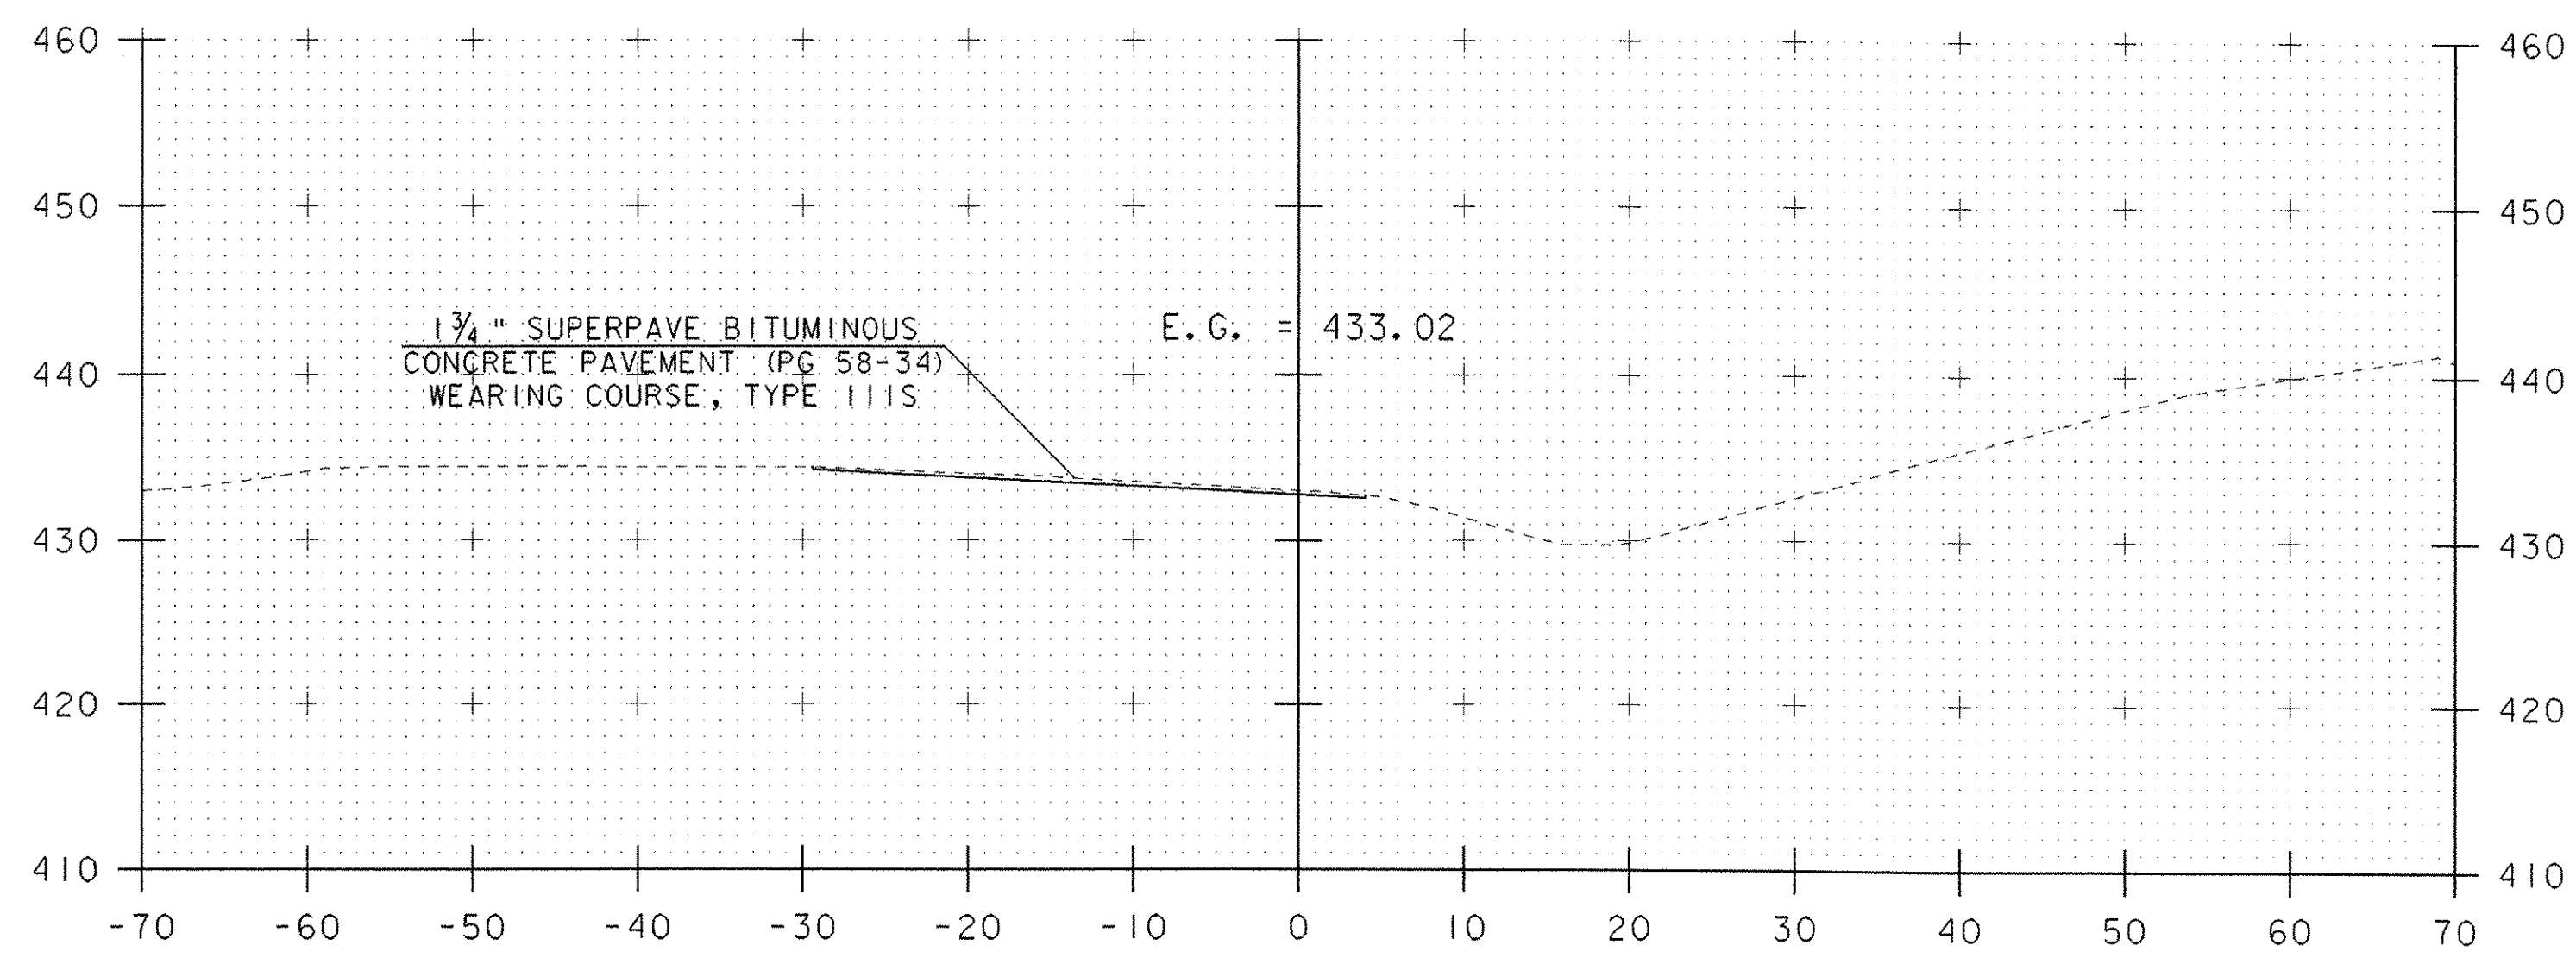


13+50

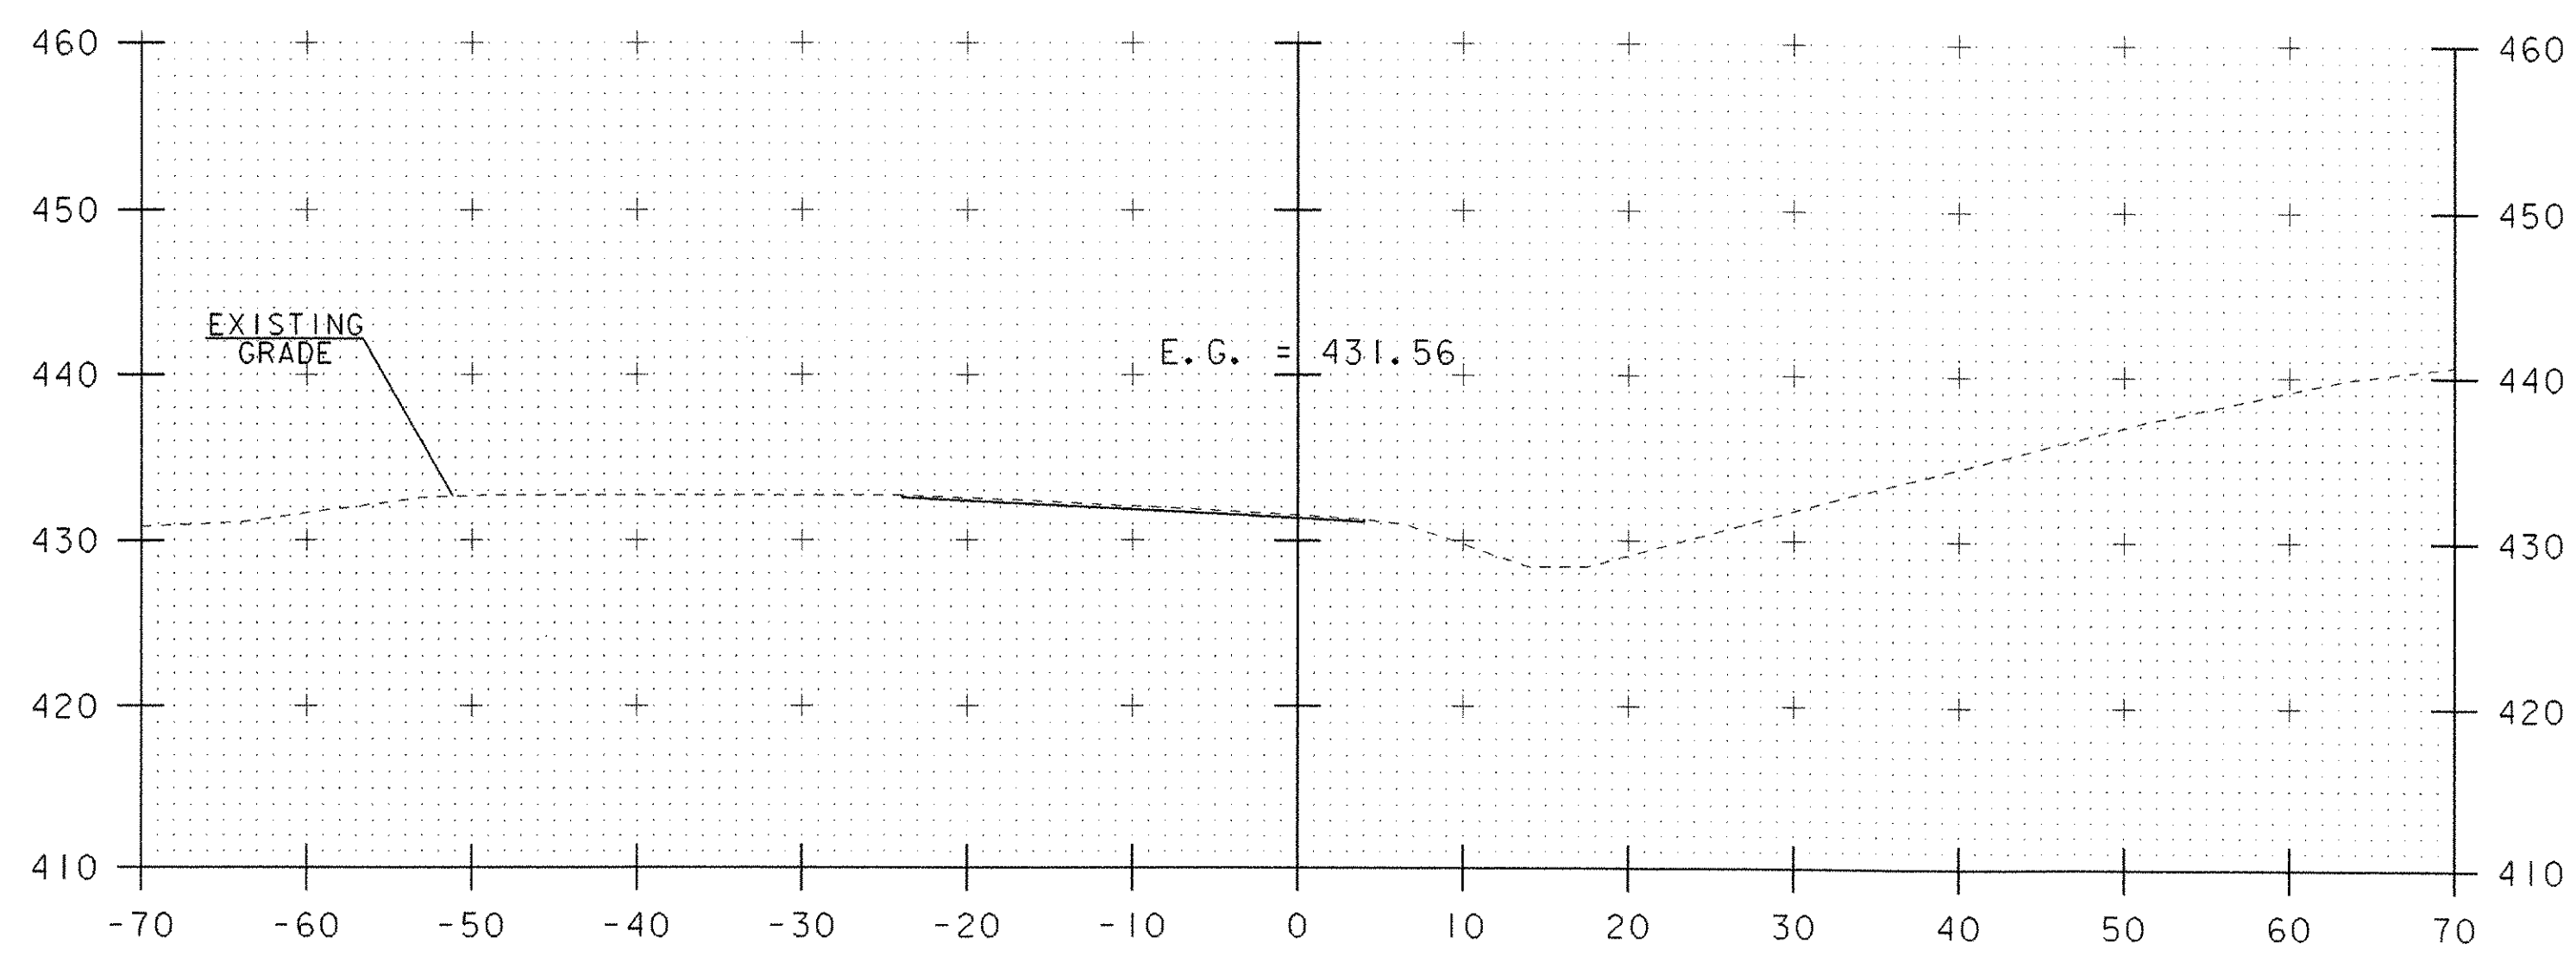


13+00

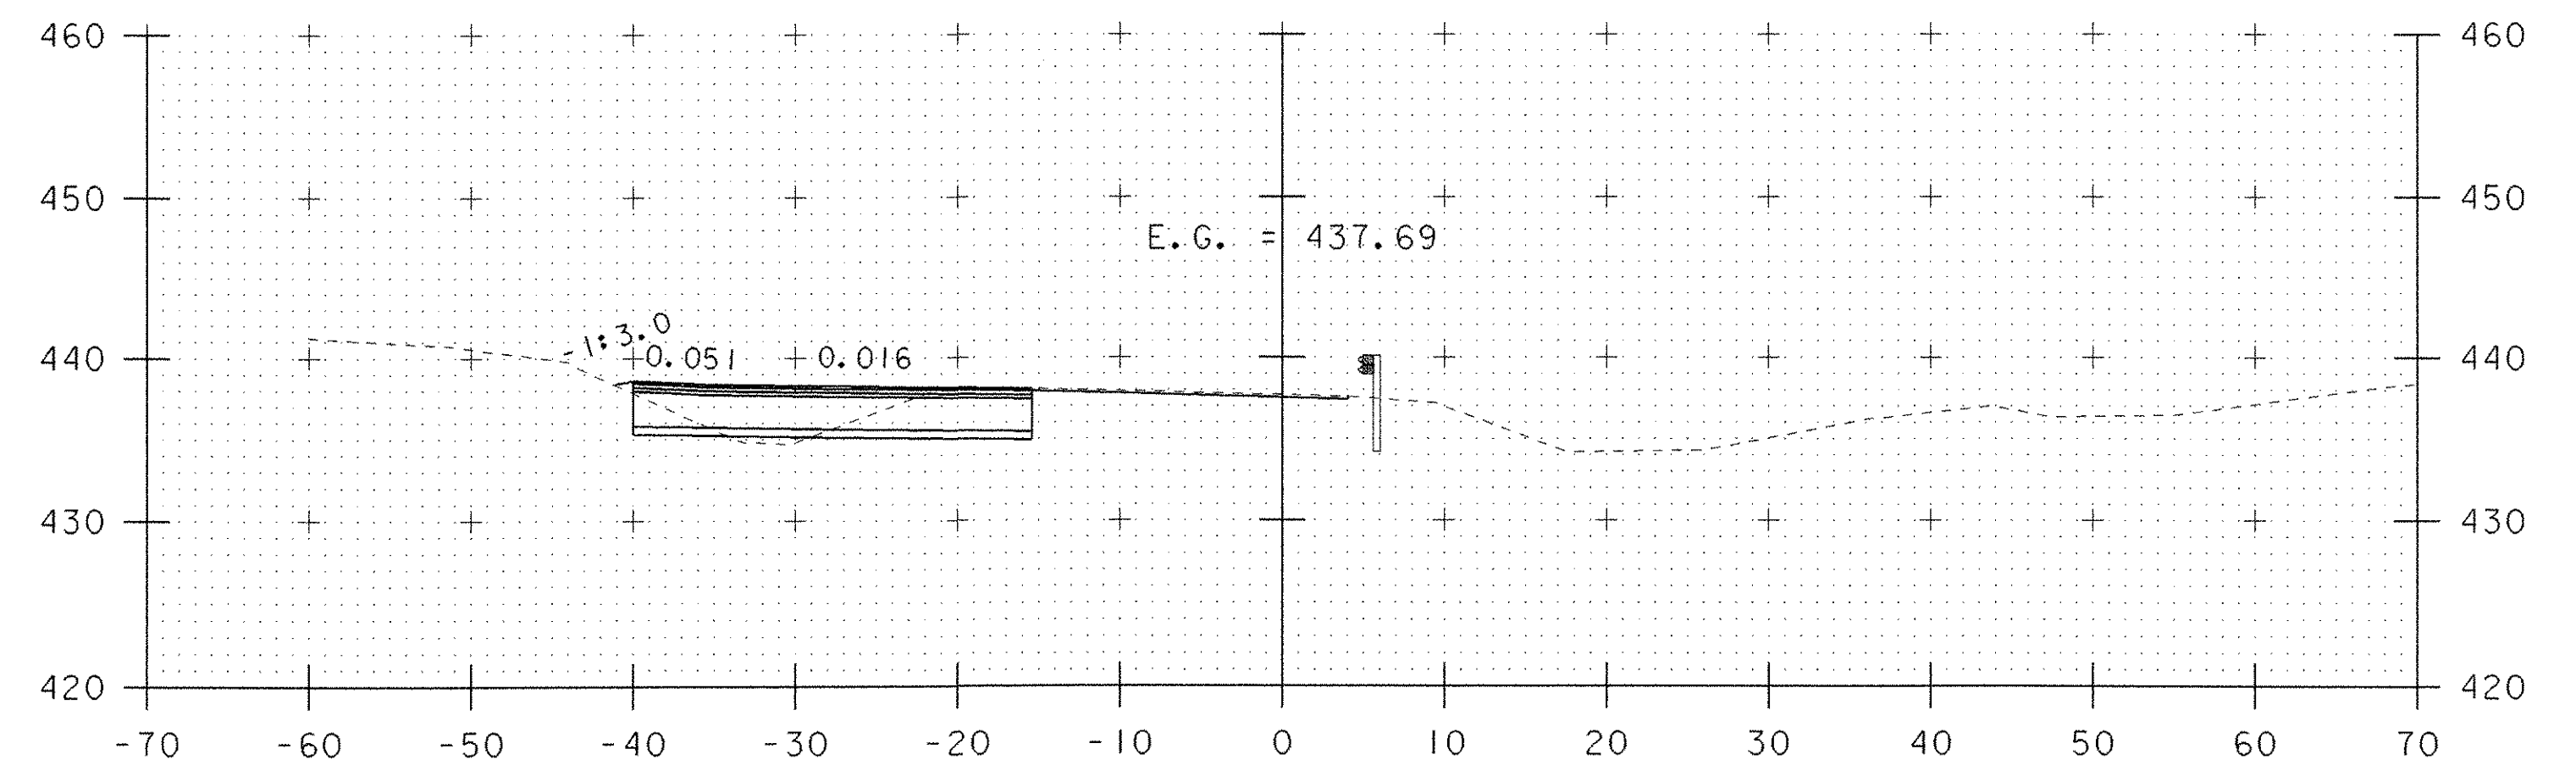

15+50

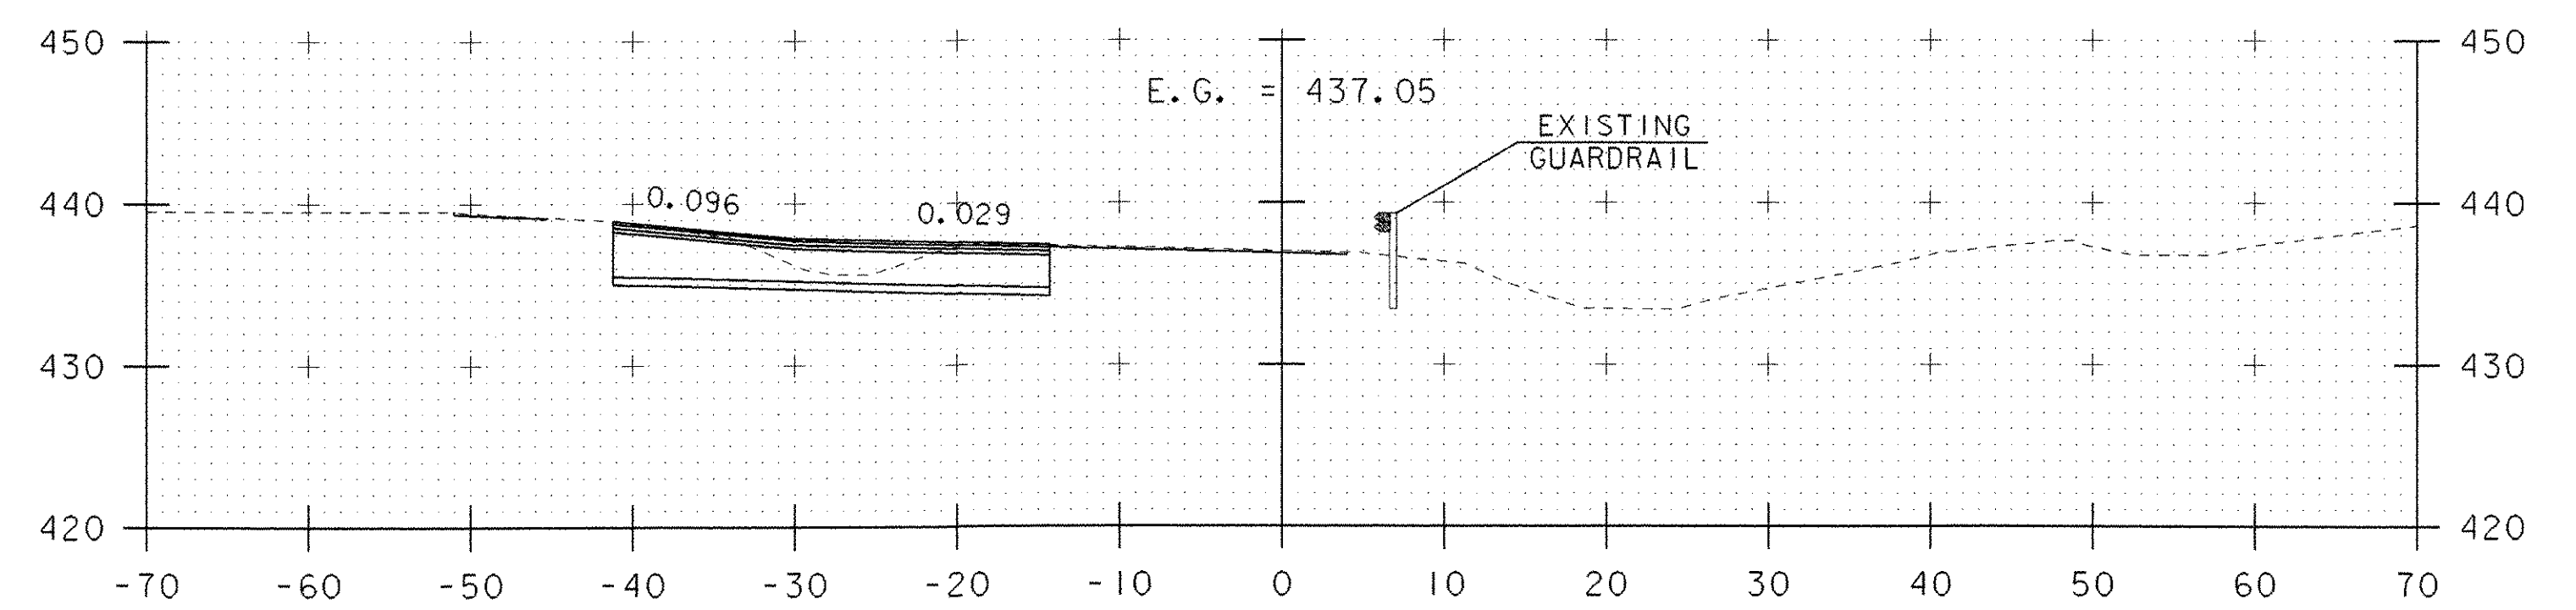


15+00

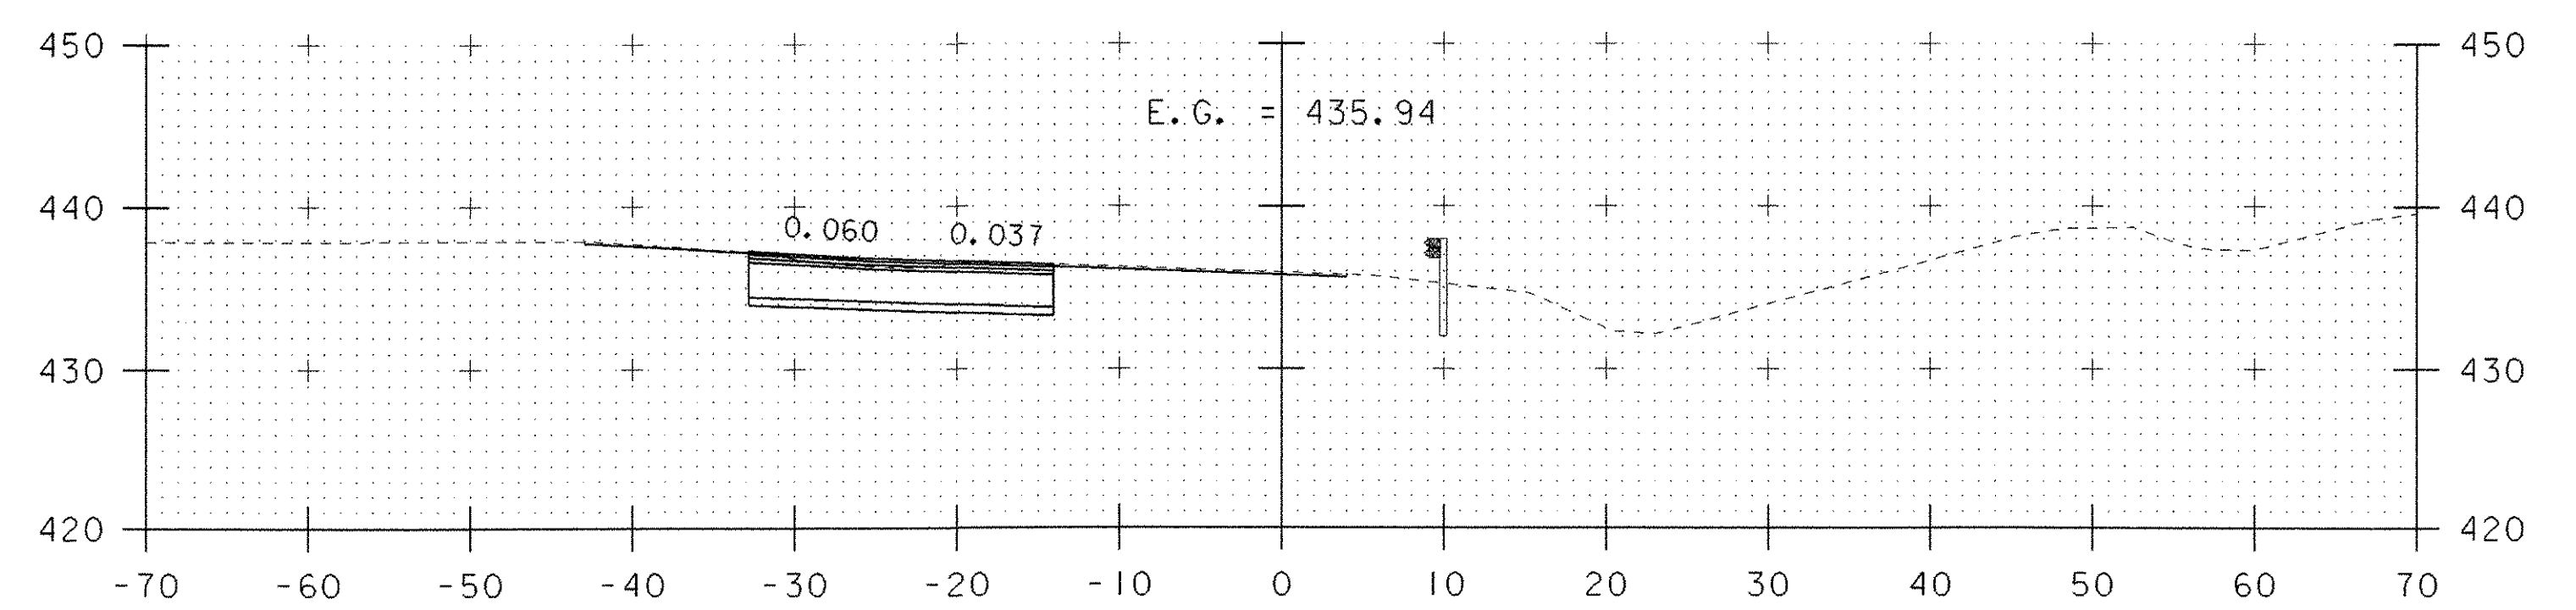

14+50







DATUM
 VERTICAL N/A
 HORIZONTAL N/A

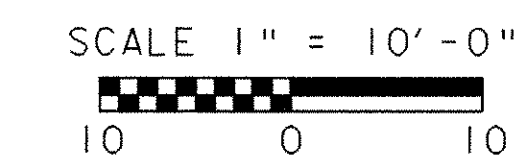


PROJECT NAME: I-89 EXIT 12 SB OFF RAMP
 PROJECT NUMBER: IM 089-2(35)

FILE NAME: 618800F4XS01.dgn
 PROJECT LEADER: EPD
 DESIGNED BY: JDA
 STA. 13+00 TO STA. 15+50

PLOT DATE: 17-MAY-2005
 DRAWN BY: JDA / PGJ
 CHECKED BY: EPD
 SHEET 74 OF 76

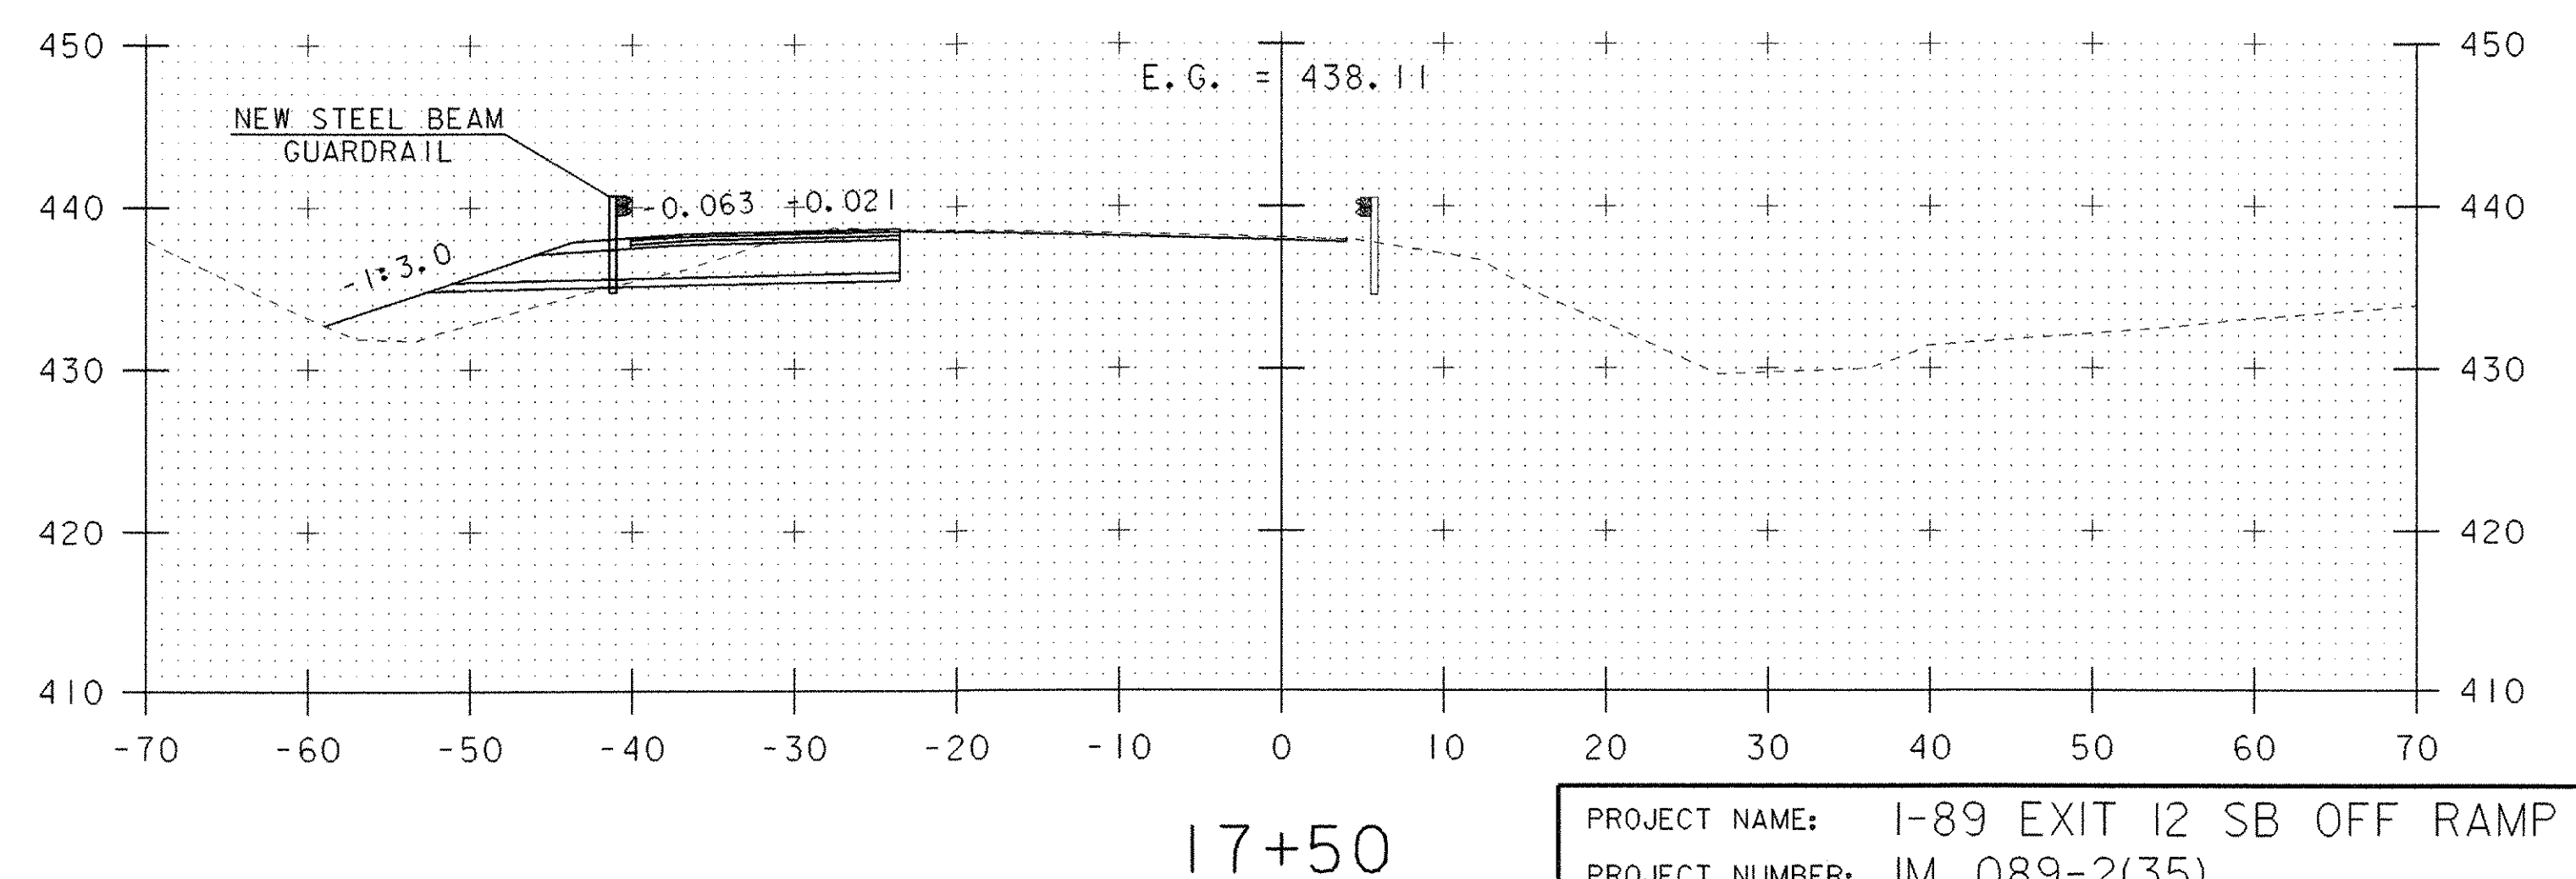
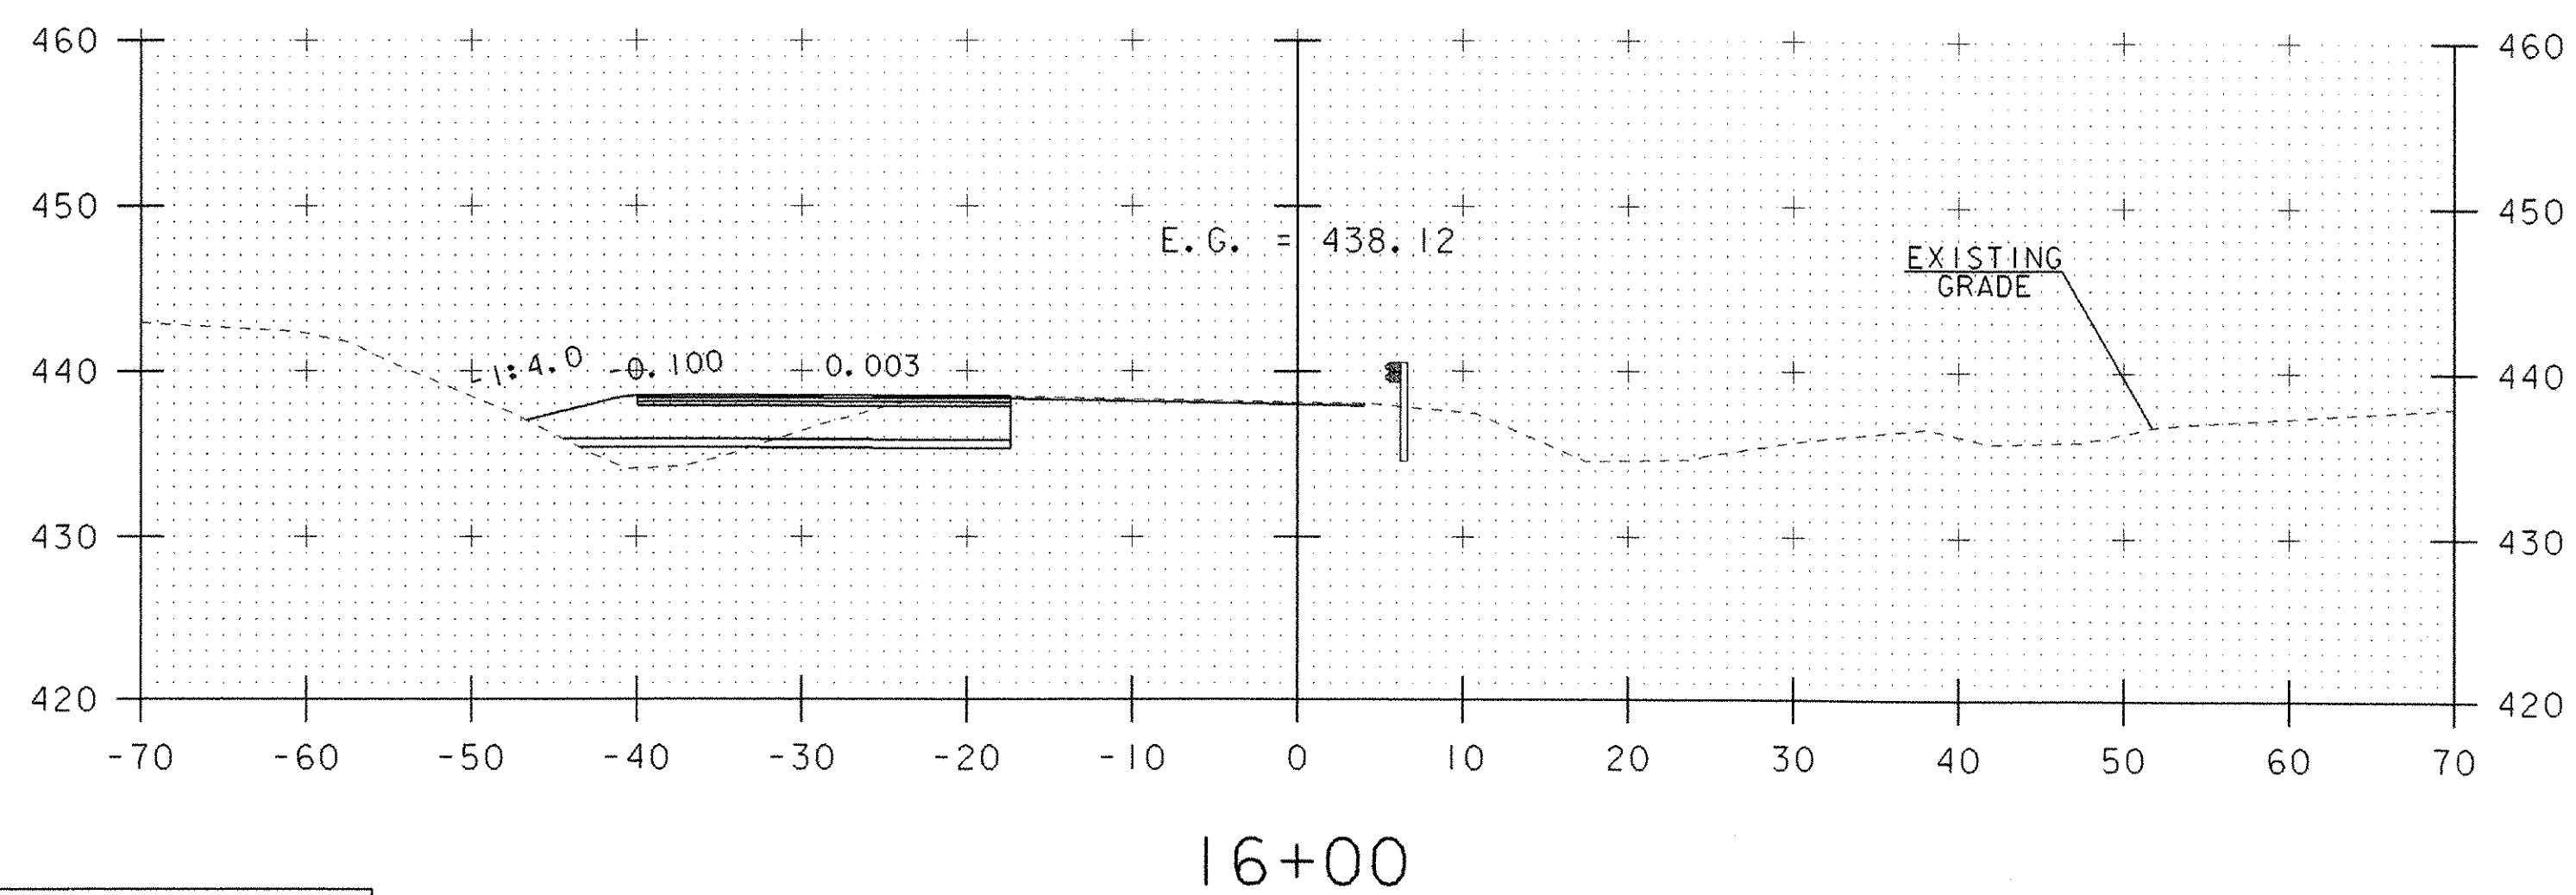
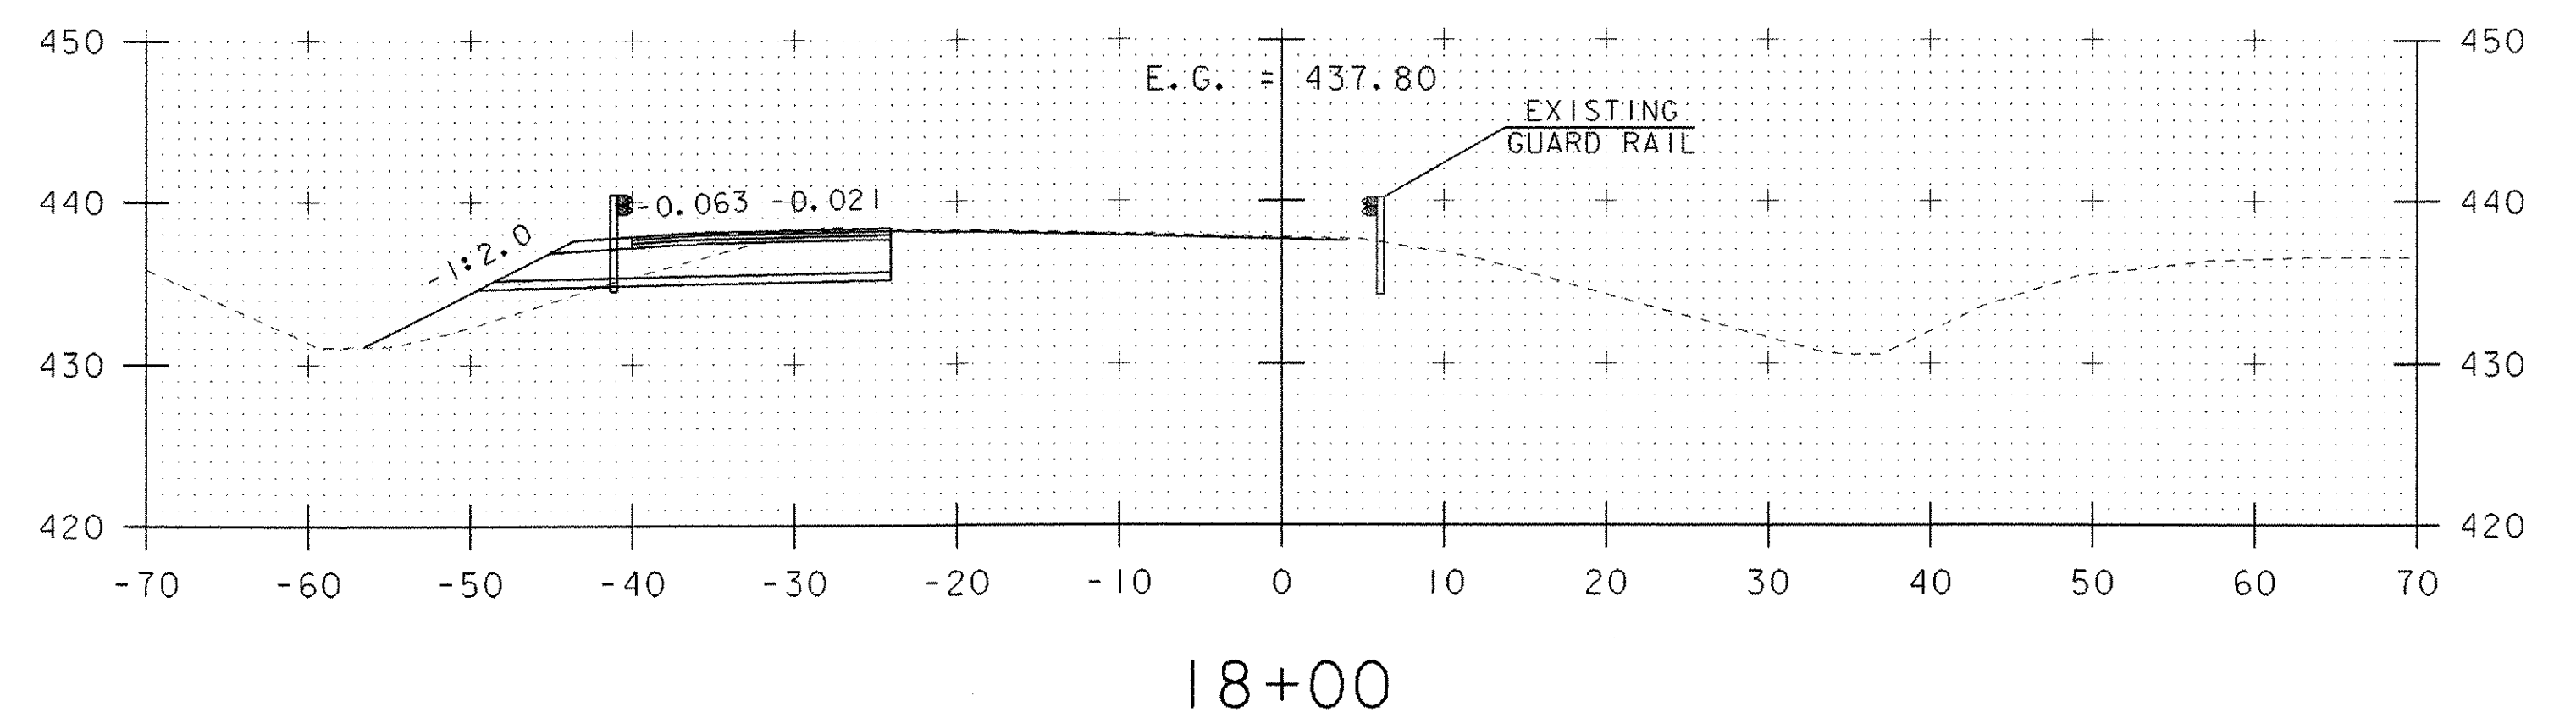
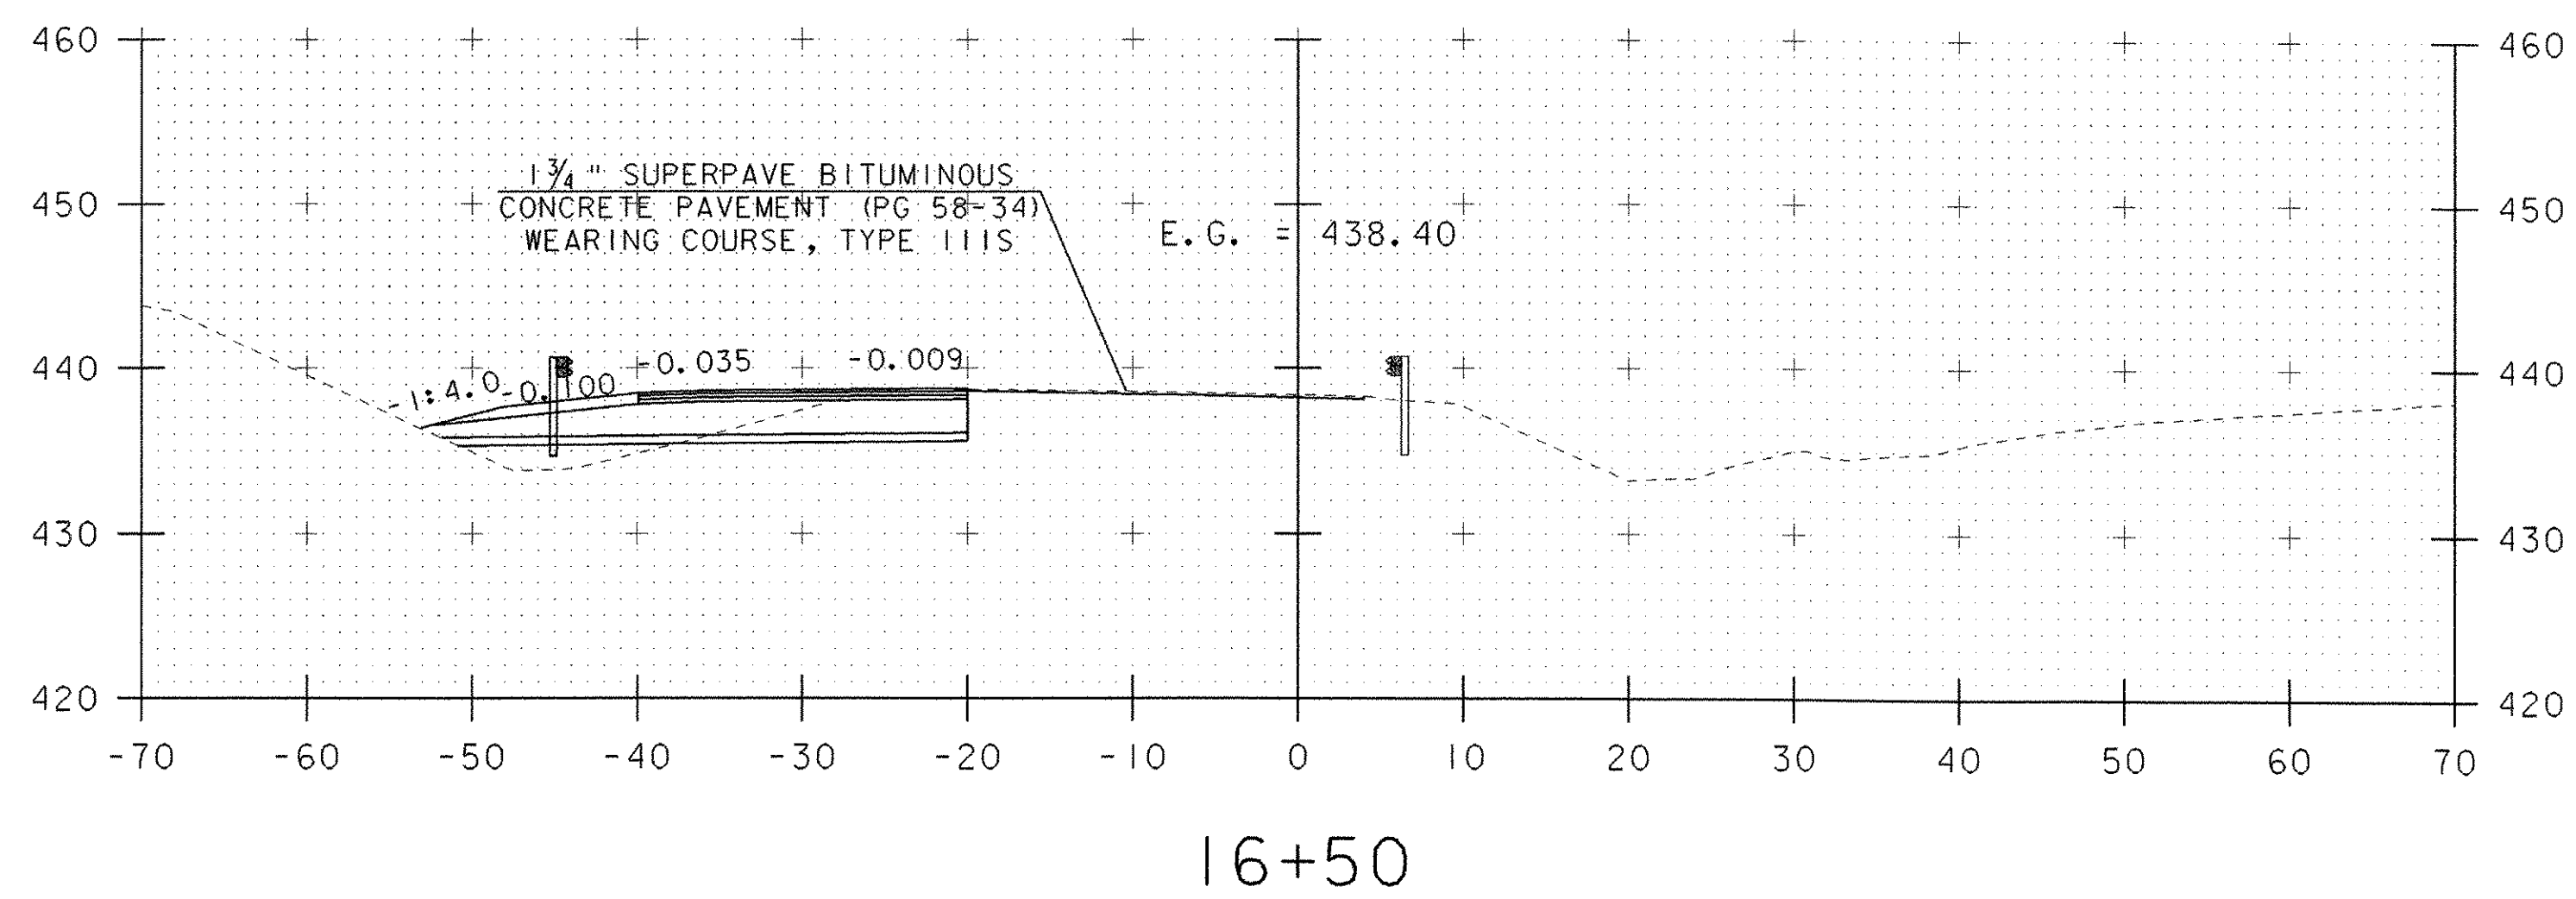
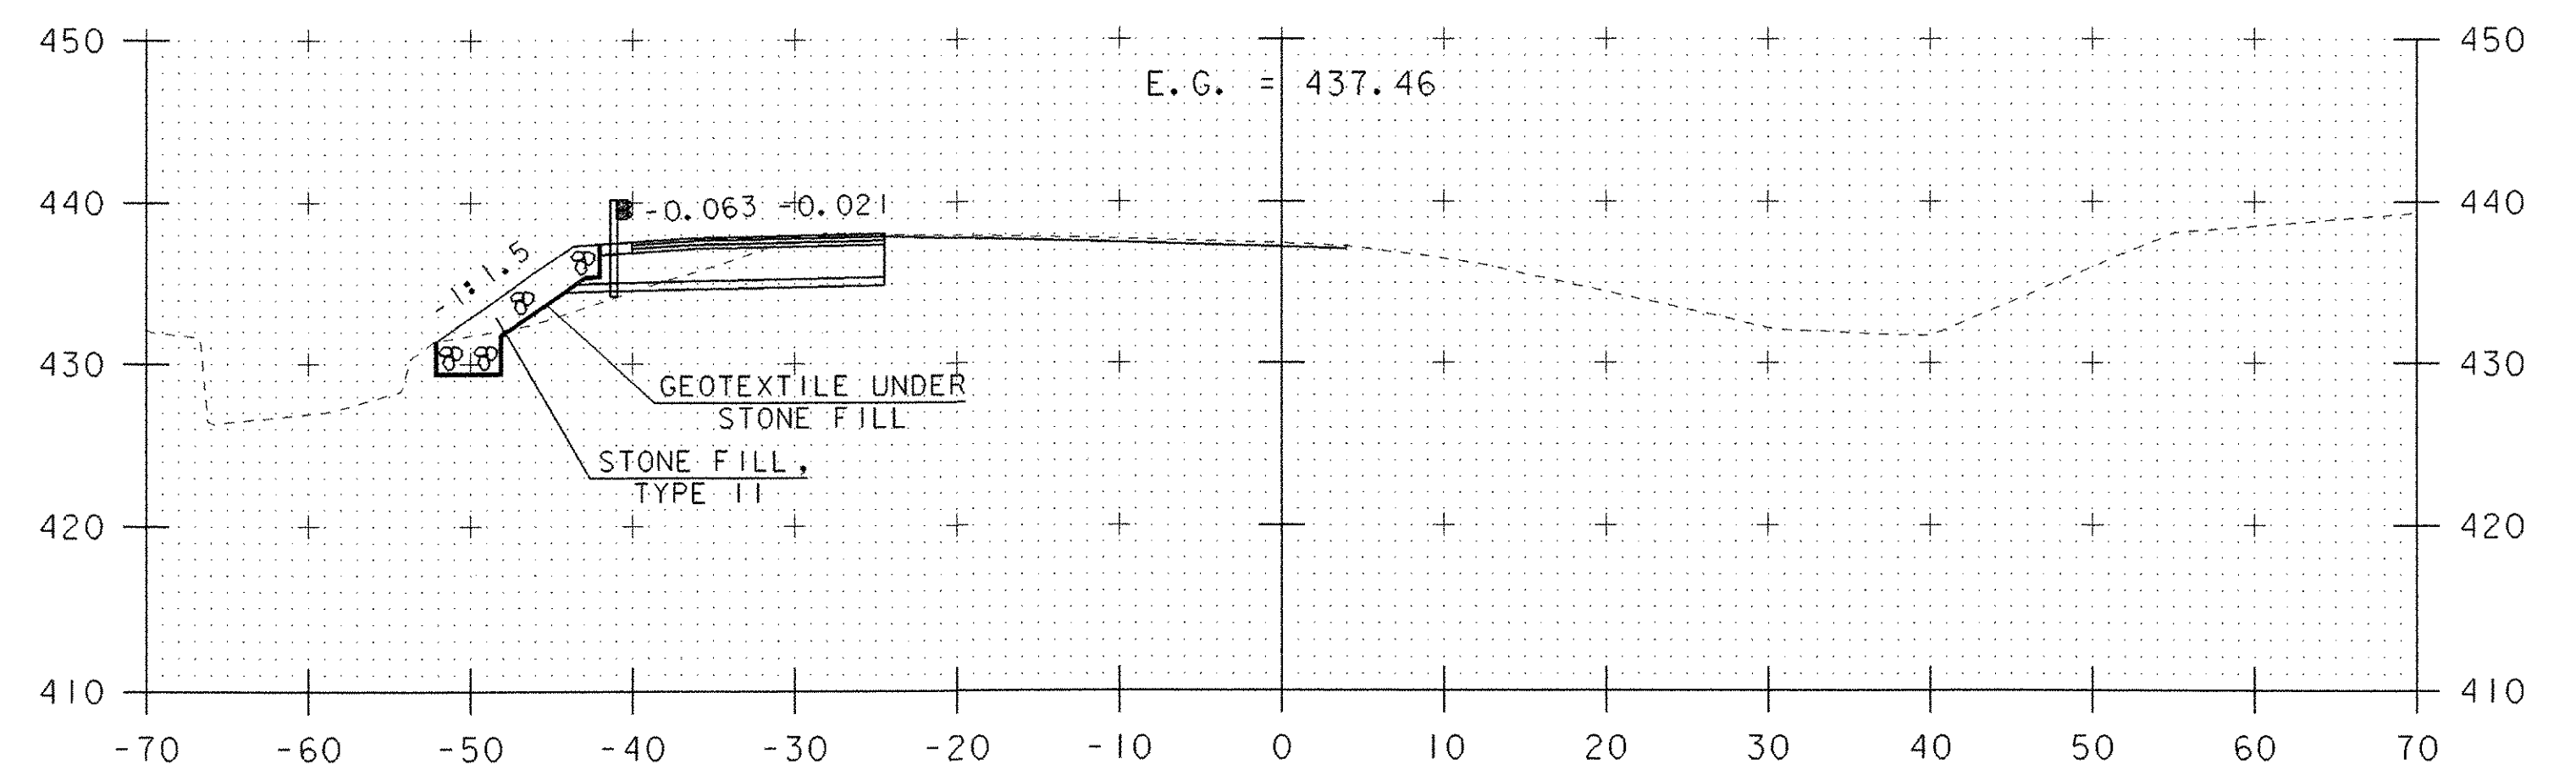
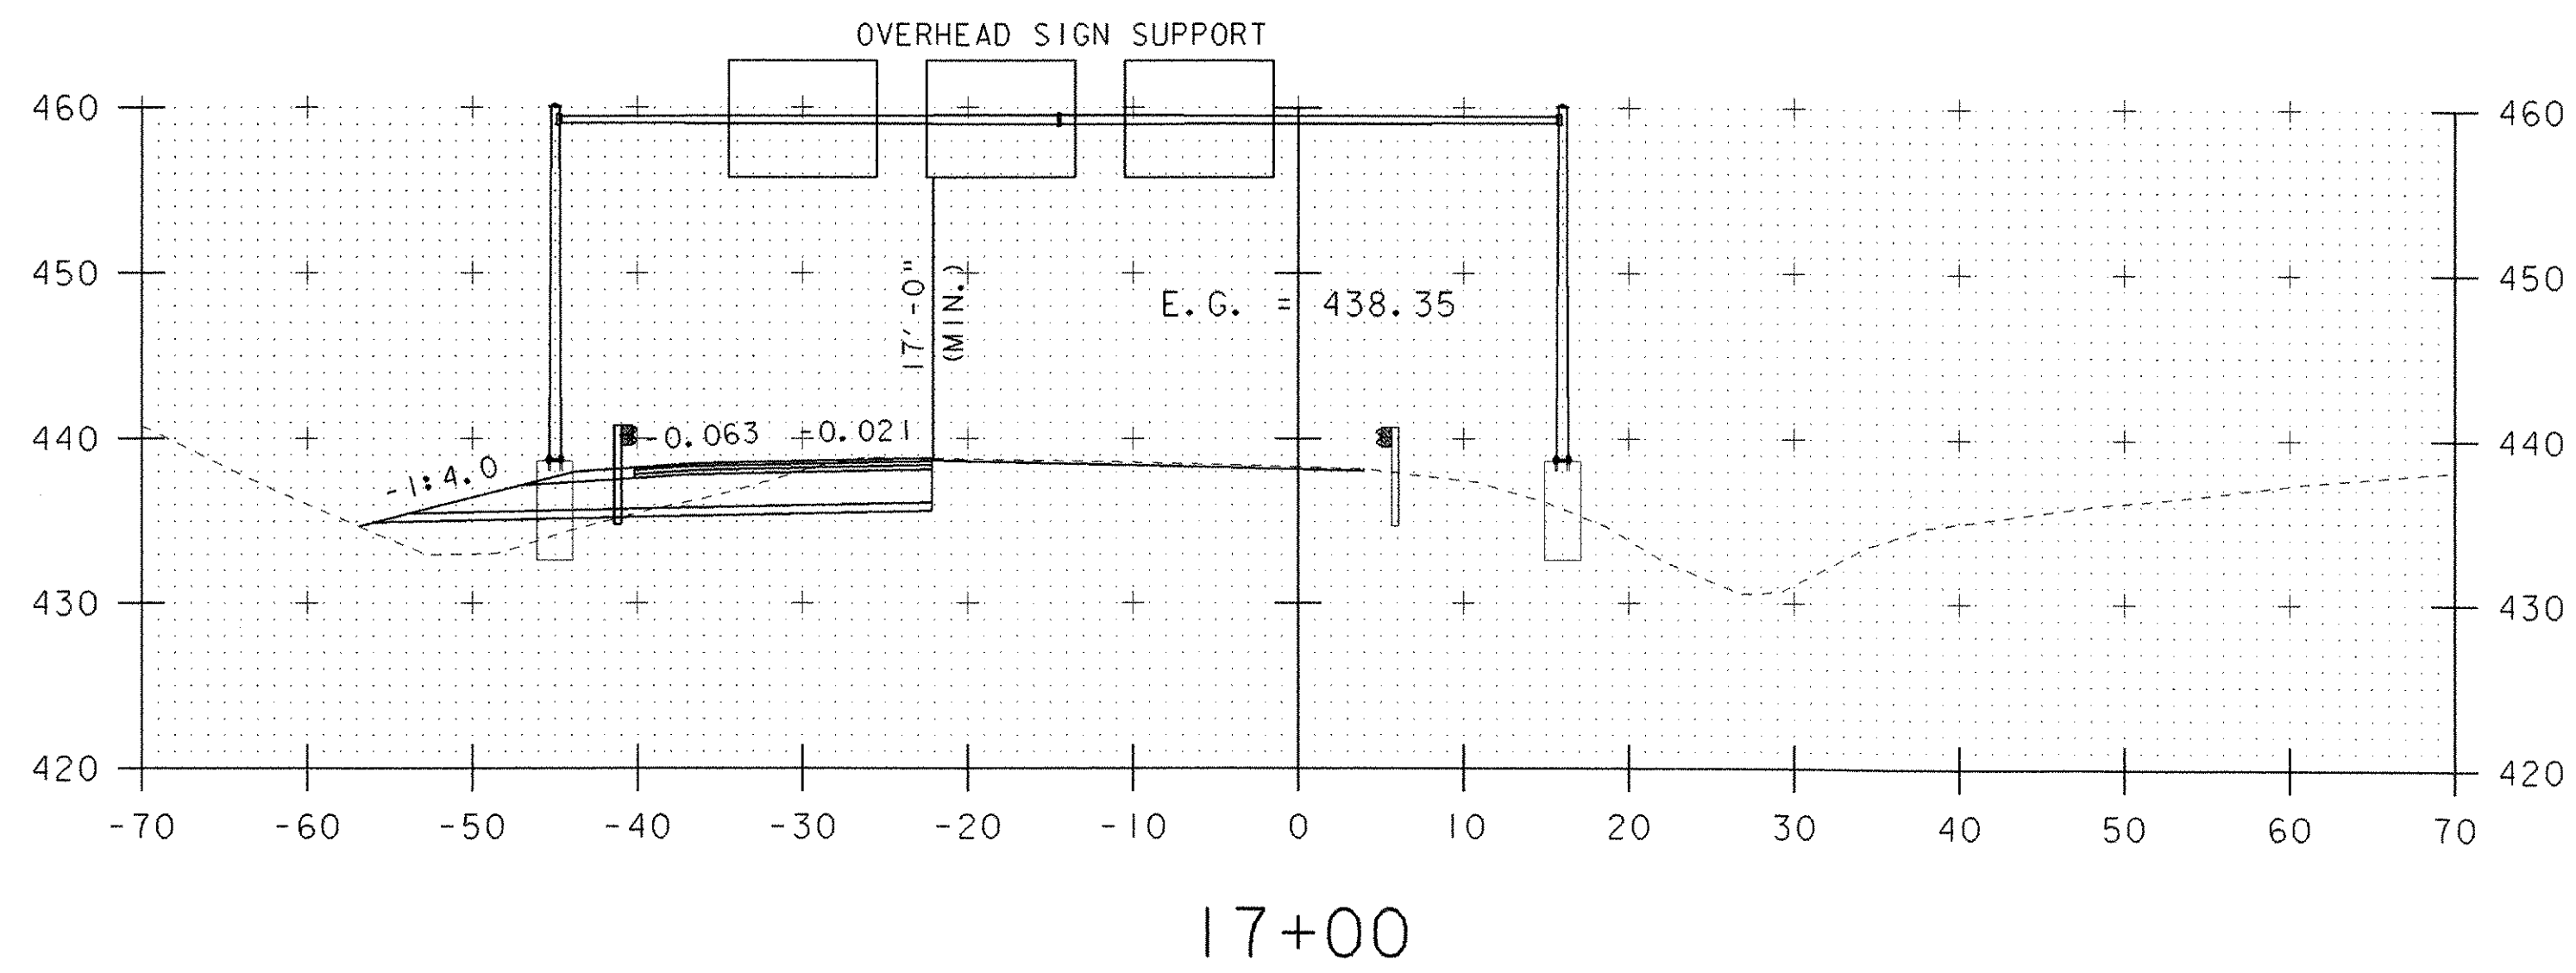


| | |
|------------|-----|
| DATUM | |
| VERTICAL | N/A |
| HORIZONTAL | N/A |

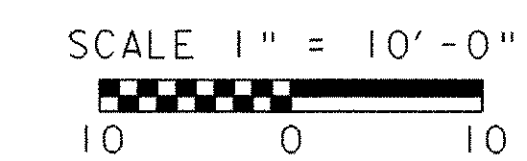


PROJECT NAME: I-89 EXIT 12 SB OFF RAMP
PROJECT NUMBER: IM 089-2(35)

| | |
|-----------------------------|------------------------|
| FILE NAME: 618800F4XS01.dgn | PLOT DATE: 17-MAY-2005 |
| PROJECT LEADER: EPD | DRAWN BY: JDA / PGJ |
| DESIGNED BY: JDA | CHECKED BY: EPD |
| STA. 16+00 TO STA. 18+50 | SHEET 75 OF 76 |

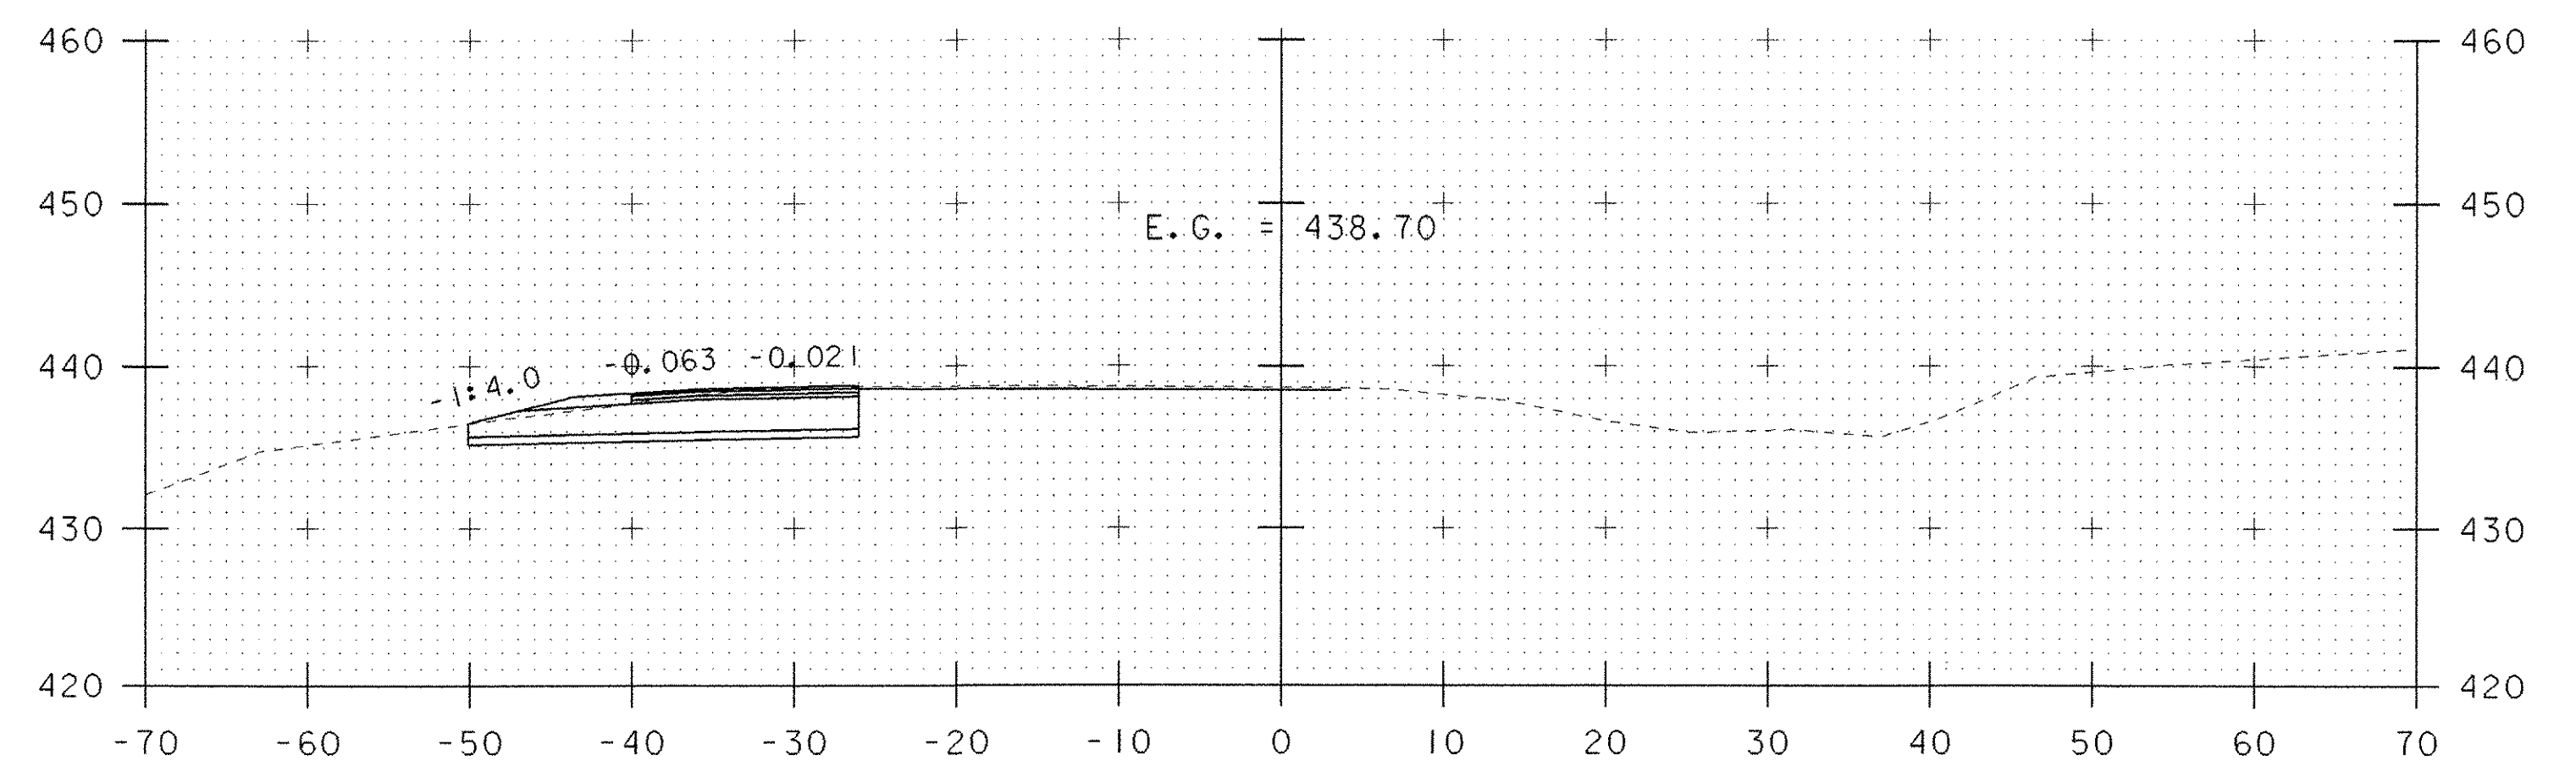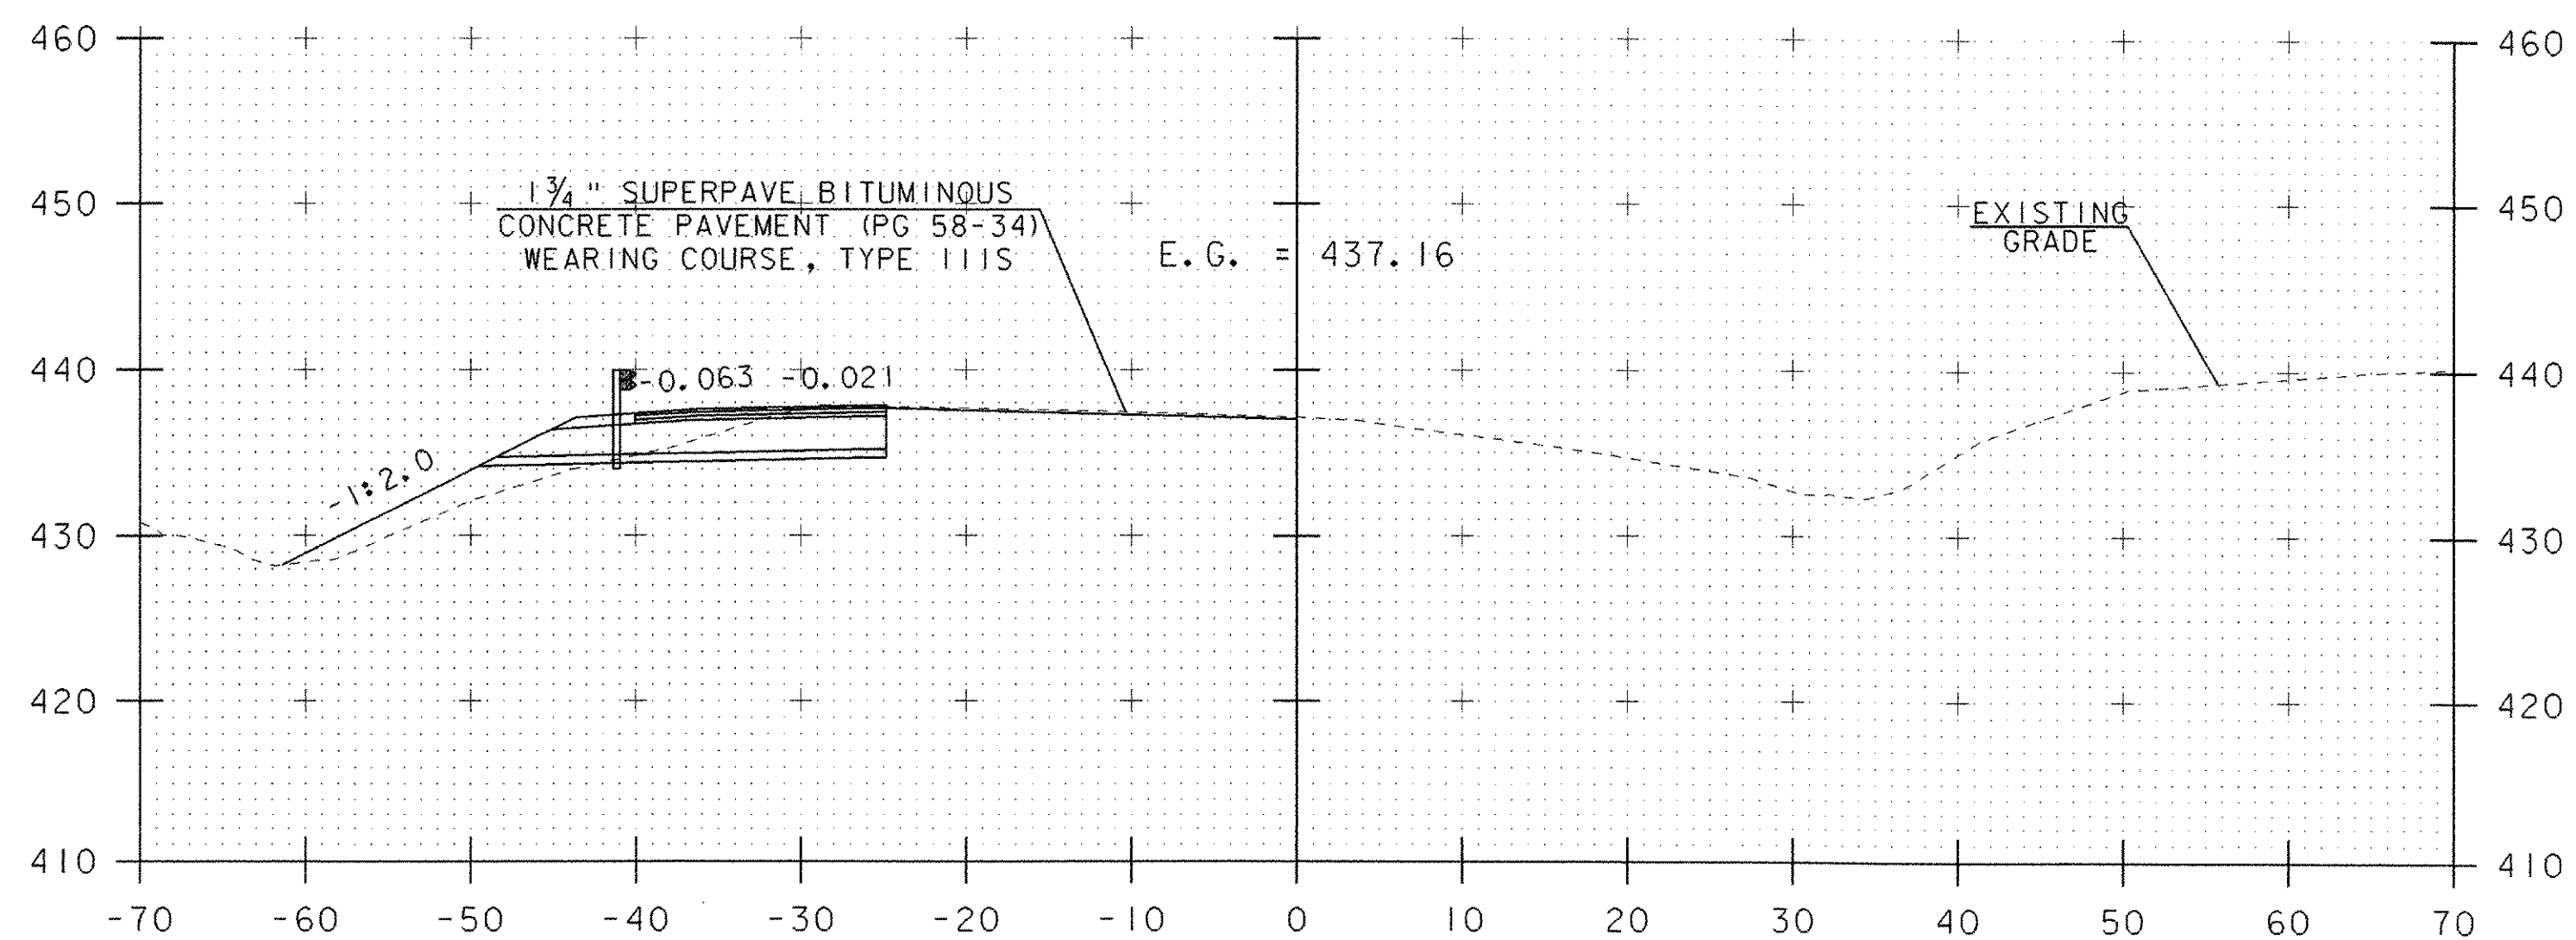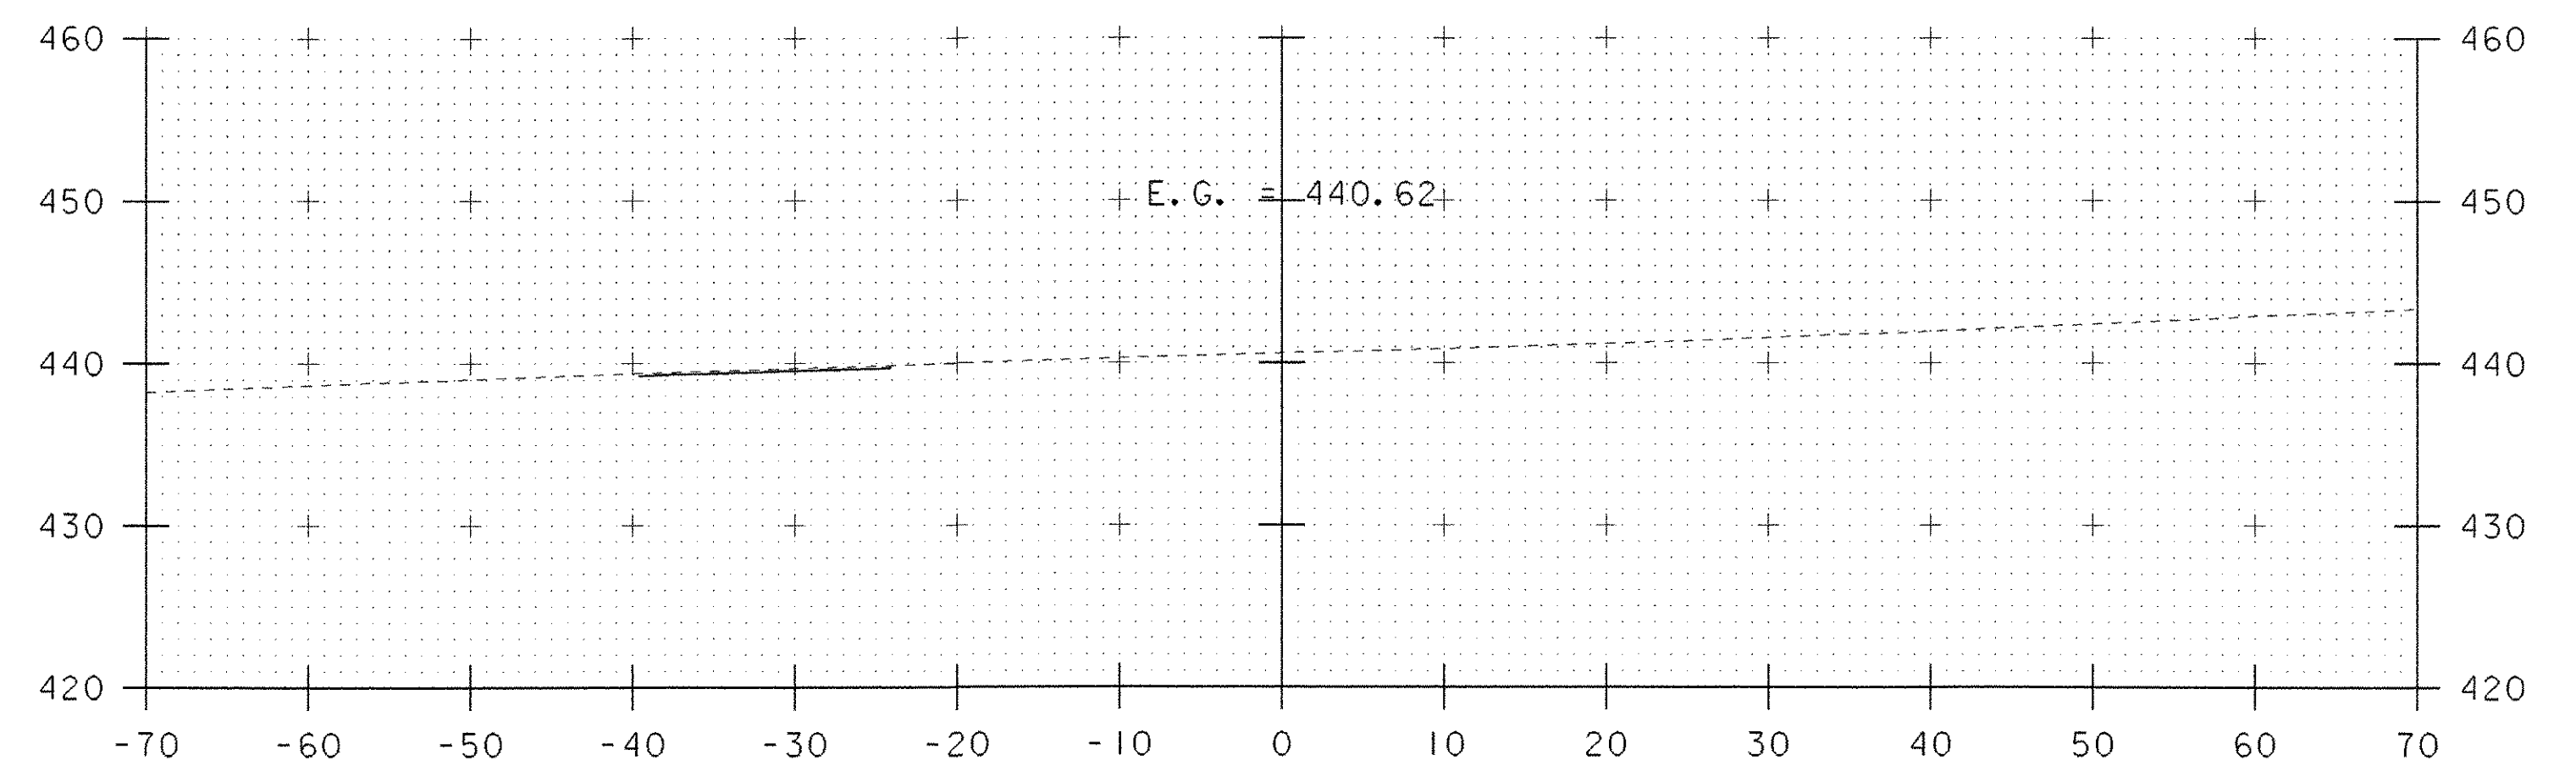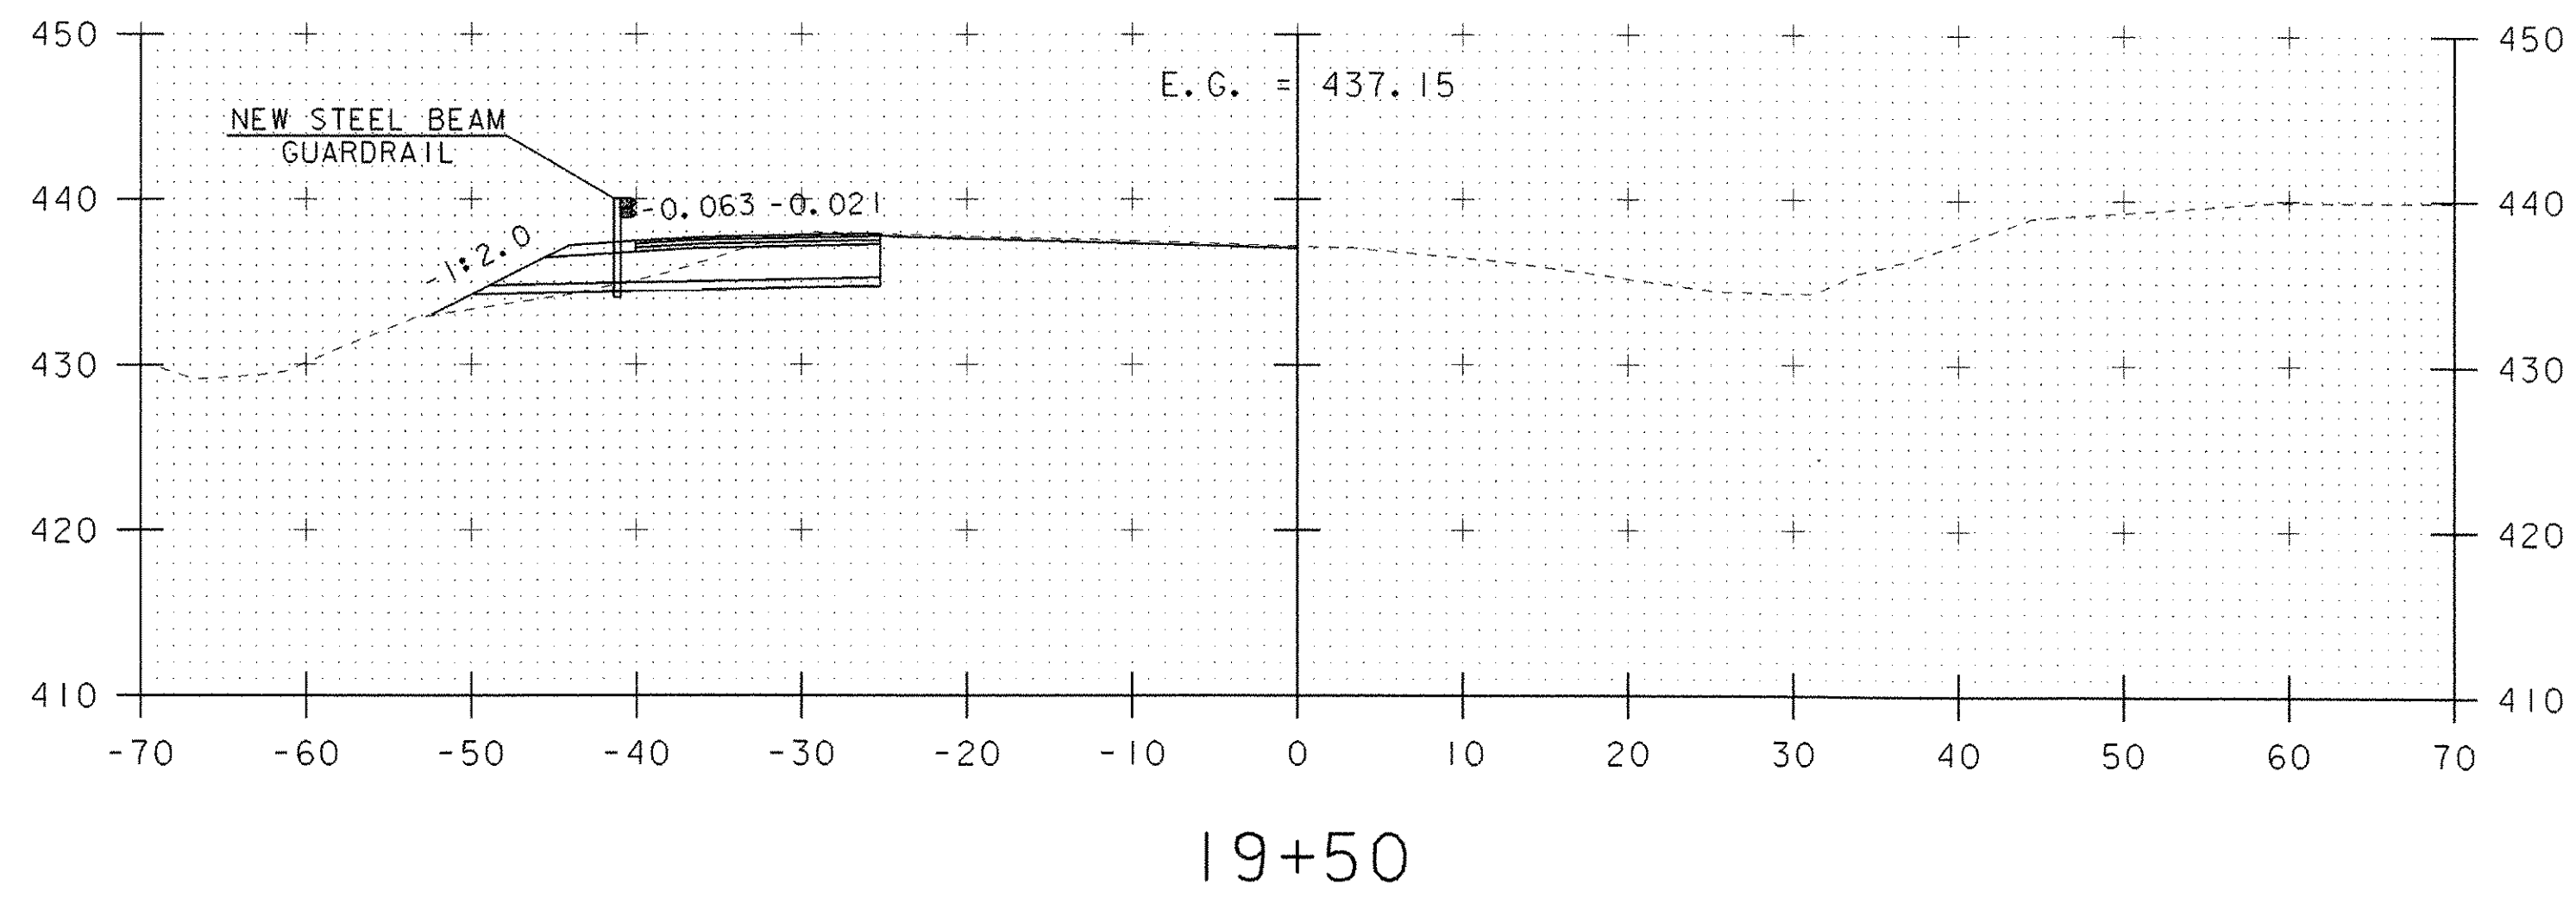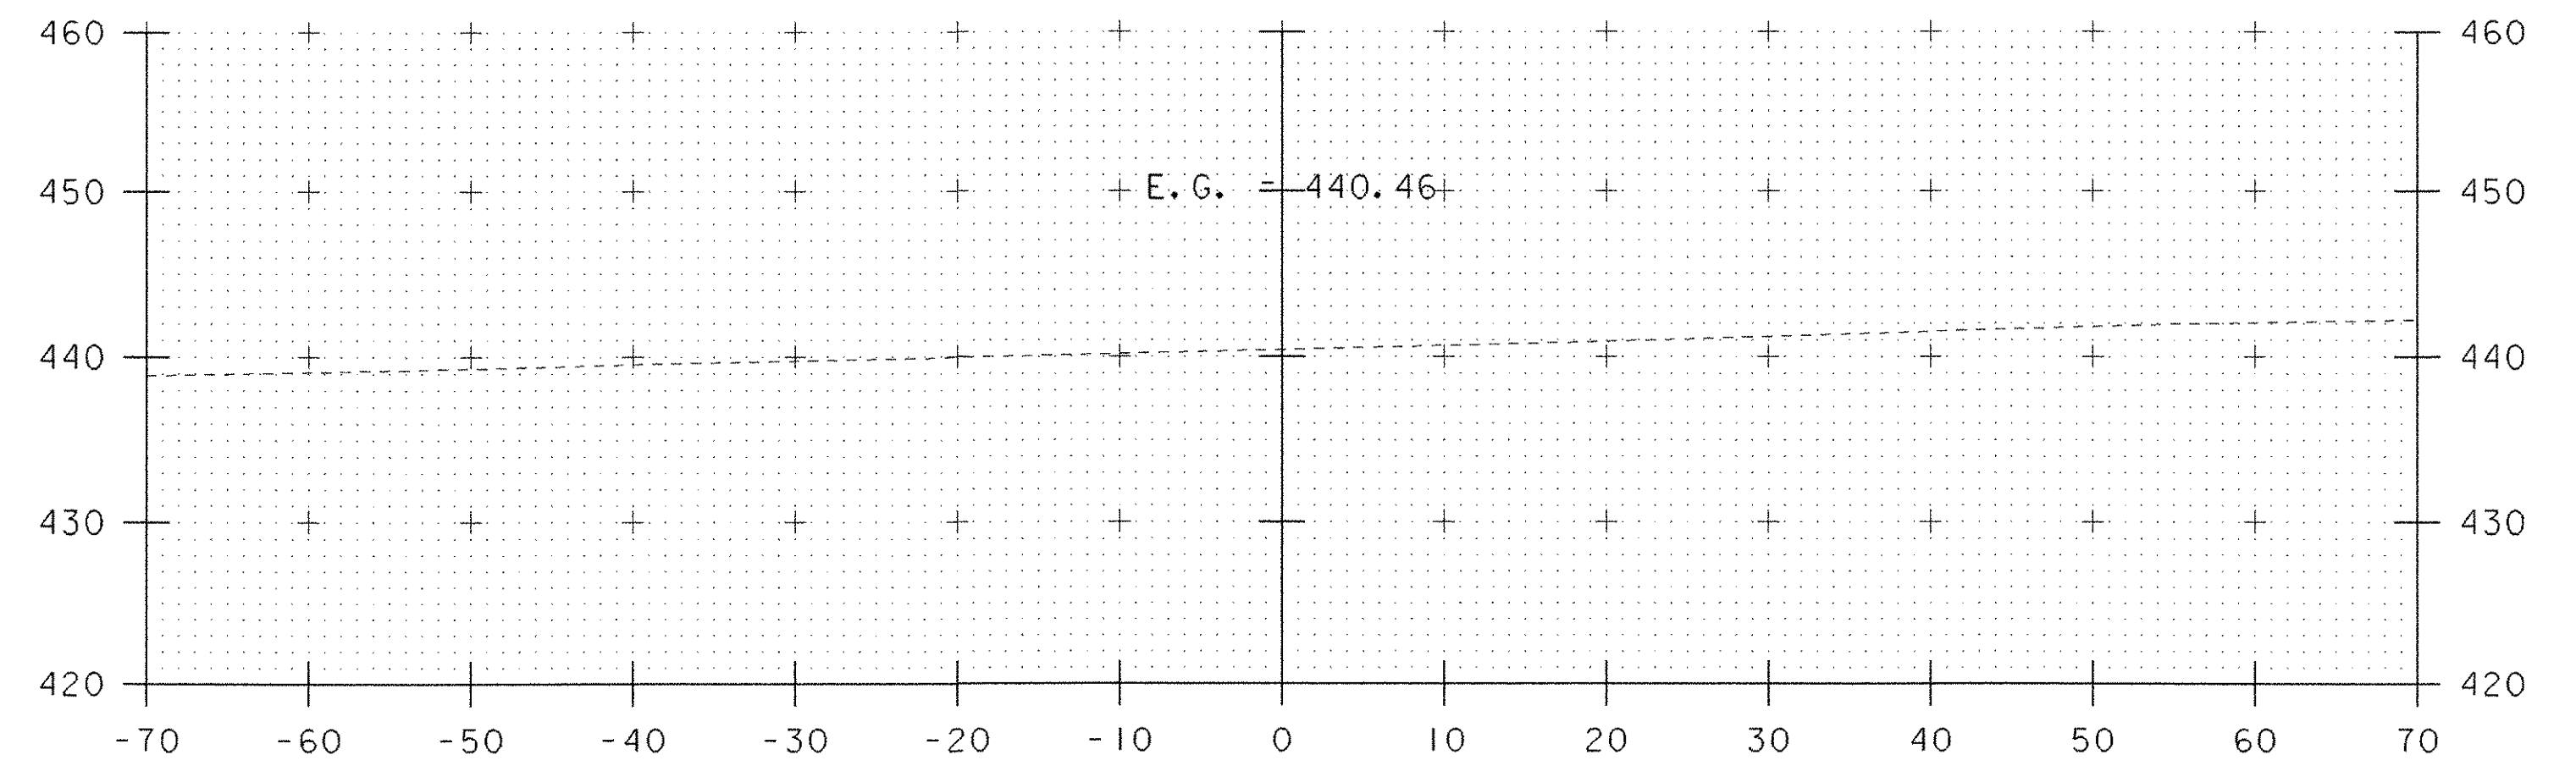
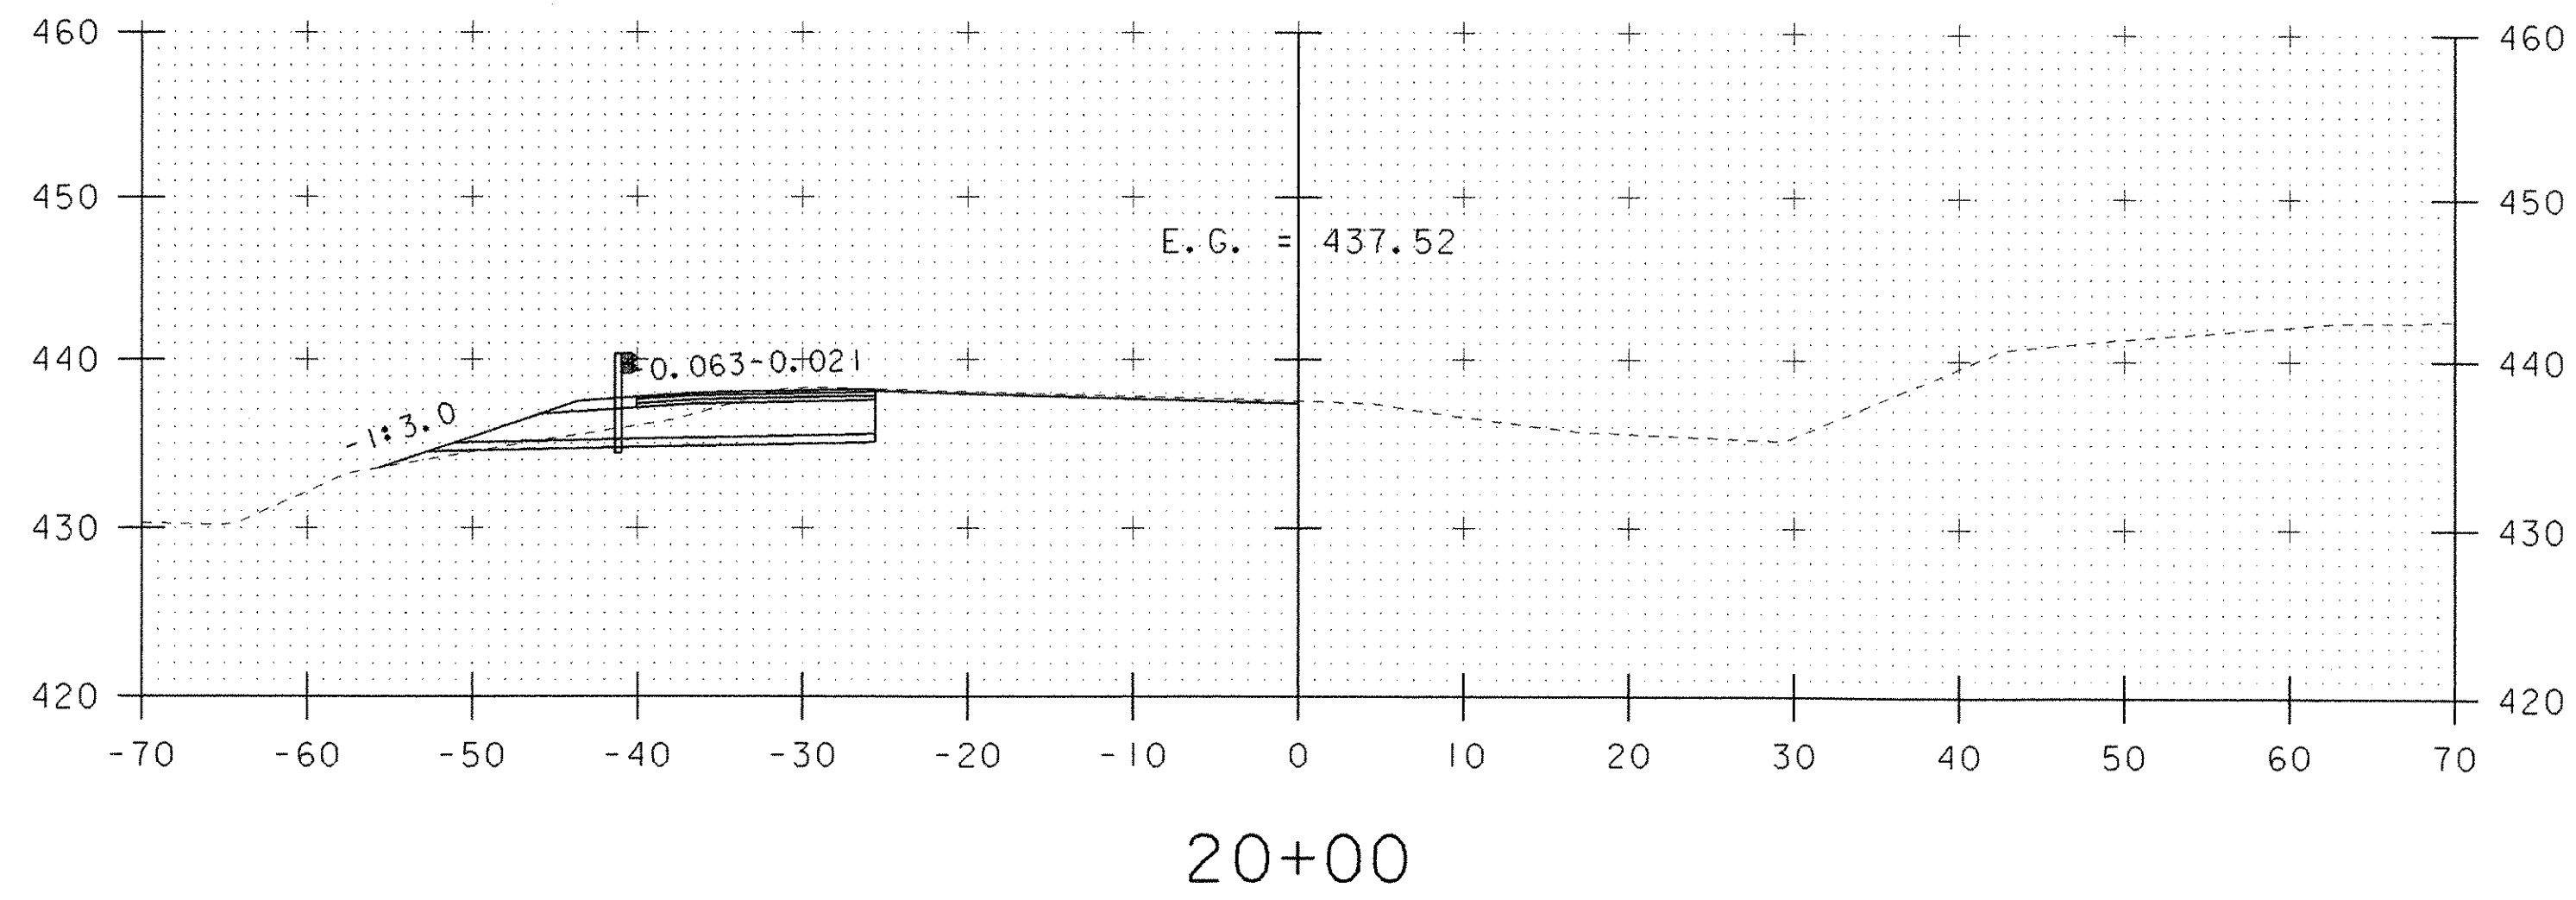


| | |
|------------|-----|
| DATUM | |
| VERTICAL | N/A |
| HORIZONTAL | N/A |

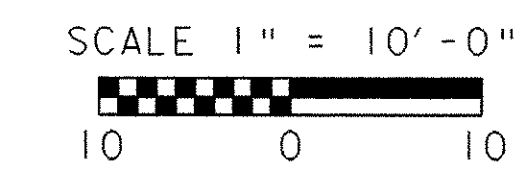

PROJECT NAME: I-89 EXIT 12 SB OFF RAMP
PROJECT NUMBER: IM 089-2(35)


| | |
|-----------------------------|------------------------|
| FILE NAME: 618800F4XS01.dgn | PLOT DATE: 17-MAY-2005 |
| PROJECT LEADER: EPD | DRAWN BY: JDA / PGJ |
| DESIGNED BY: JDA | CHECKED BY: EPD |
| STA. 19+00 TO STA. 21+43 | SHEET 76 OF 76 |

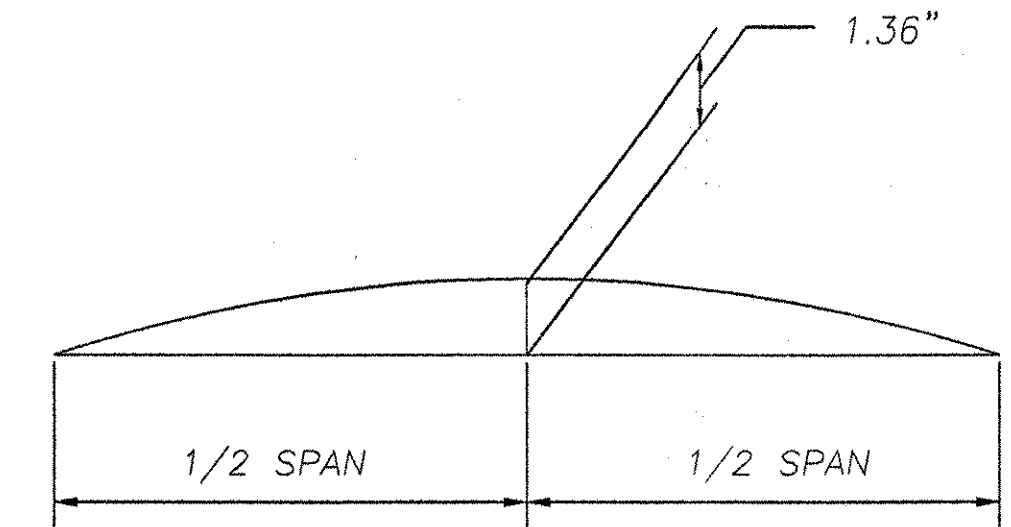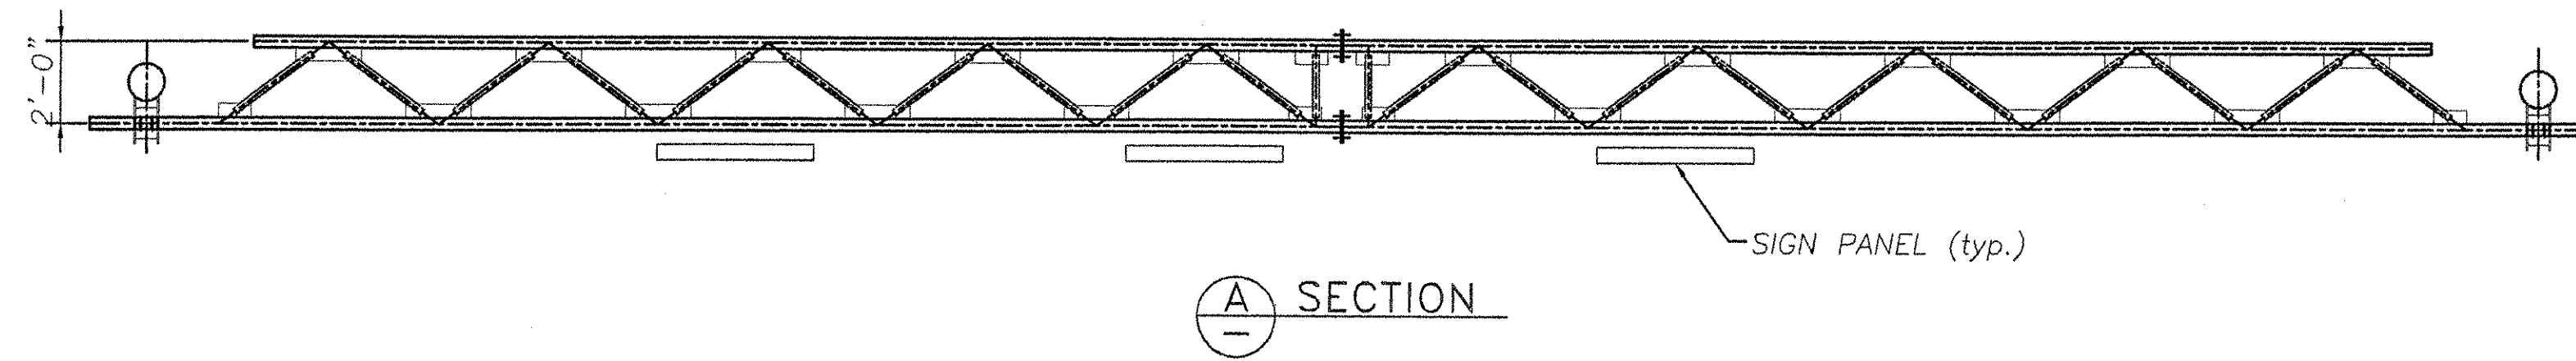

CAMBER DIAGRAM


NOTE:

CAMBER WILL BE ACHIEVED BY SHORTENING LOWER CHORD PIPES BY AN AMOUNT SUCH THAT POSITIVE UPWARD DEFLECTION IS PRODUCED WHEN TRUSSES ARE BROUGHT TOGETHER AT SPLICES.

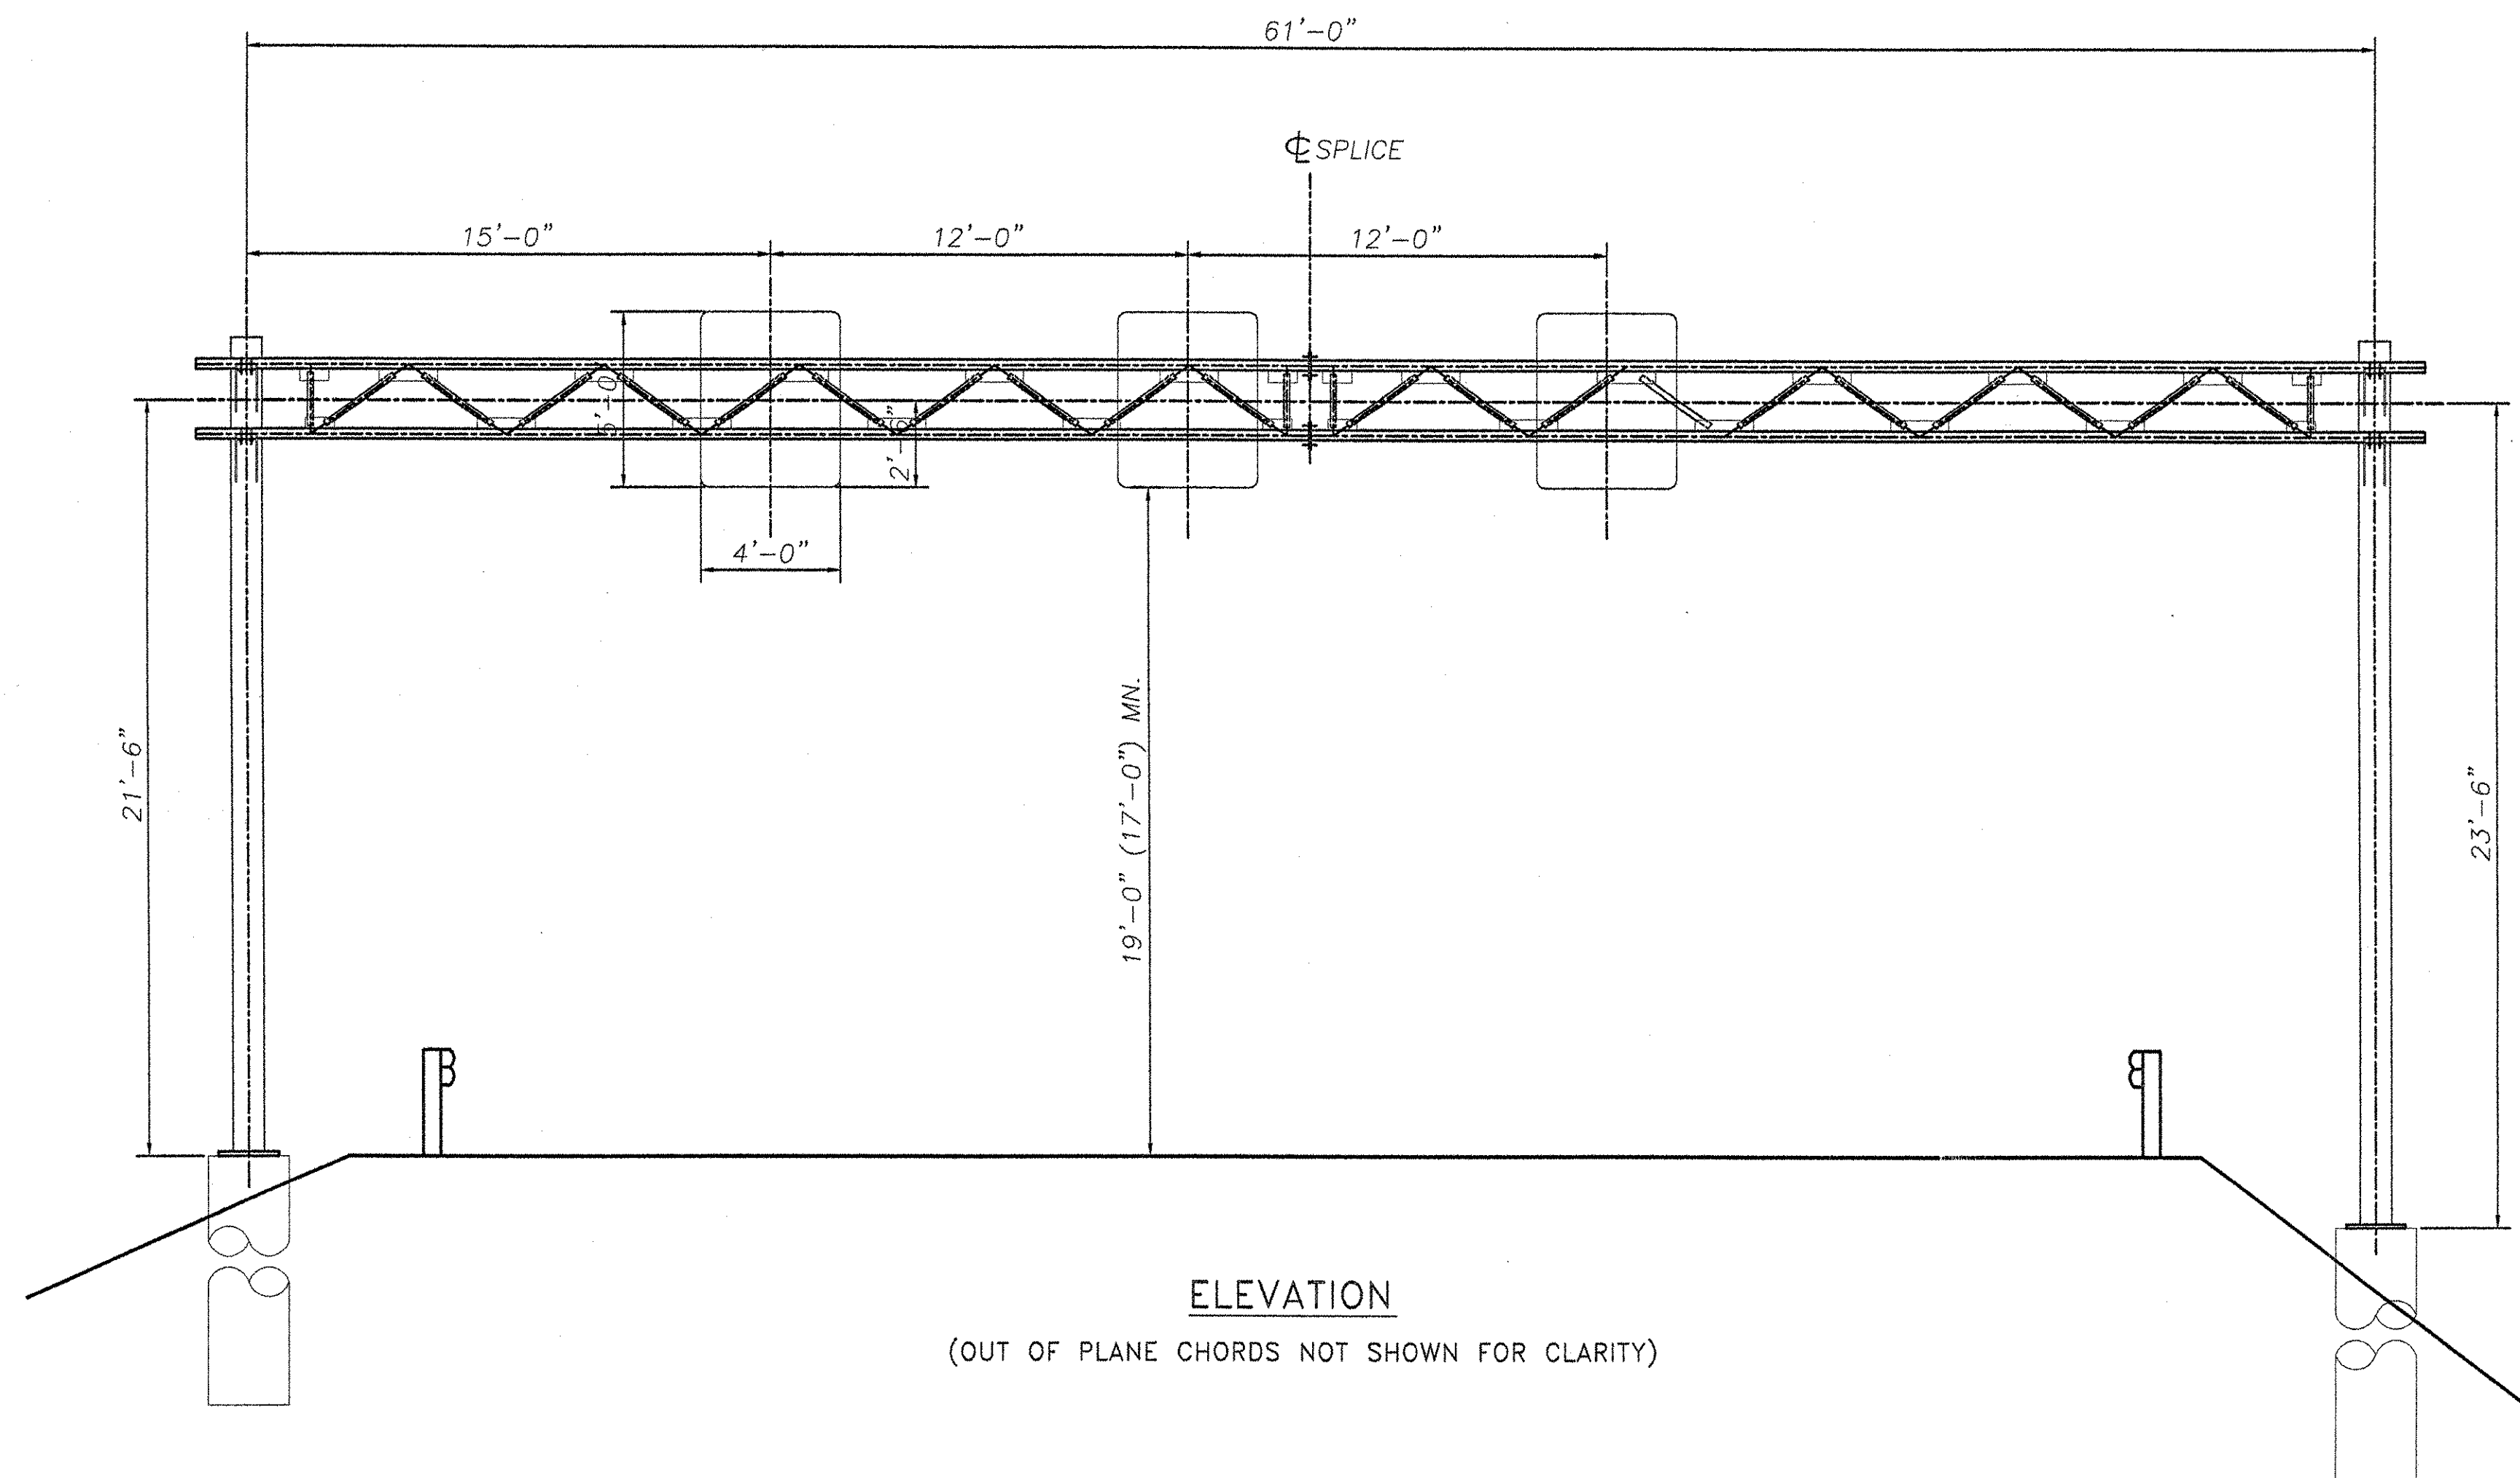

ELEVATION

(OUT OF PLANE CHORDS NOT SHOWN FOR CLARITY)

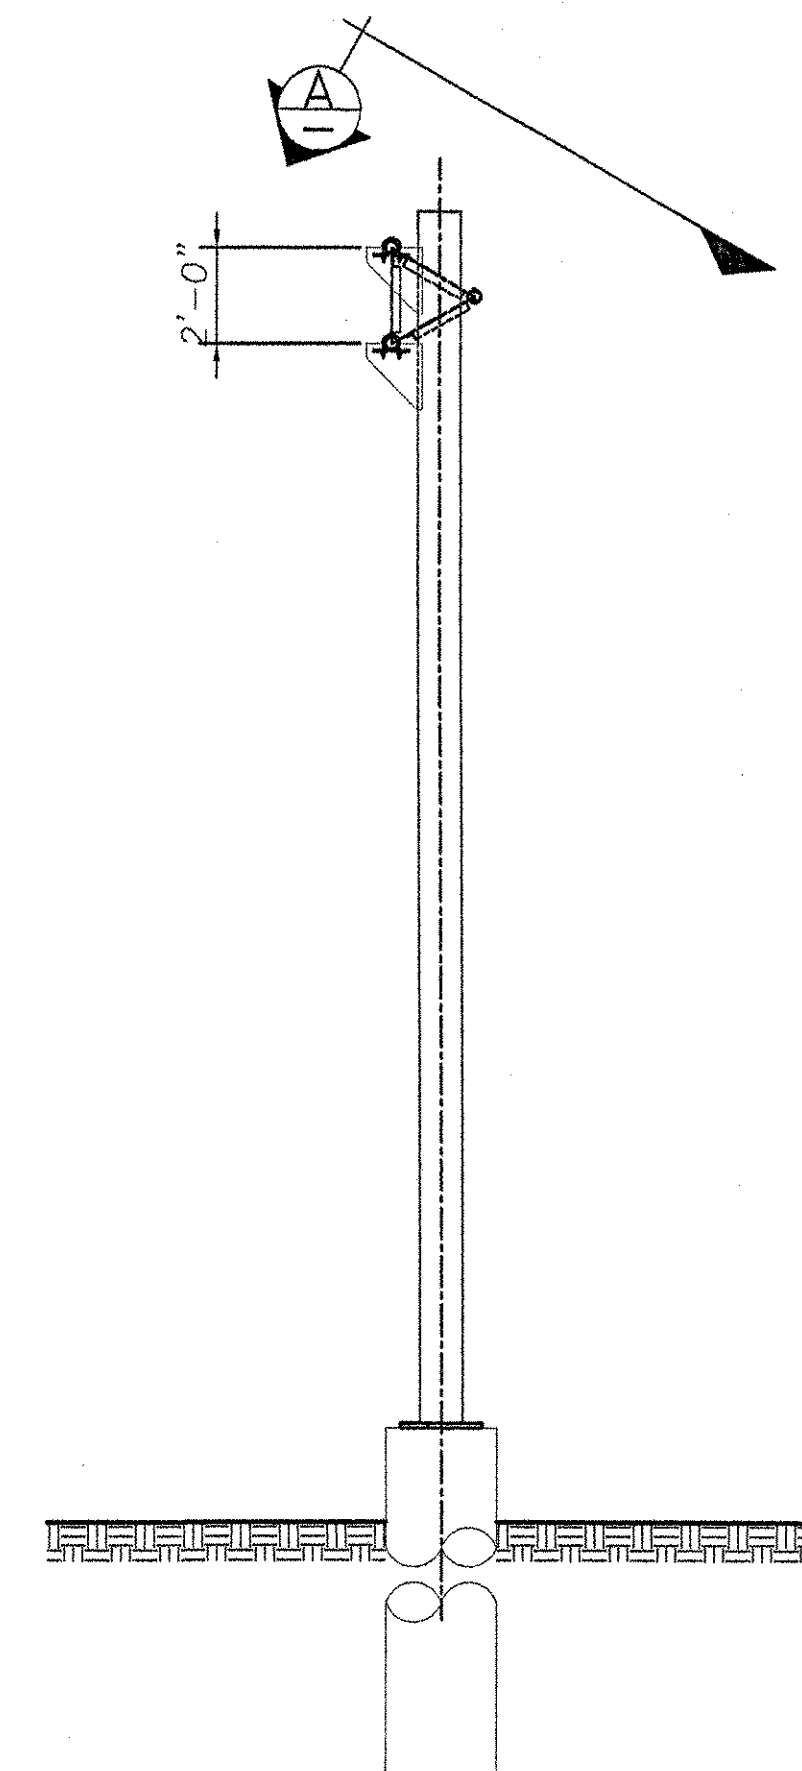








| REVISIONS | | |
|-----------|-------------------|---------|
| No. | Remarks | Date |
| 0 | Initial submittal | 7-19-05 |
| | | |
| | | |



HIGHWAY SAFETY CORP.
GLASTONBURY, CT

| | | |
|--------------------|--|-------------------|
| GENERAL CONTRACTOR | TRI-CHORD SIGN STRUCTURE I-89 EXIT 12 SB OFF RAMP CHITTENDEN COUNTY, VERMONT PROJECT No. IM 089-2(35) | DRAWN MHH |
| CHECKED | | |
| DATE | 7/8/05 | |
| SCALE | N.T.S. | |
| HSO REFERENCE NO. | | 1515 |
| GENERAL CONTRACTOR | | SIZE D REVISION 0 |
| SUB CONTRACTOR | F.R. LAFAYETTE | SHEET NO. 1 of 8 |

F.R. Lafayette

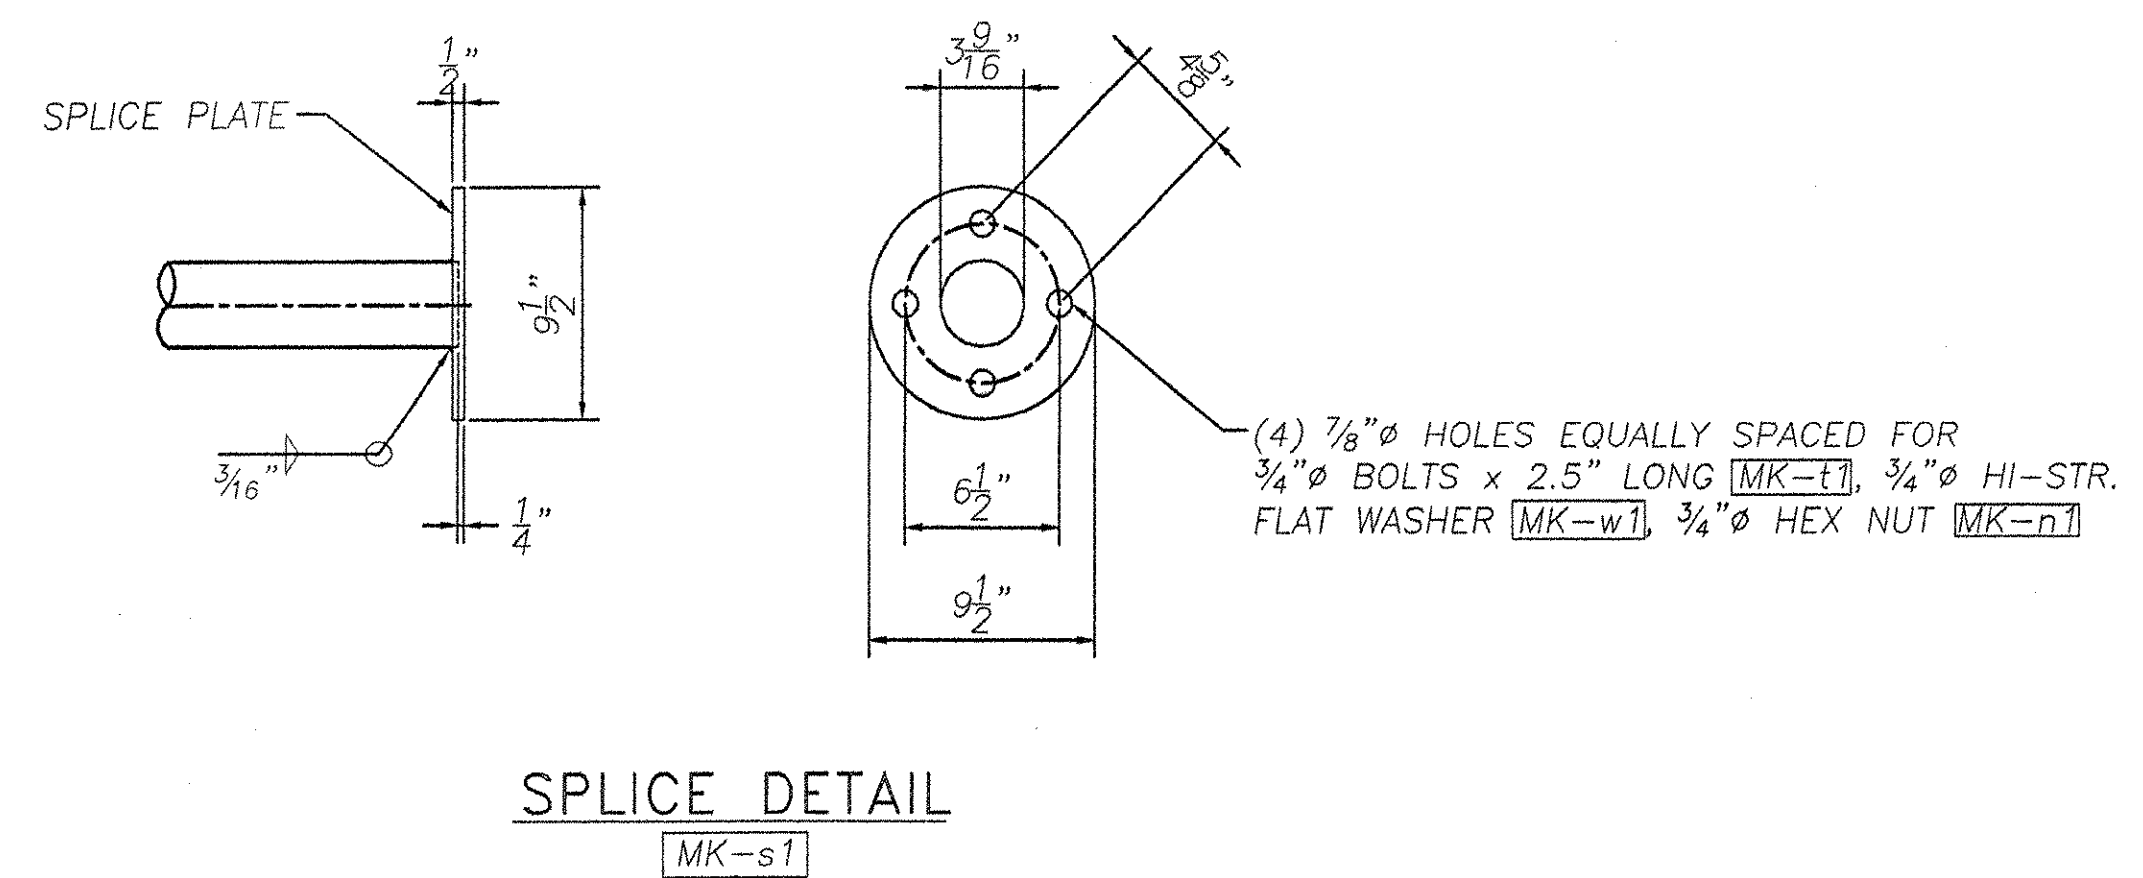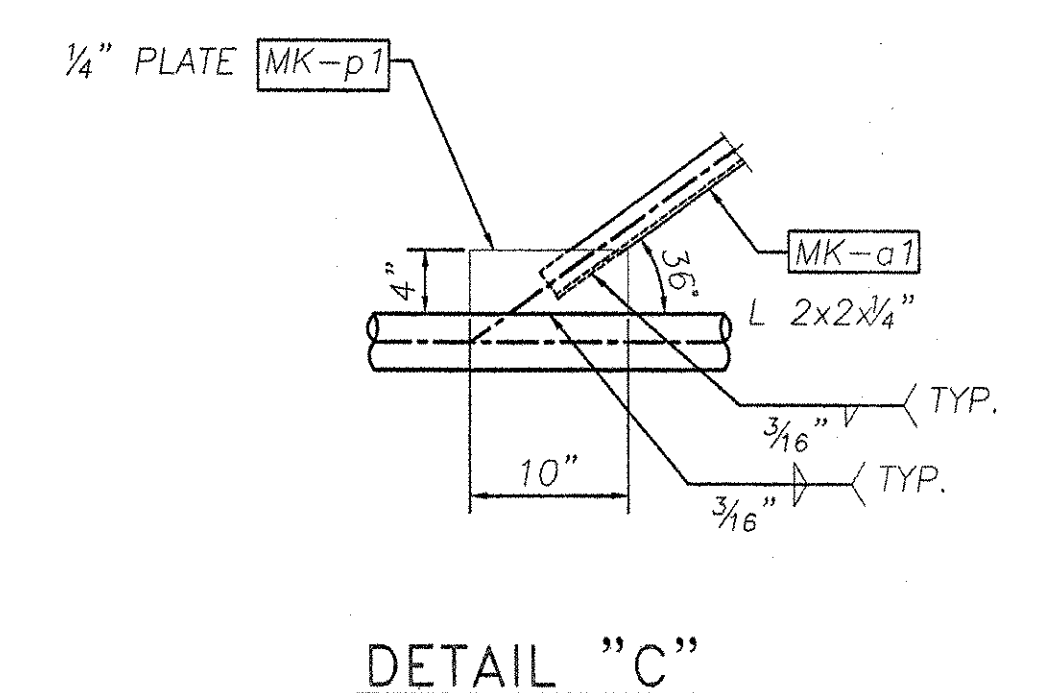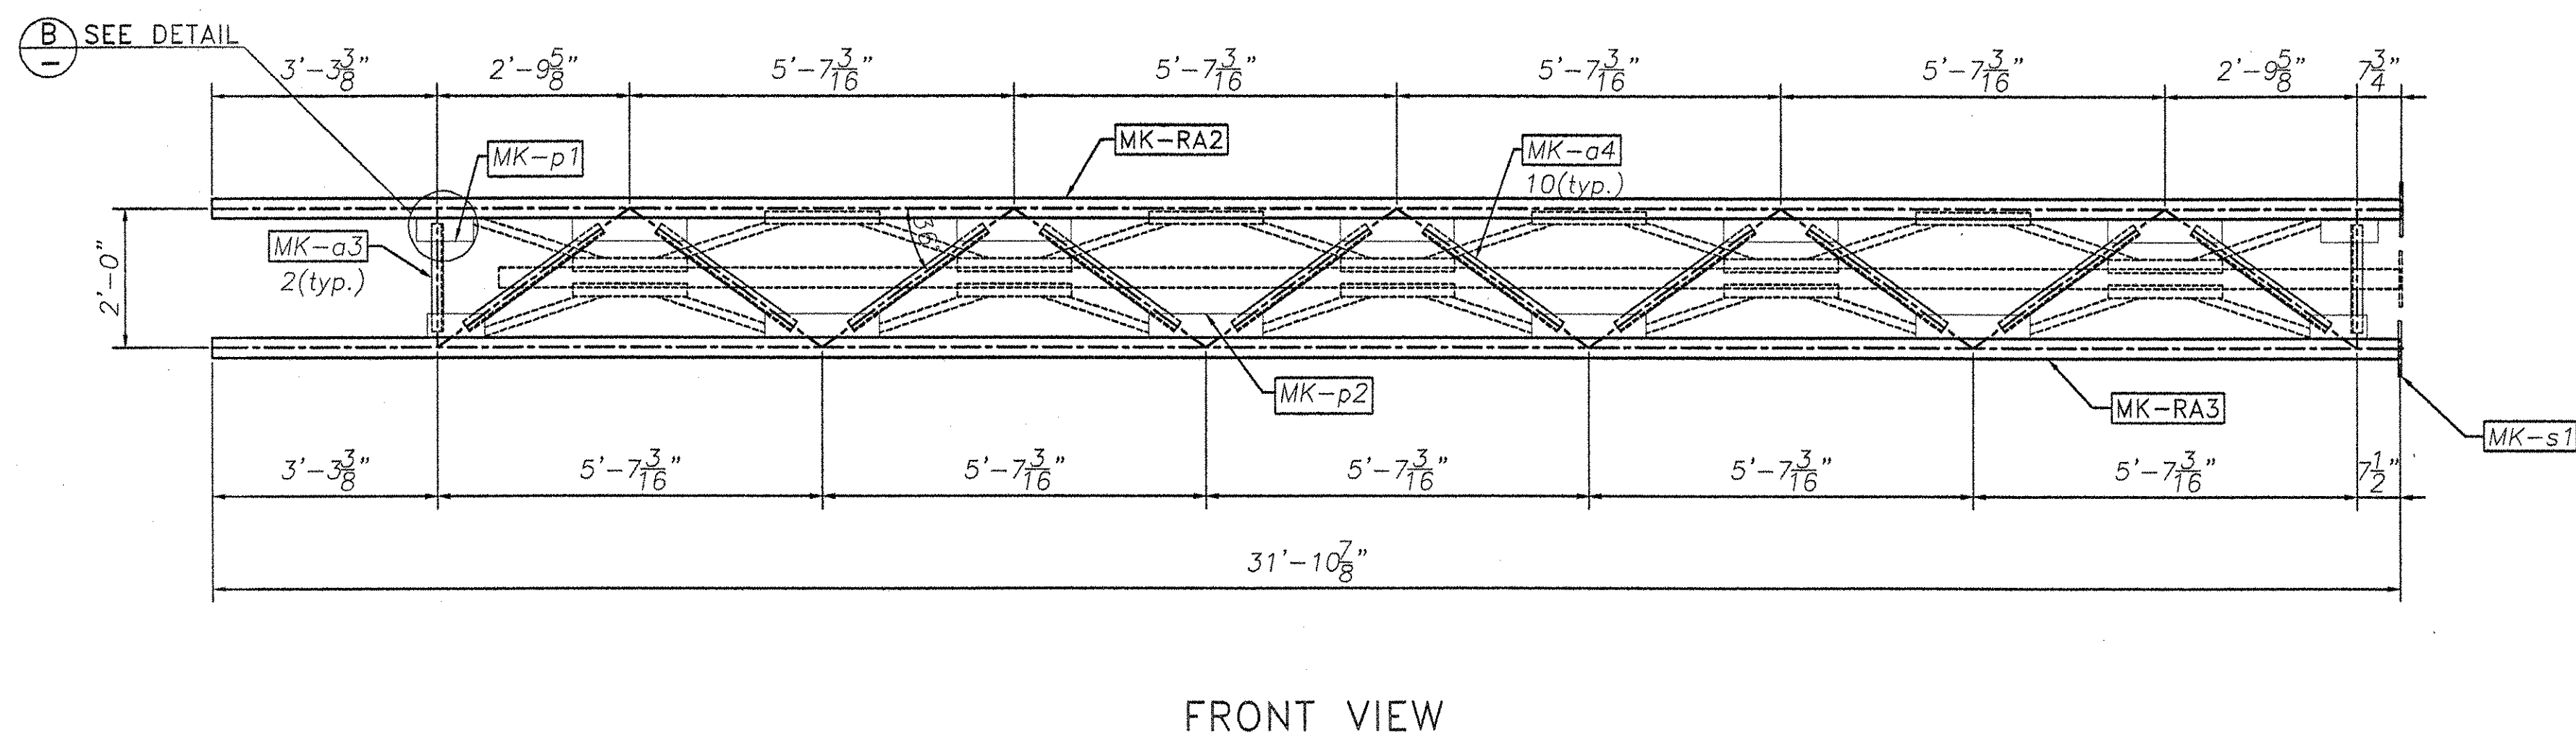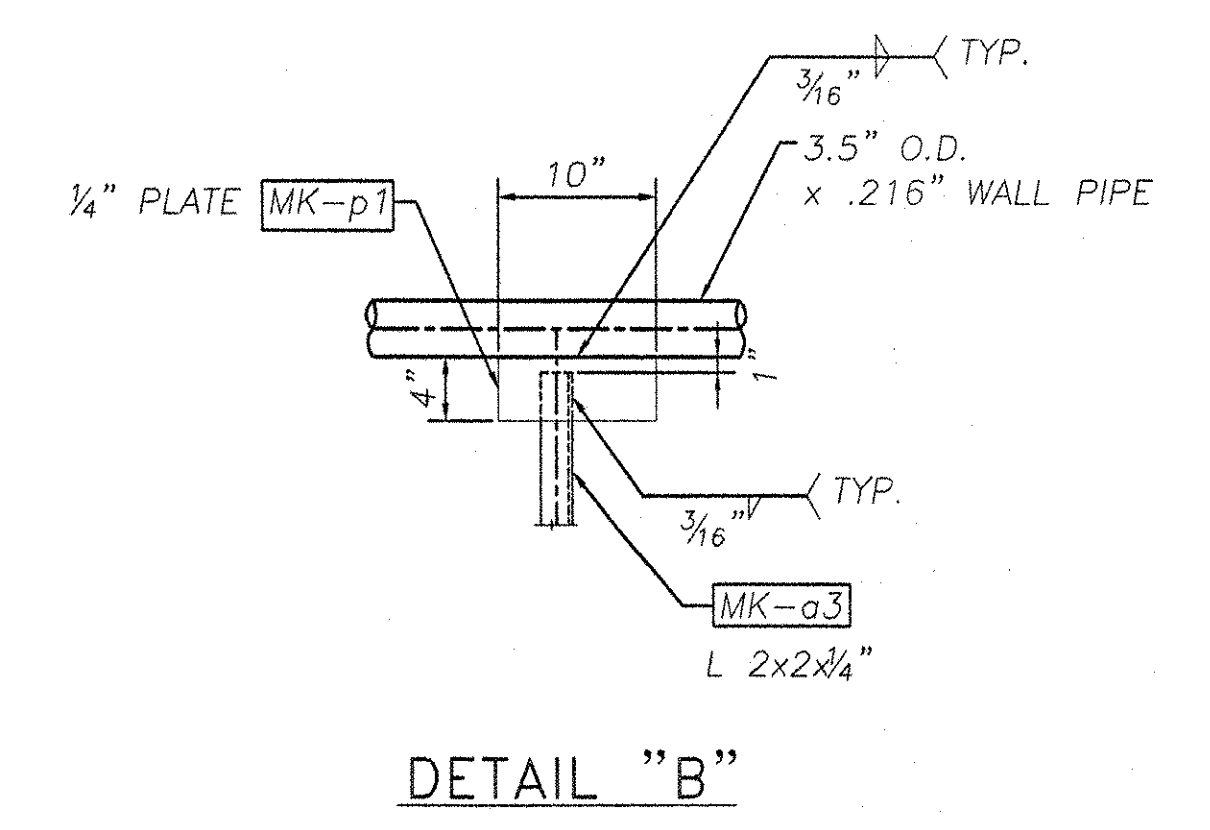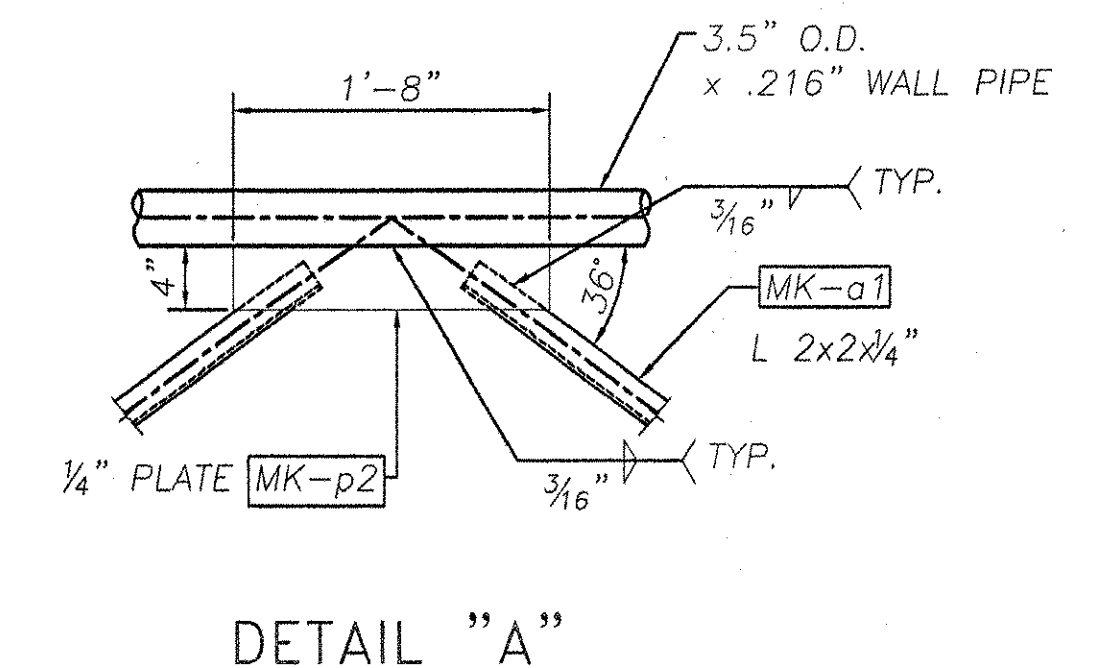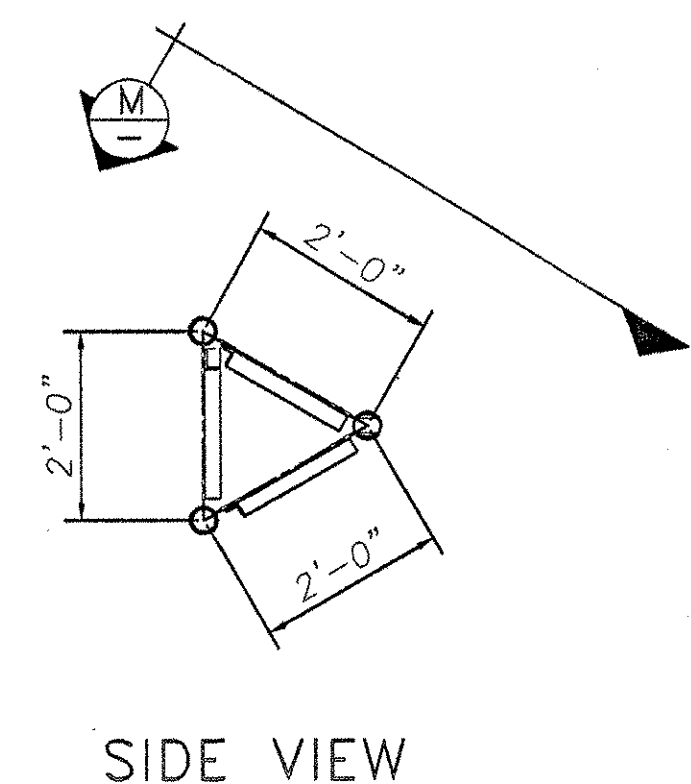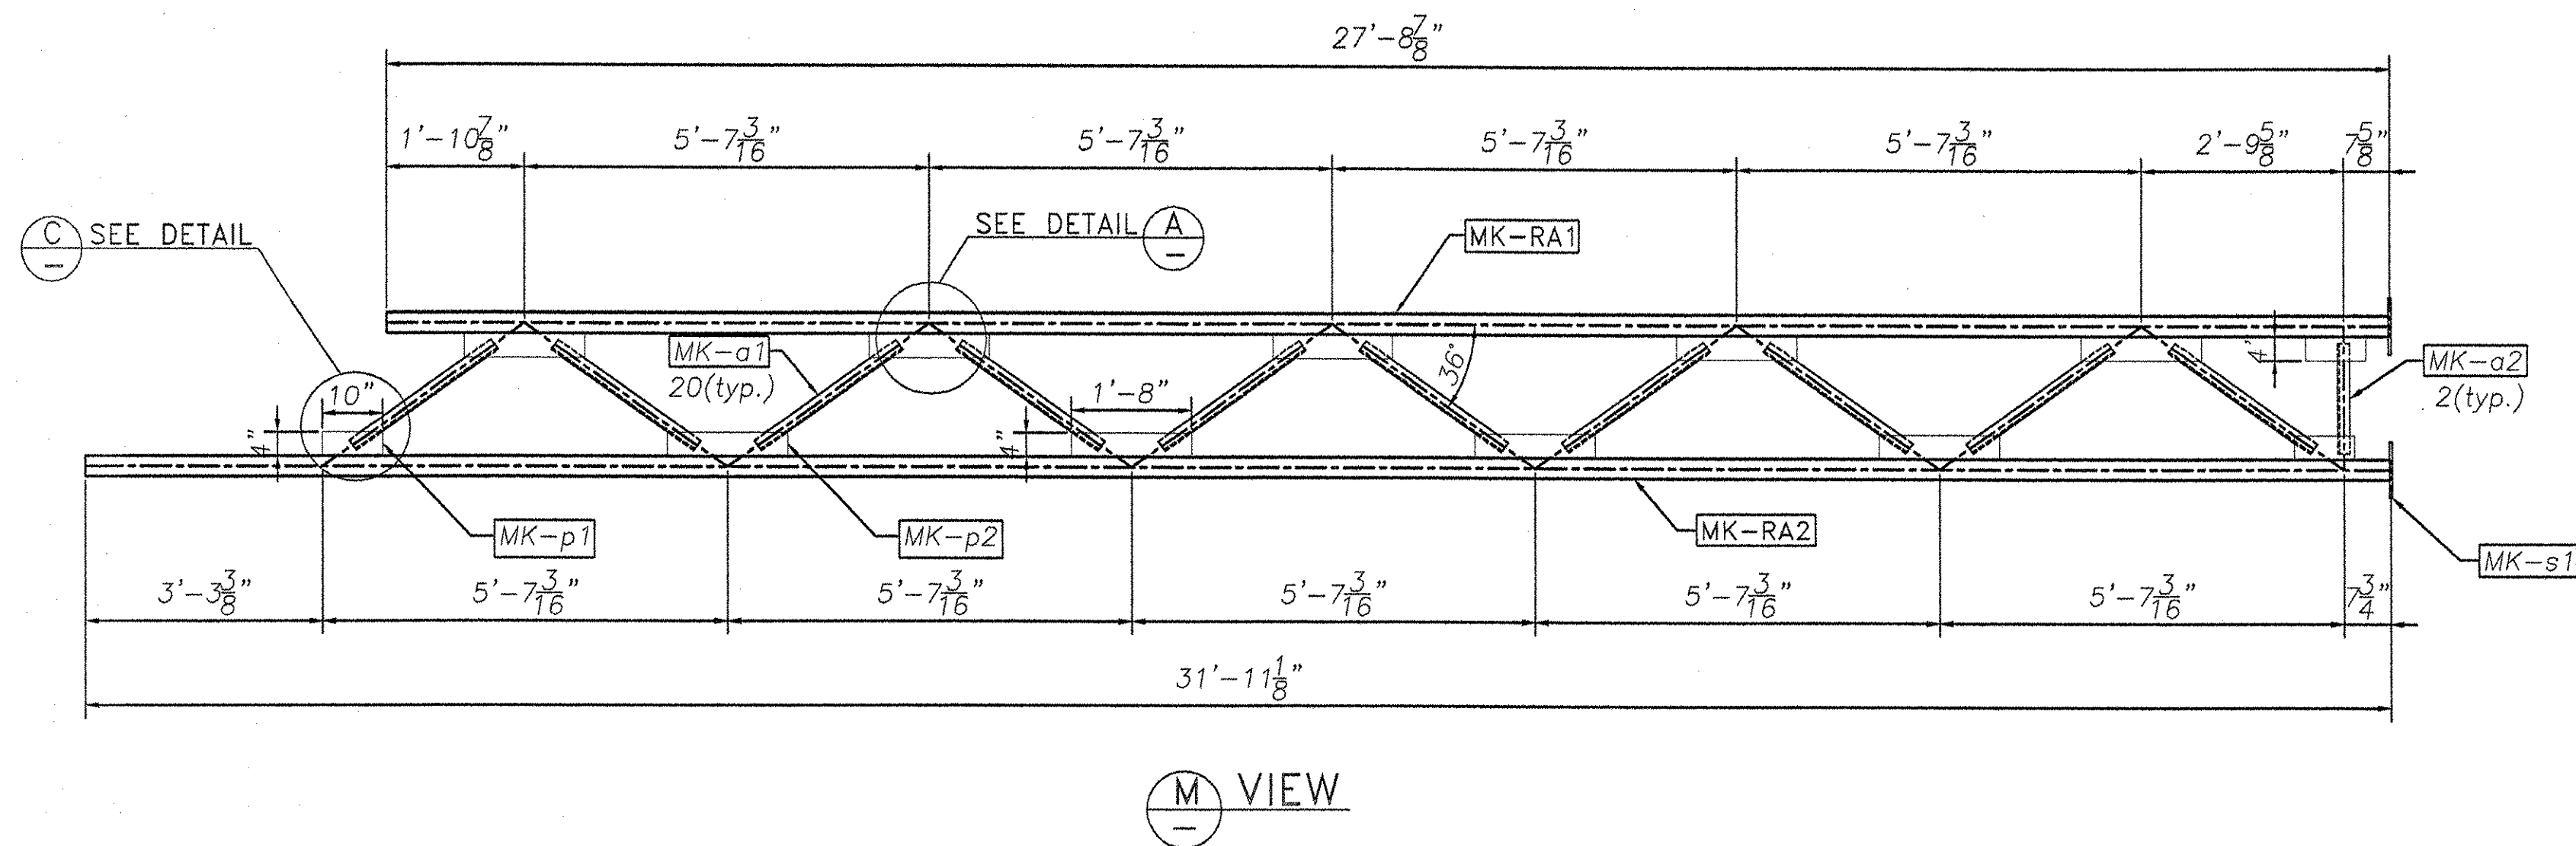


HIGHWAY SAFETY CORP.
GLASTONBURY, CT

TRI-CHORD SIGN STRUCTURE
I-89 EXIT 12 SB OFF RAMP
CHITTENDEN COUNTY, VERMONT
PROJECT No. IM 089-2(35)


| | | |
|--------------------|-------------------|--------|
| GENERAL CONTRACTOR | DATE | 7/8/05 |
| SUB CONTRACTOR | SCALE | NTS |
| | HSO REFERENCE NO. | 1515 |
| | SIZE | D |
| | REVISION | 0 |
| | SHEET NO. | 2 of 8 |

| REVISIONS | | |
|-----------|-------------------|------|
| No. | Remarks | Date |
| 0 | Initial submittal | |


Handwritten signature/initials

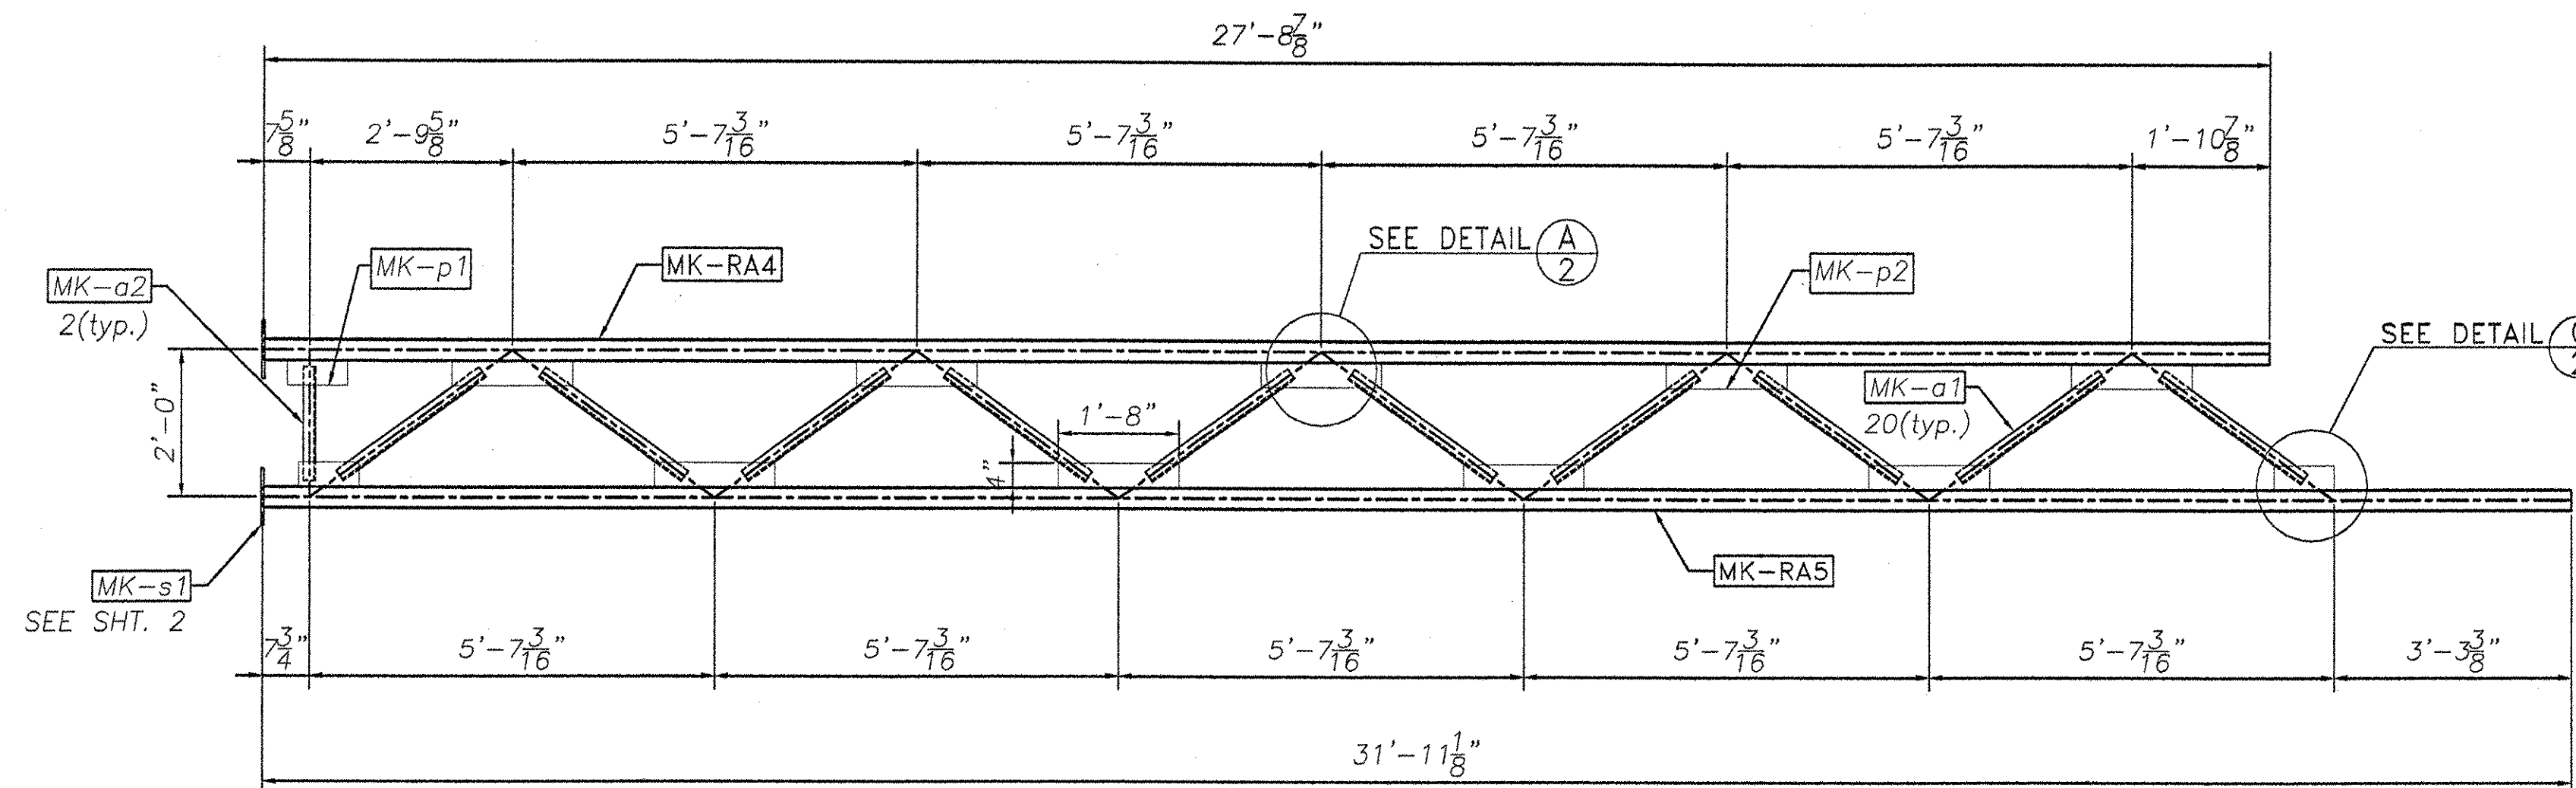

N VIEW

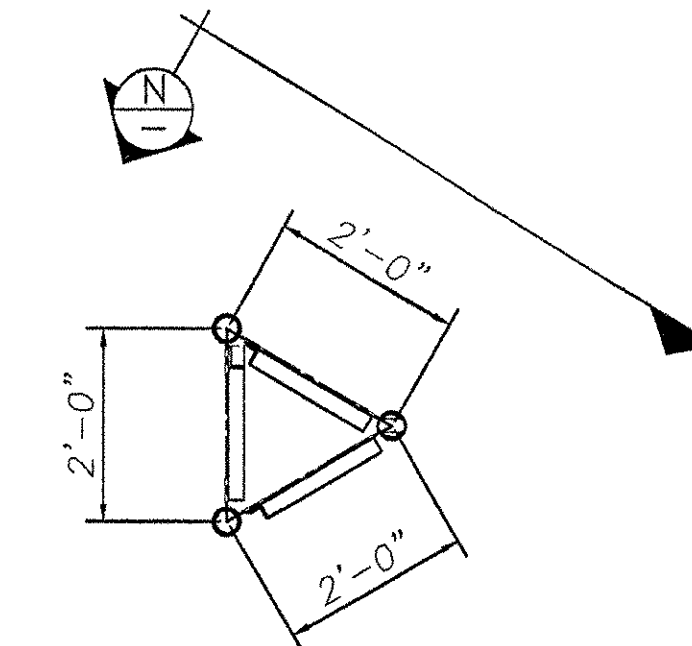

SIDE VIEW

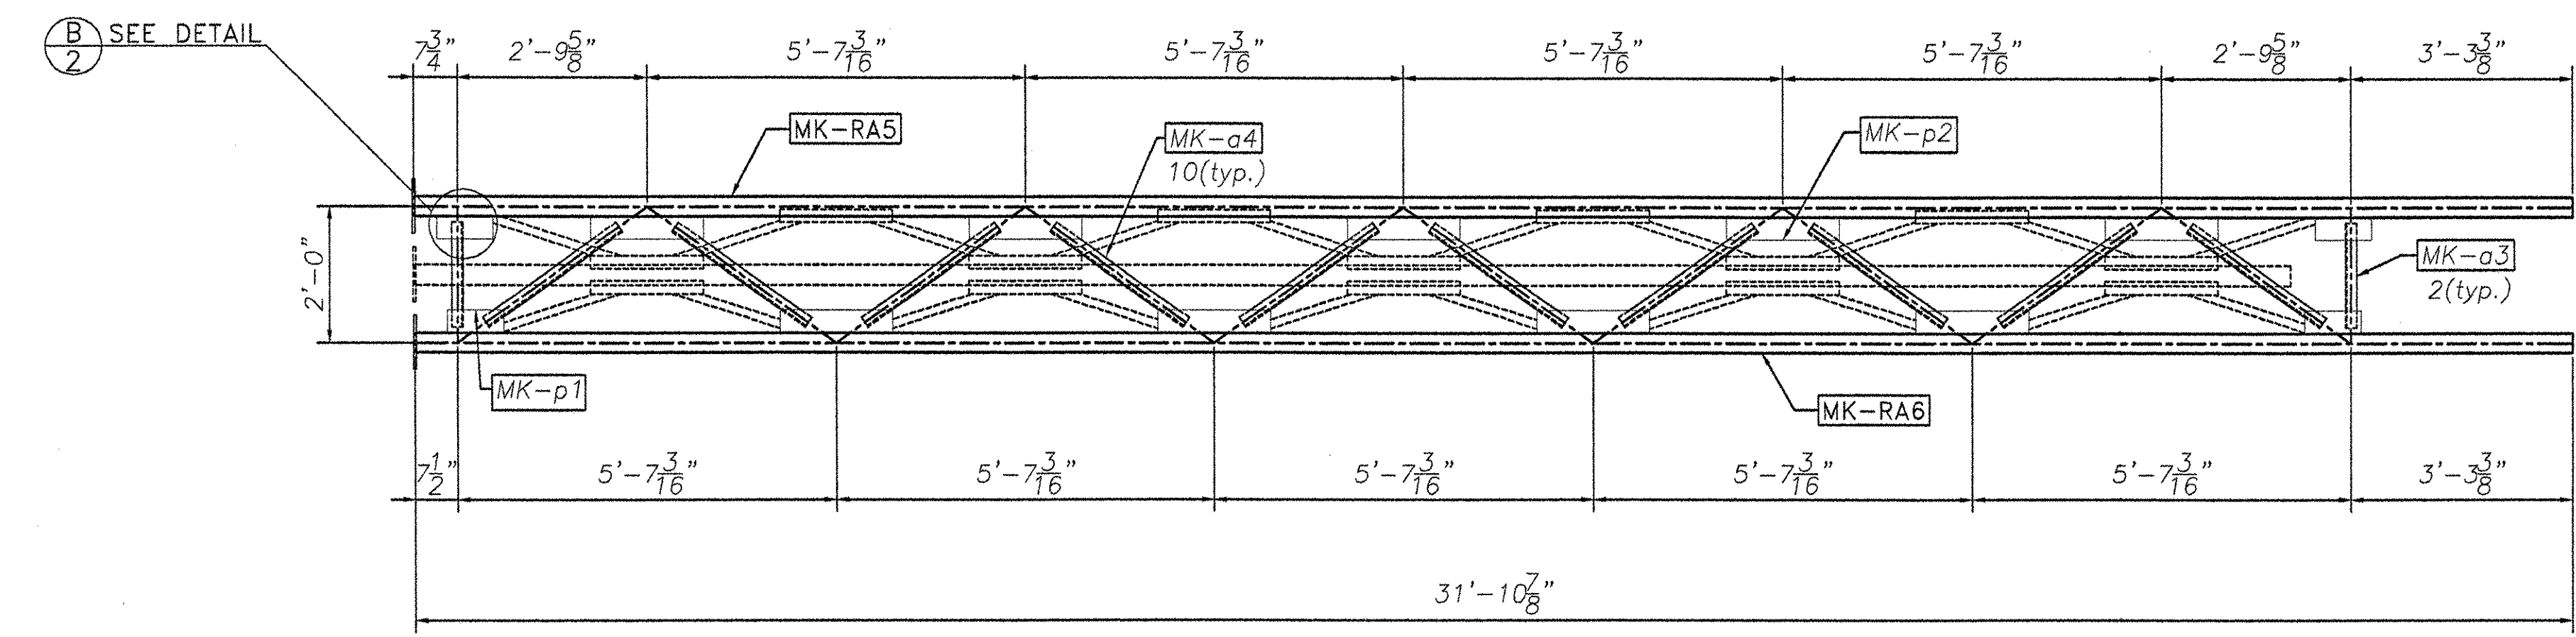

FRONT VIEW

| REVISIONS | | |
|-----------|-------------------|------|
| No. | Remarks | Date |
| 0 | Initial submittal | |
| | | |
| | | |



HIGHWAY SAFETY CORP.
GLASTONBURY, CT



TRI-CHORD SIGN STRUCTURE
I-89 EXIT 12 SB OFF RAMP
CHITTENDEN COUNTY, VERMONT
PROJECT No. IM 089-2(35)

DRAWN: MHM
CHECKED: [Signature]
DATE: 7/8/05
SCALE: NTS
TISC REFERENCE NO.: 1515


GENERAL CONTRACTOR: [Blank]
SUB CONTRACTOR: F.R. LAFAYETTE

SHEET NO. 3 of 8


[Handwritten signature]

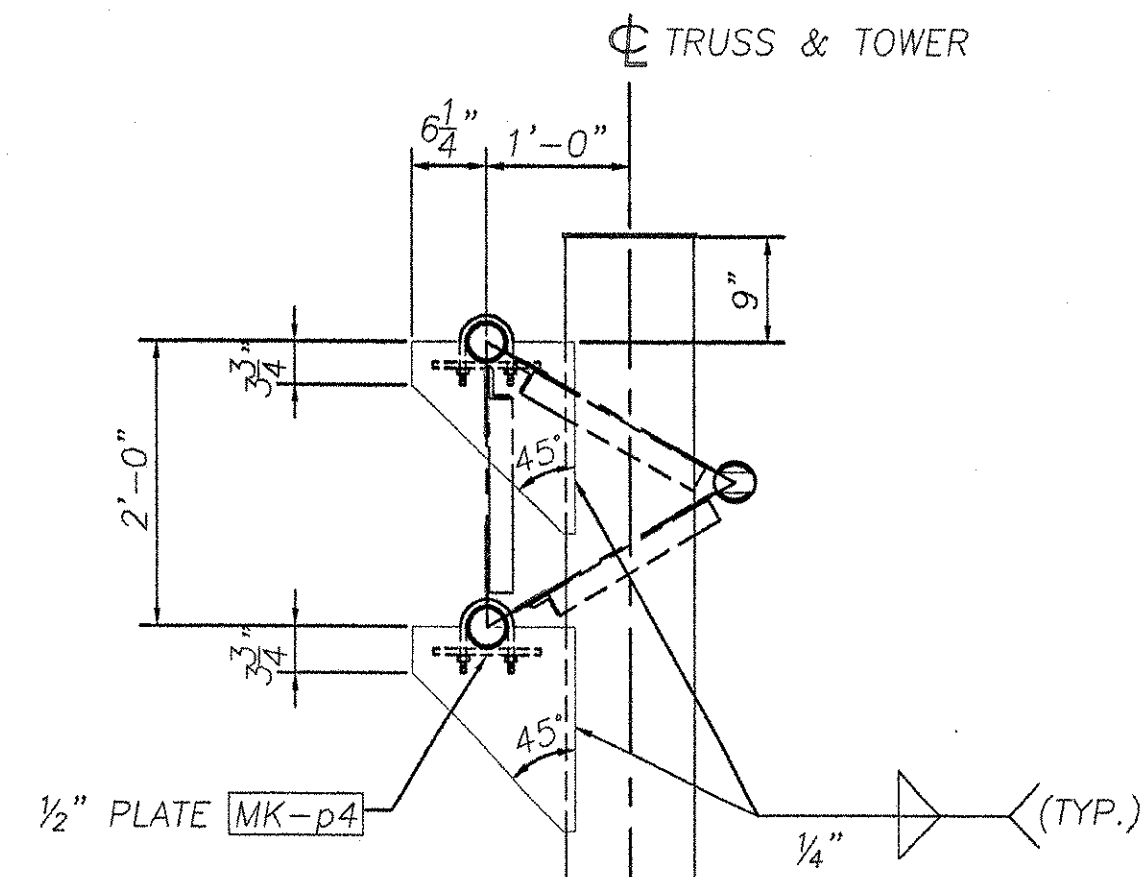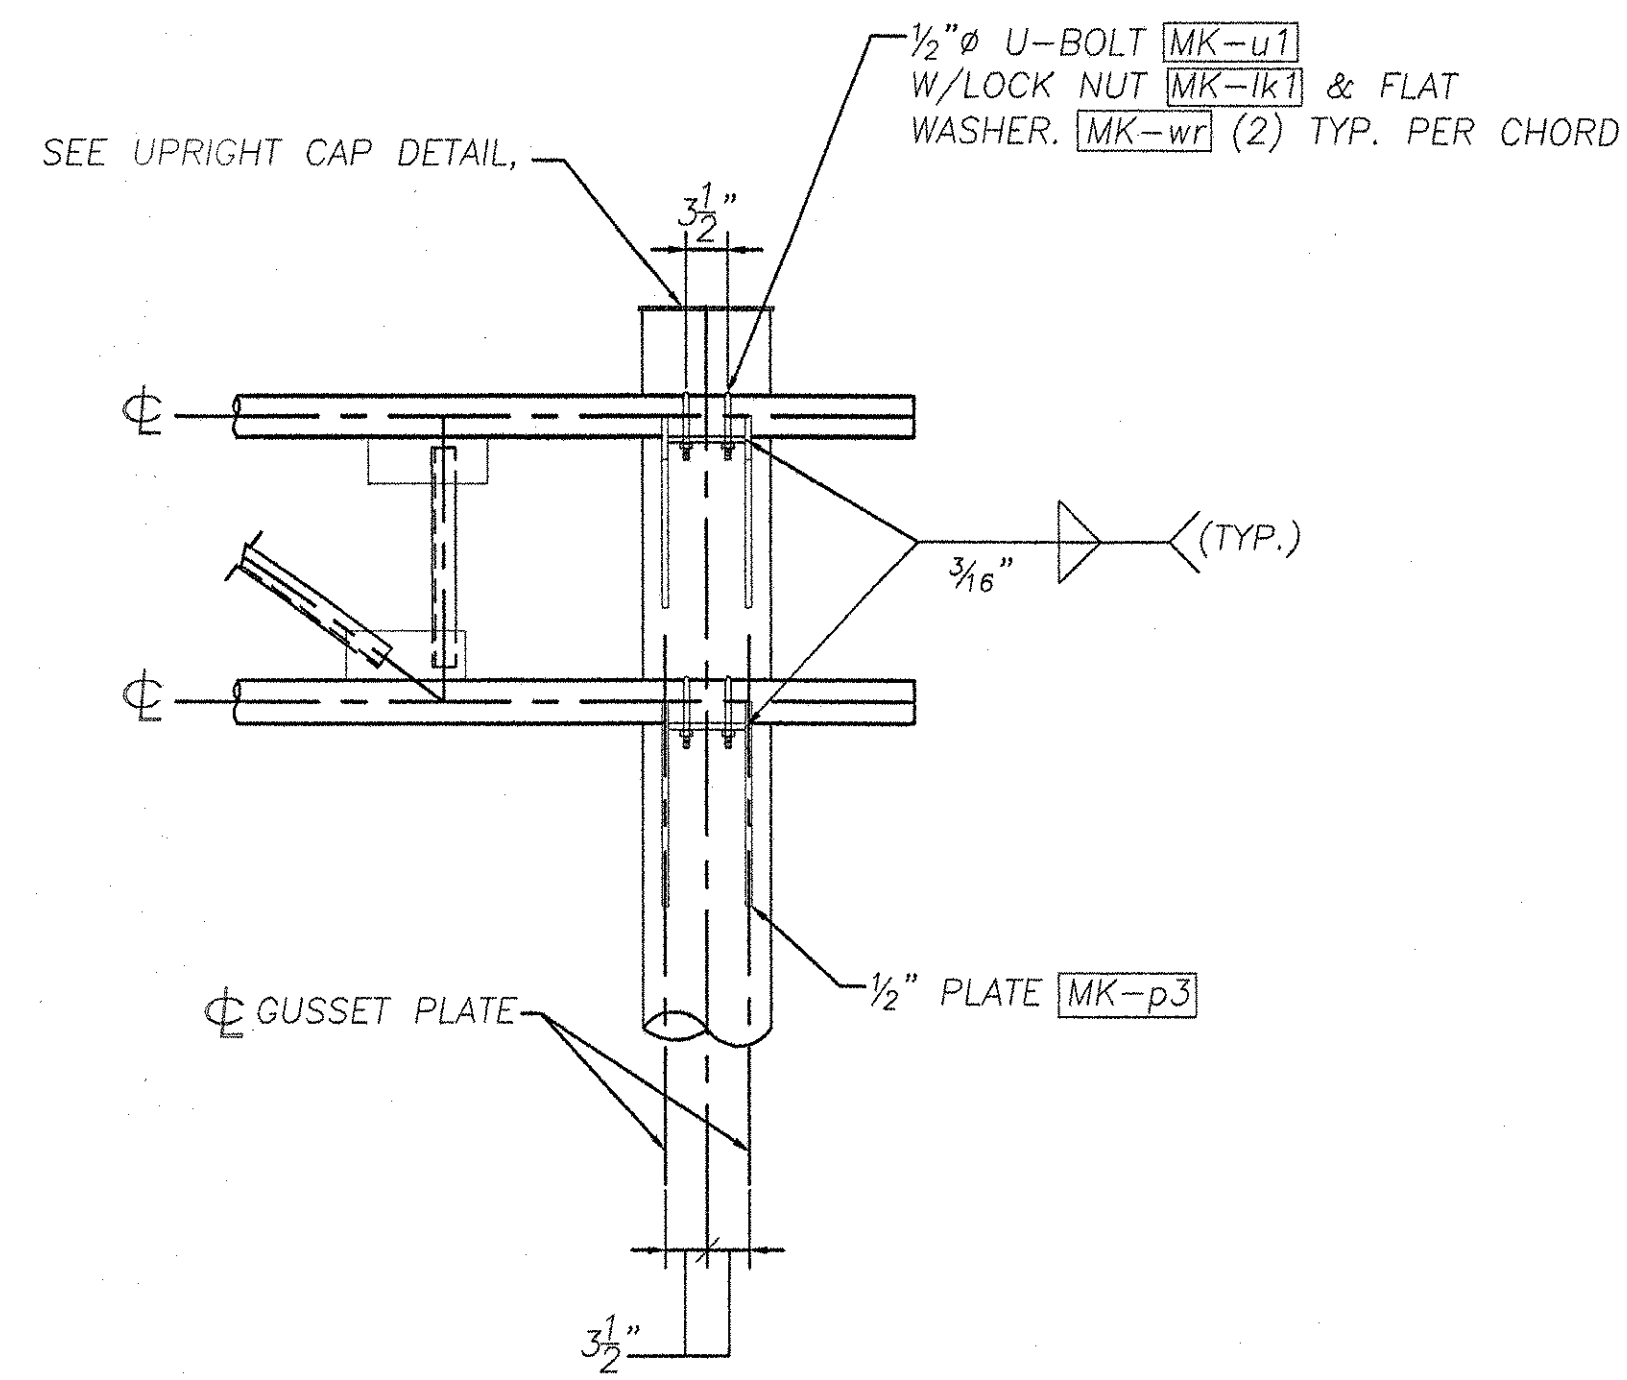


TRUSS CONNECTION DETAIL

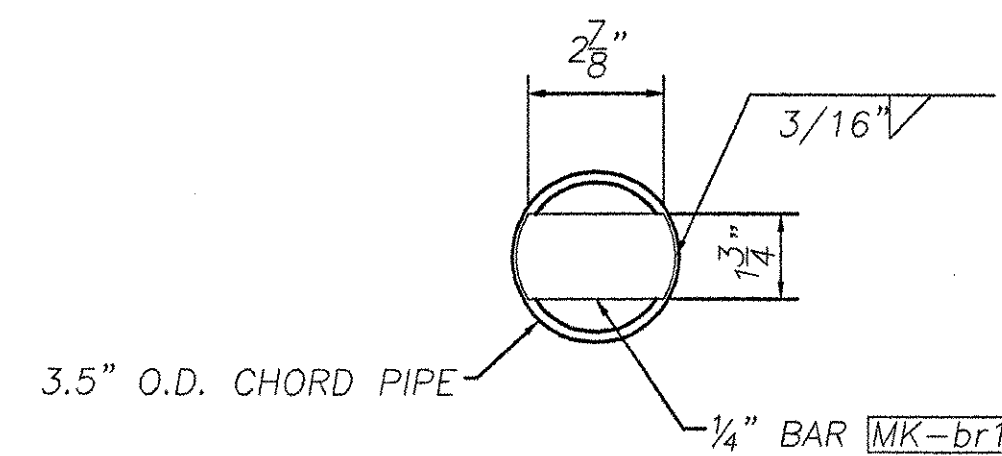


PLUG DETAIL
(EACH END OF TRUSS CHORD)

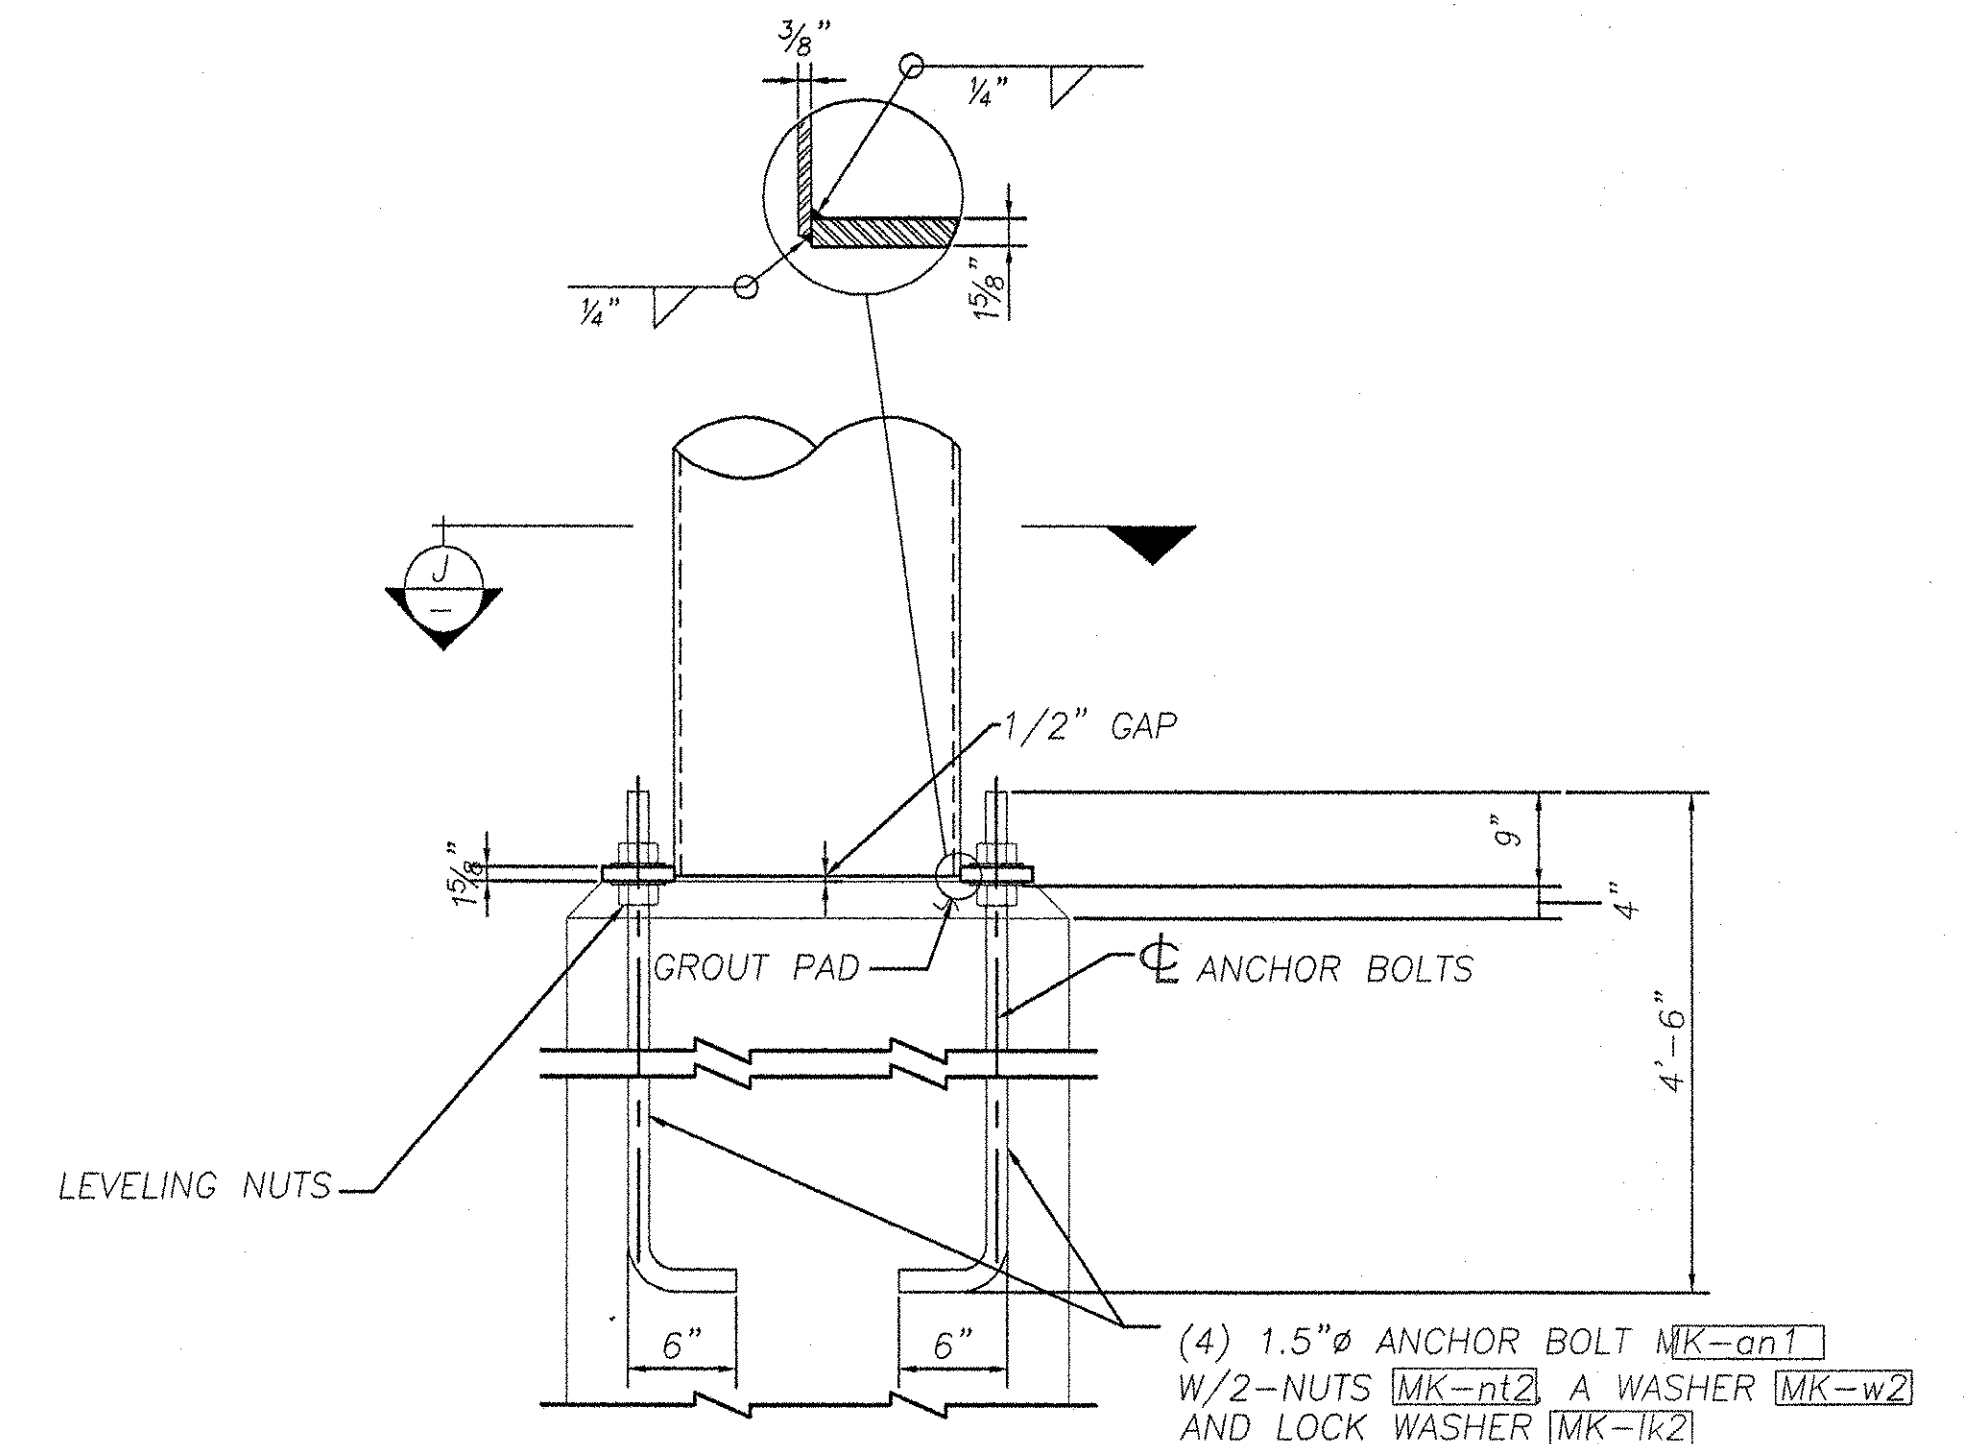


ANCHORAGE ASSEMBLY

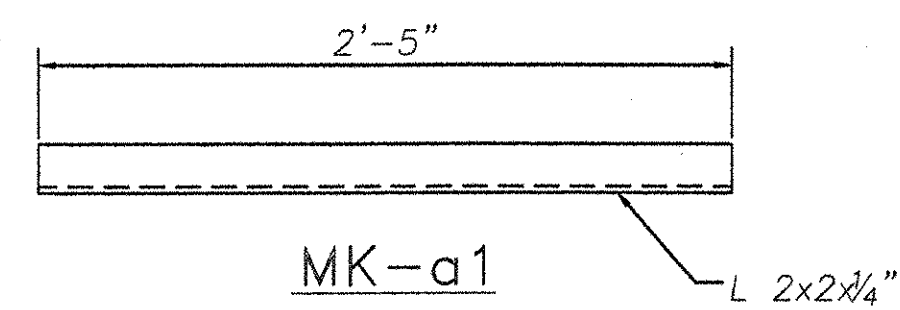


MK-a1

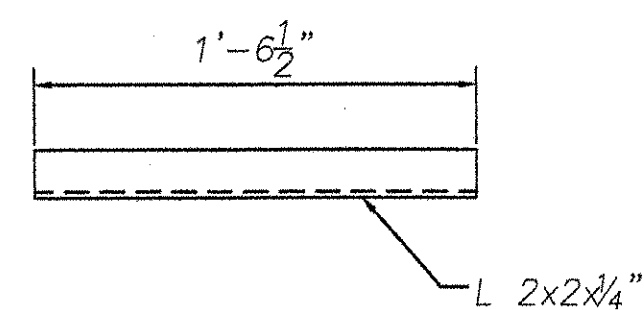


MK-a2

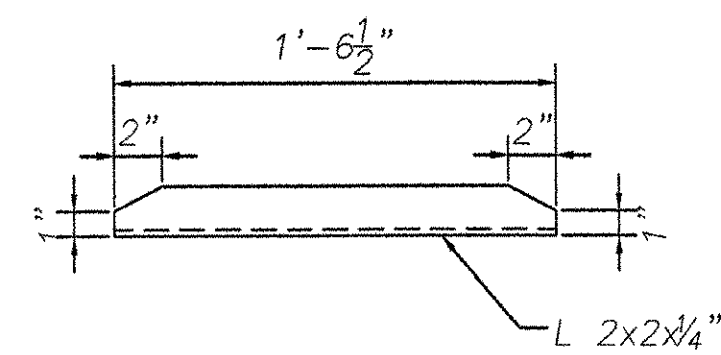


MK-a3

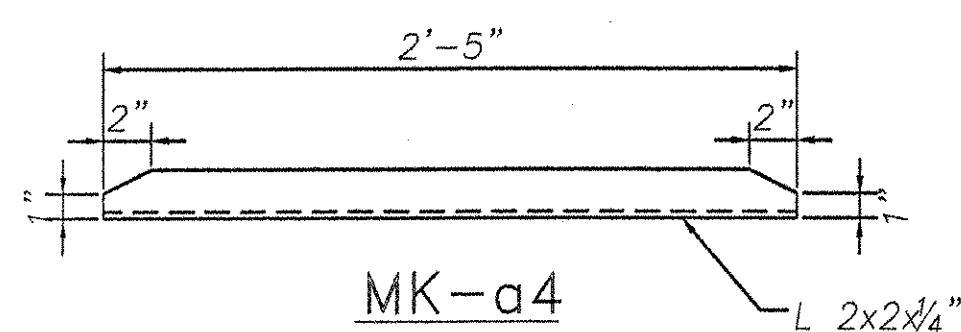

MK-a4

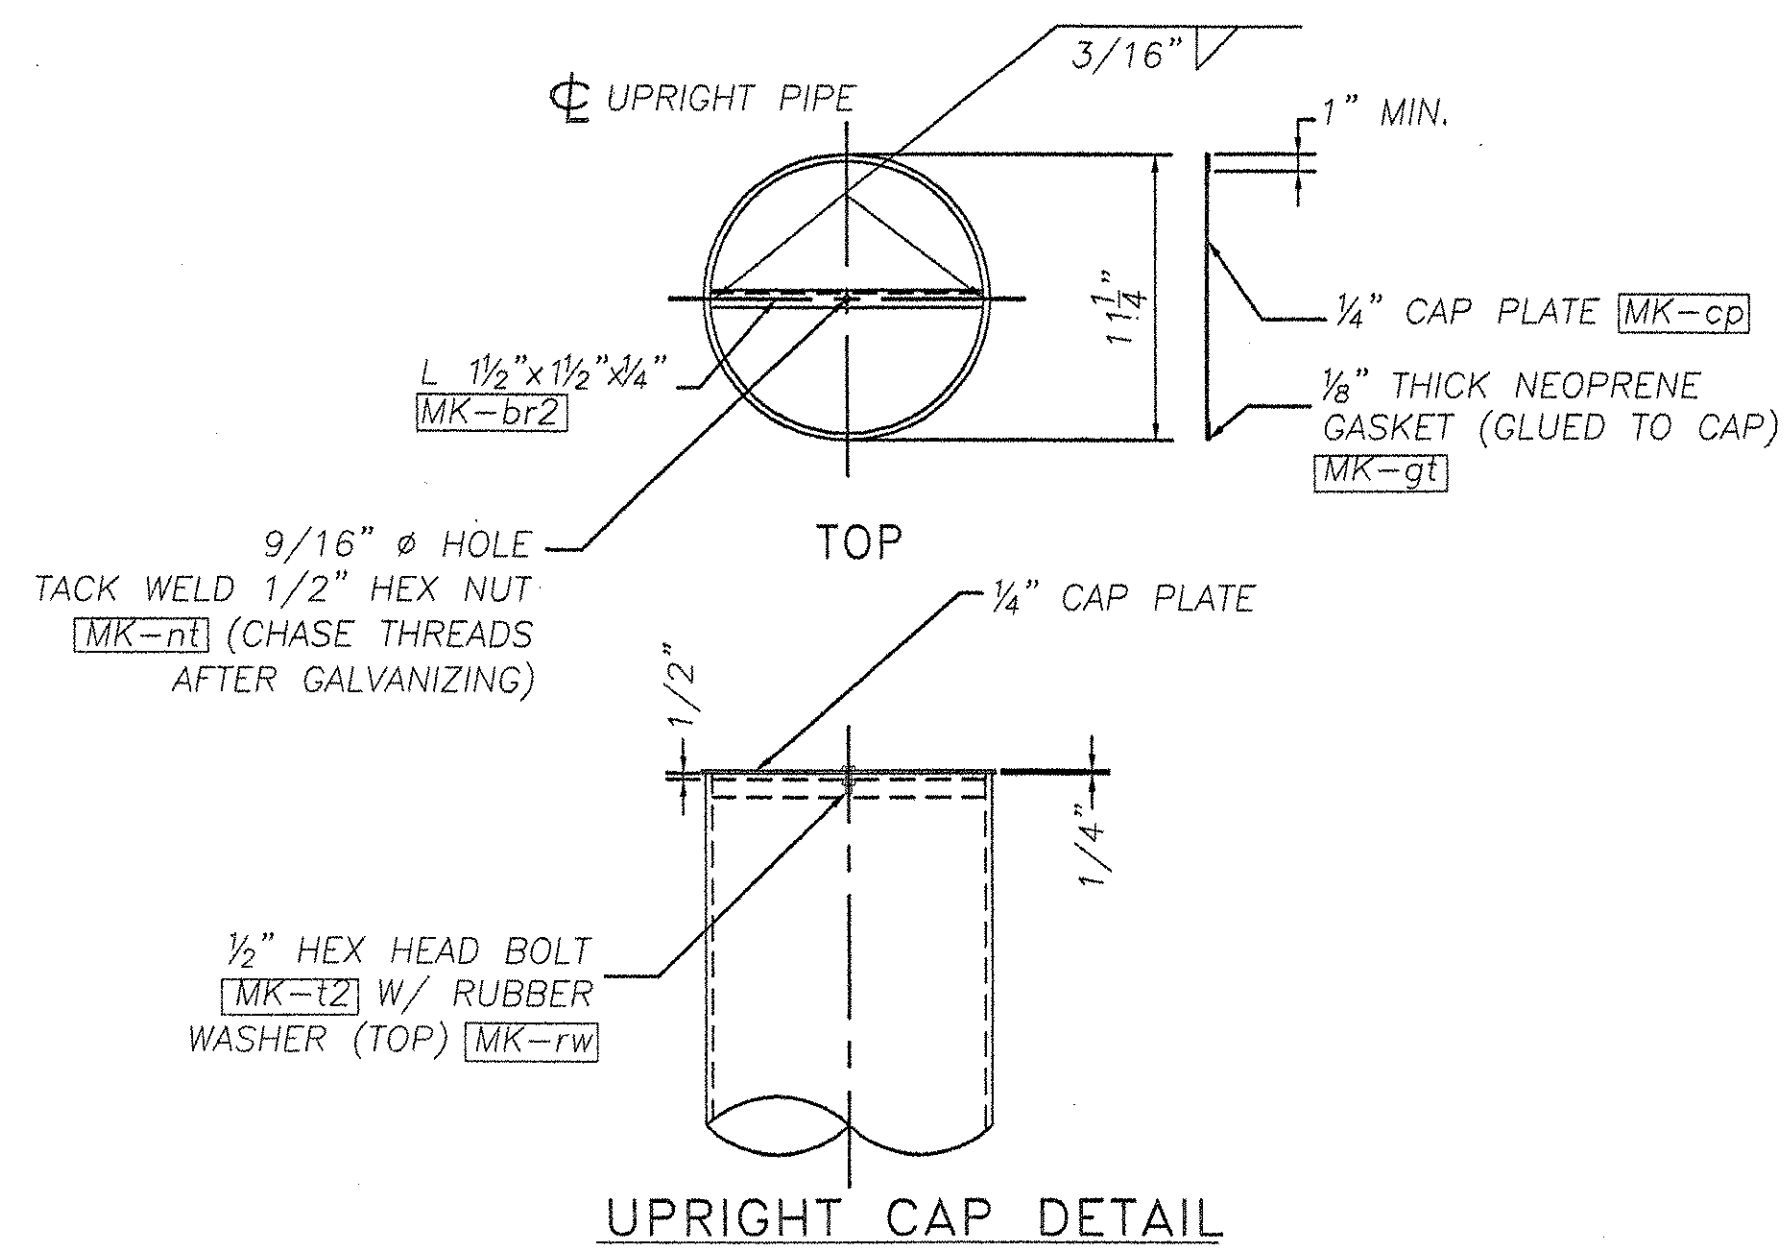

UPRIGHT CAP DETAIL

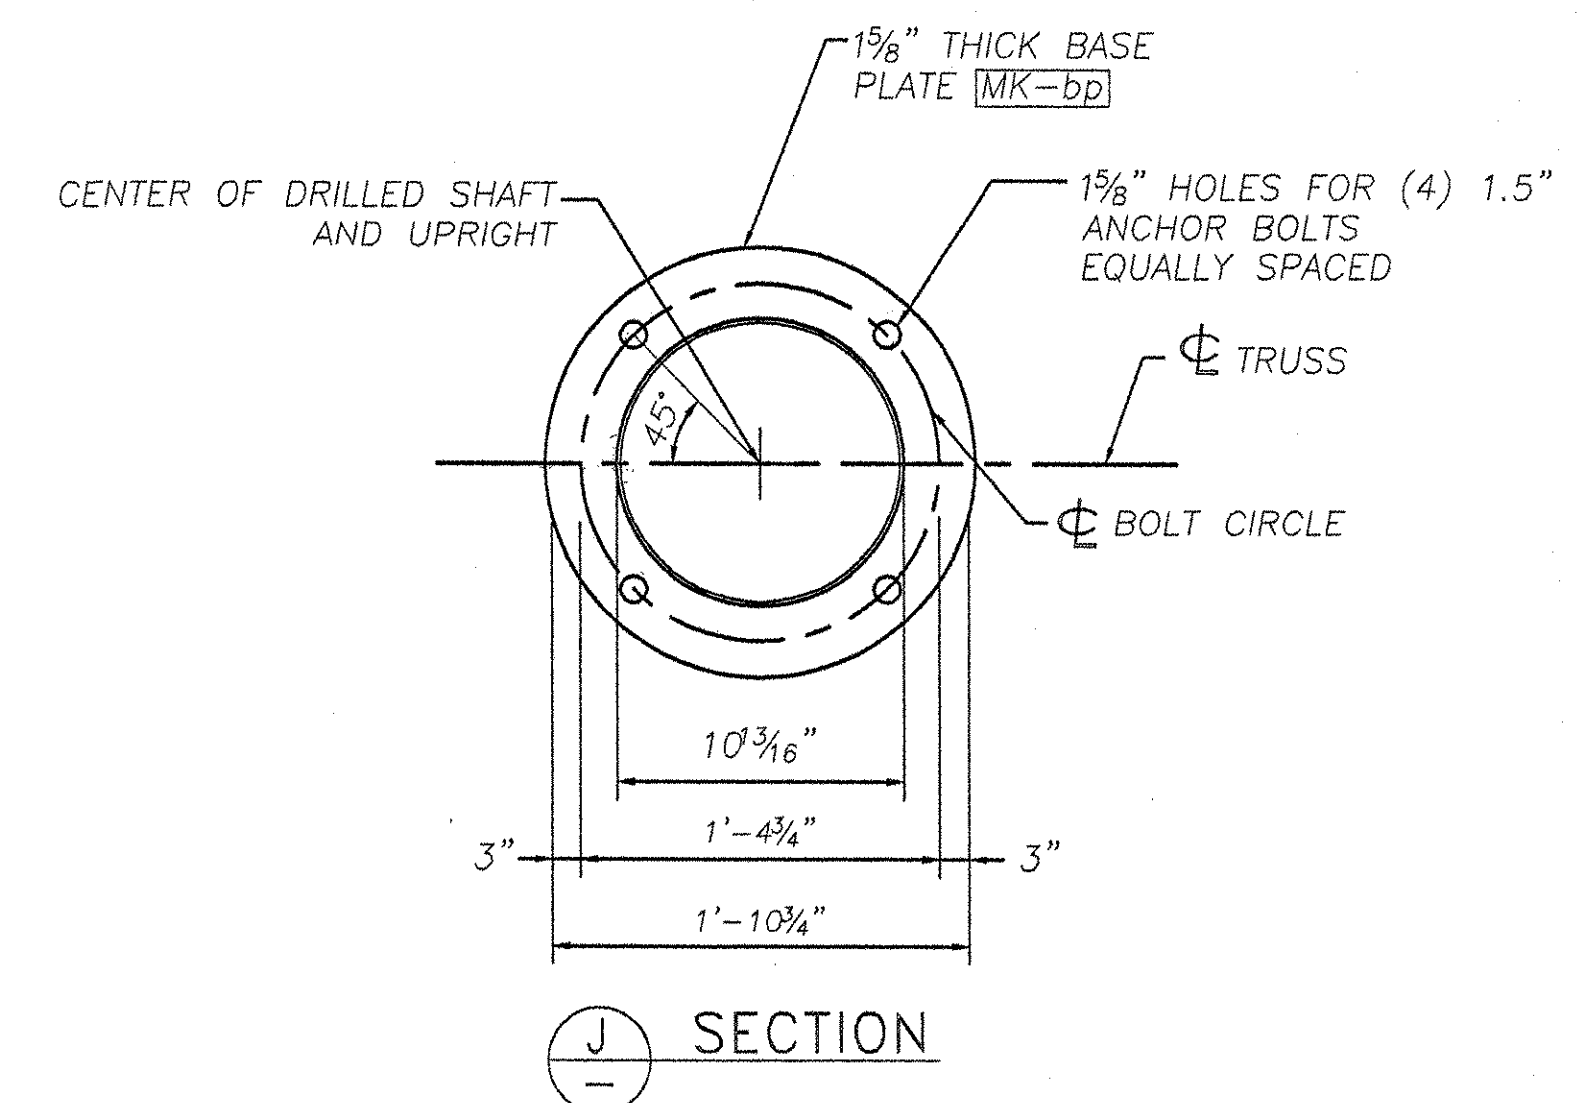

SECTION J

| REVISIONS | | |
|-----------|-------------------|------|
| No. | Remarks | Date |
| 0 | Initial submittal | |
| | | |
| | | |




HIGHWAY SAFETY CORP.
GLASTONBURY, CT


TRI-CHORD SIGN STRUCTURE
I-89 EXIT 12 SB OFF RAMP
CHITTENDEN COUNTY, VERMONT
PROJECT No. IM 089-2(35)

| | |
|-------------------|--------------------|
| DRAWN | MHM |
| CHECKED | <i>[Signature]</i> |
| DATE | 7/8/05 |
| SCALE | N.T.S. |
| HSC REFERENCE NO. | 1515 |
| SIZE | D |
| REVISION | 0 |
| SHEET NO. | 4 of 8 |


[Handwritten signature]

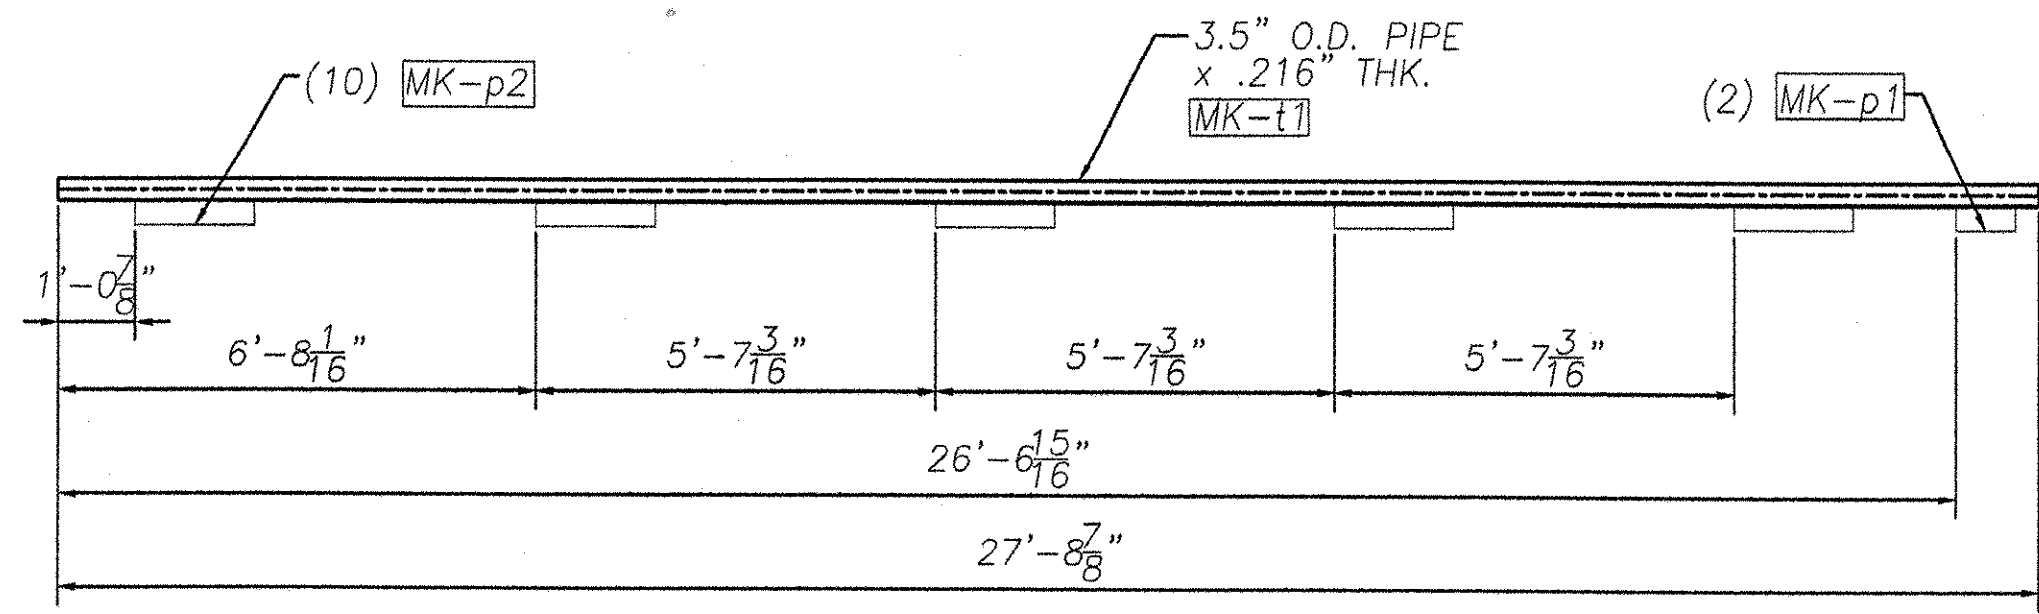


MK-RA1

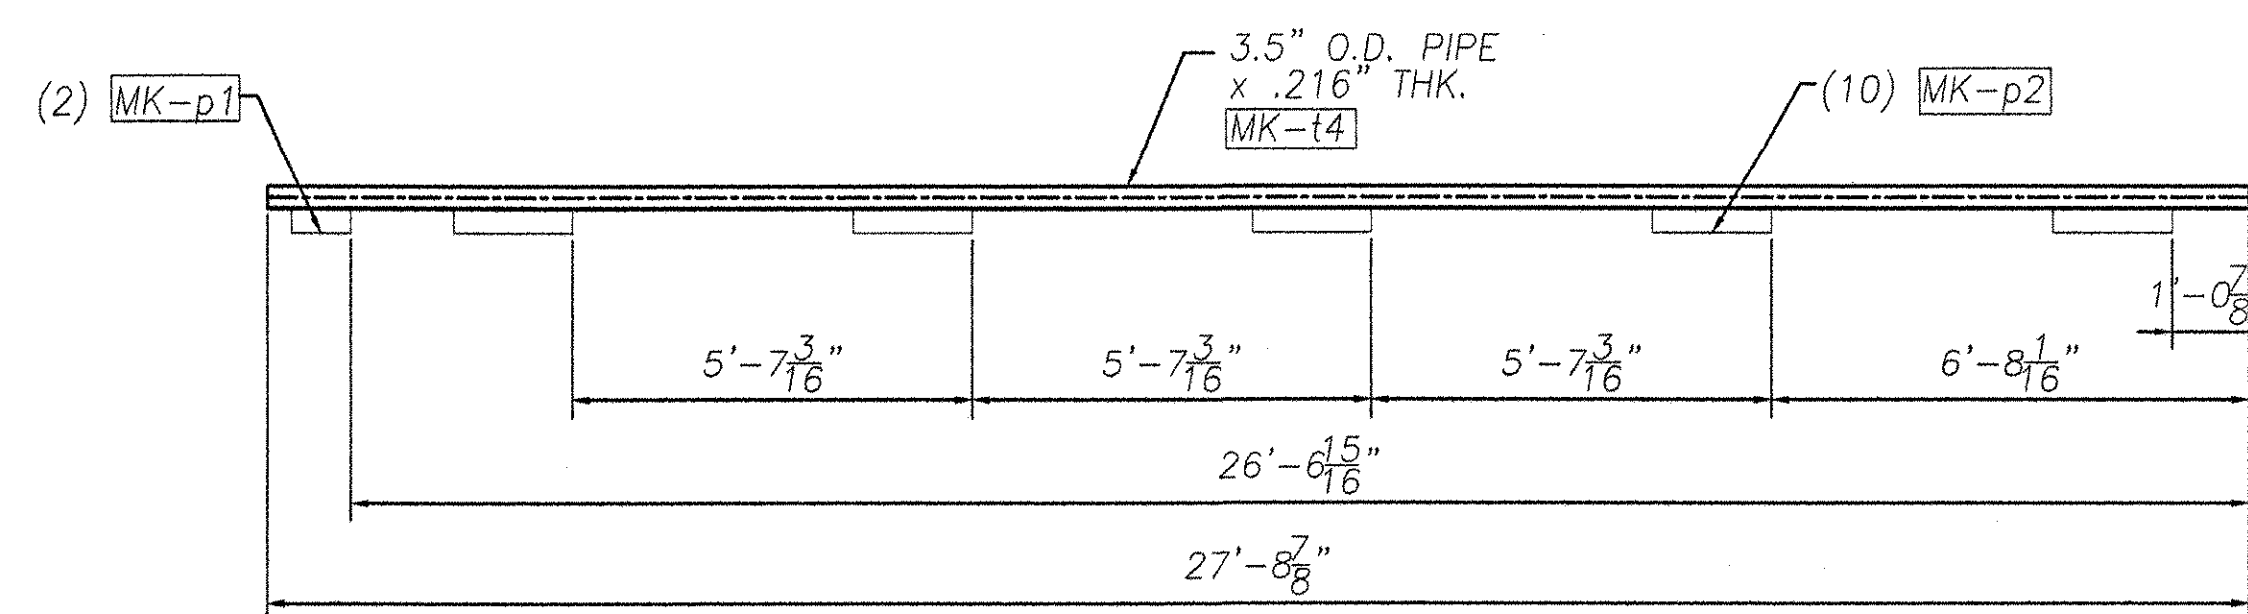




MK-RA4

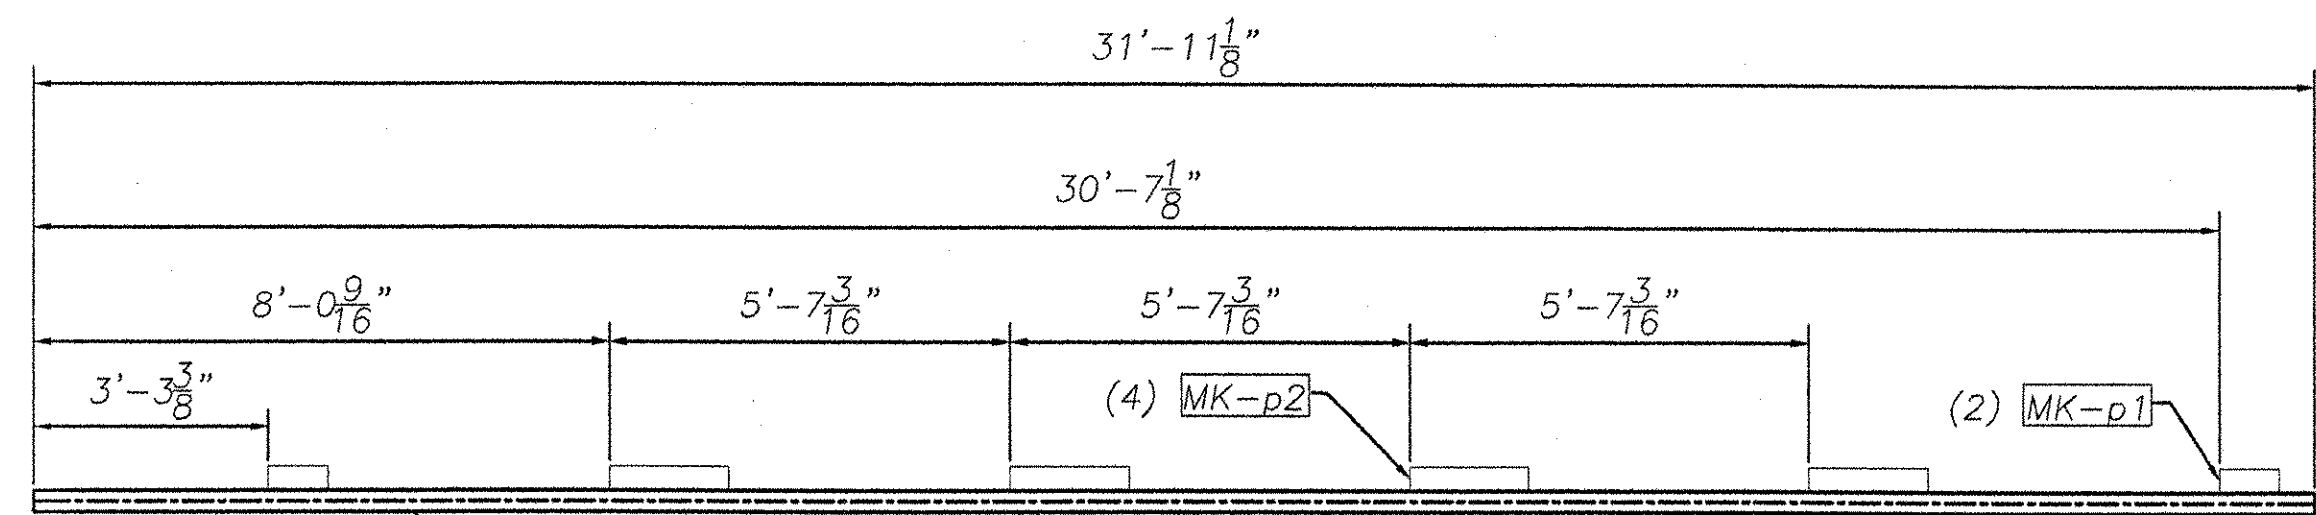



MK-RA2

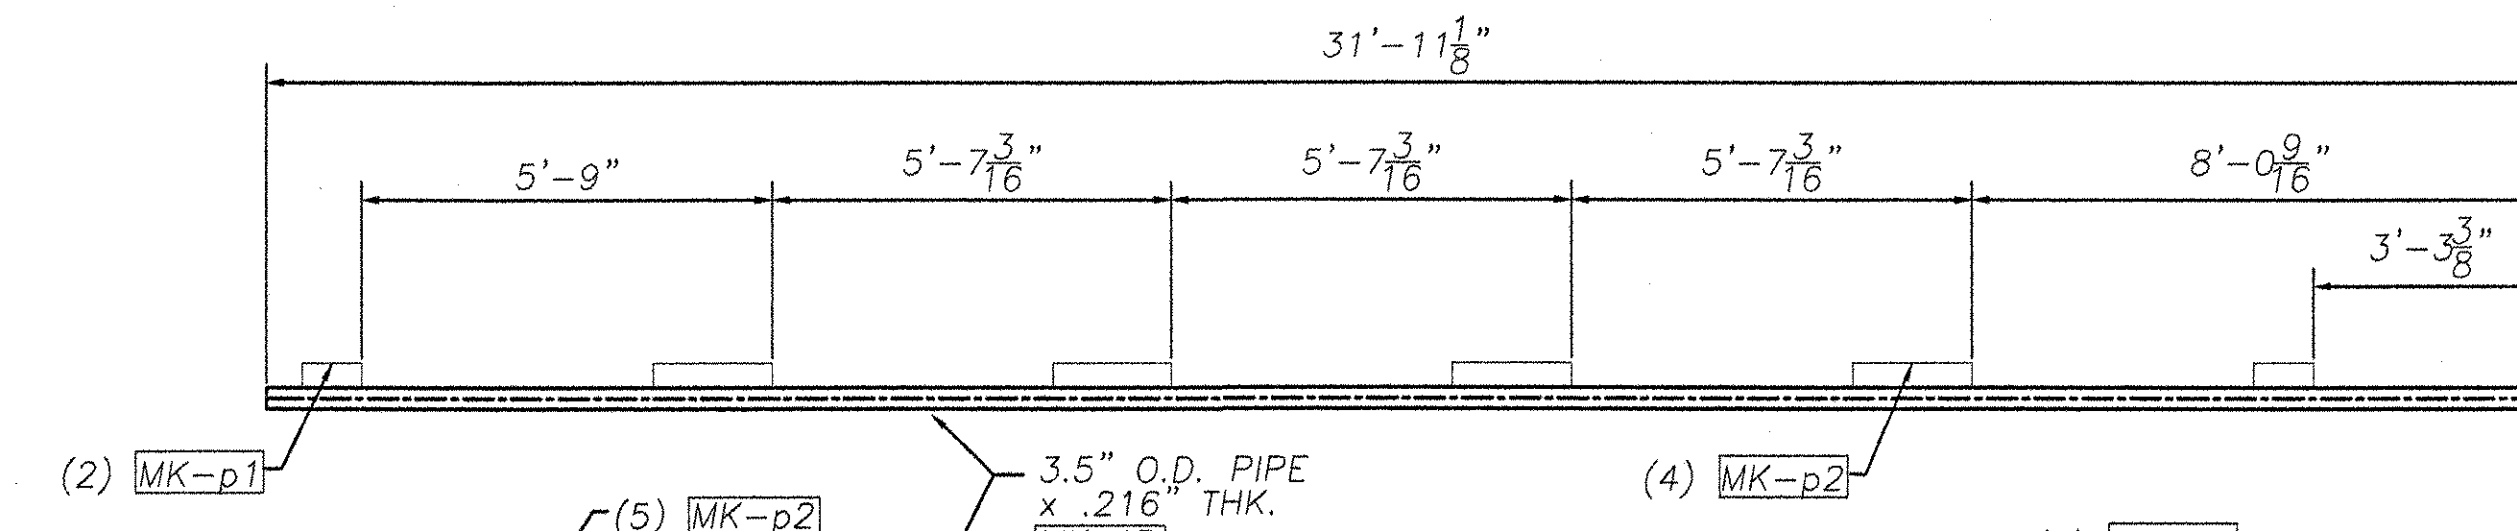


MK-RA5

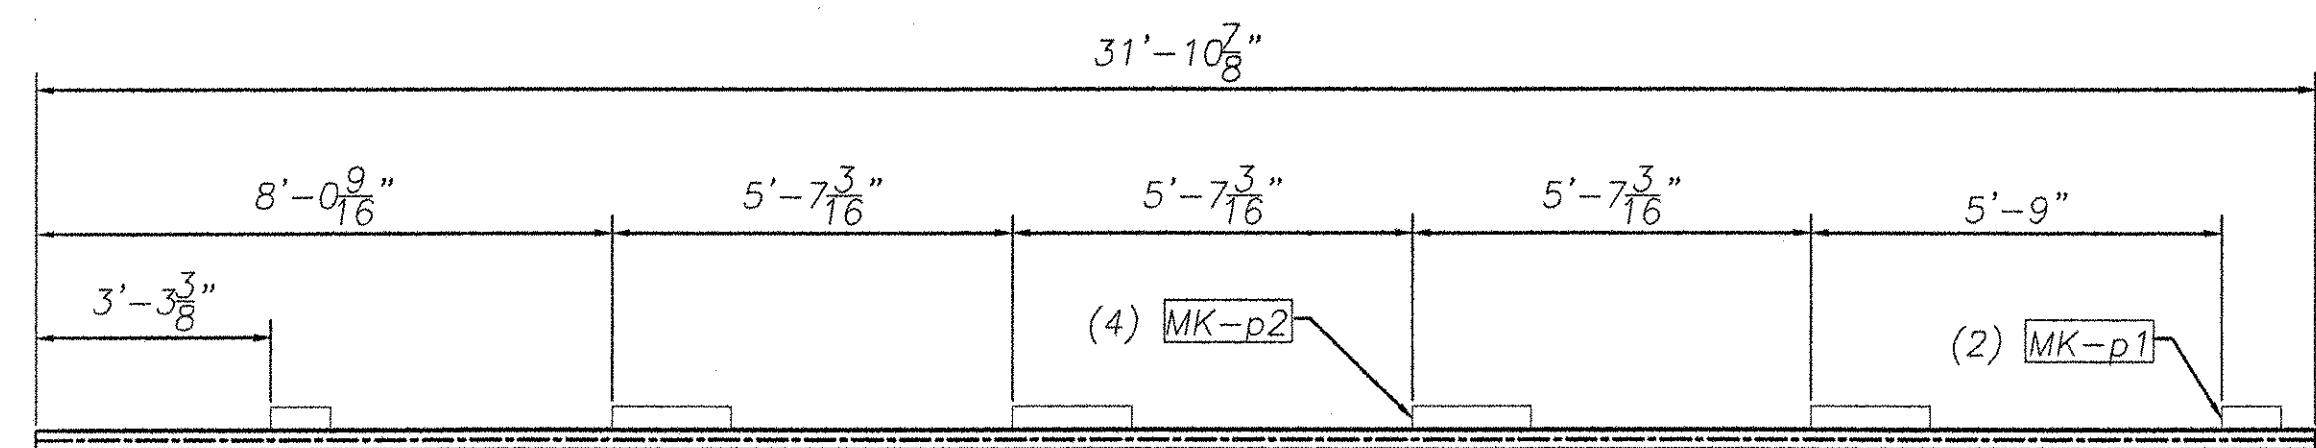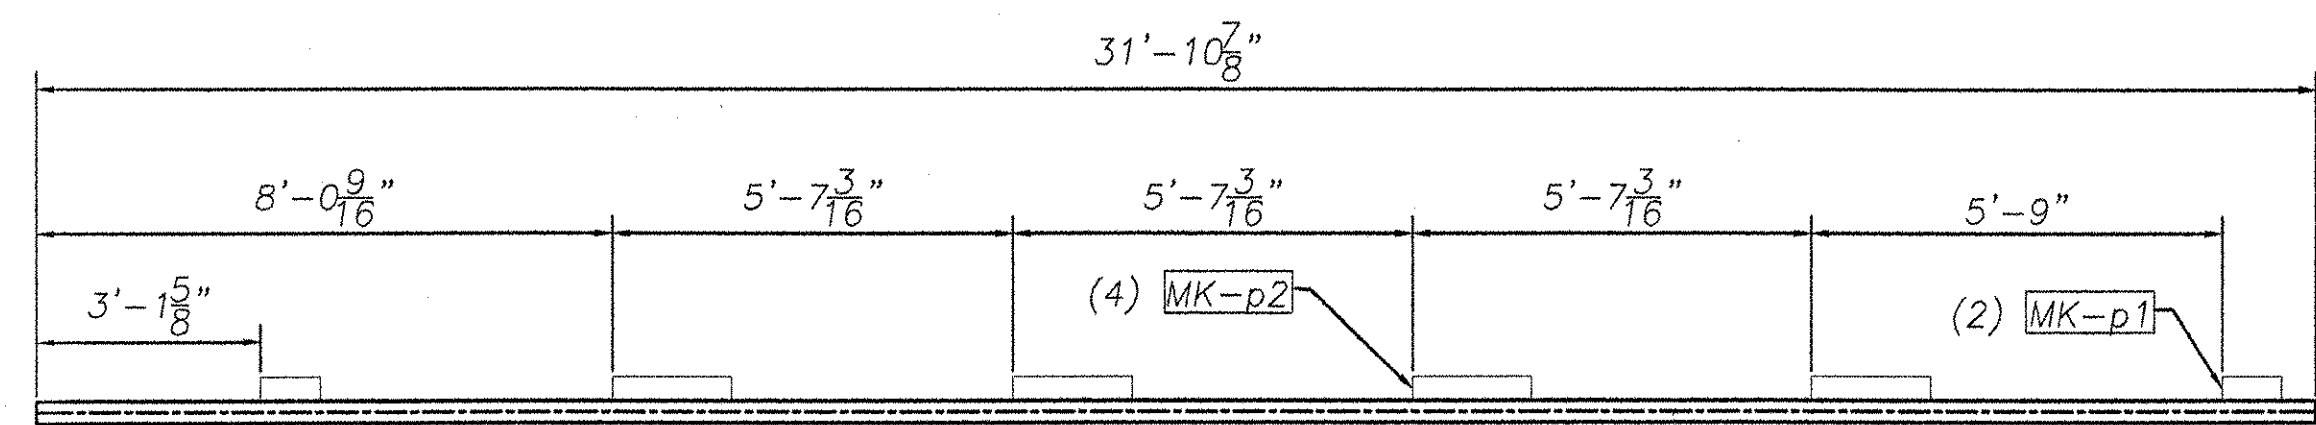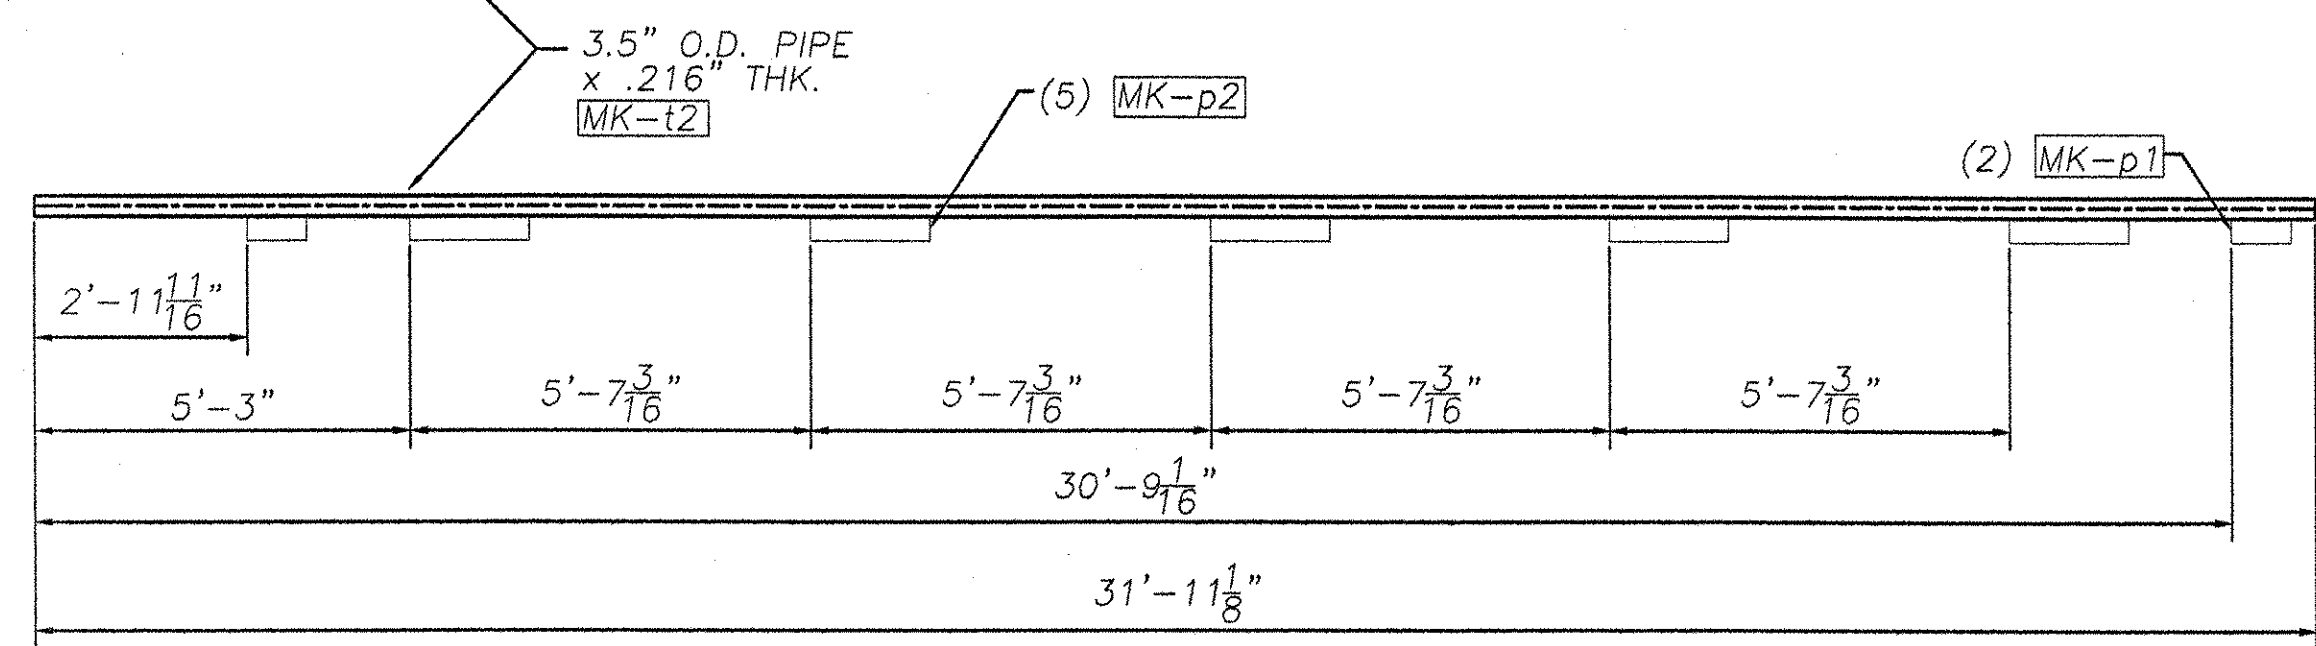

MK-RA3

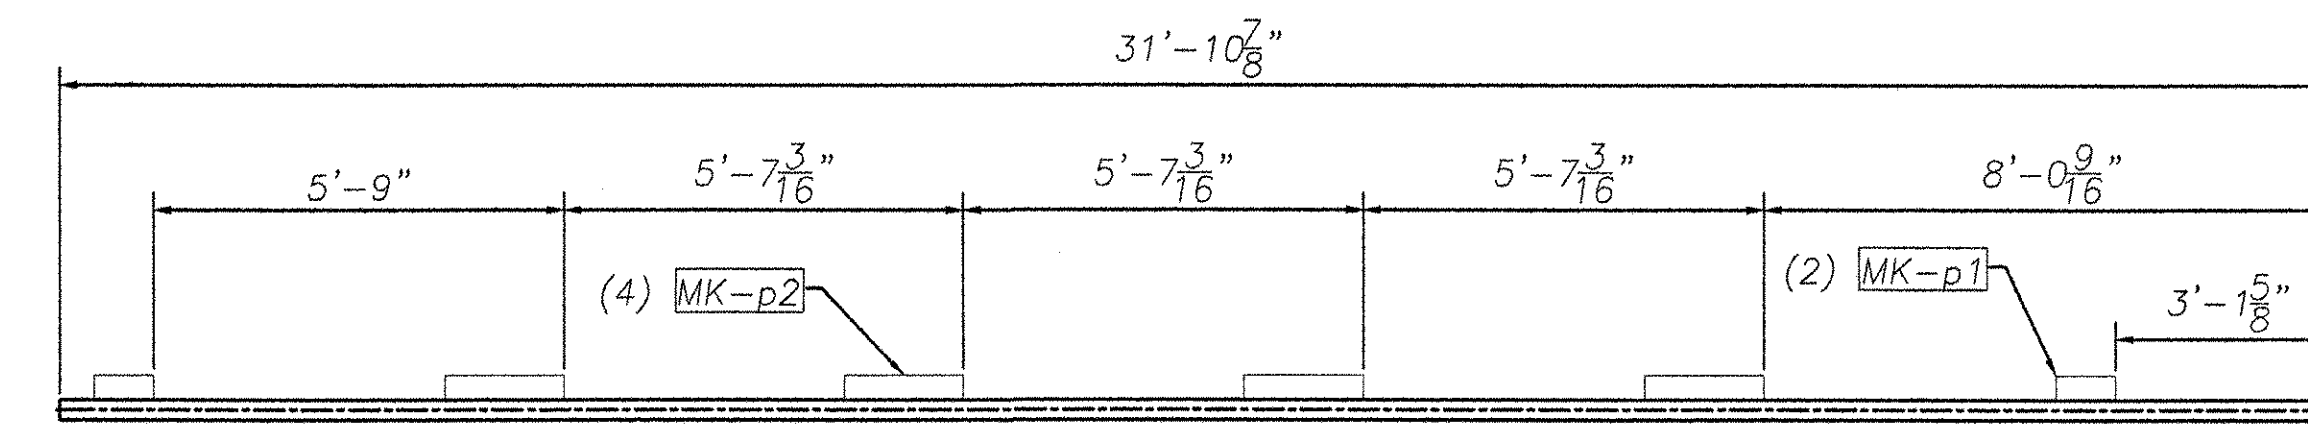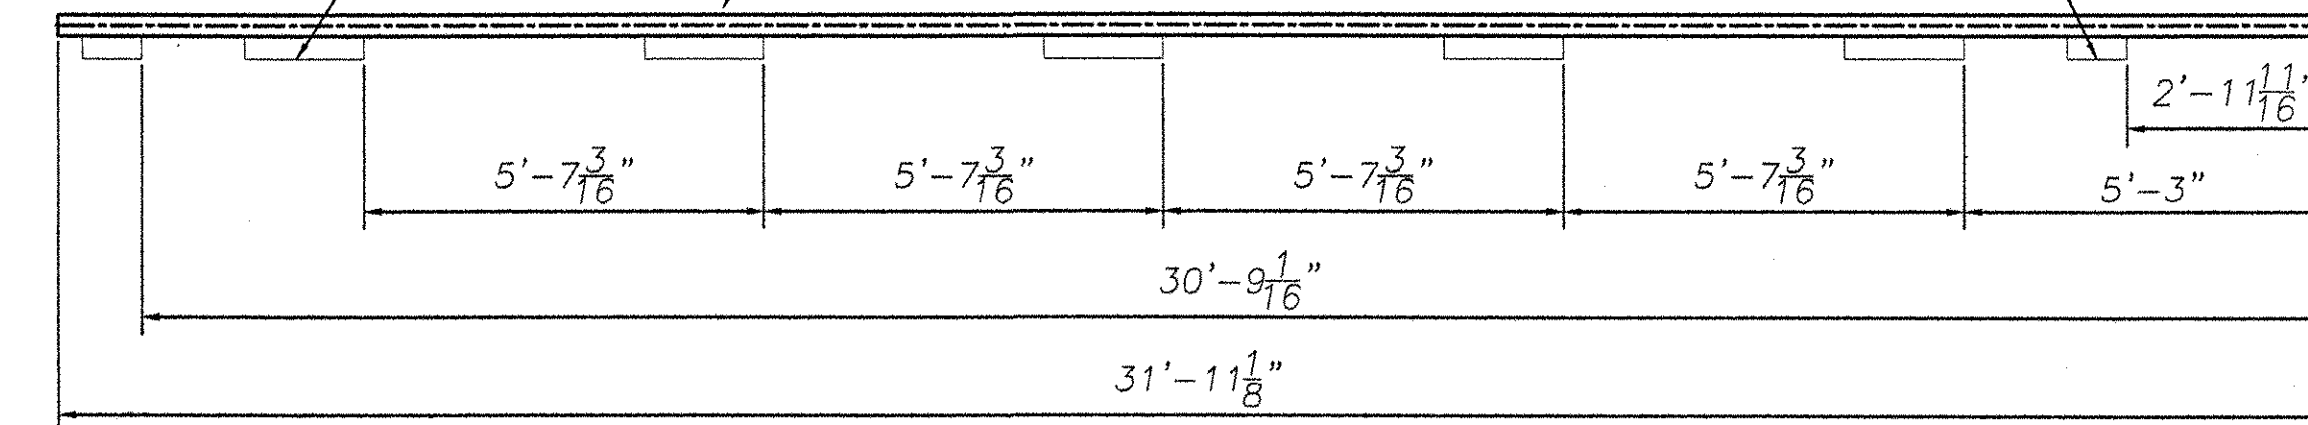

MK-RA6

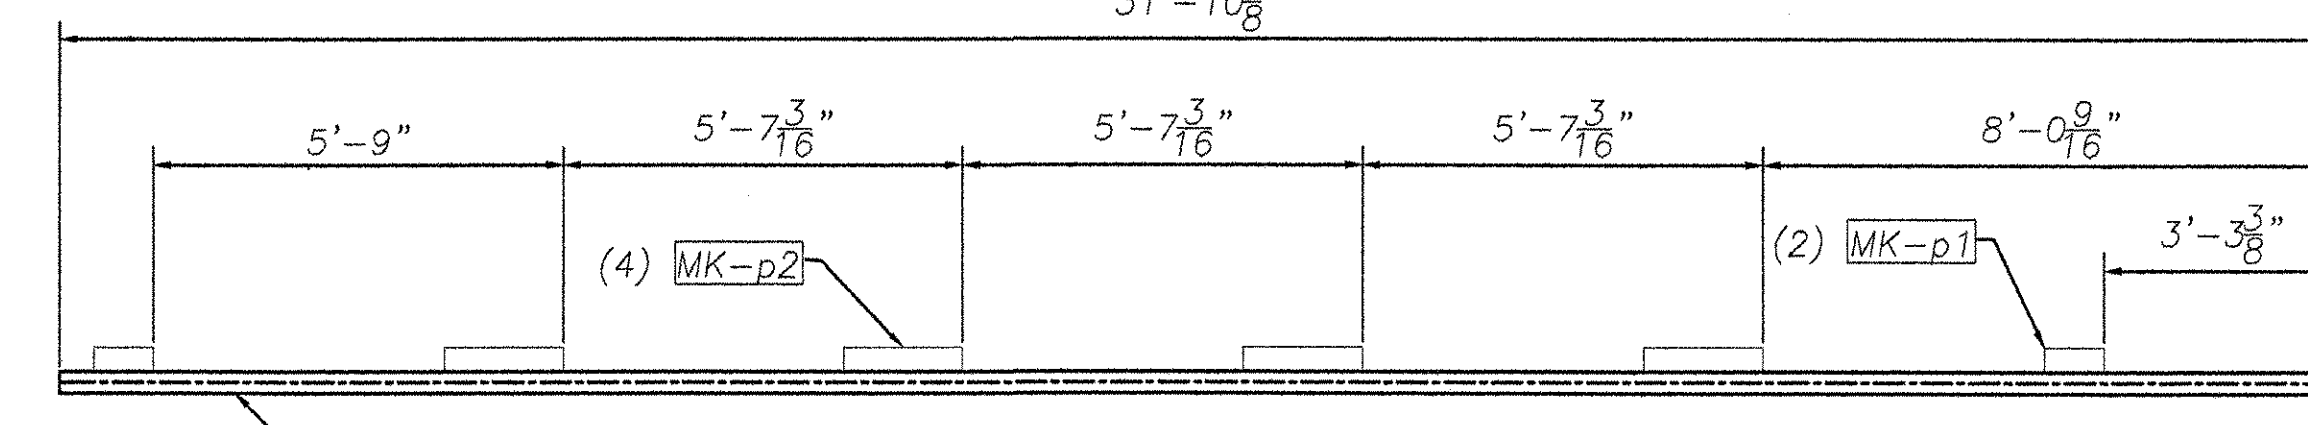


| REVISIONS | | |
|-----------|-------------------|------|
| No. | Remarks | Date |
| 0 | Initial submittal | |
| | | |
| | | |

PLF


HIGHWAY SAFETY CORP.
GLASTONBURY, CT

| | | |
|--|---|----------|
| GENERAL CONTRACTOR | SIZE | REVISION |
| SUB CONTRACTOR | D | 0 |
| TRI-CHORD SIGN STRUCTURE 1-89 EXIT 12 SB OFF RAMP CHITTENDEN COUNTY, VERMONT PROJECT No. IM 089-2(35) | DRAWN: MMH CHECKED: <i>[Signature]</i> DATE: 7/8/05 SCALE: NTS HSC REFERENCE NO.: 1515 SHEET NO.: 5 of 8 | |
| F.R. LAFAYETTE | | |




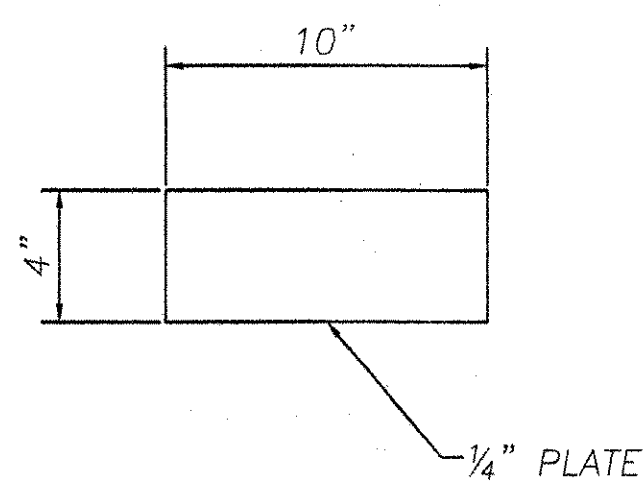


MK-p1

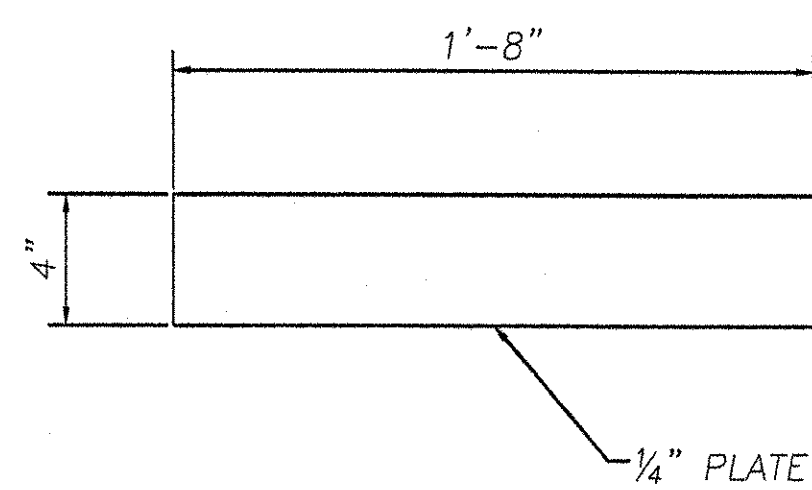


MK-p2

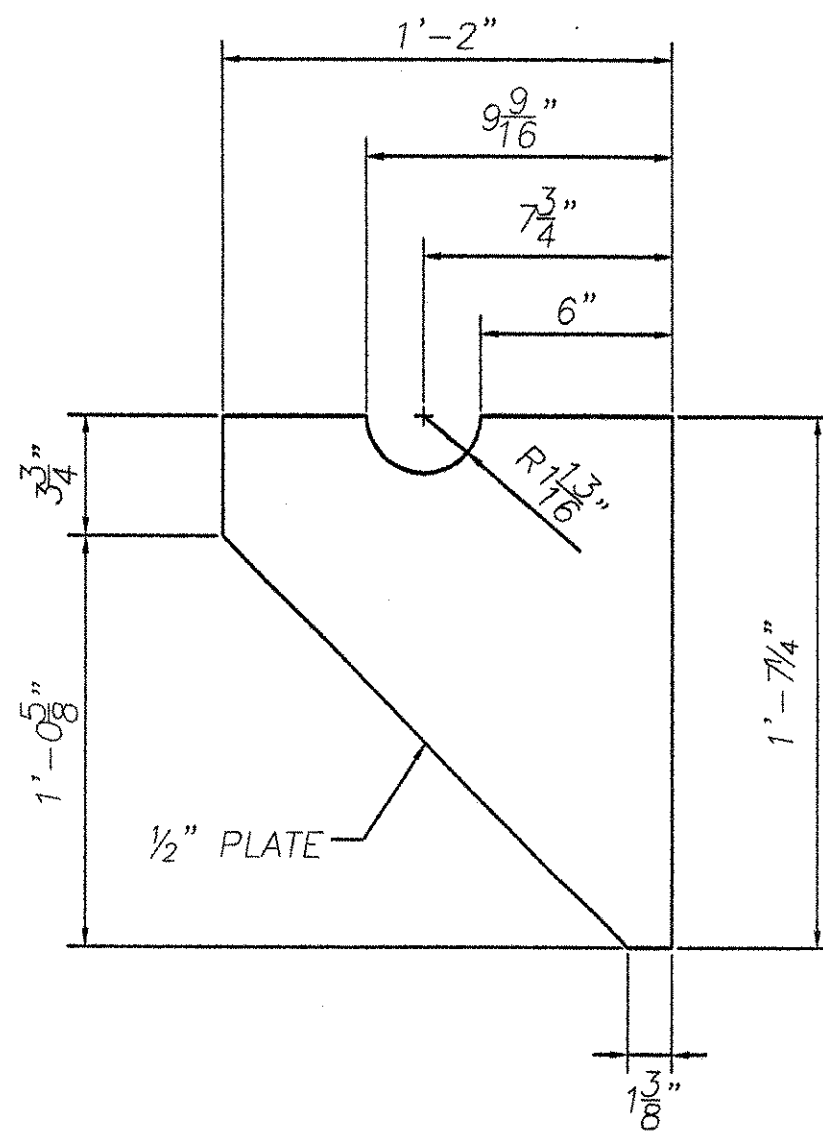


MK-p3

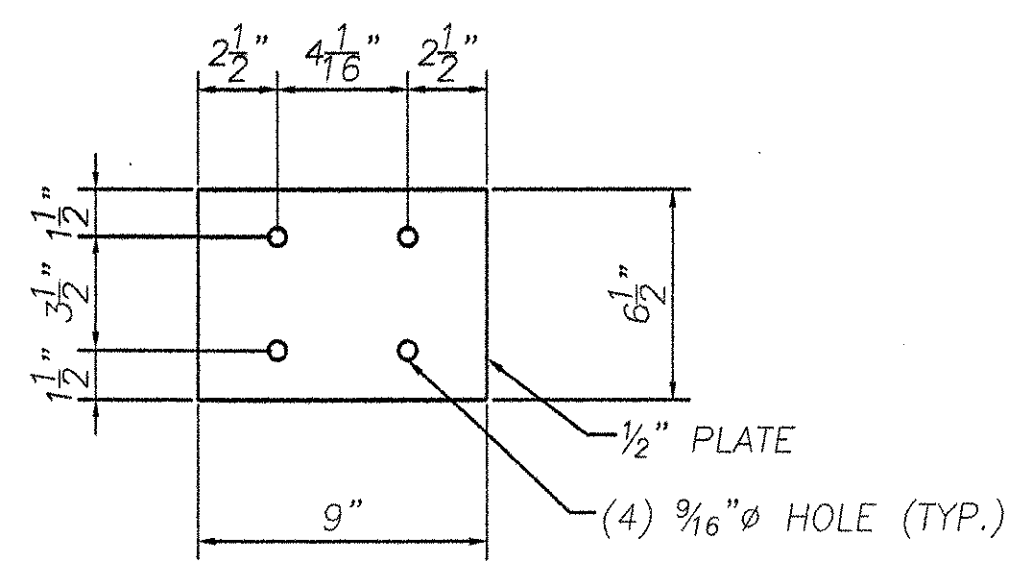


MK-p4

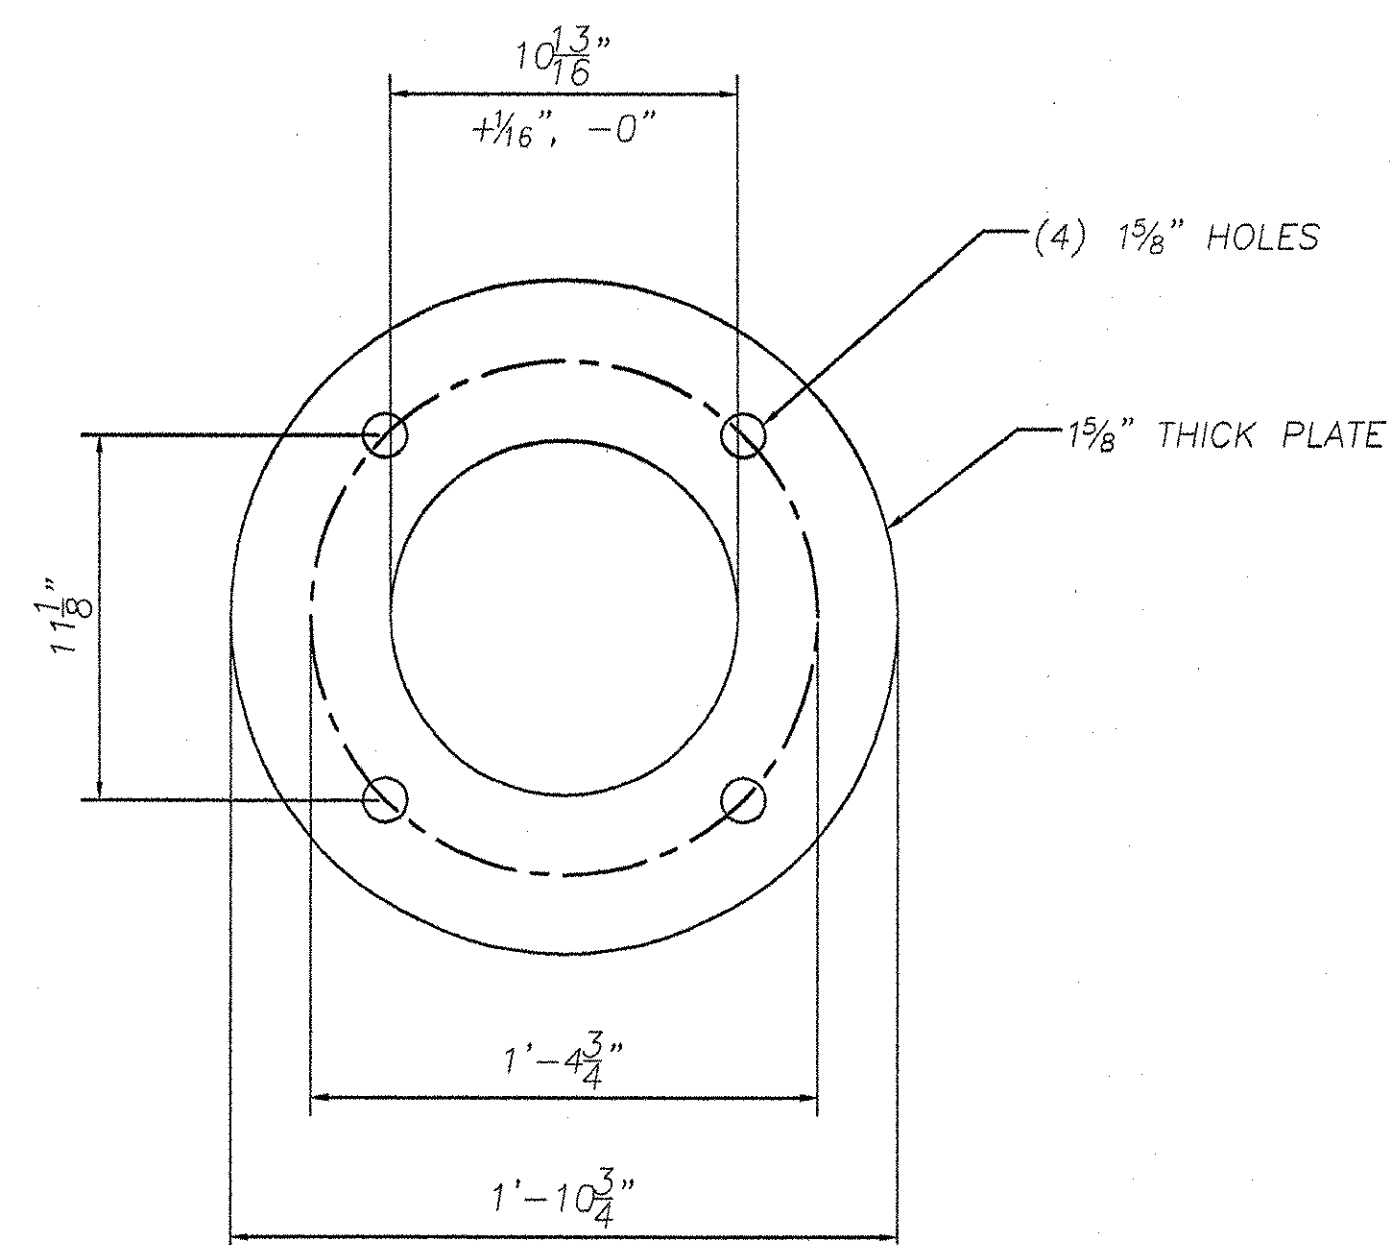


MK-bp

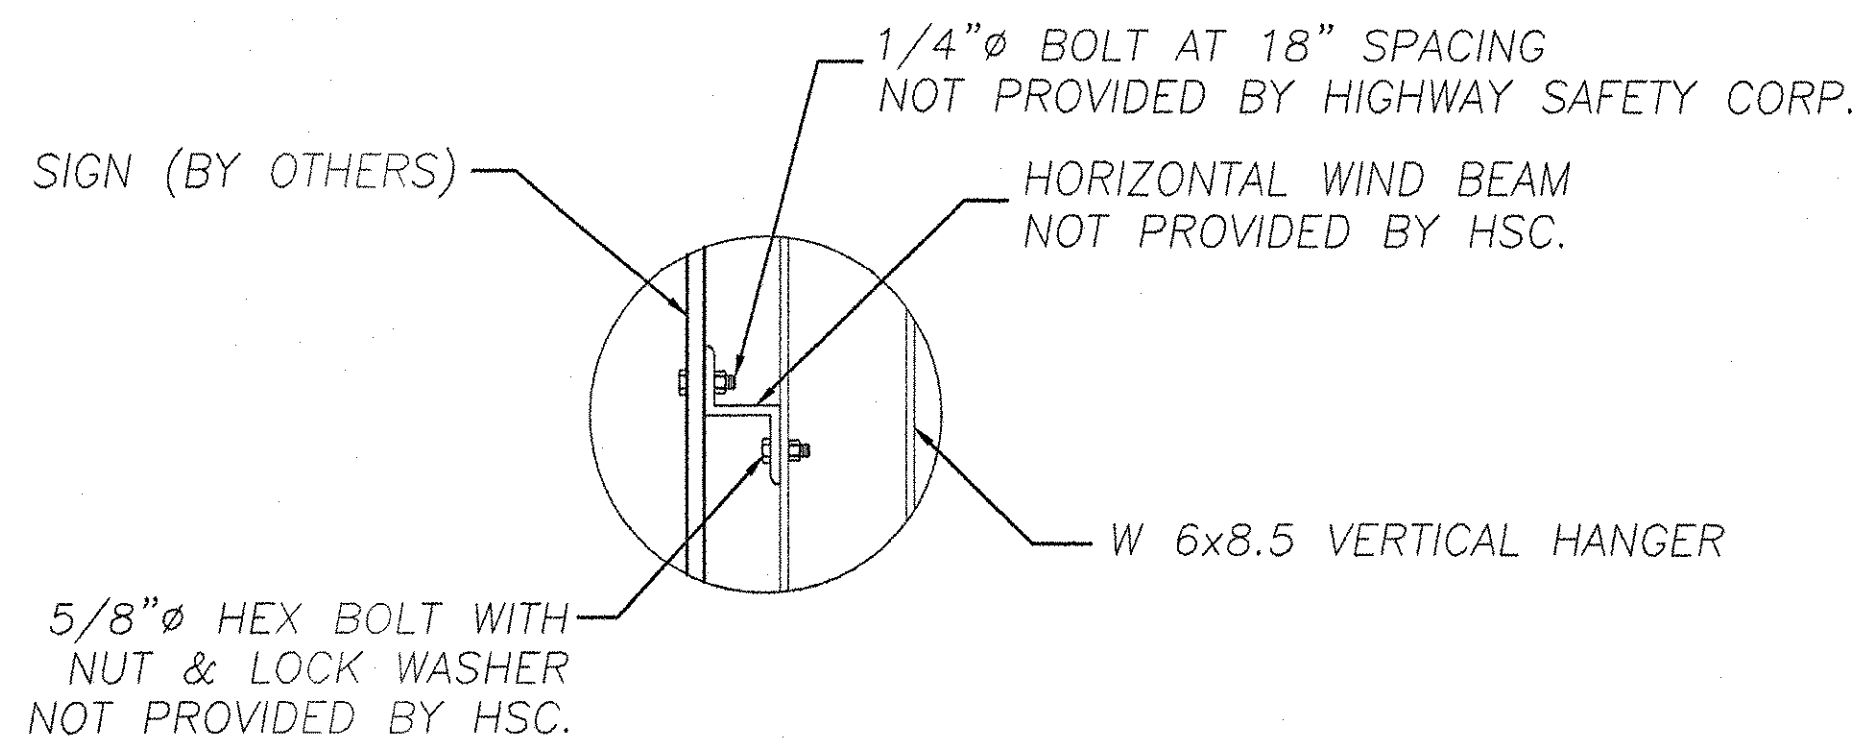


SIGN ATTACHMENT DETAIL

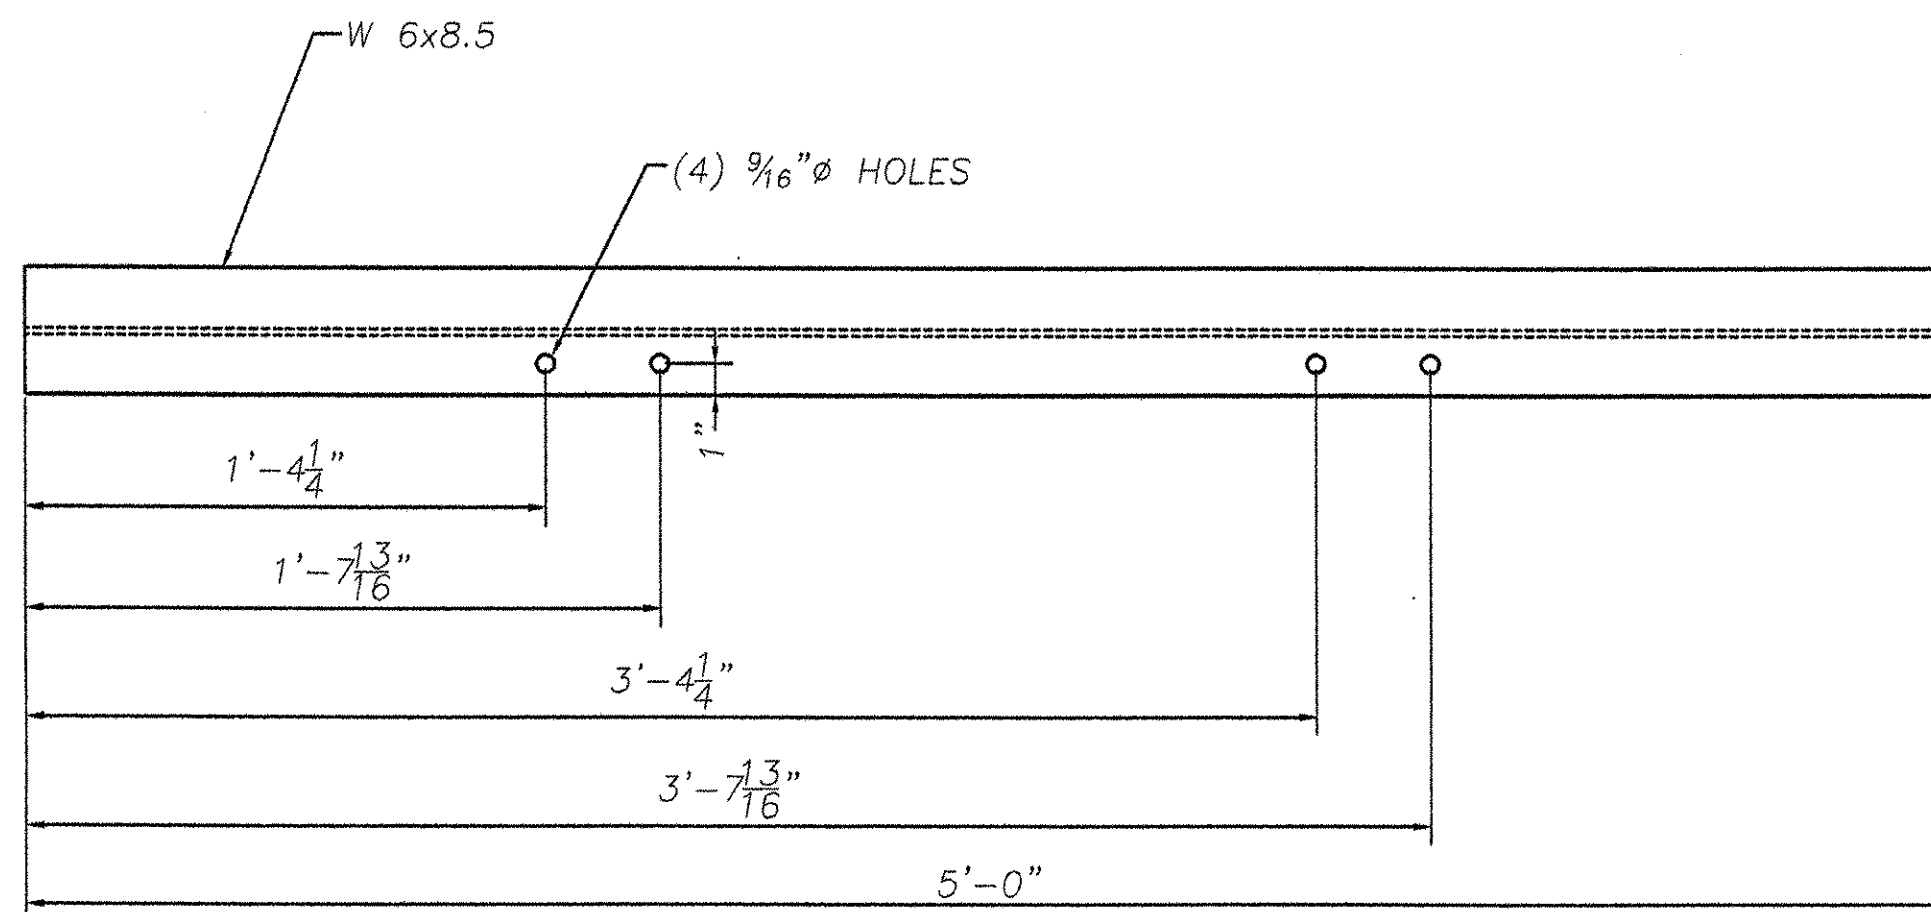

MK-vh

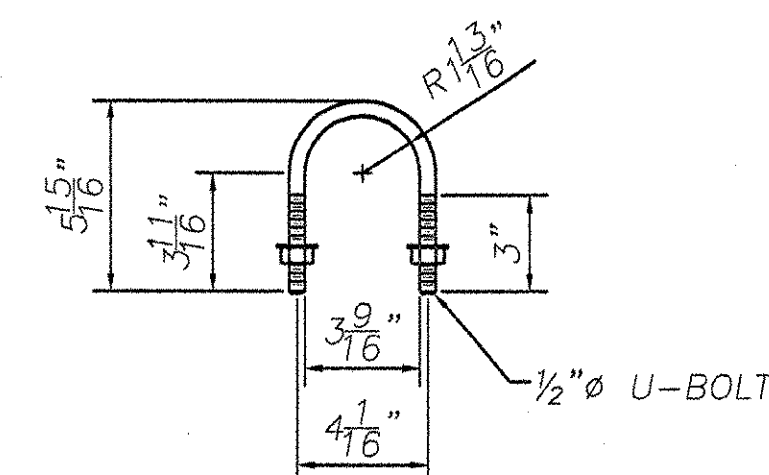


MK-u1

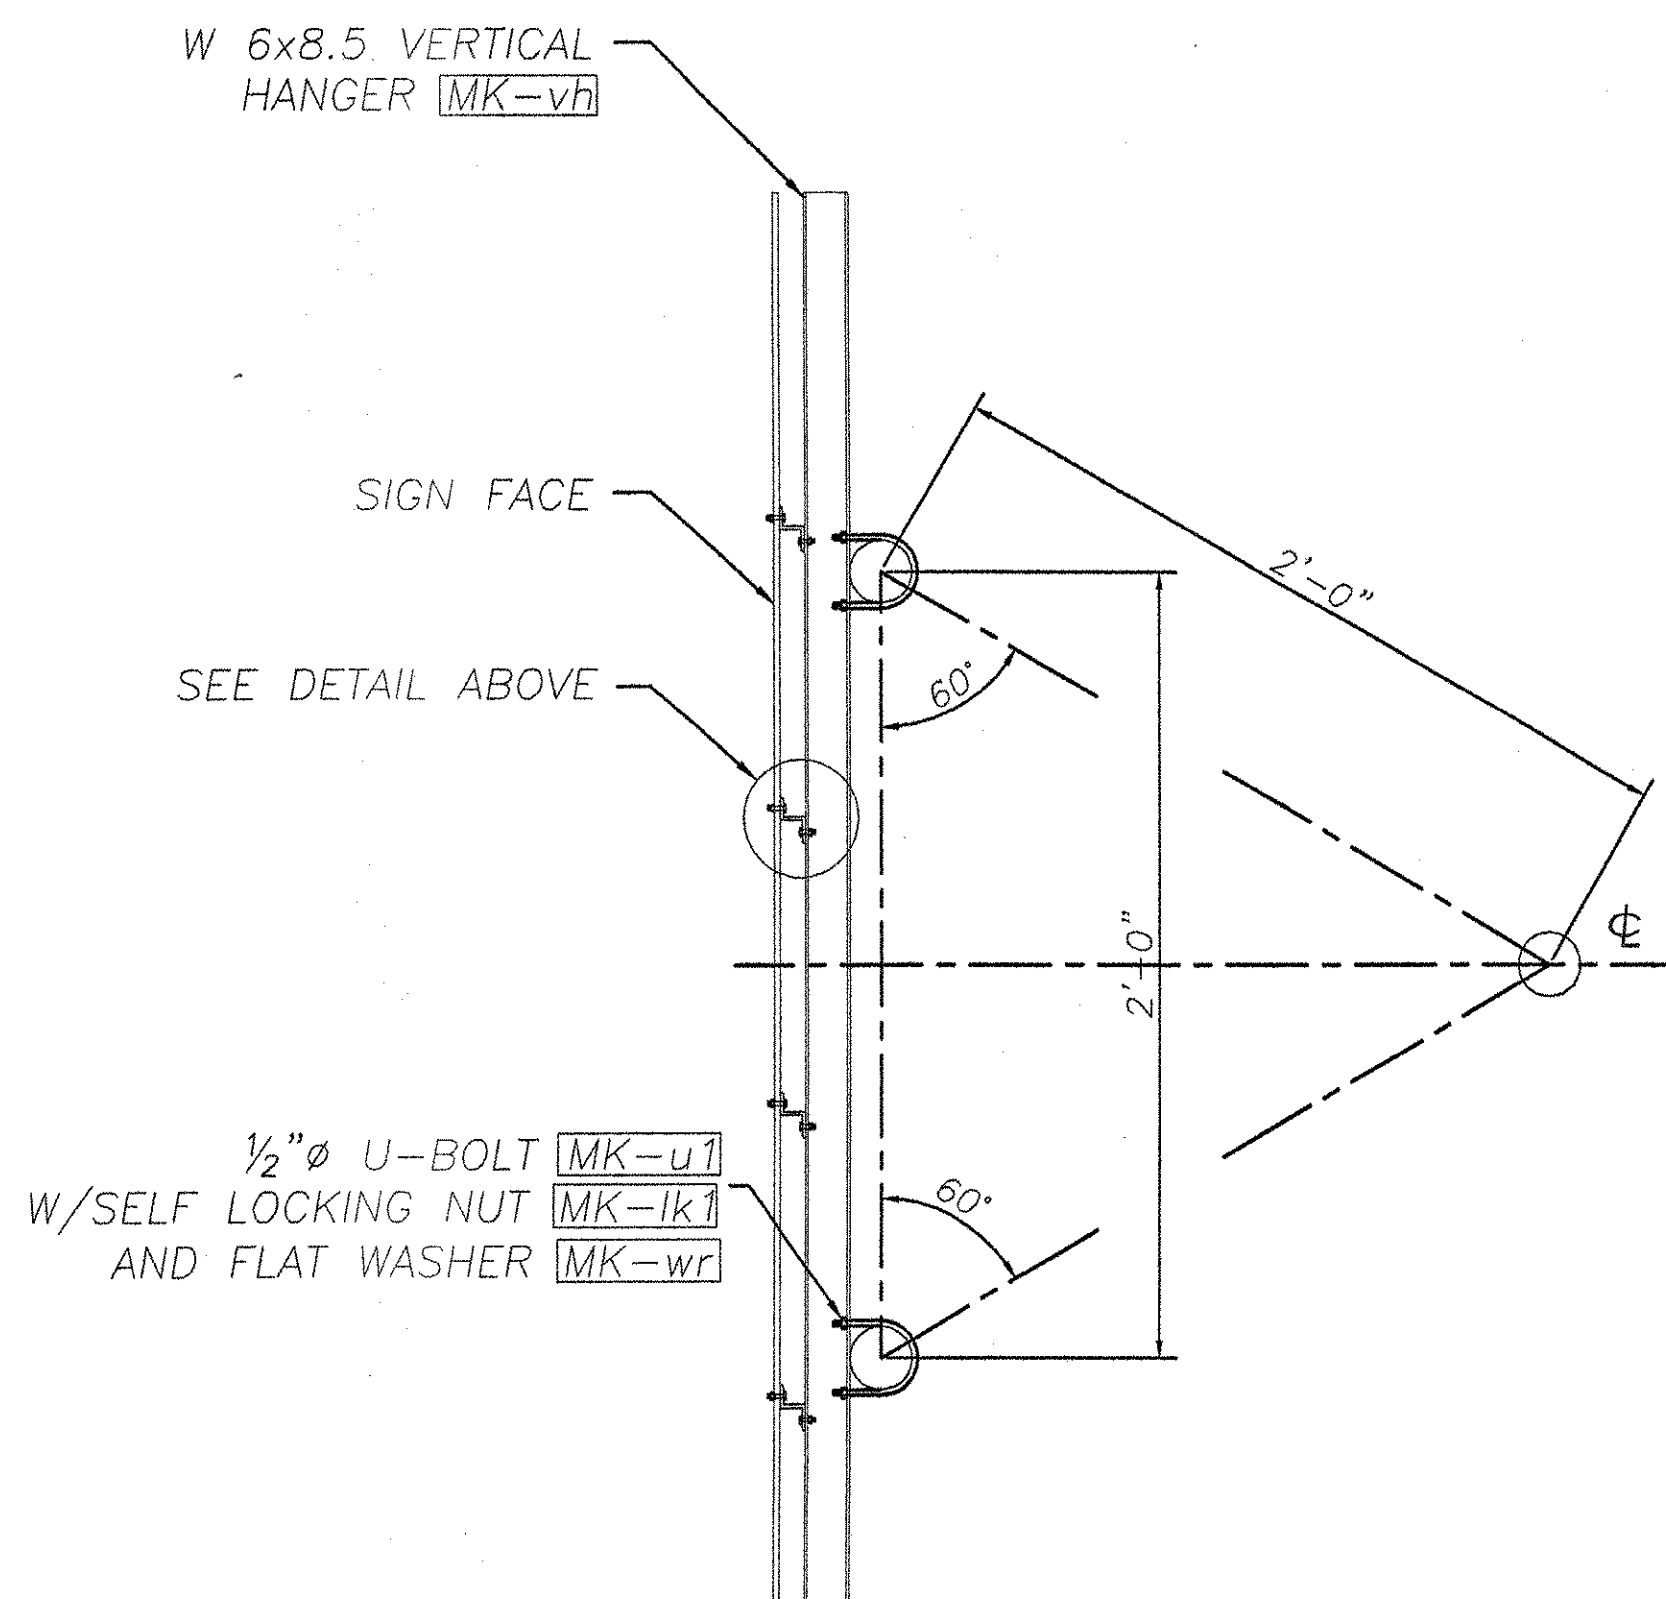

SIGN MOUNTING DETAIL

VERTICAL HANGER BEAMS & U-BOLTS INCLUDED

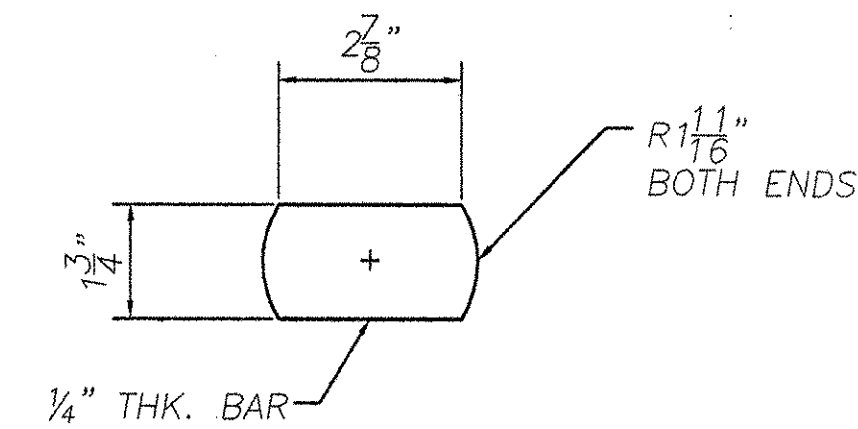

MK-br1



HIGHWAY SAFETY CORP.
GLASTONBURY, CT


TRI-CHORD SIGN STRUCTURE
I-89 EXIT 12 SB OFF RAMP
CHITTENDEN COUNTY, VERMONT
PROJECT No. IM 089-2(35)

GENERAL CONTRACTOR: F.R. LAFAYETTE
SUB CONTRACTOR: F.R. LAFAYETTE

DRAWN: MHM
CHECKED: [Signature]
DATE: 7/8/05
SCALE: NTS
HSC REFERENCE NO.: 1515
SIZE: D
REVISION: 0
SHEET NO.: 6 of 8

| REVISIONS | | |
|-----------|-------------------|------|
| No. | Remarks | Date |
| 0 | Initial submittal | |
| | | |
| | | |

F.R. Lafayette

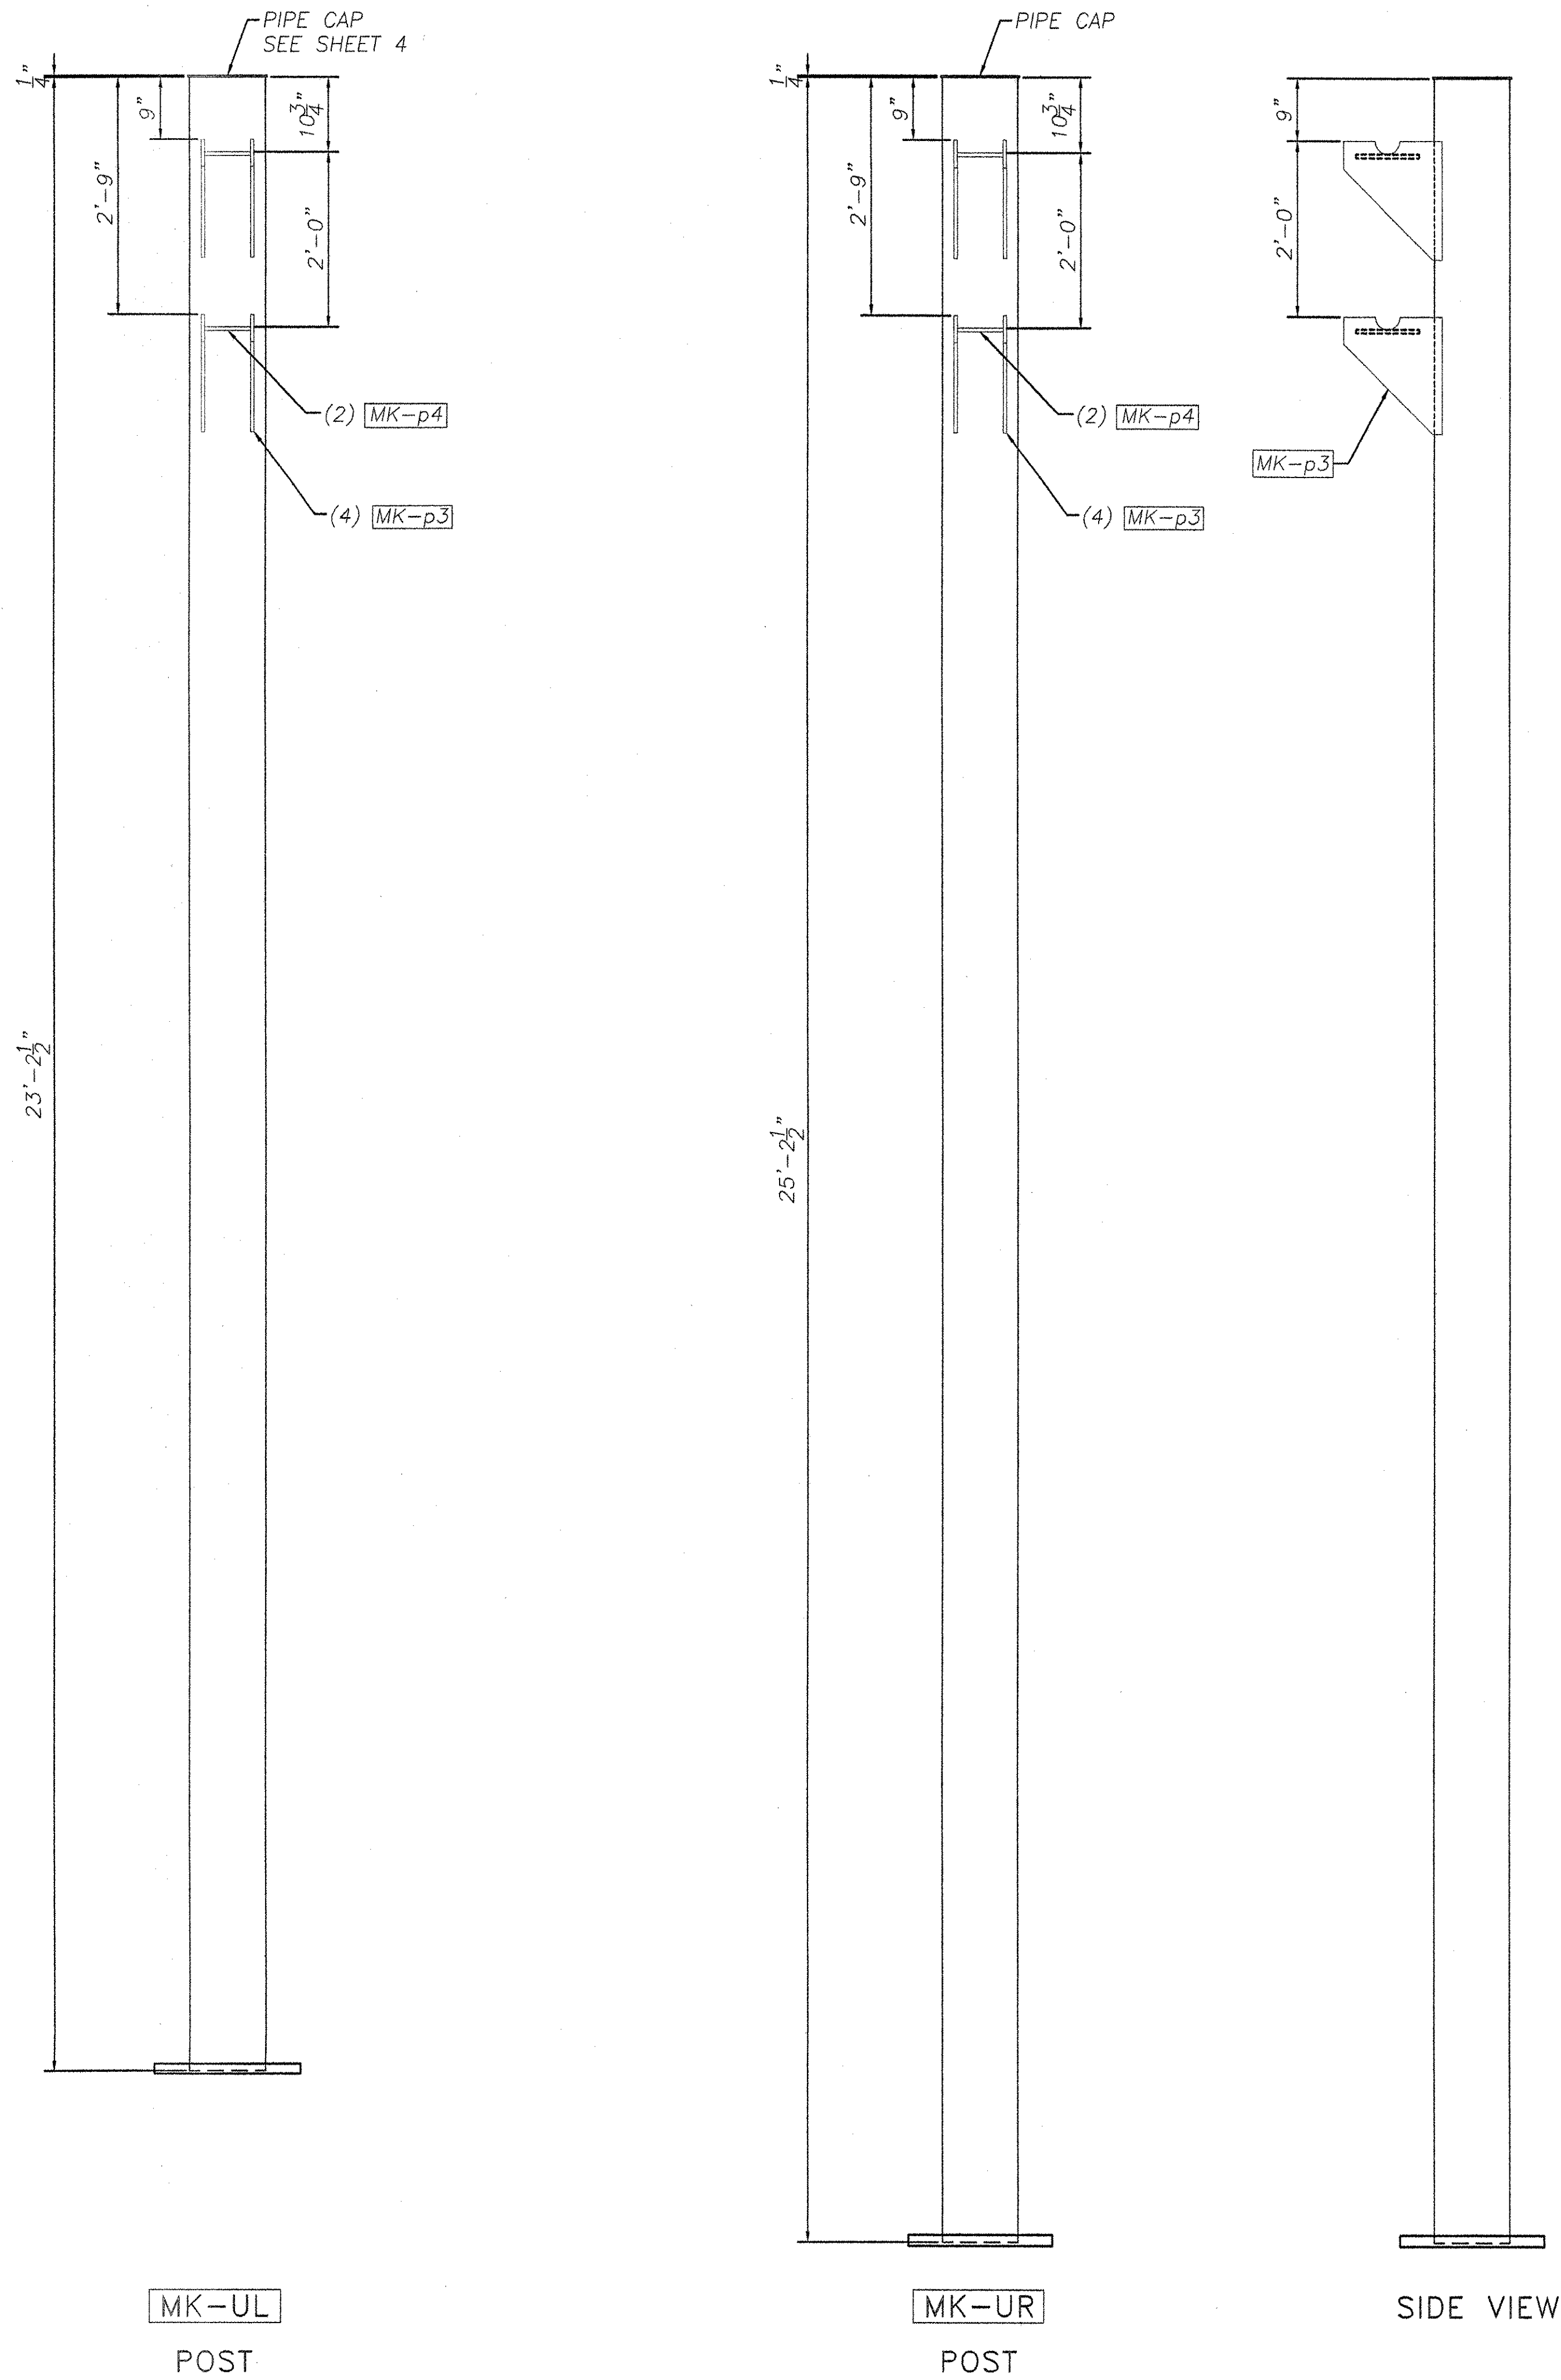

| ENGLISH BILL OF MATERIAL FOR REFERENCE ONLY | | | | | |
|---|-----|------|--|-------------|--------------------------|
| Mk. | Mk. | Qty. | Description | Length | Material |
| RA1,RA4 | | 2 | CHORD TRUSS ASSEMBLY | | |
| t1,14 | | 2 | CHORD PIPE 3.5" O.D. x .216" THICK | 27'-8.875" | A500 Gr. B |
| p1 | | 4 | TRUSS TO CHORD CONN. PLATE .250"x4" | 10" | A709 Gr. 50 |
| p2 | | 20 | TRUSS TO CHORD CONN. PLATE .250"x4" | 1'-8" | A709 Gr. 50 |
| s1 | | 2 | 0.5" THICK CHORD SPLICE PLATE | 9.5" DIA. | A709 Gr. 50 |
| br1 | | 2 | PLUG BAR .250"x1.750" | 2.875" | A709 Gr. 50 |
| RA2,RA5 | | 2 | CHORD TRUSS ASSEMBLY | | |
| t2,15 | | 2 | CHORD PIPE 3.5" O.D. x .216" THICK | 31'-11.125" | A500 Gr. B |
| p1 | | 8 | TRUSS TO POST CONN. PLATE .250"x4" | 10" | A709 Gr. 50 |
| p2 | | 18 | TRUSS TO POST CONN. PLATE .250"x4" | 1'-8" | A709 Gr. 50 |
| s1 | | 2 | 0.5" THICK CHORD SPLICE PLATE | 9.5" DIA. | A709 Gr. 50 |
| br1 | | 2 | PLUG BAR .250"x1.750" | 2.875" | A709 Gr. 50 |
| RA3,RA6 | | 2 | CHORD TRUSS ASSEMBLY | | |
| t3,16 | | 2 | CHORD PIPE 3.5" O.D. x .216" THICK | 31'-10.875" | A500 Gr. B |
| p1 | | 8 | TRUSS TO POST CONN. PLATE .250"x4" | 10" | A709 Gr. 50 |
| p2 | | 16 | TRUSS TO POST CONN. PLATE .250"x4" | 1'-8" | A709 Gr. 50 |
| s1 | | 2 | 0.5" THICK CHORD SPLICE PLATE | 9.5" DIA. | A709 Gr. 50 |
| br1 | | 2 | PLUG BAR .250"x1.750" | 2.875" | A709 Gr. 50 |
| a1 | | 40 | L 2x2x1/4" | 2'-5" | A709 Gr. 36 |
| a2 | | 4 | L 2x2x1/4" | 1'-6.50" | A709 Gr. 36 |
| a3 | | 4 | L 2x2x1/4" | 1'-6.5" | A709 Gr. 36 |
| a4 | | 20 | L 2x2x1/4" | 2'-5" | A709 Gr. 36 |
| t1 | | 12 | .750" HEX BOLT | 2.5" | A325 |
| n1 | | 12 | .750" HEX NUT | --- | A563DH |
| w1 | | 12 | .750" FLAT WASHER | --- | F436 |
| UL | | 1 | LEFT POST ASSEMBLY | | |
| | | 1 | UPRIGHT PIPE 10.75" O.D. x .365" THICK | 23'-2.50" | A500 Gr. B |
| p3 | | 4 | TRUSS TO POST CONN. PLATE .50"x1'-2" | 1'-7.25" | A709 Gr. 50 |
| p4 | | 2 | TRUSS TO POST CONN. PLATE .50"x6.50" | 9" | A709 Gr. 50 |
| u1 | | 4 | .50" U-BOLT | 5.938" | F1554 Gr 36 |
| lk1 | | 8 | .50" SELF LOCKING HEX NUT | --- | A563DH |
| wr | | 8 | .50" FLAT WASHER | --- | F436 |
| | | 1 | POST CAP | | |
| br2 | | 1 | L1 1/2x1 1/2x1/4" | 10" | A709 Gr. 36 |
| cp | | 1 | .25" THICK END CAP PLATE | 11.25" | A709 Gr. 36 |
| t2 | | 1 | .50" HEX BOLT | 1.5" | A307 |
| nt | | 1 | .50" HEX NUT | --- | A563 |
| rw | | 1 | .50" RUBBER WASHER | --- | 50 DURO. NEOPRENE |
| gt | | 1 | .125" THICK NEOPRENE GASKET | 11.25" | 50 DURO. NEOPRENE |
| | | 1 | BASE PLATE ASSEMBLY | | |
| bp | | 1 | 1 5/8" THICK BASE PLATE | 1'-8.75" | A709 Gr. 50 |
| an1 | | 4 | 1.5" ANCHOR BOLT | 5'-0" | STAINLESS STEEL TYPE 304 |
| w2 | | 4 | 1.5" WASHER | --- | STAINLESS STEEL TYPE 304 |
| nl2 | | 8 | 1.5" HEAVY HEX NUT | --- | M292 Gr B |
| lk2 | | 4 | 1.5" LOCK WASHER | --- | STAINLESS STEEL TYPE 304 |
| UR | | 1 | RIGHT POST ASSEMBLY | | |
| | | 1 | UPRIGHT PIPE 10.75" O.D. x .365" THICK | 25'-2.50" | A500 Gr. B |
| p3 | | 4 | TRUSS TO POST CONN. PLATE .50"x1'-2" | 1'-7.25" | A709 Gr. 50 |
| p4 | | 2 | TRUSS TO POST CONN. PLATE .50"x6.50" | 9" | A709 Gr. 50 |
| u1 | | 4 | .50" U-BOLT | 5.938" | F1554 Gr 36 |
| lk1 | | 8 | .50" SELF LOCKING HEX NUT | --- | A563DH |
| wr | | 8 | .50" FLAT WASHER | --- | F436 |
| | | 1 | POST CAP | | |
| br2 | | 1 | L1 1/2x1 1/2x1/4" | 10" | A709 Gr. 36 |
| cp | | 1 | .25" THICK END CAP PLATE | 11.25" | A709 Gr. 36 |
| t2 | | 1 | .50" HEX BOLT | 1.5" | A307 |
| nt | | 1 | .50" HEX NUT | --- | A563 |
| rw | | 1 | .50" RUBBER WASHER | --- | 50 DURO. NEOPRENE |
| gt | | 1 | .125" THICK NEOPRENE GASKET | 11.25" | 50 DURO. NEOPRENE |
| | | 1 | BASE PLATE ASSEMBLY | | |
| bp | | 1 | 1 5/8" THICK BASE PLATE | 1'-8.75" | A709 Gr. 50 |
| an1 | | 4 | 1.5" ANCHOR BOLT | 5'-0" | STAINLESS STEEL TYPE 304 |
| w2 | | 4 | 1.5" WASHER | --- | STAINLESS STEEL TYPE 304 |
| nl2 | | 8 | 1.5" HEAVY HEX NUT | --- | M292 Gr B |
| lk2 | | 4 | 1.5" LOCK WASHER | --- | STAINLESS STEEL TYPE 304 |
| | | 1 | SIGN ASSEMBLY | | |
| vh | | 6 | W6x8.5 VERTICAL SIGN HANGER | 5'-0" | A709 Gr. 36 |
| u1 | | 12 | .50" U-BOLT | 5.938" | F1554 Gr 36 |
| lk1 | | 24 | .50" SELF LOCKING HEX NUT | --- | A563DH |
| wr | | 24 | .50" FLAT WASHER | --- | F436 |




HIGHWAY SAFETY CORP.
GLASTONBURY, CT

TRI-CHORD SIGN STRUCTURE
I-89 EXIT 12 SB OFF RAMP
CHITTENDEN COUNTY, VERMONT
PROJECT No. IM 089-2(35)

DRAWN: MHM
CHECKED: [Signature]
DATE: 7/8/05
SCALE: N.T.S.
HSC REFERENCE NO.: 1515
GENERAL CONTRACTOR: [Signature]
SUB CONTRACTOR: F.R. LAFAYETTE
SHEET NO.: 7 of 8

| REVISIONS | | |
|-----------|-------------------|------|
| No. | Remarks | Date |
| 0 | Initial submittal | |

[Handwritten signature]

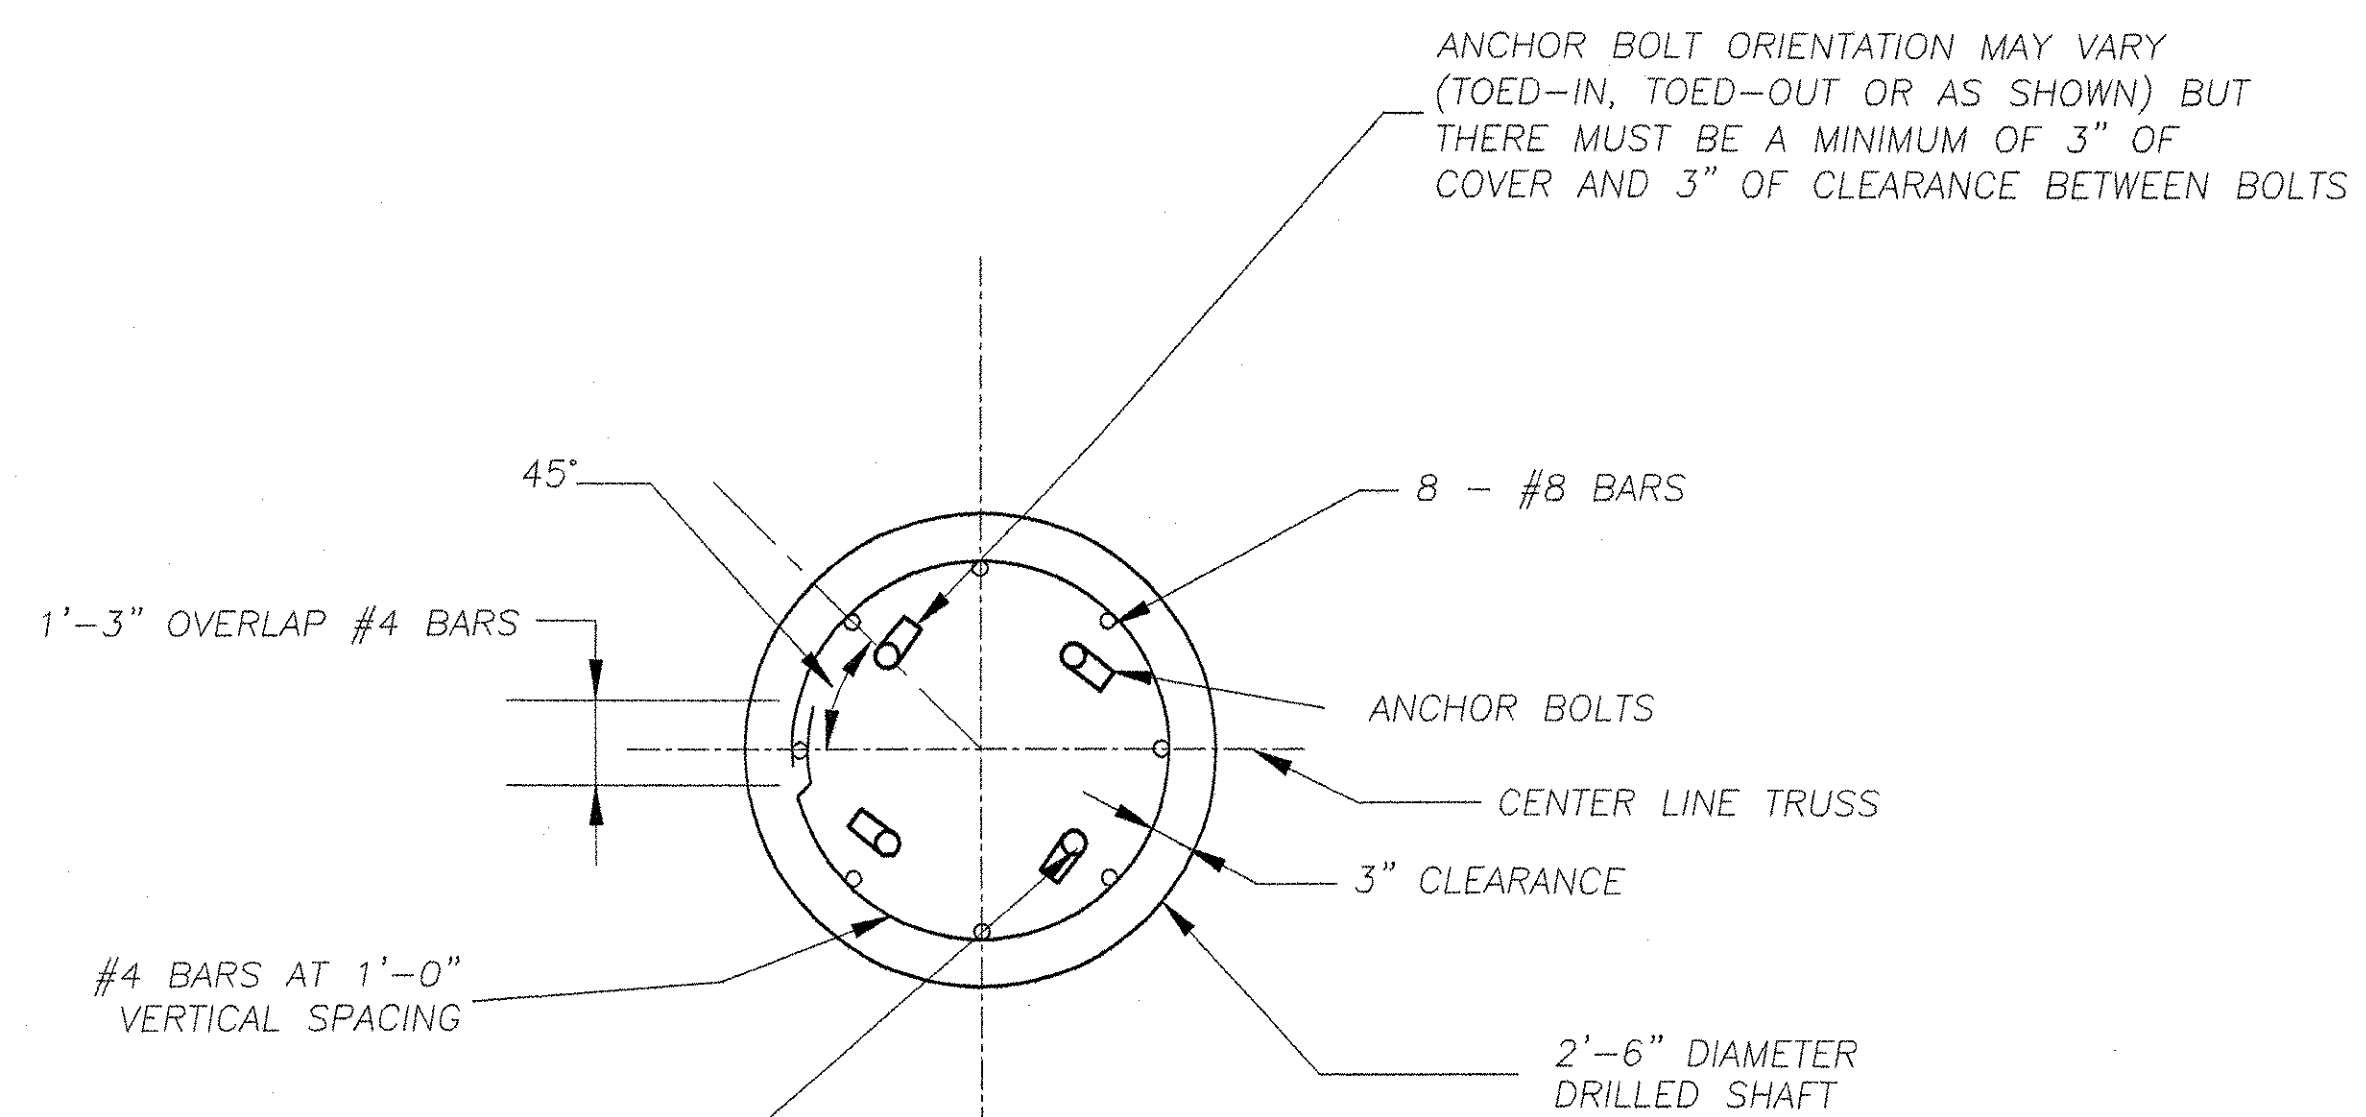


POSITION ANCHOR BOLTS TO ALLOW MINIMUM CLEARANCE OF 1-1/2" TO NEAREST REINFORCING STEEL SEE SECTION FOR ANCHOR BOLT LOCATION SHEET 4 OF 8

DRILLED SHAFT SECTION

NOTES:

DESIGN CRITERIA ARE AS FOLLOWS:
 CONCRETE $f_c=1400$ psi $f'_c=3500$ psi
 REINFORCING $f_s=24000$ PSI (GRADE 60)
 FOOTING SOIL PRESSURE: 3000 PSF (MAXIMUM)

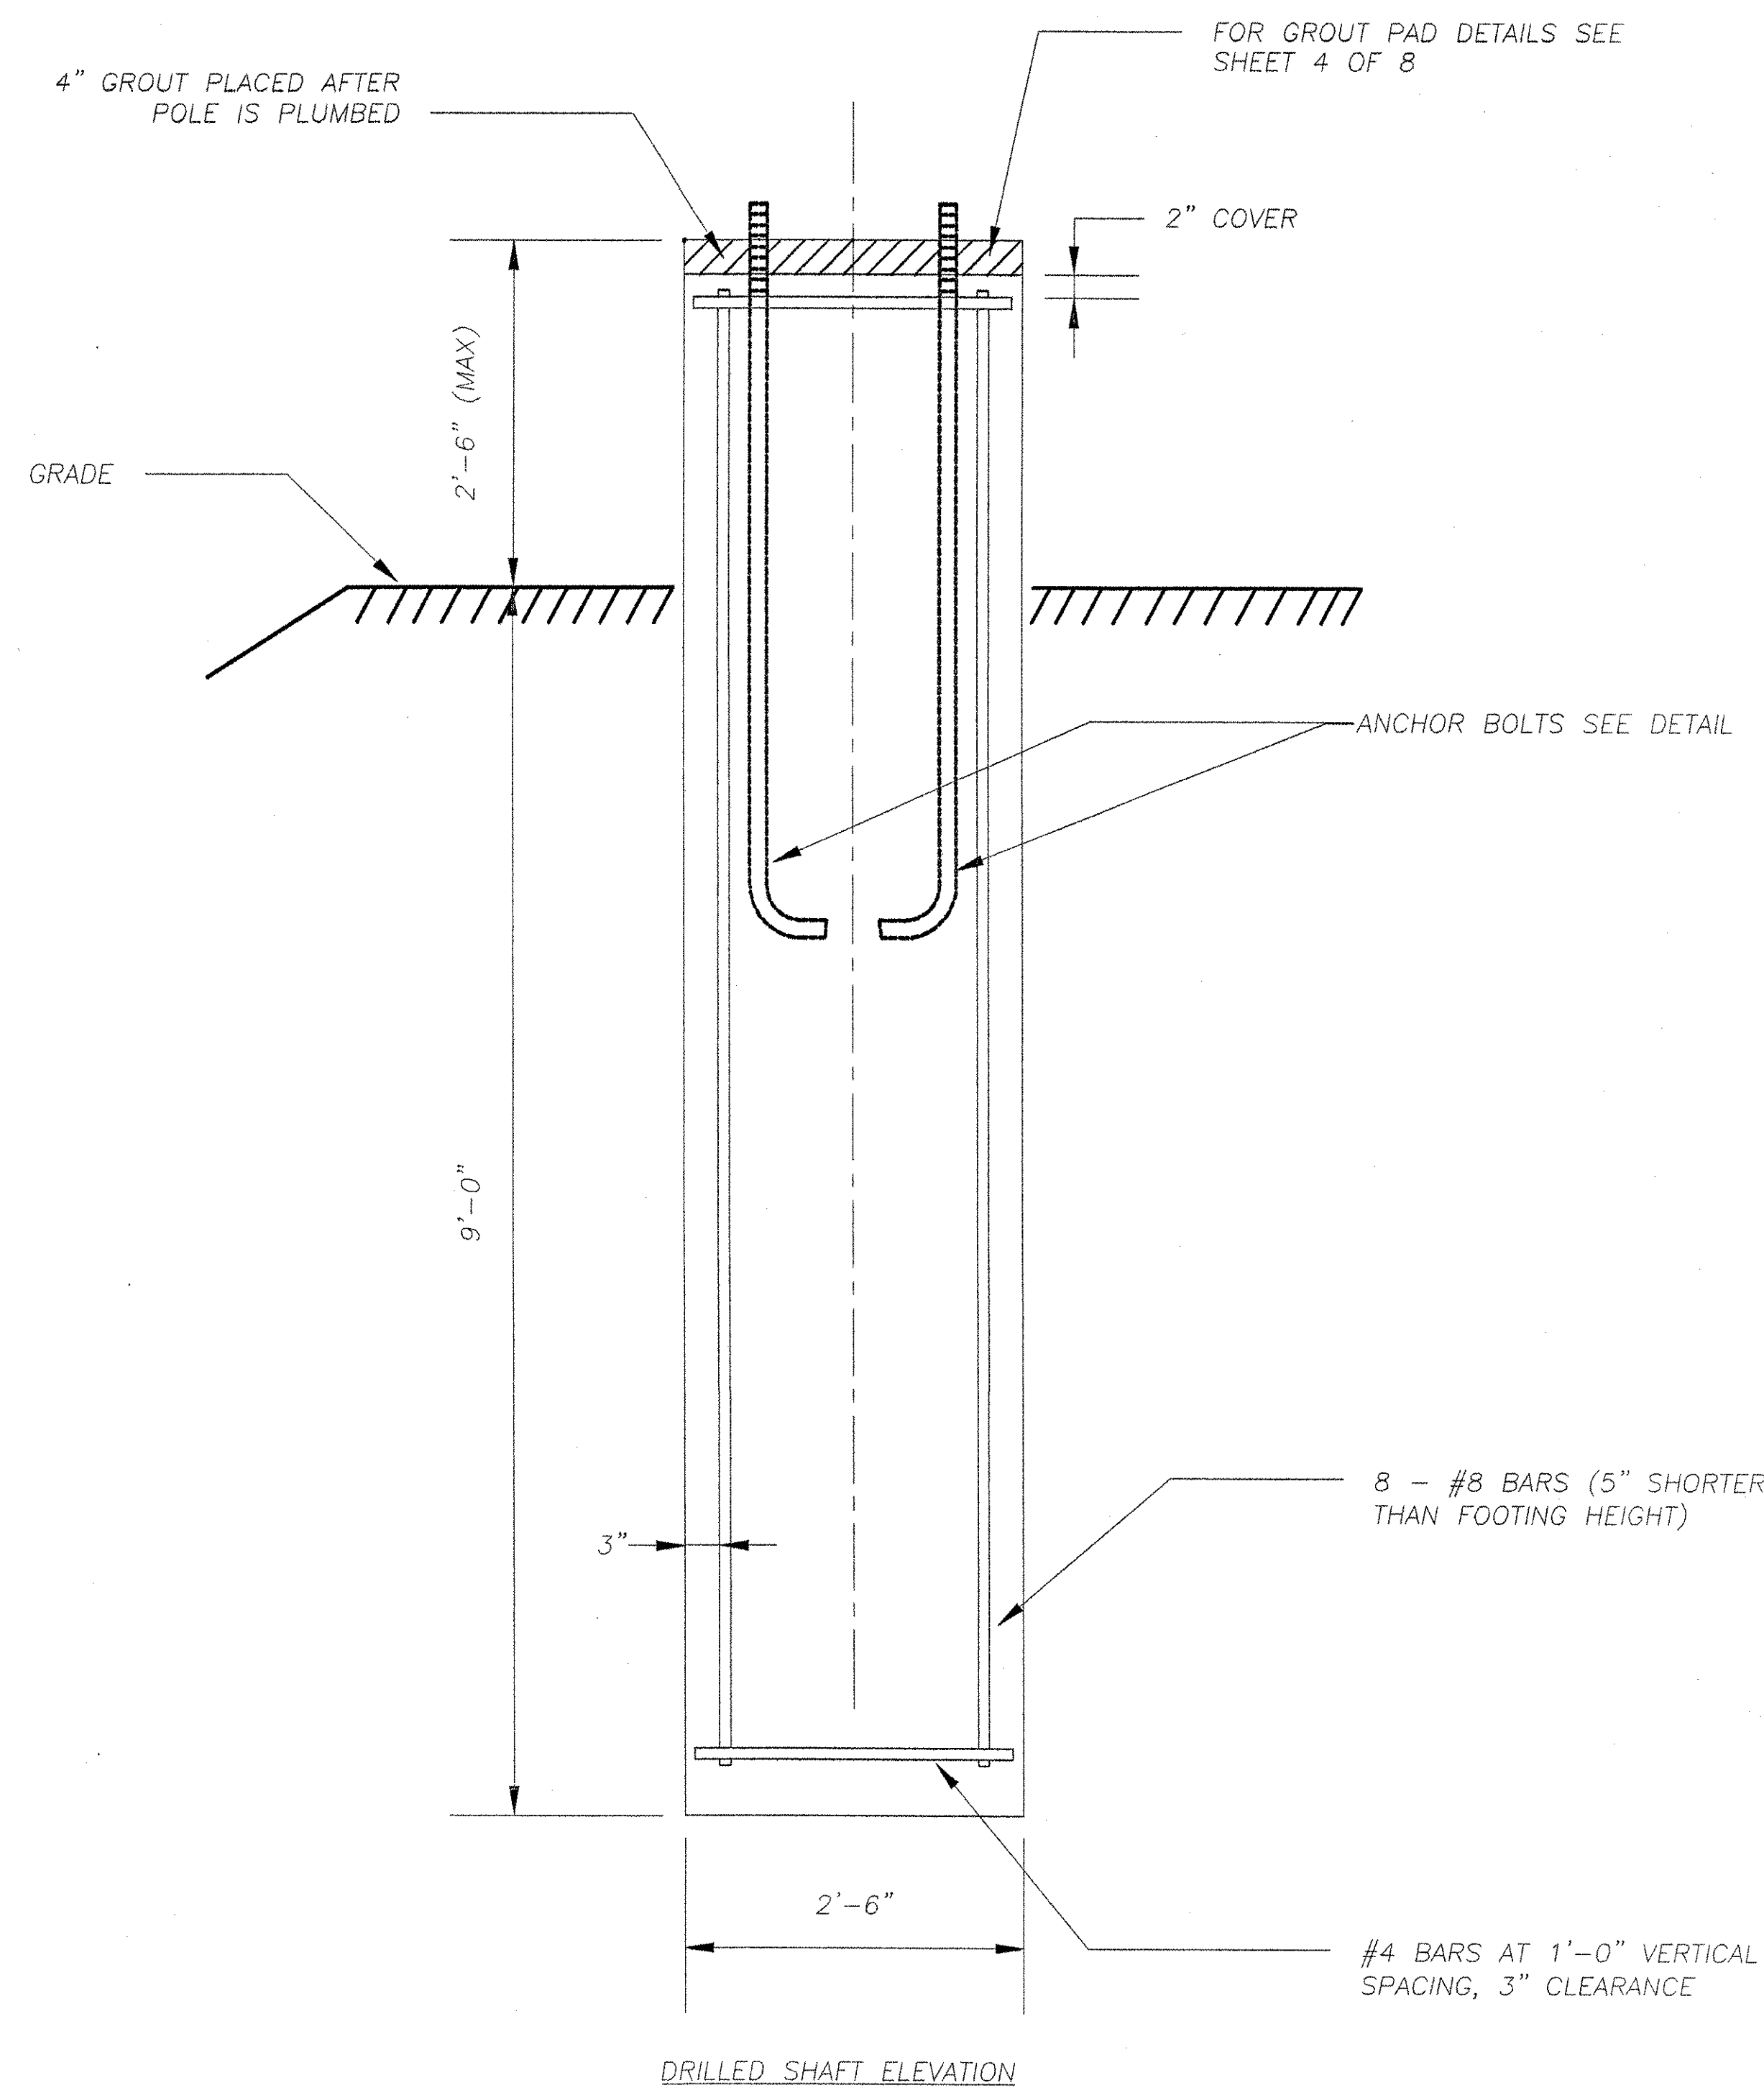

DRILLED SHAFT ELEVATION



HIGHWAY SAFETY CORP.
 GLASTONBURY, CT

TRI-CHORD SIGN STRUCTURE
 I-89 EXIT 12 SB OFF RAMP
 CHITTENDEN COUNTY, VERMONT
 PROJECT No. IM 089-2(35)

| | |
|-------------------|--------------------|
| DRAWN | |
| CHECKED | <i>[Signature]</i> |
| DATE | 11/15/05 |
| SCALE | N.T.S. |
| HSC REFERENCE NO. | 1515 |
| SIZE | D |
| REVISION | 0 |
| SHEET NO. | 8 of 8 |

| REVISIONS | | |
|-----------|-------------------|------|
| No. | Remarks | Date |
| 0 | Initial submittal | |
| | | |
| | | |

[Handwritten signature]