



**END PROJECT  
STA. 21+42.59**

**BEGIN PROJECT  
STATION 0+00.00  
MM 84.349**

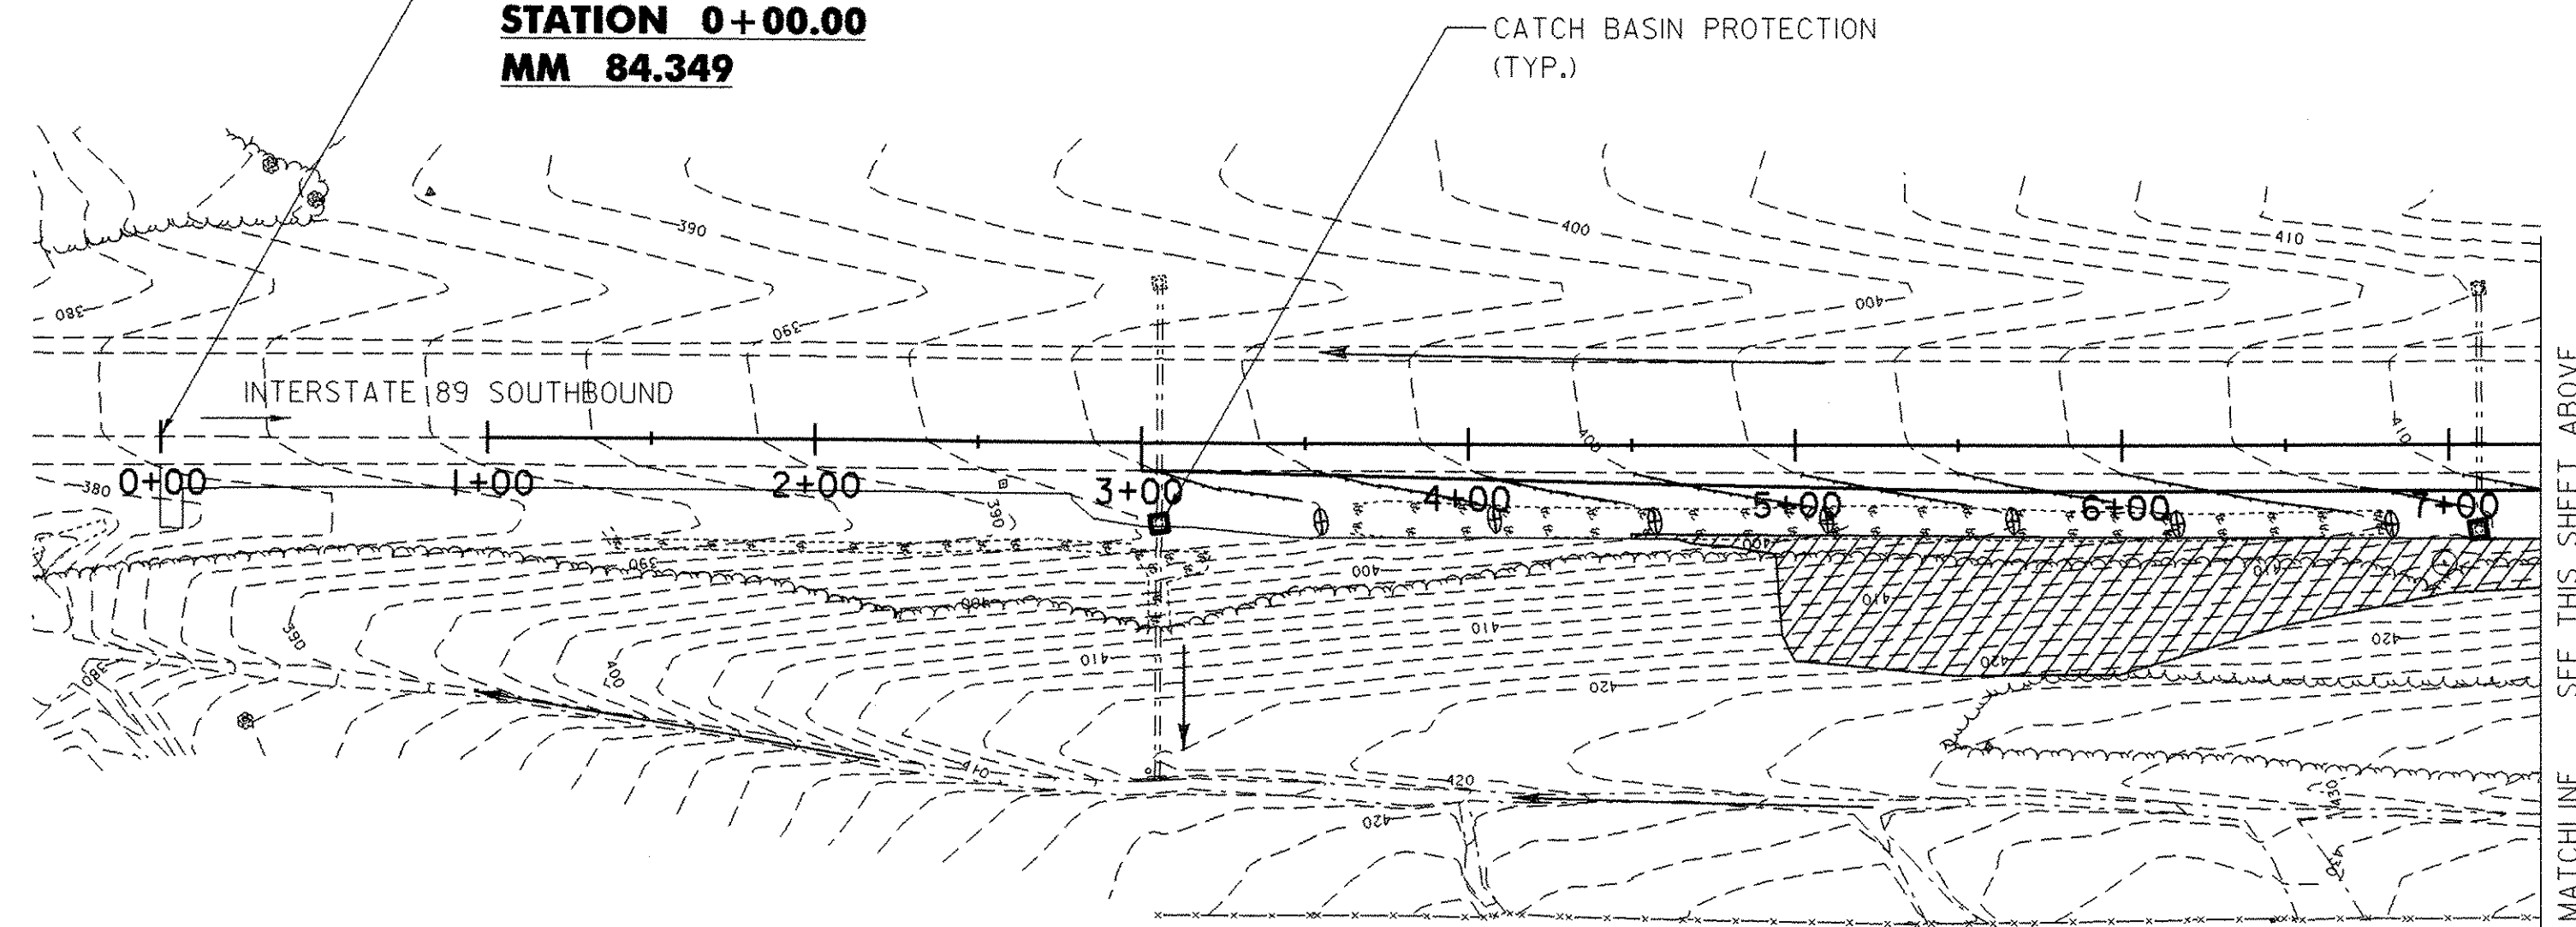

- LEGEND**
- EDGE OF PAVEMENT
  - ▲ HVCTRL POINT
  - TREELINE
  - TREE
  - SIGN
  - === CULVERT
  - EXISTING CHANNEL
  - ..... EXISTING STANDING WATER
  - ▣ CATCH BASIN
  - GUARDRAIL
  - R.O.W. LINE
  - TOE OF SLOPE
  - ... SILT FENCE
  - ⊕ CHECK DAM
  - ▨ EROSION MATTING
  - ▨ STONE FILL, TYPE II
  - ▣ CATCH BASIN PROTECTION

<b>DATUM</b>	
VERTICAL	N/A
HORIZONTAL	N/A

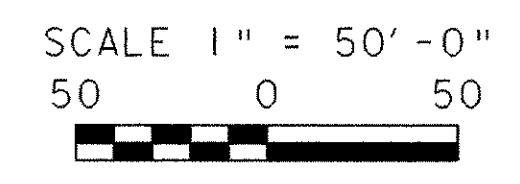

PROJECT NAME:	WILLISTON	PLOT DATE:	17-MAY-2005
PROJECT NUMBER:	IM 089-2(35)	DRAWN BY:	JDA / PGJ
FILE NAME:	p04all4.dgn	CHECKED BY:	EPD
PROJECT LEADER:	EPD	DESIGNED BY:	JDA
DESIGNED BY:	JDA	EROSION AND SEDIMENT CONTROL PLAN	SHEET 59 OF 78