



3+05

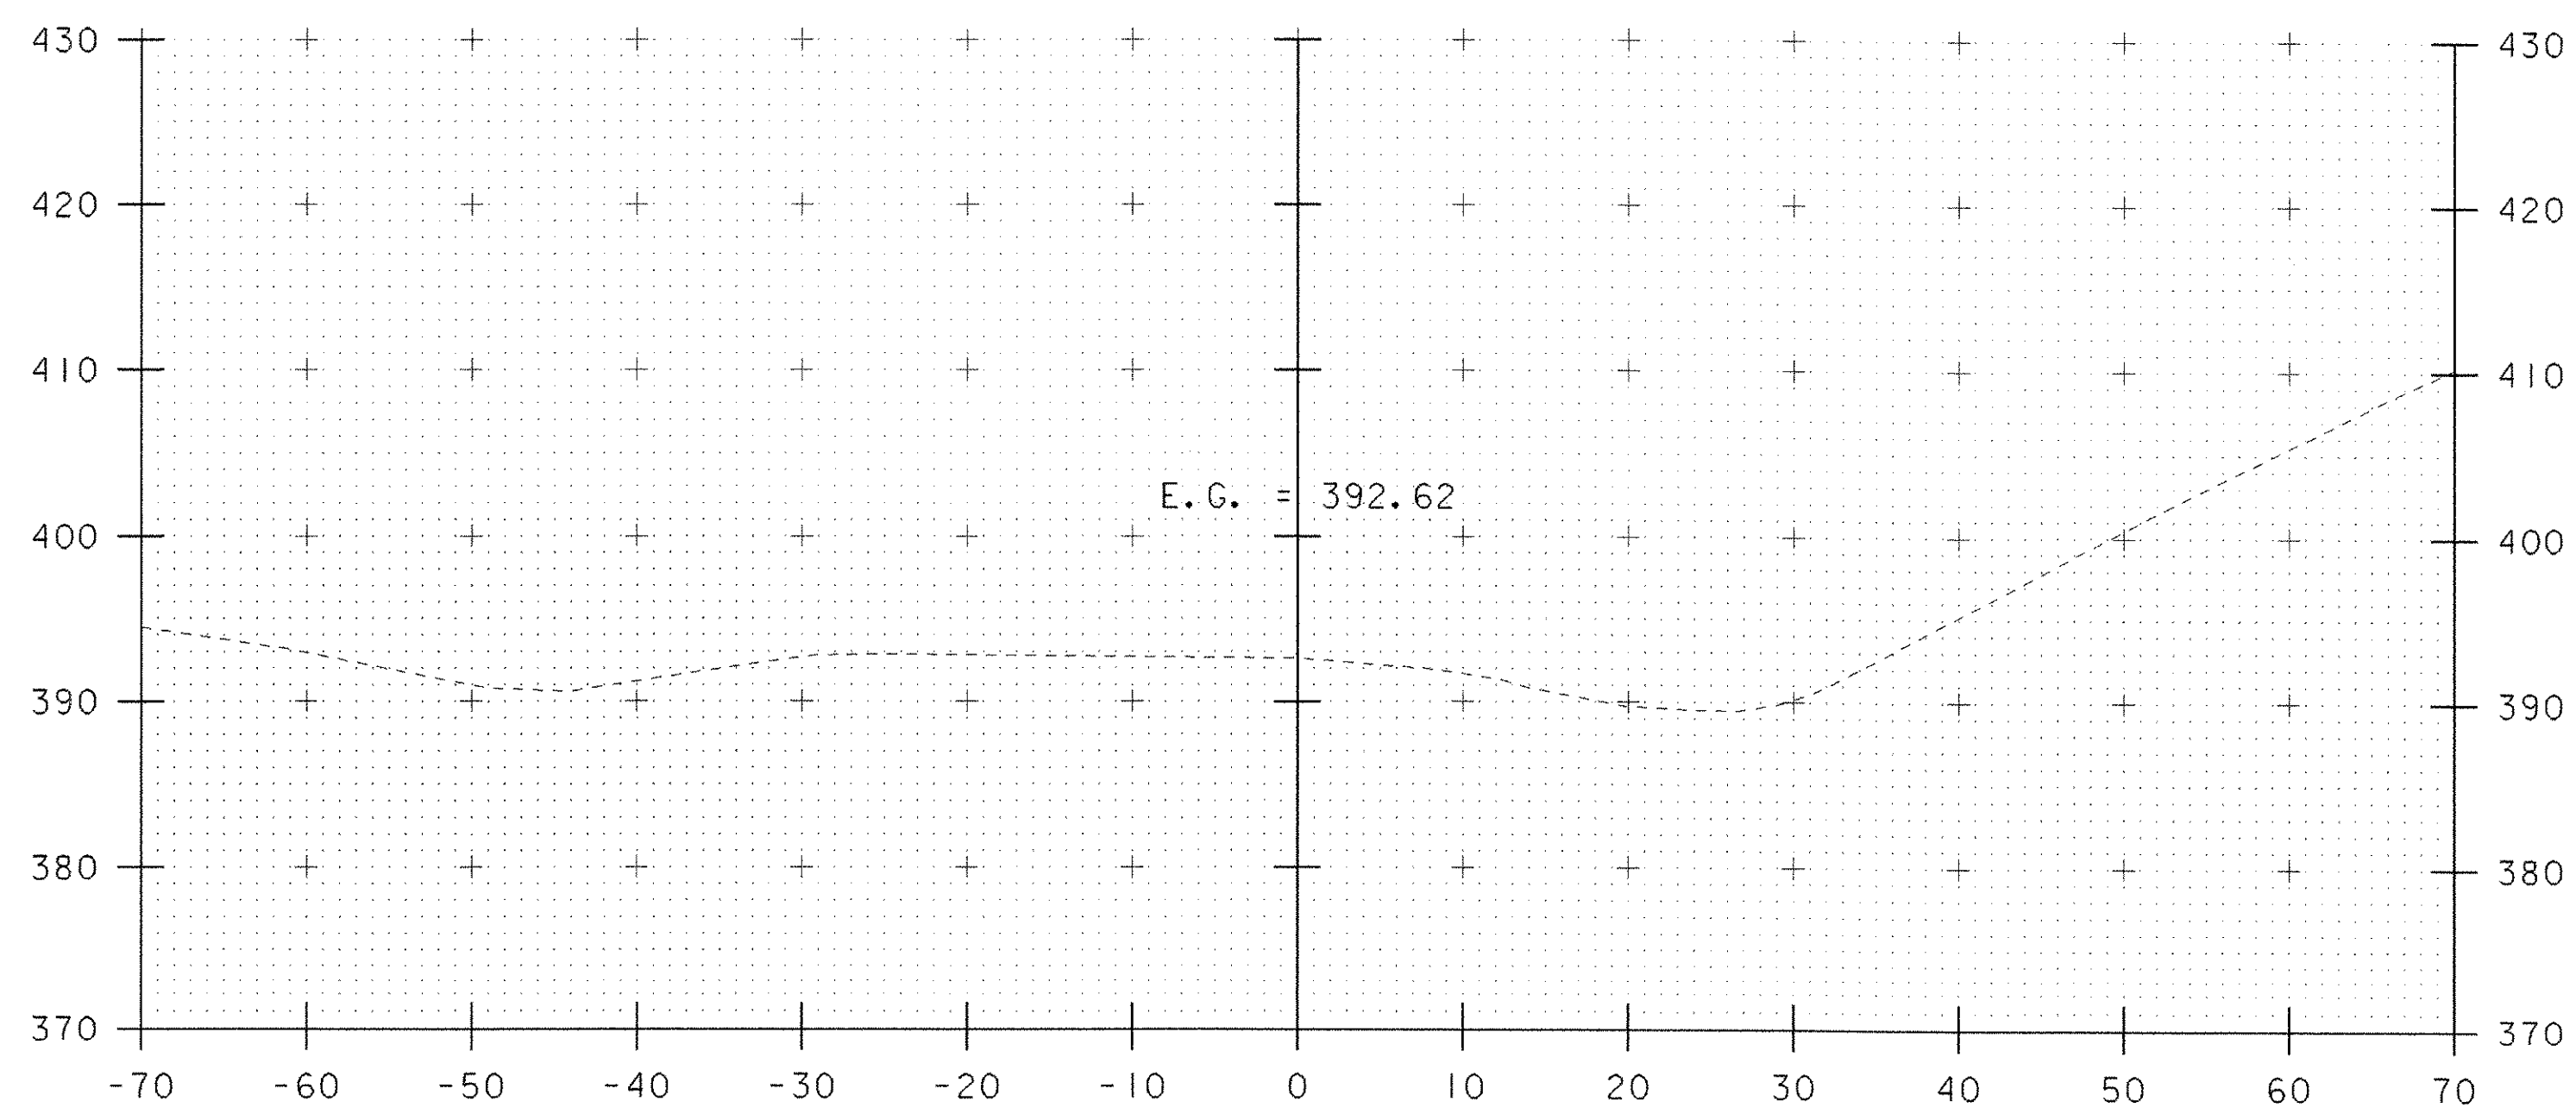

2+50

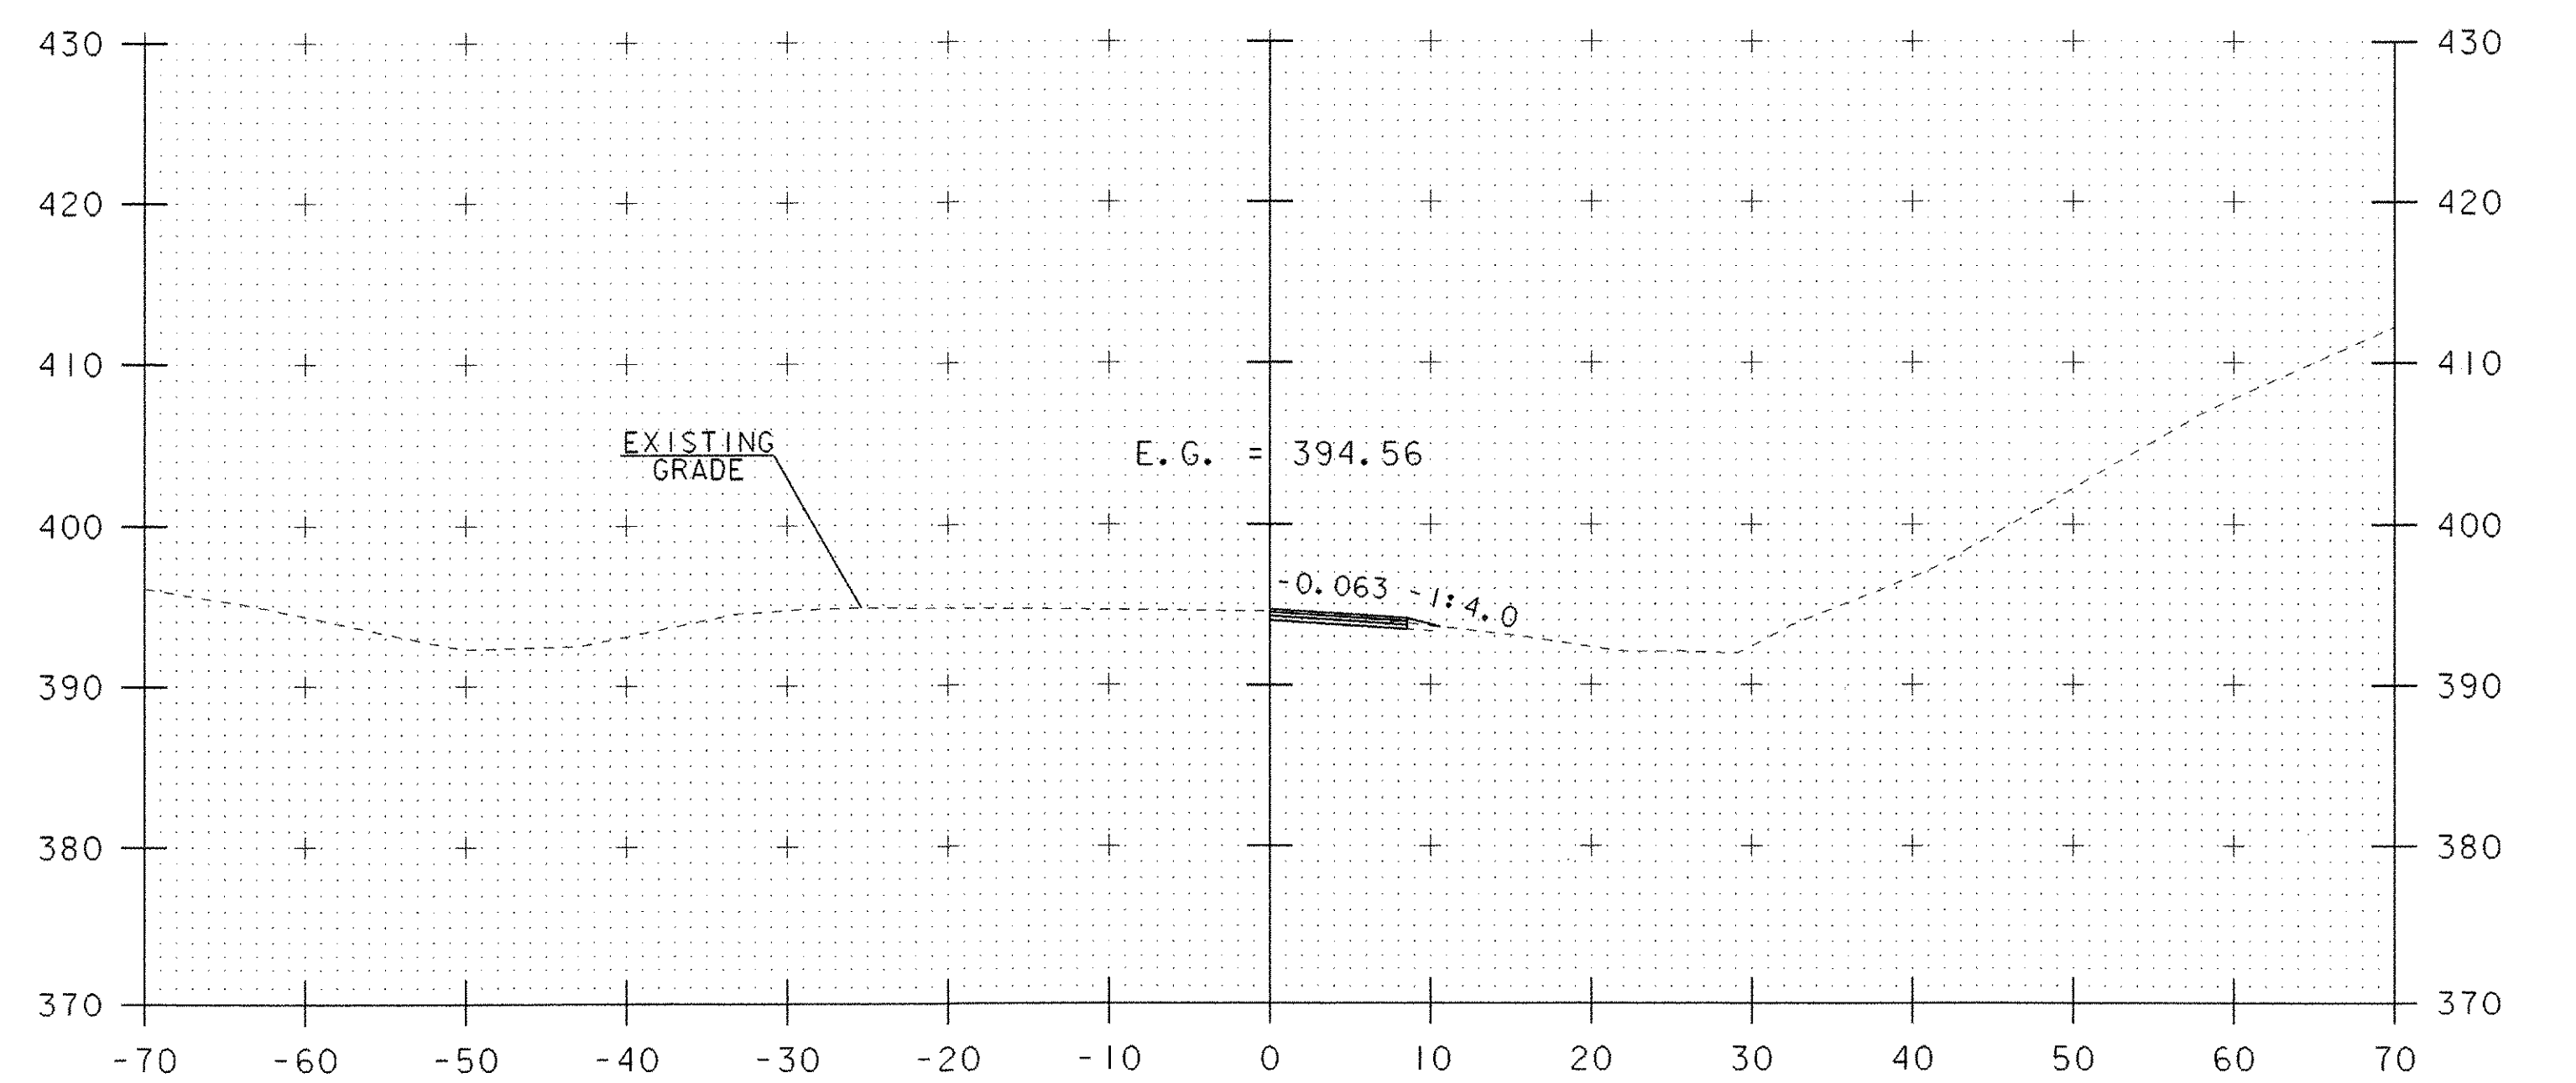


3+00

NOTE: STA. 2+50 - 3+00 RT - GRADE DITCH TO DRAIN

DATUM
 VERTICAL N/A
 HORIZONTAL N/A

NOTE: SEE LAYOUT SHEET AND TRENCH DETAIL ON SIGN ACTUATION NOTES AND DETAILS SHEET FOR PLACEMENT OF CONDUIT.

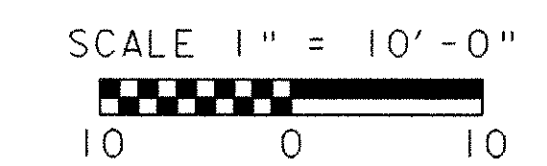

PROJECT NAME: I-89 EXIT 12 SB OFF RAMP
 PROJECT NUMBER: IM 089-2(35)

FILE NAME: 618800F4XS01.dgn
 PROJECT LEADER: EPD
 DESIGNED BY: JDA
 STA. 2+50 TO STA. 3+05

PLOT DATE: 17-MAY-2005
 DRAWN BY: JDA / PGJ
 CHECKED BY: EPD
 SHEET 69 OF 76