




7+09

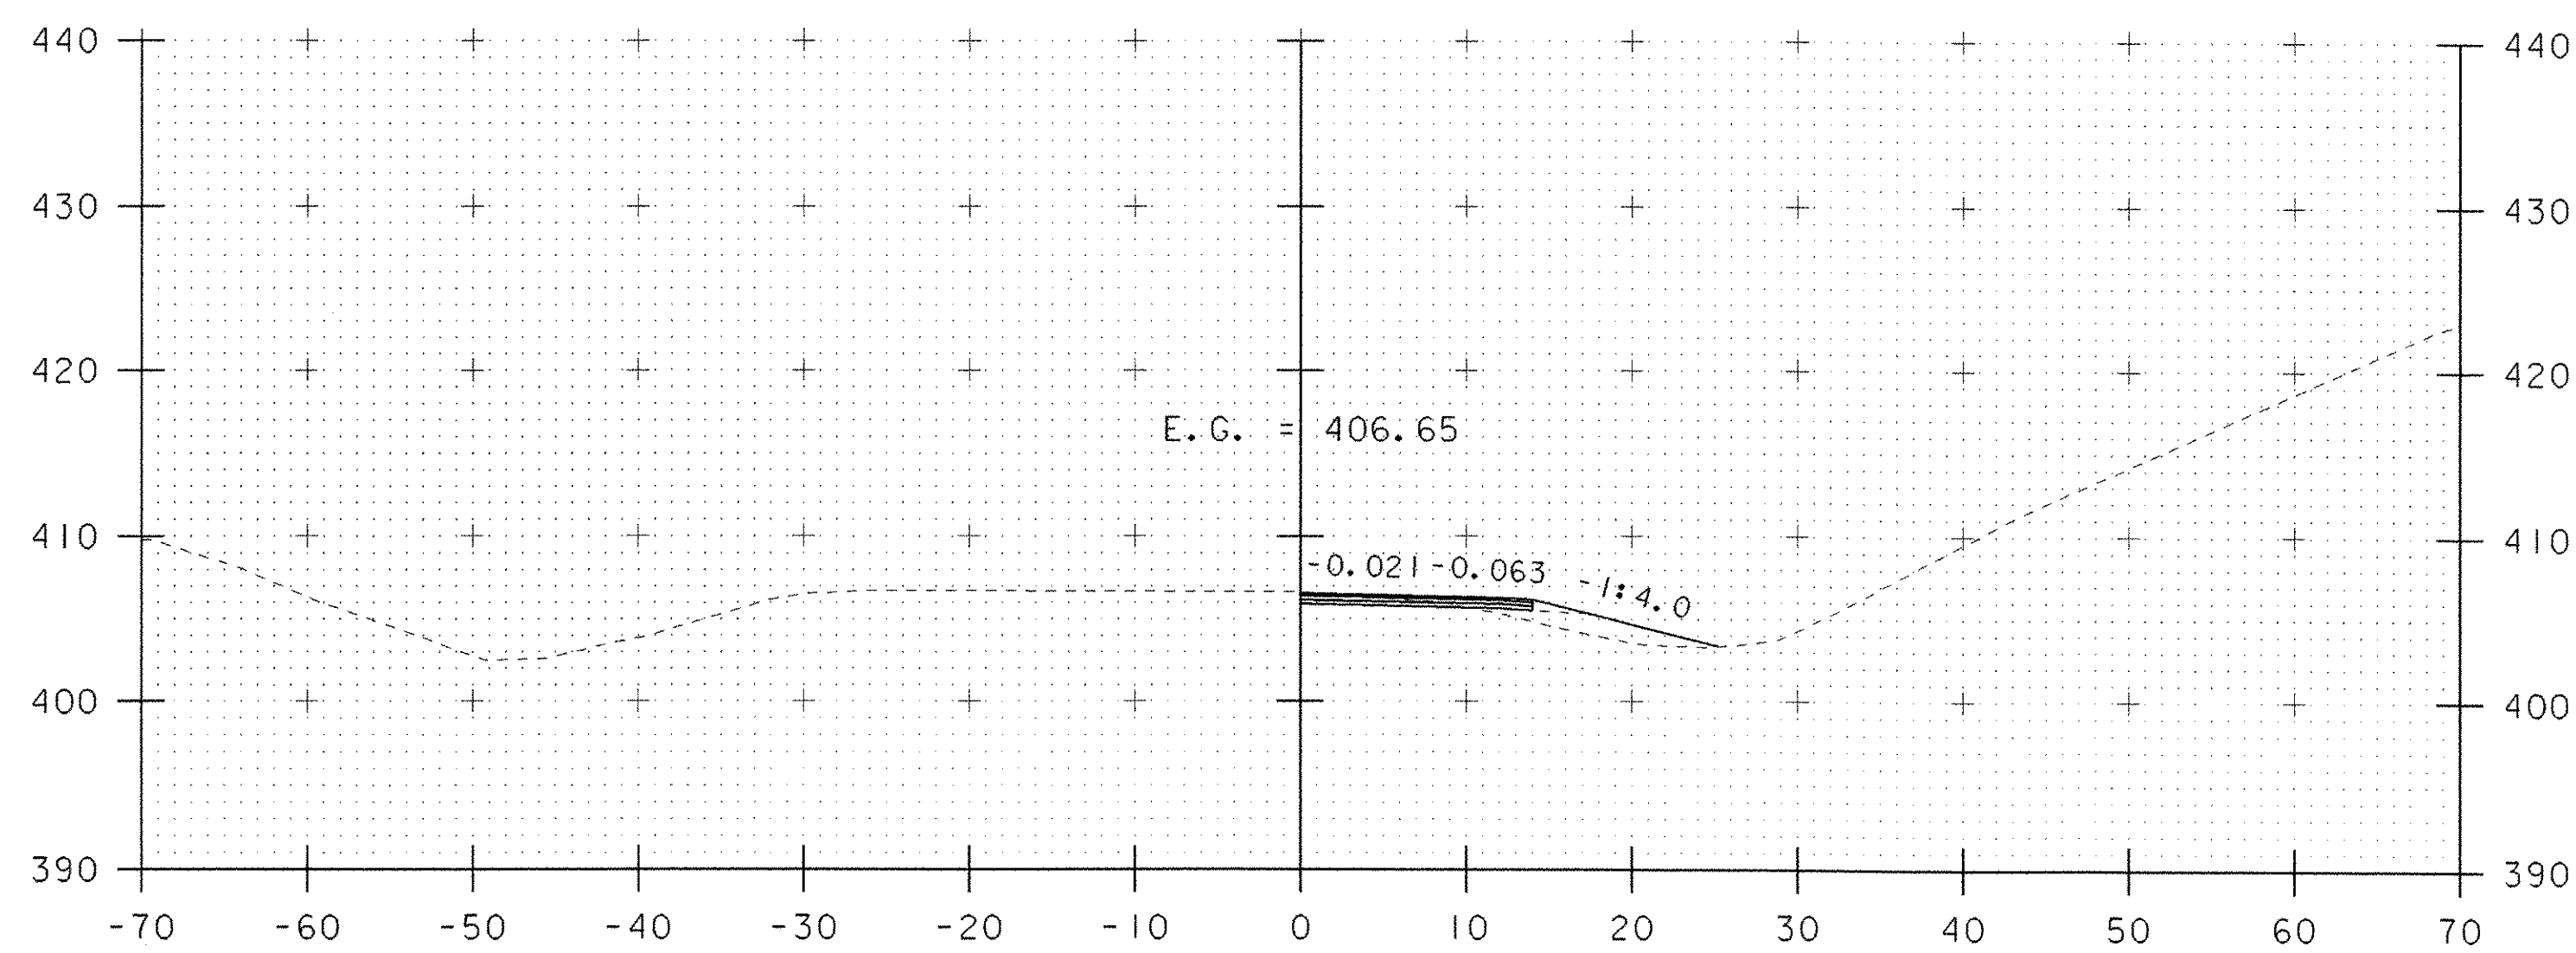


6+00

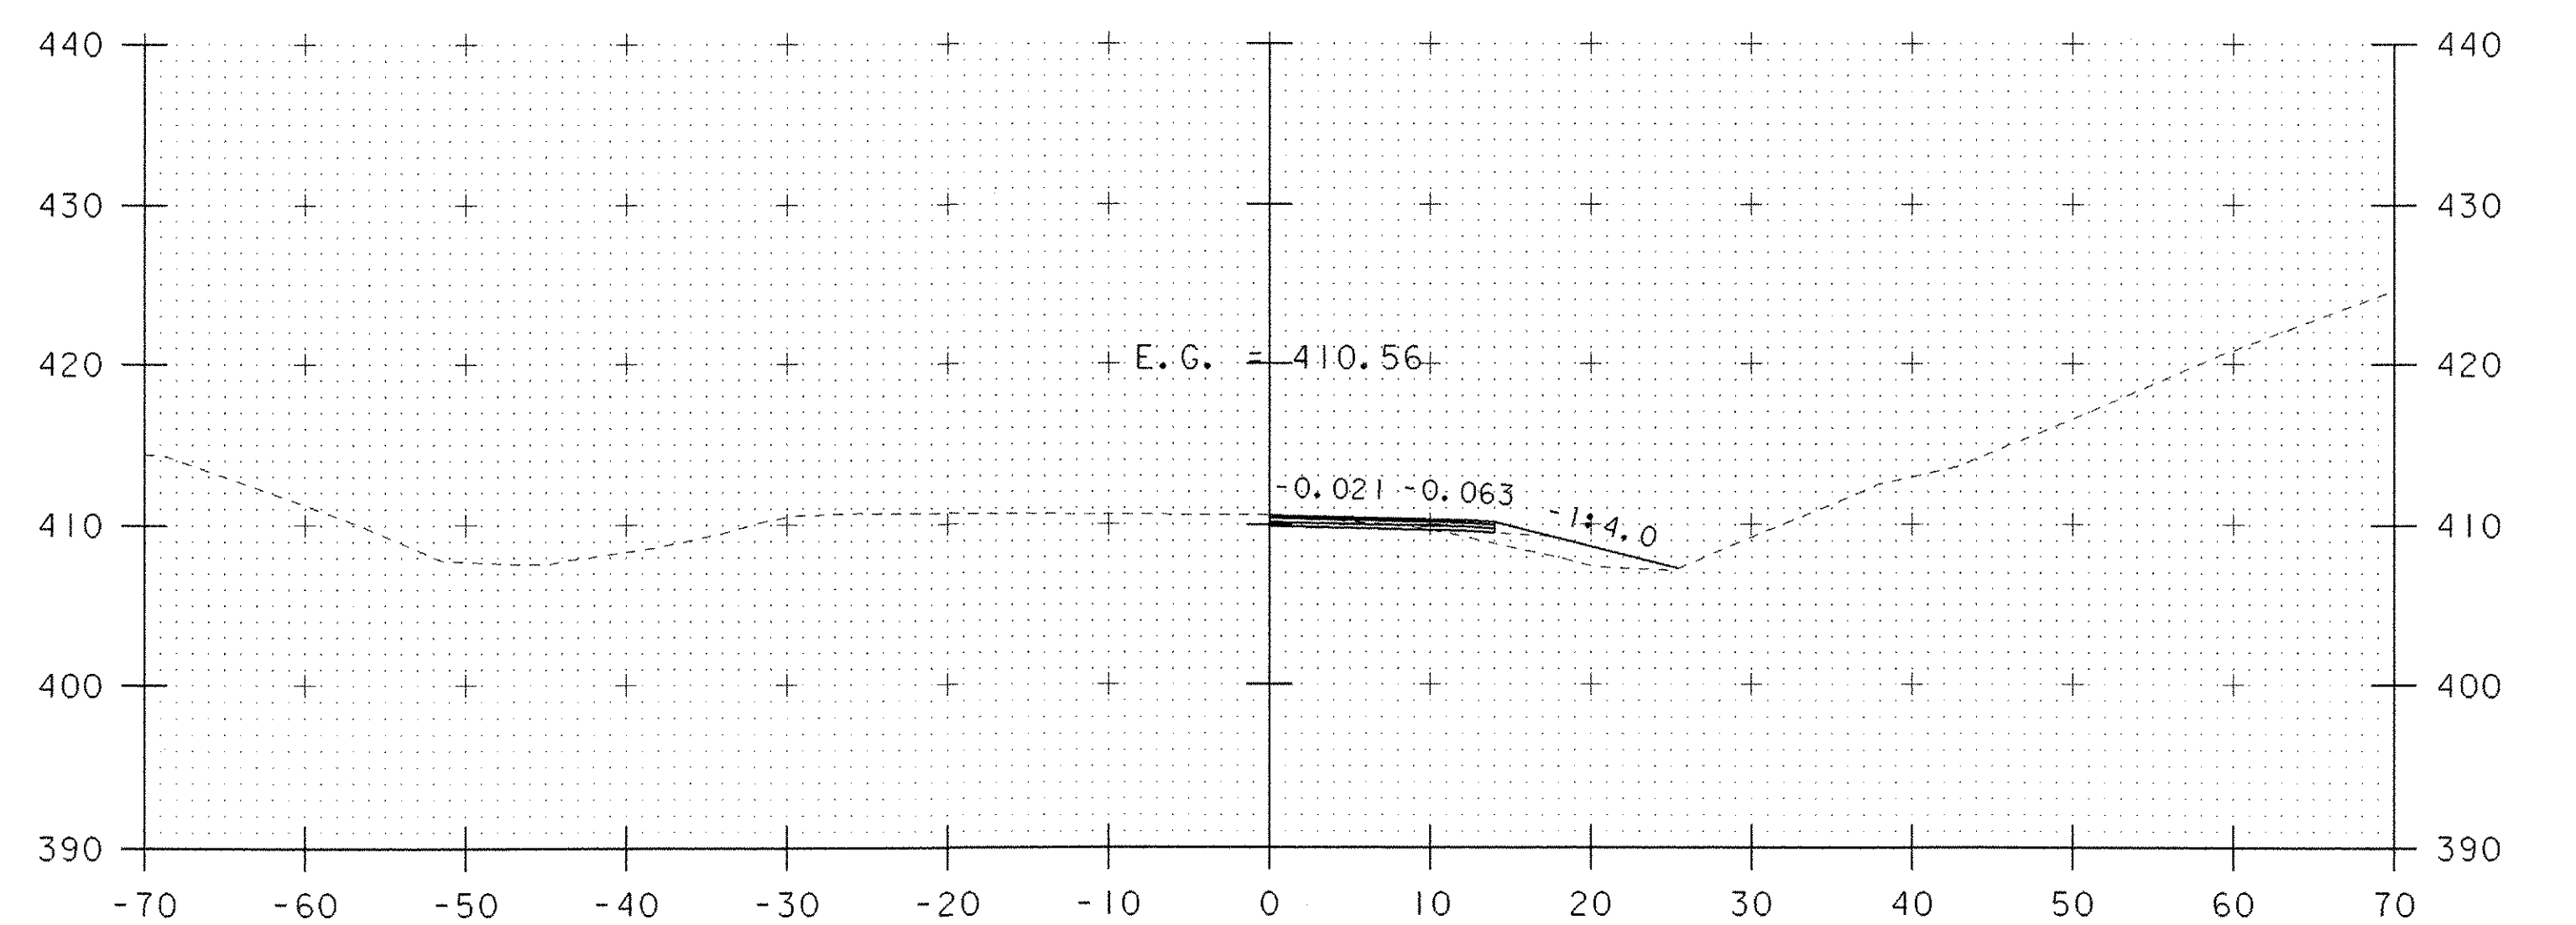

7+00

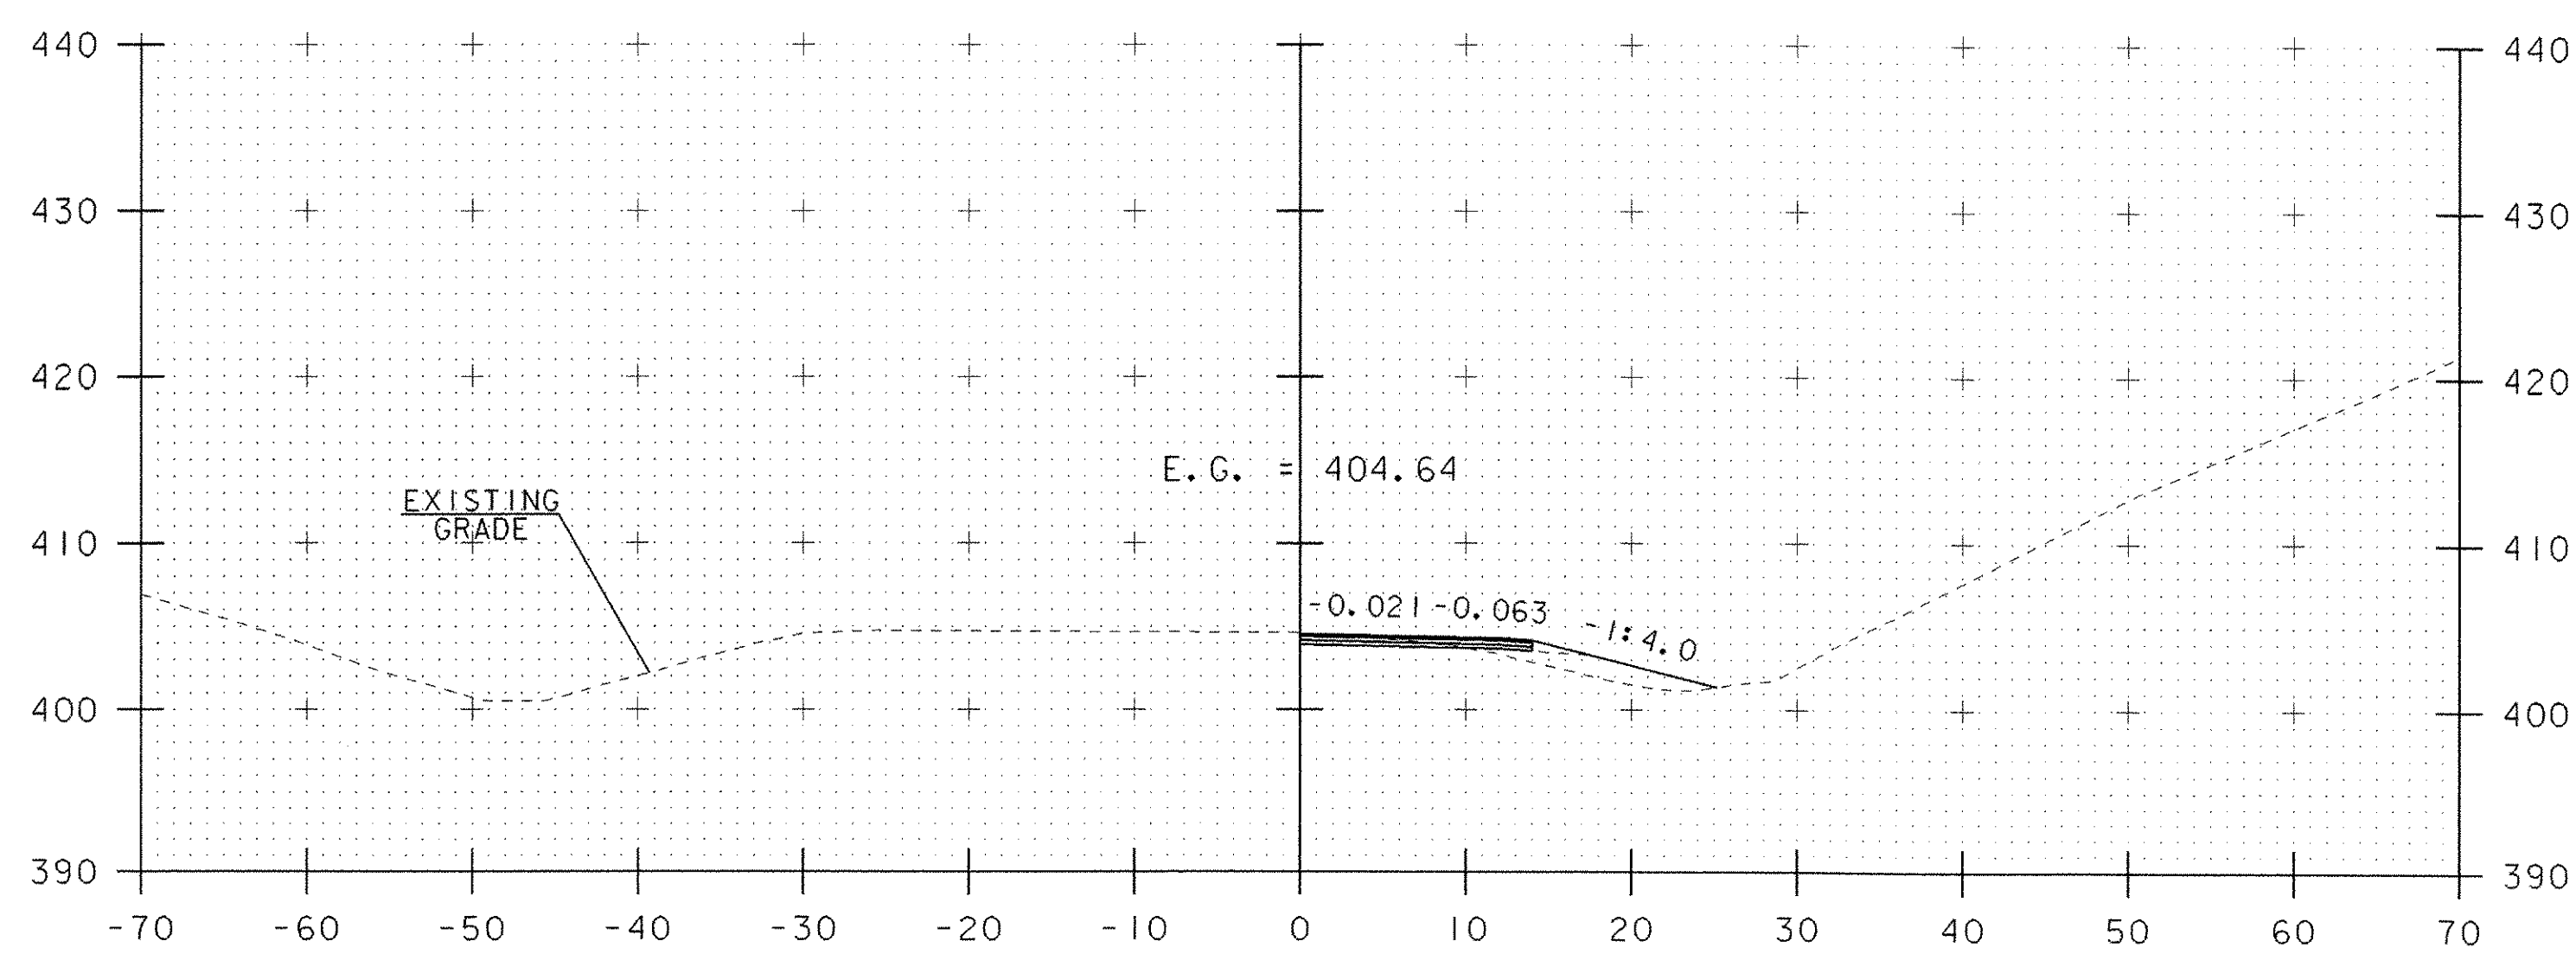


5+50

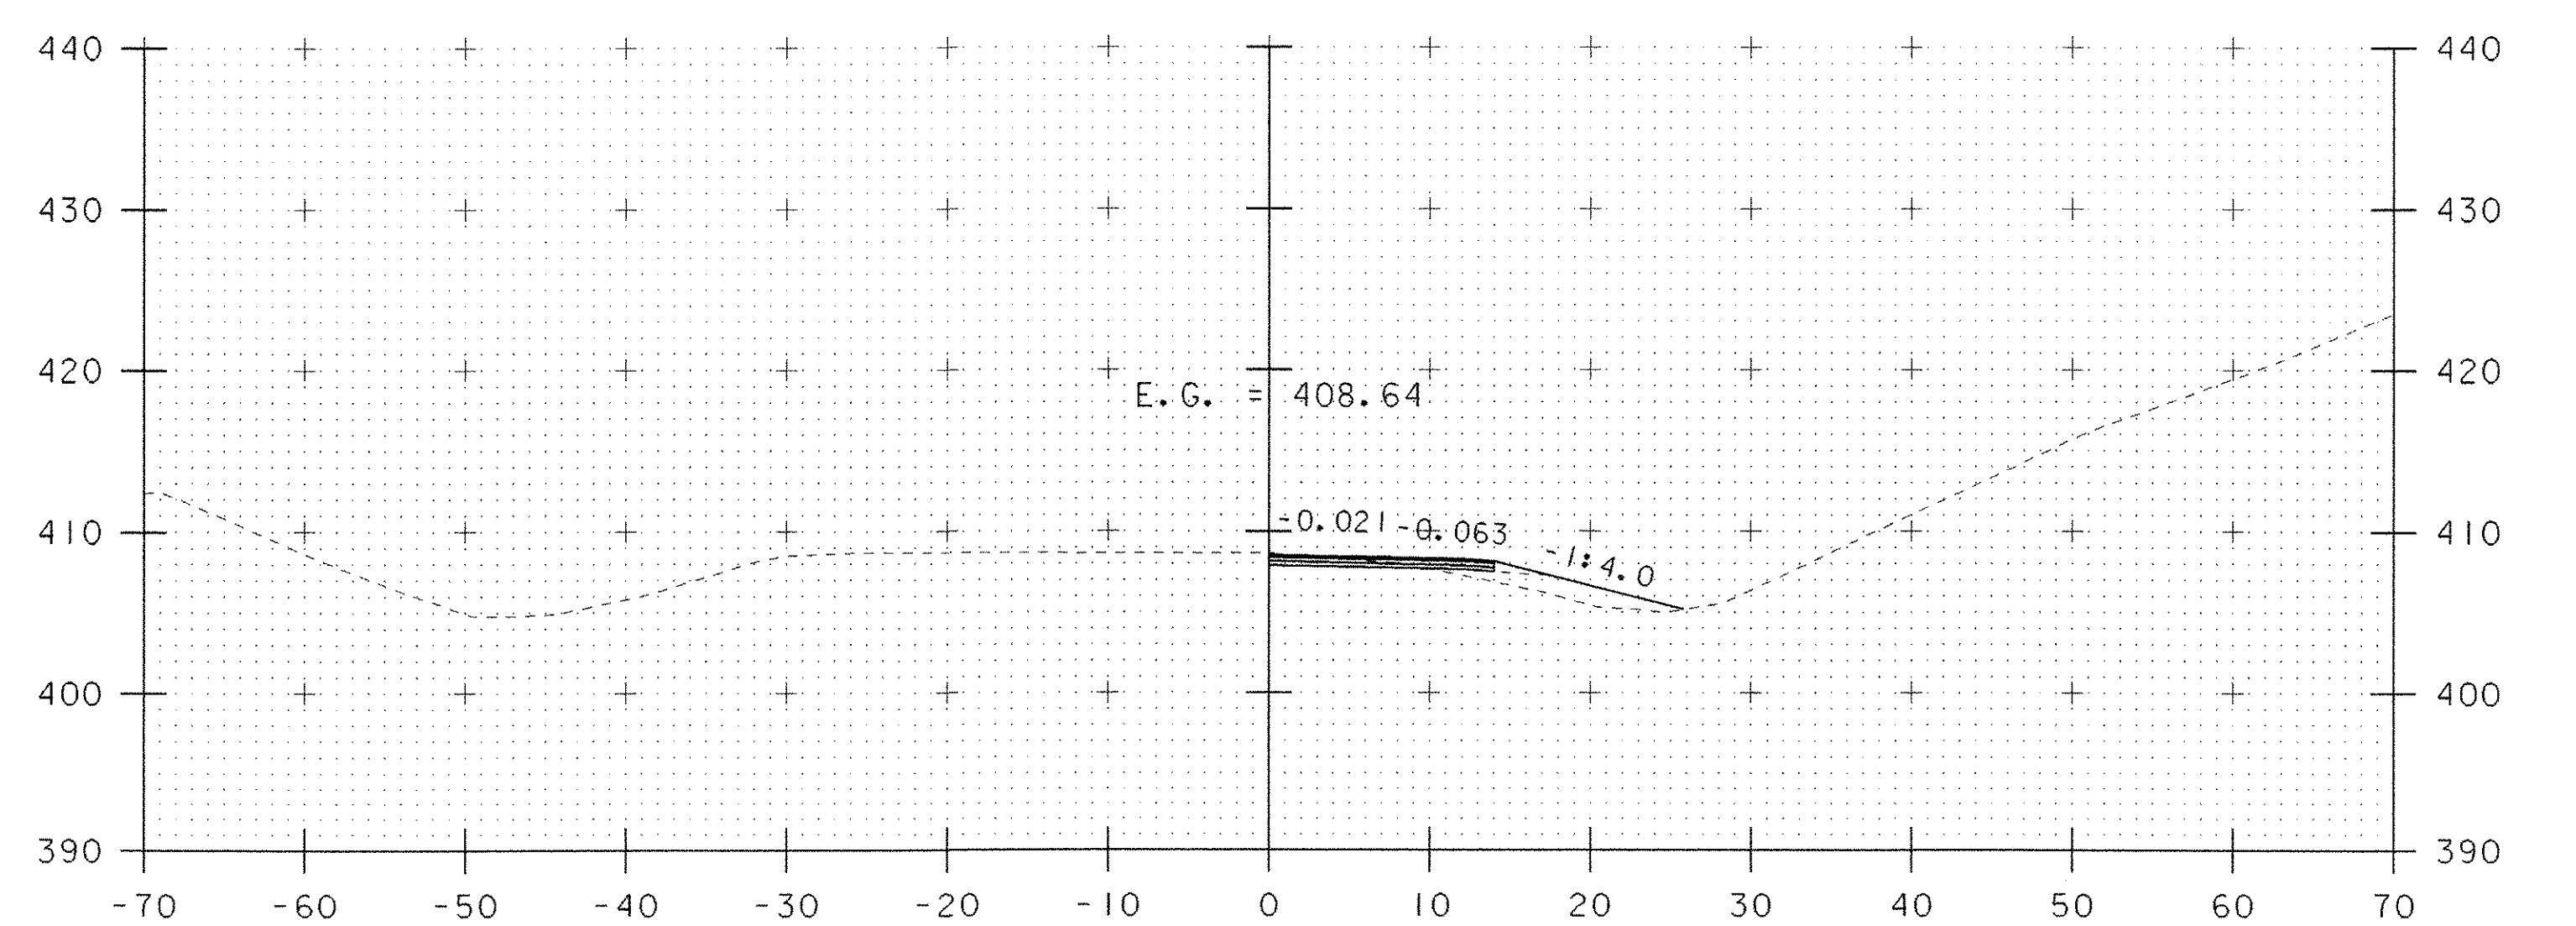

6+50

DATUM
 VERTICAL N/A
 HORIZONTAL N/A

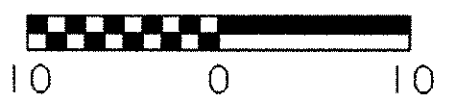SCALE 1" = 10'-0"


PROJECT NAME: I-89 EXIT 12 SB OFF RAMP
 PROJECT NUMBER: IM 089-2(35)
 FILE NAME: 618800F4XS01.dgn
 PROJECT LEADER: EPD
 DESIGNED BY: JDA
 STA. 5+50 TO STA. 7+00
 PLOT DATE: 17-MAY-2005
 DRAWN BY: JDA / PGJ
 CHECKED BY: EPD
 SHEET 71 OF 76